



## CSP 26-036KB (BP048) – ADDENDUM No.02 BP048 HVAC – MEP West Zone 3


FOR

**Fort Bend Independent School District**  
2023 Bond Program

**To access the complete Addendum:**

<https://fortbendisd.bonfirehub.com/portal/>

Reviewed By:  Signed by:  
Juan Valdez  
D66E219662EF4EE... 1/27/2026  
PROJECT MANAGER

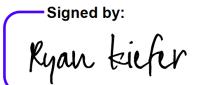Reviewed By:  Signed by:  
Ryan Kiefer  
1F973D1CC91A41D... 1/27/2026  
DESIGN MANAGER

Reviewed By:  Signed by:  
Brenda Garcia  
F7F6BD96D7C742E... 1/27/2026  
CONSTRUCTION MANAGER

Approved By:  Signed by:  
Daniel Bankhead  
AABFCACAE7E9453... 1/27/2026  
DESIGN AND CONSTRUCTION EXECUTIVE DIRECTOR

Approved By:  Signed by:  
Director Materials Management  
DF25ADA7E416421... 1/27/2026  
DIRECTOR MATERIALS MANAGEMENT

# ADDENDUM SUMMARY

## FBISD BP048 HVAC - MEP WEST ZONE 3 25241.0100

Date and Time: 1/26/2026 5:00 PM

Addendum #: 002

This addendum contains changes to the requirements of the contract drawings and/or project manual. Such changes shall be incorporated into the contract documents and shall apply to the work with the same meaning and force as if they had been included in the original documents. Wherever this addendum modifies a portion of the paragraph of project manual or any portion of the drawing, the remainder of the paragraph of drawing affected shall remain in force.

The conditions of the basic project manual shall govern all work described in this addendum. Wherever the conditions of work and the quality of quantity of materials or workmanship are not fully described in this Addendum, the conditions of work, etc. included in the basic project manual for similar items of work shall apply to the work described in this addendum.

The "Conditions of the Contract" apply to all work described in this Addendum.

A total of eighteen (18) pages submitted in Addendum #2.

The following changes shall be and are hereby made:

### SUMMARY OF REVISIONS:

Addendum No.2 provides clarifications and revisions to the sheets as outlined below. See MEP narratives for their respective summaries.

#### Austin HS:

- A-M10-01 - MECHANICAL DEMOLITION PLAN - LEVEL 01 – OVERALL
  - Updated Keynote 2 to clarify the demolition scope
- A-M10-02 - MECHANICAL DEMOLITION PLAN - LEVEL 02 – OVERALL
  - Updated Keynote 2 to clarify the demolition scope
- A-M20-01 - MECHANICAL PLAN - LEVEL 01 – OVERALL
  - Added Controls to be by Unify Controls note
- A-M20-02 - MECHANICAL PLAN - LEVEL 02 – OVERALL
  - Added Controls to be by Unify Controls note
- A-M20-03 - MECHANICAL ENLARGED PLANS
  - Added Controls to be by Unify Controls note
- A-M20-04 - MECHANICAL ENLARGED PLANS
  - Added Controls to be by Unify Controls note
- A-M20-05 - MECHANICAL ENLARGED PLANS
  - Added Controls to be by Unify Controls note
- A-M30-00 - MECHANICAL SCHEDULES
  - Added a pump alignment note to the pump schedule
- A-M40-01 - MECHANICAL DETAILS
  - Added a note for the unit dimensions and field adjustments to be made by contractors

**Bowie MS:**

- B-M20-01 - MECHANICAL PLAN - LEVEL 01 - OVERALL
  - Added a keynote telling contractor to replace cooling tower bypass line
- B-M30-00 - MECHANICAL SCHEDULES
  - Added a pump alignment note to the pump schedule

**Crockett MS:**

- C-M20-01 - MECHANICAL PLAN - LEVEL 01 - OVERALL
  - Added a keynote telling mechanical contractor to coordinate with controls contractor on CT Valve protection.
- C-M30-00 - MECHANICAL SCHEDULES
  - Added a pump alignment note to the pump schedule

**Garcia MS:**

- G-M30-00 - MECHANICAL SCHEDULES
  - Added a pump alignment note to the pump schedule

**Hodges Bend MS:**

- H-M30-00 - MECHANICAL SCHEDULES
  - Added a pump alignment note to the pump schedule

**BIDDERS QUESTIONS:**

The contract documents reference modifications and additions to sprinkler systems, including new or modified supervisory and waterflow devices that require connection to the existing fire alarm system(s). However, the drawings and specifications do not clearly identify the existing fire alarm system manufacturer and control panel model at each campus included in this CSP.

Please provide, for each building included in this package:

- Fire Alarm Control Panel (FACP) manufacturer
- Fire Alarm Control Panel model

**BIDDERS RESPONSE:**

Response Per Jesus Garcia, FBISD

Austin HS: NFS2-3030,

Bowie MS: Silent Knight IFP-2100

Crockett MS: Silent Knight 6820

Garcia MS: Notifier AFP 2020

Hodges Bend MS: Notifier 3030

Travis HS: IFP 2100

Walker Station ES: Notifier 640

**End of Addendum Summary**

*Please review this information and advise writer of any corrections, misunderstandings or additions within 3 business days.*

**SCOPE NOTE:**  
REFER TO ATTACHMENTS FOR EXISTING CONDITIONS REGARDING LOCATIONS OF EQUIPMENT, EXTENTS OF DUCTWORK / PIPING, AND ADDITIONAL INFORMATION.

<b>ISSUES</b>		
1	07.18.2025	DESIGN DEVELOPMENT
2	09.29.2025	50% CONSTRUCTION DOCUMENTS
3	11.11.2025	90% CONSTRUCTION DOCUMENTS
4	12.11.2025	100% CONSTRUCTION DOCUMENTS

	<h1>REVISIONS</h1>	
1	01/23/2026	ADDENDUM #2

A circular seal for a professional engineer. The outer ring contains the words "STATE OF TEXAS" at the top and "PROFESSIONAL ENGINEER" at the bottom, separated by stars. The inner circle contains the name "KOUROSH M. YAZDANI" above the word "LICENSED" and "01/23/2026" below it. The entire seal is rendered in a high-contrast, black and white graphic style.

Date of issue:  
01.23.2026

**FORT BEND ISD - BP048**  
**HVAC MEP WEST ZONE 3**  
**STEPHEN F. AUSTIN HS**  
3434 Pheasant Creek Dr

STRUCTURE INC. C.C.B.I.  
Sugar Land, TX 77498

# 1 MECHANICAL DEMOLITION PLAN - LEVEL 01

1/32" = 1'-0"

## DEMOLITION NOTE

1. DEMOLITION INTENT: REMOVE ALL TERMINAL UNITS, AIR HANDLING UNITS, AND PUMPS DESIGNATED FOR REMOVAL. COORDINATE WITH BUILDING OWNER FOR ALL EQUIPMENT TO BE SALVAGED. IF THE OWNER DOES NOT WISH TO RETAIN EQUIPMENT, DISPOSE OF IN A MANNER ACCEPTABLE TO ALL AUTHORITIES HAVING JURISDICTION.
2. PRIOR TO WORK, GENERAL AND MECHANICAL CONTRACTORS SHALL OBTAIN CONFIRMATION FROM OWNER BEFORE REMOVING ANY CONDUIT, CIRCUIT, WIRING, PIPING, EQUIPMENT OR CONTROL WIRING WHICH MAY STILL BE IN USE. THE CONTRACTOR SHALL REPLACE ANY ITEM REMOVED DURING THE DEMOLITION PROCESS, WHICH IS INTENDED TO REMAIN AT NO ADDITIONAL COST TO THE OWNER.
3. REMOVE ALL NON-ACTIVE CONTROLS, SUPPORTS, HANGERS, INSULATION, ETC. REMOVE ANY REMAINING REFRIGERANT LEGAL AND ENVIRONMENTALLY RESPONSIBLE MANNER, IN ACCORDANCE WITH ALL LAWS AND REGULATIONS.
4. CONTRACTOR TO COORDINATE EXTENT OF DEMOLITION WITH ALL NEW WORK INTENT.
5. DEMOLITION AND NEW CONSTRUCTION ACTIVITIES SHALL IN NO WAY DISRUPT ONGOING OPERATIONS. TEMPORARY SHUTDOWN SCHEDULES MUST BE APPROVED, IN ADVANCE, BY THE CONSTRUCTION MANAGER AND THE CLIENT REPRESENTATIVE.
6. CONTRACTOR SHALL MAINTAIN A CLEAN JOBSITE AT ALL TIMES.


## ⑧ MECHANICAL KEYED NOTES

1. DEMOLISH EXISTING CENTRAL STATION AIR-HANDLING UNITS AND DISCONNECT ASSOCIATED PIPING AND DUCTWORK CONNECTIONS. CONTRACTOR TO DEMOLISH DUCTWORK JUST BEYOND EXISTING FLEX CONNECTORS AND PIPING BACK TO ISOLATION VALVE IN MECHANICAL ROOM. IF NO ISOLATION VALVE EXISTS, THEN CONTRACTOR IS TO PROVIDE PROVISIONS TO FREEZE TAP NEW SUPPLY AND RETURN CHW AND HW ISOLATION VALVES. THE LIMITS OF DEMOLITION ARE TO ENSURE NEW UNIT CAN BE INSTALLED.
2. REMOVE AND DEMOLISH EXISTING TERMINAL UNIT. DEMOLISH FLEX CONNECTIONS, COILS AND ASSOCIATED PIPING, ASSOCIATED CONTROLS ACTUATORS AND SENSORS. MAKE READY ALL CONNECTIONS FOR INSTALLATION OF NEW TERMINAL UNIT AND CONTROLS. CONTROLS CONTRACTOR TO SECURE ALL EXISITNG CONTROLS RELATED INFORMATION, INCLUDING BUT NOT LIMITED TO SEQUENCE OF OPERATIONS, ETC. PRIOR TO ANY DEMOLITION OF EQUIPMENT. CONTRACTOR TO REMOVE PROTECT AND REINSTALL ANY CEILING GRID AND TILE NECESSARY TO PROPERLY DEMOLISH EXISITNG TERMINAL UNIT AND MAKE READY FOR NEW TERMINAL UNIT INSTALLATION.
3. CONTRACTOR TO DEMOLISH EXISTING HOT WATER PUMP IN ITS ENTIRETY, INCLUDING ALL CONTROLS, INERTIA PADS, AND SUPPORTS. DEMOLISH EXISTING PIPING BACK TO ISOLATION VALVES. IF NO ISOLATION VALVES EXIST, THE CONTRACTOR IS TO PROVIDE PROVISIONS TO LINE FREEZE AND ADD NEW LINE SUPPLY AND RETURN MANUAL ISOLATION VALVES PER SPECIFICATIONS.
4. REFURBISH THE AIR HANDLING UNIT WITH THE FOLLOWNG. THROUGHLY CLEAN THE ENTIRE UNIT FROM THE INSIDE OUT INCLUDING THE FAN WHEEL, CHILLED WATER AND HEATING WATER COILS. PROVIDE NEW FILTERS, MOTORIZED DAMPERS, ACTUATORS, FAN BELTS AND VARIABLE FREQUENCY DRIVE. GREASE FAN SHAFT AND BEARINGS. VERIFY EXISITNG MOTOR GROUNDING IS ADEQUATE AND INSTALL NEW GROUNDING AS NECESSARY. CONTRACTOR TO PROVIDE OEM REFURBISHMENT BY COORDINATING THE REFURBISHMENT DIRECTLY WITH THE MANUFACTURER'S REPRESENTATIVE. UNIT MANUFACTURER IS MCQUAY (NOW DAIKIN).

# MECHANICAL DEMOLITION PLAN - LEVEL 01 - OVERALL

**JOB** 25241.0000  
**DATE** 12/11/25  
**SHEET**

A-M10-01

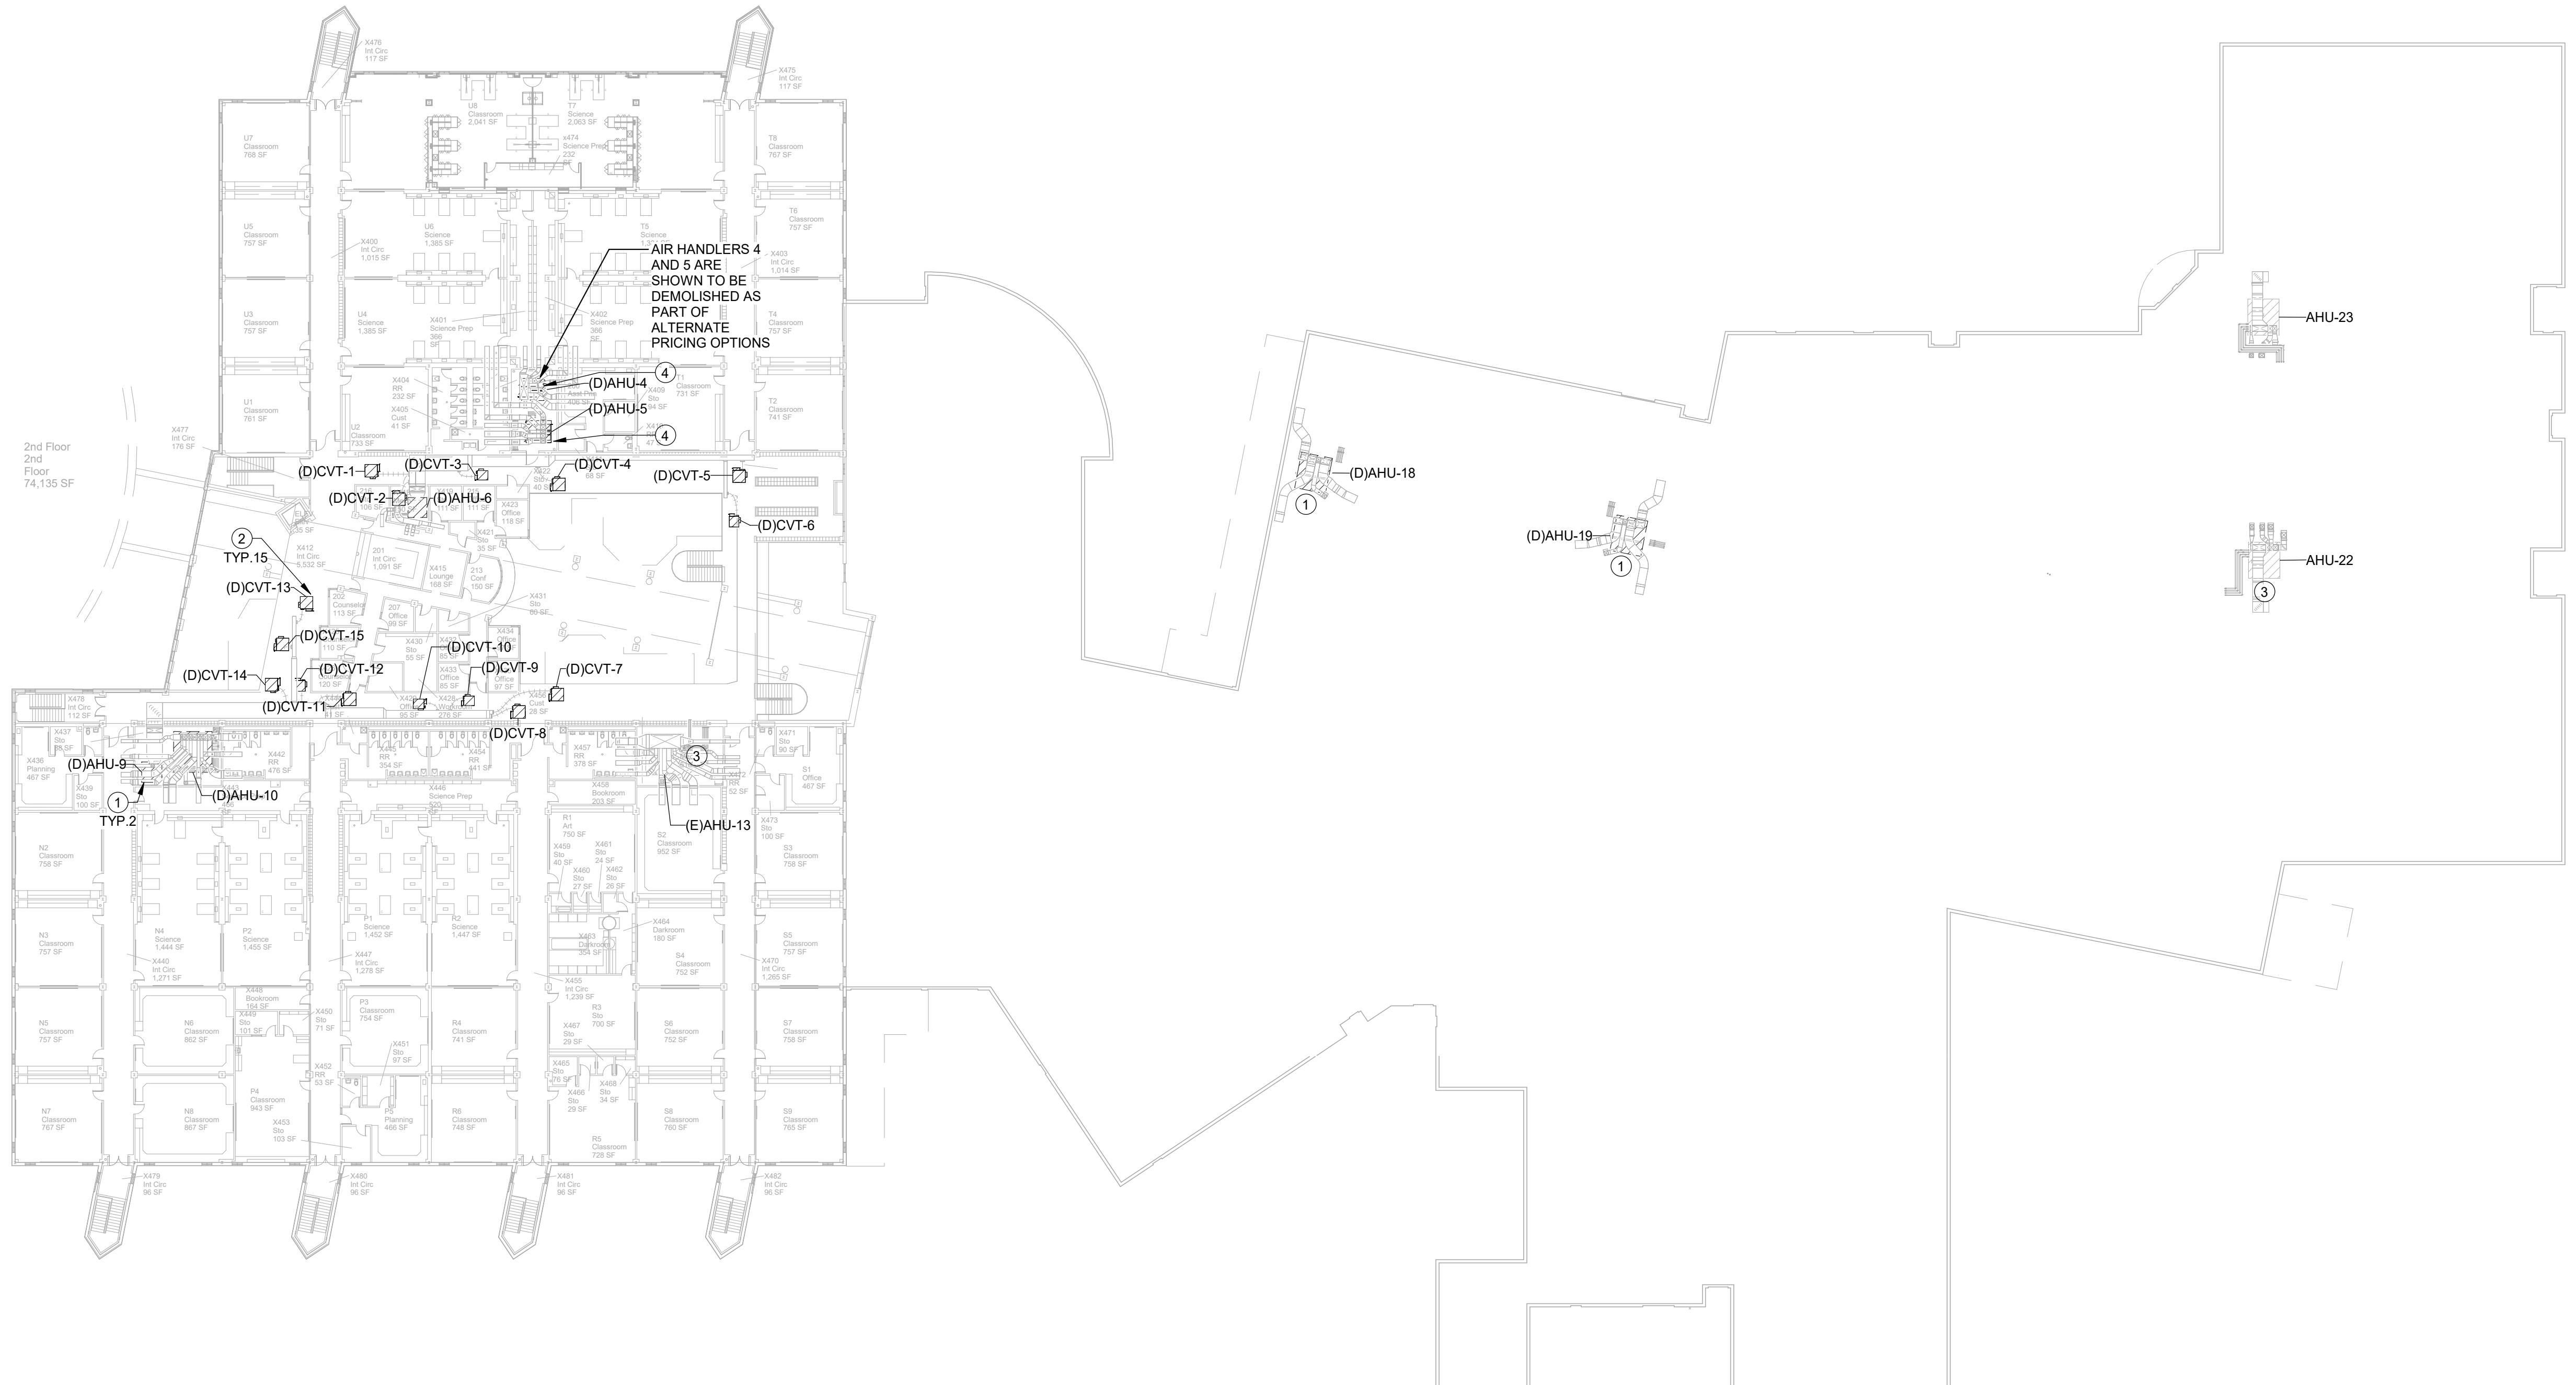

## 1 MECHANICAL DEMOLITION PLAN - LEVEL 02

1/32" = 1'-0"

### DEMOLITION NOTES:

- DEMOLITION INTENT: REMOVE ALL TERMINAL UNITS, AIR HANDLING UNITS, AND PUMPS DESIGNATED FOR REMOVAL. COORDINATE WITH BUILDING OWNER FOR ALL EQUIPMENT TO BE SALVAGED. IF THE OWNER DOES NOT WISH TO RETAIN EQUIPMENT, DISPOSE OF IN A MANNER ACCEPTABLE TO ALL AUTHORITIES HAVING JURISDICTION.
- PRIOR TO WORK, GENERAL AND MECHANICAL CONTRACTORS SHALL OBTAIN CONFIRMATION FROM OWNER BEFORE REMOVING ANY CONDUIT, CIRCUIT, WIRING, PIPING, EQUIPMENT OR CONTROL WIRING WHICH MAY STILL BE IN USE. THE CONTRACTOR SHALL REPLACE ANY ITEM REMOVED DURING THE DEMOLITION PROCESS, WHICH IS INTENDED TO REMAIN, AT NO ADDITIONAL COST TO THE OWNER.
- REMOVE ALL NON-ACTIVE CONTROLS, SUPPORTS, HANGERS, INSULATION, ETC. REMOVE ANY REMAINING REFRIGERANT IN LEGAL AND ENVIRONMENTALLY RESPONSIBLE MANNER, IN ACCORDANCE WITH ALL LAWS AND REGULATIONS.
- CONTRACTOR TO COORDINATE EXTENT OF DEMOLITION WITH ALL NEW WORK INTENT.
- DEMOLITION AND NEW CONSTRUCTION ACTIVITIES SHALL IN NO WAY DISRUPT ONGOING OPERATIONS. TEMPORARY SHUTDOWN SCHEDULES MUST BE APPROVED, IN ADVANCE, BY THE CONSTRUCTION MANAGER AND THE CLIENT REPRESENTATIVE.
- CONTRACTOR SHALL MAINTAIN A CLEAN JOBSITE AT ALL TIMES.

### MECHANICAL KEYED NOTES

- DEMOLISH EXISTING CENTRAL STATION AIR-HANDLING UNITS AND DISCONNECT ASSOCIATED PIPING AND DUCTWORK CONNECTIONS. CONTRACTOR TO DEMOLISH DUCTWORK JUST BEYOND EXISTING FLEX CONNECTORS AND PIPING BACK TO ISOLATION VALVE IN MECHANICAL ROOM. IF NO ISOLATION VALVE EXISTS, THEN CONTRACTOR IS TO PROVIDE PROVISIONS TO FREEZE TAP NEW SUPPLY AND RETURN CHW AND HW ISOLATION VALVES. THE LIMITS OF DEMOLITION ARE TO ENSURE NEW UNIT CAN BE INSTALLED.
- REMOVE AND DEMOLISH EXISTING TERMINAL UNIT. DEMOLISH FLEX CONNECTIONS, COILS AND ASSOCIATED PIPING, ASSOCIATED CONTROLS, ACTUATORS, AND SENSORS. REMOVE AND CONNECTION FOR INSTALLATION OF NEW TERMINAL UNIT. CONTRACTOR TO REMOVE AND RELOCATE EXISTING CONTROLS, ACTUATORS, AND SENSORS. CONTRACTOR IS TO PROVIDE SEQUENCED INFORMATION, INCLUDING BUT NOT LIMITED TO SEQUENCE OF OPERATIONS, ETC. PRIOR TO ANY DEMOLITION OF EQUIPMENT. CONTRACTOR TO REMOVE PROTECT AND REINSTALL ANY CEILING GRID AND TILE NECESSARY TO PROPERLY DEMOLISH EXISTING TERMINAL UNIT AND MAKE READY FOR NEW TERMINAL UNIT INSTALLATION.
- REFURBISH THE AIR HANDLING UNIT WITH THE FOLLOWING: THOROUGHLY CLEAN THE ENTIRE UNIT FROM THE INSIDE OUT, INCLUDING THE FAN WHEEL, CHILLED WATER AND HEATING WATER COILS, PROVIDE NEW FILTERS, MOTORIZED DAMPERS, ACTUATORS, FAN BELTS AND VARIABLE FREQUENCY DRIVE, GREASE FAN SHAFT AND BEARINGS. VERIFY EXISTING MOTOR GROUNDING IS ADEQUATE AND INSTALL NEW GROUNDING AS NECESSARY. CONTRACTOR TO PROVIDE OEM REFURBISHMENT BY COORDINATING THE REFURBISHMENT DIRECTLY WITH THE MANUFACTURER'S REPRESENTATIVE. UNIT MANUFACTURER IS MCQUAY (NOW DAKIN).
- CONTRACTOR TO INCLUDE REFURBISHMENT SCOPE FOR THIS AIR HANDLING UNIT UNDER BASE SCOPE. AS PART OF THE ALTERNATE SCOPE, REMOVE REFURBISHMENT OF THE UNIT AND INCLUDE FULL REPLACEMENT PER REPLACEMENT KEYED NOTES, AND EQUIPMENT SCHEDULE ON SHEET A-M30-00.

ISSUES	
1	07.18.2025 DESIGN DEVELOPMENT
2	09.29.2025 50% CONSTRUCTION DOCUMENTS
3	11.11.2025 90% CONSTRUCTION DOCUMENTS
4	12.11.2025 100% CONSTRUCTION DOCUMENTS


### REVISIONS



Date of issue:  
01.23.2026

## FORT BEND ISD - BP048 HVAC MEP WEST ZONE 3 STEPHEN F. AUSTIN HS

3434 Pheasant Creek Dr.  
Sugar Land, TX 77498

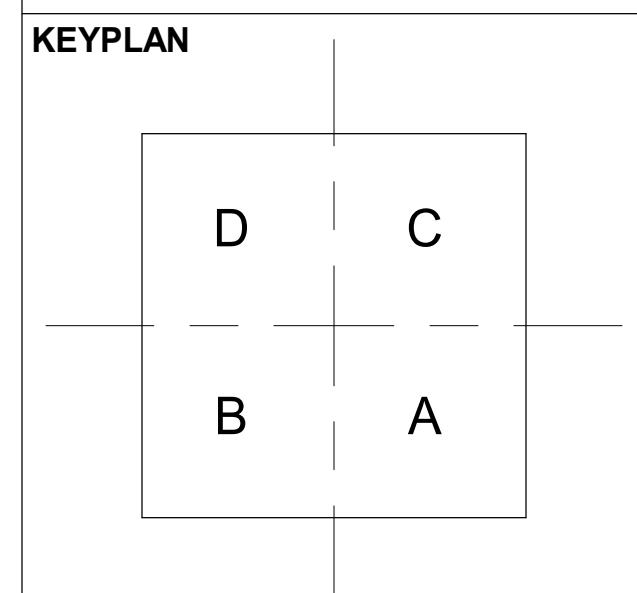

### MECHANICAL DEMOLITION PLAN - LEVEL 02 - OVERALL

JOB 25241.0000  
DATE 12/11/25  
SHEET

A-M10-02

SCOPE NOTE:  
REFER TO ATTACHMENTS FOR EXISTING CONDITIONS REGARDING LOCATIONS OF EQUIPMENT, EXTENTS OF DUCTWORK / PIPING, AND ADDITIONAL INFORMATION.

ISSUES	
1	07.18.2025 DESIGN DEVELOPMENT
2	09.29.2025 50% CONSTRUCTION DOCUMENTS
3	11.11.2025 90% CONSTRUCTION DOCUMENTS
4	12.11.2025 100% CONSTRUCTION DOCUMENTS

REVISIONS	
1	01/23/2026 ADDENDUM #2



KOURISH, M.A.Z.D.P.  
LICEN  
01/23/2026

Date of issue:  
01.23.2026

# FORT BEND ISD - BP048 HVAC MEP WEST ZONE 3 STEPHEN F. AUSTIN HS

3434 Pheasant Creek Dr.  
Sugar Land, TX 77498



## 1 MECHANICAL PLAN - LEVEL 01

1/32" = 1'-0"


CONTROLS AT THIS CAMPUS IS BY UNIFY CONTROLS  
CONTRACTOR TO CONTACT AND COORDINATE WITH  
UNIFY CONTROLS FOR UPDATES.

### MECHANICAL GENERAL NOTES:

- REFER TO MECHANICAL COVER SHEET FOR SYMBOLS, ABBREVIATIONS, AND ADDITIONAL INFORMATION.
- REFER TO MECHANICAL SCHEDULES AND DETAIL DRAWINGS FOR ADDITIONAL INFORMATION.
- MAINTAIN MANUFACTURER'S RECOMMENDED SERVICE CLEARANCE FOR NEW AND EXISTING MECHANICAL EQUIPMENT.
- THE CONTRACTOR SHALL VERIFY ALL EXISTING AND NEW MECHANICAL EQUIPMENT ARE MOUNTED SO THAT ALL REQUIRED CLEARANCES ARE MAINTAINED AT THE BOTTOM AND SIDES OF EACH UNIT FOR PROPER SERVICING, MAINTENANCE AND CODE CLEARANCES PRIOR TO FINAL PLACEMENT AND INSTALLATION OF NEW AIR HANDLING UNIT. COORDINATE COMPLETELY WITH ALL NEW WALLS TO STRUCTURE, AND RELOCATE AS REQUIRED TO MAINTAIN PROPER CLEARANCES. ADJUST DUCTWORK CONNECTIONS AS NECESSARY.
- CONTRACTOR SHALL FIELD VERIFY ACTUAL LOCATIONS OF ALL EQUIPMENT, DUCTWORK, & PIPING PRIOR TO SUBMITTING A BID. COORDINATE COMPLETELY WITH ALL OTHER TRADES. RELOCATE TERMINAL UNITS AND PROVIDE ADDITIONAL DUCTWORK, OFFSETS, FITTINGS, ETC. AS REQUIRED.
- PRIOR TO ANY CONSTRUCTION THE MECHANICAL CONTRACTOR SHALL RECORD THE AIR QUANTITY FOR EACH EXISTING AIR DEVICE IN THE ADJACENT SPACES AND RESTROOMS CONNECTED TO COMMON EQUIPMENT. AFTER THE COMPLETION OF THE RENOVATION WORK, MECHANICAL CONTRACTOR SHALL USE THE SAME BALANCING EQUIPMENT TO REBALANCE ALL EXISTING AIR DEVICES TO THE ORIGINAL AIR QUANTITIES.
- DUUE TO DRAWING SCALE, IT IS NOT POSSIBLE TO INDICATE ALL OFFSETS, FITTINGS AND ACCESSORIES WHICH MAY BE REQUIRED. THE CONTRACTOR SHALL EXAMINE FIELD CONDITIONS AND FURNISH THE NECESSARY FITTINGS WHICH MAY BE REQUIRED TO COMPLETE THE INSTALLATION. CONTRACTOR SHALL FURNISH AND INSTALL BALANCING DAMPERS IN HVAC SYSTEMS THAT HAVE MORE THAN ONE INLET/OUTLET UNLESS NOTED OTHERWISE. BALANCING DAMPERS SHALL APPLY TO NEW AND EXISTING DUCTWORK.
- URING CONSTRUCTION, SEAL ALL OPEN DUCTS WITH PLASTIC TO PREVENT DUST/DIRT. CLEAN ALL INTERIOR DUCT SPACES PRIOR TO DUCT INSTALLATION. ALL VAV TERMINAL UNIT FILTERS SHALL BE MAINTAINED DURING CONSTRUCTION AND REPLACED AT THE END OF CONSTRUCTION. PROVIDE CONSTRUCTION FILTERS OVER AIR HANDLING UNIT INTAKES AND MAINTAIN FILTER MEDIA DURING CONSTRUCTION. REPLACE ALL FILTERS AT END OF CONSTRUCTION. REMOVE UPON COMPLETION.

### MECHANICAL KEYED NOTES

- PROVIDE NEW CENTRAL STATION AIR-HANDLING UNITS PER MECHANICAL SCHEDULES. CONTRACTOR TO PROVIDE NEW DUCTWORK CONNECTIONS AND PIPING CONNECTS PER MECHANICAL DETAILS. CONTROLS CONTRACTOR TO PROVIDE NEW DDC CONTROLS, INCLUDING NEW CONTROL VALVES, ACTUATORS, AUTOMATIC DAMPERS, CONTROLLERS, CONTROL PANELS, PROGRAMMING AND UPGRADED FRONT-END GRAPHICS. CONTROLS CONTRACTOR TO COORDINATE WITH DDC SYSTEM MANUFACTURER TO ENSURE THAT ALL NEW CONTROLS ARE ACCORDING TO THE DDC SYSTEM. NEW CONTROLS ARE INSERTED INTO UPDATED CONTROLS SYSTEM. MODIFY EXISTING SUPPORTS AS REQUIRED TO ACCOMMODATE NEW AIR HANDLER. EXTEND EXISTING ACCESS/SERVICE CATWALKS TO ALL SIDES OF UNIT REQUIRING ACCESS. PROVIDE DELEGATED DESIGN AS REQUIRED.
- NEW FAN POWERED TERMINAL UNIT. REFER TO SCHEDULE ON SHEET M30-00 AND DETAILS ON SHEET M40-00. CONTRACTOR TO INSTALL NEW FLEX CONNECT DUCTWORK BETWEEN NEW TERMINAL UNIT AND EXISTING DUCTWORK. PROVIDE AND INSTALL NEW HOT WATER COIL PIPING AND CONNECTION, INCLUDING A 3/4" CONTROL BALL VALVE. CONTRACTOR TO COORDINATE WITH DDC SYSTEM MANUFACTURER TO ENSURE THAT ALL NEW CONTROLS ARE ACCORDING TO THE DDC SYSTEM. MODIFY EXISTING SUPPORTS AS REQUIRED TO ACCOMMODATE NEW AIR HANDLER. EXTEND EXISTING ACCESS/SERVICE CATWALKS TO ALL SIDES OF UNIT REQUIRING ACCESS. PROVIDE DELEGATED DESIGN AS REQUIRED.
- LOCATE TERMINAL UNIT CONTROLLER IN PLenum, OR IN NEARBY MECHANICAL ROOM WITH NEW AHU CONTROLS. COORDINATE WITH CONTROLS CONTRACTOR.
- CONTRACTOR TO PROVIDE NEW HOT WATER PUMP TYING INTO EXISTING PIPING TO REMAIN. PROVIDE ALL NEW GAUGES, VALVES, AND ASSOCIATED APPURTENANCES, ETC PER DETAIL. MECHANICAL CONTRACTOR SHALL PROVIDE NEW VFD - ELECTRICAL CONTRACTOR TO INSTALL THE VFD. CONTRACTOR TO COORDINATE ALL PIPING CONNECTIONS TO ENSURE NO UNNECESSARY TURNS ARE CREATED WHICH WOULD POTENTIALLY CREATE AN ISSUE WITH CONTROLS, GAUGES, VALVES, ETC. TO BE INSTALLED IN THE PIPING. SEE DETAIL ON SHEET A-M04-00. REFER TO SCHEDULE SHEET FOR ADDITIONAL INFORMATION.

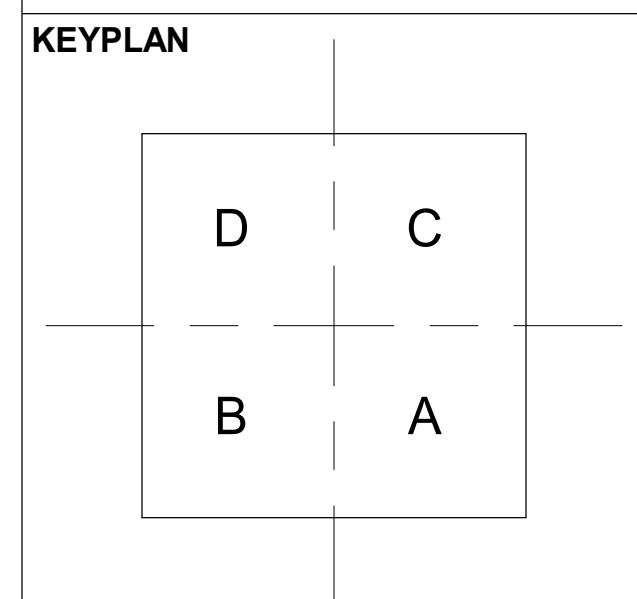

### MECHANICAL PLAN - LEVEL 01 - OVERALL

JOB 25241.0000  
DATE 12/11/25  
SHEET

Y squared  
ENGINEERING  
2508 Rapport Place  
Houston, Texas 77008  
346-341-2168  
www.y-squared.com  
TX Firm No. 22107  
Project No. 25027.00

A-M20-01

**SCOPE NOTE:**  
REFER TO ATTACHMENTS FOR EXISTING CONDITIONS REGARDING LOCATIONS OF EQUIPMENT, EXTENTS OF DUCTWORK / PIPING, AND ADDITIONAL INFORMATION.

<b>ISSUES</b>		
1	07.18.2025	DESIGN DEVELOPMENT
2	09.29.2025	50% CONSTRUCTION DOCUMENTS
3	11.11.2025	90% CONSTRUCTION DOCUMENTS
4	12.11.2025	100% CONSTRUCTION DOCUMENTS

	<b>REVISIONS</b>	
1	01/23/2026	ADDENDUM #2



Date of issue:  
01.23.2026

**FORT BEND ISD - BP048  
HVAC MEP WEST ZONE 3  
STEPHEN F. AUSTIN HS  
3434 Pheasant Creek Dr**

# 1 MECHANICAL PLAN - LEVEL 02

1/32" = 1'-0"

## MECHANICAL GENERAL NOTE


1. REFER TO MECHANICAL COVER SHEET FOR SYMBOLS, ABBREVIATIONS, AND ADDITIONAL INFORMATION.
2. REFER TO MECHANICAL SCHEDULES AND DETAIL DRAWINGS FOR ADDITIONAL INFORMATION.
3. MAINTAIN MANUFACTURER'S RECOMMENDED SERVICE CLEARANCE FOR NEW AND EXISTING MECHANICAL EQUIPMENT.
4. THE CONTRACTOR SHALL VERIFY ALL EXISTING AND NEW MECHANICAL EQUIPMENT ARE MOUNTED SO THAT ALL REQUIRED CLEARANCES ARE MAINTAINED AT THE BOTTOM AND SIDES OF EACH UNIT FOR PROPER SERVICING, MAINTENANCE AND CODE CLEARANCES PRIOR TO FINAL PLACEMENT AND INSTALLATION OF NEW AIR HANDLING UNIT. COORDINATE COMPLETELY WITH ALL NEW WALLS TO STRUCTURE, AND RELOCATE AS REQUIRED TO MAINTAIN PROPER CLEARANCES. ADJUST DUCTWORK CONNECTIONS AS NECESSARY.
5. CONTRACTOR SHALL FIELD VERIFY ACTUAL LOCATIONS OF ALL EQUIPMENT, DUCTWORK, & PIPING PRIOR TO SUBMITTING A BID. COORDINATE COMPLETELY WITH ALL OTHER TRADES. RELOCATE TERMINAL UNITS AND PROVIDE ADDITIONAL DUCTWORK, OFFSETS, FITTINGS, ETC. AS REQUIRED.
6. PRIOR TO ANY CONSTRUCTION THE MECHANICAL CONTRACTOR SHALL RECORD THE AIR QUANTITY FOR EACH EXISTING AIR DEVICE IN THE ADJACENT SPACES AND RESTROOMS CONNECTED TO COMMON EQUIPMENT. AFTER THE COMPLETION OF THE RENOVATION WORK, MECHANICAL CONTRACTOR SHALL USE THE SAME BALANCING EQUIPMENT TO REBALANCE ALL EXISTING AIR DEVICES TO THE ORIGINAL AIR QUANTITIES.
7. DUE TO DRAWING SCALE, IT IS NOT POSSIBLE TO INDICATE ALL OFFSETS, FITTINGS AND ACCESSORIES WHICH MAY BE REQUIRED. THE CONTRACTOR SHALL EXAMINE FIELD CONDITIONS AND FURNISH THE NECESSARY FITTINGS WHICH MAY BE REQUIRED TO COMPLETE THE INSTALLATION. CONTRACTOR SHALL FURNISH AND INSTALL BALANCING DAMPERS IN HVAC SYSTEMS THAT HAVE MORE THAN ONE INLET/OUTLET UNLESS NOTED OTHERWISE. BALANCING DAMPERS SHALL APPLY TO NEW AND EXISTING DUCTWORK.
8. DURING CONSTRUCTION, SEAL ALL OPEN DUCTS WITH PLASTIC TO PREVENT DUST/DIRT. CLEAN ALL INTERIOR DUCT SURFACES PRIOR TO DUCT INSTALLATION. ALL VAV TERMINAL UNIT FILTERS SHALL BE MAINTAINED DURING CONSTRUCTION AND REPLACED AT THE END OF CONSTRUCTION. PROVIDE CONSTRUCTION FILTERS OVER AIR HANDLING UNIT INTAKES AND MAINTAIN FILTER MEDIA DURING CONSTRUCTION. REPLACE ALL FILTERS AT END OF CONSTRUCTION. REMOVE UPON COMPLETION.

## ⑧ MECHANICAL KEYED NOTES

1. PROVIDE NEW CENTRAL STATION AIR-HANDLING UNITS PER MECHANICAL SCHEDULES. CONTRACTOR TO PROVIDE NEW DUCTWORK CONNECTIONS AND PIPING CONNECTS PER MECHANICAL DETAILS. CONTROLS CONTRACTOR TO PROVIDE NEW DDC CONTROLS, INCLUDING NEW CONTROL VALVES, ACTUATORS, AUTOMATIC DAMPERS, CONTROLLERS, CONTROL PANELS, PROGRAMMING AND UPGRADED FRONT END GRAPHICS. CONTROLS CONTRACTOR TO COORDINATE WITH DISTRICT ENERGY MANAGER TO ENSURE THE LATEST CONTROLS SEQUENCE OF OPERATIONS FOR THE NEW AHUS ARE INSERTED INTO UPDATED CONTROLS SYSTEM. MODIFY EXISTING SUPPORTS AS REQUIRED TO ACCOMMODATE NEW AIR HANDLER. EXTEND EXISTING ACCESS/SERVICE CATWALKS TO ALL SIDES OF UNIT REQUIRING ACCESS. PROVIDE DELEGATED DESIGN AS REQUIRED.
2. NEW FAN POWERED TERMINAL UNIT, REFER TO SCHEDULE ON SHEET M30-00 AND DETAILS ON SHEET M40-00. CONTRACTOR TO INSTALL NEW FLEX CONNECT DUCTWORK BETWEEN NEW TERMINAL UNIT AND EXISTING DUCTWORK. PROVIDE AND INSTALL NEW HOT WATER COIL PIPING AND CONNECTION, INCLUDING A 3/4" CONTROL BALL VALVE, ACTUATOR AND AIR TEMPERATURE SENSORS AND HUMIDISTATS FOR EACH ZONE. CONTROLS CONTRACTOR TO CONNECT NEW CONTROLS TO EXISITNG CONTROLS SYSTEM WHERE NECESSARY. REUSE EXISTING SEQUENCE OF OPERATION FOR FAN POWERED TERMINAL UNIT. COORDINATE WITH DISTRICT ENERGY MANAGER FOR ANY UPDATED SEQUENCE.
3. LOCATE TERMINAL UNIT CONTROLLER IN PLENUM, OR IN NEARBY MECHANICAL ROOM WITH NEW AHU CONTROLS. COORDINATE WITH CONTROLS CONTRACTOR.






CONTROLS AT THIS CAMPUS IS BY UNIFY CONTROLS.  
CONTRACTOR TO CONTACT AND COORDINATE WITH  
UNIFY CONTROLS FOR UPGRADES.

## KEYPLAN

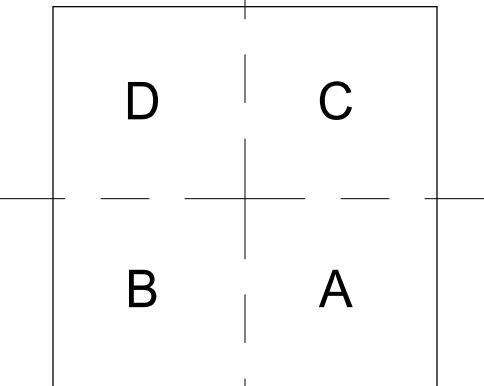


# MECHANICAL PLAN - LEVEL 02 - OVERALL

**JOB** 25241.0000  
**DATE** 12/11/25  
**SHEET**

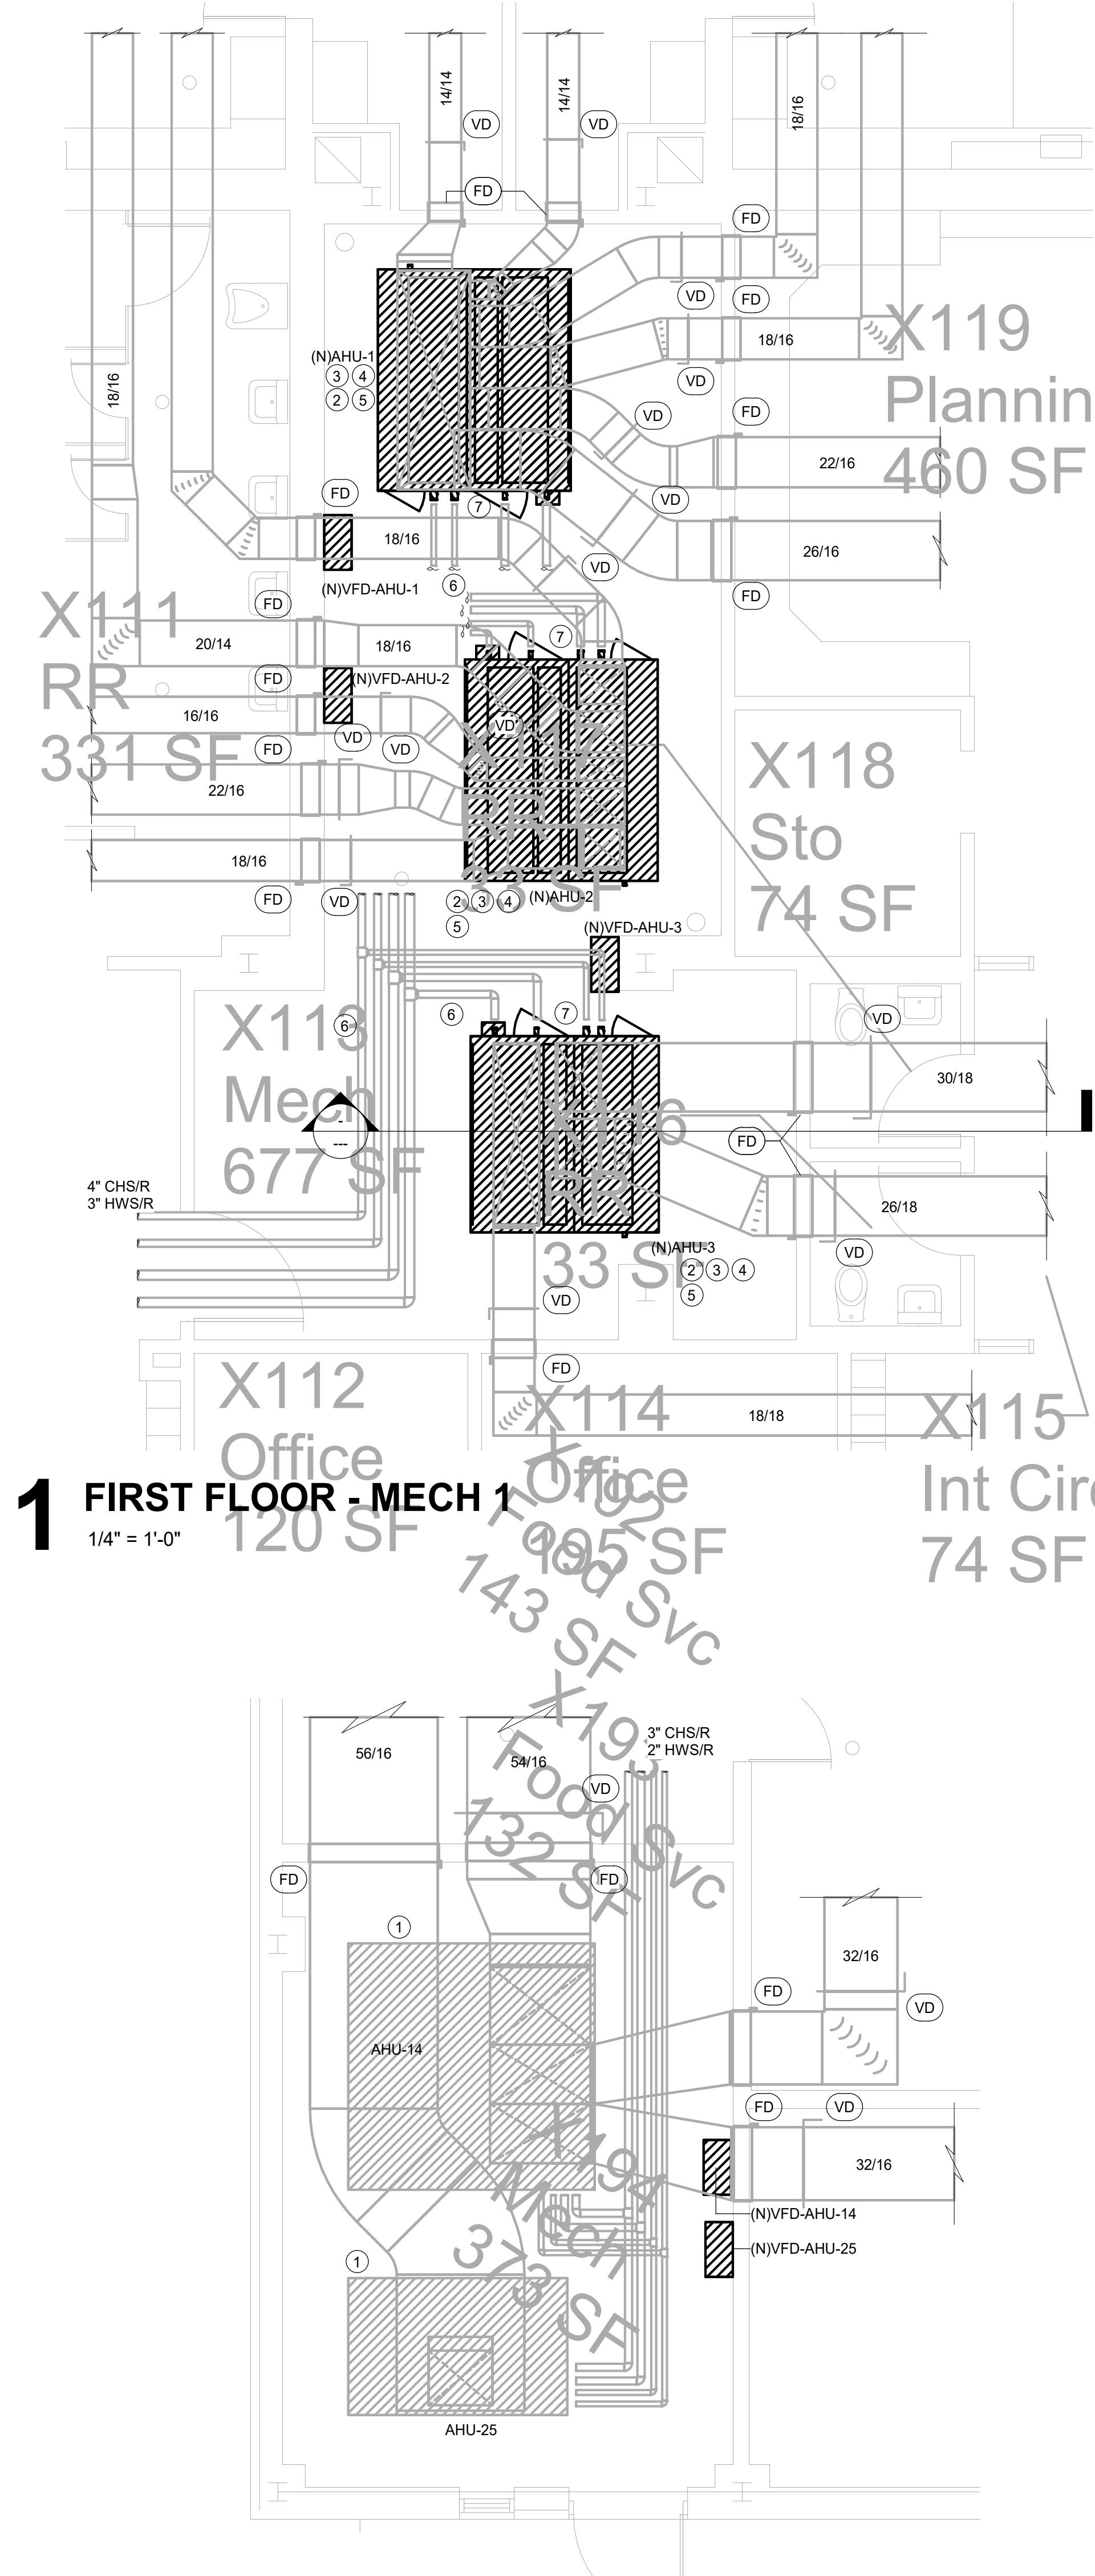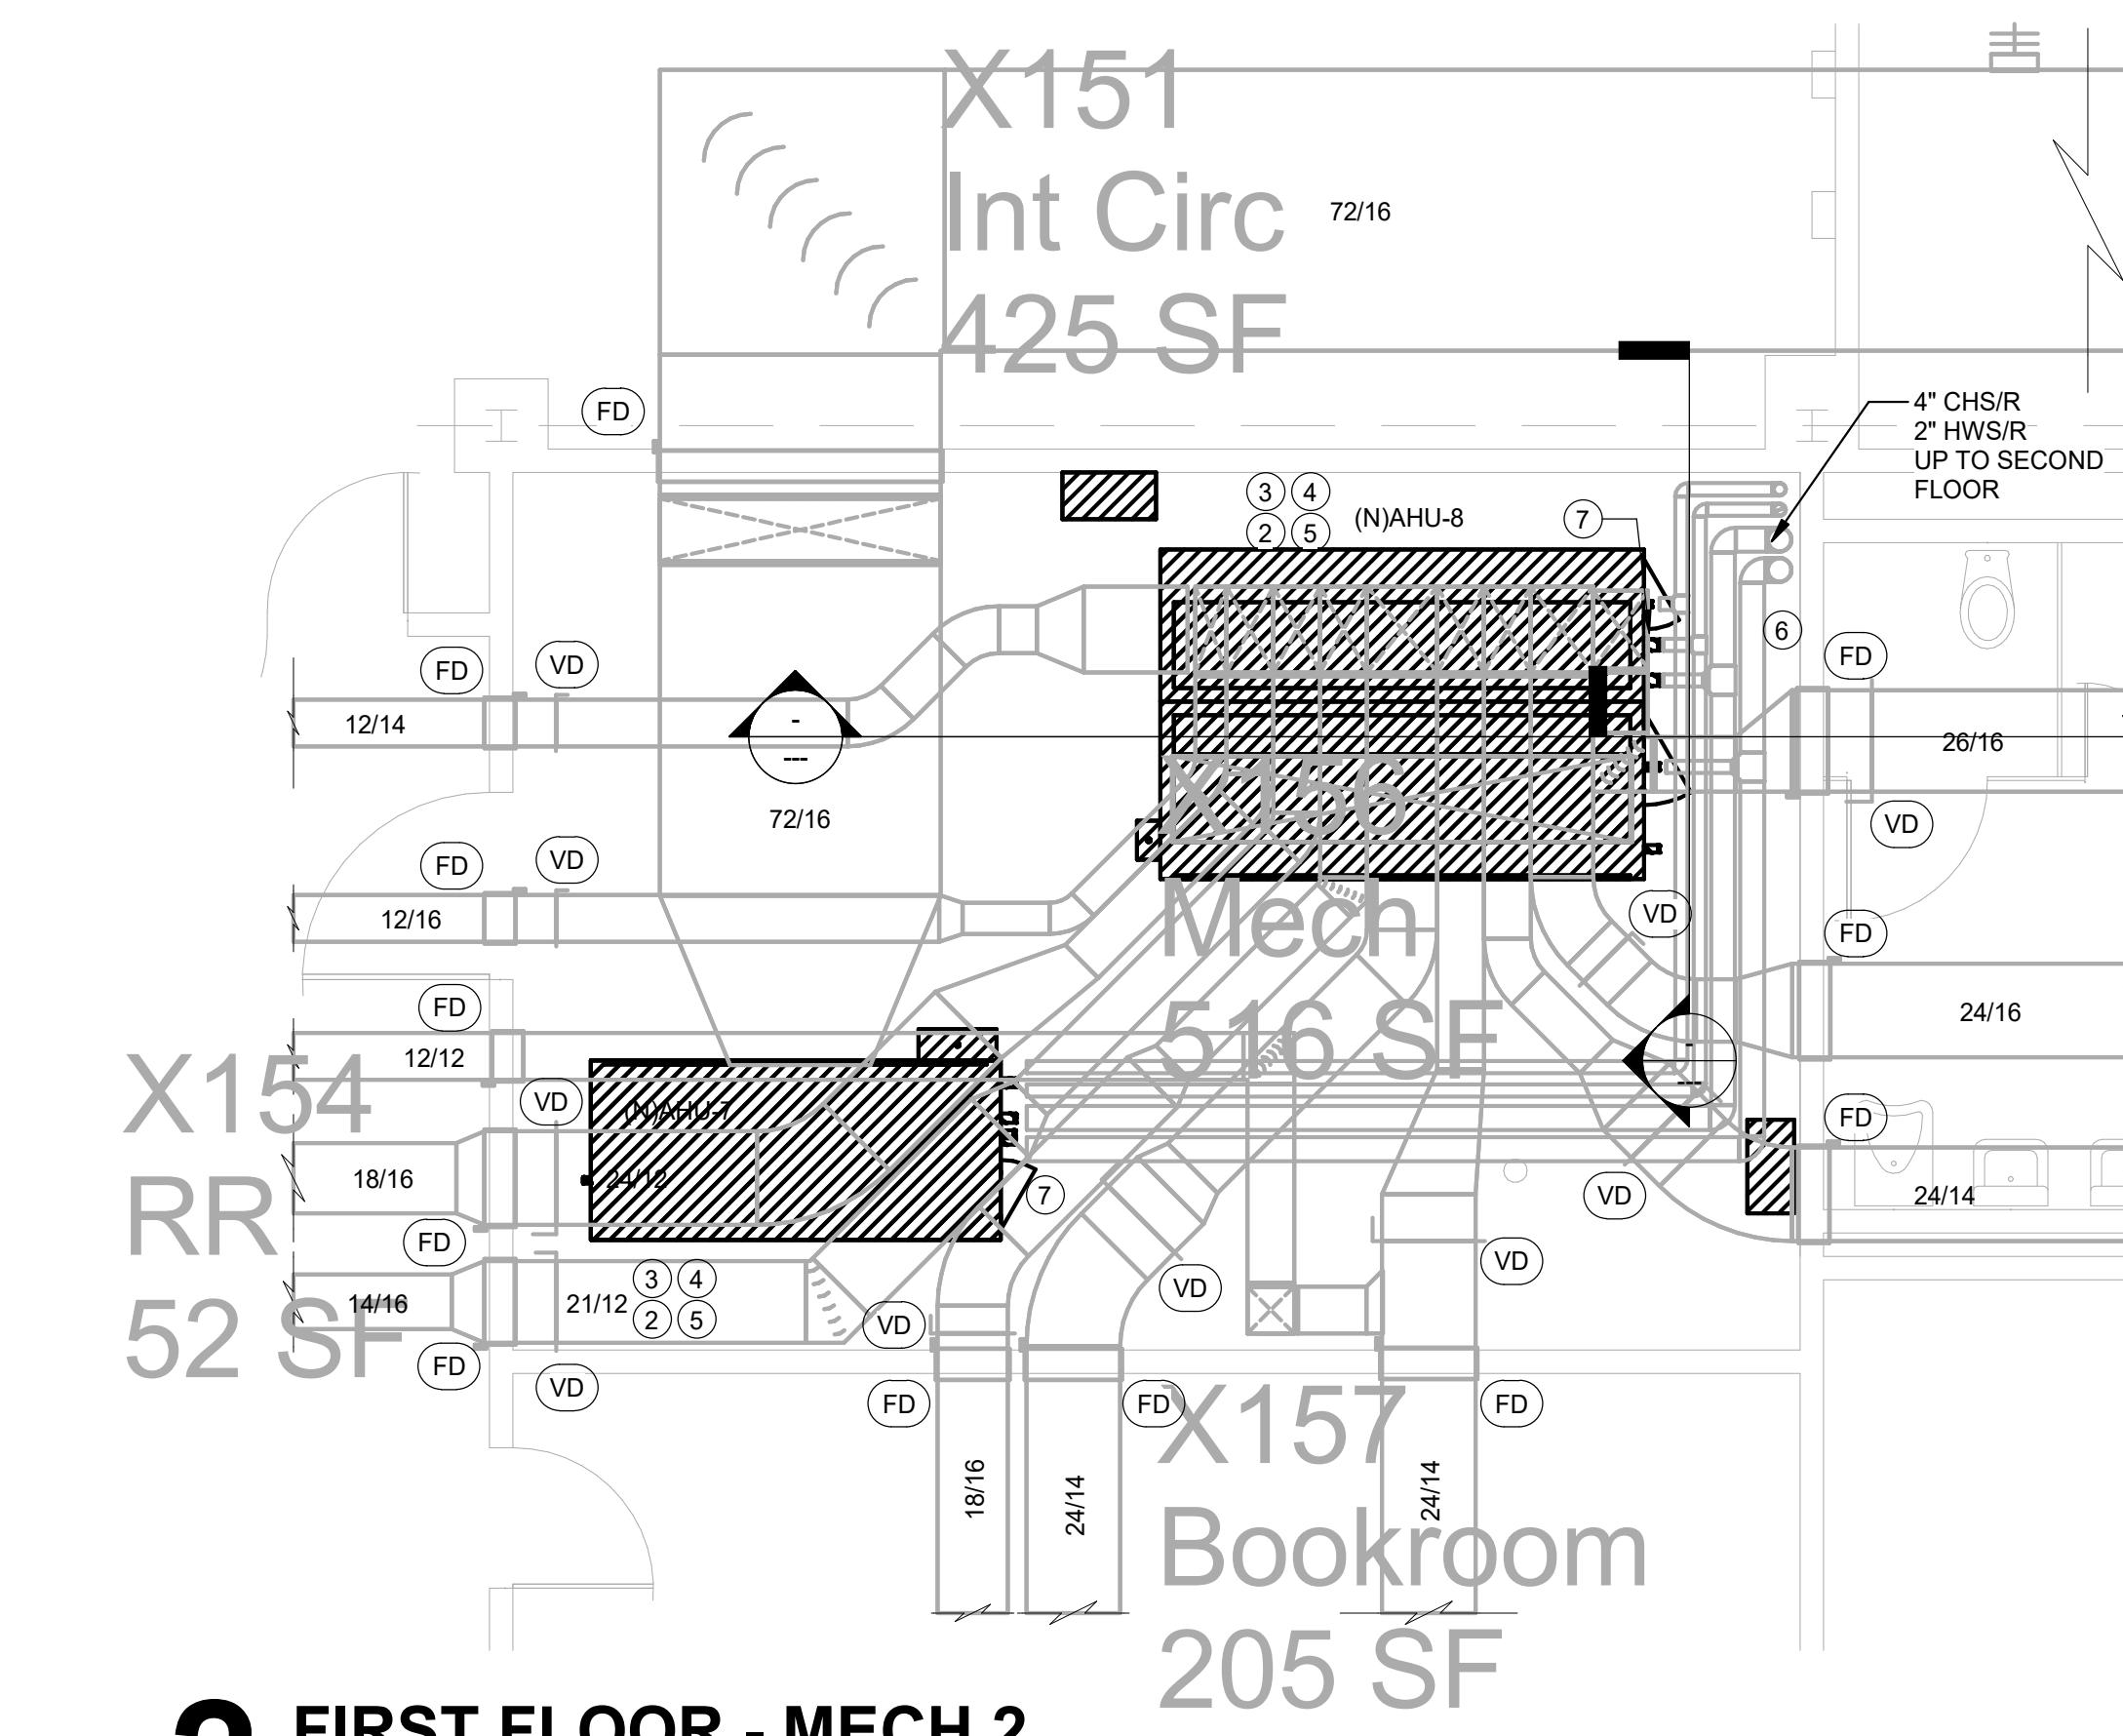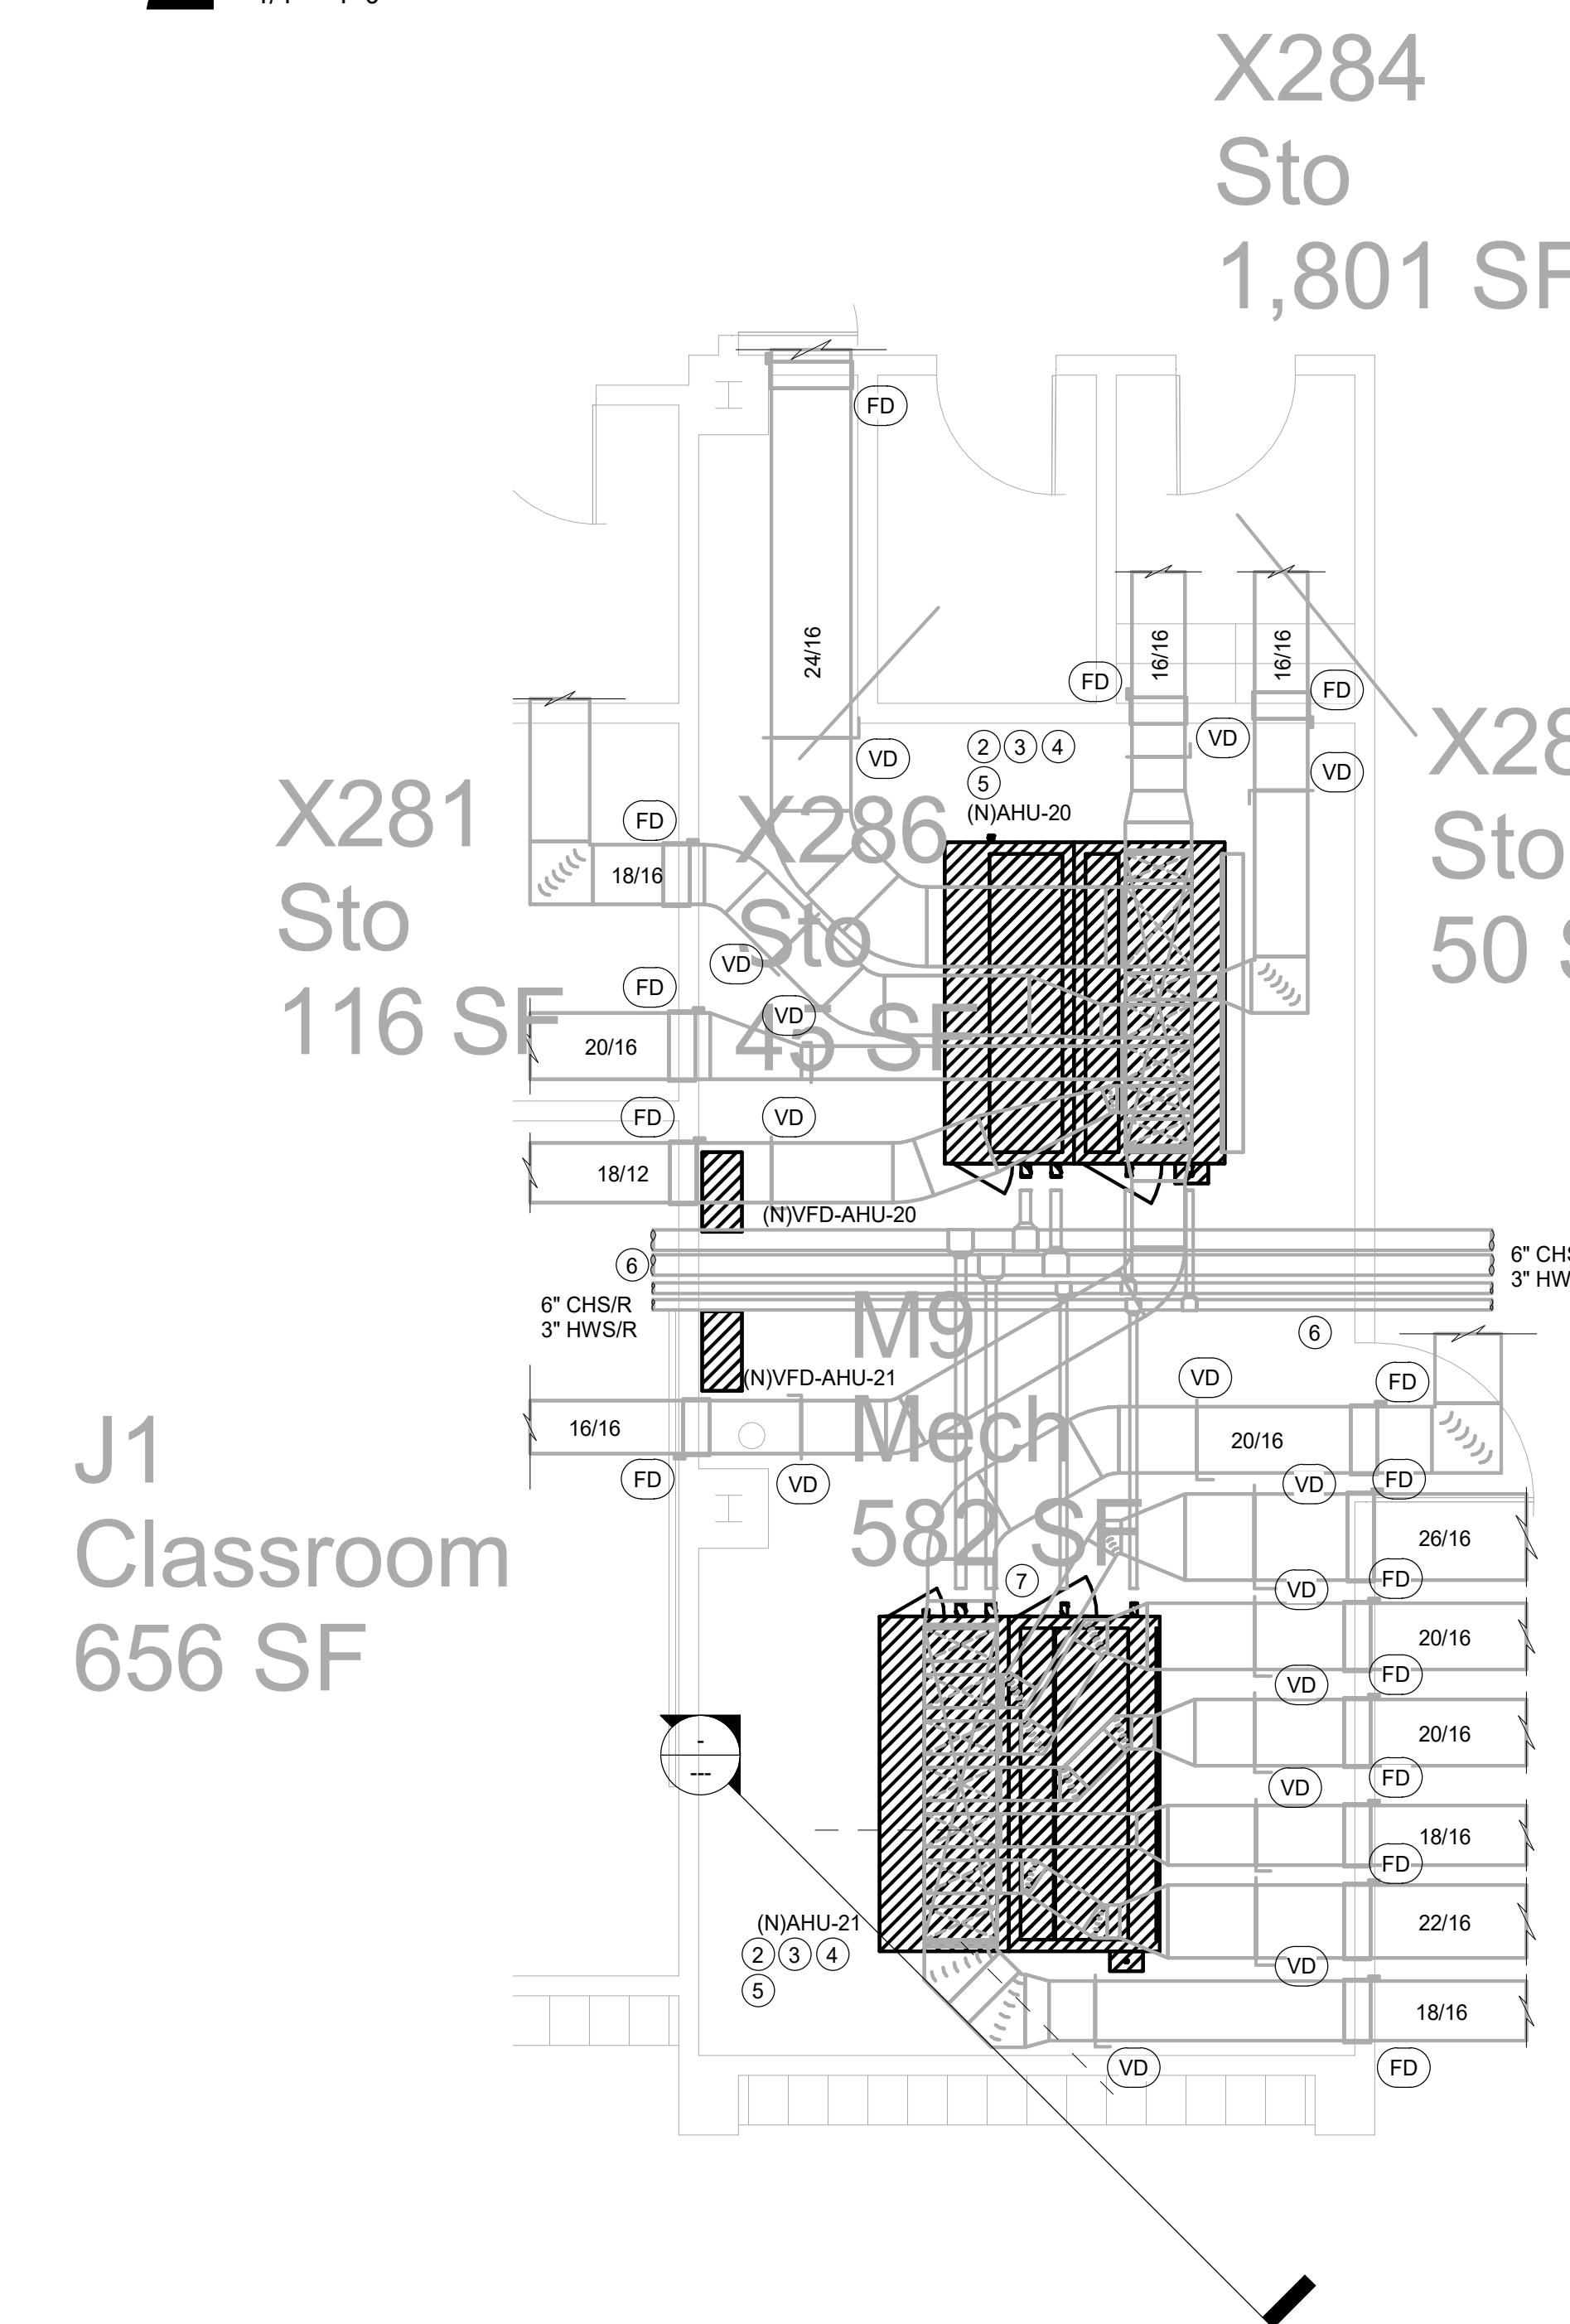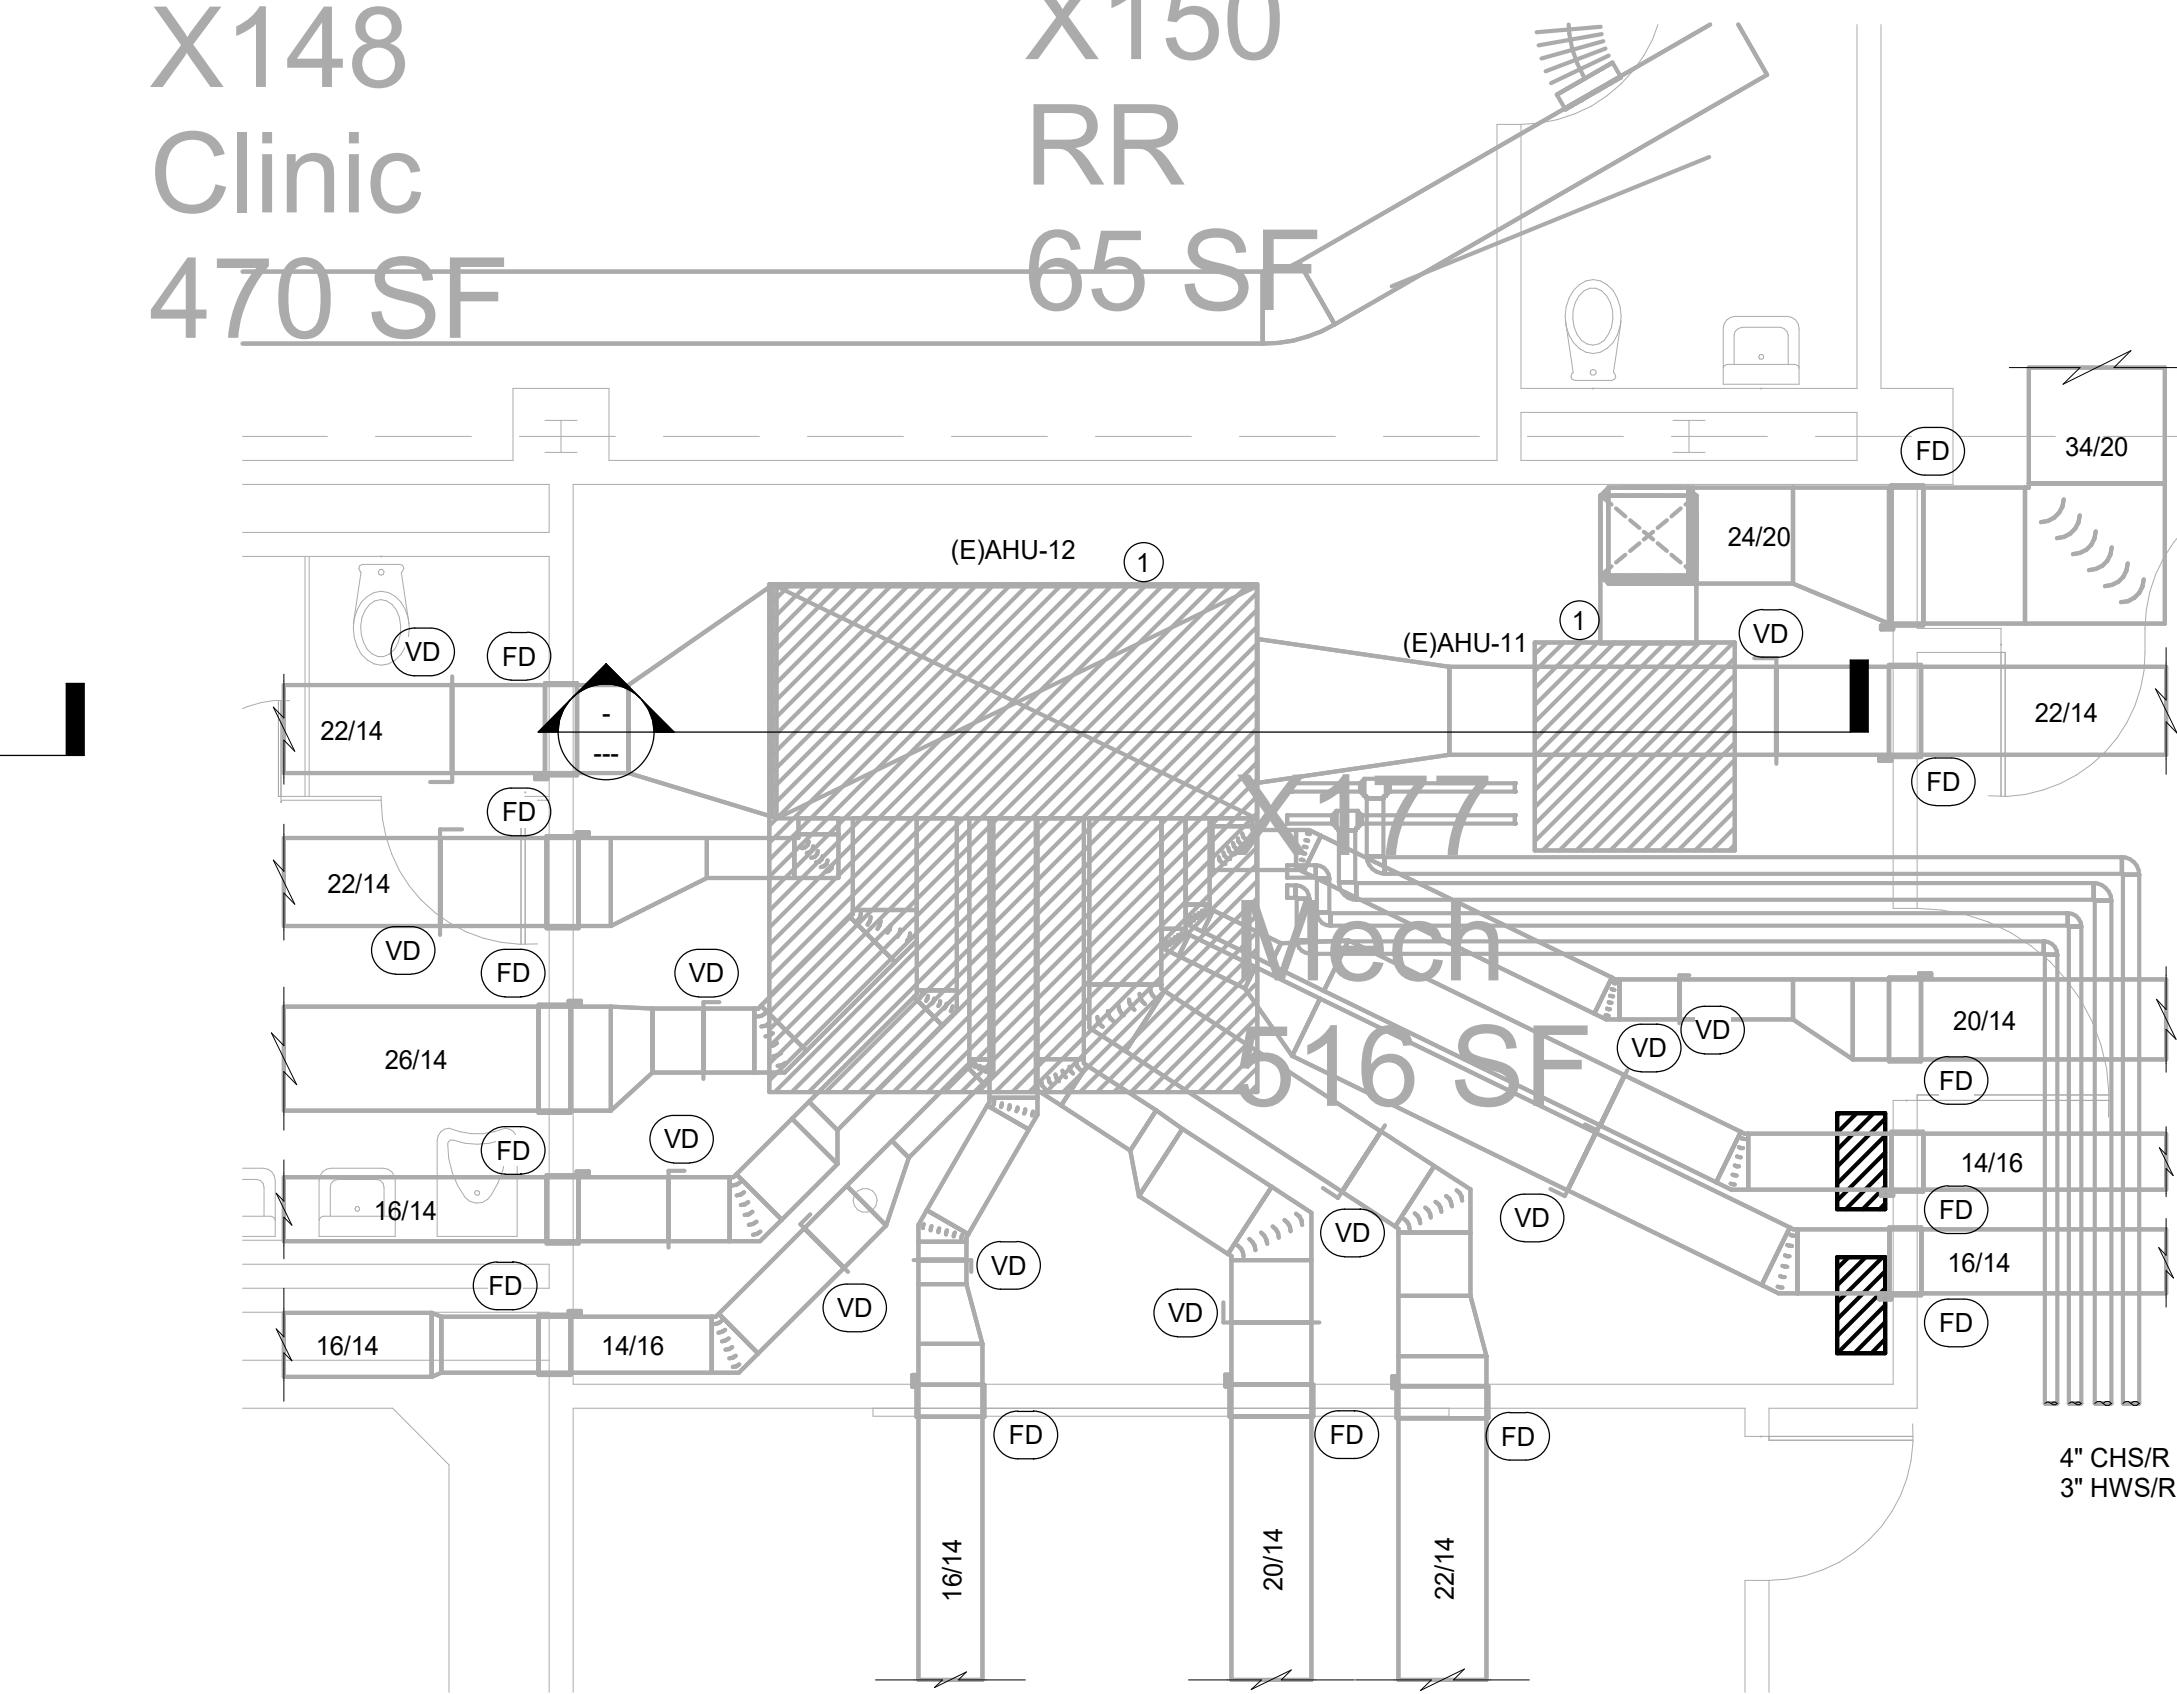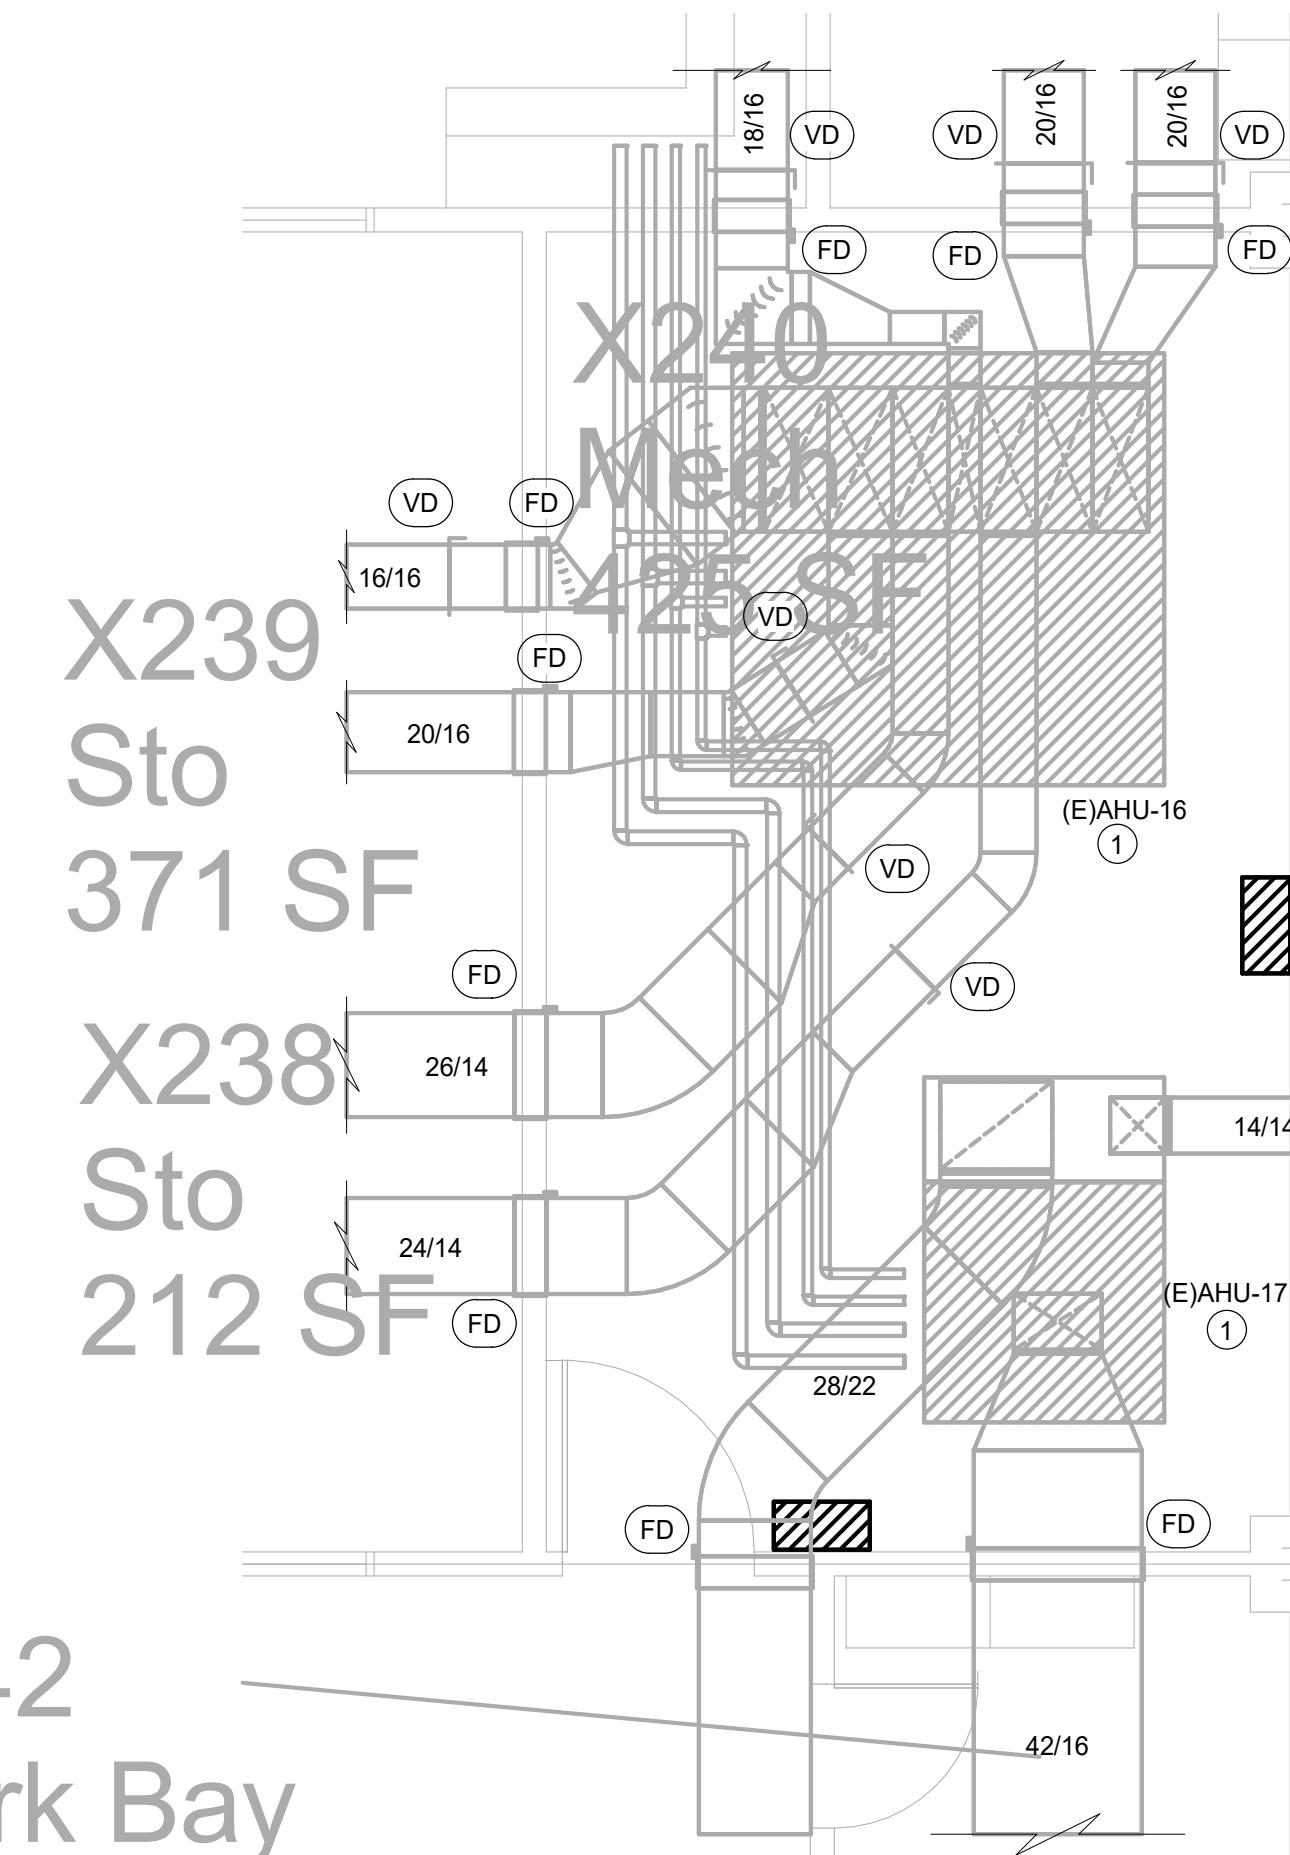Science Prep  
366  
SF4 FIRST FLOOR - MECH 4  
1/4" = 1'-0"2 FIRST FLOOR - MECH 2  
1/4" = 1'-0"5 FIRST FLOOR - MECH 5  
1/4" = 1'-0"3 FIRST FLOOR - MECH 3  
1/4" = 1'-0"

## MECHANICAL KEYED NOTES

- REFURBISH THE AIR HANDLING UNIT WITH THE FOLLOWING. THOROUGHLY CLEAN THE ENTIRE UNIT FROM INSIDE OUT, INCLUDING THE FAN WHEEL, OIL FILLED WATER AND HEATING WATER COILS. PROVIDE NEW FILTERS, MOTORIZED DAMPERS, ACTUATORS, FAN BELTS, GREASE FAN SHAFT AND BEARINGS. VERIFY EXISTING MOTOR GROUNDING IS ADEQUATE AND INSTALL NEW GROUNDING AS NECESSARY. CONTRACTOR TO PROVIDE OEM REFURBISHMENT BY COORDINATING THE REFURBISHMENT DIRECTLY WITH THE MANUFACTURER'S REPRESENTATIVE. UNIT MANUFACTURER IS TEMTROL.
- PROVIDE NEW CHILLED WATER AND HEATING HOT WATER CONTROL BALL VALVES. REFER TO SCHEDULES FOR VALVE SIZING.
- ROUTE 1-1/2" CONDENSATE PIPE TO THE NEAREST DRAIN.
- PROVIDE AND INSTALL UPGRADED DDC CONTROLS FOR NEW AHUS AND ALL ASSOCIATED DEVICES PART OF THE AIR DISTRIBUTION SYSTEM CONNECTED TO THE AHU. CONTRACTOR TO PROVIDE DDC CONTROLS, ACTUATORS, VALVES, FUMA, FUMA, AND HUMIDIFIERS. REFER TO SCHEDULES FOR VALVE SIZING. PROVIDE ADDITIONAL CONTROLS INFORMATION.
- PROVIDE AND INSTALL NEW AIR HANDLING UNIT. CONTRACTOR TO VERIFY EXISTING CONDITIONS AND INSTALLATION METHODOLOGY PRIOR TO ORDERING ANY EQUIPMENT. RECONNECT ALL DUCTWORK TO THE CORRECT ZONES ON NEW UNIT UTILIZING SHEET METAL DUCTWORK AND FLEX CONNECTIONS AS NECESSARY. REFER TO SPECIFICATIONS FOR DUCTWORK TAILS. RECONNECT CHW AND HW LINES TO NEW UNIT. REFER TO DETAILS FOR COIL CONNECTION REQUIREMENTS.
- PROVIDE LINE ISOLATION VALVE AT CHW AND HW ENTRY INTO MECHANICAL ROOM. CONTRACTOR TO PERFORM LINE FREEZE AS NECESSARY TO INSTALL NEW VALVE.
- PROVIDE NEW LINE ISOLATION VALVE AT AHU CONNECTIONS. REFER TO COIL DETAILS. ENSURE ISOLATION IS IN THE CORRECT LOCATION.

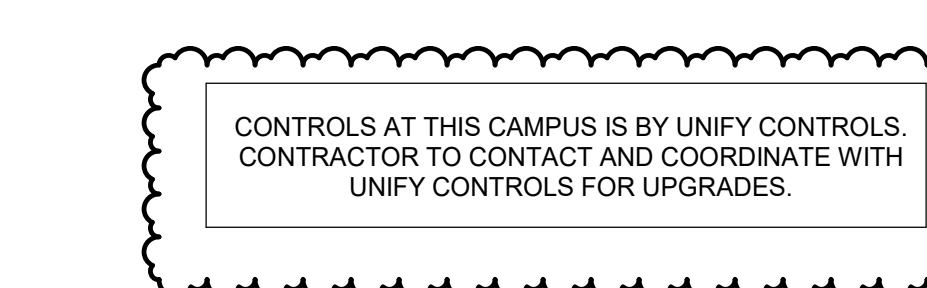FORT BEND ISD - BP048  
HVAC MEP WEST ZONE 3  
STEPHEN F. AUSTIN HS3434 Pheasant Creek Dr.  
Sugar Land, TX 77498

CORGAN

ISSUES	
1	07.18.2025
2	09.29.2025
3	11.11.2025
4	12.11.2025

REVISIONS	
1	01/23/2026 ADDENDUM #2

Date of issue:  
01.23.2026

KEYPLAN	
D	C
B	A

MECHANICAL  
ENLARGED PLANS

JOB 25241.0000  
DATE 12/11/25  
SHEET

A-M20-03

1/4" = 1'-0"

**SECOND FLOOR - MECH 1**

3" CHS/R  
2" HWS/R  
UP FROM  
FIRST FLOOR

14/14

14/14

18/16

18/16

22/16

26/16

20/16

22/16

16/16

18/16

44/16

(N)AHU-4

(N)VFD-AHU-4

(N)VFD-AHU-5

(N)AHU-5

FD

VD

2 3  
4 5

7

X411

Sto

68 SF

X422

Sto

40 SF

This architectural floor plan illustrates the mechanical systems for the Second Floor (MECH 5). The plan shows a network of ductwork, including a large duct labeled '34/30' at the top and '32/30' on the left. A central equipment room contains a unit labeled '(N)AHU-18' with five circular components labeled 2, 3, 4, 5. The plan also features a structural grid with columns labeled 16/16 and 30/28. Fire dampers (FD) are indicated at several locations. A legend in the top right corner specifies '3" CHS/R' and '2" HWS/R' for pipe sizes. A scale bar at the bottom left indicates '1/4" = 1'-0".

**5** SECOND FLOOR - MECH 5

1/4" = 1'-0"

SECOND FLOOR - MECH 3

1/4" = 1'-0"

4" CHS/R  
2" HWS/R  
UP FROM  
FIRST FLOOR

X443  
Science Prep  
466  
SF

CONTROLS AT THIS CAMPUS IS BY UNIFY CONTROLS.  
CONTRACTOR TO CONTACT AND COORDINATE WITH  
UNIFY CONTROLS FOR UPGRADES.

MECHANICAL RETRO NOTES


1. REFURBISH THE AIR HANDLING UNIT WITH THE FOLLOWING. THOROUGHLY CLEAN THE ENTIRE UNIT FROM INSIDE OUT INCLUDING THE FAN WHEEL, CHILLED WATER AND HEATING WATER COILS. PROVIDE NEW FILTERS, MOTORIZED DAMPERS, ACTUATORS, FAN BELTS. GREASE FAN SHAFT AND BEARINGS. VERIFY EXISTING MOTOR GROUNDING IS ADEQUATE AND INSTALL NEW GROUNDING AS NECESSARY. CONTRACTOR TO PROVIDE OEM REFURBISHMENT BY COORDINATING THE REFURBISHMENT DIRECTLY WITH THE MANUFACTURER'S REPRESENTATIVE. UNIT MANUFACTURER IS TEMTROL.
2. PROVIDE NEW CHILLED WATER AND HEATING HOT WATER CONTROL BALL VALVES. REFER TO SCHEDULES FOR VALVE SIZING.
3. ROUTE 1-1/2" CONDENSATE PIPE TO THE NEAREST DRAIN.
4. PROVIDE AND INSTALL UPGRADED DDC CONTROLS FOR NEW AHU'S AND ALL ASSOCIATED DEVICES PART OF THE AIR DISTRIBUTION SYSTEM CONNECTED TO THE AHU. CONTROLS CONTRACTOR TO PROVIDE ALL NEW THERMOSTATS AND HUMIDISTATS FOR EACH ZONE. REFER TO M6.00 AND M6.01 SHEETS FOR ADDITIONAL CONTROLS INFORMATION.
5. PROVIDE AND INSTALL NEW AIR HANDLING UNIT. CONTRACTOR TO VERIFY EXISTING CONDITIONS AND INSTALLATION METHODOLOGY PRIOR TO ORDERING ANY EQUIPMENT. RECONNECT ALL DUCTWORK TO THE CORRECT ZONES ON NEW UNIT UTILIZING SHEET METAL DUCTWORK AND FLEX CONNECTIONS AS NECESSARY. REFER TO SPECIFICATIONS FOR DUCTWORK DETAILS. RECONNECT CHW AND HW LINES TO NEW UNIT. REFER TO DETAILS FOR COIL CONNECTION REQUIREMENTS.
6. PROVIDE LINE SIZE ISOLATION VALVE AT CHW AND HW ENTRY INTO MECHANICAL ROOM. CONTRACTOR TO PERFORM LINE FREEZE AS NECESSARY TO INSTALL NEW VALVE.
7. PROVIDE NEW LINE SIZE ISOLATION VALVE AT AHU CONNECTIONS. REFER TO COIL DETAILS ENSURE ISOLATION IS IN THE CORRECT LOCATION.

**FOR<sup>T</sup> BEND ISD - BP048**  
**HVAC MEP WEST ZONE 3**  
**STEPHEN F. AUSTIN HS**  
3434 Pheasant Creek Dr.  
Sugar Land, TX 77498

## KEYPLAN

# MECHANICAL ENLARGED PLANS

<b>Y</b> <b>W</b> <b>2</b> <b>ENGINEERING</b>	<b>JOB</b> 25241.0000
08 Reppart Place ouston, Texas 77008 6-341-2168 www.yw-squared.com	<b>DATE</b> 12/11/25
Firm No. 22107 ject No. 25027.00	<b>SHEET</b>
<b>A-M20-04</b>	

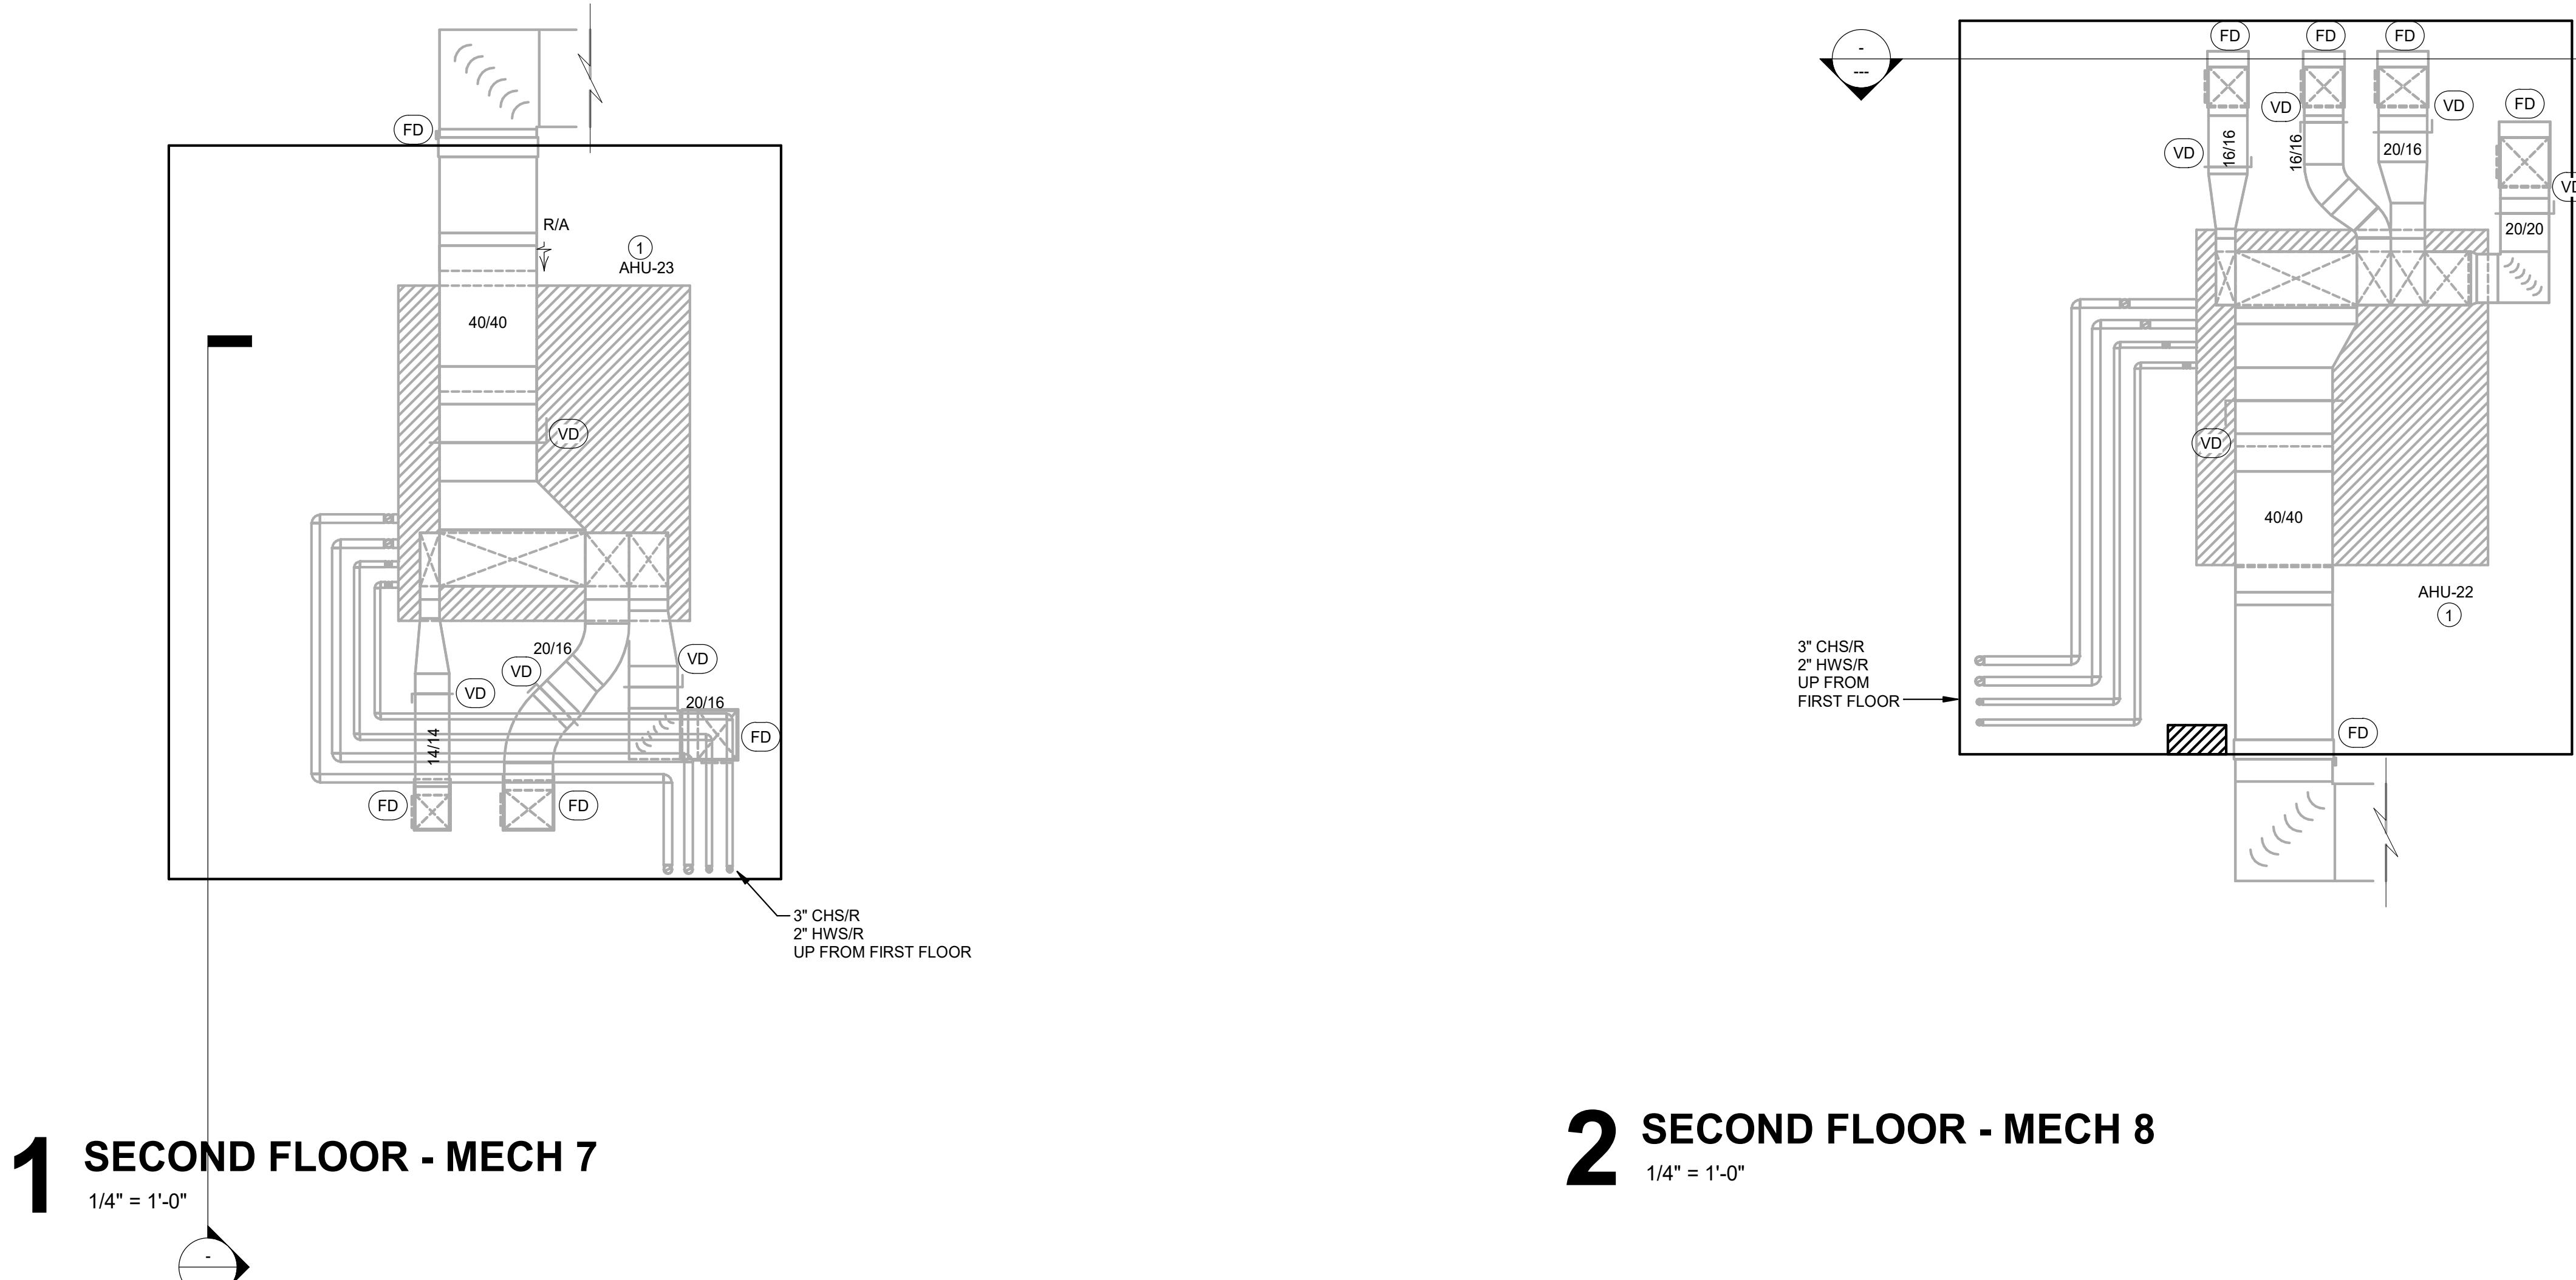


⊗ MECHANICAL KEYED NOTES

1. REFURBISH THE AIR HANDLING UNIT WITH THE FOLLOWING: THOROUGHLY CLEAN THE ENTIRE UNIT FROM INSIDE OUT INCLUDING THE FAN WHEEL, CHILLED WATER AND HEATING WATER COILS. PROVIDE NEW FILTERS, MOTORIZED DAMPERS, ACTUATORS, FAN BELTS, GREASE FAN SHAFT AND BEARINGS. VERIFY EXISTING MOTOR GROUNDING IS ADEQUATE AND INSTALL NEW GROUNDING AS NECESSARY. CONTRACTOR TO PROVIDE OEM REFURBISHMENT BY COORDINATING THE REFURBISHMENT DIRECTLY WITH THE MANUFACTURER'S REPRESENTATIVE. UNIT MANUFACTURER IS TEMTROL.

CONTROLS AT THIS CAMPUS IS BY UNIFY CONTROLS  
CONTRACTOR TO CONTACT AND COORDINATE WITH  
UNIFY CONTROLS FOR UPDATES.

**FORT BEND ISD - BP048**  
**HVAC MEP WEST ZONE 3**  
**STEPHEN F. AUSTIN HS**

3434 Pheasant Creek Dr.  
Sugar Land, TX 77498

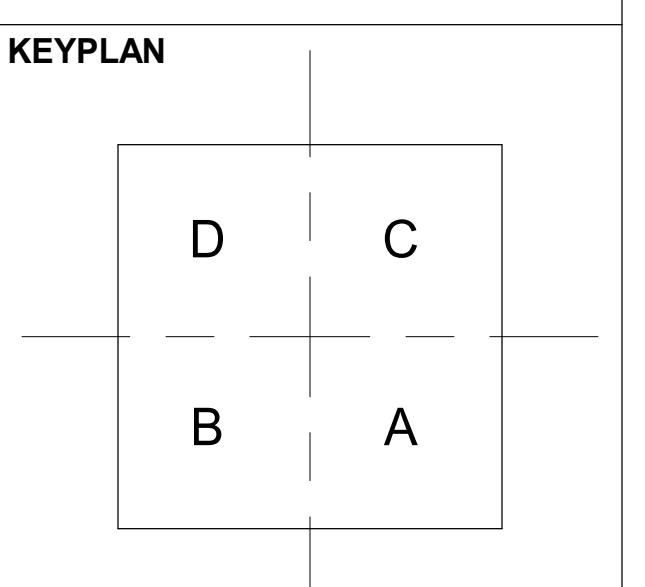

**MECHANICAL  
ENLARGED PLANS**

**JOB** 25241.0000  
**DATE** 12/11/25  
**SHEET**

**YW<sup>2</sup>**  
ENGINEERING  
2508 Rappaport Place  
Houston, Texas 77008  
346-341-2168  
www.yw-squared.com  
TX Firm No. 22107  
Project No. 25027.00

**A-M20-05**

DESIGNATION	SERVICE	LOCATION	FAN DATA										COOLING COIL DATA							HOT WATER HEATING COIL DATA						MISCELLANEOUS			MANUFACTURER/ SERIES BASIS FOR DESIGN	REMARKS / NOTES			
			TOTAL AIR VOLUME/CFM	OUTSIDE AIR VOLUME/CFM	OUTSIDE AIR VOLUME/CFM (MAXIMUM)	FAN TYPE	FAN SPEED MAX. RPM	MINIMUM FAN DIAMETER (IN)	EXT. STATIC PRESS. INCL. FILTERS (IN WG)*	INTERNAL STATIC PRESS. (IN WG)	MAX. FAN MOTOR HP	ELECTRICAL DATA VOLTS/PHASE/HZ	TOTAL AIR VOLUME/CFM	MAX. COIL FACE VELOCITY (FPM)	ENTERING AIR TEMPERATURE °F - DB/WB	LEAVING AIR TEMPERATURE °F - DB / WB	TOTAL SENSIBLE HEAT MBTUH*	GRAND TOTAL HEAT MBTUH	ENTERING WATER TEMPERATURE °F	CHILLED WATER QUANTITY GPM	TOTAL AIR VOLUME/CFM	MAX. COIL FACE VELOCITY (FPM)	TOTAL HEAT BTUH	ENTERING AIR TEMPERATURE °F - DB	ENTERING WATER TEMP. (°F)	GPM	MAX. PD (FT)	UNIT TYPE ***	FILTER SEQUENCE TYPE				
AHU-1	CLASSROOMS	A118	12,100	3,000	5,050	FAN ARRAY	3,166	22	1.38	1.21	(2) @ 4.5HP EACH	460 / 3 / 60	10,285	490	81.5 / 72.3	49.8 / 49.8	348.7	704.4	40	70.4	10,285	940	356.7	63.8	180	17.4	4.5	BTM2	MEDIA ROLL	--	NORTEK AIR SOLUTIONS TEMTROL / 182T	1, 2, 3, 4, 5, 6, 7, 8, 9, 10, 12	
AHU-2	CLASSROOMS	A118	10,800	2,700	4,630	FAN ARRAY	3,166	22	1.38	1.15	(2) @ 4.0HP EACH	460 / 3 / 60	9,180	475	81.7 / 72.6	49.8 / 49.8	313.5	639.4	40	62.8	9,180	840	313.8	63.8	180	15.5	8.0	BTM2	MEDIA ROLL	--	NORTEK AIR SOLUTIONS TEMTROL / 182T	1, 2, 3, 4, 5, 6, 7, 8, 9, 10, 12	
AHU-3	LIBRARY	B113	10,750	2,150	2,150	FAN ARRAY	3,166	22	1.38	0.84	(2) @ 4.0HP EACH	460 / 3 / 60	9,138	450	78.1 / 67.7	49.9 / 49.8	278.2	475.2	40	59.0	9,138	965	319.5	63.8	180	15.5	7.5	BTM2	MEDIA ROLL	--	NORTEK AIR SOLUTIONS TEMTROL / 182T	1, 2, 3, 4, 5, 6, 7, 8, 9, 10, 12	
AHU-6	LOCKERS / CORRIDOR / OFFICES	B205	9,350	1,400	1,400	BELT	3,166	22	1.29	1.34	7.5HP	460 / 3 / 60	9,350	490	77.0 / 66.1	47.6 / 47.6	296.7	484.9	40	63.5	9,350	490	360.7	61.8	180	15.8	8.5	VDT	MEDIA ROLL	VAV	NORTEK AIR SOLUTIONS TEMTROL / 213T	1, 2, 3, 4, 5, 6, 7, 9, 10, 12	
AHU-7	CORRIDOR / OFFICES	C113	11,825	1,775	1,775	FAN ARRAY	3,521	20	1.68	1.31	(2) @ 5.0HP EACH	460 / 3 / 60	11,825	495	77.0 / 66.1	48.1 / 48.1	369.9	600.0	40	63.5	11,825	495	432.3	61.8	180	15.8	17	VDT	MEDIA ROLL	VAV	NORTEK AIR SOLUTIONS TEMTROL / 184T	1, 2, 3, 4, 5, 6, 7, 9, 10, 12	
AHU-8	CLASSROOMS	C113	19,500	4,875	7,840	FAN ARRAY	3,166	22	1.40	0.93	(2) @ 7.5HP EACH	460 / 3 / 60	16,575	450	80.3 / 70.7	49.8 / 49.7	543.4	1041.4	40	113.4	16,575	985	574.5	63.8	180	27.8	8.0	BTM2	MEDIA ROLL	--	NORTEK AIR SOLUTIONS TEMTROL / 213T	1, 2, 3, 4, 5, 6, 7, 8, 9, 10, 12	
AHU-9	CORRIDOR / OFFICES	C213	11,075	1,660	1,660	FAN ARRAY	3,521	20	1.30	1.18	(2) @ 4.0HP EACH	460 / 3 / 60	11,075	460	77.0 / 66.1	47.8 / 47.8	349.3	569.9	40	75.2	11,075	460	431.2	61.8	180	18.7	5.0	VDT	MEDIA ROLL	VAV	NORTEK AIR SOLUTIONS TEMTROL / 182T	1, 2, 3, 4, 5, 6, 7, 9, 10, 12	
AHU-10	CLASSROOMS	C213	18,600	4,650	7,840	FAN ARRAY	3,166	22	1.40	0.87	(2) @ 7.0HP EACH	460 / 3 / 60	15,810	430	81.6 / 72.4	49.6 / 49.6	541	1,096.3	40	117.0	15,810	940	558.6	63.8	180	26.8	7.0	BTM2	MEDIA ROLL	--	NORTEK AIR SOLUTIONS TEMTROL / 184T	1, 2, 3, 4, 5, 6, 7, 8, 9, 10, 12	
AHU-18	AUDITORIUM	G202	21,750	5,435	5,435	FAN ARRAY	3,166	22	1.51	1.08	(2) @ 9.5HP EACH	460 / 3 / 60	19,575	495	78.7 / 68.5	49.7 / 49.7	611.2	1,080.6	40	133.9	19,575	990	679.9	63.8	180	33.1	9.5	BTM2	MEDIA ROLL	--	NORTEK AIR SOLUTIONS TEMTROL / 213T	1, 2, 3, 4, 5, 6, 7, 8, 9, 10, 13	
AHU-19	AUDITORIUM	G204	21,750	5,435	5,435	FAN ARRAY	3,166	22	1.51	1.08	(2) @ 9.5HP EACH	460 / 3 / 60	19,575	495	78.7 / 68.5	49.7 / 49.7	611.2	1,080.6	40	133.9	19,575	990	679.9	63.8	180	33.1	9.5	BTM2	MEDIA ROLL	--	NORTEK AIR SOLUTIONS TEMTROL / 213T	1, 2, 3, 4, 5, 6, 7, 8, 9, 10, 13	
AHU-20	CLASSROOMS	G157	11,010	2,200	4,885	FAN ARRAY	3,166	22	1.32	1.00	(2) @ 4.0HP EACH	460 / 3 / 60	9,359	465	82.0 / 72.8	50.2 / 50.2	318.2	649.3	40	65.1	9,359	855	317.7	63.8	180	15.8	8.5	BTM2	MEDIA ROLL	--	NORTEK AIR SOLUTIONS TEMTROL / 182T	1, 2, 3, 4, 5, 6, 7, 8, 9, 10, 12	
AHU-21	CLASSROOMS	G157	16,050	3,210	6,310	FAN ARRAY	3,166	22	1.35	1.22	(2) @ 6.0HP EACH	460 / 3 / 60	13,643	470	81.1 / 71.8	49.8 / 49.8	457.3	909.3	40	94.9	13,643	1030	459.8	63.8	180	23.1	5.0	BTM2	MEDIA ROLL	--	NORTEK AIR SOLUTIONS TEMTROL / 184T	1, 2, 3, 4, 5, 6, 7, 8, 9, 10, 12	
ALTERNATE PRICING OPTION AIR HANDLERS LIST BELOW:																																	
ALTERNATE #3	AHU-4	CLASSROOMS	A220	12,100	3,025	5,050	DD	3,166	22	2.59	1.21	(2) @ 4.5HP EACH	460 / 3 / 60	10,285	490	81.5 / 72.3	49.8 / 49.8	349.3	705.3	40	76.0	10,285	940	356.7	63.8	180	17.4	4.5	BTM2	MEDIA ROLL	--	NORTEK AIR SOLUTIONS TEMTROL / 182T	1 THRU 12
ALTERNATE #4	AHU-5	CLASSROOMS	A220	10,800	2,700	4,630	DD	3,166	22	2.53	1.15	(2) @ 4.0HP EACH	460 / 3 / 60	9,180	475	81.7 / 72.6	49.8 / 49.8	313.5	639.6	40	67.9	9,180	840	313.8	63.8	180	15.5	8.5	BTM2	MEDIA ROLL	--	NORTEK AIR SOLUTIONS TEMTROL / 182T	1 THRU 12

\* SCHEDULED SENSIBLE HEAT DOES NOT INCLUDE MOTOR HEAT.

\*\* EXTERNAL STATIC PRESSURE INCLUDES FILTER RESISTANCE.

\*\*\* SEE PLAN AND AIR HANDLER UNIT DETAIL FOR CONFIGURATION.

\*\*\*\* DO NOT BLOW UP, THE ENTERING AIR CONDITIONS EXCLUDE THE MOTOR HEAT.

NEW NOTES:

1. DIRECT DRIVE SUPPLY FAN WITH PREMIUM EFFICIENCY TECF MOTOR AND CERAMIC BEARINGS TO PREVENT CURRENT DAMAGE.

2. DOUBLE WALL CONSTRUCTION WITH 2" INSULATION AND WELDED STRUCTURAL STEEL BASE WITH 4" FOAM INSULATION.

3. CHILLED WATER COILS SHALL INCLUDE STAINLESS STEEL CASING AND STAINLESS STEEL DRAIN PAN

4. LOOSE NEMATIC VENT TO THE FIELD INSTALLED AHU SHALL INCLUDE A THERMO-PROTECTED JUNCTION BOX OR MOTOR OVERLOAD PANEL FOR FIELD VFD CONNECTION

5. AHU SHALL BE COORDINATED TO THE TRADES FOR EGRESS FOR FIELD ASSEMBLY

6. PROVIDE VFD WITH INTEGRAL DISCONNECT AND BYPASS. ELECTRICAL CONTRACTOR TO MAINTAIN ALL NEC CLEARANCES.

7. CONTRACTOR SHALL BE RESPONSIBLE TO ENSURE AHUS ARE ABLE TO BE INSTALLED ON EXISTING HOUSEKEEPING PADS.

8. ALL BTM2 UNITS SHALL HAVE HOT, COLD AND NEUTRAL DECKS.


9. MECHANICAL CONTRACTOR IS RESPONSIBLE TO COORDINATE WITH GENERAL CONTRACTOR AND FIRE ALARM VENDOR TO REMOVE, PROTECT, AND REINSTALL ALL FIRE ALARM DEVICES ASSOCIATED WITH THE AHU.

10. PROVIDE NEW CONTROLS, CONTROL VALVES, AND ACTUATORS FOR ALL NEW UNITS. SEQUENCE SHALL BE SIMILAR TO EXISTING SEQUENCE. REFER TO CONTROL DIAGRAMS FOR MORE INFORMATION.

11. THIS AIR HANDLER IS INTENDED TO BE AN ALTERNATE PRICING OPTION.

12. PROVIDE CHILLED WATER 2-WAY CONTROL VALVE.

13. PROVIDE CHILLED WATER 3-WAY CONTROL VALVE.

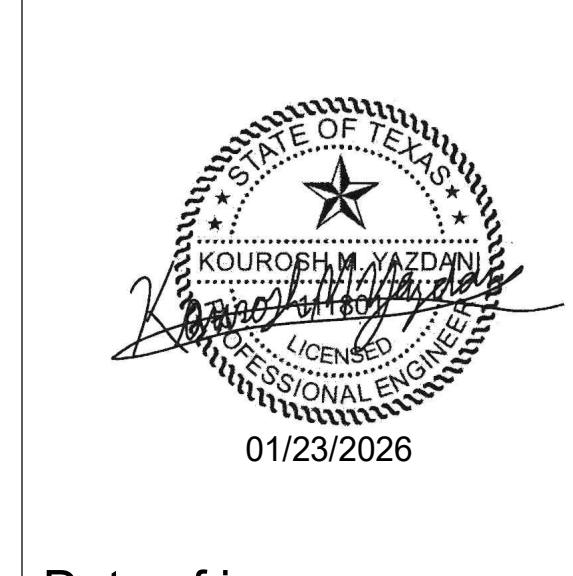





## MECHANICAL GENERAL NOTES:

- REFER TO MECHANICAL COVER SHEET FOR SYMBOLS, ABBREVIATIONS, AND ADDITIONAL INFORMATION.
- REFER TO MECHANICAL SCHEDULES AND DETAIL DRAWINGS FOR ADDITIONAL INFORMATION.
- Maintain manufacturer's recommended service clearance for new and existing mechanical equipment.
- The contractor shall verify all existing and new mechanical equipment are mounted so that all required clearances are maintained at the bottom and sides of each unit for proper servicing and maintenance. Coordinate completely with all new walls to structure, and relocate as required to maintain proper clearances.
- Contractor shall field verify actual locations of all equipment & piping prior to submitting a bid. Coordinate completely with all other trades. Relocate terminal units and provide additional ductwork, offsets, fittings, etc. as required.
- Due to drawing scale, it is not possible to indicate all offsets, fittings and accessories which may be required. The contractor shall examine field conditions and furnish the necessary fittings which may be required to complete the installation. Contractor shall furnish and install balancing dampers in HVAC systems that have more than one inlet/outlet unless noted otherwise. Balancing dampers shall apply to new and existing ductwork.

## ⑧ MECHANICAL KEYED NOTES

- Contractor to provide new primary chilled water pump tying into existing piping to remain. Provide all new gauges, valves, and associated appurtenances, etc per detail. Mechanical contractor shall provide new VFD - electrical contractor to install the VFD. Contractor to coordinate all piping connections to ensure no unnecessary are created which would potentially create an issue with controls, gauges, valves, etc. to be installed in the piping. See detail A-M04-00. Refer to schedule sheet for additional information.
- Contractor to provide new secondary chilled water pump tying into existing piping to remain. Provide all new gauges, valves, and associated appurtenances, etc per detail. Mechanical contractor shall provide new VFD - electrical contractor to install the VFD. Contractor to coordinate all piping connections to ensure no unnecessary are created which would potentially create an issue with controls, gauges, valves, etc. to be installed in the piping. See detail A-M04-00. Refer to schedule sheet for additional information.
- Contractor to provide new hot water pump tying into existing piping to remain. Provide all new gauges, valves, and associated appurtenances, etc per detail. Mechanical contractor shall provide new VFD - electrical contractor to install the VFD. Contractor to coordinate all piping connections to ensure no unnecessary are created which would potentially create an issue with controls, gauges, valves, etc. to be installed in the piping. See detail A-M04-00. Refer to schedule sheet for additional information.
- Refurbish existing cooling tower. Scope shall include new fill media, replacement of fans, replacement of motors, replacement of drift eliminators, regrease all bearings, thoroughly clean interior and exterior, and paint.
- Contractor to replace entire condenser water cooling tower bypass line header (approximately 8') from bottom elbow where piping runs underneath the tower to each basin, including isolation valves at each tower. Paint to match existing piping.

ISSUES	
1	07.18.2025 DESIGN DEVELOPMENT
2	09.29.2025 50% CONSTRUCTION DOCUMENTS
3	11.11.2025 90% CONSTRUCTION DOCUMENTS
4	12.11.2025 100% CONSTRUCTION DOCUMENTS

REVISIONS	
1	01/23/2026 ADDENDUM #2

  
 KOUROEH M. AZADIAN  
 STATE OF TEXAS  
 LICENSED PROFESSIONAL ENGINEER  
 01/23/2026

Date of issue:  
01.23.2026


# FORT BEND ISD - BP048

## HVAC MEP WEST ZONE 3

### JAMES BOWIE MS

700 PLANTATION DR.  
RICHMOND, TX 77406

## KEYPLAN

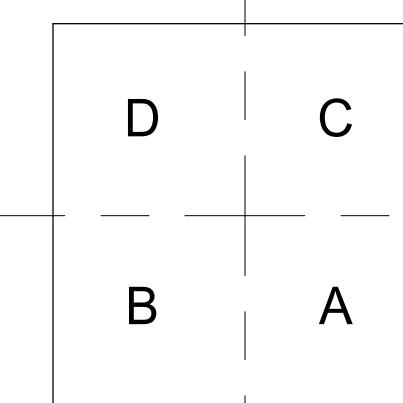

### MECHANICAL PLAN - LEVEL 01 - OVERALL

JOB 25241.0000  
 DATE 01/23/26  
 SHEET

  
 2508 Report Place  
 Houston, Texas 77008  
 346-341-2168  
 www.w2-squared.com  
 TX Firm No. 22107  
 Project No. 25027.00

A circular seal for a professional engineer. The outer ring contains the words "STATE OF TEXAS" at the top and "PROFESSIONAL ENGINEER" at the bottom, separated by a dotted line. The inner circle features a five-pointed star in the center, with the name "KOUROSH M. YAZDANI" written in capital letters just below it. A large, handwritten signature of the name is written across the center of the seal. At the bottom, the date "01/23/2026" is printed.

Date of issue:  
01.23.2026

# SCHEDULE OF COOLING TOWERS REFURBISHMEN

SCHEDULE OF COOLING TOWERS REFURBISHMENT											
DESIGNATION CT-	CAPACITIES							M I C .	E L E C T R I C A L	MANUFACTURER / SERIES BASIS FOR DESIGN	NOTES / REMARKS
	NUMBER OF CELLS	WATER QUANTITY PER CELL (GPM)	TOTAL QUANTITY WATER COOLED PER COOLING TOWER (GPM)	TOTAL TONS PER COOLING TOWER	ENTERING WATER TEMPERATURE °F	LEAVING WATER TEMPERATURE °F	AMBIENT WET BULB TEMPERATURE °F				
CT-1	2	1350	2700	900	96	86	80	1	30HP PER CELL	-	BALTIMORE AIRCOIL COMPANY

## NOTE

NOTES:

1. COOLING TOWER IS TO BE REFURBISHED.
2. PROVIDE TOWER FANS WITH ABB VARIABLE FREQUENCY DRIVE FOR EACH FAN MOTOR.
3. CLEAN, RESEAL, AND RECAULK COLD WATER BASIN.
4. MOTOR, FAN AND BELT SHALL BE REPLACED. MOTOR SHALL HAVE A MAX RPM OF 1800.
5. FLOAT VALVE TO BE REPLACED. CONTRACTOR TO VERIFY MAKEUP WATER VALVE OPERATION WITH FLOAT AND INCLUSIONS WITHIN BID TO FIX AS NECESSARY.
6. FILL, DRIFT ELIMINATORS AND AIR INLET LOUVERS TO BE REPLACED.
7. REGREASE ALL BEARINGS, THOROUGHLY CLEAN INTERIOR AND EXTERIOR, AND REAPPLY PROTECTIVE COATING OF WETTED SURFACES.
8. FAN VFD ENCLOSURE SHALL BE NEMA 4X RATED.
9. PROVIDE A VIBRATION CUT-OUT SWITCH TO DE-ENERGIZE FAN MOTOR UPON EXCESSIVE VIBRATION.
10. PATCH AND REPAIR CASING PANELS.
11. STRUCTURE SHALL BE REPAIRED OF ALL EXISTING DAMAGE.
12. EXISTING BASIN HEATER SHALL REMAIN.

## SCHEDULE OF PUMPS

DESIGNATION	SERVICE	LOCATION	CAPACITIES							ELECTRICAL			MANUFACTURER/SERIES BASIS FOR DESIGN	NOTES/REMARKS		
			WATER TEMPERATURE °F	TYPE	DESIGN CONDITIONS GPM	DESIGN CONDITIONS HEAD - FT	SHUTOFF HEAD - FT	WORKING PRESSURE / PSIG	APPROXIMATE IMPELLER DIAMETER / IN.	BHP	MOTOR HP	RPM	VOLTS/PHASE/HZ			
HWP-1	BOILER	RM E137	180°	FRAME MOUNTED END SUCTION	395	160	175.6	150	9.81	12.5	22.45	30	1780	460/360	GRUNDFOS SERIES LF SIZE 286T-4x14	1, 2, 3, 4, 5, 6
HWP-2	BOILER	RM E137	180°	FRAME MOUNTED END SUCTION	395	160	175.6	150	9.81	12.5	22.45	30	1780	460/360	GRUNDFOS SERIES LF SIZE 286T-4x14	1, 2, 3, 4, 5, 6
PCHP-1	BUILDING CHW	RM E138	42°	FRAME MOUNTED END SUCTION	775	50	57.5	150	9.25	9.0	12.37	15	1760	460/360	GRUNDFOS SERIES LF SIZE 254T-5x9.5	1, 2, 3, 4, 5, 6
PCHP-2	BUILDING CHW	RM E138	42°	FRAME MOUNTED END SUCTION	775	50	57.5	150	9.25	9.0	12.37	15	1760	460/360	GRUNDFOS SERIES LF SIZE 254T-5x9.5	1, 2, 3, 4, 5, 6
SCHP-1	BUILDING CHW	RM E138	42°	FRAME MOUNTED END SUCTION	605	140	188.9	150	17.46	13.0	30.43	40	1780	460/360	GRUNDFOS SERIES LF SIZE 324T-4x13	1, 2, 3, 4, 5, 6
SCHP-2	BUILDING CHW	RM E138	42°	FRAME MOUNTED END SUCTION	605	140	188.9	150	17.46	13.0	30.43	40	1780	460/360	GRUNDFOS SERIES LF SIZE 324T-4x13	1, 2, 3, 4, 5, 6


## NOTES

1. PROVIDE WITH PREMIUM EFFICIENCY VSD-RATED MOTOR. PROVIDE ELECTRICALLY INSULATED BEARINGS ON VSD DRIVEN MOTORS.
2. PUMP SHALL BE INSTALLED ON A NEW CONCRETE INERTIA BASE. PROVIDE VIBRATION ISOLATION RAILS, VARIABLE SPEED DRIVE (VSD), AND NECESSARY INTERFACE WITH EXISTING CONTROLLER.
3. ELECTRICAL DISCONNECT SHALL BE PROVIDED AND INSTALLED BY EC.
4. PROVIDE WITH ABB VSD, OR APPROVED EQUAL.
5. CONTROLS CONTRACTOR TO PROVIDE NEW CONTROLLERS AND SEQUENCE PER FBISD STANDARDS FOR NEW VARIABLE SPEED PUMP(S) AS REQUIRED. CONTROLS CONTRACTOR TO PROVIDE AND INSTALL NEW DIFFERENTIAL PRESSURE (DP) SENSOR. MECHANICAL CONTRACTOR TO COORDINATE LOCATIONS OF TAPS FOR DP SENSORS WITH CONTROLS CONTRACTOR. RECOMMEND TO BE INSTALLED APPROXIMATELY TWO THIRDS (2/3) TO THREE QUARTERS (3/4) DOWN STEAM OF PUMP(S).
6. CONTRACTOR SHALL VERIFY PUMP BODY DISCHARGE PIPING CONNECTION TO ENSURE ALIGNMENT WITH PIPING OR ADJUST PIPING AS REQUIRED WHILE MAINTAINING APPURTENANCES AS SHOWN IN THE DETAILS.

**FORT BEND ISD - BP048**  
**HVAC MEP WEST ZONE 3**  
**JAMES BOWIE MS**

700 PLANTATION DR.  
RICHMOND, TX 77406

## KEYPLAN

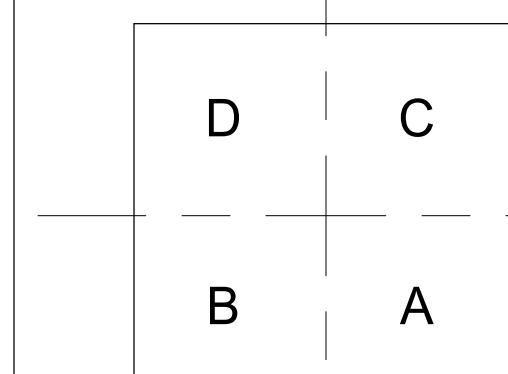

# MECHANICAL SCHEDULES

**YW<sup>2</sup>**  
ENGINEERING  
508 Reppart Place  
ouston, Texas 77008  
46-341-2168  
[www.yw-squared.com](http://www.yw-squared.com)  
X Firm No. 22107  
roject No. 25027.00

**JOB** 25241.0000  
**DATE** 01/23/26  
**SHEET**

**B-M30-00**

**DAVID CROCKETT MS**  
**HVAC MEP WEST ZONE 3**  
**FORT BEND ISD - BP048**  
**19001 REECHNIT ST**

1900 BELMONT ST.  
RICHMOND, TX 77407

## MECHANICAL GENERAL NOTES:

REFER TO MECHANICAL COVER SHEET FOR SYMBOLS, ABBREVIATIONS, AND ADDITIONAL INFORMATION.

REFER TO MECHANICAL SCHEDULES AND DETAIL DRAWINGS FOR ADDITIONAL INFORMATION.

MAINTAIN MANUFACTURER'S RECOMMENDED SERVICE CLEARANCE FOR NEW AND EXISTING MECHANICAL EQUIPMENT.

THE CONTRACTOR SHALL VERIFY ALL EXISTING AND NEW MECHANICAL EQUIPMENT ARE MOUNTED SO THAT ALL REQUIRED CLEARANCES ARE MAINTAINED AT THE BOTTOM AND SIDES OF EACH UNIT FOR PROPER SERVICING AND MAINTENANCE. COORDINATE COMPLETELY WITH ALL NEW WALLS TO STRUCTURE, AND RELOCATE AS REQUIRED TO MAINTAIN PROPER CLEARANCES.


CONTRACTOR SHALL FIELD VERIFY ACTUAL LOCATIONS OF ALL EQUIPMENT, DUCTWORK, & PIPING PRIOR TO SUBMITTING A BID. COORDINATE COMPLETELY WITH ALL OTHER TRADES. RELOCATE TERMINAL UNITS AND PROVIDE ADDITIONAL DUCTWORK, OFFSETS, FITTINGS, ETC. AS REQUIRED.

DUE TO DRAWING SCALE, IT IS NOT POSSIBLE TO INDICATE ALL OFFSETS, FITTINGS AND ACCESSORIES WHICH MAY BE REQUIRED. THE CONTRACTOR SHALL EXAMINE FIELD CONDITIONS AND FURNISH THE NECESSARY FITTINGS WHICH MAY BE REQUIRED TO COMPLETE THE INSTALLATION. CONTRACTOR SHALL FURNISH AND INSTALL BALANCING DAMPERS IN HVAC SYSTEMS THAT HAVE MORE THAN ONE INLET/OUTLET UNLESS NOTED OTHERWISE. BALANCING DAMPERS SHALL APPLY TO NEW AND EXISTING DUCTWORK.

Date of issue:  
01.23.2026



KEYPI


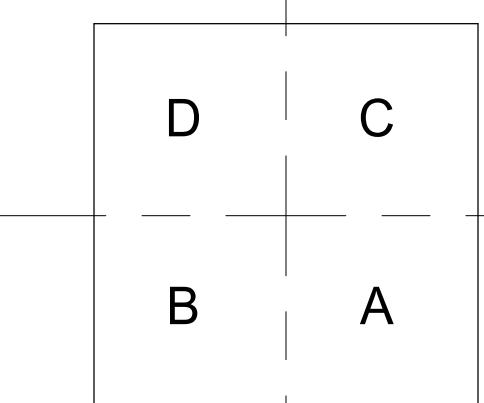


# MECHANICAL PLAN - LEVEL 0 OVERALL

**JOB** 25241.0000  
**DATE** 01/23/26  
**SHEET**

## ⑧ MECHANICAL KEYED NOTES

1. CONTRACTOR TO REPLACE OUTDOOR CONDENSER WATER PIPING SERVING CT-1. PROVIDE ALL NEW GAUGES, VALVES, AND ASSOCIATED APPURTENANCES, IN KIND. EXTEND NEW PIPING MINIMUM 1'-0" WITHIN BUILDING AT CONNECTIONS AND COORDINATE WITH EXISTING PIPING TO REMAIN FOR FINAL CONNECTION POINTS. SYSTEM SHALL BE FLUSHED AND CLEANED PRIOR TO STARTUP AND BALANCING.
2. CONTRACTOR TO PROVIDE NEW HOT WATER PUMP TYING INTO EXISTING PIPING TO REMAIN. PROVIDE ALL NEW GAUGES, VALVES, AND ASSOCIATED APPURTENANCES, ETC PER DETAIL. MECHANICAL CONTRACTOR SHALL PROVIDE NEW VFD - ELECTRICAL CONTRACTOR TO INSTALL THE VFD. CONTRACTOR TO COORDINATE ALL PIPING CONNECTIONS TO ENSURE NO UNNECESSARY ARE CREATED WHICH WOULD POTENTIALLY CREATE AN ISSUE WITH CONTROLS, GAUGES, VALVES, ETC. TO BE INSTALLED IN THE PIPING. SEE DETAIL A-M04-00. REFER TO SCHEDULE SHEET FOR ADDITIONAL INFORMATION.
3. MECHANICAL CONTRACTOR TO COORDINATE WITH CONTROLS CONTRACTOR TO REMOVE, PROTECT, AND REINSTALL CONDENSER WATER SYSTEM CONTROL VALVES. CONTROLS CONTRACTOR TO REWIRE VALVES BACK TO ORIGINAL SOURCES. CONTACT ENGINEER IF ANY ISSUES ARISE.

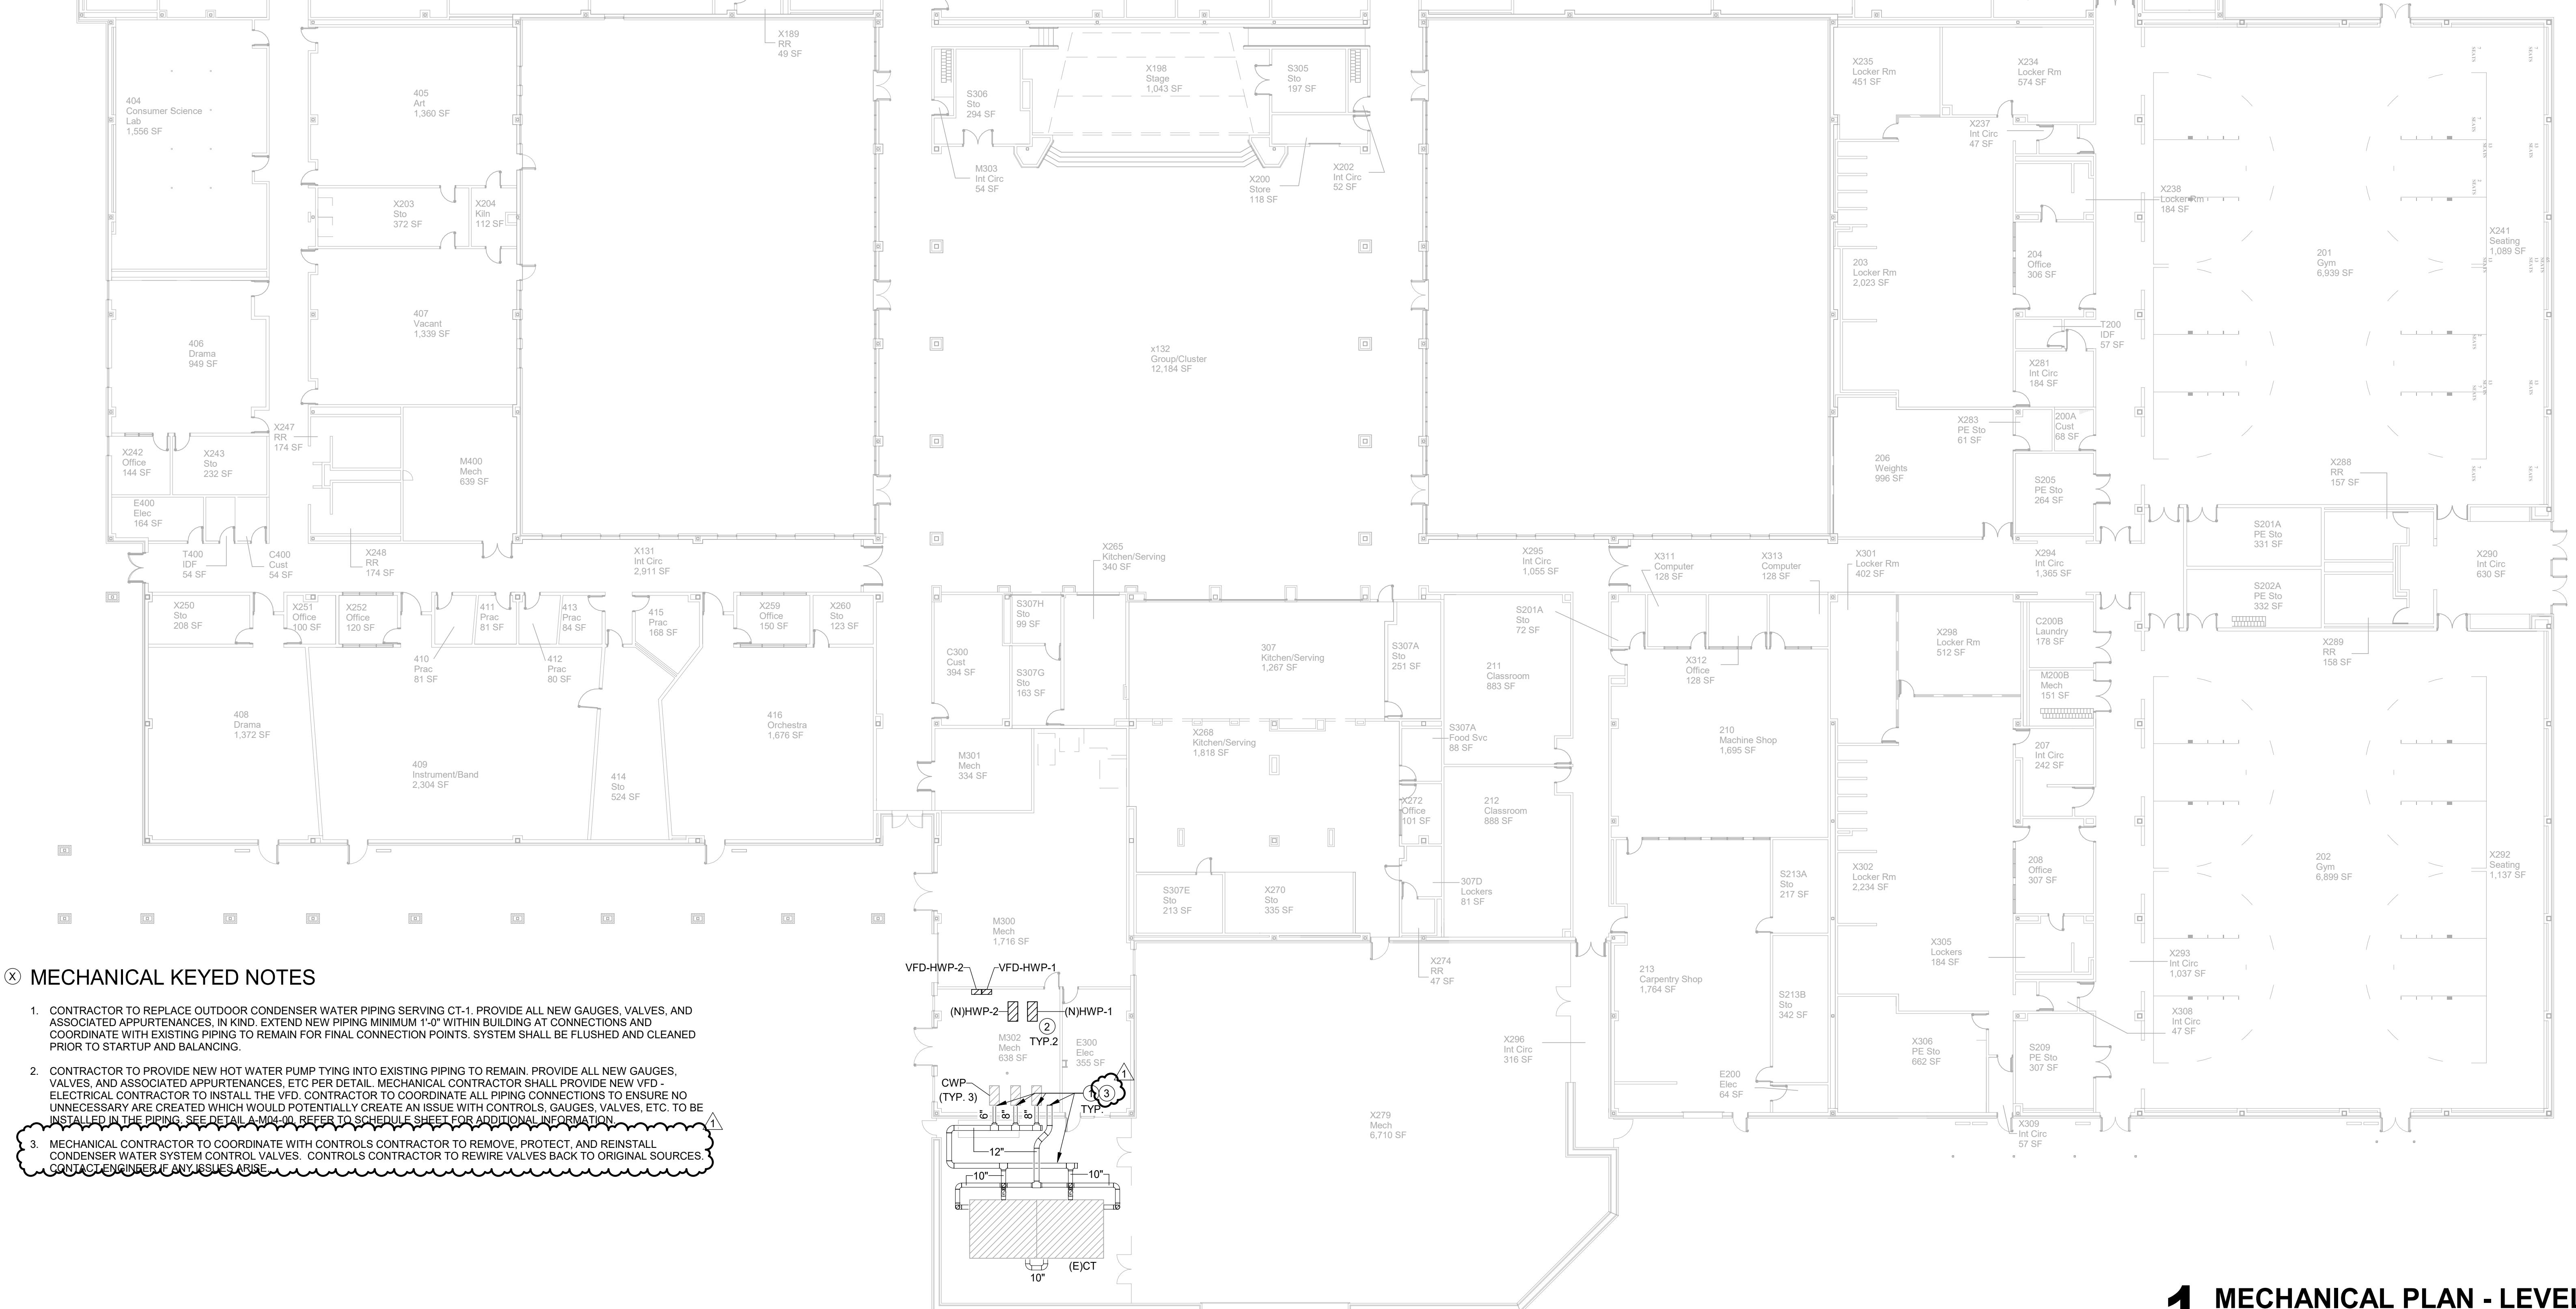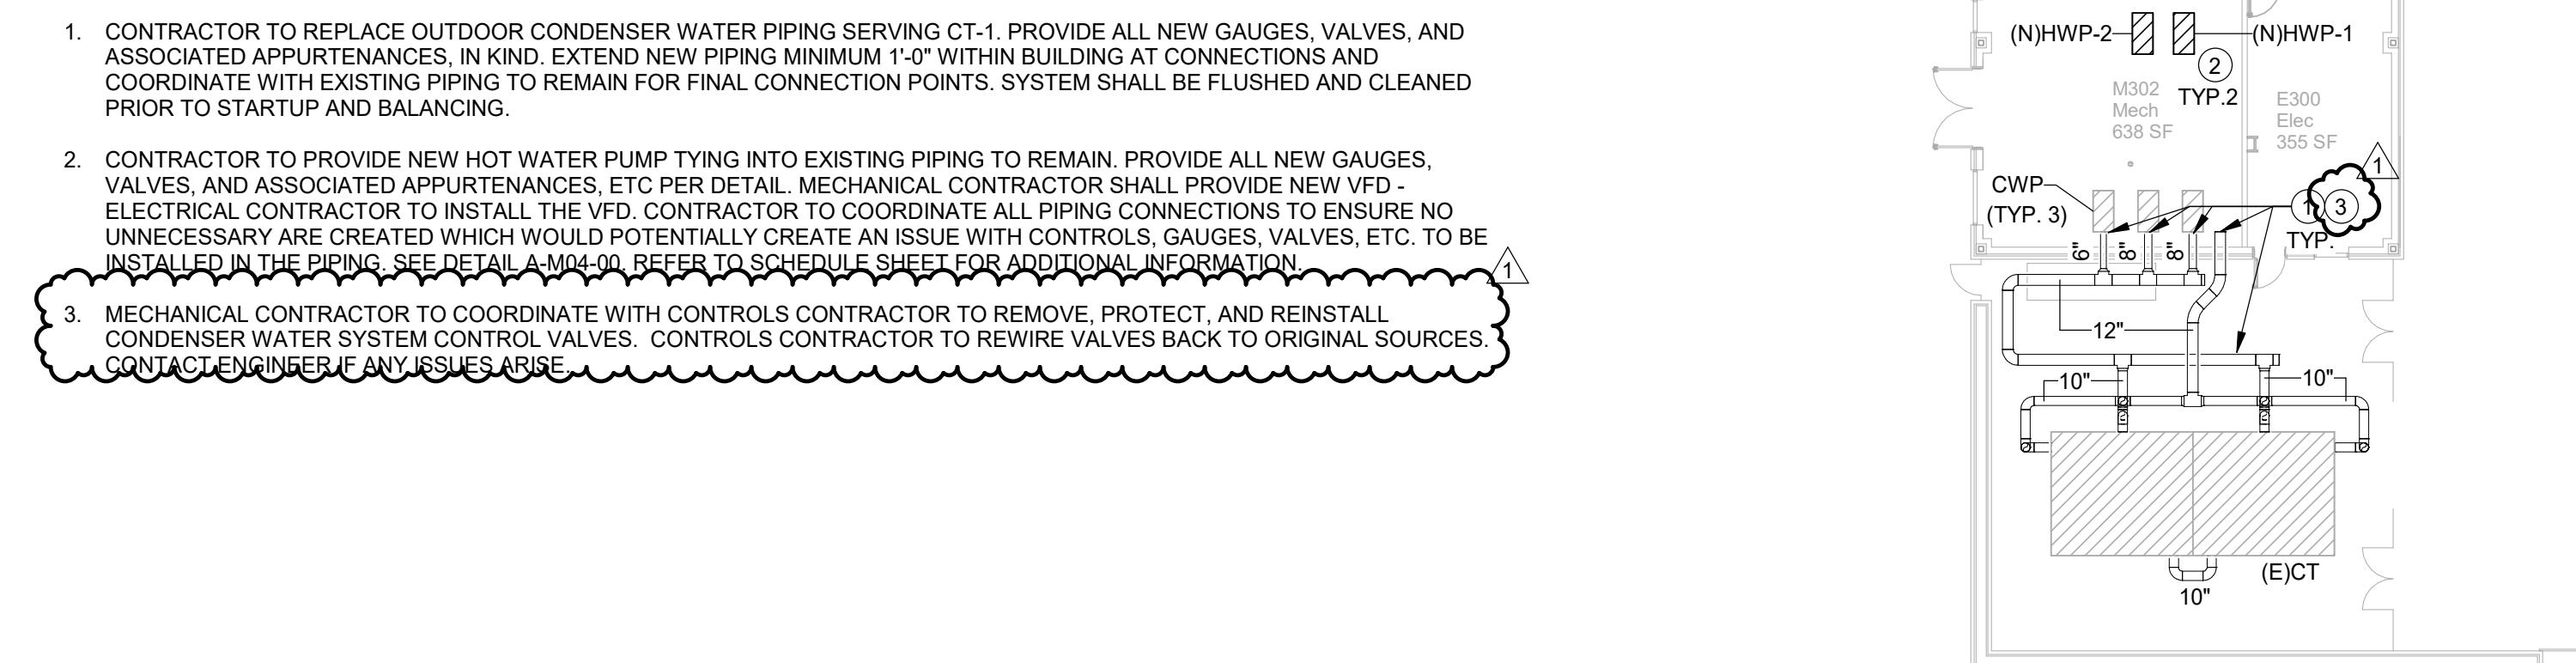

Date of issue:  
01.23.2026

SCHEDULE OF PUMPS												
DESIGNATION	SERVICE	LOCATION	CAPACITIES					ELECTRICAL			MANUFACTURER/SERIES BASIS FOR DESIGN	
			WATER TEMPERATURE °F	TYPE	DESIGN CONDITIONS GPM	DESIGN CONDITIONS HEAD - FT	SHUTOFF HEAD - FT	WORKING PRESSURE / PSIG	BHP	MOTOR HP	Volts/Phase/Hz	
HWP-1	BOILER	M392	180°	FRAME MOUNTED END SUCTION	264	100	125.8	150	936	1760	460/360	GRUNDFOS SERIES LF SIZE 25T-2.5x2x12
HWP-2	BOILER	M392	180°	FRAME MOUNTED END SUCTION	264	100	125.8	150	936	1760	460/360	GRUNDFOS SERIES LF SIZE 25T-2.5x2x12

## SCHEDULE OF PUMPS

CAPACIT


**NOTES:**

1. PROVIDE WITH PREMIUM EFFICIENCY VSD-RATED MOTOR. PROVIDE ELECTRICALLY INSULATED BEARINGS ON VSD DRIVEN MOTORS.
2. PUMP SHALL BE INSTALLED ON A NEW CONCRETE INERTIA BASE. PROVIDE VIBRATION ISOLATION RAILS, VARIABLE SPEED DRIVE (VSD), NECESSARY INTERFACE WITH EXISTING CONTROLLER.
3. ELECTRICAL DISCONNECT SHALL BE PROVIDED AND INSTALLED BY EC.
4. PROVIDE WITH ABB VSD, OR APPROVED EQUAL.
5. CONTROLS CONTRACTOR TO PROVIDE NEW CONTROLLERS AND SEQUENCE PER FBISD STANDARDS FOR NEW VARIABLE SPEED PUMP(S) AS REQUIRED. CONTROLS CONTRACTOR TO PROVIDE AND INSTALL NEW DIFFERENTIAL PRESSURE (DP) SENSOR. MECHANICAL CONTRACTOR TO COORDINATE LOCATIONS OF TAPS FOR DP SENSORS WITH CONTROLS CONTRACTOR. RECOMMEND TO BE INSTALLED APPROXIMATELY TWO THIRDS (2/3) TO THREE QUARTERS (3/4) DOWN STEAM OF PUMP(S).
6. CONTRACTOR SHALL VERIFY PUMP BODY DISCHARGE PIPING CONNECTION TO ENSURE ALIGNMENT WITH PIPING OR ADJUST PIPING AS REQUIRED WHILE MAINTAINING APPURTENANCES AS SHOWN IN THE DETAILS.

**FORT BEND ISD - BP048**  
**HVAC MEP WEST ZONE**  
**DAVID CROCKETT MS**  
**19001 REECHNIT ST**

1980 DECEMBER 81.  
RICHMOND, TX 77407

## KEYPLAN

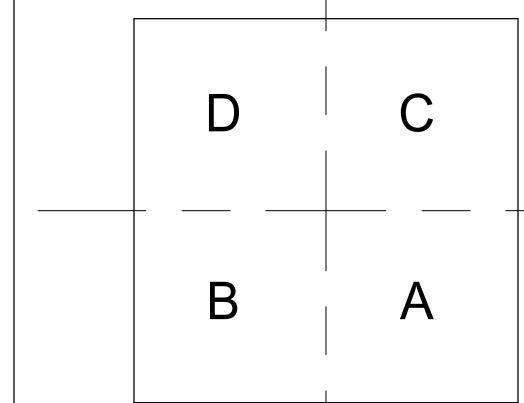

# MECHANICAL SCHEDULES

**Y**<sup>2</sup>  
ENGINEERING  
08 Reppart Place  
ouston, Texas 77008  
5-341-2168  
w.yw-squared.com  
Firm No. 22107  
ject No. 25027.00

**JOB** 25241.0000  
**DATE** 12/11/25  
**SHEET**

**C-M30-00**

A circular seal for a professional engineer. The outer ring contains the words "STATE OF TEXAS" at the top and "PROFESSIONAL ENGINEER" at the bottom. The inner circle features a five-pointed star in the center, with the name "KOUROSH M. YAZDANI" written across it. Below the name, the word "LICENSED" is written, and at the bottom of the inner circle, the date "01/23/2026" is stamped.

Date of issue:  
01.23.2026

# SCHEDULE OF COOLING TOWERS REFURBISHMENT

SCHEDULE OF COOLING TOWERS REFURBISHMENT												
DESIGNATION CT-	CAPACITIES							MISC.	ELECTRICAL		MANUFACTURER / SERIES BASIS FOR DESIGN	NOTES / REMARKS
	NUMBER OF CELLS	WATER QUANTITY PER CELL (GPM)	TOTAL QUANTITY WATER COOLED PER COOLING TOWER (GPM)	TOTAL TONS PER COOLING TOWER	ENTERING WATER TEMPERATURE °F	LEAVING WATER TEMPERATURE °F	AMBIENT WET BULB TEMPERATURE °F	NUMBER OF FANS PER CELL	NOMINAL FAN H.P. (460 VOLT)	BASIN HEATERS KW (PER CELL)		
CT-1	2	900	1800	600	96	86	80	1	25HP PER CELL	-	BALTIMORE AIRCOIL COMPANY	1 THRU 12

NOT

NOTES:

1. COOLING TOWER IS TO BE REFURBISHED.
2. PROVIDE TOWER FANS WITH ABB VARIABLE FREQUENCY DRIVE FOR EACH FAN MOTOR.
3. CLEAN, RESEAL, AND RECAULK COL WATER BASIN.
4. MOTOR, FAN AND BELT SHALL BE REPLACED. MOTOR SHALL HAVE A MAX RPM OF 1800.
5. FLOAT VALVE TO BE REPLACED. CONTRACTOR TO VERIFY MAKEUP WATER VALVE OPERATION WITH FLOAT AND INCLUDE MONIES WITHIN BID TO FIX AS NECESSARY.
6. FILL, DRIFT ELIMINATORS AND AIR INLET LOUVERS TO BE REPLACED.
7. LADDER SHALL HAVE A A 6FT EXTENSION ADDED.
8. REGREASE ALL BEARINGS, THOROUGHLY CLEAN INTERIOR AND EXTERIOR, AND REAPPLY PROTECTIVE COATING OF WETTED SURFACES.
9. FAN MOTOR STARTER SHALL BE NEMA 4X RATED.
10. PROVIDE A VIBRATION CUT-OUT SWITCH TO DE-ENERGIZE FAN MOTOR UPON EXCESSIVE VIBRATION.
11. PATCH AND REPAIR CASING PANELS.
12. EXISITNG BASIN HEATER SHALL REMAIN.

## SCHEDULE OF PUMPS

SCHEDULE OF PUMPS															
DESIGNATION	SERVICE	LOCATION	CAPACITIES					ELECTRICAL			MANUFACTURER SERIES BASIS FOR DESIGN				
			WATER TEMPERATURE °F	TYPE	DESIGN CONDITIONS GPM	DESIGN CONDITIONS HEAD - FT	SHUTOFF HEAD - FT	WORKING PRESSURE / PSIG	APPROXIMATE IMPELLER DIAMETER / IN.	BHP					
CWP-1	BUILDING CW	OUTDOOR MECH YARD	100°	FRAME MOUNTED END SUCTION	945	50	59.65	150	8.0	14.52	20	1760	460/3/60	GRUNDFOS SERIES LF SIZE 256T-65x9.5	1, 2, 3, 4, 5, 6, 7
CWP-2	BUILDING CW	OUTDOOR MECH YARD	100°	FRAME MOUNTED END SUCTION	945	50	59.65	150	8.0	14.52	20	1760	460/3/60	GRUNDFOS SERIES LF SIZE 256T-65x9.5	1, 2, 3, 4, 5, 6, 7

## NOTES


1. PROVIDE WITH PREMIUM EFFICIENCY VSD-RATED MOTOR. PROVIDE ELECTRICALLY INSULATED BEARINGS ON VSD DRIVEN MOTOR
2. PUMP SHALL BE INSTALLED ON A NEW CONCRETE BASE. PROVIDE VIBRATION ISOLATION RAILS, VARIABLE SPEED DRIVE (VSD), AND NECESSARY INTERFACE WITH EXISTING CONTROLLER.
3. ELECTRICAL DISCONNECT SHALL BE PROVIDED AND INSTALLED BY EC.
4. PUMP SHALL BE FULLY OUTDOOR RATED FOR GIVEN OPEN ENVIRONMENT.
5. PROVIDE WITH ABB VSD, OR APPROVED EQUAL.
6. CONTROLS CONTRACTOR TO PROVIDE NEW CONTROLLERS AND SEQUENCE PER FBISD STANDARDS FOR NEW VARIABLE SPEED PUMP(S) AS REQUIRED. CONTROLS CONTRACTOR TO PROVIDE AND INSTALL NEW DIFFERENTIAL PRESSURE (DP) SENSOR. MECHANICAL CONTRACTOR TO COORDINATE LOCATIONS OF TAPS FOR DP SENSORS WITH CONTROLS CONTRACTOR. RECOMMEND TO BE INSTALLED APPROXIMATELY TWO THIRDS (2/3) TO THREE QUARTERS (3/4) DOWN STREAM OF PUMP(S).
7. CONTRACTOR SHALL VERIFY PUMP BODY DISCHARGE PIPING CONNECTION TO ENSURE ALIGNMENT WITH PIPING OR ADJUST PIPING AS REQUIRED WHILE MAINTAINING APPURTENANCES AS SHOWN IN THE DETAILS.

SENSOR. MECHANICAL CONTRACTOR TO COORDINATE LOCATIONS OF TAPS FOR DP SENSORS WITH CONTROLS CONTRACTOR. RECOMMEND TO BE INSTALLED APPROXIMATELY TWO THIRDS (2/3) TO THREE QUARTERS (3/4) DOWN STEAM OF PUMP(S).

**FORT BEND ISD - BP048**  
**HVAC MEP WEST ZONE 3**  
**MACARIO GARCIA MS**  
**1855A01D BICLIMOND**

8330 OLD RICHMOND RD.  
SUGAR LAND, TX 77498

KEYPLAN

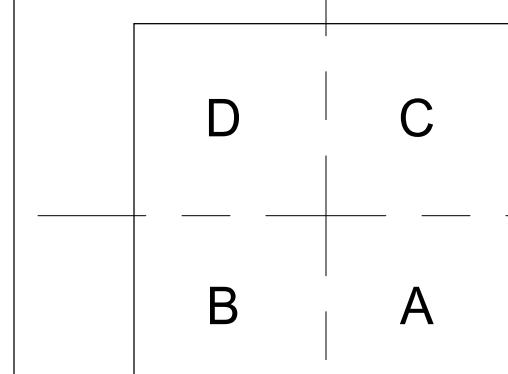

# MECHANICAL SCHEDULES

A circular seal for a Texas Professional Engineer. The outer ring contains the words "STATE OF TEXAS" at the top and "PROFESSIONAL ENGINEER" at the bottom, separated by a decorative border. A five-pointed star is positioned in the center. The name "KOUROSH M. YAZDANI" is printed in the center, above the signature. The signature "K. M. Yazdani" is written in cursive across the center. Below the signature, the word "LICENSED" is printed, and the date "01/23/2026" is printed at the bottom.

Date of issue:  
01.23.2026

## SCHEDULE OF COOLING TOWER

SCHEDULE OF COOLING TOWERS												
DESIGNATION CT-	CAPACITIES							MISC.	ELECTRICAL		MANUFACTURER / SERIES BASIS FOR DESIGN	NOTES / REMARKS
	NUMBER OF CELLS	WATER QUANTITY PER CELL (GPM)	TOTAL QUANTITY WATER COOLED PER COOLING TOWER (GPM)	TOTAL TONS PER COOLING TOWER	ENTERING WATER TEMPERATURE ° F	LEAVING WATER TEMPERATURE ° F	AMBIENT WET BULB TEMPERATURE ° F	NUMBER OF FANS PER CELL	NOMINAL FAN H.P. (460 VOLT)	BASIN HEATERS KW (PER CELL)		
CT-1	1	1200	1200	400	96	86	80	1	40HP	6	MARLEY / NC803TLN1	1 THRU 11

NOTES:

1. PROVIDE REMOTE MOUNTED VARIABLE FREQUENCY DRIVE FOR EACH FAN MOTOR. (ABB)
2. UNIT SHALL BE OF 304SS CONSTRUCTION WITH 316SS HOT AND COLD BASINS
3. PROVIDE GEAR DRIVE MOTOR OUTSIDE OF AIR STREAM.
4. PROVIDE TOWER WITH ACCESS DOOR AND MAINTENANCE LADDER WITH SAFETY CAGE.
5. PROVIDE A VIBRATION CUT-OUT SWITCH TO DE-ENERGIZE FAN MOTOR UPON EXCESSIVE VIBRATION. BY CONTROLS CONTRACTOR
6. PROVIDE WITH DAVIT, HOIST AND MOTORIZED WINCH CAPABLE OF LISTING THE FAN ASSEMBLY, GEAR, AND MOTOR.
7. PROVIDE WITH STRAINERS WITH ISOLATION VALVE ON INLET AND OUTLET AT EACH COOLING TOWER BASIN FOR CLEANING.
8. PROVIDE ACCESS PLATFORMS FOR EACH FAN MOTOR.
9. PROVIDE INTERNAL WALKWAYS INSIDE TOWER AS REQUIRED FOR MAINTENANCE TO REACH FLOAT VALVES.
10. PROVIDE WITH MECHANICAL FLOAT VALVE AND SWITCH. CONTROLS CONTRACTOR TO PROVIDE OBERFLOW SENSOR AND CONNECT ALARM TO BAS.
11. CONTROLS CONTRACTOR TO PROVIDE OIL-LEVEL SWITCH AND INCORPORATE IN TO BAS.

## SCHEDULE OF PUMPS

SCHEDULE OF PUMPS													
DESIGNATION	SERVICE	LOCATION	CAPACITIES					ELECTRICAL			MANUFACTURER/SERIES BASIS FOR DESIGN	NOTES/REMARKS	
			WATER TEMPERATURE °F	TYPE	DESIGN CONDITIONS GPM	DESIGN CONDITIONS HEAD - FT	SHUTOFF HEAD - FT	APPROXIMATE IMPELLER DIAMETER / IN.	BHP	MOTOR HP	RPM	VOLTS/PHASE/HZ	
HWP-1	BOILER	RM 1913	180°	FRAME MOUNTED END SUCTION	168	100	109.1	150	6.37	10	1760	460/3/60	GRUNDFOS SERIES LF SIZE 215T-2.5x2x12
HWP-2	BOILER	RM 1913	180°	FRAME MOUNTED END SUCTION	168	100	109.1	150	6.37	10	1760	460/3/60	GRUNDFOS SERIES LF SIZE 215T-2.5x2x12

## NOTES


NOTE:

1. PROVIDE WITH PREMIUM EFFICIENCY VSD-RATED MOTOR. PROVIDE ELECTRICALLY INSULATED BEARINGS ON VSD DRIVEN MOTORS.
2. PUMP SHALL BE INSTALLED ON A NEW CONCRETE INERTIA BASE. PROVIDE VIBRATION ISOLATION RAILS, VARIABLE SPEED DRIVE (VSD), NECESSARY INTERFACE WITH EXISTING CONTROLLER.
3. ELECTRICAL DISCONNECT SHALL BE PROVIDED AND INSTALLED BY EC.
4. PROVIDE WITH ABB VSD, OR APPROVED EQUAL.
5. CONTROLS CONTRACTOR TO PROVIDE NEW CONTROLLERS AND SEQUENCE PER FBISD STANDARDS FOR NEW VARIABLE SPEED PUMP(S) AS REQUIRED. CONTROLS CONTRACTOR TO PROVIDE AND INSTALL NEW DIFFERENTIAL PRESSURE (DP) SENSOR. MECHANICAL CONTRACTOR TO COORDINATE LOCATIONS OF TAPS FOR DP SENSORS WITH CONTROLS CONTRACTOR. RECOMMEND TO BE INSTALLED APPROXIMATELY TWO THIRDS (2/3) TO THREE QUARTERS (3/4) DOWN STREAM OF PUMP(S).
6. CONTRACTOR SHALL VERIFY PUMP BODY DISCHARGE PIPING CONNECTION TO ENSURE ALIGNMENT WITH PIPING OR ADJUST PIPING AS REQUIRED WHILE MAINTAINING APPURTENANCES AS SHOWN IN THE DETAILS.

**FORT BEND ISD - BP048**  
**HVAC MEP WEST ZONE 3**  
**HODGES BEND MS**

631 BISSONNE ISL.  
HOUSTON, TX 77083

## KEYPLAN

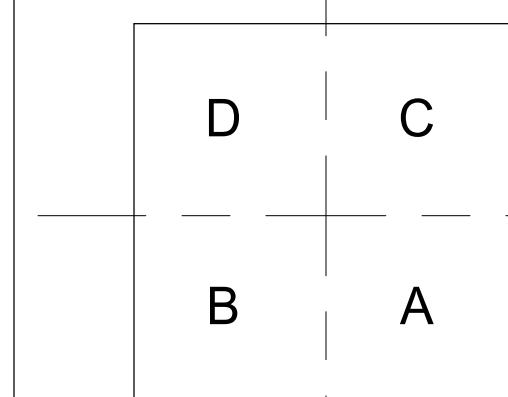

# MECHANICAL SCHEDULES

## Certificate Of Completion

Envelope Id: F48AF4E2-7B27-4495-8C83-1EFF9717889C

Status: Completed

Subject: Please DocuSign: 20260127- CSP 26-036KB - BP048 HVAC MEP West Zone 3 - Addendum No.02

Source Envelope:

Document Pages: 18

Signatures: 5

Envelope Originator:

Certificate Pages: 2

Initials: 0

Christine Manrique

AutoNav: Enabled

16431 Lexington Blvd

EnvelopeD Stamping: Enabled

Sugar Land, TX 77479

Time Zone: (UTC-08:00) Pacific Time (US & Canada)

christine.manrique@fortbendisd.gov

IP Address: 161.51.248.19

## Record Tracking

Status: Original

Holder: Christine Manrique

Location: DocuSign

1/27/2026 7:42:00 AM

christine.manrique@fortbendisd.gov

## Signer Events

Juan Valdez

cn\_juan.valdez@fortbendisd.gov

Security Level: Email, Account Authentication (None)

## Signature

 Signed by:  
Juan Valdez  
D65E219662EF4EE...

## Timestamp

Sent: 1/27/2026 7:46:27 AM

Viewed: 1/27/2026 7:48:13 AM

Signed: 1/27/2026 7:48:22 AM

Signature Adoption: Pre-selected Style

Using IP Address: 161.51.248.19

## Electronic Record and Signature Disclosure:

Not Offered via Docusign

Ryan Kiefer

ryan.kiefer@fortbendisd.gov

Security Level: Email, Account Authentication (None)

 Signed by:  
Ryan Kiefer  
1F973D1CC91A41D...

Sent: 1/27/2026 7:48:24 AM

Viewed: 1/27/2026 7:50:03 AM

Signed: 1/27/2026 7:50:55 AM

Signature Adoption: Pre-selected Style

Using IP Address: 161.51.248.19

## Electronic Record and Signature Disclosure:

Not Offered via Docusign

Brenda Garcia

brenda.garcia@fortbendisd.gov

Director of Construction

Security Level: Email, Account Authentication (None)

 Signed by:  
Brenda Garcia  
F7F6BD96D7C742E...

Sent: 1/27/2026 7:50:58 AM

Viewed: 1/27/2026 7:54:17 AM

Signed: 1/27/2026 7:54:24 AM

Signature Adoption: Pre-selected Style

Using IP Address: 161.51.248.19

## Electronic Record and Signature Disclosure:

Not Offered via Docusign

Daniel Bankhead

daniel.bankhead@fortbendisd.gov

Exec. Dir.

Security Level: Email, Account Authentication (None)

 Signed by:  
Daniel Bankhead  
AABFCACAF7E9453...

Sent: 1/27/2026 7:54:28 AM

Viewed: 1/27/2026 11:28:22 AM

Signed: 1/27/2026 11:31:47 AM


Signature Adoption: Pre-selected Style

Using IP Address: 107.77.221.53

Signed using mobile

## Electronic Record and Signature Disclosure:

Not Offered via Docusign

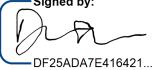Signer Events	Signature	Timestamp
Doris Emeka Onyenwe doris.emekaonyenwe@fortbendisd.gov Security Level: Email, Account Authentication (None)	 Signed by: DF25ADA7E416421...	Sent: 1/27/2026 11:31:52 AM Viewed: 1/27/2026 11:35:20 AM Signed: 1/27/2026 11:37:37 AM
<b>Electronic Record and Signature Disclosure:</b> Not Offered via DocuSign		
<b>In Person Signer Events</b>		
Editor Delivery Events	Status	Timestamp
Agent Delivery Events	Status	Timestamp
Intermediary Delivery Events	Status	Timestamp
Certified Delivery Events	Status	Timestamp
Carbon Copy Events	Status	Timestamp
Jane Thompson cn_jane.thompson@fortbendisd.gov Executive Assistant to Daniel Bankhead Fort Bend ISD Security Level: Email, Account Authentication (None)	<b>COPIED</b>	Sent: 1/27/2026 7:54:28 AM
<b>Electronic Record and Signature Disclosure:</b> Not Offered via DocuSign		
Antoinette Lewis Antoinette.Lewis1@fortbendisd.gov Security Level: Email, Account Authentication (None)	<b>COPIED</b>	Sent: 1/27/2026 11:37:39 AM
<b>Electronic Record and Signature Disclosure:</b> Not Offered via DocuSign		
Kathleen Booker Kathleen.Booker@fortbendisd.gov Security Level: Email, Account Authentication (None)	<b>COPIED</b>	Sent: 1/27/2026 11:37:39 AM Viewed: 1/27/2026 11:39:00 AM
<b>Electronic Record and Signature Disclosure:</b> Not Offered via DocuSign		
Witness Events	Signature	Timestamp
Notary Events	Signature	Timestamp
Envelope Summary Events	Status	Timestamps
Envelope Sent Certified Delivered Signing Complete Completed	Hashed/Encrypted Security Checked Security Checked Security Checked	1/27/2026 7:46:27 AM 1/27/2026 11:35:20 AM 1/27/2026 11:37:37 AM 1/27/2026 11:37:39 AM
Payment Events	Status	Timestamps