

11 Greenway Plaza Suite 2210 Houston, Texas 77046-1104 Telephone: 713/965-0608 Fax: 713/961-4571

ADDENDUM NO. 01 June 24, 2025

To Drawings and Specifications dated June 10, 2025.

PKG 3A – GPHS New Fieldhouse

Prepared by:	PBK
	11 Greenway Plaza, 22 nd Floor
	Houston, TX 77046-1104
	PBK Project No: 240539

Notice to Bidders

- A. Receipt of this Addendum shall be acknowledged on the Bid Form.
- B. This Addendum forms part of the Contract documents for the above referenced project and shall be incorporated integrally therewith.
- C. Each bidder shall make necessary adjustments and submit his proposal with full knowledge of all modifications, clarifications, and supplemental data included therein. Where provisions of the following supplemental data differ from those of the original Contract Documents, this Addendum shall govern.

GENERAL

Item No. 01 Pre-proposal Conference Sign in Sheet – Refer to Attachment

Item No. 02 CSP 25-500 Phase 3A GPHS New Fieldhouse Bid Package Volume 01 – Refer to revised pages.

- 1. Revisions to proposal time for Alternate Bid, Unit Prices, Subcontractors list and Small Business percentage form.
- 2. Alternate 1B added to the Alternates Proposal page and revision to alternate 2C.
- 3. Revisions to Alternate discrepancy:
 - Base Proposal Reduction

Item No. 03 Pre-proposal Questions

Question 01: Can Contractors submit the following on July 15 at 3PM?

- 1. Unit prices
- 2. Alternates
- 3. Subcontractors listing
- 4. Small Business Percentage Form
- i. Response: Yes.

Question 02: Base bid adjustment alternate is also labeled #05.

i. Response: Base bid alternate number has been revised to #06.

- Question 03: What is the status of permit?
 - i. Response: Permit is approved and is waiting at City of Galena Park for Contractor to obtain and pay permit fees.
- Question 04: When would Notice to Proceed be given?

i. Response: August 25, 2025 as outlined in Volume 01.

Question 05: Are there any other Contractors working at Galena Park HS?

i. Response: Phase 02 Contractor is wrapping up warranty period within next month.

Question 06: Bid Bond Form references a Proposal Bond form being part of the proposal documents, can a contractor use AIA form?

i. Response: Please use the AIA form for bid bond.

Question 07: How are qualification documents should be submitted?

- i. Response: Documents shall be emailed to <u>facilities@galenaparkisd.com</u>.
- Question 08: How is our cost proposal/bid containing cost information to be submitted?
 - i. Response: Bids can be certified mailed or must be hand-delivered to Sydney Mckay NOT the receptionist.
- Question 09: On page 18 of Volume 01, there is a discrepancy between the documents regarding the percentage of bid bond. What is the correct percentage
 - i. Response: Bid Bond is 10%, this will be revised in Volume 01.
- Question 10: Can Contractors walk the jobsite?
 - i. Response: Yes, please reach out to Galena Park ISD for access, the existing building sitting on New Fieldhouse site will be demolished and cleared prior to issuing NTP.
- Question 11: What do you mean by substantial completion date and final completion date?
 i. Response: June 10, 2026, is the Substantial Completion date and Final Completion includes the Warranty period.
- Question 12: What happens if we have questions on July 7 and we get a late response?
 - Response: All questions pertaining to Qualification Documentation will be answered on or before July 8.
- Question 13: How many addendums do you anticipate to issue?
 - i. Response: We anticipate issuing a total of 3 addenda, with final addendum scheduled for release on July 9,2025. However, bidders are advised to monitor lon Wave regularly, as additional addenda may be issued if necessary.
- Question 14: Do you expect us to submit a flash drive? What should be included in the flash drive?
 - i. Response: Please DO NOT include cost-related information on the flash drive. All Pre-Qualification documents can be submitted on a flash drive.
- Question 15: Is the final signature on Ion Wave mandatory?
- i. Response: No, Ion Wave is used for communication only.
- Question 16: What is the lead time for DIRTT wall system?
- i. Response: Contact Heather Kenney for additional information <u>hkenney@dirtt.com</u>
- Question 17: Spec section 11 66 13 is missing. Please Advise.
 - i. Response: Missing spec attached.

i.

- Question 18: Does the packet that is due 7/8/25 need to be submitted in the same format as the final proposal? 1 hard copy and 1 electronic copy in a sealed envelope?
 - i. Response: They are submitted digitally to <u>facilities@galenaparkisd.com</u> GPISD will have them printed and available for evaluation.
- Question 19: Can you please send us the link where we can see the plans.
 - i. Response: Per the District's Bid Opportunity Detail, please refer to bidding documents here <u>https://galenaparkisd.ionwave.net/PublicDetail.aspx?bidID=287&SourceType=1</u>
- Question 20: Related to pages 34 & 35 of Vol. 1 RFP Unit Rates and Subcontractor Listing: Please clarify what is meant by "line excluded from response total".
 - i. Response: The unit price should not be added to the total bid amount. It will be evaluated on its own-separate from the total cost.
- Question 21: We are an approved vendor with Galena Park ISD. I was wondering if you have selected a testing lab for the construction materials testing for this project?
 - i. Response: Geotechnical studies were done by UES. UES is being considered as a potential CMT provider pending final approval
- Question 22: I'm a fire alarm sales rep for Johnson Controls and I am interested in bidding this project. Would you be able to point me towards the general contractors that will be bidding this, and if you have it, their contact information as well? Any help is greatly appreciated as I'm having issues accessing the bid package.
 - i. Response: Bidder's list attached for Contractor information.
- Question 23: Where should questions about the project be directed to?
 - Response: Bidders shall email questions ONLY to <u>facilities@galenaparkisd.com</u>. Do not email Gloria Carlos as listed in the RFP.

SPECIFICATIONS

Item No. 1

Revision to Project Manual Cover Sheet

A. Revision to Board of Trustees and Superintendent of Schools:

Item No. 2 Revision to 01 23 00 Alternates:

- A. Alternate No. 1 B: 23 09 23 Direct Digital Controls Unify Energy Solutions
 - This Alternate shall establish the amount to adjust the Base Proposal for the cost of furnishing and installing Direct Digital Controls manufactured by Reliable Controls – Installed by Unify Energy Solutions. This alternate shall include the pricing for all materials and labor for proper completion. Refer to specs and drawings for additional information.
- B. Alternate Number 2C: 23 52 16 Condensing Boilers Patterson Kelley
 - This Alternate shall establish the amount to be added to the Base Proposal for the Contractor to furnish Condensing Boilers, manufactured by **Patterson-Kelley – Senic** <u>Solis</u> model as shown and scheduled on the drawings and as specified. Alternate boiler price shall include warranty as specified per 1.9.

ng
n

A. Issued specification in its entirety.

- Item No. 4 11 66 13 Exercise Equipment:
 - A. Issued specification in its entirety.

Item No. 5 Revision to 27 10 00 – Structured Cabling System:

- A. 1.2 QUALITY ASSURANCE
 - A. Acceptable manufacturers:
 - 2. Acceptable product manufacturers shall provide a complete category 6 solution as manufactured by Panduit <u>or Commscope</u> only. No other manufacturers will be allowed.

Item No. 6 27 42 20 –

27 42 20 – Smart Restroom Systems:

- A. Issued specification in its entirety.
 - Clarification of 'OL' and related devices indicated on sheet T-001 Technology System Notes and Legends, TN-101 - 1st Floor Technology Plan, And TN-102 - 2nd Floor Technology Plan.

DRAWINGS

<u>CIVIL</u>

Item No. 01 C003 -Demolition Plan

- A. 11'-6"x 20'-9" pavement and 11'-6" LF curb on both sides of the pavement to be removed at east of the fire lane.
- B. 18'-6"x 8'-0" sidewalk to be removed.

Item No. 02 C101 -Site Plan

- A. The direction of the gate swing changed towards the equipment yard.
- B. Add conc. sidewalk width by 5'-3" on southeast corner of the building north of fire lane.
- C. Handicap Ramps added. Item No. 06: Add 56'-0"x 2'-0" mow strip.

Item No. 03 C201 -Drainage and Utility Plan

A. Change 18" Storm sewer pipe length to 88LF from 98LF.

C301 -Grading and Paving Plan

A. Updated grading as shown.

Item No. 05 C501 -Details

Item No. 04

A. Mow strip and sidewalk ramps details added.

STRUCTURAL

	S-101 Foundation Plan
	Adjusted column sizes at A-6 and A-7.
	Adjusted footing sizes at E-5 and E-6.
	Changed section provided along grid A.
Item No. 02	S-102 Second Floor Framing Plan
Α.	· · · J · · · · · · · · · · · · · · · · · · ·
В.	· · · J · · · · · · · · · · · · · · · ·
Item No. 03	S-103 Roof Framing Plan
	Adjusted beam sizes as shown on plan.
	Added camber values to beams bearing folding partitions as shown on plan.
Item No. 04	- · · · · · · · · · · · · · · · · · · ·
	Provided BOD elevations along perimeter.
Item No. 05	
	Provided footing information per finalized soil report.
В.	- F
Item No. 06	
	Modified detail 1/S-311.
Item No. 07	
	Modified detail 1/S-320.
Item No. 08	· · · · · · · · · ·
	Modified detail 6/S-512.
Item No. 09	
	Modified detail 5/S-524.
B.	
-	Modified detail 9/S-524.
Item No. 10	- · · · · · · · · · · · · · · · · · · ·
A.	Provided brace loads to each brace elevation.

<u>DIRTT</u>

ltem No. 01	DW100.7 HIGHLIGHTED PLAN FIRST FLOOR
А.	DIRTT walls thickness changes from 4" to 6" thick
ltem No. 02	DW100.8 HIGHLIGHTED PLAN SECOND FLOOR
А.	DIRTT walls thickness changes from 4" to 6" thick
ltem No. 03	DW400.1 TYPICAL WALL DETAILS
А.	Typical wall section for 4" and 6" DIRTT walls were added

ARCHITECTURAL

Item No. 01 G-000 COVERSHEET

A. Revision to Board of Trustees and replaced in its entirety.

Item No. 02 AS-100 OVERALL SITE PLAN

- A. Added mow strip at new fence at the north side of the site by the existing field house
- B. Added note to demolish portion of existing sidewalk and replace with sod
- C. Reversed the swing direction of gate 1908F
- D. Extended the new sidewalk on the south side out to the existing fence
- E. Added curb cuts at relocated gate
- F. Revised the radius of the fire lane and provided dimensions
- G. Miscellaneous graphic cleanup (not clouded)

Item No. 03 A-101 LEVEL 1 – FLOOR PLAN

A. Added demountable partition wrap at column C/9, refer to DW-100.1.

- B. Relocated F.E.C. at custodial 1906.
- C. Revised partition dt-6 to be DT-4 at Staff RR 1926 and hydrotherapy.
- D. Added 4" concrete base below lockers at south of freshman + JV lockers 1904 and soccer locker 1916.

Item No. 04

A-102 LEVEL 2 – FLOOR PLAN

- A. Added callout for detail 10/A-701.
- B. Added notes at operable partition pockets.
- C. Added DT-2 partition at south side of elevator.
- D. Revised partition DT-6 to be DT-4 at kitchen east wall and back of operable partition pocket.

Item No. 05 A-301 OVERALL ROOF PLANS

A. Callouts to 15/A-322 added to roof plan

Item No. 06 A-411 ENLARGED TOILET PLANS

A. Grab bars added to control wall and dimensions revised to show compliance with standard rollin shower.

Item No. 07

- A-422 ELEVATOR PLANS & SECTIONS
 A. Added DT-2 partition at south side of elevator.
- B. Added callout for detail 10/A-851.
- C. Revised notes and on detail 03.
- D. Added detail 06.

Item No. 08 A-501 EXTERIOR ELEVATIONS

- A. Added 4" concrete curb under storefront windows.
- B. Revised keynote legend.
- C. Revised specification numbers on details 02, 03, & 04.
- Item No. 09

A-621 WALL SECTIONS

A. Revised detail 01.

Item No. 10 A-711 WALL SECTION DETAILS

A. Revised detail 13.

Item No. 11 A-712 STOREFRONT DETAILS

- A. Added detail 12.
- Item No. 12 A-810 DOOR SCHEDULE

A. Revised door e1000a information.

Item No. 13 A-900 FINISH SCHEDULE

- A. Updated Epoxy flooring to 09 67 00.FF1
- B. Added new Epoxy flooring 09 67 00.FF2

Item No. 14 A-901 LEVEL 1 OVERALL FINISH PLAN

- A. Updated finish flooring in the Athletic Locker Rooms
 - B. Updated floor finish legend

Item No. 15 A-902 LEVEL 2 OVERALL FINISH PLAN

A. Updated floor finish legend

<u>MECH</u>

Item No. 01 M-101 - 1ST FLOOR MECHANICAL PLAN

- A. Missing thermostat added for FCU in Riser Rm-1907.
- B. Added keynote 14 stating "ALL OUTDOOR REFRIGERANT PIPING SHALL BE WRAPPED WITH ALUMINUM JACKET. PROVIDE WALL SUPPORTS AT EVERY 3' INTERVALS" to refrigerant piping of ACCU-1907
- C. Now showing housekeeping pad for ACCU-RISER RM-1907. Also added the following to keynote 13: "GC TO COORDINATE PAD DIMENSIONS AND LOCATIONS"

Item No. 02 M-102 – 2ND FLOOR MECHANICAL PLAN

- A. <u>Replace drawing in its entirety</u>. Shifted RTU-2-02 to clean up the ductwork and hydronic piping on the second floor.
- B. Added barometric damper symbol to RH-01.

Item No. 03 M-201 – MECHANICAL ENLARGED PLAN

- A. Corrected B-01 dimensions on the enlarged plan.
- B. Added the following line to keynotes 3, 4, 7, 8, 9, and 11: "GC TO COORDINATE PAD DIMENSIONS AND LOCATIONS".
- C. Now showing housekeeping pads for B-01, ACCU-1913, and ACCU-01.

Item No. 04 M-301 – ROOF MECHANICAL PLAN

- A. Replace drawing in its entirety.
 - 1. Shifted RTU-2-02 to clean up the ductwork and hydronic piping on the second floor. Updated routing of hydronic piping and condensate drain line.

M-501 – MECHANICAL SCHEDULES

- A. Replace drawing in its entirety.
 - 1. Schedule notes 12,13 for the scroll air-cooled chiller schedule did not print in the permit set and now have been added. They included the following:
 - 2. Provide factory installed heat trace for evaporator. Electrical contractor shall provide separate 120/1/60 circuits to the evaporator.
 - 3. Provide unit with multiple refrigerant circuits.
- B. Schedule notes 16-19 for the packaged outdoor air handling unit schedule did not print in the permit set and now have been added. They include the following:
 - 1. Provide access door on the opposite side of the piping connection.
 - 2. Provide with outside air intake rain hood.
 - 3. Provide 14" tall insulated and full perimeter fully welded wind rated curb with hold down brackets; structurally calculated to meet the wind requirements of the 2018 IBC rated for 155 mph, three second gust. Manufacturer to provide signed and sealed drawings by professional engineer of the rated assembly. Curb shall be provided by the manufacturer and not by others.
 - 4. Provide acoustical style roof curbs with BRD acoustical roof curb treatment; refer to detail and specification.
- C. Updated RTU-1-01 and RTU-1-02 after the initial units were failing the ComCheck.

Item No. 06

Item No. 05

M-502 – MECHANICAL SCHEDULES

A. Removed schedule note 5 from electric unit heater schedule requiring powder coated epoxy finish for corrosive environments.

<u>ELEC</u>

Item No. 01 E301 – ELECTRICAL ROOF PLAN

A. Updated location of RTU-2-02 to conform with mechanical.

Item No. 02 E701 – ELECTRICAL PANEL SCHEDULES

A. Updated breakers and load for RTU-2-01 and RTU-2-02 to conform with update mechanical loads

PLUMBING

Item No. 01 P1

P101 – 1ST FLOOR PLUMBING PLAN

- A. Shifted piping into new plumbing chase for sink in Training Room 1917 to match architectural background.
- B. Updated piping serving showers in Coaches RR 1957A on level 2 to match architectural background.

Item No. 02 P102 – 2ND FLOOR PLUMBING PLAN

- A. Shifted piping into relocated plumbing wet wall for RR 1964 and RR 1965 to match architectural background.
- B. Updated piping serving showers in Coaches RR 1957A to match architectural background.



END OF ADDENDUM NO. 01

06/24/2025





PKG 3A – GPHS New Fieldhouse GALENA PARK INDENDENT SCHOOL DISTRICT

GPISD Project Number: 002.3-2025 PBK Project Number: 240539

PRE-PROPOSAL CONFERENCE

SIGN-IN SHEET

Tuesday, June 24, 2025 at 10:00 A.M.

<i>a</i>	Name	Company	Phone	Email
01	Pete Galyean	GTTFAC	281-441-8282	paalyean ogt construction con
02	Vin Salinas	Satterfiel' Pontikes		Vsalinas@Satpon.com
03	Jesus Ratlikk	C. A Walker Construe	832-974-692	Bids @ Cawalker. Net
04	Alexis Delardo	Pivision One Constr.		
05	Aumkar Paradkar	S&P	713-496-1360	houstonbids @ satpon.com
06	TED TOU	Patriot	832 746 0934	
07	Swino Malik	Dunhill	713 823-9210	p smalik@dunhillcustruction.com
08	Chris Youmans	BESS CONSTRUCTION		Bidse Bass Construction.com
09	Warnen Parlar	Bartlett-Cecke	713-570-1489	Bidture Bartlettacke. rain
10	Jaxson Lyness	Millennium	832-995-6448	Estimating @mps-tam. com
11	Jake Crain	Crain Group	713-436-8727	bids @ craingroup.com
12	John itom 567	INDI	346-456-922	D & JHOFASBY @ ENDICONSTRACT
	Mitchell McCashlud	M Scott Constantian	281-250-3623	mitchell@mscottionstruction.com
14	Brandon Assoncas	Stp	713-496-1300	houston bids@ satpon.com
15	Pam Haynes	Gamma		phaynes c gamma const. con
16	Mark Nethersole	TYP	832-763-160	moethersie & texuspride disput kon
17				· · · · ·
18				
19				
20				
21				
22				
23				
24				





PKG 3A – GPHS New Fieldhouse GALENA PARK INDENDENT SCHOOL DISTRICT

GPISD Project Number: 002.3-2025 PBK Project Number: 240539

PRE-PROPOSAL CONFERENCE

SIGN-IN SHEET

Tuesday, June 24, 2025 at 10:00 A.M.

	Name	Company	Phone	Email
01	Alex Urbina,	J.C.I Construct	281-355 61 5151	bids @ iciconstruction inc.com
02	Jose E. Gowzalez	Bortlett, Cocke General Centrater	346-718-06-7/	jon jonzaleze bartletacke. com
03	Nestor Gonzalez	C.A. Walker	713-956-7070	bids@cawalker.ne+
04	Sydney McKey	GPISD	X1020	SMC Kay @ galeneupullisd can
05	Luis Pieraldi	E Contrectors	713-493-2500	LPieraldi @ econtractors com
06	Daniella quaimare	Dunhill Construction	281-4082748	dquaimare@dunhillconstruction.com
07	Roger Graham -	opw.ter	\$32-655-3051	roger @topunteres/1c.com
08	Bleck Ptope	1.0	219 877 7126	Billtodes @ SATPOH. COM
09	Shellic Natha	Bartlett Cocke	281. 725.805	-Shathore bartlettoacke, com
10	Marlon Kluxray	Acutera	715-837-6558	marin Olvariz Ony accetet ion
11	EUGONE MARTINEZ	Accutek	713-391-5418	Eugene, MANTINEZ EMYaccutt, com
12	RAUL CAUDEIZA	NASH	281-829-4815	BIDS@NASH WOUSTRIESINC. Com
13	PRASAD NUNNAR	STERCING STRUCTURES	73.827 7447	BEUS & Staly strekeres com
14	Leon Horn	American Fence	281-932-6598	lean harn @ omencen fence can
15	Rickey Treat	Comer Corp	281 479 2322	RickeyT@comexcorp.com
16	Cristian Rodriguez	prymalla	979-732-573	
17	Connor McMarrows	AMISYS	612-839-7610	CONNOT @ AMISYS. LOM
18	Will pap	MPS		Estimating & My - fram. con
19	PHILLIP CANO	PRIVE CONTENCTOR:	2819990875	estimating @ prime contractorsinc.com
20	JASON F. GARCIA	ADS Custom Signs	713 943 0895	Marilyn @ artwingraphics.com
21	Billy Carroll	Corregos	346-353-4771	benrolle congurus.con
22	Mohammad Zaidi	Congar USA	832-457-504	mzaidia) congarwa.com
23				J
24				

Base Proposal Information

CSP #25-500Project:Galena Park High School Phase 3A - New FieldhouseType:Competitive Sealed ProposalIssue Date:June 15, 2025Question Deadline:July 7, 2025 @ 10:00 AMResponse Deadline:July 9, 2025

25-500 PROPOSAL Close Date and Time: July 15, 2025 @ 2:00 PM

Galena Park Independent School District (GPISD) is requesting **Competitive Sealed Proposals** (CSP 25-500) for Galena Park High School Phase 3A (GPISD Project B104-002.3-2025. Proposals are due on July 15, 2025. Base Proposal at 2:00 PM and Alternate Proposal at 3:00 PM. After which proposals will be opened publicly and read aloud at 3:00 PM at the GPISD Administration Building. Submissions must be delivered to the Facility Planning & Construction Department in the GPISD Administration Building, 14705 Woodforest Blvd., Houston, TX 77015, in a sealed envelope by the close date and time stated in this bid event. A Proposal Security in the amount of ten percent (10%) of the proposal amount is required.

The scope of work includes: Approximate Built up area 34,000 SF, two-story Field House including site works

A pre-proposal conference will be held at the **GPISD Administration Building**, on June 24, 2025 at 10:00 AM. Attendance is highly recommended.

Proposal Documents will be available on June 15, 2025 @ 10:00 AM on the district website, and on the GPISD eBid system https://galenaparkisd.ionwave.net.

GPISD reserves the right to reject any and all proposals, the right to negotiate with any proposers after submission of proposals, and at its discretion, may waive any formalities or minor irregularities regarding the proposals.

10. PROPOSAL BOND FOR BUILDING CONSTRUCTION CONTRACTS

Proposal Bond for Building Construction Contracts

A. Each individual Proposal package submitted must be accompanied by Bid Bond made payable to Owner in an amount of ten percent (10%) of the Proposal price (for Proposal bond purposes, the Proposal price shall include the base Proposal, plus all alternates; however, the Contract price shall be as awarded by Galena Park Independent School District). Proposal Bond shall be in the form of a Cashier's Check or a Proposal Bond, duly executed by proposer as principal and having as surety thereon, a corporate surety company duly authorized and admitted to do business in the State of Texas and licensed by the State of Texas to issue such bond, as a guarantee that the proposer will enter into a Contract and execute required Performance and Payment Bonds within ten (10) days of Galena Park Independent School District.

B. Each Proposal must be accompanied by information establishing that the agent signing the bond is authorized to write the bond in the amount requested, and if applicable, that reinsurance requirements, have been met, including limits and ratings or other evidence of company solvency.

C. Proposer must demonstrate to Owner that he can secure required bonds, issued by a corporate surety company authorized and admitted to do business in the State of Texas and licensed in the State of Texas to issue such bond, which bonds shall be written in the form contained in the Project Manual without modification.

Alternate Proposal Lines

ALTERNATES PROPOSAL

Alternate No. 1 A: Direct Digital Controls – Automated Logic Corporation (Response required)

	\$
Alternate No. 1 B: Direct Digital Controls – Unify Energy Solutions (Response required)	\$
Alternate No. 2A: Condensing Boilers - RBI (Response required)	\$
Alternate No. 2B: Condensing Boilers - Raypak (Response required)	\$
Alternate No. 2C: Condensing Boilers – Patterson – Kelley – Solis (Response required)	♥ model
	\$
Alternate No. 2D: Condensing Boilers - Camus (Response required)	
	\$
Alternate No. 3A: Scroll Water Chillers Air-Cooled – Trane - Extend	ed Warranty

(Response required)

\$_____

Alternate No. 3B: Scroll Water Chillers Air-Cooled – Carrier- Extended Warranty (Response required) \$_____ Alternate No. 3C: Scroll Water Chillers Air-Cooled – JCI Extended Warranty (Response required) \$_____ Alternate No. 4A: Packaged, Outdoor, Central-Station Hydronic Air-Handling Units – Carrier (Response required) \$____ Alternate No. 4B: Packaged, Outdoor, Central-Station Hydronic Air-Handling Units – Trane (Response required) \$_____ Alternate No. 4C: Packaged, Outdoor, Central-Station Hydronic Air-Handling Units – JCI (Response required) \$ Alternate 4D: 23 74 13.16 – Packaged, Outdoor, Central-Station Hydronic Air-Handling Units – Temtrol (Response required) \$_____ Alternate No. 5: Provide metal stud partition assemblies and accessories in lieu of Integrated Interior Assemblies (Section 13 42 75) per guidelines listed below (Response required) \$

Base Proposal Reduction –

• Item Notes: If there is a discount to the Base Proposal enter the amount here

\$



Project Manual

for

PKG 3A – GPHS New Fieldhouse

PBK Project No.: 240539 Galena Park Project No.: 002.3-2025

for the

GALENA PARK INDEPENDENT SCHOOL DISTRICT

10 June 2025

Issue for Proposal

VOLUME 2



Project Manual

for

PKG 3A – GPHS New Fieldhouse

PBK Project No.: 240539 Galena Park Project No.: 002.3-2025

for the

GALENA PARK INDEPENDENT SCHOOL DISTRICT

10 June 2025

Issue for Proposal

VOLUME 2

Board of Trustees

Ramon Garza Linda Clark Sherrard Jose Jimenez Adrian Stephens Noe Ezparza Norma Hernandez Amanda Erebia Dr. John C. Moore President Vice President Secretary Trustee Trustee Trustee Superintendent of Schools



Project Manual

for

PKG 3A – GPHS New Fieldhouse

PBK Project No.: 240539 Galena Park Project No.: 002.3-2025

for the

GALENA PARK INDEPENDENT SCHOOL DISTRICT

10 June 2025

Issue for Proposal

VOLUME 2

Team

Architect PBK 11 Greenway Plaza Blvd, 22nd Floor Houston, Texas 77046 Phone: (713) 965-0608

MEP

LEAF Engineers 11 Greenway Plaza Blvd, 15th Floor Houston, Texas 77046 Phone: (713) 940-3300 **Structural** Kubala Engineers 11 Greenway Plaza Blvd, Ste. 1510 Houston, Texas 77046 Phone: (713) 940-3343

Facilities

BEAM Professionals 11 Greenway Plaza Blvd, 15th Floor Houston, Texas 77046 Phone: (713) 965-0608 Civil

DIG Engineers 11 Greenway Plaza Blvd, Ste. 1520 Houston, Texas 77046 Phone: (346) 308-9036

Landscape

Edgeland Group 11 Greenway Plaza Blvd, 15th Floor Houston, Texas 77046 Phone: (713) 460-0988

SECTION 01 23 00 - ALTERNATES

PART 1 - GENERAL

1.1 RELATED DOCUMENTS

A. Drawings and general provisions of the Contract, including General and Supplementary Conditions and other Division 01 Specification Sections, apply to this Section.

1.2 SUMMARY

A. Section includes: Administrative and procedural requirements for alternates.

1.3 **DEFINITIONS**

- A. Alternate: An amount proposed by bidders and stated on the Bid Form for certain Work defined in the bidding requirements that may be added to or deducted from the base bid amount if Owner decides to accept a corresponding change either in the amount of construction to be completed or in the products, materials, equipment, systems, or installation methods described in the Contract Documents.
 - 1. Alternates described are part of the Work when enumerated in the Agreement.
 - 2. The cost or credit for each alternate is the net addition to or deduction from the Contract Sum to incorporate alternate into the Work. No other adjustments are made to the Contract Sum.

1.4 **PROCEDURES**

- A. Coordination: Revise or adjust affected adjacent Work as necessary to completely integrate Work of the alternate into Project.
 - 1. Include as part of each alternate, miscellaneous devices, accessory objects, and similar items incidental to or required for a complete installation whether or not indicated as part of alternate.
- B. Notification: Forty-eight (48) hours following award of the Contract, notify each party involved, in writing, of the status of each alternate. Indicate if alternates have been accepted, rejected, or deferred for later consideration. Include a complete description of negotiated revisions to alternates.
- C. Execute accepted alternates under the same conditions as other Work of the Contract.
- D. Schedule: A schedule of alternates is included at the end of this Section. Specification Sections referenced in schedule contain requirements for materials necessary to achieve the Work described under each alternate.

PART 2 - PRODUCTS

Not Used.

PART 3 - EXECUTION

3.1 SCHEDULE OF ALTERNATES

- A. Alternate Number 1: 23 09 23 Direct Digital Controls Automated Logic Corporation
 - This Alternate shall establish the amount to adjust the Base Proposal for the cost of furnishing and installing Direct Digital Controls manufactured by Automated Logic Corporation; WEBCTRL® – Installed by Automated Logic Corporation (ALC) – Houston. This alternate shall include the pricing for all materials and labor for proper completion. Refer to specs and drawings for additional information.

- B. Alternate No. 1 B: 23 09 23 Direct Digital Controls Unify Energy Solutions
 - This Alternate shall establish the amount to adjust the Base Proposal for the cost of furnishing and installing Direct Digital Controls manufactured by Reliable Controls – Installed by Unify Energy Solutions. This alternate shall include the pricing for all materials and labor for proper completion. Refer to specs and drawings for additional information.
- C. Alternate Number 2a: 23 52 16 Condensing Boilers RBI
 - This Alternate shall establish the amount to be added to the Base Proposal for the Contractor to furnish Condensing Boilers, manufactured by **RBI – Flexcore model** as shown and scheduled on the drawings and as specified. Alternate boiler price shall include warranty as specified per 1.9.
- D. Alternate Number 2b: 23 52 16 Condensing Boilers Raypak
 - This Alternate shall establish the amount to be added to the Base Proposal for the Contractor to furnish Condensing Boilers, manufactured by **Raypak – XVERS** model as shown and scheduled on the drawings and as specified. Alternate boiler price shall include warranty as specified per 1.9.
- E. Alternate Number 2c: 23 52 16 Condensing Boilers Patterson Kelley
 - This Alternate shall establish the amount to be added to the Base Proposal for the Contractor to furnish Condensing Boilers, manufactured by **Patterson-Kelley – Senic Solis model** as shown and scheduled on the drawings and as specified. Alternate boiler price shall include warranty as specified per 1.9.
- F. Alternate Number 2d: 23 52 16 Condensing Boilers Camus
 - This Alternate shall establish the amount to be added to the Base Proposal for the Contractor to furnish Condensing Boilers, manufactured by Camus – Avenger model as shown and scheduled on the drawings and as specified. Alternate boiler price shall include warranty as specified per 1.9.
- G. Alternate Number 3a: 23 64 23 Scroll Water Chillers Air-Cooled Trane
 - 1. This Alternate shall establish the amount to be added to the Base Proposal for the Contractor to furnish Scroll Water Chillers Air-Cooled, manufactured by **Trane** as shown and scheduled on the drawings and as specified. Alternate chiller price shall include (5) five-year parts, labor, refrigerant, etc. extended warranty (re: 1.10 Warranty) as well as (5) five-year Preventative Maintenance Service (re: 1.11 Preventative Maintenance Service); there are no chillers included in the base bid.
- H. Alternate Number 3b: 23 64 23 Scroll Water Chillers Air-Cooled Carrier
 - 1. This Alternate shall establish the amount to be added to the Base Proposal for the Contractor to furnish Scroll Water Chillers Air-Cooled, manufactured by **Carrier** as shown and scheduled on the drawings and as specified. Alternate chiller price shall include (5) five-year parts, labor, refrigerant, etc. extended warranty (re: 1.10 Warranty) as well as (5) five-year Preventative Maintenance Service (re: 1.11 Preventative Maintenance Service); there are no chillers included in the base bid.
- I. Alternate Number 3c: 23 64 23 Scroll Water Chillers Air-Cooled JCI

1.

This Alternate shall establish the amount to be added to the Base Proposal for the Contractor to furnish Scroll Water Chillers Air-Cooled, manufactured by **JCI** as shown and scheduled on the drawings and as specified. Alternate chiller price shall include (5) five-year parts, labor, refrigerant, etc. extended warranty (re: 1.10 Warranty) as well as (5) five-year Preventative Maintenance Service (re: 1.11 Preventative Maintenance Service); there are no chillers included in the base bid.

- J. Alternate Number 4a: 23 74 13.16 Packaged, Outdoor, Central-Station Hydronic Air-Handling Units Carrier
 - 1. This Alternate shall establish the amount to be added to the Base Proposal for the Contractor to furnish Packaged, Outdoor, Central-Station Hydronic Air- Handling Units, manufactured by **Carrier** as shown and scheduled on the drawings and as specified; there are no Packaged, Outdoor, Central -Station Hydronic Air-Handling Units included in the base bid.
- K. Alternate Number 4b: 23 74 13.16 Packaged, Outdoor, Central-Station Hydronic Air-Handling Units **Trane**
 - 1. This Alternate shall establish the amount to be added to the Base Proposal for the Contractor to furnish Packaged, Outdoor, Central-Station Hydronic Air- Handling Units, manufactured by **Trane** as shown and scheduled on the drawings and as specified; there are no Packaged, Outdoor, Central -Station Hydronic Air-Handling Units included in the base bid.
- L. Alternate Number 4c: 23 74 13.16 Packaged, Outdoor, Central-Station Hydronic Air-Handling Units **JCI**
 - 1. This Alternate shall establish the amount to be added to the Base Proposal for the Contractor to furnish Packaged, Outdoor, Central-Station Hydronic Air- Handling Units, manufactured by **JCI** as shown and scheduled on the drawings and as specified; there are no Packaged, Outdoor, Central -Station Hydronic Air-Handling Units included in the base bid.
- M. Alternate Number 4d: 23 74 13.16 Packaged, Outdoor, Central-Station Hydronic Air-Handling Units – Temtrol
 - 1. This Alternate shall establish the amount to be added to the Base Proposal for the Contractor to furnish Packaged, Outdoor, Central-Station Hydronic Air- Handling Units, manufactured by **Temtrol** as shown and scheduled on the drawings and as specified; there are no Packaged, Outdoor, Central -Station Hydronic Air-Handling Units included in the base bid.
- N. Alternate Number 5: Provide metal stud partition assemblies and accessories in lieu of Integrated Interior Assemblies (Section 13 42 75) per guidelines listed below:
 - 1. Provide gypsum board assemblies per Section 09 21 16.
 - a. Partition: 25 ga. metal studs at 16" O.C., width to match width of assembly framing. One layer of 5/8" impact resistant type "x" gyp. board on each side with sound attenuation blanket, STC 45. Wall base to match scheduled flooring with continuous acoustical sealant on both sides.
 - 2. Wall Finish:
 - a. Ceramic Wall tile up to 7'-0" at Corridor side.
 - i. Manufacturer: Crossville Studios Urbanology by Stile
 - ii. Color: WT-3 Metropolis chiseled & WT-4 Titanium Chiseled
 - iii. Size: 24"X48"
 - b. Ceramic Wall tile at Restrooms.
 - i. Manufacturer: WT-5, WT-6 & WT-7 Esmer Raku
 - ii. Color: White Size: 3"x12" Matte
 - iii. Color: Charcoal // Mustard Size: 3"x12" Glossy
 - c. Ceramic Wall tile at Stairwell (2-Story)
 - i. Manufacturer: Crossville Studios Urbanology by Stile
 - ii. Color: WT-3 Metropolis chiseled & WT-4 Titanium Chiseled
 - iii. Size: 24"X48"
 - d. Glass Mirrors Annealed Float Glass.

- i. Clear, ASTM C1036, with copper and silver coatings, and protective overcoating.
 - a. Thickness: 1/4 inch (6.4 mm).
 - b. Edges: Arrised.
 - c. Size: As indicated on Drawings.
- 3. Provide aluminum framed storefronts per Section 08 43 13 at all window and door locations.
 - a. 6'-10" door frame with transom above height to match scheduled ceiling
 - b. 1 3/4" thick, plastic clad, solid core wood doors.
 - c. Anodized aluminum frame, typical
 - d. Window glazing and frame: Anodized aluminum frame, typical and 1/4" thick clear tempered glass
- 4. Tack boards Vinyl mounted on resilient cork underlay, 1/2" thick.
 - a. Basis of Design: Claridge Fabricork series #1550EW or comparable product.
 - b. Fabric Wrapped Edge: Wrap edge of tackboard panel with fabric facing.
 - c. Color and Pattern: Selected by Architect.
- 5. Marker Boards with multimedia finish and aluminum tray and trim (magnetic).
 - a. 24-gauge porcelain enamel steel LCS 24 face sheet on 7/16 inch MDF core with 0.015 inch aluminum back sheet. Color: White & Magnetic.
- 6. Educational Casework:
 - a. Manufactured plastic laminated casework, hardware and related accessories.
 - b. Identification of casework components and related products by surface visibility.
 - i. Balanced construction: High pressure laminate or cabinet liner shall be installed on both sides of core to restrict warpage in accordance with AWI Quality Standards Illustrated Section 400B-T-2.
 - ii. Open Interiors: Open unit without solid door and drawer fronts, and units with full glass insert or acrylic doors.
 - iii. Closed Interiors: Closed unit behind solid door, drawer fronts, and sliding solid doors.
 - iv. Exposed Ends: Exterior side surface that is visible after installation.
 - v. Other Exposed Surfaces: Faces of doors and drawers when closed and tops of cabinets less than 72 inches above finished floor.
 - vi. Semi-Exposed Surfaces: Interior surfaces which are visible, bottoms of wall cabinets and tops of cabinets 72 inches or more above finished floor.
 - vii. Concealed Surfaces: Any surface not visible after installation.
- 7. Electrical Work Scope:
 - a. Refer to 26 05 00 Common Work Results for Electrical
 - b. Provide all work for electrical systems required in the project to be properly installed, tested and performing their intended function. Coordinate the work of this division with all other divisions to ensure that all components of the electrical system will be installed at the proper time and fit the available space. Locate and size all openings in work of other trades required for the proper installation of the electrical system components. Make all electrical connections to all equipment furnished by this division and any other division. Make all electrical connections from all 120 volt and greater dampers and switches to associated exhaust fan(s) furnished by any other division.
- 8. Plumbing Work Scope:

- a. Refer to 22 05 00 Common Work Results for Plumbing
- b. Plumbing systems installed, and the work performed under Division 22 of the
- c. Specifications, shall include, but are not necessarily limited to connection points for all systems from the site utilities shall be at 5'-0" from the exterior of the building unless specifically noted otherwise. Provide all work for plumbing and fire protection systems required in the project to be properly installed, tested, and performing their intended function.
- 9. Technology Work Scope:
 - a. Refer to 27 00 00 Basic Materials and Methods
 - b. The Contractor shall be responsible for coordination and proper relation of his work to the building structure and to the work of all trades. Provide an extension of the existing installed systems interfaced with new systems in the newly constructed building, complete in every respect.

END OF SECTION 01 23 00

SECTION 09 67 00 - FLUID-APPLIED FLOORING

PART 1 GENERAL

1.1 RELATED DOCUMENTS

A. The provisions of the General Conditions, Supplementary Conditions, Drawings, Specifications, and the Sections included under Division 01 General Requirements and References, are included as a part of this Section as though bound herein.

1.2 SUMMARY

- A. Section Includes: Requirements including but not limited to:
 - 1. Fluid-applied, epoxy resin flooring system.
 - 2. Accessories necessary for a complete installation.
- B. Related Sections:
 - 1. Section 01 61 16 Volatile Organic Compound (VOC) Content Restrictions.

1.3 REFERENCE STANDARDS

- A. ASTM D635 Standard Test Method for Rate of Burning and/or Extent and Time of Burning of Plastics in a Horizontal Position; 2022.
- B. ASTM D4263 Standard Test Method for Indicating Moisture in Concrete by the Plastic Sheet Method; 1983 (Reapproved 2018).
- C. ASTM E648 Standard Test Method for Critical Radiant Flux of Floor-Covering Systems Using a Radiant Heat Energy Source; 2023.
- D. ASTM F1869 Standard Test Method for Measuring Moisture Vapor Emission Rate of Concrete Subfloor Using Anhydrous Calcium Chloride; 2023.
- E. ASTM F2170 Standard Test Method for Determining Relative Humidity in Concrete Floor Slabs Using in situ Probes; 2019a.
- F. NFPA 253 Standard Method of Test for Critical Radiant Flux of Floor Covering Systems Using a Radiant Heat Energy Source; 2023.

1.4 **DEFINITIONS**

- A. Refer to Section 01 42 16 Definitions for the following terms:
 - 1. Comparable Product.

1.5 SUBMITTALS

- A. Product Data: Technical data for each type of product indicated include manufacturer's technical data, application instructions, and recommendations for each flooring component required.
- B. Samples: Submit flooring system required, 6 inches (150 mm) square, applied to a rigid backing.
 - 1. Two samples indicating range of slip resistant textures
 - 2. Two samples of actual color and texture selected by Architect.
- C. Reports and Certificates:
 - 1. Installer Certificates: Signed by manufacturer certifying that installers comply with specified requirements.
- D. Maintenance Data: Submit data for flooring system to include in maintenance manuals.

1.6 QUALITY ASSURANCE

- A. Regulatory Requirements:
 - 1. Building Code: Comply with applicable requirements of the IBC for interior floors.
 - 2. Fire Test Response Characteristics: Determined by testing identical products according to ASTM E648 or NFPA 253 by a qualified testing agency.
 - 3. Accessibility Requirements: Comply with applicable requirements.

- 4. Flammability: Self-extinguishing according to ASTM D635.
- B. Installer Qualifications: Installer having minimum 5 years documented experience in the installation of epoxy floors and who is a manufacturer authorized representative trained and approved for installation of flooring systems required. Engage installer certified in writing by floor manufacturer as qualified to apply flooring systems indicated.
- C. Source Limitations: Obtain primary flooring materials, including primers, resins, hardening agents, grouting coats, and topcoats, from single source from single manufacturer. Provide secondary materials, including patching and fill material, joint sealant, and repair materials, of type and from source recommended by manufacturer of primary materials.
- D. Pre-Installation Conference: Conduct conference at site.

1.7 DELIVERY, STORAGE, AND HANDLING

A. Deliver materials in original packages and containers, with seals unbroken, bearing manufacturer's labels indicating brand name and directions for storage and mixing with other components.

1.8 FIELD CONDITIONS

- A. Environmental Limitations: Comply with flooring manufacturer's written instructions for substrate temperature, ambient temperature, moisture, ventilation, and conditions affecting resinous flooring application.
- B. Lighting: Provide permanent lighting or, if permanent lighting is not in place, simulate permanent lighting conditions during resinous flooring application.
- C. Close spaces to traffic during flooring application and for 24 hours after application unless manufacturer recommends a longer period.

1.9 WARRANTY

A. Manufacturer shall furnish a single, written warranty covering both material and workmanship for a period of (1) full year from date of installation, or provide a joint and several warranty signed on a single document by material manufacturer and applicator jointly and severally warranting the materials and workmanship for a period of (1) full year from date of installation. A sample warranty letter must be included with bid package or bid may be disqualified.

PART 2 PRODUCTS

2.1 MANUFACTURERS

- A. Subject to compliance with specification requirements, products by the listed manufacturers or fabricators may be submitted for use in the Work.
 - 1. BASF Corporation: construction.basf.com.
 - 2. Crossfield Products Corp.: www.crossfieldproducts.com.
 - 3. Patcraft.
 - 4. Sherwin-Williams Company (The), High Performance Flooring: industrial.sherwinwilliams.com/na/us/en/resin-flooring.html.
 - 5. Sika Corporation; Flooring: https://usa.sika.com/en/construction/floor-wall/flooring-systems.html.
 - 6. Stonhard Group (The): www.stonhard.com.
- B. Substitutions: Refer to Section 01 25 13 Product Substitution Procedures.
 - 1. Manufacturers and fabricators not listed must have a minimum of 5 years' experience manufacturing products meeting or exceeding the specifications and comply with Division 01 requirements regarding substitutions to be considered. Submit as a substitution.

2.2 DESCRIPTION

- A. Regulatory Requirements:
 - 1. Code Standards:

a. Refer to specification Section 01 41 00 - Regulatory Requirements for code requirements and code standards applicable to all materials and work necessary to complete the scope of work.

2.3 FLUID-APPLIED, EPOXY RESIN FLOORING SYSTEM (FF-1, FF-2)

- A. Basis of Design Product:
 - 1. Traditional Flake as manufactured by Patcraft.
- B. System Characteristics:
 - 1. Color:
 - a. FF-1: F0130 Giant.
 - b. FF-2: F0570 Astral.
 - 2. Pattern: As indicated on Drawings.
 - 3. Integral Cove Base: As indicated on Drawings.
- C. System Components: Manufacturer's standard components that are compatible with each other and as follows:
 - 1. Prime Coat: 912 LV Epoxy Primer.
 - 2. Base Coat: 610 Self-Leveling Epoxy.
 - 3. Visual Layer: Decorative Flake.
 - 4. Top Coat: 670 Polyaspartic Coating.

PART 3 EXECUTION

3.1 PREPARATION

- A. Prepare and clean substrates according to resinous flooring manufacturer's written instructions for substrate indicated. Provide clean, dry substrate for resinous flooring application.
- B. Concrete Substrates: Provide sound concrete surfaces free of laitance, glaze, efflorescence, curing compounds, form release agents, dust, dirt, grease, oil, and other contaminants incompatible with resinous flooring.
 - 1. Remove existing floor covering, adhesives, and contaminates. Ensure existing concrete floor is ready to receive epoxy floor covering.
 - 2. Roughen concrete by Shot Blasting (mechanical preparation only) substrates complying with manufacturer's written instructions.
 - 3. Repair damaged and deteriorated concrete according to resinous flooring manufacturer's written instructions.
 - 4. Verify that concrete substrates are dry and moisture vapor emissions are within acceptable levels according to manufacturer's written instructions.
 - a. Anhydrous Calcium Chloride Test: ASTM F1869. Proceed with application of resinous flooring only after substrates have maximum moisture-vapor-emission rate of 3 lb of water/1,000 sq. ft. (1.36 kg of water/92.9 sq. m) of slab area in 24 hours.
 - b. Plastic Sheet Test: ASTM D4263. Proceed with application after testing indicates absence of moisture in substrates.
 - c. Relative Humidity Test: Use in situ probes, ASTM F2170. Proceed with installation only after substrates have a maximum 75 percent relative humidity level measurement.
 - 5. Alkalinity and Adhesion Testing: Verify that concrete substrates have pH within acceptable range. Perform tests recommended by manufacturer. Proceed with application only after substrates pass testing.
- C. Patching and Filling: Use patching and fill material to fill holes and depressions in substrates according to manufacturer's written instructions.
 - 1. Control Joint Treatment: Treat control joints and other nonmoving substrate cracks to prevent cracks from reflecting through resinous flooring according to manufacturer's written instructions.

D. Epoxy Materials: Mix components and prepare materials according to resinous flooring manufacturer's written instructions.

3.2 APPLICATION

- A. Apply components of resinous flooring system according to manufacturer's written instructions to produce a uniform, monolithic wearing surface of thickness indicated.
 - 1. Coordinate application of components to provide optimum adhesion of resinous flooring system to substrate, and optimum intercoat adhesion.
 - 2. Cure resinous flooring components according to manufacturer's written instructions. Prevent contamination during application and curing processes.
 - 3. Expansion and Isolation Joint Treatment: At substrate expansion and isolation joints, comply with resinous flooring manufacturer's written instructions.
- B. Primer/Waterproofing Membrane: Apply primer or waterproofing membrane over entire substrate surface in manufacturer's recommended thickness.
 - 1. Apply to integral cove base substrates.
- C. Integral Cove Base: Apply cove base mix to wall surfaces before applying flooring. Apply according to manufacturer's written instructions and details, including those for taping, mixing, priming, troweling, sanding, and topcoating of cove base. Do not broadcast into cove. Mix quartz aggregates and add thixotropic and hand trowel. Round internal and external corners.
- D. Quartz Granules: Broadcast Quartz into Undercoat. Scrape off and vacuum up excess aggregate.
- E. Topcoats: Trowel or squeegee apply clear epoxy resin coat topcoats indicated for flooring system and at spreading rates recommended in writing by manufacturer and to produce wearing surface indicated.

3.3 CURING

A. Cure resinous flooring materials in compliance with manufacturer's directions, taking care to prevent contamination during stages of application and prior to completion of curing process. Close area of application for a minimum of 48 hours.

3.4 PROTECTION

A. Protect resinous flooring from damage and wear during the remainder of construction period. Use protective methods and materials, including temporary covering, recommended in writing by resinous flooring manufacturer.

3.5 CLEANING

A. Cleaning: Remove temporary covering and clean resinous flooring just prior to final inspection. Use cleaning materials and procedures recommended by resinous flooring manufacturer.

END OF SECTION 09 67 00

SECTION 11 66 13 - EXERCISE EQUIPMENT

PART 1 GENERAL

1.1 RELATED DOCUMENTS

A. Drawings and general provisions of the Contract, including General and Supplementary Conditions and other Division 01 Specification Sections, apply to this Section.

1.2 SUMMARY

- A. Section Includes: Requirements including but not limited to:
 - 1. Exercise equipment.
 - a. Athletic Edge Treatment Table Custom
 - b. Athletic Edge Taping Station Custom
 - c. Hausmann Mammoth 3-Section Hi-Lo Table
 - d. Sammons Preston Crutch Rack Storage Medco
 - e. Wall Mounted Weight Rack
 - f. Liberty Hardware Double Prong Hook
 - g. StoreMoreStore Should Pad Storage rack
 - h. Uline 18"x36" Lockable Metal Shelving
 - i. Jersey wardrobe Cabinet
 - j. Huskey Movable Island
 - 2. Accessories necessary for a complete installation

1.3 **REFERENCE STANDARDS**

- A. ANSI A208.1 American National Standard for Particleboard; 2022.
- B. ASTM A36/A36M Standard Specification for Carbon Structural Steel; 2019.
- C. ASTM A47/A47M Standard Specification for Ferritic Malleable Iron Castings; 1999, with Editorial Revision (2022).
- D. ASTM A391/A391M Standard Specification for Grade 80 Alloy Steel Chain; 2021.
- E. ASTM A413/A413M Standard Specification for Carbon Steel Chain; 2021.
- F. ASTM A500/A500M Standard Specification for Cold-Formed Welded and Seamless Carbon Steel Structural Tubing in Rounds and Shapes; 2023.
- G. ASTM A513/A513M Standard Specification for Electric-Resistance-Welded Carbon and Alloy Steel Mechanical Tubing; 2020a.
- H. ASTM A1011/A1011M Standard Specification for Steel, Sheet and Strip, Hot-Rolled, Carbon, Structural, High-Strength Low-Alloy, High-Strength Low-Alloy with Improved Formability, and Ultra-High Strength; 2023.
- I. ASTM B179 Standard Specification for Aluminum Alloys in Ingot and Molten Forms for Castings from All Casting Processes; 2018.
- J. ASTM B209/B209M Standard Specification for Aluminum and Aluminum-Alloy Sheet and Plate; 2021a.
- K. ASTM B221 Standard Specification for Aluminum and Aluminum-Alloy Extruded Bars, Rods, Wire, Profiles, and Tubes; 2021.
- L. ASTM B221M Standard Specification for Aluminum and Aluminum-Alloy Extruded Bars, Rods, Wire, Profiles, and Tubes (Metric); 2021.
- M. ASTM C1107/C1107M Standard Specification for Packaged Dry, Hydraulic-Cement Grout (Nonshrink); 2020.

1.1 PERFORMANCE REQUIREMENTS

A. Comply with requirements of ASTM F2276-10 "Standard Specification for Fitness Equipment".

1.2 SUBMITTALS

- A. Product Data: Technical data for each type of product, including assembly, disassembly, and storage instructions for removable equipment and to indicate the performance, fabrication procedures, product variations, and accessories
 - 1. If applicable, include assembly, disassembly, and storage instructions for removable equipment.
 - 2. Motors: Show nameplate data, ratings, characteristics, and mounting arrangements.
- B. Shop Drawings: Submit plans, elevations, sections, details, and attachments to other work.
 - 1. Include details of field assembly for removable equipment, connections, installation, mountings, floor inserts, attachments to other work, and operational clearances.
 - 2. Include transport and storage accessories for removable equipment.
- C. Coordination Drawings: Court layout plans, drawn to scale, and coordinated with floor inserts, game lines, and markers applied to finished flooring.
- D. Product Certificates: For each type of exercise equipment.
- E. Operation and Maintenance Data: For exercise equipment to include in emergency, operation, and maintenance manuals.

1.3 FIELD CONDITIONS

- A. Environmental Limitations: Do not install exercise equipment until spaces are enclosed and weatherproof, wet work in spaces is complete and dry, and ambient temperature and humidity conditions are maintained at the levels indicated for Project when occupied for its intended use.
- B. Field Measurements: Verify position and elevation of power connections and layout for exercise equipment.

1.4 COORDINATION

- A. Coordinate installation of power connections with structural floors and finish flooring installation.
- B. Coordinate layout and installation of overhead and wall supported exercise equipment and suspension system components with other construction including lighting fixtures, HVAC equipment, fire suppression system components, and partition assemblies.

1.5 WARRANTY

- A. Written warranty in which manufacturer agrees to repair or replace components of gymnasium equipment that fail in materials or workmanship within specified warranty period.
 - 1. Failures include, but are not limited to, the following:
 - a. Basketball backboard failures including glass breakage.
 - b. Faulty operation of basketball backstops.
 - 2. Warranty Period: years from date of Substantial Completion.

PART 2 PRODUCTS

2.1 MATERIALS

- A. Aluminum: Alloy and temper recommended by manufacturer for use and finish type indicated.
 - 1. Extruded Bars, Profiles, and Tubes: ASTM B221 (ASTM B221M)
 - 2. Cast Aluminum: ASTM B179
 - 3. Flat Sheet: ASTM B209/B209M
- B. Steel: Comply with the following:
 - 1. Steel Plates, Shapes, and Bars: ASTM A36/A36M.
 - 2. Steel Tubing: ASTM A500/A500M or ASTM A513/A513M, cold formed.
 - 3. Steel Sheet: ASTM A1011/A1011M.

- C. Support Cable: 1/4 inch (6 mm) diameter, 7x19 galvanized stranded steel wire rope with breaking strength of 7000 lb (3175 kg). Provide fittings complying with wire rope manufacturer's written instructions for size, number, and installation method.
- D. Support Chain and Fittings: For chains used for overhead lifting, provide Grade 80 heat treated alloy steel chains, complying with ASTM A391/A391M, with commercial quality, hot dip galvanized or zinc plated steel connectors and hangars.
- E. General Purpose Chain: For chains not used for overhead lifting, provide carbon steel chain, complying with ASTM A413/A413M, Grade 30 proof coil chain or other grade recommended by gymnasium equipment manufacturer. Provide coating type, chain size, number, and installation method complying with manufacturer's written instructions.
- F. Castings and Hangers: Malleable iron, complying with ASTM A47/A47M; grade required for structural loading.
- G. Softwood Plywood: DOC PS 1, exterior.
- H. Particleboard: ANSI A208.1.
- I. Equipment Wall Mounted Board: Wood, finish, size, and quantity as required to mount exercise equipment according to manufacturer's written instructions.
- J. Anchors, Fasteners, Fittings, and Hardware: Corrosion resistant or noncorrodible units; concealed; .
- K. Grout: Non-shrink, non-metallic, pre-mixed, factory packaged, non-staining, non-corrosive, nongaseous grout, complying with ASTM C1107/C1107M with minimum strength recommended in writing by exercise equipment manufacturer.

2.2 PRODUCTS

- A. Athletic Edge Treatment Table Custom
 - 1. Description: Aluma Elite Treatment Table Custom
 - a. A4359 Lift Back and Split Leg Cushions
 - b. A42740 1 Storage Cabinet with sliding drawers
 - 1) Cabinet Location head end
 - 2) Drawer Location Left
 - c. Upholstery Color Black
 - d. Standard Frame Black
 - e. Standard Accent Color Yellow
 - f. Item# D55194201
 - g. Qty: Ref Schedule on AQ-101
- B. Athletic Edge Taping Station Custom
 - 1. Description: Athletic Edge Taping Station Custom
 - a. Height 42"
 - b. Depth 42"
 - c. Number of Seats 4 Seats and 3 Centers 18' long
 - d. TTS Model-Standard Center Cabinet
 - e. TSFO-D3-1/2 Drawer Pull out
 - f. Center Cabinet Front Option CCFO-D2-Open Cubby
 - g. Upholstery Black
 - h. Laminate top Color Slate Grey
 - i. Qty: Ref Schedule on AQ-101
- C. Hausmann Mammoth 3-Section Hi-Lo Treatment Table
 - 1. Vendor: Alert Services
 - 2. Item # D2497703
 - 3. Qty: Ref Schedule on AQ-101

Exercise Equipment 11 66 13 - 3

- D. Sammons Preston Crutch Storage Rack
 - 1. Vendor: Medco
 - 2. Item # 081186501
 - 3. Qty: Ref Schedule on AQ-101
- E. Wall Mounted Weight Rack
 - 1. Vendor: Medco
 - 2. Item # 081031111
 - 3. Qty: Ref Schedule on AQ-101
- F. Double Prong Helmet Hooks
 - 1. Vendor: Liberty Hardware
 - 2. Item # B46114Q-SN-C5
 - 3. Qty: Ref Schedule on AQ-101
- G. Shoulder Pad Storage rack
 - 1. Vendor: STOREMORESTORE
 - 2. Item # SMS-08-V42-FB-1530-42SS
 - 3. Qty: Ref Schedule on AQ-101
- H. Uline 18"x36" Lockable Metal Shelving
 - 1. Vendor: Uline
 - 2. Security Cart: H-2656
 - 3. Qty: Ref Schedule on AQ-101
- I. Jersey Wardrobe Cabinet
 - 1. Vendor: SCHOOLLOCKERS
 - 2. Description: Small Stadium Locker with Shelf
 - 3. Item # SL-1-181872-SHELF-G2026029
 - 4. Qty: Ref Schedule on AQ-101
- J. Huske Movable Island
 - 1. Vendor: Huskey
 - 2. Tool Storage: H46X18MWC9BLK
 - 3. Qty: Ref Schedule on AQ-101

PART 3 EXECUTION

3.1 EXAMINATION

- A. Examine substrates, areas, and conditions for compliance with requirements for exercise equipment layout, alignment of mounting substrates, installation tolerances, operational clearances, and other conditions affecting performance of the Work.
 - 1. Verify critical dimensions.
 - 2. Examine supporting structure, subfloors, and footings below finished floor.
 - 3. Examine wall assemblies, where reinforced to receive anchors and fasteners, to verify that locations of concealed reinforcements are clearly marked. Locate reinforcements and mark locations.
- B. Proceed with installation after correcting unsatisfactory conditions.

3.2 INSTALLATION

- A. Comply with manufacturer's written installation instructions. Complete equipment field assembly where required.
- B. Unless otherwise indicated, install exercise equipment after other finishing operations, including painting, are completed.

- C. Permanently Placed Exercise Equipment and Components: Install rigid, level, plumb, square, and true; anchored securely to supporting structure; positioned at locations and elevations indicated; in proper relation to adjacent construction; and aligned with court layout.
 - 1. Floor Insert Location: Coordinate location with application of game lines and markers, .
 - 2. Floor Insert Elevation: Coordinate installed heights of floor insert with installation of finish flooring and floor-plate type.
 - 3. Operating Exercise Equipment: Verify clearances for movable components of exercise equipment throughout entire range of operation and for access to operating components.
- D. Anchoring to In Place Construction: Use anchors and fasteners where necessary to secure built in and permanently placed exercise equipment to structural support and to properly transfer load to in place construction.
- E. Connections: Connect electric operators to building electrical system.

3.3 ADJUSTING

A. Adjust movable components of exercise equipment to operate safely, smoothly, easily, and quietly, free from binding, warp, distortion, nonalignment, misplacement, disruption, or malfunction, throughout entire operational range. Lubricate hardware and moving parts.

3.4 CLEANING

- A. After completing exercise equipment installation, inspect components. Remove spots, dirt, and debris and touch up damaged shop applied finishes according to manufacturer's written instructions.
- B. Replace exercise equipment and finishes that cannot be cleaned and repaired, in a manner approved by Architect, before time of Substantial Completion.

3.5 **DEMONSTRATION**

A. Engage a factory authorized service representative to train Owner's maintenance personnel to adjust, operate, and maintain exercise equipment.

END OF SECTION 11 66 13

SECTION 27 42 20 - ADD #1

SMART RESTROOM SYSTEM

PART 1 - GENERAL

1.01 RELATED DOCUMENTS

A. Drawings and general provisions of the Contract, including General and Supplementary Conditions and Division 01 Specification Sections, apply to this Section.

1.02 SUMMARY

- A. Section includes smart restroom systems with the following subsystems/components:
 - 1. Cloud-based Business Intelligence Software and Mobile App.
 - 2. Stall Occupancy System
 - 3. Throughput Counters
 - 4. Ancillary Equipment
 - 5. Conductors and Cables.
- B. Related requirements:
 - 1. Section 08 31 00 Access Doors and Panels
 - 2. Section 10 28 00 Toilet, Bath, and Laundry Accessories
 - 3. Section 26 05 19 Low Voltage Electrical Power Conductors and Cables
 - 4. Section 26 05 33 Raceway and Boxes for Electrical Systems
 - 5. Section 27 10 00 Structured Cabling System

1.03 ACTION SUBMITTALS

- A. Product Data: For each type of product. Product data submittal shall clearly identify any/all options (colors, features, functions, etc.) to be provided for the project.
- B. Shop Drawings:
 - 1. Include plans, elevations, sections, and mounting details.
 - 2. Include details of equipment assemblies. Indicate dimensions, weights, loads, required clearances, method of field assembly, components, and location and size of each field connection.
 - 3. Include scaled drawings for indicator lights, wall-mounted tablets and any other devices that will be mounted in areas visible to the public.
 - 4. Include diagrams for power, signal, and communications wiring.
 - a. Identify terminals to facilitate installation, operation, and maintenance.
 - b. Single-line diagram showing interconnection of components.
 - c. Cabling diagram showing cable routing.
 - 5. Provide details of all types of wireless connectivity. Provide specific information on frequency band usage and any expectation of connectivity to be provided by the Owner. Details shall include proposed security provisions to protect data transmissions.

1.04 INFORMATIONAL SUBMITTALS

- A. Coordination Drawings:
 - 1. Reflected ceiling plans, drawn to scale, on which ceiling-mounted items including smart

restroom devices, luminaires, diffusers, grilles, speakers, sprinklers, access panels, and special moldings are shown and coordinated with each other, using input from installers of the items involved.

- 2. Elevation drawings, drawn to scale, on which wall-mounted items including survey tablets, digital signage, luminaires, windows, doors, access panels, wall finishes, and trims are shown and coordinated with each other, using input from installers of the items involved.
- B. Qualification Data:
 - 1. Installers.
 - 2. Testing personnel
 - 3. Training personnel
- C. Field quality-control reports.

1.05 CLOSEOUT SUBMITTALS

- A. Record Drawings:
 - 1. In addition to items specified in Section 01 78 39 "Project Record Documents," include the following:
 - a. Updates to Shop Drawings which denote actual installed conditions.
 - b. Particular emphasis shall be placed on documenting the locations of devices and power/data circuits installed behind finished surfaces.
- B. Operation and Maintenance Data:
 - 1. In addition to any items specified in Section 01 78 23 "Operation and Maintenance Data," include the following:
 - a. A record of Owner's equipment-programming option decisions.
 - b. Plans, drawn to scale, indicating location, designation, and connection of smart restroom system components.
- C. Software Operational Documentation:
 - 1. Software operating and upgrade manuals.
 - 2. Device address list.
 - 3. Screenshots of final display arrangements/dashboards.

1.06 QUALITY ASSURANCE

A. Installer Qualifications: An authorized representative(s) who is trained and approved by manufacturer(s).

1.07 COORDINATION

- A. Ceilings: Coordinate layout and installation of ceiling-mounted smart restroom devices with other construction that penetrates ceilings or is supported by them, including light fixtures, HVAC equipment, fire-suppression system, and partition assemblies. Installation of in-ceiling or above-ceiling devices must allow for maintenance access. Where installations occur in hard ceilings, provide devices that may be removed from below ceiling, or provide ceiling access panels to support maintenance access from above ceilings. Coordinate ceiling access panels/placements with the Architect and the ceiling work of other disciplines.
- B. Power: Coordinate all power requirements with electrical work. Ensure all electrical connections are accessible for disconnect and maintenance purposes.
- C. Communications: Proposed communications schemes must be coordinated with and approved

by the Owner's IT Department. Whether communications include the use of Owner's public/private Wi-Fi, contracted Wi-Fi vendor, establishing a new dedicated Wi- Fi system, Bluetooth, cellular data, hardwired connections to Owner's network, or a combination thereof, such communications schemes must meet the Owner's approval. Refer to the Contract Drawings for proposed communications schemes. Deviations must be fully coordinated and approved by the Owner.

D. Screen Designs: Coordinate all screen layouts (i.e., survey tablets, Business Intelligence Software (BIS) dashboards, and Mobile App screen layouts) directly with the Owner. Owner's approval must be obtained prior to deployment.

PART 2 - PRODUCTS

2.01 SYSTEM DESCRIPTION

- A. Equipment: Modular, using solid-state components, and rated for continuous duty unless otherwise indicated. Select equipment for normal operation on input power supplied at 110 to 130 V, 60 Hz without requirement of any external power conditioning equipment.
- B. Software: Business Intelligence Software (BIS): None required for sensors in standalone mode.
- C. Coordinate features and select subsystems/components to form a fully integrated system. Match components and subsystems for optimum performance of specified functions.

2.02 FUNCTIONAL DESCRIPTION

- A. Business Intelligence Software: None required for sensors in standalone mode.
- B. Restroom and/or Stall Occupancy: Each restroom and/or stall will be equipped with a combination sensor/indicator light installed at those locations designated on the Contract Drawings. Persons entering and exiting the stalls shall be detected by the sensor and shall cause the light to toggle between green/blue and red. The sensor shall be designed/configured to not trigger as a result of routine personnel movements in the corridor outside the restroom and/or stalls. In addition, multiple persons entering/exiting a restroom and/or stall, e.g., caretaker and child, shall be detected as a singular event. The lights shall be placed in a manner to provide a clear indication to personnel as to which restrooms and/or stalls are occupied. Data received from the sensors/lights shall be populated into the BIS so that occupancy for the individual restrooms and/or stalls can be tracked in real time.
- C. Throughput Counting: Sensors shall be installed in the entries and exits of each restroom to track the movement of patrons to/from each individual restroom. The sensors will be used to support the following functions:
 - 1. Each restroom shall be configured with a threshold value associated with throughput. The threshold shall be configurable by the Owner and may vary based upon the size of each restroom.

2.03 BUSINESS INTELLIGENCE SOFTWARE – N/A

- A. Web-hosted application that can be accessed by authorized users from a variety of web browsers/devices.
- B. The basis of design for smart bathroom installations at the high school is a standalone sensor

system for restroom occupancy indication only.

2.04 STALL OCCUPANCY SYSTEM

- A. Occupancy Sensors/Indicator Lights: Ceiling or wall-mounted LED lights with integrated sensors that connect wirelessly to the system hub. Sensors/lights shall be powered via Zurn Z-PWRSUP-W1 mounted in Raco 260 electrical box in plenum that shall provide 12VDC power to daisy-chained power connections on sensors/lights.
 - 1. Basis-of-Design Product: Subject to compliance with requirements, provide the Z-LIGHT-W1 system provided by Zurn Industries, LLC.
 - 2. Sensor/Light: Mounting: Units shall be ceiling or wall-mounted with consideration of the ceiling heights required under this project (typically 10') and the top of the sensor shall not exceed 8' 6" after finished floor. Sensors shall communicate via a wireless meshed network back to the system hub.
 - 3. LED Light Color: Green/Red and Blue/Red (for handicapped stalls).
 - 4. Power Supply: The system shall be powered via Z-PWRSUP-W1 12VDC power supplies to support up to 40 connected devices.
 - 5. Internet Reporting Device with Smart Hub: System shall interface with the BIS via the cloud.
 - 6. The system shall provide the following capabilities:
 - a. Provide all local wireless communications equipment, communications gateways, power supplies and cabling, data services, cloud-hosting services, and licensing required to collect data from the sensors identified above and to control the associated status lights.
 - b. Provide an application programming interface (API) and associated support/development services, if necessary, to allow information collected from the sensors to be shared with the Owner's existing Smart Restroom System should there be one existing.
 - c. Provide all data services, hosting services, licensing, and maintenance support services, etc., required to provide a fully functional expansion to the TRAX smart restroom system. Such services must meet the performance period, licensing, and support service requirements identified within Part 3 of this specification section.

2.05 ANCILLARY EQUIPMENT

- A. Provide all ancillary equipment required to provide fully functional smart restroom installations. Such equipment shall vary by manufacturer and specific system requirements. Ancillary equipment for this project includes, but is not necessarily limited to, the following:
 - 1. Network Equipment: Provide connections to all PoE network switches required to support the proposed solution.
 - 2. Power Supplies: Provide power supplies as needed to support the proposed solution. Coordinate power supply connections with electrical outlets.
 - 3. Specialty Cables: Provide any/all specialty cable required to interconnect system components.

2.06 CONDUCTORS AND CABLES

- A. Provide cables that fully comply with manufacturer's recommendations.
- B. Refer to Section 27 10 00 "Structured Cabling System" for "Category" cabling to be used for smart restroom system ethernet hubs where indicated.

- C. Conductors: Jacketed, twisted pair and twisted multipair, untinned solid copper. Sizes as recommended by system manufacturer, but no smaller than No. 24 AWG.
- D. Insulation: Thermoplastic, not less than 1/32 inch thick.
- E. Plenum Cable: Listed and labeled for plenum installation.

2.07 RACEWAYS

- A. If required, smart restroom system raceways and boxes shall comply with requirements in state and local codes.
- B. Outlet boxes shall be not less than 2 inches wide, 3 inches high, and 2-1/2 inches deep.

PART 3 - EXECUTION

3.01 WIRING METHODS

- A. Wiring Method: Conceal conductors and cables in accessible ceilings, walls, and floors where possible.
 - 1. Install plenum cable in environmental air spaces, including plenum ceilings.
- B. Wiring within Enclosures: Bundle, lace, and train conductors to terminal points with no excess and without exceeding manufacturer's limitations on bending radii.

3.02 INSTALLATION OF RACEWAYS

- A. Comply with state and local regulatory requirements for installation of conduits and wireways.
- B. Install manufactured conduit sweeps and long-radius elbows whenever possible.

3.03 INSTALLATION OF CABLES

- A. Comply with NECA 1.
- B. General Requirements:
 - 1. Terminate conductors; no cable shall contain unterminated elements. Make terminations only at outlets and terminals.
 - 2. Refer to Section 27 10 00 "Structured Cabling System" for termination requirements associated with "Category" cabling to be used for smart restroom systems.
 - 3. Splices, Taps, and Terminations: Arrange on numbered terminal strips in junction, pull, and outlet boxes; terminal cabinets; and equipment enclosures. Cables may not be spliced.
 - 4. Secure and support cables at intervals not exceeding 30 inches and not more than 6 inches from cabinets, boxes, fittings, outlets, racks, frames, and terminals.
 - 5. Do not install bruised, kinked, scored, deformed, or abraded cable. Do not splice cable between termination, tap, or junction points. Remove and discard cable if damaged during installation and replace it with new cable.
 - 6. Cold-Weather Installation: Bring cable to room temperature before de-reeling. Heat lamps shall not be used.

- C. Open-Cable Installation:
 - 1. Suspend cable not in a wireway or pathway a minimum of 8 inches above ceiling by cable supports not more than 60 inches apart.
 - 2. Cable shall not be run through structural members or be in contact with pipes, ducts, or other potentially damaging items.
- D. Separation of Wires: Separation requirements for data cabling described in section 27 10 00 "Structured Cabling System" shall apply to all data cabling required for the smart restroom systems.

3.04 INSTALLATION

A. Identification of Conductors and Cables: Color-code conductors and apply wire and cable marking tape to designate wires and cables so they identify media in coordination with system wiring diagrams.

3.05 GROUNDING

A. Ground cable shields and equipment to eliminate shock hazard and to minimize ground loops, common-mode returns, noise pickup, cross talk, and other impairments.

3.06 SOFTWARE PROGRAMMING

- A. Programming: Fully brief Owner on available programming options, e.g., alert threshold settings, user account privileges, mobile app management functions, etc. Record Owner's decisions and set up initial system configuration. Prepare a written record of decisions, implementation methodology and final results.
- B. User Interfaces/Dashboard Layouts: Based upon the unique features of the smart restroom system, fully brief Owner on the available options for presenting information via the various display screens, user interfaces, and dashboards. After initial requirements are identified and the owner requires it for full functionality of the system, provide customized layouts for the Owner's review and approval. Up to three (3) review iterations should be anticipated. As a minimum, the customized screen layouts shall include the following:
 - 1. One (1) dedicated dashboard for each restroom included in the project.
 - 2. Five (5) overview dashboards that convey overall status of all restrooms, supplies, and cleaning status.

3.07 FIELD QUALITY CONTROL

- A. Manufacturer's Field Service: Engage a factory-authorized service representative to test and inspect components, assemblies, and equipment installations, including connections.
- B. Tests and Inspections:
 - 1. Schedule tests with at least seven days' advance notice.
 - 2. After installing smart restroom systems and after electrical circuitry has been energized, test for compliance with requirements.
 - 3. Operational Tests:
 - a. BIS Platform Test N/A
 - 1) Verify URL and Database Setup

- 2) Verify all data APIs are active and triggering effectively
- 3) Verify all user information has been accurately entered into the BIS
- 4) Verify report generation
- b. Throughput Test
 - 1) Demonstrate input/output to be accurate
 - 2) Verify network is active
 - 3) Verify data APIs are active
 - 4) Verify throughput counting alerts are activated.
 - 5) Verify throughput thresholds can be adjusted and the alert activations coincide with new thresholds.
- c. Stall Occupancy System Test
 - 1) Verify API is active
 - 2) Verify network is active
 - 3) Demonstrate all lights/sensors are functional and trigger events through light changes and via API
 - 4) Verify map on URL accurately reflects stall numbers and visualizations of opens/closes are accurate
- d. Mobile App/Activity
 - 1) Verify API is active
 - 2) Verify presence duration threshold timer is properly configured.
 - 3) Verify mobile device presence restarts throughput counter at the end of the threshold period.
 - 4) Verify mobile device presence does not restart the throughput counter if duration is less than the threshold period.
 - 5) Verify presence thresholds can be adjusted and the resetting of throughput counters coincide with new thresholds.
- C. Inspection: Verify that units and controls are properly labeled, and interconnecting wires and terminals are identified.
- D. Smart restroom systems will be considered defective if they do not pass tests and inspections.
- E. Prepare test and inspection reports.

3.08 STARTUP SERVICE

- A. Engage a factory-authorized service representative to perform startup service and initial system programming].
 - 1. Verify that device installations comply with manufacturer's submittal and installation requirements.
 - 2. Complete installation and startup check according to manufacturer's written instructions.

3.09 ADJUSTING

- A. On-Site Assistance: Engage a factory-authorized service representative to provide on- site assistance in adjusting devices, controls, and software settings to meet occupancy conditions.
- B. Occupancy Adjustments: When requested within three (3) months of date of Substantial Completion, provide on-site assistance in adjusting system to suit actual occupied conditions. Provide up to one visit to Project site during other-than-normal occupancy hours for this purpose.

3.10 DEMONSTRATION

- A. Comply with the applicable provisions of Division 01 specifications including, but not limited to, Section 01 79 00 Demonstration and Training.
- B. Engage a factory-authorized service representative to train Owner's System Administrator and IT Staff, Custodial Supervisors, custodians, and maintenance personnel to adjust, operate, and maintain the smart restroom systems. Training shall cover all deployed technologies.
- C. All training shall take place at the Field House over a two-day period. Training shall be conducted by qualified personnel fully conversant on the equipment, materials, software, and overall operation of the installed systems. Multiple sessions for each training module shall be scheduled to accommodate both day and night shifts during their normal working hours. Each training shall contain both lecture discussions and hands-on demonstrations.
- D. In addition to module-specific training guides, training materials shall include system documentation, as-built drawings, and O&M manuals.
- E. As a minimum, training modules shall include:
 - 1. Maintenance and IT Technical Support Staff (minimum of 2 hours/session)
 - a. Site visit to provide orientation of device locations
 - b. First level trouble shooting
 - c. Equipment restarting
 - d. Network Connectivity repair
 - e. Threshold setup
 - 2. Custodian Training (minimum of 1 hour/session) ONLY if customer survey and/or custodial tablets are being utilized in the project.
 - a. How to operate/interact with tablets
 - b. How to view dashboards
 - c. How to use mobile devices
 - 3. Custodial Supervisor Training (minimum of 2 hours/session) ONLY if customer survey and/or custodial tablets and/or BIS solutions are being utilized in the project.
 - a. Custodian Training (described above)
 - b. Reports and business intelligence review
 - c. Mobile device use and threshold restarting
 - d. Customer survey feedback alerts/data review
 - e. Predictive analytics overview
 - f. Dashboard reviews
 - 4. Administrator Training (minimum of 3 hours/session)
 - a. Maintenance and IT Technical Support Staff Training (described above)
 - b. Custodian Training (described above)
 - c. Custodial Supervisor Training (described above)
 - d. Administrative rights and access to BIS portal
 - e. User rights set up/configuration
 - f. Alerts set up/configuration

3.11 SYSTEM WARRANTY

- A. Comply with the applicable provisions of Division 01 specifications including, but not limited to, Section 01 77 00 Closeout Procedures.
- B. The Contractor shall warrant the smart restroom systems against defects in materials and

workmanship, including any required parts and labor, during the one (1) year warranty period from date of smart restroom final acceptance or beneficial use, whichever occurs first, of the completed smart restroom system at no additional cost to the project.

- 1. Stall indicator lights shall be warranted for a period of five (5) years from date of final acceptance or beneficial use, whichever occurs first.
- C. During the warranty period, all software updates and bug fixes shall be provided to the Owner at no additional cost as a part of the annual Service Level Agreement (SLA).

3.12 MAINTENANCE SUPPORT

- A. The Work includes a one-year Service Level Agreement (SLA) which coincides with the warranty period. The SLA shall include both hardware and software licensing and support in accordance with the following:
 - 1. 24/7/365 technical support for all troubleshooting and questions. The technical support services shall include a Help Desk that includes the following:
 - a. The Help Desk shall be based in North America to provide toll-free telephone support to Owner's personnel.
 - b. In the event all lines are busy, the Help Desk shall include an answering service.
 - c. The Help Desk shall issue a return email or issue a call to provided telephone number(s) within the time frames identified later in this section.
 - d. Upon receipt of a request for assistance by either phone or email, a case number notification will be issued to the Owner's designated representative.
 - 2. All technical support requests will be recorded and tracked through completion.
 - 3. Requests for technical support shall be responded to in a timely manner. The Contractor shall respond (i.e. telephone call, email reply) to all such requests. Issues or problems shall be assigned to appropriate specialists/service personnel and resolved in the time frames set out below.

Severity Level	Definition	Minimum Response Times	Maximum Resolution Times
1. System Down	Mainframe, server or back end systems failure	Immediate	Within 4 hours
2. Critical	Business outage or significant customer impact that threatens future productivity	Within 2 hours	Within 8 hours
3. Urgent	High-impact problem where production is proceeding, but in a significantly impaired fashion; there is a time- sensitive issue important to long term productivity that is not causing an immediate work stoppage; or there is significant customer concern.	Within 4 hours	Within 8 hours
4. Important	Important issue that does not have significant current productivity impact	Within 1 business day	Within 24 hours

5. Monitor	Issue requiring no further action beyond monitoring for follow- up, if needed	1-2 business days	
6. Informational	Request for information only	1-2 business days	

- 4. If technical support requests cannot be resolved remotely or over the phone, the Contractor shall provide "on-call" corrective maintenance services for all installed hardware and software. Qualified maintenance personnel shall respond on-site, if required, on the next business day following the service request. This service shall include all labor, material, travel expenses, and incidentals at no additional cost to the Owner.
- 5. The Contractor shall maintain complete logs of all maintenance activities including service calls, corrective maintenance, component failures, etc. The maintenance logs shall be made available to the Owner upon request.

3.13 SPARE PARTS

- A. As a requirement of Project Closeout, the following materials shall be turned over to the Owner for storage on site.
 - 1. A minimum of 10 or 10% (whichever is greater) stall **sensor/**indicator light assemblies
 - 2. A minimum of 1 or 10% (whichever is greater) stall occupancy system controller/hub
 - 3. A minimum of 1 or 10% (whichever is greater) customer survey tablet with loaded application(s)
 - 4. A minimum of 1 or 10% (whichever is greater) BLE Beacon
- B. Any spare parts used by the Contractor to replace defective components during the warranty period shall be immediately replaced and returned to the Owner's spare equipment stock at no cost to the Owner.

END OF SECTION 27 42 20

SECTION 27 42 20 - ADD #1

SMART RESTROOM SYSTEM

PART 1 - GENERAL

1.01 RELATED DOCUMENTS

A. Drawings and general provisions of the Contract, including General and Supplementary Conditions and Division 01 Specification Sections, apply to this Section.

1.02 SUMMARY

- A. Section includes smart restroom systems with the following subsystems/components:
 - 1. Cloud-based Business Intelligence Software and Mobile App.
 - 2. Stall Occupancy System
 - 3. Throughput Counters
 - 4. Ancillary Equipment
 - 5. Conductors and Cables.
- B. Related requirements:
 - 1. Section 08 31 00 Access Doors and Panels
 - 2. Section 10 28 00 Toilet, Bath, and Laundry Accessories
 - 3. Section 26 05 19 Low Voltage Electrical Power Conductors and Cables
 - 4. Section 26 05 33 Raceway and Boxes for Electrical Systems
 - 5. Section 27 10 00 Structured Cabling System

1.03 ACTION SUBMITTALS

- A. Product Data: For each type of product. Product data submittal shall clearly identify any/all options (colors, features, functions, etc.) to be provided for the project.
- B. Shop Drawings:
 - 1. Include plans, elevations, sections, and mounting details.
 - 2. Include details of equipment assemblies. Indicate dimensions, weights, loads, required clearances, method of field assembly, components, and location and size of each field connection.
 - 3. Include scaled drawings for indicator lights, wall-mounted tablets and any other devices that will be mounted in areas visible to the public.
 - 4. Include diagrams for power, signal, and communications wiring.
 - a. Identify terminals to facilitate installation, operation, and maintenance.
 - b. Single-line diagram showing interconnection of components.
 - c. Cabling diagram showing cable routing.
 - 5. Provide details of all types of wireless connectivity. Provide specific information on frequency band usage and any expectation of connectivity to be provided by the Owner. Details shall include proposed security provisions to protect data transmissions.

1.04 INFORMATIONAL SUBMITTALS

- A. Coordination Drawings:
 - 1. Reflected ceiling plans, drawn to scale, on which ceiling-mounted items including smart

restroom devices, luminaires, diffusers, grilles, speakers, sprinklers, access panels, and special moldings are shown and coordinated with each other, using input from installers of the items involved.

- 2. Elevation drawings, drawn to scale, on which wall-mounted items including survey tablets, digital signage, luminaires, windows, doors, access panels, wall finishes, and trims are shown and coordinated with each other, using input from installers of the items involved.
- B. Qualification Data:
 - 1. Installers.
 - 2. Testing personnel
 - 3. Training personnel
- C. Field quality-control reports.

1.05 CLOSEOUT SUBMITTALS

- A. Record Drawings:
 - 1. In addition to items specified in Section 01 78 39 "Project Record Documents," include the following:
 - a. Updates to Shop Drawings which denote actual installed conditions.
 - b. Particular emphasis shall be placed on documenting the locations of devices and power/data circuits installed behind finished surfaces.
- B. Operation and Maintenance Data:
 - 1. In addition to any items specified in Section 01 78 23 "Operation and Maintenance Data," include the following:
 - a. A record of Owner's equipment-programming option decisions.
 - b. Plans, drawn to scale, indicating location, designation, and connection of smart restroom system components.
- C. Software Operational Documentation:
 - 1. Software operating and upgrade manuals.
 - 2. Device address list.
 - 3. Screenshots of final display arrangements/dashboards.

1.06 QUALITY ASSURANCE

A. Installer Qualifications: An authorized representative(s) who is trained and approved by manufacturer(s).

1.07 COORDINATION

- A. Ceilings: Coordinate layout and installation of ceiling-mounted smart restroom devices with other construction that penetrates ceilings or is supported by them, including light fixtures, HVAC equipment, fire-suppression system, and partition assemblies. Installation of in-ceiling or above-ceiling devices must allow for maintenance access. Where installations occur in hard ceilings, provide devices that may be removed from below ceiling, or provide ceiling access panels to support maintenance access from above ceilings. Coordinate ceiling access panels/placements with the Architect and the ceiling work of other disciplines.
- B. Power: Coordinate all power requirements with electrical work. Ensure all electrical connections are accessible for disconnect and maintenance purposes.
- C. Communications: Proposed communications schemes must be coordinated with and approved

by the Owner's IT Department. Whether communications include the use of Owner's public/private Wi-Fi, contracted Wi-Fi vendor, establishing a new dedicated Wi- Fi system, Bluetooth, cellular data, hardwired connections to Owner's network, or a combination thereof, such communications schemes must meet the Owner's approval. Refer to the Contract Drawings for proposed communications schemes. Deviations must be fully coordinated and approved by the Owner.

D. Screen Designs: Coordinate all screen layouts (i.e., survey tablets, Business Intelligence Software (BIS) dashboards, and Mobile App screen layouts) directly with the Owner. Owner's approval must be obtained prior to deployment.

PART 2 - PRODUCTS

2.01 SYSTEM DESCRIPTION

- A. Equipment: Modular, using solid-state components, and rated for continuous duty unless otherwise indicated. Select equipment for normal operation on input power supplied at 110 to 130 V, 60 Hz without requirement of any external power conditioning equipment.
- B. Software: Business Intelligence Software (BIS): None required for sensors in standalone mode.
- C. Coordinate features and select subsystems/components to form a fully integrated system. Match components and subsystems for optimum performance of specified functions.

2.02 FUNCTIONAL DESCRIPTION

- A. Business Intelligence Software: None required for sensors in standalone mode.
- B. Restroom and/or Stall Occupancy: Each restroom and/or stall will be equipped with a combination sensor/indicator light installed at those locations designated on the Contract Drawings. Persons entering and exiting the stalls shall be detected by the sensor and shall cause the light to toggle between green/blue and red. The sensor shall be designed/configured to not trigger as a result of routine personnel movements in the corridor outside the restroom and/or stalls. In addition, multiple persons entering/exiting a restroom and/or stall, e.g., caretaker and child, shall be detected as a singular event. The lights shall be placed in a manner to provide a clear indication to personnel as to which restrooms and/or stalls are occupied. Data received from the sensors/lights shall be populated into the BIS so that occupancy for the individual restrooms and/or stalls can be tracked in real time.
- C. Throughput Counting: Sensors shall be installed in the entries and exits of each restroom to track the movement of patrons to/from each individual restroom. The sensors will be used to support the following functions:
 - 1. Each restroom shall be configured with a threshold value associated with throughput. The threshold shall be configurable by the Owner and may vary based upon the size of each restroom.

2.03 BUSINESS INTELLIGENCE SOFTWARE – N/A

- A. Web-hosted application that can be accessed by authorized users from a variety of web browsers/devices.
- B. The basis of design for smart bathroom installations at the high school is a standalone sensor

system for restroom occupancy indication only.

2.04 STALL OCCUPANCY SYSTEM

- A. Occupancy Sensors/Indicator Lights: Ceiling or wall-mounted LED lights with integrated sensors that connect wirelessly to the system hub. Sensors/lights shall be powered via Zurn Z-PWRSUP-W1 mounted in Raco 260 electrical box in plenum that shall provide 12VDC power to daisy-chained power connections on sensors/lights.
 - 1. Basis-of-Design Product: Subject to compliance with requirements, provide the Z-LIGHT-W1 system provided by Zurn Industries, LLC.
 - 2. Sensor/Light: Mounting: Units shall be ceiling or wall-mounted with consideration of the ceiling heights required under this project (typically 10') and the top of the sensor shall not exceed 8' 6" after finished floor. Sensors shall communicate via a wireless meshed network back to the system hub.
 - 3. LED Light Color: Green/Red and Blue/Red (for handicapped stalls).
 - 4. Power Supply: The system shall be powered via Z-PWRSUP-W1 12VDC power supplies to support up to 40 connected devices.
 - 5. Internet Reporting Device with Smart Hub: System shall interface with the BIS via the cloud.
 - 6. The system shall provide the following capabilities:
 - a. Provide all local wireless communications equipment, communications gateways, power supplies and cabling, data services, cloud-hosting services, and licensing required to collect data from the sensors identified above and to control the associated status lights.
 - b. Provide an application programming interface (API) and associated support/development services, if necessary, to allow information collected from the sensors to be shared with the Owner's existing Smart Restroom System should there be one existing.
 - c. Provide all data services, hosting services, licensing, and maintenance support services, etc., required to provide a fully functional expansion to the TRAX smart restroom system. Such services must meet the performance period, licensing, and support service requirements identified within Part 3 of this specification section.

2.05 ANCILLARY EQUIPMENT

- A. Provide all ancillary equipment required to provide fully functional smart restroom installations. Such equipment shall vary by manufacturer and specific system requirements. Ancillary equipment for this project includes, but is not necessarily limited to, the following:
 - 1. Network Equipment: Provide connections to all PoE network switches required to support the proposed solution.
 - 2. Power Supplies: Provide power supplies as needed to support the proposed solution. Coordinate power supply connections with electrical outlets.
 - 3. Specialty Cables: Provide any/all specialty cable required to interconnect system components.

2.06 CONDUCTORS AND CABLES

- A. Provide cables that fully comply with manufacturer's recommendations.
- B. Refer to Section 27 10 00 "Structured Cabling System" for "Category" cabling to be used for smart restroom system ethernet hubs where indicated.

- C. Conductors: Jacketed, twisted pair and twisted multipair, untinned solid copper. Sizes as recommended by system manufacturer, but no smaller than No. 24 AWG.
- D. Insulation: Thermoplastic, not less than 1/32 inch thick.
- E. Plenum Cable: Listed and labeled for plenum installation.

2.07 RACEWAYS

- A. If required, smart restroom system raceways and boxes shall comply with requirements in state and local codes.
- B. Outlet boxes shall be not less than 2 inches wide, 3 inches high, and 2-1/2 inches deep.

PART 3 - EXECUTION

3.01 WIRING METHODS

- A. Wiring Method: Conceal conductors and cables in accessible ceilings, walls, and floors where possible.
 - 1. Install plenum cable in environmental air spaces, including plenum ceilings.
- B. Wiring within Enclosures: Bundle, lace, and train conductors to terminal points with no excess and without exceeding manufacturer's limitations on bending radii.

3.02 INSTALLATION OF RACEWAYS

- A. Comply with state and local regulatory requirements for installation of conduits and wireways.
- B. Install manufactured conduit sweeps and long-radius elbows whenever possible.

3.03 INSTALLATION OF CABLES

- A. Comply with NECA 1.
- B. General Requirements:
 - 1. Terminate conductors; no cable shall contain unterminated elements. Make terminations only at outlets and terminals.
 - 2. Refer to Section 27 10 00 "Structured Cabling System" for termination requirements associated with "Category" cabling to be used for smart restroom systems.
 - 3. Splices, Taps, and Terminations: Arrange on numbered terminal strips in junction, pull, and outlet boxes; terminal cabinets; and equipment enclosures. Cables may not be spliced.
 - 4. Secure and support cables at intervals not exceeding 30 inches and not more than 6 inches from cabinets, boxes, fittings, outlets, racks, frames, and terminals.
 - 5. Do not install bruised, kinked, scored, deformed, or abraded cable. Do not splice cable between termination, tap, or junction points. Remove and discard cable if damaged during installation and replace it with new cable.
 - 6. Cold-Weather Installation: Bring cable to room temperature before de-reeling. Heat lamps shall not be used.

- C. Open-Cable Installation:
 - 1. Suspend cable not in a wireway or pathway a minimum of 8 inches above ceiling by cable supports not more than 60 inches apart.
 - 2. Cable shall not be run through structural members or be in contact with pipes, ducts, or other potentially damaging items.
- D. Separation of Wires: Separation requirements for data cabling described in section 27 10 00 "Structured Cabling System" shall apply to all data cabling required for the smart restroom systems.

3.04 INSTALLATION

A. Identification of Conductors and Cables: Color-code conductors and apply wire and cable marking tape to designate wires and cables so they identify media in coordination with system wiring diagrams.

3.05 GROUNDING

A. Ground cable shields and equipment to eliminate shock hazard and to minimize ground loops, common-mode returns, noise pickup, cross talk, and other impairments.

3.06 SOFTWARE PROGRAMMING

- A. Programming: Fully brief Owner on available programming options, e.g., alert threshold settings, user account privileges, mobile app management functions, etc. Record Owner's decisions and set up initial system configuration. Prepare a written record of decisions, implementation methodology and final results.
- B. User Interfaces/Dashboard Layouts: Based upon the unique features of the smart restroom system, fully brief Owner on the available options for presenting information via the various display screens, user interfaces, and dashboards. After initial requirements are identified and the owner requires it for full functionality of the system, provide customized layouts for the Owner's review and approval. Up to three (3) review iterations should be anticipated. As a minimum, the customized screen layouts shall include the following:
 - 1. One (1) dedicated dashboard for each restroom included in the project.
 - 2. Five (5) overview dashboards that convey overall status of all restrooms, supplies, and cleaning status.

3.07 FIELD QUALITY CONTROL

- A. Manufacturer's Field Service: Engage a factory-authorized service representative to test and inspect components, assemblies, and equipment installations, including connections.
- B. Tests and Inspections:
 - 1. Schedule tests with at least seven days' advance notice.
 - 2. After installing smart restroom systems and after electrical circuitry has been energized, test for compliance with requirements.
 - 3. Operational Tests:
 - a. BIS Platform Test N/A
 - 1) Verify URL and Database Setup

- 2) Verify all data APIs are active and triggering effectively
- 3) Verify all user information has been accurately entered into the BIS
- 4) Verify report generation
- b. Throughput Test
 - 1) Demonstrate input/output to be accurate
 - 2) Verify network is active
 - 3) Verify data APIs are active
 - 4) Verify throughput counting alerts are activated.
 - 5) Verify throughput thresholds can be adjusted and the alert activations coincide with new thresholds.
- c. Stall Occupancy System Test
 - 1) Verify API is active
 - 2) Verify network is active
 - 3) Demonstrate all lights/sensors are functional and trigger events through light changes and via API
 - 4) Verify map on URL accurately reflects stall numbers and visualizations of opens/closes are accurate
- d. Mobile App/Activity
 - 1) Verify API is active
 - 2) Verify presence duration threshold timer is properly configured.
 - 3) Verify mobile device presence restarts throughput counter at the end of the threshold period.
 - 4) Verify mobile device presence does not restart the throughput counter if duration is less than the threshold period.
 - 5) Verify presence thresholds can be adjusted and the resetting of throughput counters coincide with new thresholds.
- C. Inspection: Verify that units and controls are properly labeled, and interconnecting wires and terminals are identified.
- D. Smart restroom systems will be considered defective if they do not pass tests and inspections.
- E. Prepare test and inspection reports.

3.08 STARTUP SERVICE

- A. Engage a factory-authorized service representative to perform startup service and initial system programming].
 - 1. Verify that device installations comply with manufacturer's submittal and installation requirements.
 - 2. Complete installation and startup check according to manufacturer's written instructions.

3.09 ADJUSTING

- A. On-Site Assistance: Engage a factory-authorized service representative to provide on- site assistance in adjusting devices, controls, and software settings to meet occupancy conditions.
- B. Occupancy Adjustments: When requested within three (3) months of date of Substantial Completion, provide on-site assistance in adjusting system to suit actual occupied conditions. Provide up to one visit to Project site during other-than-normal occupancy hours for this purpose.

3.10 DEMONSTRATION

- A. Comply with the applicable provisions of Division 01 specifications including, but not limited to, Section 01 79 00 Demonstration and Training.
- B. Engage a factory-authorized service representative to train Owner's System Administrator and IT Staff, Custodial Supervisors, custodians, and maintenance personnel to adjust, operate, and maintain the smart restroom systems. Training shall cover all deployed technologies.
- C. All training shall take place at the Field House over a two-day period. Training shall be conducted by qualified personnel fully conversant on the equipment, materials, software, and overall operation of the installed systems. Multiple sessions for each training module shall be scheduled to accommodate both day and night shifts during their normal working hours. Each training shall contain both lecture discussions and hands-on demonstrations.
- D. In addition to module-specific training guides, training materials shall include system documentation, as-built drawings, and O&M manuals.
- E. As a minimum, training modules shall include:
 - 1. Maintenance and IT Technical Support Staff (minimum of 2 hours/session)
 - a. Site visit to provide orientation of device locations
 - b. First level trouble shooting
 - c. Equipment restarting
 - d. Network Connectivity repair
 - e. Threshold setup
 - 2. Custodian Training (minimum of 1 hour/session) ONLY if customer survey and/or custodial tablets are being utilized in the project.
 - a. How to operate/interact with tablets
 - b. How to view dashboards
 - c. How to use mobile devices
 - 3. Custodial Supervisor Training (minimum of 2 hours/session) ONLY if customer survey and/or custodial tablets and/or BIS solutions are being utilized in the project.
 - a. Custodian Training (described above)
 - b. Reports and business intelligence review
 - c. Mobile device use and threshold restarting
 - d. Customer survey feedback alerts/data review
 - e. Predictive analytics overview
 - f. Dashboard reviews
 - 4. Administrator Training (minimum of 3 hours/session)
 - a. Maintenance and IT Technical Support Staff Training (described above)
 - b. Custodian Training (described above)
 - c. Custodial Supervisor Training (described above)
 - d. Administrative rights and access to BIS portal
 - e. User rights set up/configuration
 - f. Alerts set up/configuration

3.11 SYSTEM WARRANTY

- A. Comply with the applicable provisions of Division 01 specifications including, but not limited to, Section 01 77 00 Closeout Procedures.
- B. The Contractor shall warrant the smart restroom systems against defects in materials and

workmanship, including any required parts and labor, during the one (1) year warranty period from date of smart restroom final acceptance or beneficial use, whichever occurs first, of the completed smart restroom system at no additional cost to the project.

- 1. Stall indicator lights shall be warranted for a period of five (5) years from date of final acceptance or beneficial use, whichever occurs first.
- C. During the warranty period, all software updates and bug fixes shall be provided to the Owner at no additional cost as a part of the annual Service Level Agreement (SLA).

3.12 MAINTENANCE SUPPORT

- A. The Work includes a one-year Service Level Agreement (SLA) which coincides with the warranty period. The SLA shall include both hardware and software licensing and support in accordance with the following:
 - 1. 24/7/365 technical support for all troubleshooting and questions. The technical support services shall include a Help Desk that includes the following:
 - a. The Help Desk shall be based in North America to provide toll-free telephone support to Owner's personnel.
 - b. In the event all lines are busy, the Help Desk shall include an answering service.
 - c. The Help Desk shall issue a return email or issue a call to provided telephone number(s) within the time frames identified later in this section.
 - d. Upon receipt of a request for assistance by either phone or email, a case number notification will be issued to the Owner's designated representative.
 - 2. All technical support requests will be recorded and tracked through completion.
 - 3. Requests for technical support shall be responded to in a timely manner. The Contractor shall respond (i.e. telephone call, email reply) to all such requests. Issues or problems shall be assigned to appropriate specialists/service personnel and resolved in the time frames set out below.

Severity Level	Definition	Minimum Response Times	Maximum Resolution Times
1. System Down	Mainframe, server or back end systems failure	Immediate	Within 4 hours
2. Critical	Business outage or significant customer impact that threatens future productivity	Within 2 hours	Within 8 hours
3. Urgent	High-impact problem where production is proceeding, but in a significantly impaired fashion; there is a time- sensitive issue important to long term productivity that is not causing an immediate work stoppage; or there is significant customer concern.	Within 4 hours	Within 8 hours
4. Important	Important issue that does not have significant current productivity impact	Within 1 business day	Within 24 hours

5. Monitor	Issue requiring no further action beyond monitoring for follow- up, if needed	1-2 business days	
6. Informational	Request for information only	1-2 business days	

- 4. If technical support requests cannot be resolved remotely or over the phone, the Contractor shall provide "on-call" corrective maintenance services for all installed hardware and software. Qualified maintenance personnel shall respond on-site, if required, on the next business day following the service request. This service shall include all labor, material, travel expenses, and incidentals at no additional cost to the Owner.
- 5. The Contractor shall maintain complete logs of all maintenance activities including service calls, corrective maintenance, component failures, etc. The maintenance logs shall be made available to the Owner upon request.

3.13 SPARE PARTS

- A. As a requirement of Project Closeout, the following materials shall be turned over to the Owner for storage on site.
 - 1. A minimum of 10 or 10% (whichever is greater) stall **sensor/**indicator light assemblies
 - 2. A minimum of 1 or 10% (whichever is greater) stall occupancy system controller/hub
 - 3. A minimum of 1 or 10% (whichever is greater) customer survey tablet with loaded application(s)
 - 4. A minimum of 1 or 10% (whichever is greater) BLE Beacon
- B. Any spare parts used by the Contractor to replace defective components during the warranty period shall be immediately replaced and returned to the Owner's spare equipment stock at no cost to the Owner.

END OF SECTION 27 42 20



PKG 3A - GPHS NEW FIELDHOUSE Galena Park ISD

1000 Keene St, Galena Park, TX 77547

ISSUE FOR PROPOSAL

June 10, 2025



BOARD OF TRUSTEES

Mr. Ramon Garza Mrs. Linda Clark Sherrard Mr. Jose Jimenez Mrs. Adrian Stephens Mr. Noe Esparza Mrs. Norma Hernandez Mrs. Amanda Erebia

Board President	Dr
Board Vice President	Dr
Board Secretary	Mr
Board Trustee	Dr
Board Trustee	Mr
Board Trustee	Mr
Board Trustee	Mr

ARCHITECT **PBK ARCHITECTS, INC** 11 GREENWAY PLAZA **SUITE 2200** HOUSTON, TX 77046 T 713-965-0608



GPISD ADMINISTRATION

r. John C. Moore r. Wanna Giacona /Ir. Ben Pape Dr. Mechelle Epps Ar. Mike McKay Ars. Holli Malloy Ar. Jerid Link

Superintendent of Schools Chief Administrative Officer Chief Financial Officer Assistant Superintendent for Student Support Assistant Superintendent for Operations Assistant Superintendent for Academic Support Assistant Superintendent for Human Resource Services

CIVIL ENGINEER DIG ENGINEER 11 GREENWAY PLAZA SUITE 1510 HOUSTON, TX 77046 T 713-965-0608

STRUCTURAL ENGINEER **KUBALA ENGINEERS 11 GREENWAY PLAZA** SUITE 1510 HOUSTON, TX 77046 T 713-965-0608

GPISD ADMINISTRATION

Mr. Bryan Clements Mr. Lee Ramirez Dr. Kimberly Martin Ms. Vivian Dancy Mr. Ed Martir Mr. Trey Kraemer

Chief of Police/Executive Director for Security & Technology Executive Director for Operations executive Director for Accountability & Academics Director for Athletics Director for Facilities, Planning & Construction Campus Liaison

MEP ENGINEER LEAF ENGINEERS 11 GREENWAY PLAZA SUITE 1510 HOUSTON, TX 77046 T 713-965-0608

ENVELOPE CONSULTANT BEAM 11 GREENWAY PLAZA SUITE 1510 HOUSTON, TX 77046 T 713-965-0608













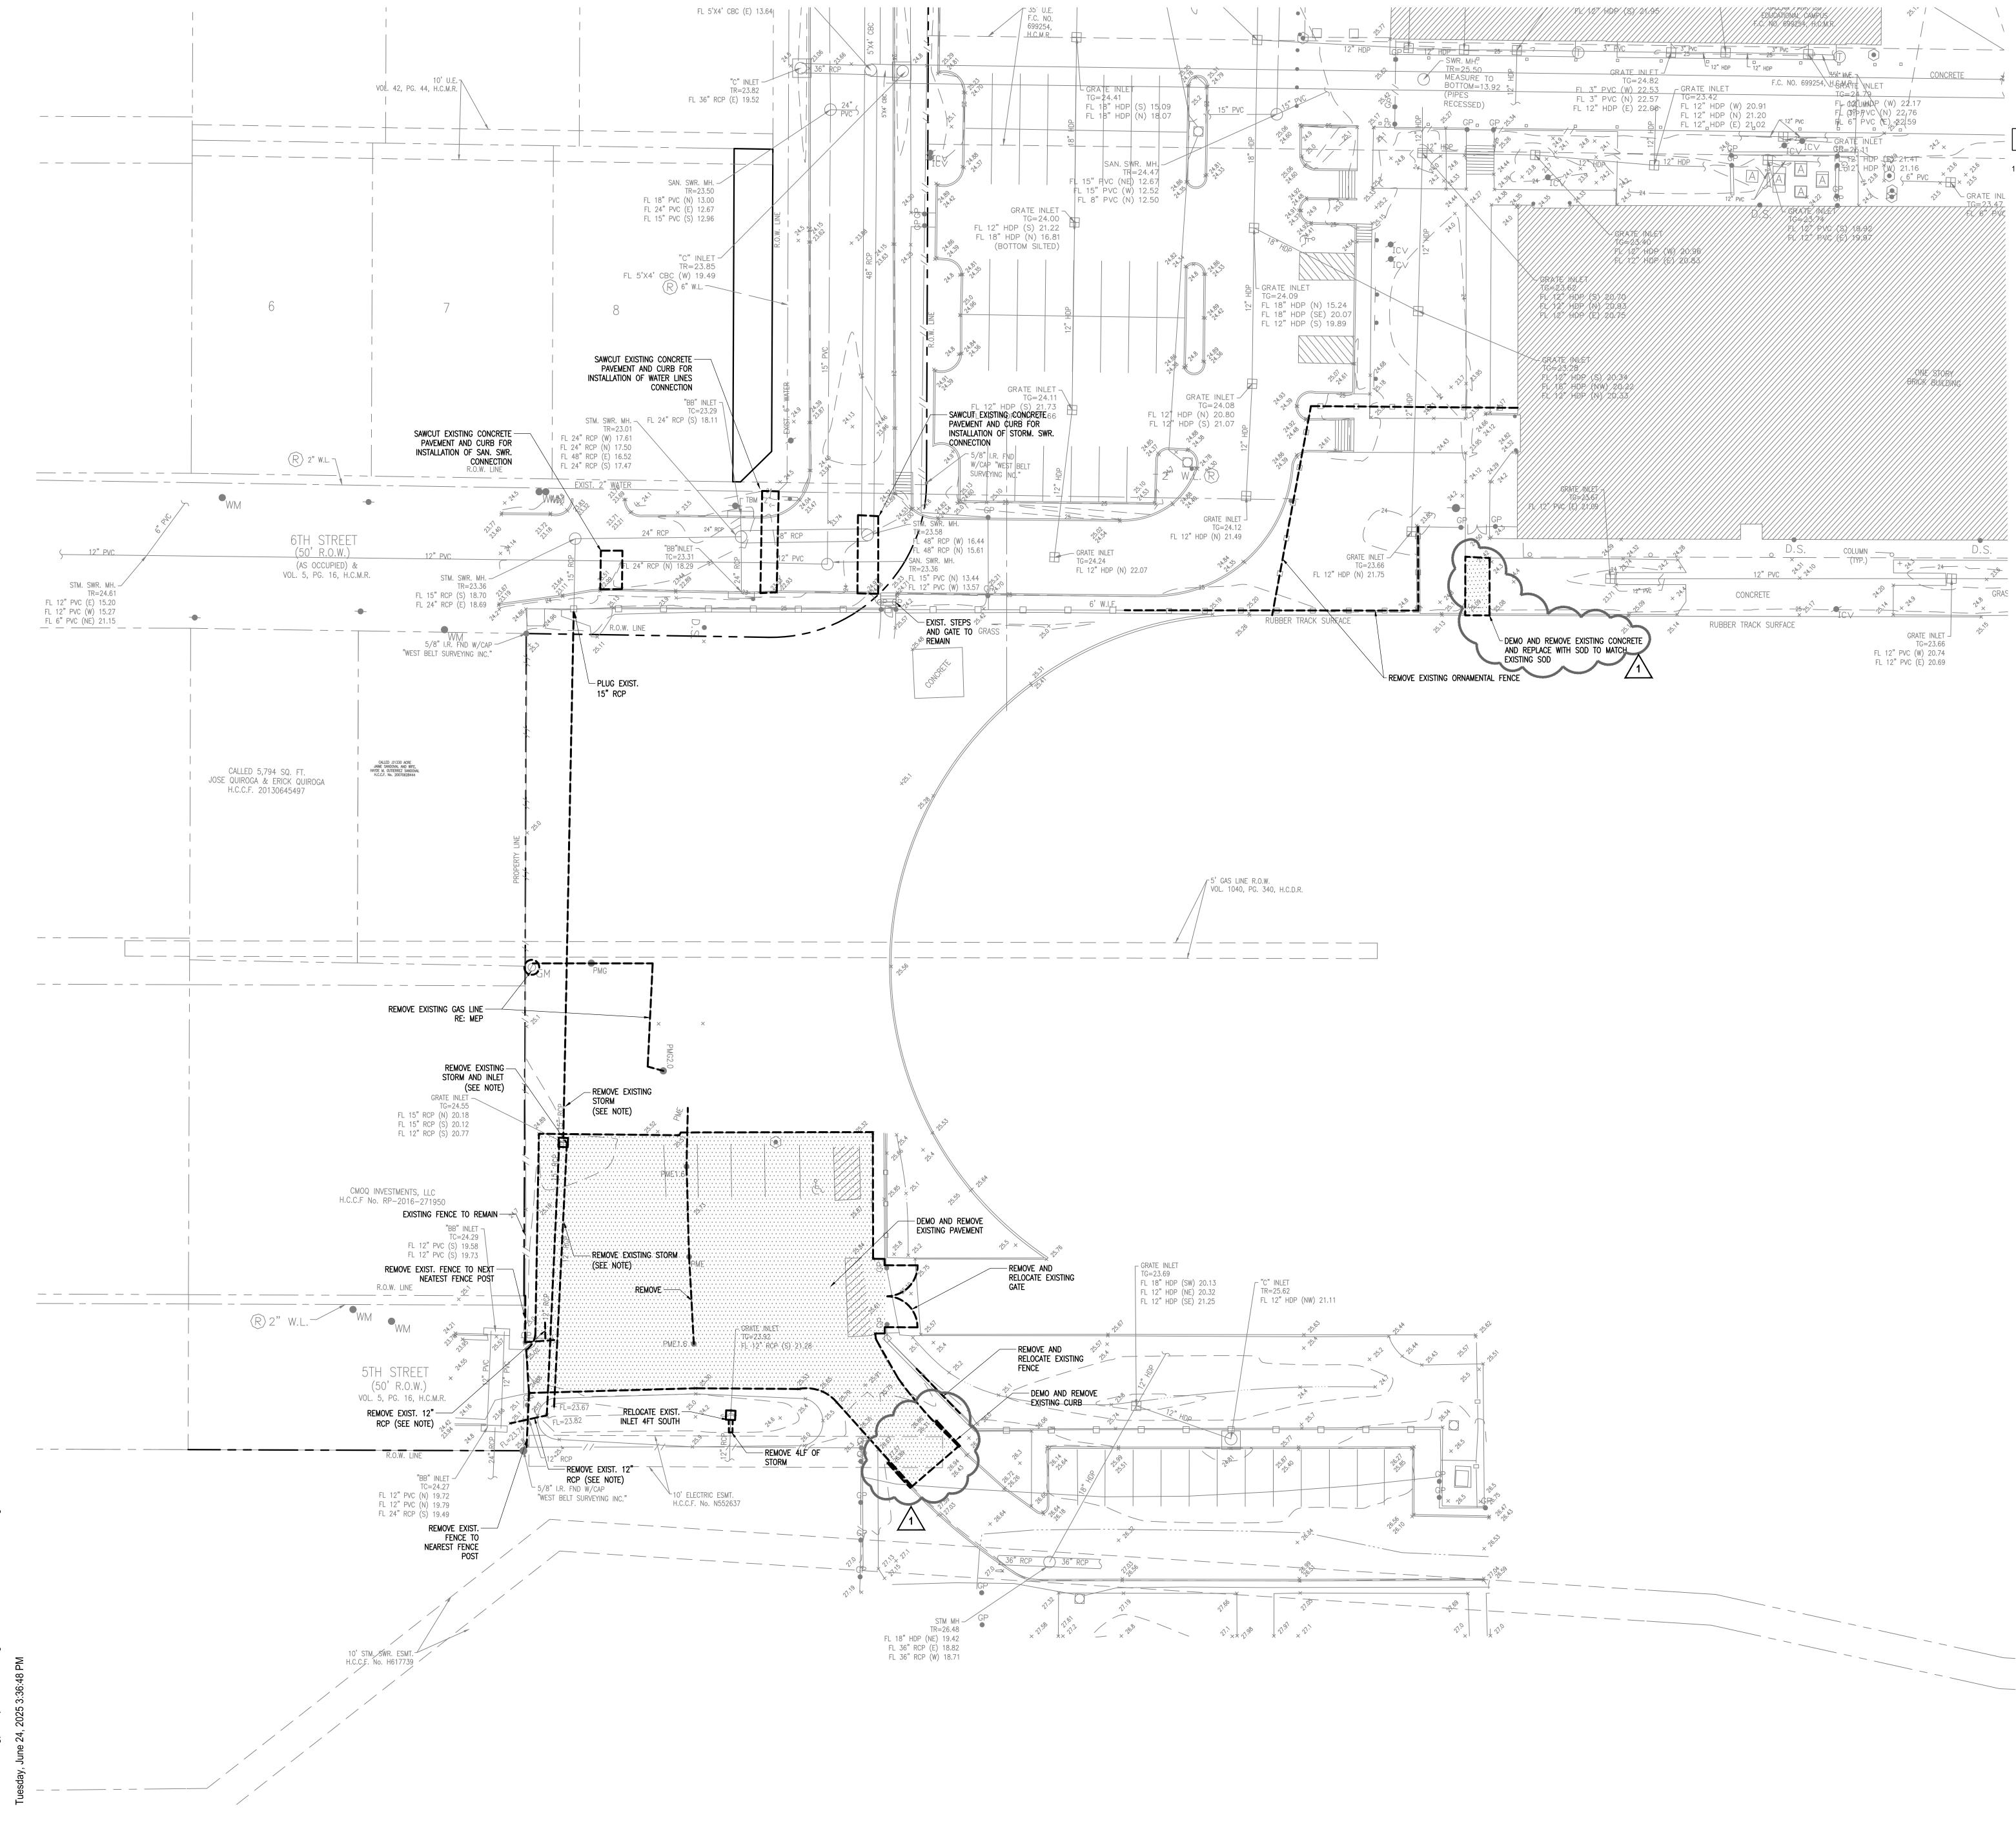

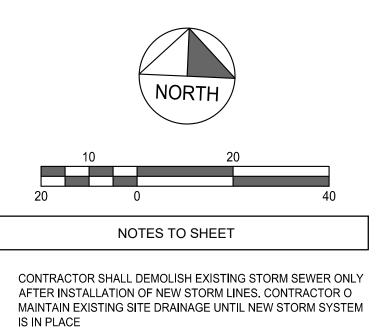





DEMOLITION PLAN

	07, 1169 07, 4/cen 07, 55/004	SED	
	CLI	ENT	
	DATE ne 24, 2025 VING HISTORY	PROJECT 1 2405	
No. Descrip		tion	Date
1	Addendu		06/24/2025
	ED BY:RKR		
	N BY: KS		



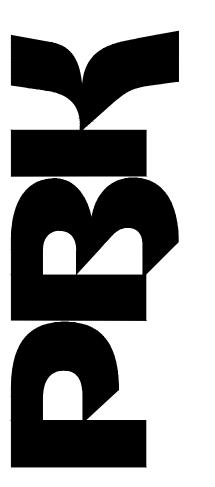




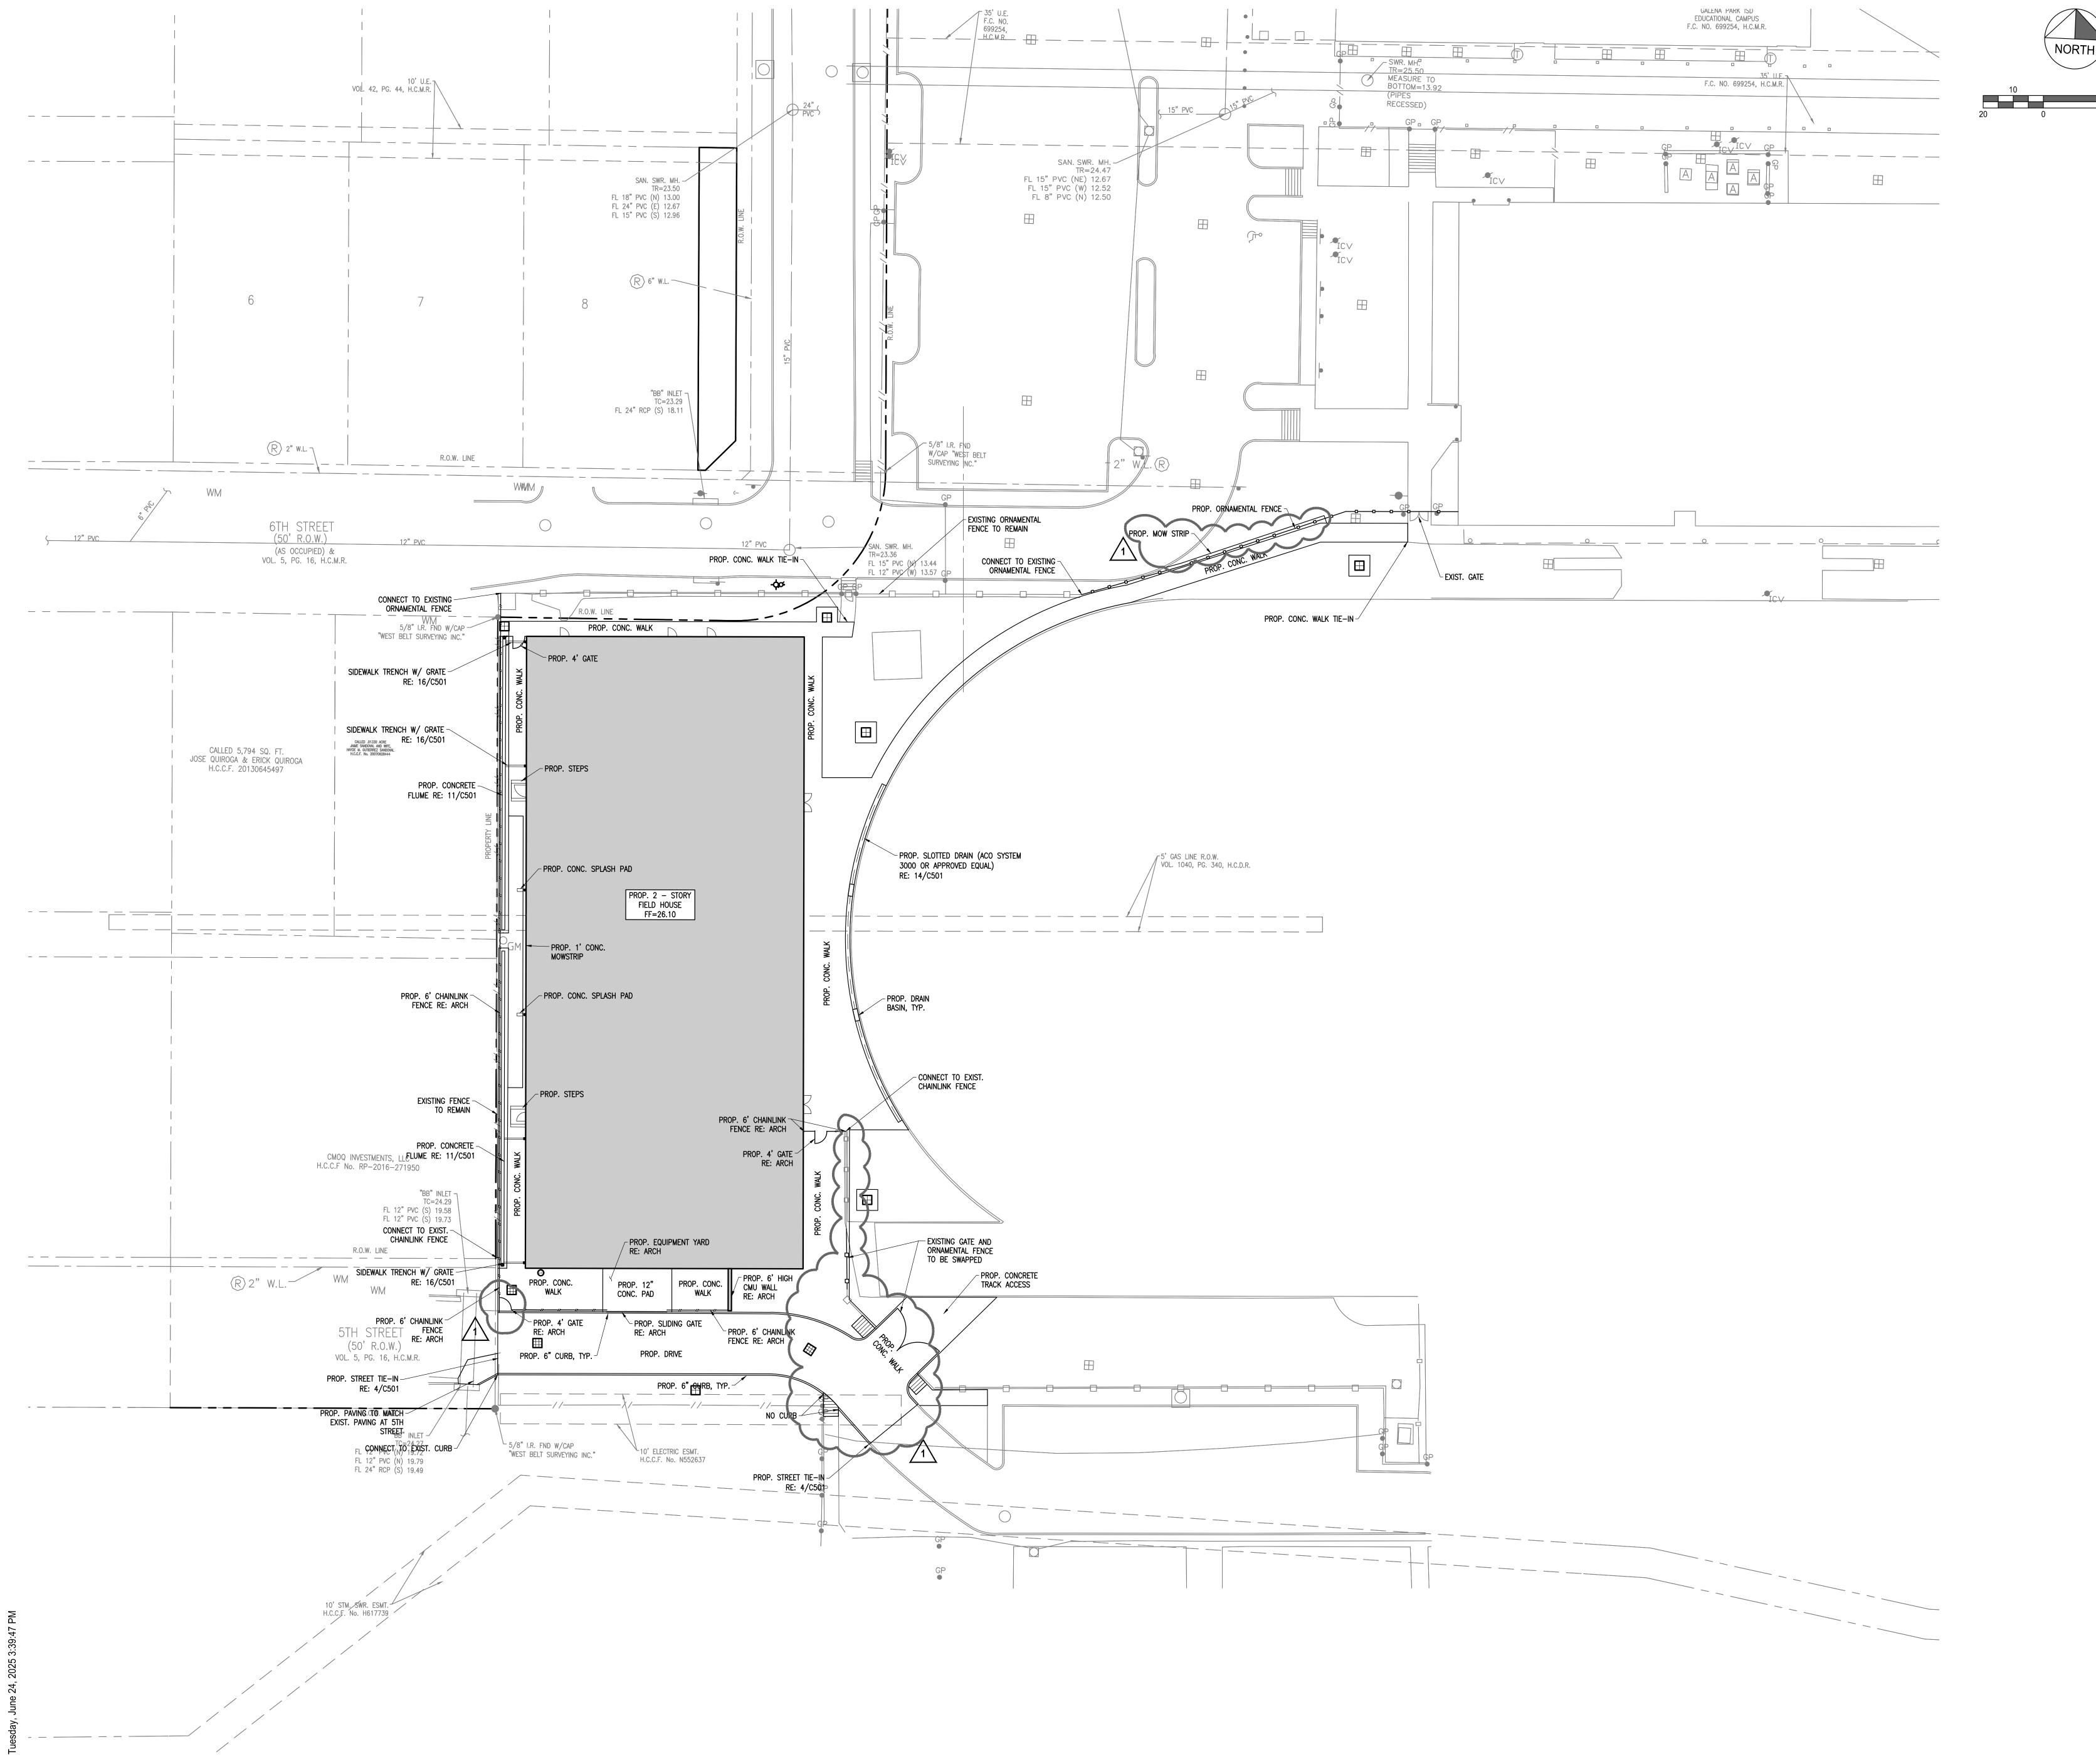





SITE PLAN

	7. 1169 7	068 ISED ISED ISED 06/10 DICENGIN F-1833			
CLIENT					
	DATE ne 24, 2025	PROJECT 1 2405			
No.		4ian	Date		
1	Addendur		06/24/2025		
	ED BY:RKR				

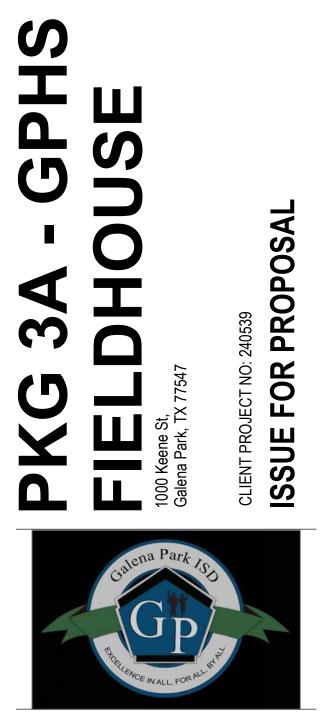



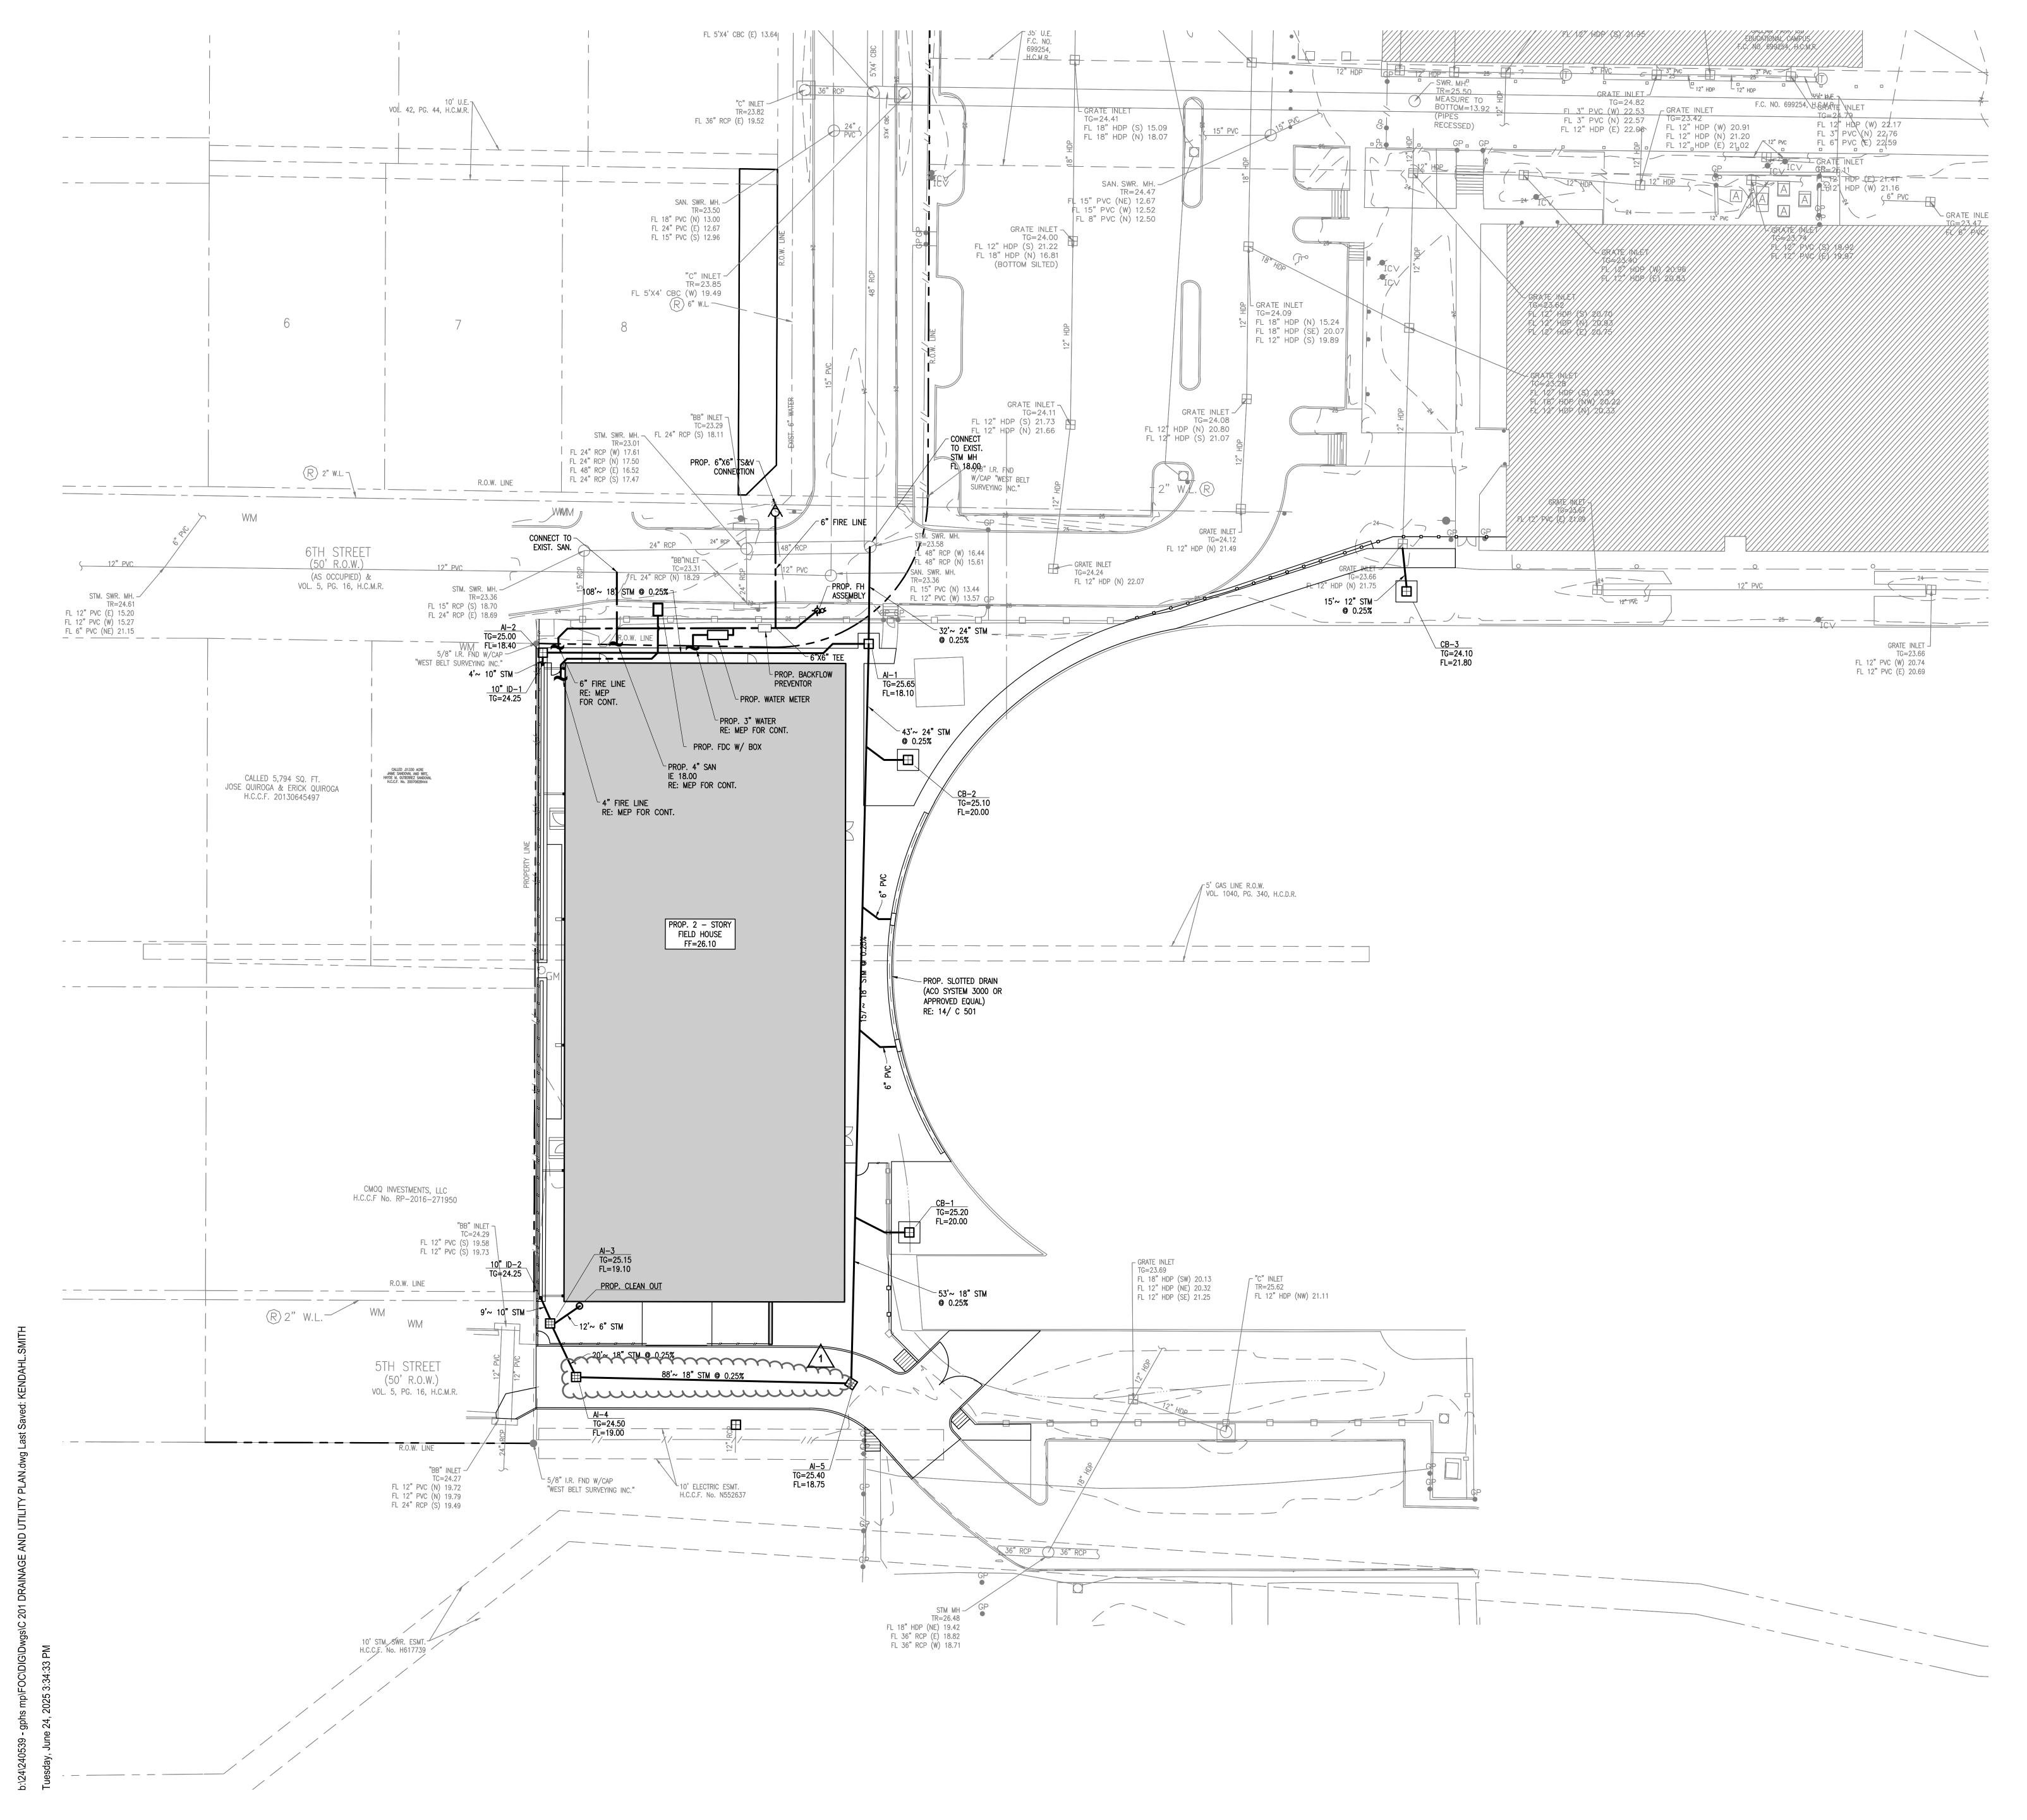


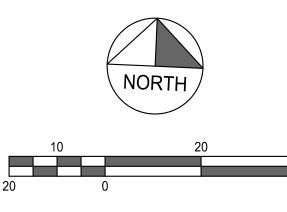





DRAINAGE AND UTILITY PLAN


	RAJEEB K. RA	JBHANDARI	
	о, 1169 О.К. ⁽ /се N С.К. ⁽ /се N		
	CS COLOR	ENG	
)/2025
		ENGIN F-183	
			20
	CLI	ENT	
	DATE	PROJECT	
	June 24, 2025	2405	539
DF	RAWING HISTORY		
No.	Descrip	tion	Date
1	Addendum 1		06/24/2025
CHE	CKED BY:RKR		
DRA\	WN BY: KS		

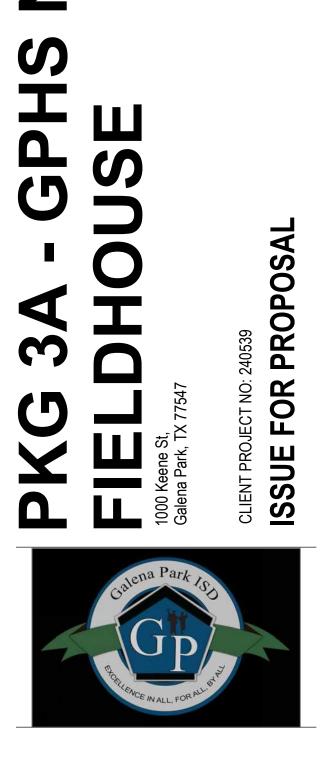

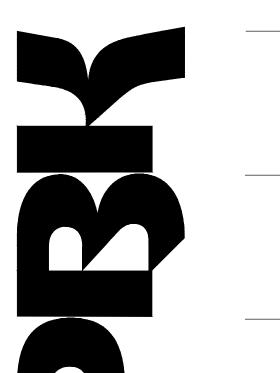



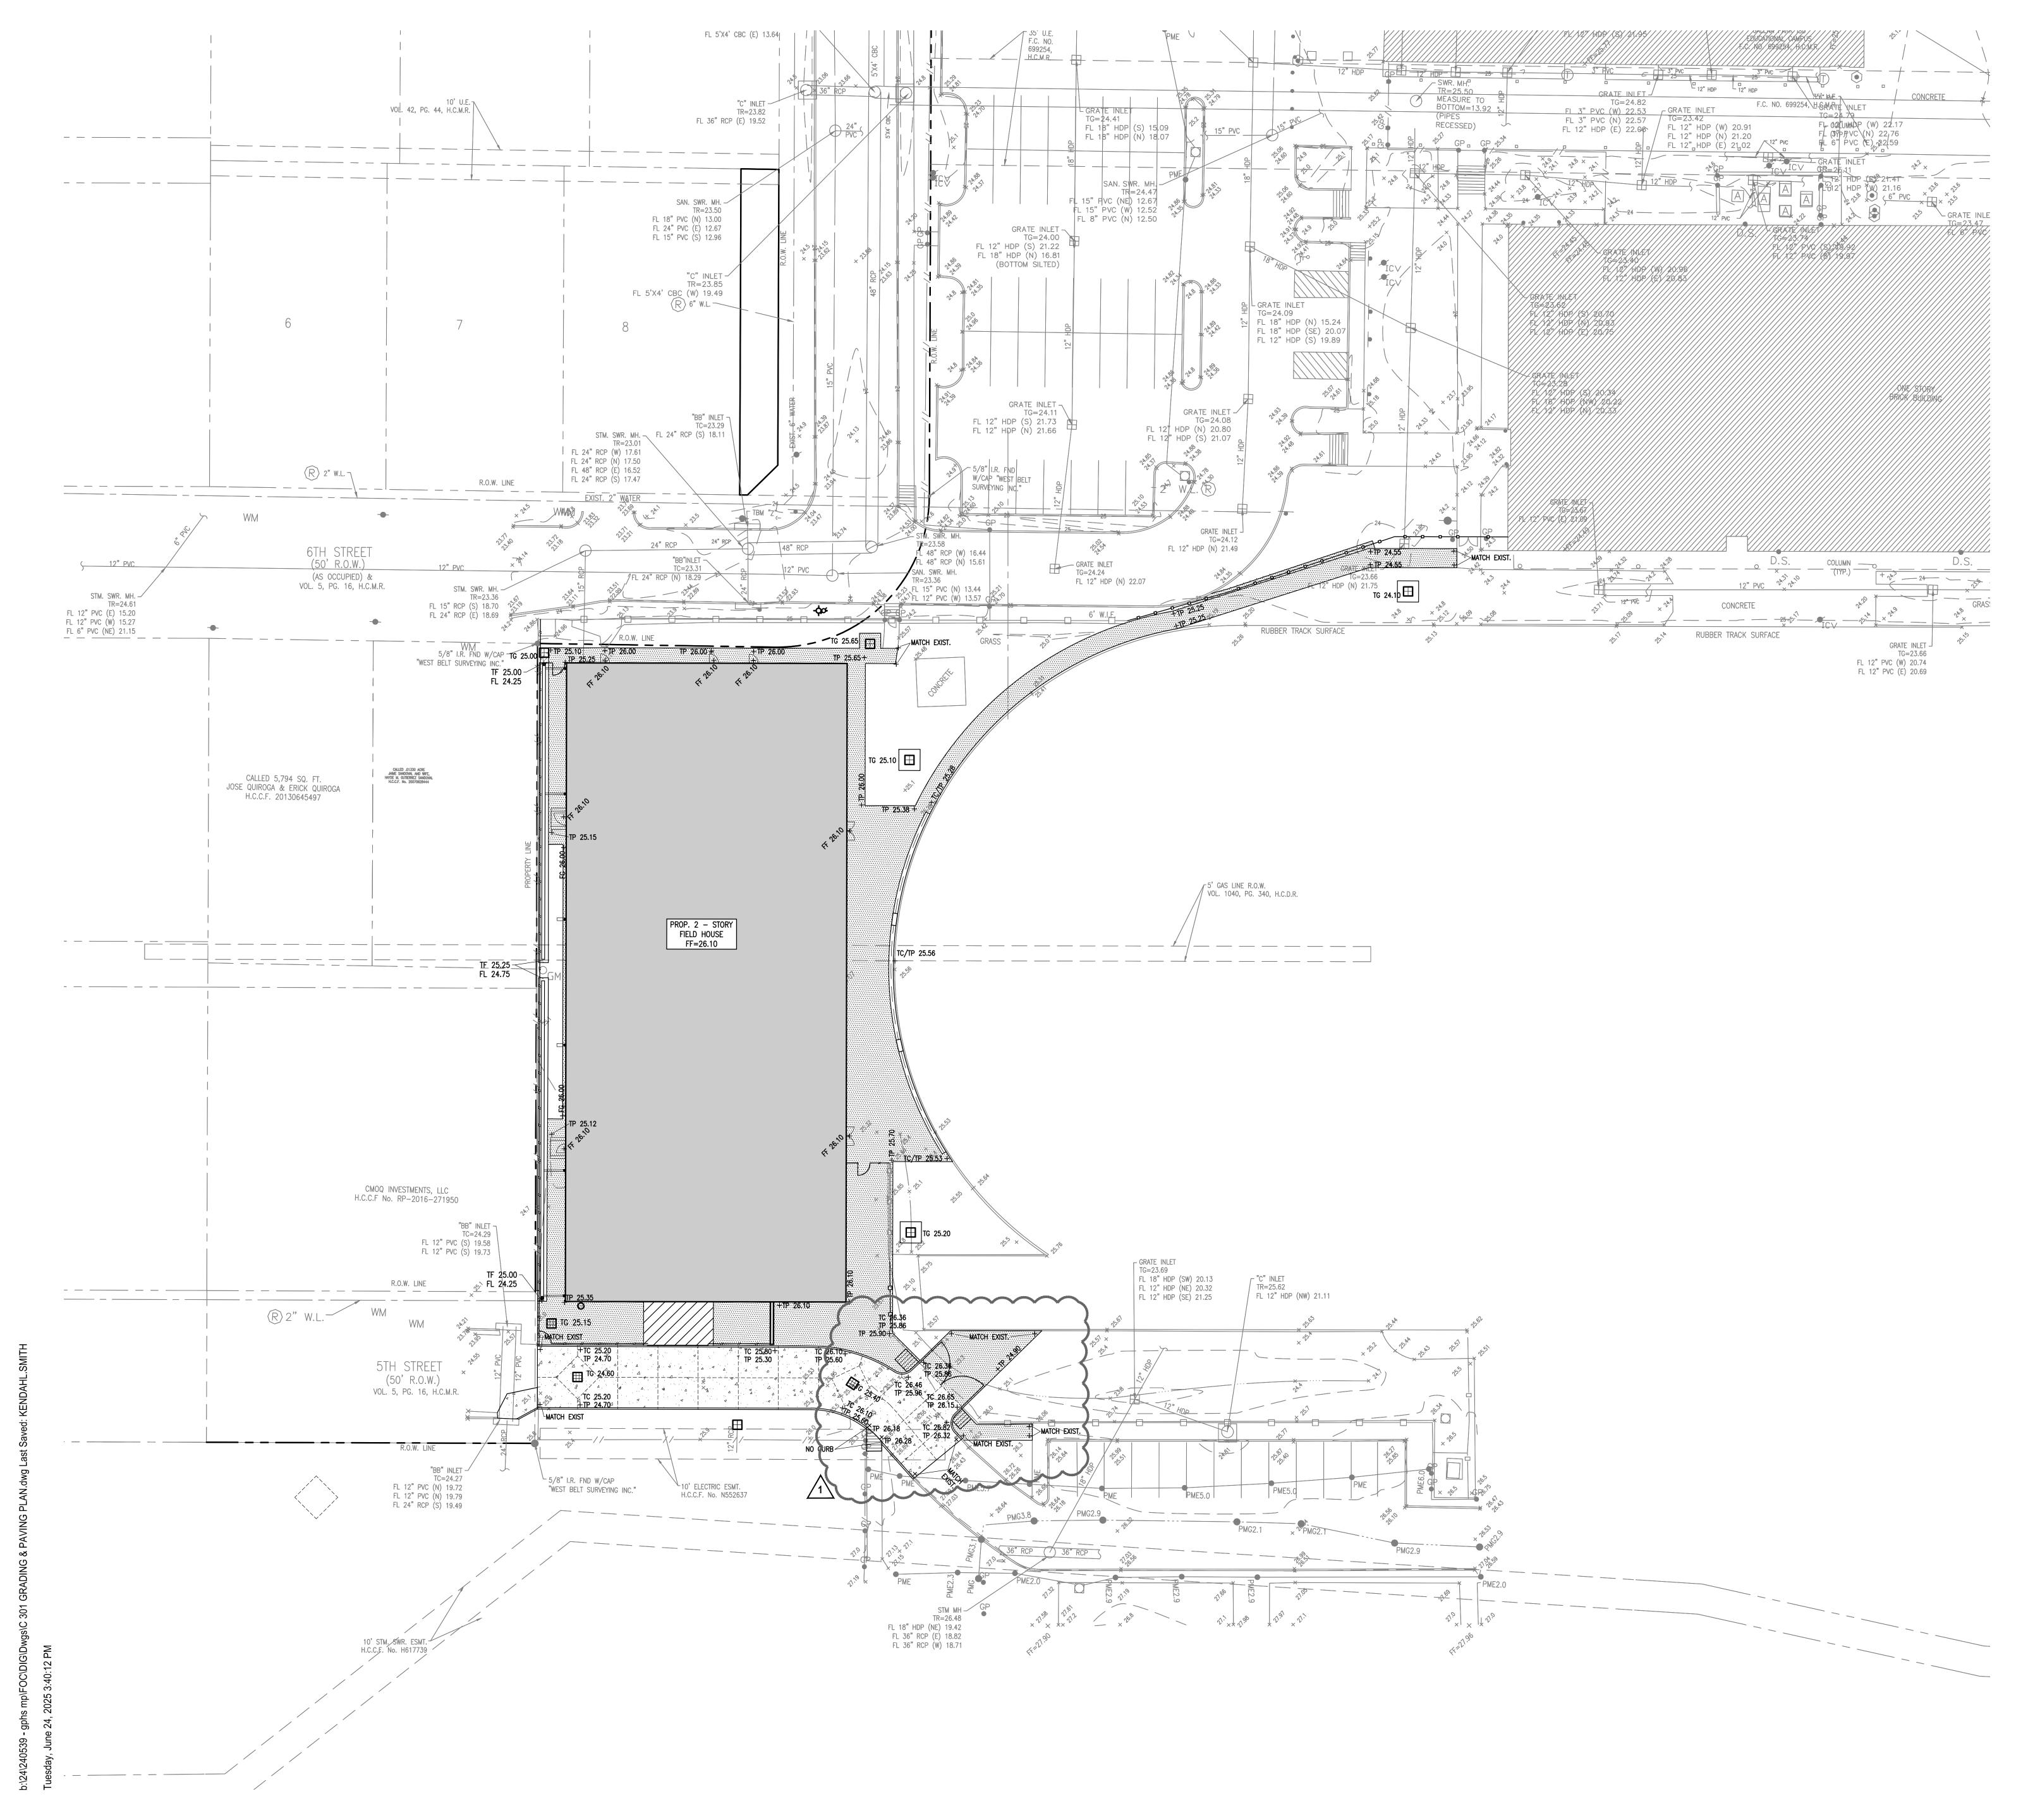

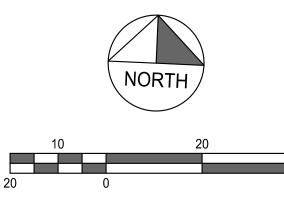


C 301

GRADING & PAVING PLAN


	RAJEEB R. RA	06/10 DIC ENGIN F-1832	
	CLIE	ENT	
DATE June 24, 2025		PROJECT 2405	
DRA	WING HISTORY		
No.	Descript	tion	Date
1	Addendur	n 1	06/24/2025



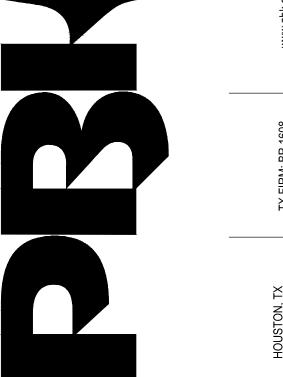


TX FIRM: BR 1608

HOUSTON, TX 713-965-0608

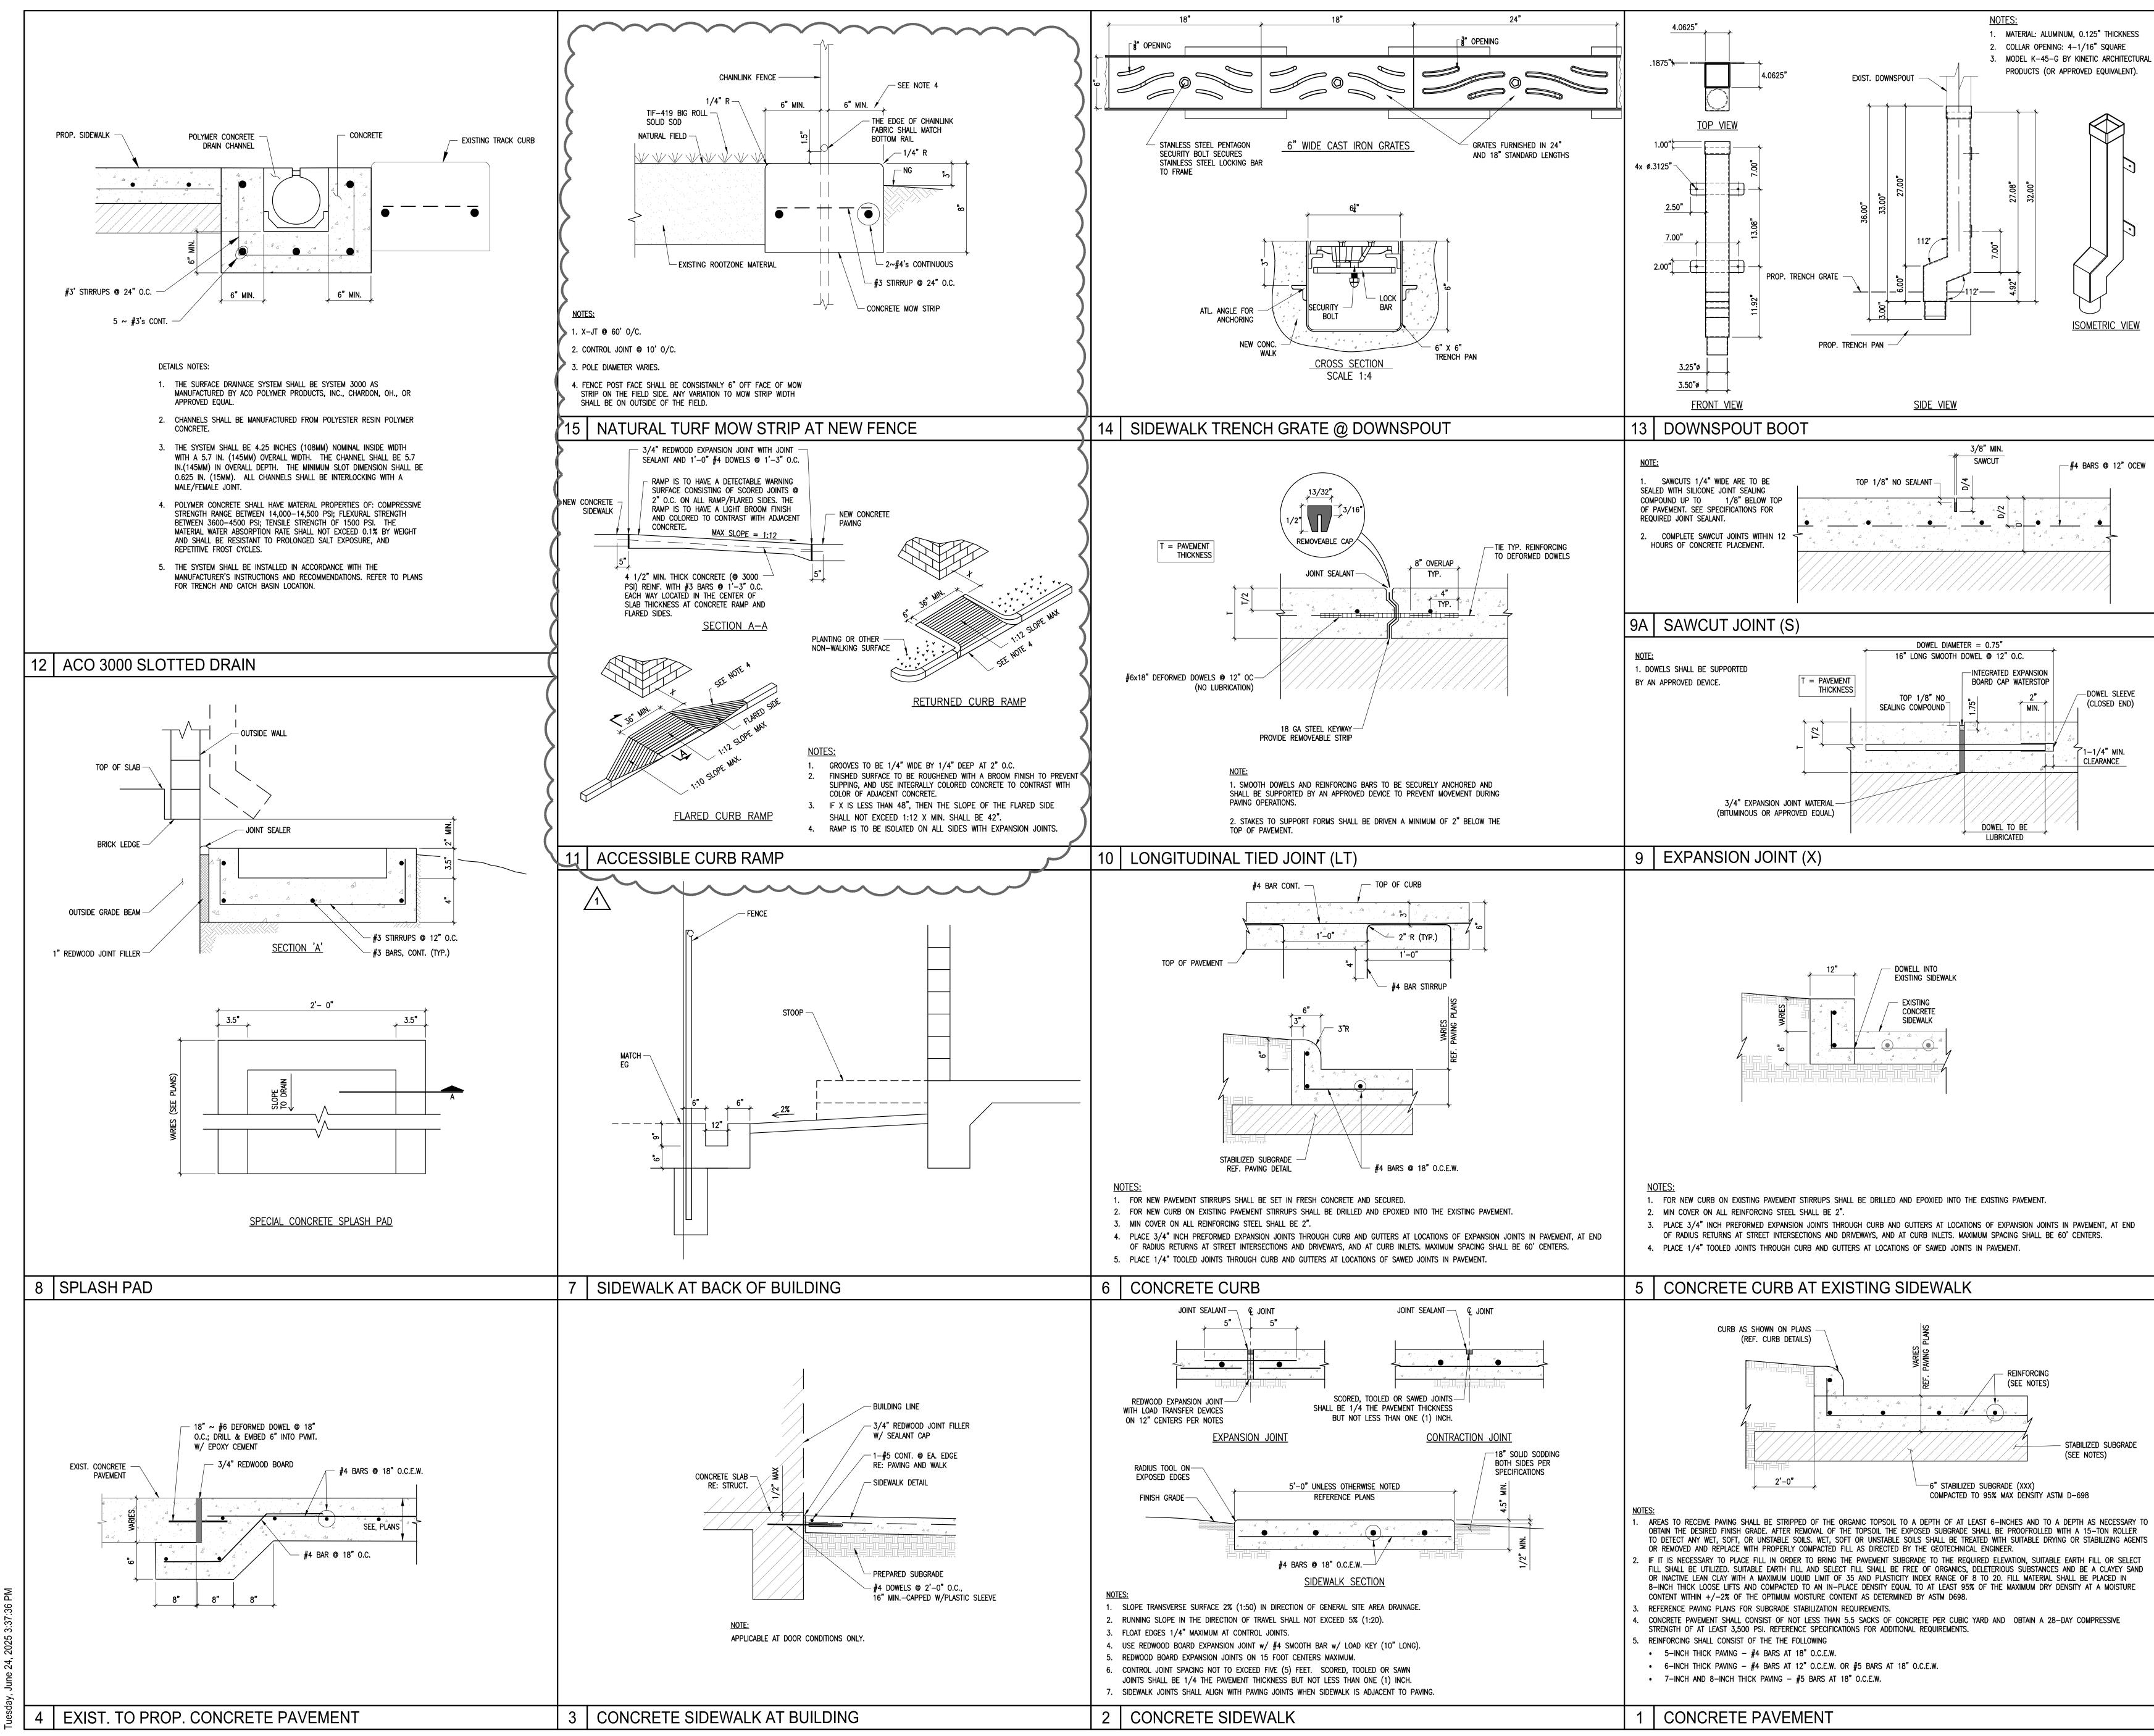




DETAILS

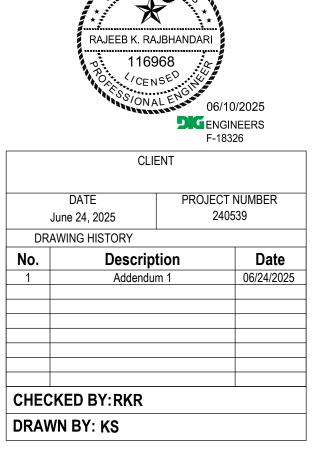






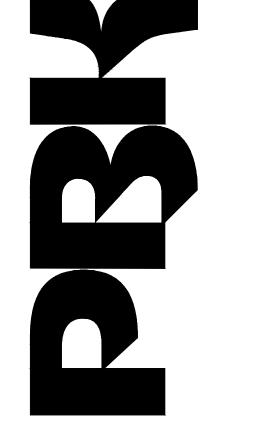





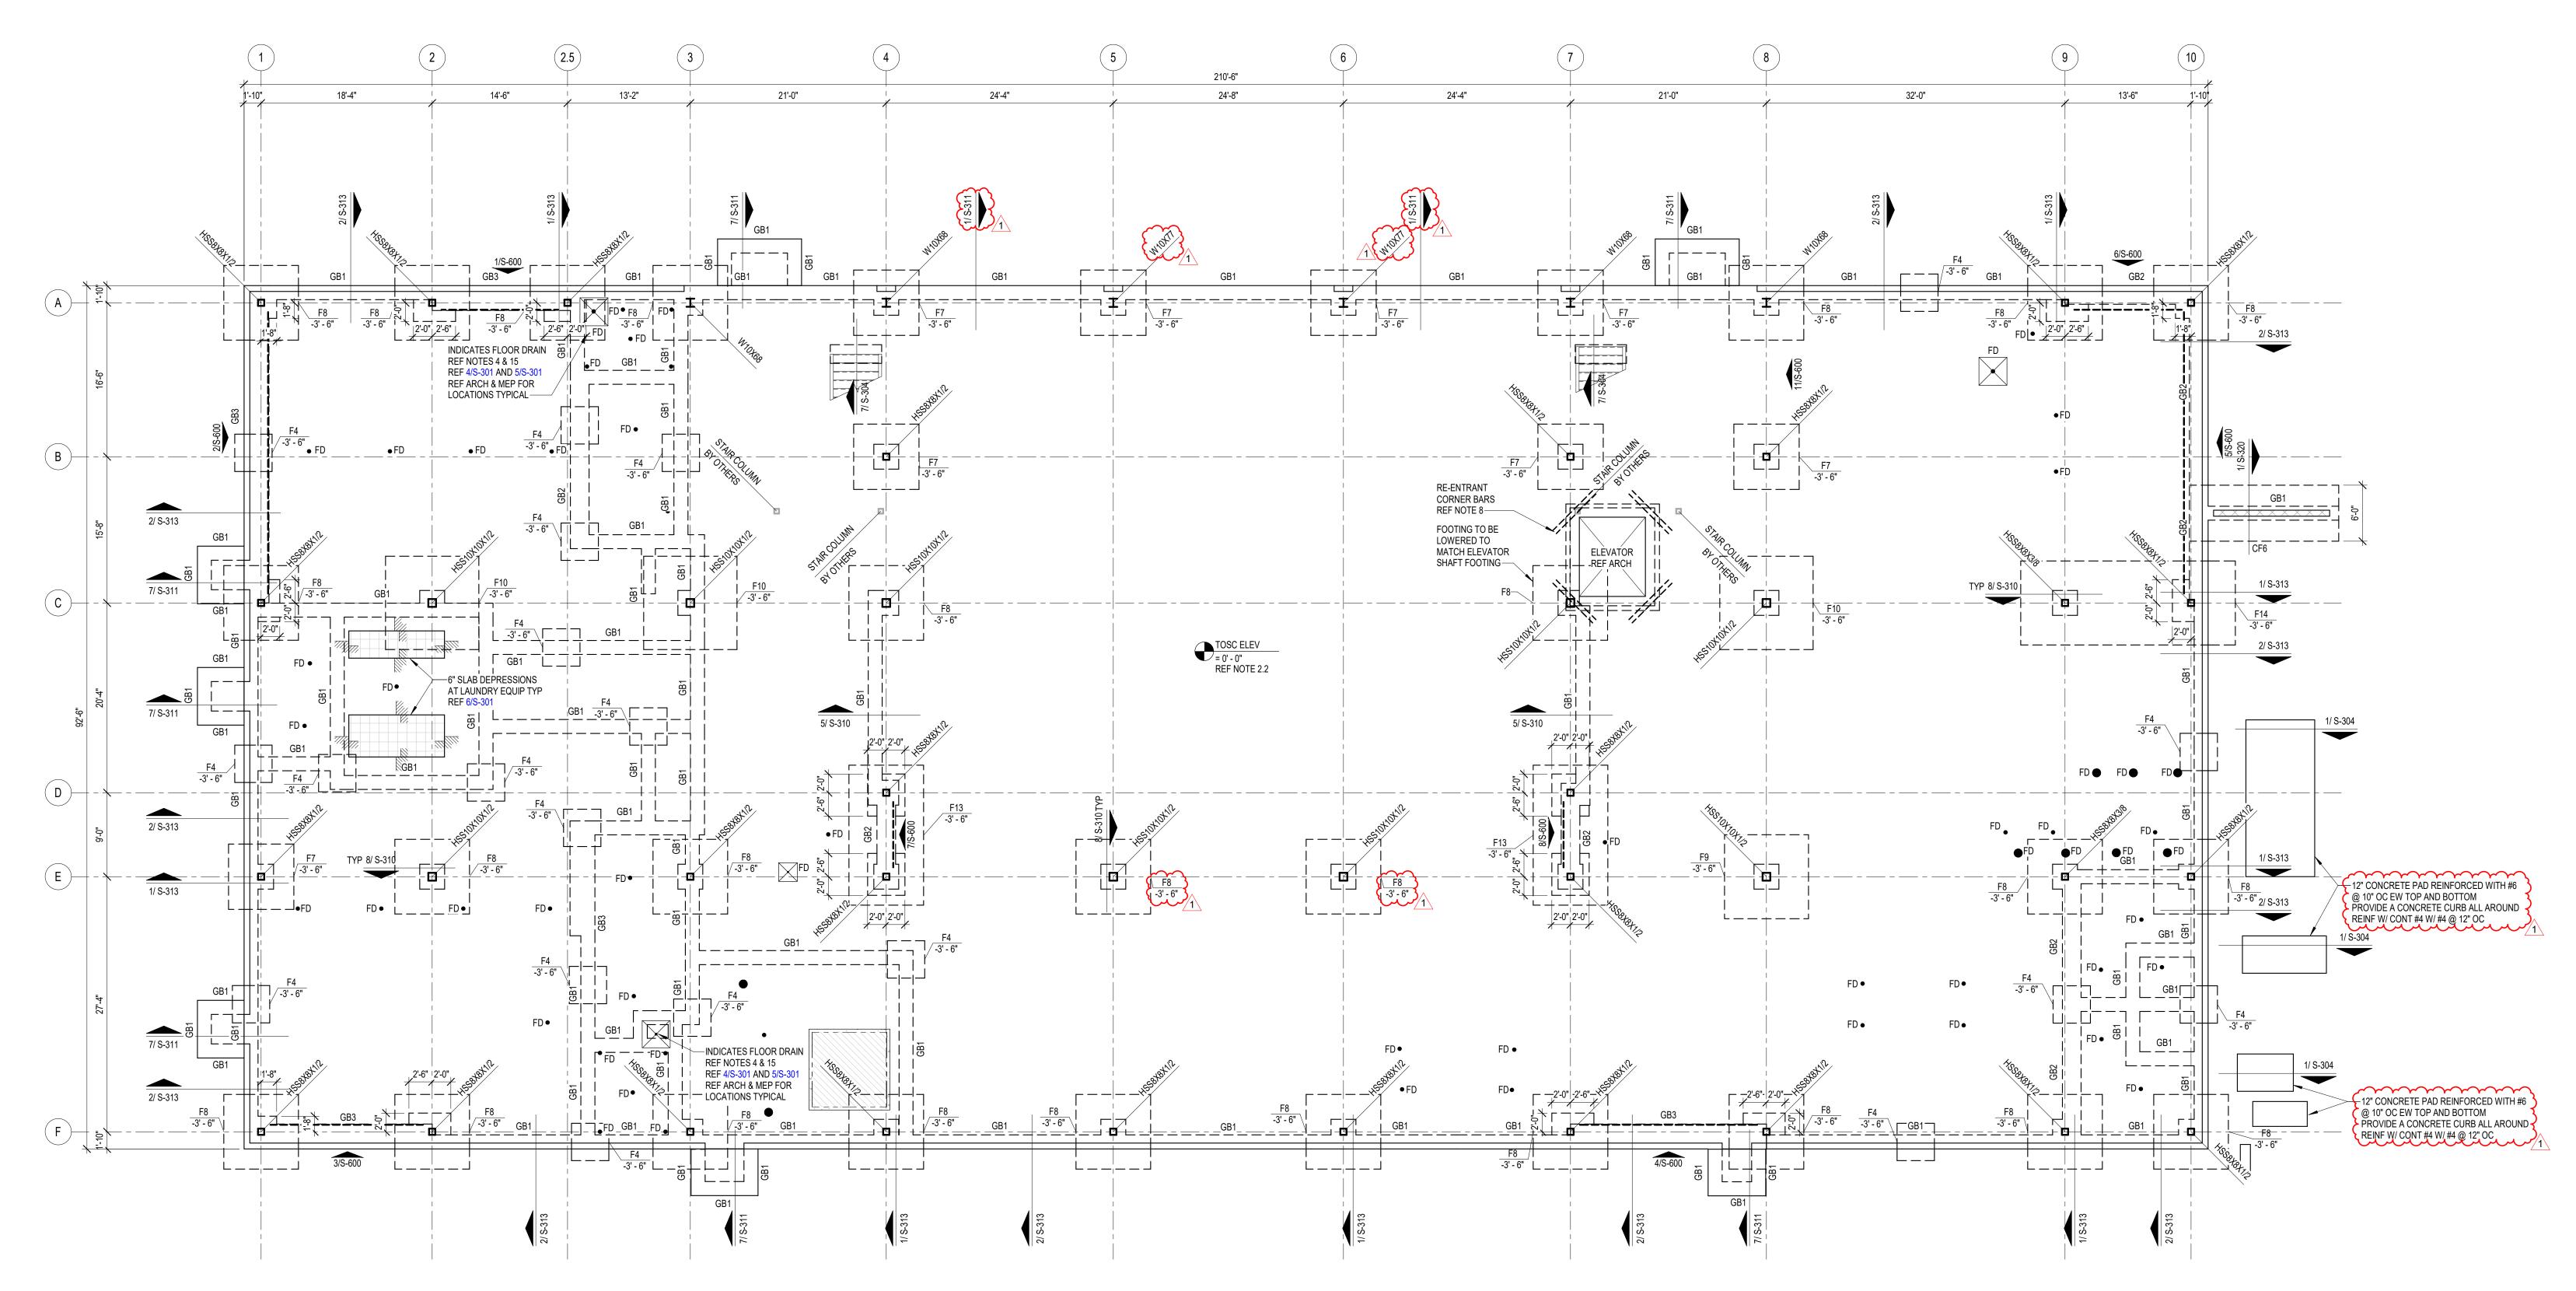



Plot Stamp: 6/24/2025 10:39:23 AM

			FOUNDATION PL	AN
1.	REFER TO PLAN FOR TOP OF STRUCTURAL CONCRETE ELEVATIONS (TOSC EL). ALL ELEVATIONS SHOWN ON THE PLAN ARE BASED ON A LEVEL ONE REFERENCE ELEVATION = 0'-0". THIS REFERENCE ELEVATION IS EQUIVALENT TO THE LEVEL ONE MEAN SEA LEVEL ELEVATION = REF CIVIL SHOWN IN THE CIVIL	4.	REFER TO ARCHITECTURAL DRAWINGS FOR EXTENTS AND DIMENSIONS OF RAISED OR DEPRESSED SLAB AREAS, SLOPES, CURBS, AND DRAINS. REFER TO TYPICAL DETAILS FOR REINFORCEMENT REQUIREMENTS.	16.
0.1	AND ARCHITECTURAL DRAWINGS AND IS NOT INTENDED TO ESTABLISH THE ACTUAL SEA LEVEL ELEVATION OF ANY PORTION OF THE STRUCTURE.	5.	GC COORDINATE ALL PENETRATIONS AND UNDERGROUND UTILITIES WITH MECHANICAL, ELECTRICAL, AND PLUMBING DRAWINGS. REFER TO TYPICAL DETAILS FOR ADDITIONAL REINFORCEMENT REQUIREMENTS.	17.
2.1.	5" THICK CONCRETE SLAB ON GRADE REINFORCED WITH #3@9" OC EACH WAY OR #4@14" OC EACH WAY, ON 2 3/4" CHAIRS FOR #3 BARS, 2 1/2" CHAIRS FOR #4 BARS SPACED AT 36" OC EACH WAY. PLACE THE SLAB ON 15 MIL WATER VAPOR BARRIER OVER COMPACTED SELECT FILL (SOIL REPORT) FOR	6.	CONTRACTOR TO FIELD VERIFY ALL EXISTING CONDITIONS AND DIMENSIONS. NOTIFY ARCHITECT AND STRUCTURAL ENGINEER OF ANY DISCREPANCIES.	
	SLAB JOINT DETAILS REFER TO 1/S-301 AND 2/S-301.	7.	GC COORDINATE ALL SLAB EDGE DIMENSIONS WITH ARCHITECTURAL DRAWINGS PRIOR TO CONSTRUCTION.	
2.2.	6" THICK CONCRETE SLAB ON GRADE REINFORCED WITH #4@14" OC EACH WAY, ON 3 1/2" CHAIRS FOR #4 BARS SPACED AT 36" OC EACH WAY. PLACE THE SLAB ON 15 MIL WATER VAPOR BARRIER OVER COMPACTED SELECT FILL (SOIL REPORT) FOR SLAB JOINT DETAILS REFER TO 1/S-301 AND 2/S-301.	8.	PROVIDE (2) - #5 x 5'-0" LONG BAR IN SLAB AT RE-ENTRANT CORNERS TYPICAL. INCLUDING RE-ENTRANT CORNERS AROUND THE PERIMETER OF THE BUILDINGS, FLOOR RECESSES AND OPENINGS.	
2.3.	10" THICK CONCRETE SLAB ON GRADE REINFORCED WITH #4@12" OC EACH WAY, TOP & BOTTOM ON 3" CHAIRS FOR BOTTOM LAYER, TOP AS REQ'D, SPACED AT 36" OC EACH WAY. PLACE THE SLAB ON 15 MIL WATER VAPOR	9.	GC COORDINATE ALL THE SIZE AND EXTENT OF ALL BRICK LEDGES SHOWN ON PLAN OR DETAILS WITH ARCHITECTURAL DRAWINGS.	18.
	BARRIER OVER COMPACTED SELECT FILL (SOIL REPORT) FOR SLAB JOINT DETAILS REFER TO 1/S-301 AND 2/S-301.	10.	REF S0.xx SERIES DRAWINGS FOR GENERAL NOTES AND TYP DETAILS	19.
2.4.	5 1/2" THICK CONCRETE SLAB ON GRADE AT THE POLISHED CONC AREAS	11.	REF S3.xx SERIES DRAWINGS FOR FOUNDATION AND SLAB-ON-GRADE DETAILS.	20.
	REINFORCED WITH #3@10" OC EACH WAY ON 3 1/4" CHAIRS FOR #3 BARS SPACED AT 36" OC EACH WAY. PLACE THE SLAB ON 15 MIL WATER VAPOR	12.	REF S4.xx SERIES DRAWINGS FOR CMU DETAILS.	
	BARRIER OVER COMPACTED SELECT FILL (SOIL REPORT) FOR SLAB JOINT DETAILS REFER TO 1/S-301 AND 2/S-301.	13.	REF S5.xx SERIES DRAWINGS FOR STEEL DETAILS.	
3.1.	TOP OF INTERIOR GRADE BEAM ELEVATION SHALL BE = -1'-0" UON.	14.	REF S6.xx SERIES DRAWINGS FOR STEEL BRACE ELEVATIONS AND DETAILS.	21.
	TOP OF PERIMETER GRADE BEAM ELEVATION SHALL BE = -1'-0" UON.	15.	REFER TO ARCH AND PLUMBING DRAWINGS FOR THE SIZE, NUMBER AND LOCATION OF ALL THE TRENCHES, AND FLOOR DRAINS. REF 10/S-301 FOR	21.
3.2.	TOP OF INTERIOR/ EXTERIOR PLINTH ELEVATION SHALL BE = -1'-0" UON. TOP OF INTERIOR PIER ELEVATION WITHOUT PLINTH SHALL BE = -1'-0" UON. TOP OF INTERIOR PIER ELEVATION WITH PLINTH SHALL BE = -3'-6" UON.		TRENCH DETAIL AND REF 4/S-301 FOR FLOOR DRAIN DETAIL.	

TOP OF INTERIOR PIER ELEVATION WITH GRADE BEAM SHALL BE = -3'-6" UON.

TOP OF EXTERIOR PIER ELEVATION SHALL BE = -3'-6" UON.

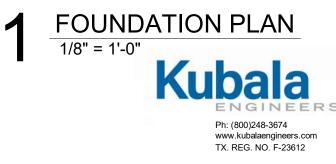

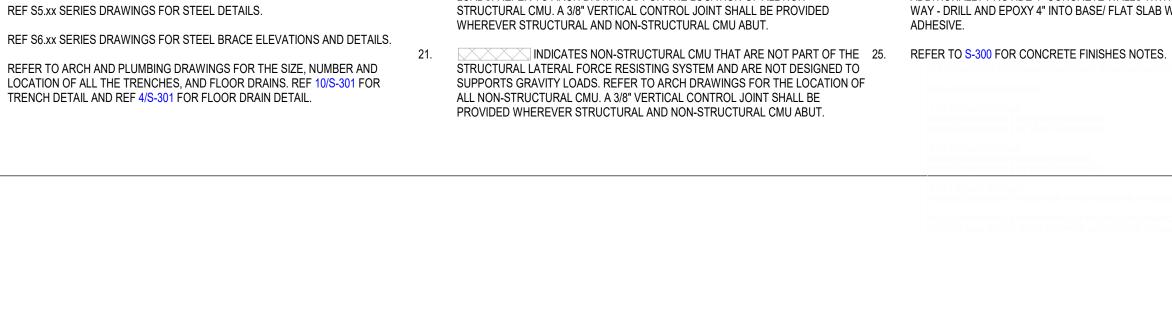

BUILDINGS, FLOOR RECESSES AND OPENINGS. PLAN OR DETAILS WITH ARCHITECTURAL DRAWINGS. REF S0.xx SERIES DRAWINGS FOR GENERAL NOTES AND TYP DETAILS 19.

FOUNDATION PLAN NOTES

- REFER TO ARCH AND PLUMBING DRAWINGS FOR THE SIZE, NUMBER AND

- REFER TO ARCHITECTURAL DRAWINGS FOR EXTENTS AND DIMENSIONS OF 16. AT INTERIOR CMU WALL LOCATIONS, WHERE THE GRADE BEAM IS NOT SHOWN, 22. PROVIDE SLAB TURNDOWN PER DETAIL 4/S-313 TYPICAL. AT INTERIOR GLAZING LOCATIONS, WHERE THE GRADE BEAM IS NOT SHOWN, PROVIDE TURNDOWN SIMILAR TO DETAIL 4/S-313; TYPICAL.
 - PIERS / FOOTINGS WITHOUT CENTERLINES SHOWN ON PLANS, SECTIONS AND/OR DETAILS SHALL BE LOCATED AS FOLLOWS:
 - COLUMNS AND PILASTERS: CENTERLINE OF THE COLUMN. GRADE BEAMS AND WALLS: CENTERLINE OF THE GRADE BEAM OR WALL. ALONG THE LENGTH OF GRADE BEAMS AND WALLS: INTERMEDIATE
 - PIERS/FOOTINGS SHALL BE SPACED EQUALLY BETWEEN PIERS/FOOTINGS THAT ARE DIMENSIONALLY SET ON PLAN OR AS NOTED ABOVE D
 - PIERS SUPPORTING SLABS ON CARTON FORMS: UNLESS NOTED OTHERWISE, PIERS NOT DIMENSIONED SHALL BE SPACED EQUALLY BETWEEN PIERS THAT ARE DIMENSIONALLY SET ON PLAN.

GC COORDINATE ALL THE SIZE AND EXTENT OF ALL BRICK LEDGES SHOWN ON 18. GC TO COORDINATE THE LOCATION OF ALL CONCRETE CURBS WITH ARCH DRAWINGS. REF 7/S-301 FOR DETAIL TYPICAL. GC COORDINATE THE LOCATION OF ALL CANOPY COLUMNS WITH ARCH

> DRAWINGS. INDICATES STRUCTURAL CMU THAT ARE PART OF THE STRUCTURAL LATERAL FORCE RESISTING SYSTEM AND SUPPORTS GRAVITY LOADS. REFER TO ARCH DRAWINGS FOR THE LOCATION OF ALL NON-


IT CAN BE COMMON PRACTICE FOR STEEL STUB-UPS WITH STRUCTURAL STEEL SILL SUPPORT MEMBERS TO BE PROVIDED AT LONG FIRST FLOOR WINDOW SILLS (REF DETAIL 3/S-311); HOWEVER, FOR FIRST FLOOR WINDOWS, 8'-0" AND NARROWER, THE GC SHALL PROVIDE PRE-ENGINEERED COLD-FORM SILL SUPPORTS UTILIZING COLD-FORM FRAMING ONLY. THESE COLD-FORM SILL SHALL BE DESIGNED BY THE DRYWALL SUBCONTRACTOR'S ENGINEER AND SUBMITTED IN THE SHOP DRAWINGS FOR REVIEW. WHERE FIRST FLOOR WINDOW SILLS EXCEED 8'-0" THE CONTRACTOR SHALL PROVIDE MISCELLANEOUS STRUCTURAL STEEL PER 3/S-311 TYPICAL.


- IT CAN BE COMMON PRACTICE FOR STEEL STUB-UPS WITH STRUCTURAL
- AND SUBMITTED IN THE SHOP DRAWINGS FOR REVIEW. WHERE FIRST FLOOR WINDOW SILLS EXCEED 8'-0" THE CONTRACTOR SHALL PROVIDE MISCELLANEOUS STRUCTURAL STEEL PER 3/S-311 TYPICAL.
- PROVIDE STRUCTURAL GEO-FOAM WITH 4" CONCRETE TOPPING SLAB WITH WWF OVER SLAB ON GRADE FOR HATCHED AREAS. GEO-FOAM AND TOPPING WAY - DRILL AND EPOXY 4" INTO BASE/ FLAT SLAB WITH HILTI HY-200 V3

- STEEL SILL SUPPORT MEMBERS TO BE PROVIDED AT LONG FIRST FLOOR WINDOW SILLS (REF DETAIL 3/S-311); HOWEVER, FOR FIRST FLOOR WINDOWS, 8'-0" AND NARROWER, THE GC SHALL PROVIDE PRE-ENGINEERED COLD-FORM SILL SHALL BE DESIGNED BY THE DRYWALL SUBCONTRACTOR'S ENGINEER
- SILL SUPPORTS UTILIZING COLD-FORM FRAMING ONLY. THESE COLD-FORM

- SLAB BY MANUFACTURER REF ARCH AND GENERAL NOTES. GC NOTE: ORIGINAL BASE / FLAT SLAB EXTENDS CONTINUOUS BELOW PLATFORM AND STAIRS. PROVIDE GEO-FOAM FILL BELOW PLATFORM WITH 4" CONCRETE TOPPING SLAB WITH 6x6x2.9x2.9 W.W.M. AT MID-HEIGHT OF SLAB. ADDITIONALLY PROVIDE 4" CONCRETE WALLS WITH #4 BARS AT 12" OC EACH



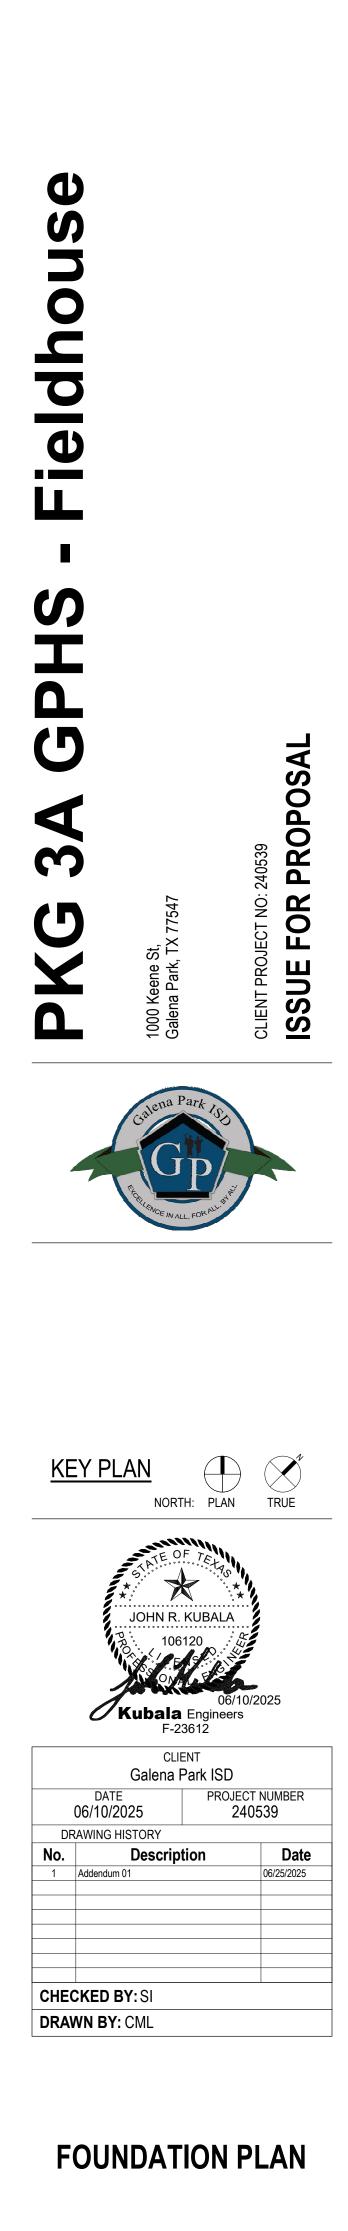

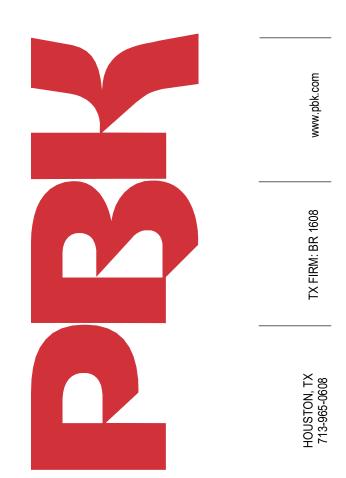

		SECOND FLOOR FRAMING PLAN
B B B B B B C <thc< th=""> <thc< th=""> <thc< th=""> <thc< th=""></thc<></thc<></thc<></thc<>		
A H = xxtk (ASD) H = xxtk (ASD) H = xxtk (ASD) B B 2/ 8-510 B		
Bigli 2 1/2" Bigli 2 1/2" 1'-2 1/2" 18'-4" 14'-6" 13'-2" BOA 10'-2 1/2" 18'-4" 14'-6" 13'-2" Index of the second	(A)	
H = xxK (ASD) ALONG GRID		
11:2 1/2" 18:4" 14:6" 13:2" BOA 00500 10000 10000 10000 00500 10000 10000 10000 10000 00500 10000 10000 10000 10000 00500 10000 10000 10000 10000 10000 00500 10000 10000 10000 10000 10000 10000 00500 10000 10000 10000 10000 10000 10000 10000 005000 100000 10000 100000 <td< td=""><td></td><td></td></td<>		
68 ¹ / ₂ 1/2' 18 ² / ₄ 18 ² / ₄ 14 ² / ₆ 13 ² / ₄ 11 ² / ₄		1'-2 1/2' BOA
69 ¹ / ₂ 1/2" 18'-4" 18'-4" 18'-4" 18'-4" 18'-4" 18'-6" INDICATES CANOPY BELOW (BY OTHERS) REF ARCH 11S-600 INDICATES CANOPY BELOW (BY OTHERS) REF ARCH INDICATES CANOPY BELOW (BY OTHERS) REF ARCH INDICATES CANOPY BELOW (BY OTHERS) REF ARCH INDICATES CANOPY BELOW (BY OTHERS) REF NOTE 13 (25) FFXI (24) (25) FFXI (24) (25) FFXI (24) (25) FFXI (24) (25) FFXI (24) (25) FFXI (24) (25) FFXI (24) (26) FFXI (24) (27) FFXI (24) (
69-2 1/2" NDICATES CANOPY BELOW (BY OTHERS) REF ARCH 1/5-600 W21X44 (14) 1/5-600 W21X44 (14) The formation of the formatio of the formation of the formation of the formatio of the	M21)	
69 ⁴ 2 1/2" 14 ¹ -6" 13 ⁻ 2" 14 ¹ -6" 13 ⁻ 2" INDICATES CANOPY BELOW (BY OTHERS) REF ARCH 1/S-600 1/S-600 1/S-600 1/S-600 REF NOTE 10 (2) HT XL2 (2) HT XL2 (3) HT XL2 (3) HT XL2 (3) HT XL2 (4) HT XL2 (4) HT XL2 (5) H	X44 (18) REF	
69 ¹ -2 1/2" 14'-6" 13'-2" INDICATES CANOPY BELOW (BY OTHERS) REF ARCH 1/S-600 W21X44 (14) FD (2) (2) (2) (2) (2) (2) (2) (2) (2) (2)	NOTE 13 NOTE 13	
69 ¹ / ₂ 1/2" 13 ¹ -2" INDICATES CANOPY BELOW (BY OTHERS) REF ARCH W21X44 (14) T FD FD FD		14'-6"
1/2" 13'-2" INDICATES CANOPY BELOW (BY OTHERS) REF ARCH W21X44 (14) REF NOTE 10	FD	\rightarrow
CANOPY OTHERS)	REF NO	/1/2"13
	44 (14) OTE 10	
	W24X55 (32)	

2/ S-510

W21X48 (18)

_+___₩18X40 (18).**L**___+

3/S-600

REF NOTE 1.

|

FD

REF NOTE 10

+ 63-----

FLOOR DECK

-INDICATES FLOOR DRAIN

REF NOTES 4 & 15 REF 4/S-301 AND 5/S-301 REF ARCH & MEP FOR LOCATIONS TYPICAL

W24X55 (28)


W27X84 (28)


2/ S-510

D—


E —

F - - H = xxK (ASD) - - ALONG GRID

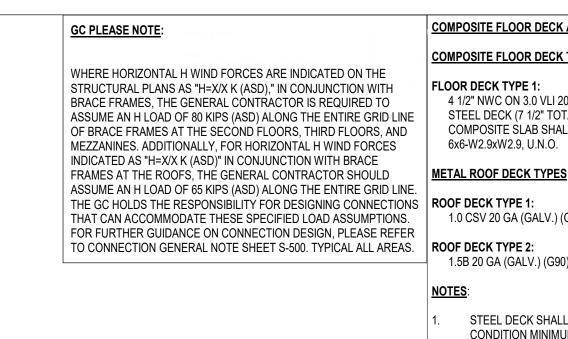

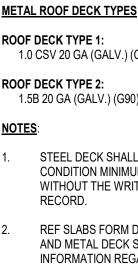




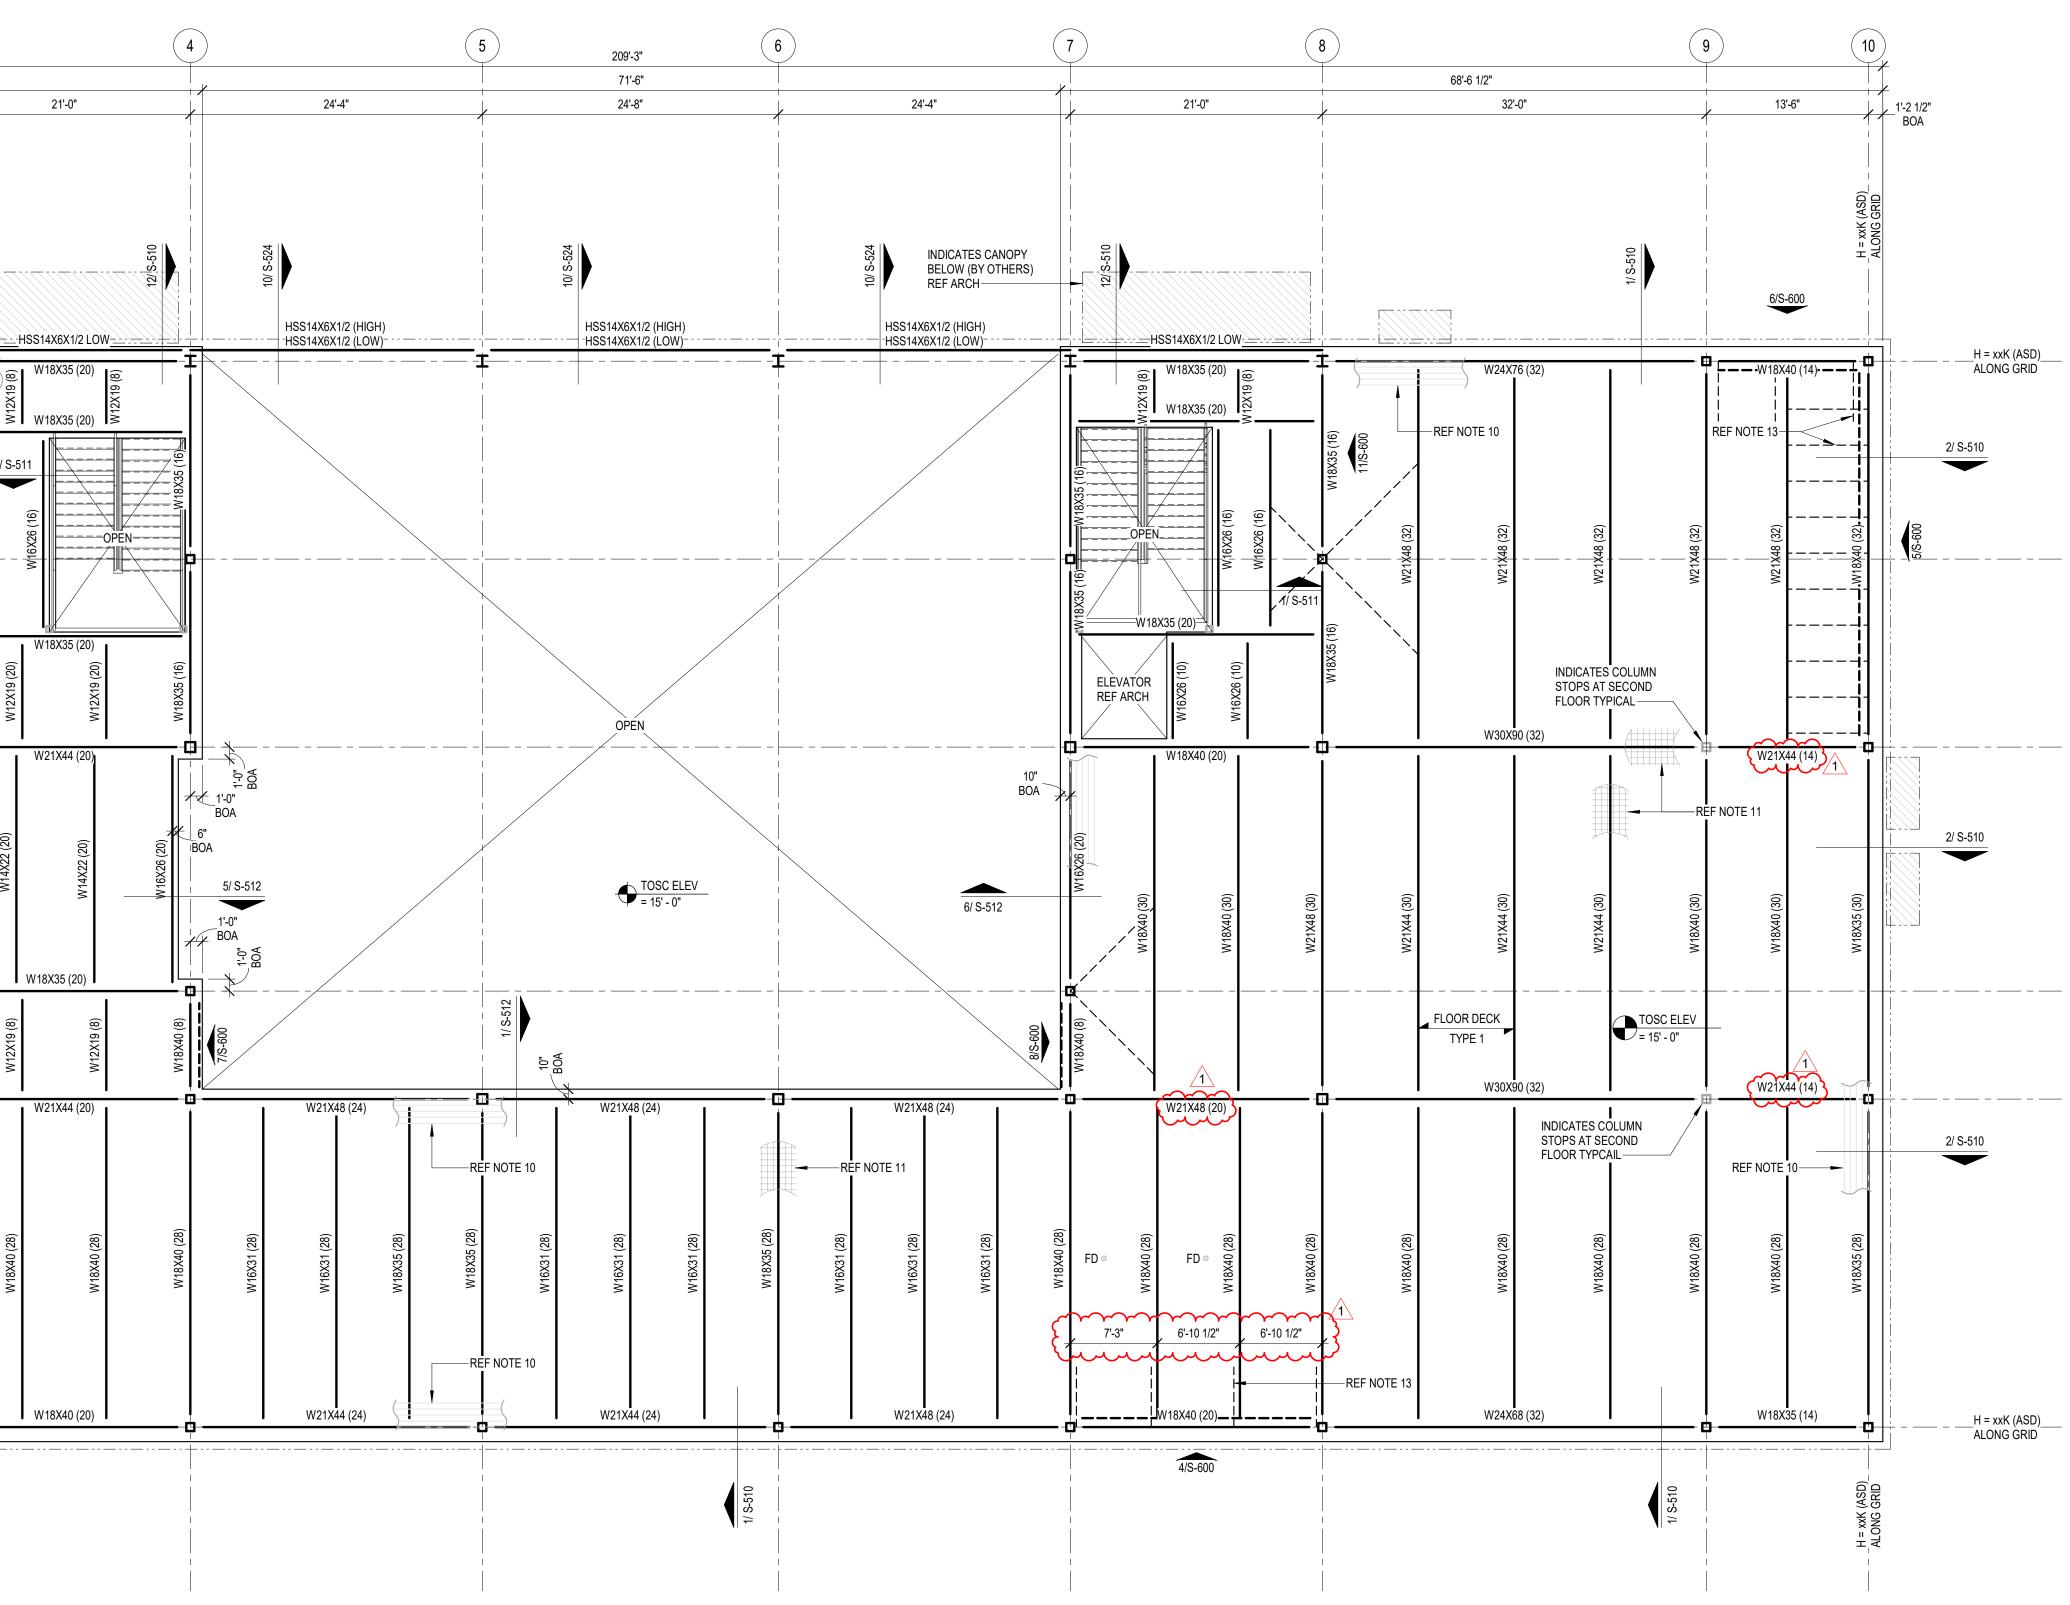



ECK AND METAL ROOF DECK LEGEND		COMPOSITE FLOOR PLAN NOTES		COMPOSITE FLOOR PLAN NOTES
ECK TYPES				
	1.	REF PLAN FOR TOP OF SLAB ELEVATION.	12.	CONTRACTOR TO VERIFY ALL SLAB EDGE DIMENSIONS WITH ARCHITECTURAL DRAWINGS PRIOR TO CONSTRUCTION
′LI 20 GA (GALV) (G90) COMPOSITE TOTAL SLAB THICKNESS).	2.	ALL ELEVATIONS ARE BASED ON TOSC EL = 0'-0".	40	
SHALL BE REINFORCED WITH WWR .O.	3.	STEEL DECK SHALL BE PLACED WITH A TWO-SPAN CONDITION MINIMUM. NO SINGLE SPANS ARE ALLOWED WITHOUT WRITTEN APPROVAL OF ENGINEER-OF-RECORD.	13.	INDICATES WIND BRACE BEAM BOTTOM FLANGE BRACING PER 2/S-505 TYPICAL ALONG ENTIRE GRID AT ALL BRACE FRAMES. AT LOCATIONS WHERE BEAM SPACING EXCEEDS 4'-0" OC, REF 1/S-505.
(PES	4.	COMPOSITE BEAM CONSTRUCTION IS UNSHORED.	14.	REF S0.XX SERIES DRAWINGS FOR GENERAL NOTES AND TYP DETAILS.
V.) (G90) VENTED MTL DECK.	5.	DETAILING OF ALL MEMBER CONNECTIONS TO THE SUPPORTS SHALL BE PERFORMED TO SATISFY LATEST OSHA ERECTION REQUIREMENTS.	15.	REF S4.XX SERIES DRAWINGS FOR CMU DETAILS.
	6.	TO SATISFY LATEST USHA ERECTION REQUIREMENTS.	16.	REF S5.XX SERIES DRAWINGS FOR STEEL FRAMING DETAILS.
(G90) MTL DECK.			17.	REF S6.XX SERIES DRAWINGS FOR STEEL BRACE ELEVATIONS AND DETAILS.
	7.	UNLESS SHOWN OTHERWISE, STEEL BEAMS OR JOISTS ARE CENTERED ON AND EQUALLY SPACED BETWEEN COLUMN CENTERLINES.	18.	ALL CMU SHOWN ON PLAN ARE PART OF THE STRUCTURAL LATERAL
HALL BE PLACED WITH TWO-SPAN NIMUM. NO SINGLE SPANS ARE ALLOWED WRITTEN APPROVAL OF THE ENGINEER-OF-	8.	ALL STRUCTURAL STEEL THAT IS PERMANENTLY EXPOSED TO THE EXTERIOR OR IS PERMANENTLY IN UNCONDITIONED SPACE SHALL BE HOT-DIPPED GALVANIZED.		FORCE RESISTING SYSTEM AND SUPPORTS GRAVITY LOADS. NON-STRUCTURAL CMU EXISTS IN OTHER LOCATION (REF ARCH DRAWINGS). A 3/8" VERTICAL CONTROL JOINT SHALL BE PROVIDED WHEREVER STRUCTURAL AND NON-STRUCTURAL CMU ABUT.
RM DECK (AT FLOORS) GENERAL NOTES	9.	REFER TO MECHANICAL, ELECTRICAL, AND PLUMBING DRAWINGS FOR PENETRATIONS NOT SHOWN. REFER TO TYPICAL DETAILS FOR ADDITIONAL REINFORCEMENT REQUIREMENTS AT OPENINGS.	19.	INDICATES PLAN DIAGONAL STRUT WT5X15. COPE WEB AT BEAMS AND OVERLAP FLANGE 4". WELD TO TOP FLANGE AND COLUMNS WITH 5/16" FILLET WELD 3-SIDES TYPICAL.
CK SCHEDULE ON SHEET S-504 FOR MORE REGARDING FLOOR DECK REQUIREMENTS.	10.	PROVIDE ADDITIONAL (5) - #5 CONT BARS IN COMPOSITE SLAB ALONG FULL PERIMETER	20.	GC SHALL COORDINATE LOCATION OF FOLDING PARTITIONS WITH ARCH DRAWINGS. REF DETAIL 1/S-509.
OF DECKING GENERAL NOTES AND METAL LE ON SHEET S-506 FOR MORE REGARDING ROOF DECK REQUIREMENTS.		OF SLAB AND AROUND OPENINGS. EXTEND BARS 10'-0" PAST CORNERS OF OPENINGS. PROVIDE STD HOOK AT TERMINATION ENDS. ALL LAPS IN REINFORCING SHALL BE WITH MECHANICAL COUPLERS OR 20'-0" LAP SPLICE TYPICAL. REFER TO DETAIL 1/S-504.	21.	REF DETAIL -/513 FOR ADDITIONAL REINFORCEMENT UNDER INTERIOR CMU WALLS PARALLEL TO DECK SPAN. GC TO COORDINATE THE LOCATION OF ALL CMU WALLS WITH ARCH DRAWINGS.
	11.	PROVIDE 6'-0" WIDE EXTRA LAYER OF WWF AT 3/4" CLR. FROM TOSC OVER EVERY SINGLE BEAM THAT RUNS BETWEEN COLUMNS IN ADDITION TO EVERY GIRDER BEAM TYPICAL.	22.	PROVIDE MISCELLANEOUS STEEL PER 12/S-501 ABOVE AND BELOW ANY WINDOW THAT DOES NOT ALIGN WITH THE BACK-UP, UNO, TYPICAL. LOOSE LINTELS REQUIRED BELOW WINDOW SHALL BE INVERTED (DOG LEG DOWN) TYPICAL.

SECOND FLOOR FRAMING PLAN 1/8" = 1'-0"



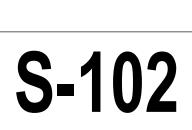

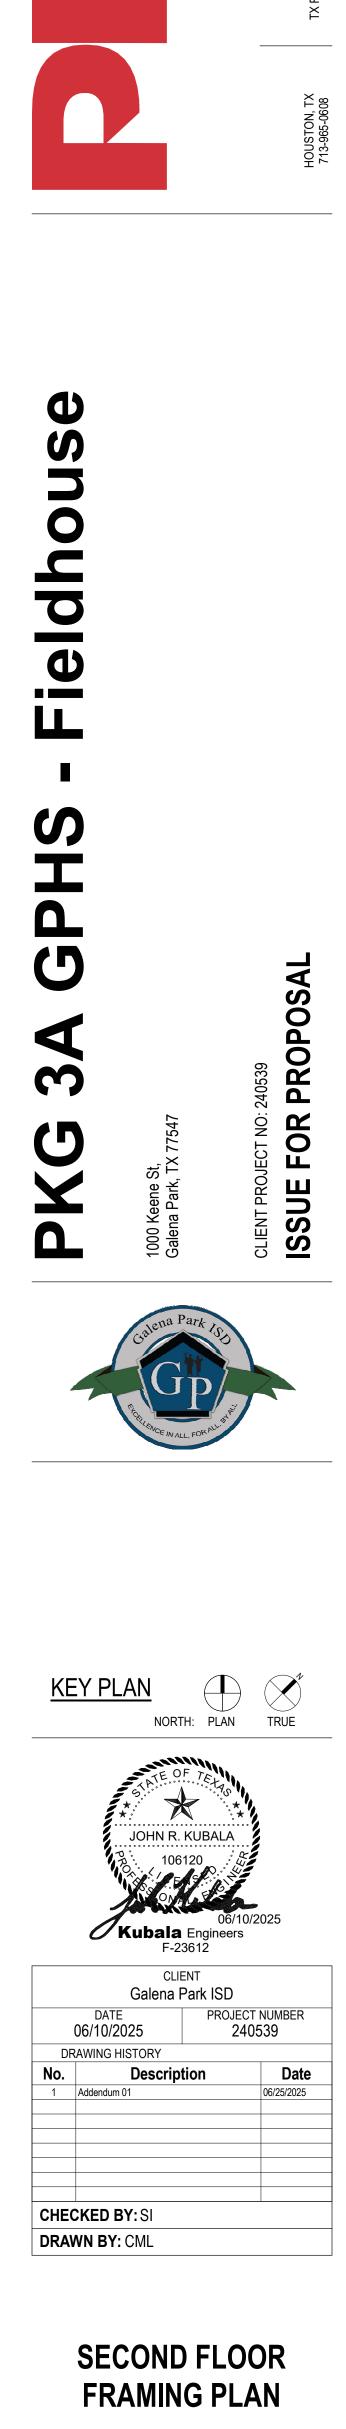

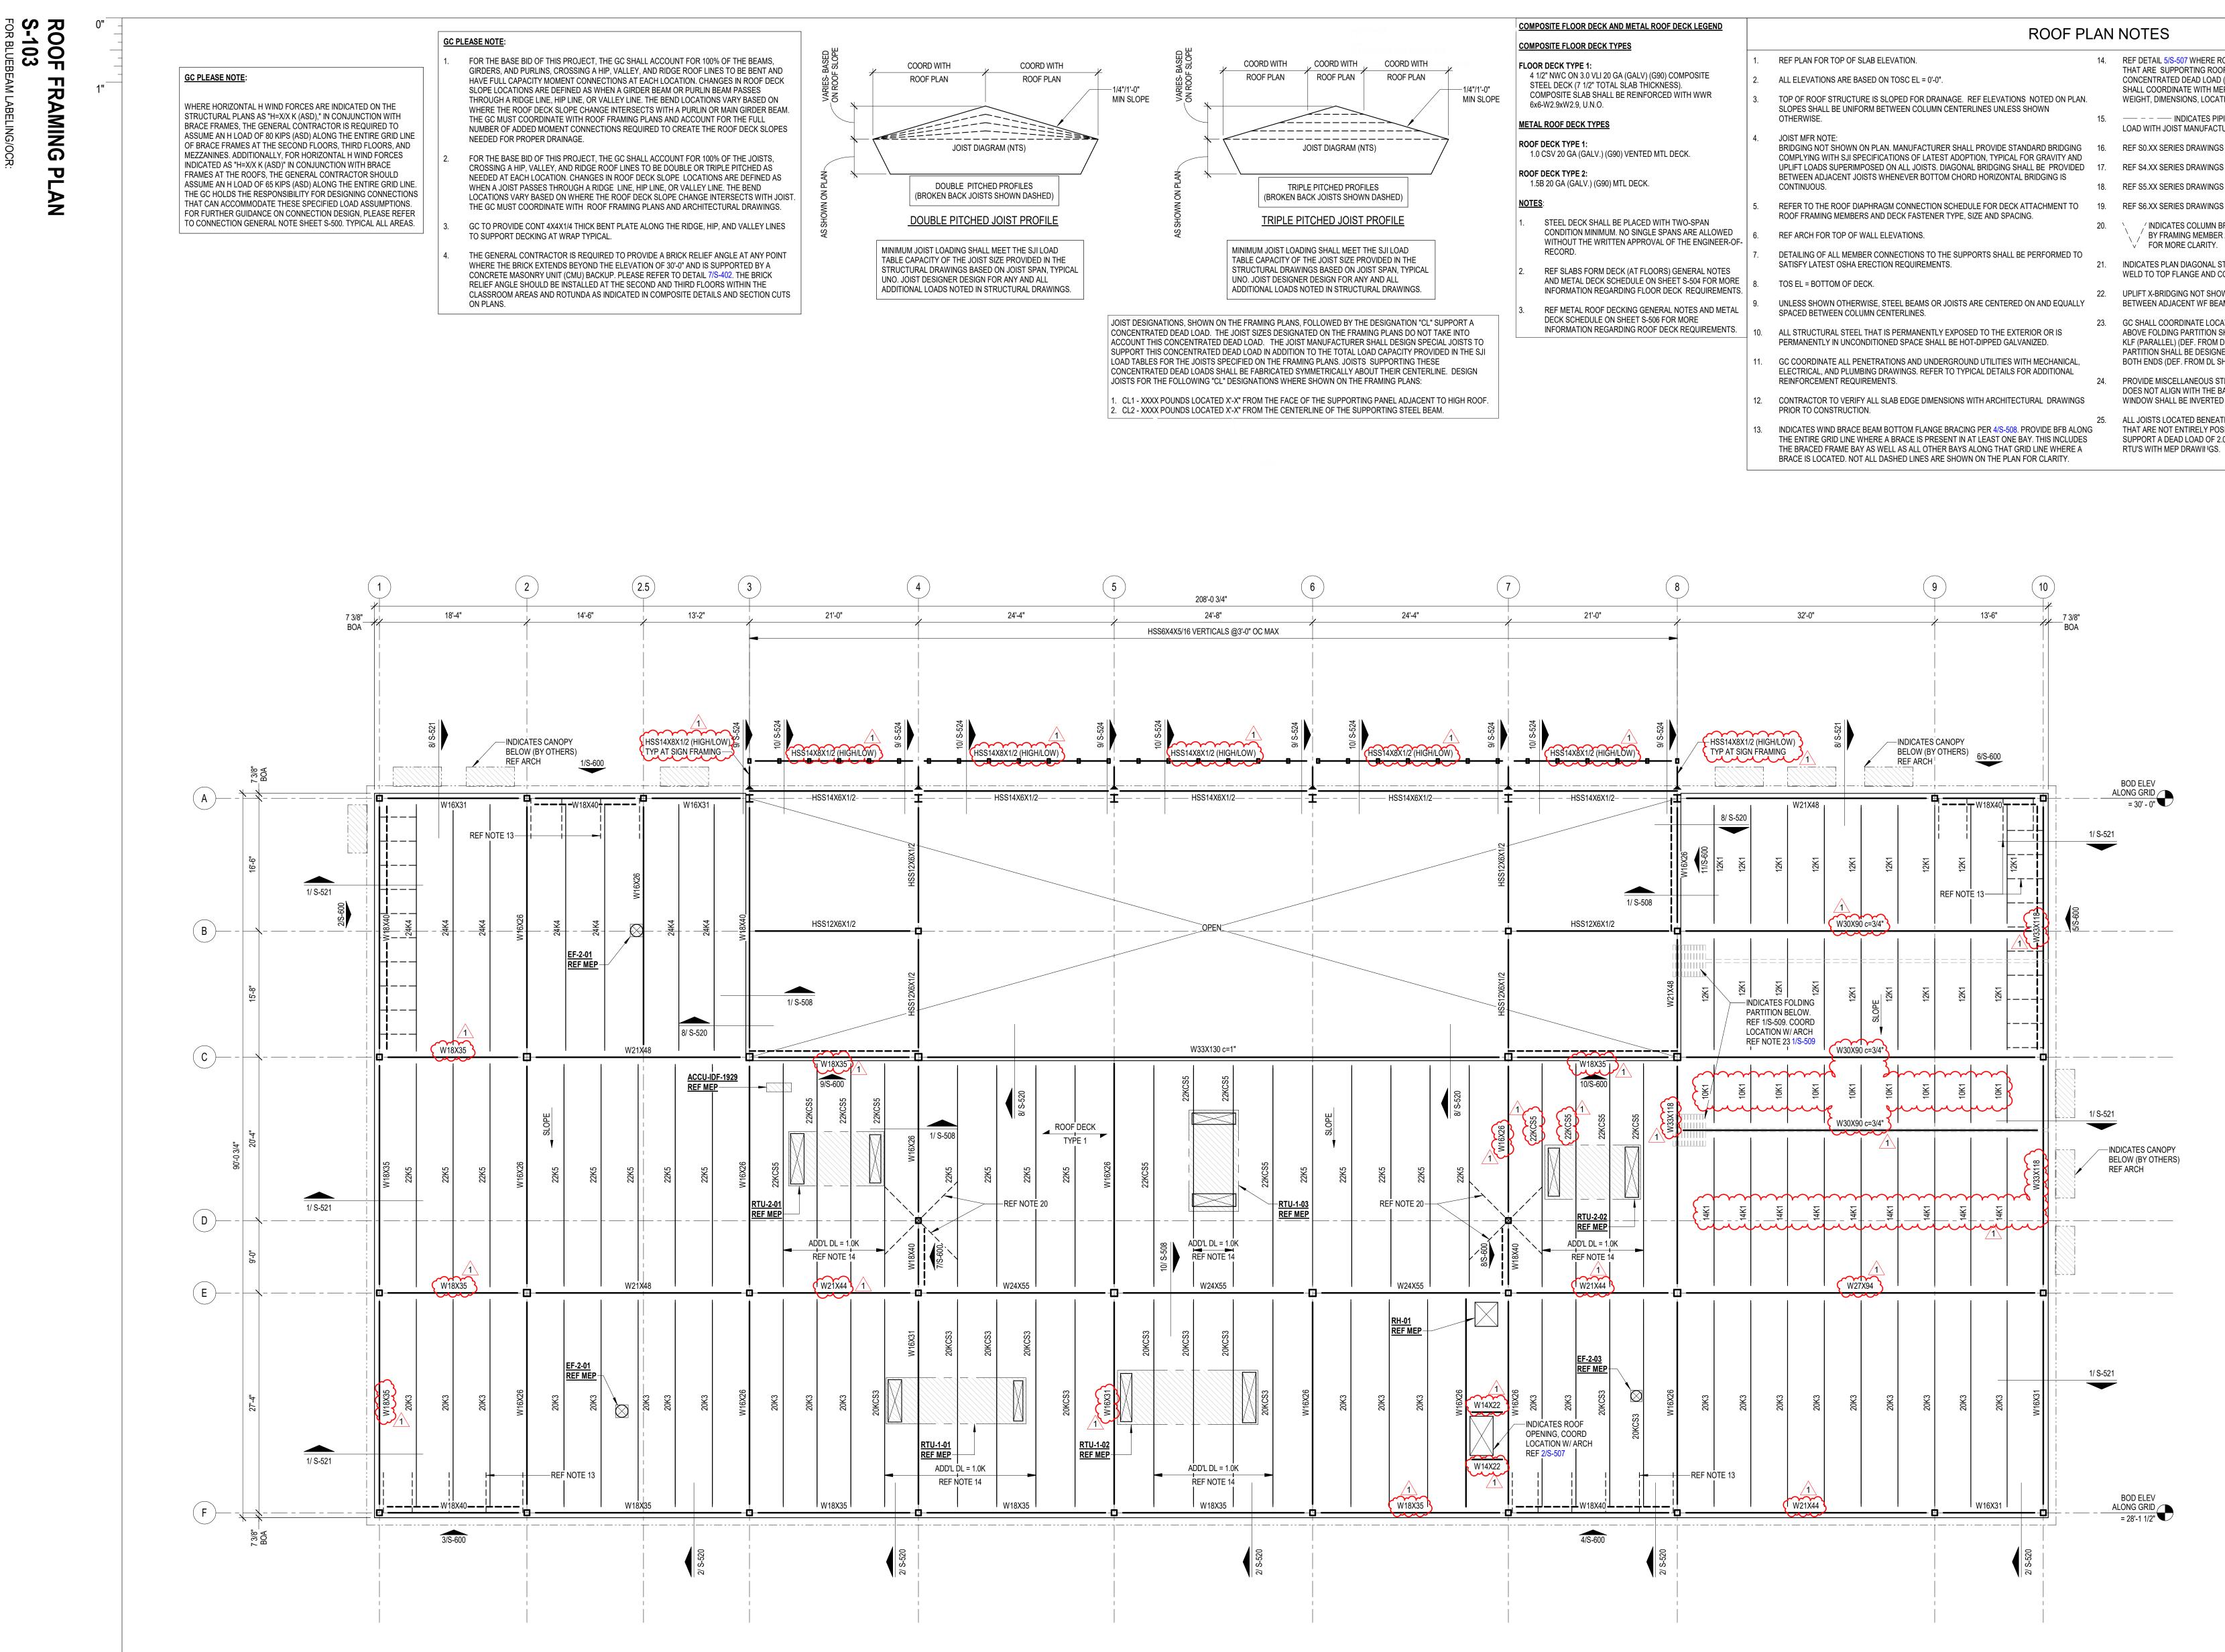


Plot Stamp: 6/24/2025 10:39:23 AM


· · · · · · · · · · · · · · · · · · ·	T						
CK AND METAL ROOF DECK LEGEND	ROOF PLAN NOTES						
CK TYPES							
	1.	REF PLAN FOR TOP OF SLAB ELEVATION.	14.	REF DETAIL 5/S-507 WHERE ROOF TOP EQUIPMENT REQUIRES A STRUCTURAL CURB. JOISTS			
LI 20 GA (GALV) (G90) COMPOSITE FOTAL SLAB THICKNESS).	2.	ALL ELEVATIONS ARE BASED ON TOSC EL = 0'-0".		THAT ARE SUPPORTING ROOF TOP EQUIPMENT SHALL BE DESIGNED FOR AN ADDITIONAL CONCENTRATED DEAD LOAD (AS SHOWN ON PLAN AT ANY POINT ALONG JOIST SPAN). GC SHALL COORDINATE WITH MEP, ARCHITECTURE AND EQUIPMENT CUTSHEETS FOR FINAL			
HALL BE REINFORCED ŴITH WWR O.	3.	TOP OF ROOF STRUCTURE IS SLOPED FOR DRAINAGE. REF ELEVATIONS NOTED ON PLAN. SLOPES SHALL BE UNIFORM BETWEEN COLUMN CENTERLINES UNLESS SHOWN		WEIGHT, DIMENSIONS, LOCATION, ETC.			
PES		OTHERWISE.	15.	INDICATES PIPING RUN, REF MEP DRAWINGS; GC SHALL COORDINATE GIVEN LOAD WITH JOIST MANUFACTURER. REF SHEET S-011.			
/.) (G90) VENTED MTL DECK.	4.	JOIST MFR NOTE: BRIDGING NOT SHOWN ON PLAN. MANUFACTURER SHALL PROVIDE STANDARD BRIDGING COMPLYING WITH SJI SPECIFICATIONS OF LATEST ADOPTION, TYPICAL FOR GRAVITY AND	16.	REF S0.XX SERIES DRAWINGS FOR GENERAL NOTES AND TYP DETAILS			
		,	17.	REF S4.XX SERIES DRAWINGS FOR CMU DETAILS.			
G90) MTL DECK.		CONTINUOUS.	18.	REF S5.XX SERIES DRAWINGS FOR STEEL FRAMING DETAILS.			
	5.	REFER TO THE ROOF DIAPHRAGM CONNECTION SCHEDULE FOR DECK ATTACHMENT TO ROOF FRAMING MEMBERS AND DECK FASTENER TYPE, SIZE AND SPACING.	19.	REF S6.XX SERIES DRAWINGS FOR STEEL BRACE ELEVATIONS AND DETAILS.			
IALL BE PLACED WITH TWO-SPAN IMUM. NO SINGLE SPANS ARE ALLOWED VRITTEN APPROVAL OF THE ENGINEER-OF-	6.	REF ARCH FOR TOP OF WALL ELEVATIONS.	20.	/ INDICATES COLUMN BRACING PER 5/8-502. TYPICAL AT COLUMNS UNBRACED BY FRAMING MEMBER ABOUT THEIR LOCAL AXIS. NOT ALL SHOWN ON PLAN FOR MORE CLARITY.			
M DECK (AT FLOORS) GENERAL NOTES	7.	DETAILING OF ALL MEMBER CONNECTIONS TO THE SUPPORTS SHALL BE PERFORMED TO SATISFY LATEST OSHA ERECTION REQUIREMENTS.	21.	INDICATES PLAN DIAGONAL STRUT WT5X15. COPE WEB AT BEAMS AND OVERLAP FLANGE 4".			
CK SCHEDULE ON SHEET S-504 FOR MORE REGARDING FLOOR DECK REQUIREMENTS.	8.	TOS EL = BOTTOM OF DECK.	22.	WELD TO TOP FLANGE AND COLUMNS WITH 5/16" FILLET WELD 3-SIDES TYPICAL. UPLIFT X-BRIDGING NOT SHOWN ON PLANS FOR CLARITY. GC SHALL PROVIDE X-BRIDGING			
OF DECKING GENERAL NOTES AND METAL	9.	UNLESS SHOWN OTHERWISE, STEEL BEAMS OR JOISTS ARE CENTERED ON AND EQUALLY SPACED BETWEEN COLUMN CENTERLINES.	٢٢.	BETWEEN ADJACENT WF BEAMS AT ROOF PER DETAIL 3/S-507.			
E ON SHEET S-506 FOR MORE EGARDING ROOF DECK REQUIREMENTS.	10.	ALL STRUCTURAL STEEL THAT IS PERMANENTLY EXPOSED TO THE EXTERIOR OR IS PERMANENTLY IN UNCONDITIONED SPACE SHALL BE HOT-DIPPED GALVANIZED.	23.	GC SHALL COORDINATE LOCATION OF FOLDING PARTITIONS V/ITH ARCH DRAWINGS. JOISTS ABOVE FOLDING PARTITION SHALL BE DESIGNED FOR ADD'L DL= 2.0 K (PERP.) OR DL= 0.5 KLF (PARALLEL) (DEF. FROM DL SHALL NOT EXCEED 3/8"). END JOISTS ABOVE FOLDING PARTITION SHALL BE DESIGNED FOR STACKED END LOAD EQUAL TO 9000 POUNDS FOR			
	11.	GC COORDINATE ALL PENETRATIONS AND UNDERGROUND UTILITIES WITH MECHANICAL, ELECTRICAL, AND PLUMBING DRAWINGS. REFER TO TYPICAL DETAILS FOR ADDITIONAL		BOTH ENDS (DEF. FROM DL SHALL NOT EXCEED 3/8"). REF DETAIL 1/S-509.			
	12.	REINFORCEMENT REQUIREMENTS.	24.	PROVIDE MISCELLANEOUS STEEL PER 12/S-501 ABOVE AND BELOW ANY WINDOW THAT DOES NOT ALIGN WITH THE BACK-UP, UNO, TYPICAL. LOOSE LINTELS REQUIRED BELOW			
		CONTRACTOR TO VERIFY ALL SLAB EDGE DIMENSIONS WITH ARCHITECTURAL DRAWINGS PRIOR TO CONSTRUCTION.	05	WINDOW SHALL BE INVERTED (DOG LEG DOWN) TYPICAL.			
	13.	INDICATES WIND BRACE BEAM BOTTOM FLANGE BRACING PER 4/S-508. PROVIDE BFB ALONG THE ENTIRE GRID LINE WHERE A BRACE IS PRESENT IN AT LEAST ONE BAY. THIS INCLUDES THE BRACED FRAME BAY AS WELL AS ALL OTHER BAYS ALONG THAT GRID LINE WHERE A	25. 3	ALL JOISTS LOCATED BENEATH ROOFTOP UNITS AND THE ADJACENT JOISTS ON EACH SIDE THAT ARE NOT ENTIRELY POSITIONED UNDER THE ROOFTOP UNIT MUST BE DESIGNED TO SUPPORT A DEAD LOAD OF 2.0 KIPS, UNO ON PLANS. GC MUST COORDINATE LOCATION OF RTLI'S WITH MED DRAWINGS			


ROOF FRAMING PLAN Λ





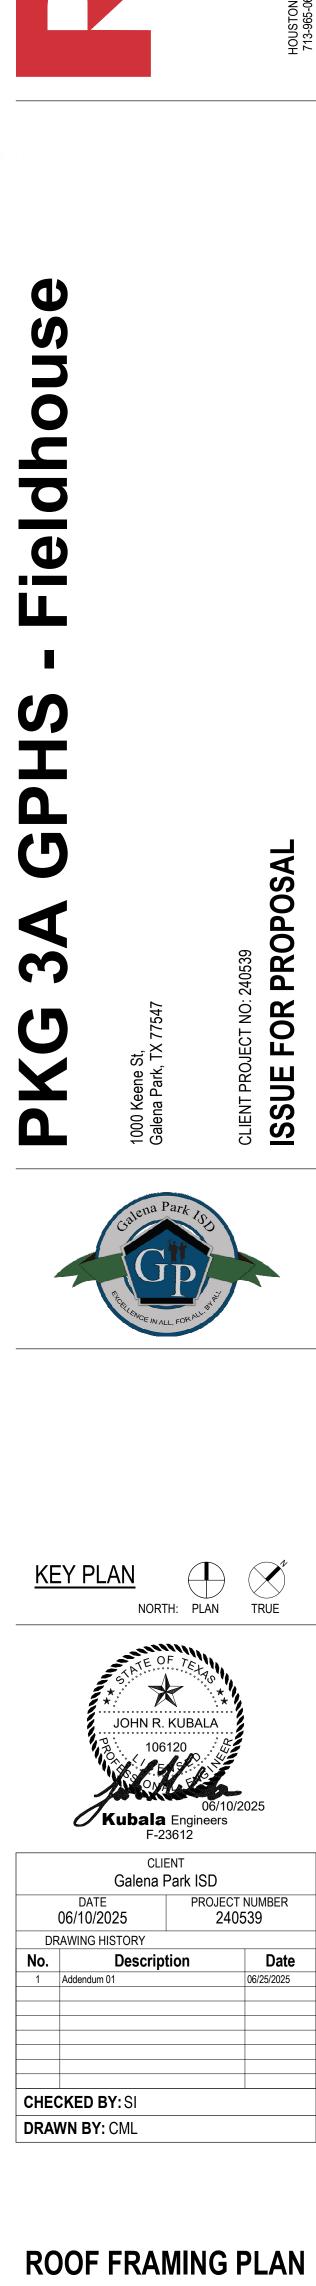

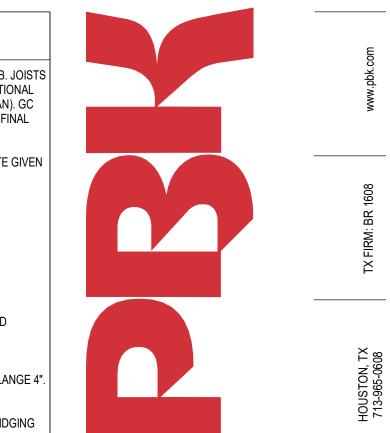

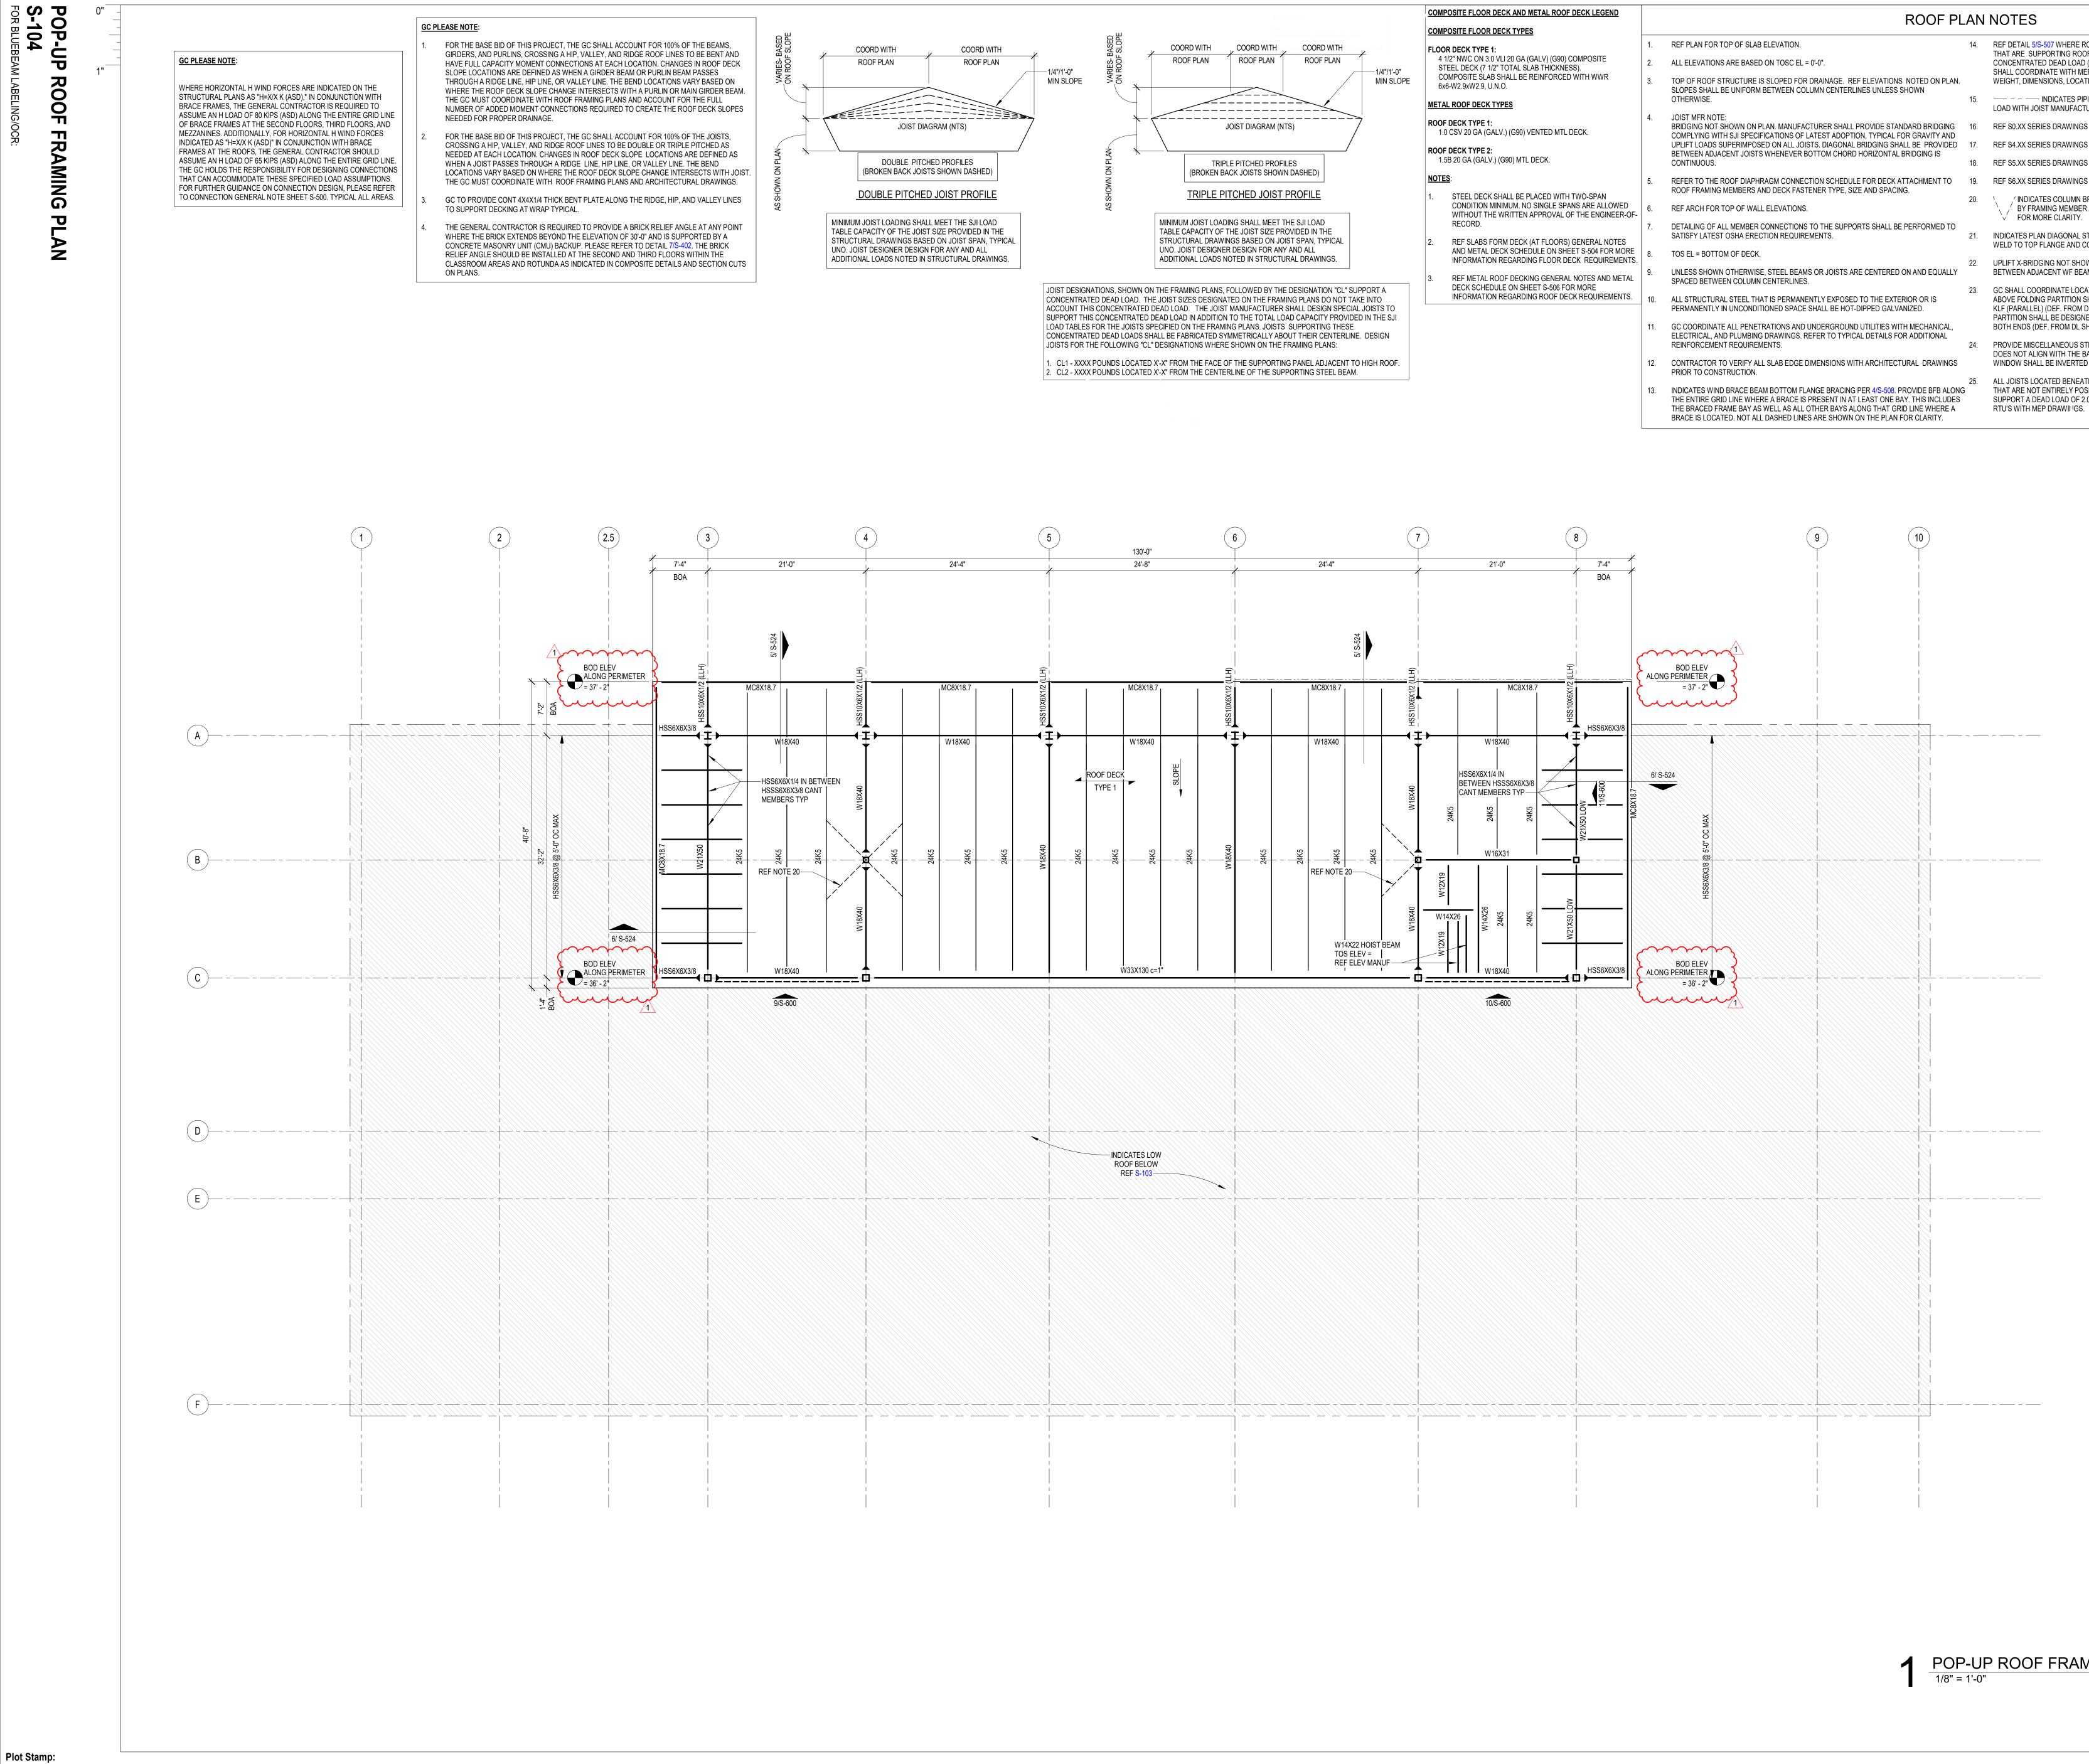

6/24/2025 10:39:24 AM


CK AND METAL ROOF DECK LEGEND	ROOF PLAN NOTES						
CK TYPES							
	1.	REF PLAN FOR TOP OF SLAB ELEVATION.	14.	REF DETAIL 5/S-507 WHERE ROOF TOP EQUIPMENT REQUIRES A STRUCTURAL CURB. JOISTS THAT ARE SUPPORTING ROOF TOP EQUIPMENT SHALL BE DESIGNED FOR AN ADDITIONAL			
LI 20 GA (GALV) (G90) COMPOSITE TOTAL SLAB THICKNESS).	2.	ALL ELEVATIONS ARE BASED ON TOSC EL = 0'-0".		CONCENTRATED DEAD LOAD (AS SHOWN ON PLAN AT ANY POINT ALONG JOIST SPAN). GC SHALL COORDINATE WITH MEP, ARCHITECTURE AND EQUIPMENT CUTSHEETS FOR FINAL			
HALL BE REINFORCED WITH WWR O.	3.	TOP OF ROOF STRUCTURE IS SLOPED FOR DRAINAGE. REF ELEVATIONS NOTED ON PLAN. SLOPES SHALL BE UNIFORM BETWEEN COLUMN CENTERLINES UNLESS SHOWN		WEIGHT, DIMENSIONS, LOCATION, ETC.			
PES		OTHERWISE.	15.				
	4.	JOIST MFR NOTE:					
V.) (G90) VENTED MTL DECK.		BRIDGING NOT SHOWN ON PLAN. MANUFACTURER SHALL PROVIDE STANDARD BRIDGING COMPLYING WITH SJI SPECIFICATIONS OF LATEST ADOPTION, TYPICAL FOR GRAVITY AND	16.	REF S0.XX SERIES DRAWINGS FOR GENERAL NOTES AND TYP DETAILS			
		UPLIFT LOADS SUPERIMPOSED ON ALL JOISTS. DIAGONAL BRIDGING SHALL BE PROVIDED BETWEEN ADJACENT JOISTS WHENEVER BOTTOM CHORD HORIZONTAL BRIDGING IS	17.	REF S4.XX SERIES DRAWINGS FOR CMU DETAILS.			
G90) MTL DECK.		CONTINUOUS.	18.	REF S5.XX SERIES DRAWINGS FOR STEEL FRAMING DETAILS.			
	5.	REFER TO THE ROOF DIAPHRAGM CONNECTION SCHEDULE FOR DECK ATTACHMENT TO ROOF FRAMING MEMBERS AND DECK FASTENER TYPE, SIZE AND SPACING.	19.	REF S6.XX SERIES DRAWINGS FOR STEEL BRACE ELEVATIONS AND DETAILS.			
HALL BE PLACED WITH TWO-SPAN IIMUM. NO SINGLE SPANS ARE ALLOWED WRITTEN APPROVAL OF THE ENGINEER-OF-	6.	REF ARCH FOR TOP OF WALL ELEVATIONS.	20.	INDICATES COLUMN BRACING PER 5/S-502. TYPICAL AT COLUMNS UNBRACED BY FRAMING MEMBER ABOUT THEIR LOCAL AXIS. NOT ALL SHOWN ON PLAN FOR MORE CLARITY.			
	7.	DETAILING OF ALL MEMBER CONNECTIONS TO THE SUPPORTS SHALL BE PERFORMED TO SATISFY LATEST OSHA ERECTION REQUIREMENTS.	21.	INDICATES PLAN DIAGONAL STRUT WT5X15. COPE WEB AT BEAMS AND OVERLAP FLANGE 4".			
RM DECK (AT FLOORS) GENERAL NOTES CK SCHEDULE ON SHEET S-504 FOR MORE	8.	TOS EL = BOTTOM OF DECK.		WELD TO TOP FLANGE AND COLUMNS WITH 5/16" FILLET WELD 3-SIDES TYPICAL.			
REGARDING FLOOR DECK REQUIREMENTS.	9.	UNLESS SHOWN OTHERWISE, STEEL BEAMS OR JOISTS ARE CENTERED ON AND EQUALLY	22.	UPLIFT X-BRIDGING NOT SHOWN ON PLANS FOR CLARITY. GC SHALL PROVIDE X-BRIDGING BETWEEN ADJACENT WF BEAMS AT ROOF PER DETAIL 3/S-507.			
OF DECKING GENERAL NOTES AND METAL LE ON SHEET S-506 FOR MORE		SPACED BETWEEN COLUMN CENTERLINES.	23.	GC SHALL COORDINATE LOCATION OF FOLDING PARTITIONS V/ITH ARCH DRAWINGS. JOISTS			
REGARDING ROOF DECK REQUIREMENTS.	10.	ALL STRUCTURAL STEEL THAT IS PERMANENTLY EXPOSED TO THE EXTERIOR OR IS PERMANENTLY IN UNCONDITIONED SPACE SHALL BE HOT-DIPPED GALVANIZED.	20.	ABOVE FOLDING PARTITION SHALL BE DESIGNED FOR ADD'L DL= 2.0 K (PERP.) OR DL= 0.5 KLF (PARALLEL) (DEF. FROM DL SHALL NOT EXCEED 3/8"). END JOISTS ABOVE FOLDING PARTITION SHALL BE DESIGNED FOR STACKED END LOAD EQUAL TO 9000 POUNDS FOR			
	11.	GC COORDINATE ALL PENETRATIONS AND UNDERGROUND UTILITIES WITH MECHANICAL, ELECTRICAL, AND PLUMBING DRAWINGS. REFER TO TYPICAL DETAILS FOR ADDITIONAL		BOTH ENDS (DEF. FROM DL SHALL NOT EXCEED 3/8"). REF DETAIL 1/S-509.			
		REINFORCEMENT REQUIREMENTS.	24.	PROVIDE MISCELLANEOUS STEEL PER 12/S-501 ABOVE AND BELOW ANY WINDOW THAT DOES NOT ALIGN WITH THE BACK-UP, UNO, TYPICAL. LOOSE LINTELS REQUIRED BELOW			
	12.	CONTRACTOR TO VERIFY ALL SLAB EDGE DIMENSIONS WITH ARCHITECTURAL DRAWINGS PRIOR TO CONSTRUCTION.		WINDOW SHALL BE INVERTED (DOG LEG DOWN) TYPICAL.			
	13.	INDICATES WIND BRACE BEAM BOTTOM FLANGE BRACING PER 4/S-508. PROVIDE BFB ALONG THE ENTIRE GRID LINE WHERE A BRACE IS PRESENT IN AT LEAST ONE BAY. THIS INCLUDES	25. Э	ALL JOISTS LOCATED BENEATH ROOFTOP UNITS AND THE ADJACENT JOISTS ON EACH SIDE THAT ARE NOT ENTIRELY POSITIONED UNDER THE ROOFTOP UNIT MUST BE DESIGNED TO SUPPORT A DEAD LOAD OF 2.0 KIPS, UNO ON PLANS. GC MUST COORDINATE LOCATION OF			











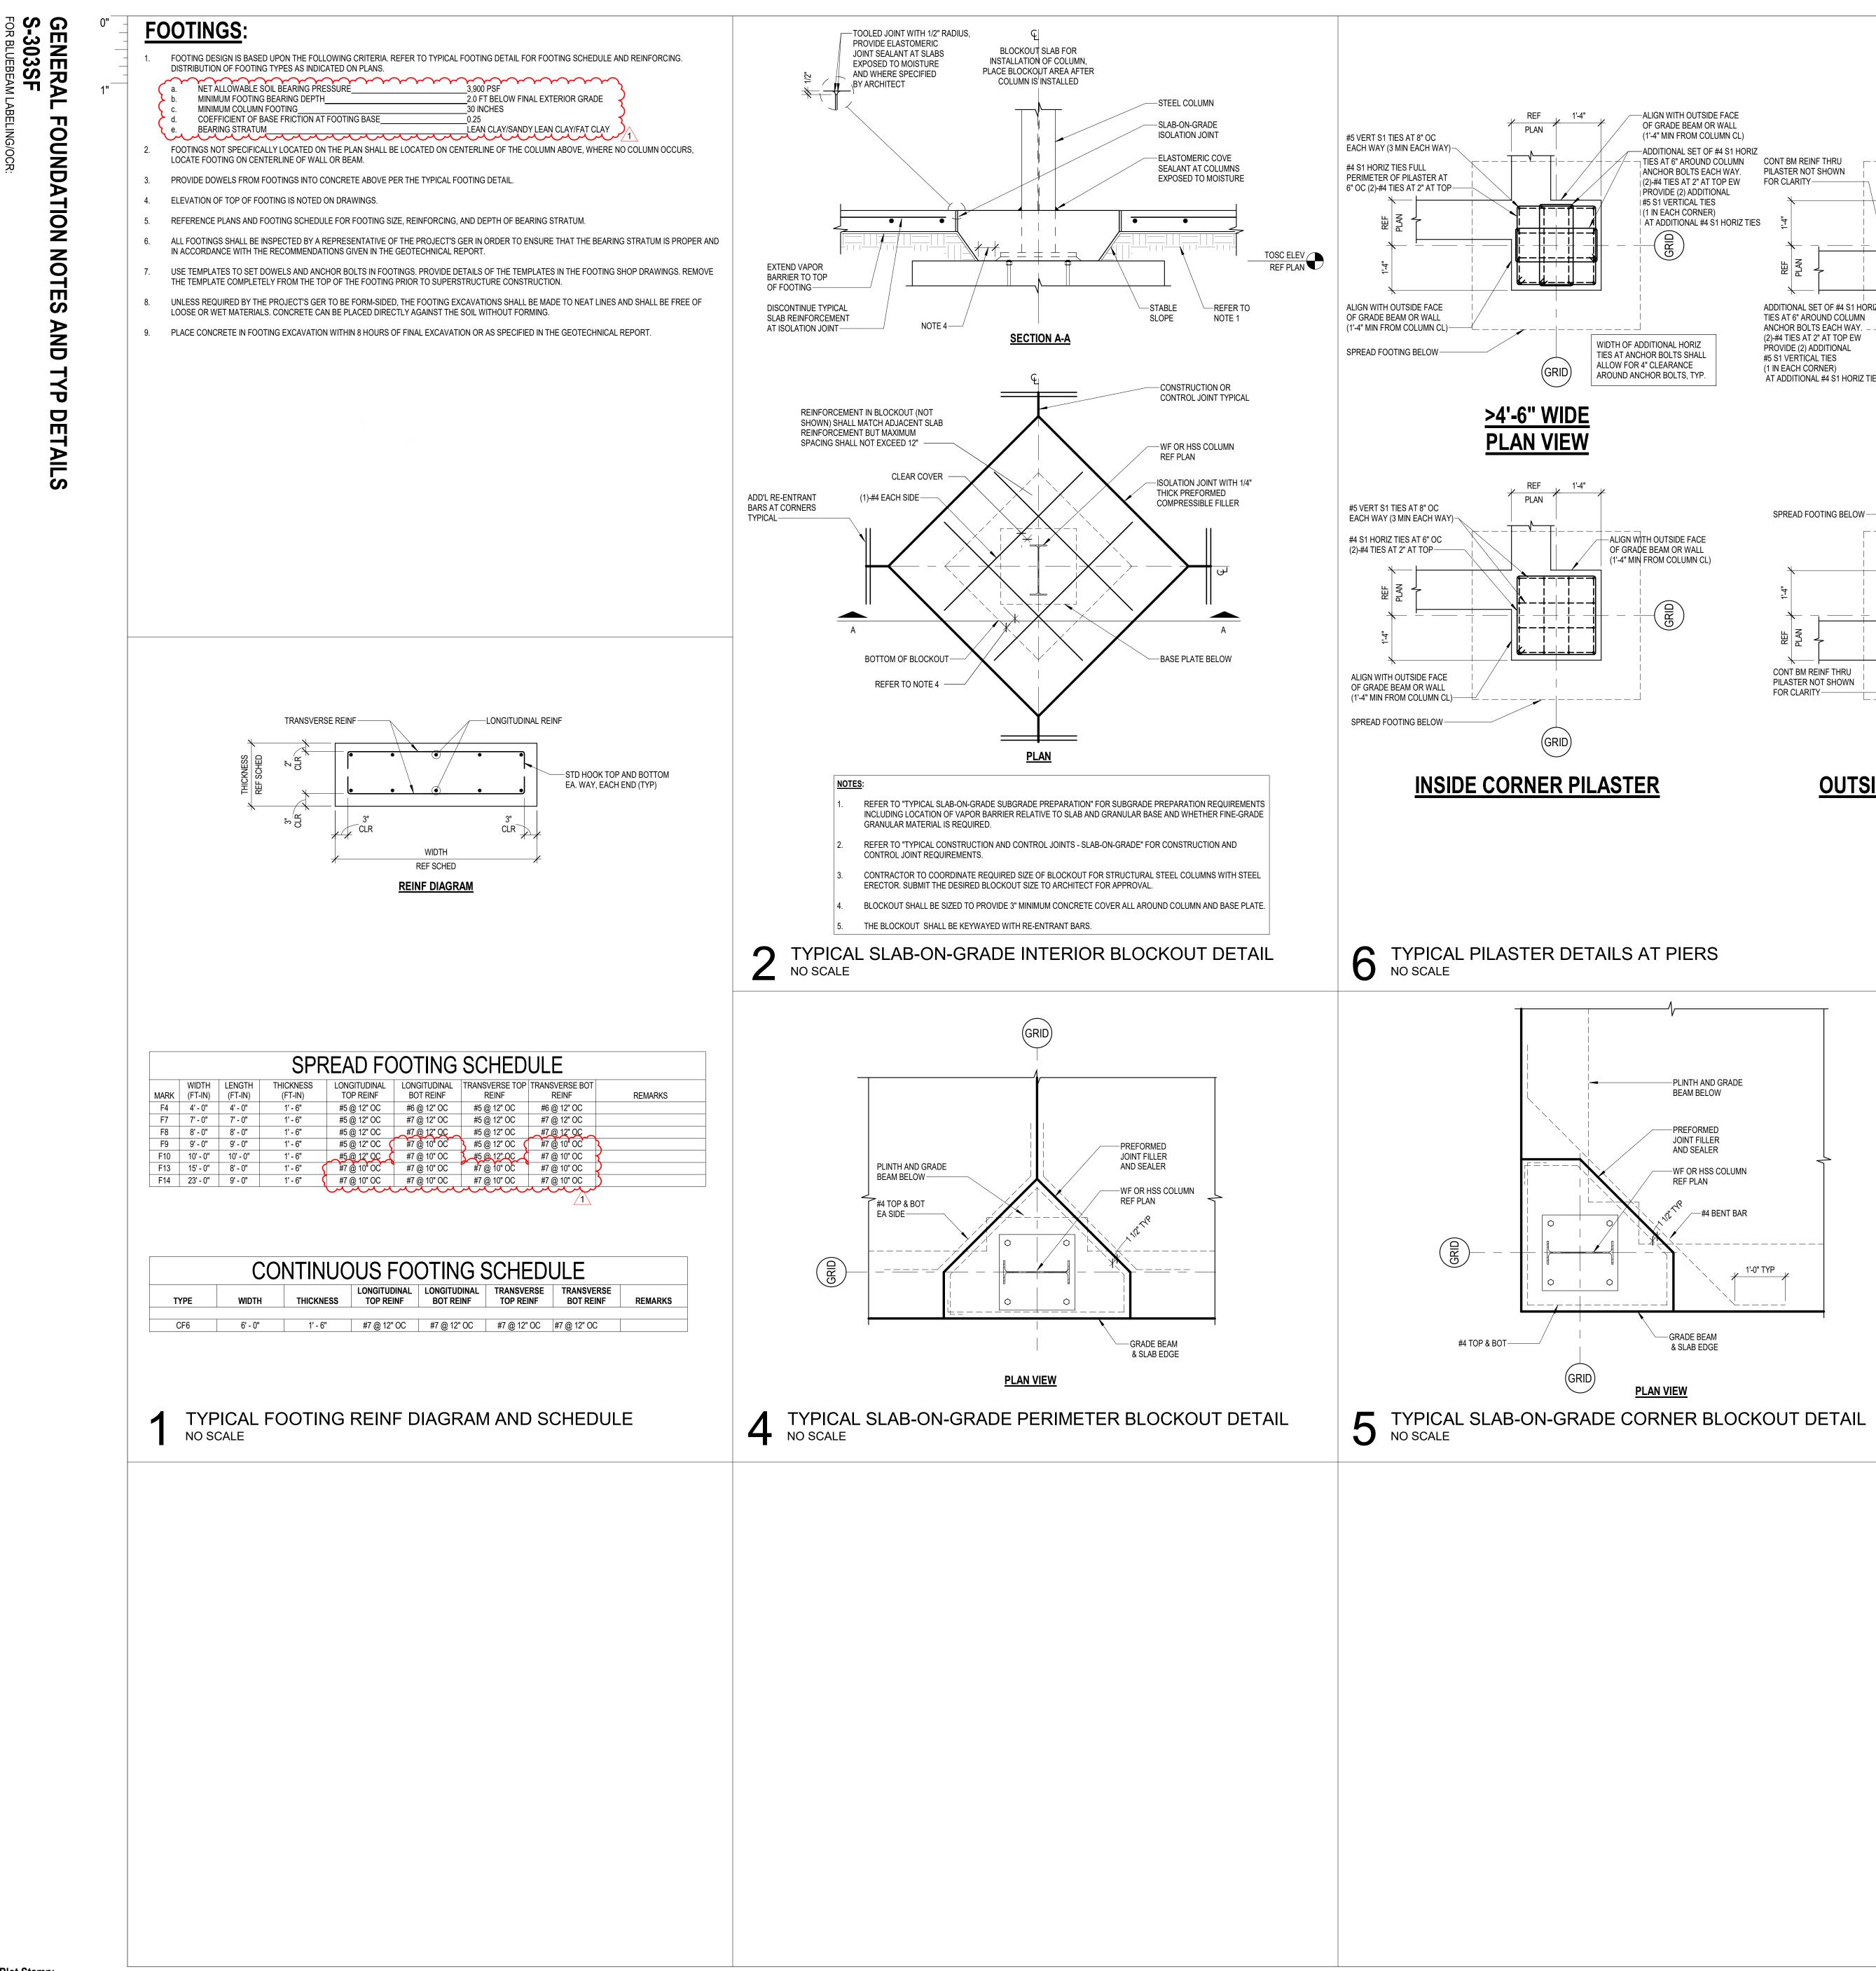


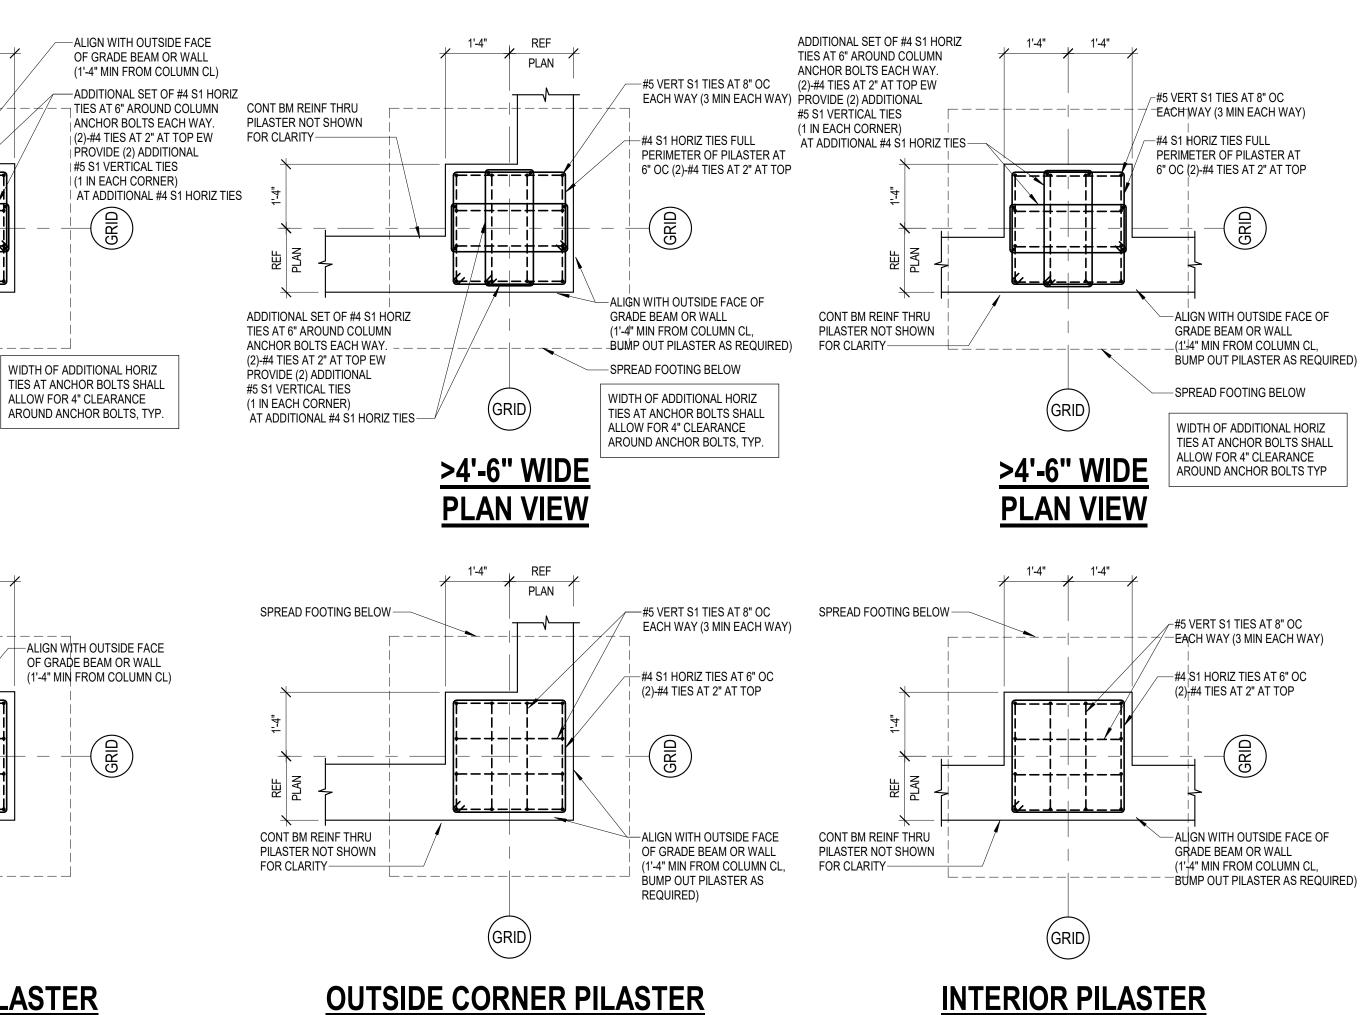

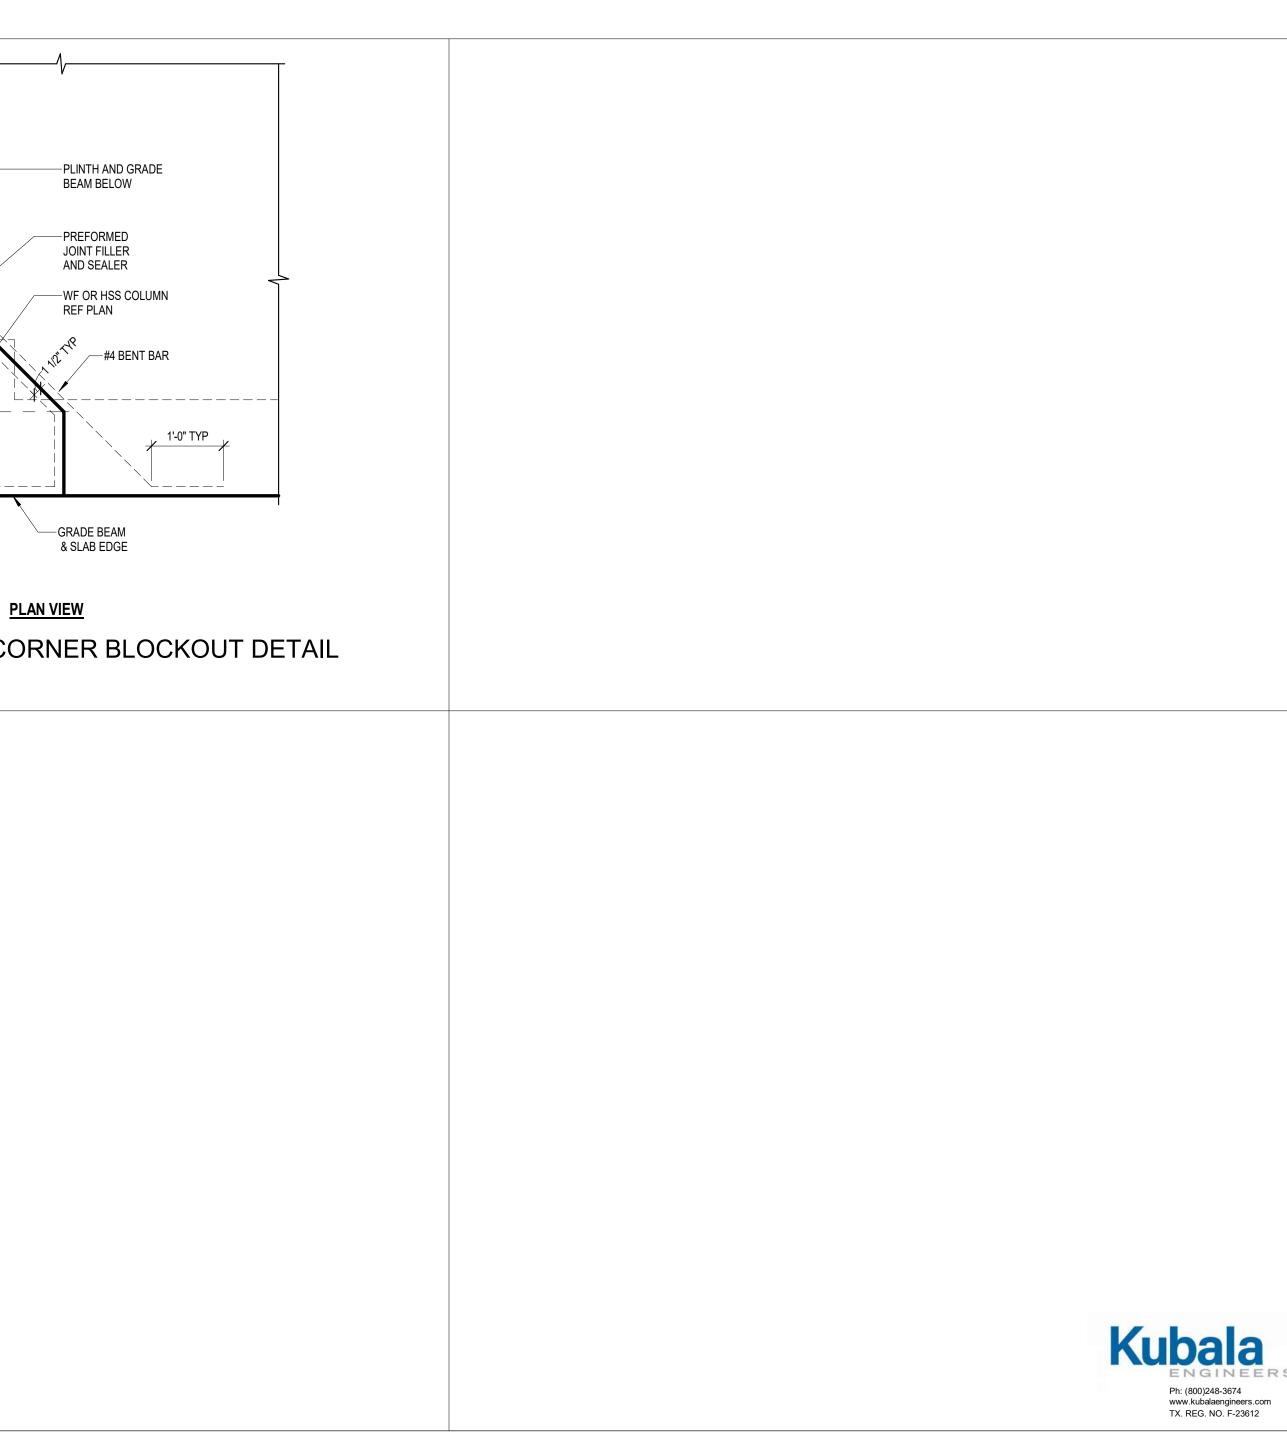



GENERAL FOUNDATION NOTES AND TYP DETAILS

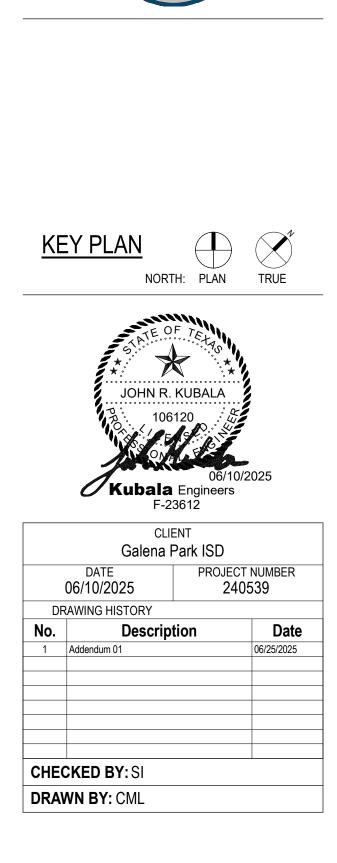








D

()

Ο

σ

ш

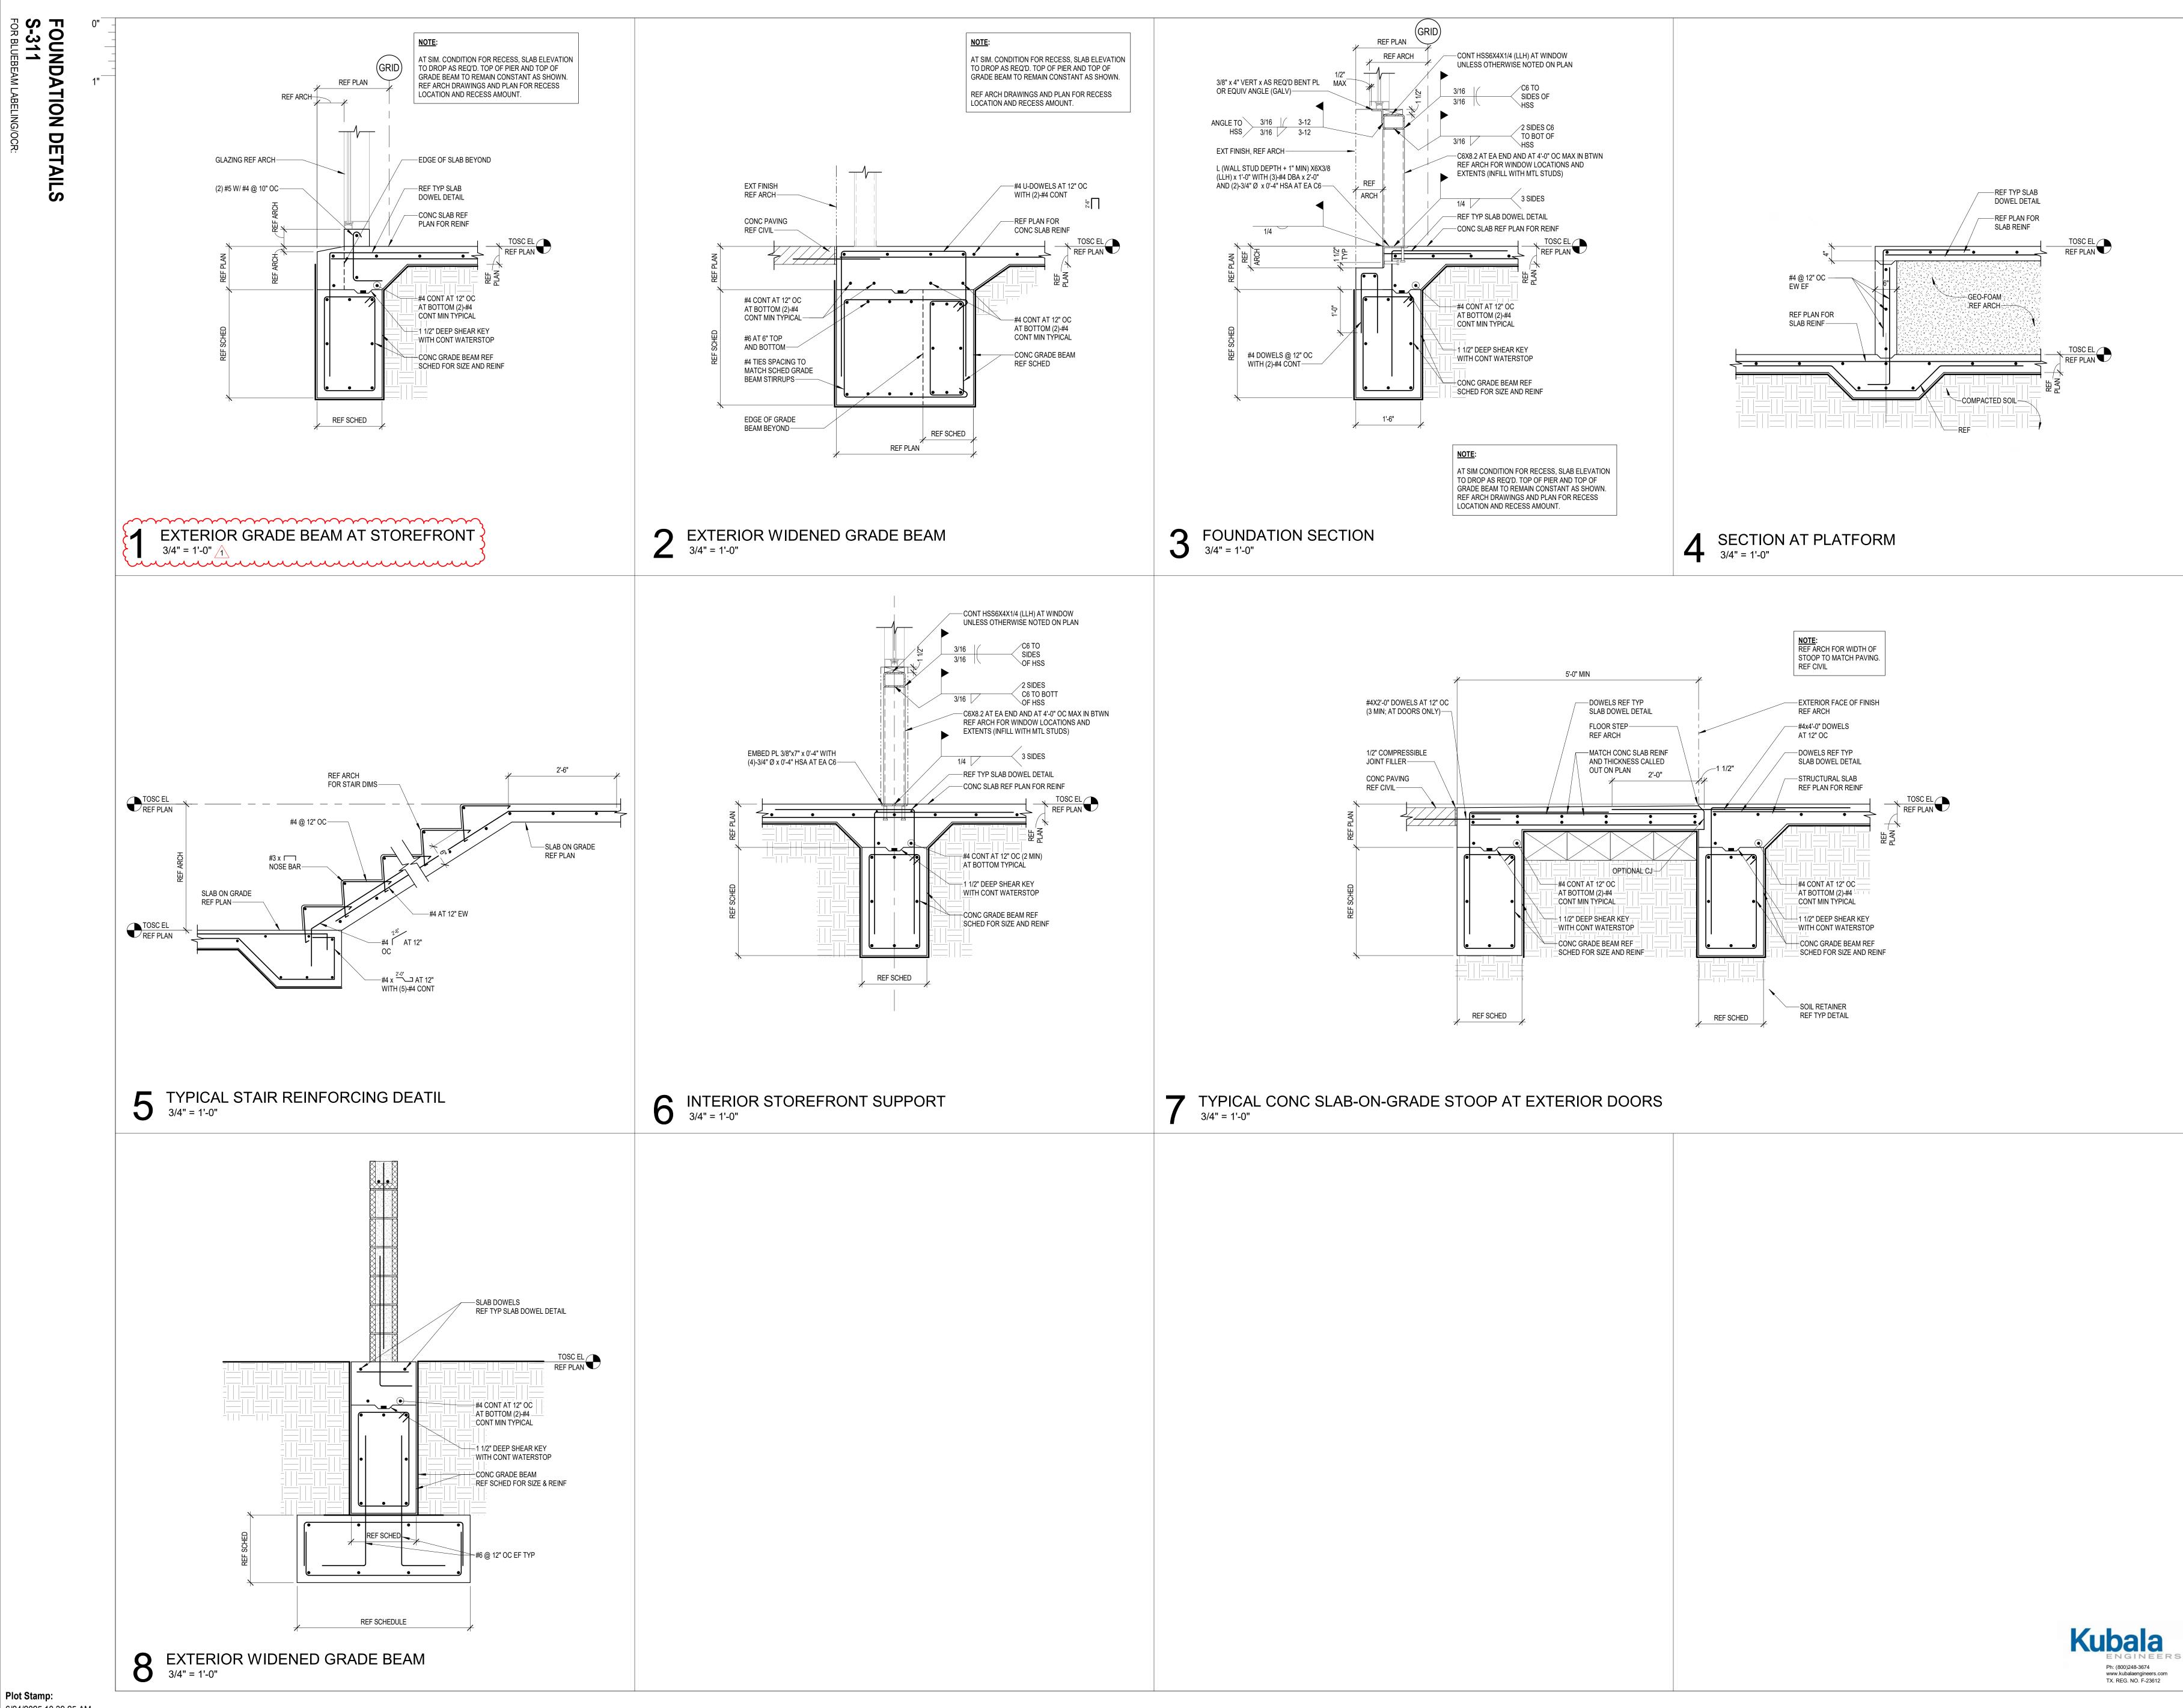

6/24/2025 10:39:25 AM





S T		
PKG 3A GPH	1000 Keene St, Galena Park, TX 77547	CLIENT PROJECT NO: 240539 ISSUE FOR PROPOSAL
	Galena Park Ist	
	PERILENCE IN ALL, FOR NUL	No. of the second secon
<u>KEY P</u>	NORTH: PLA	N TRUE
KEY PI	NORTH: PLA	A 5/10/2025
KEY P	NORTH: PLA	A 5/10/2025 ers
DAT 06/10/2	NORTH: PLA	A A b) b) c) c) c) c) c) c) c) c) c) c
DAT 06/10/2 DRAWING No.	NORTH: PLA	6/10/2025 ers D DJECT NUMBER 240539 Date
DAT 06/10/2 DRAWING No.	NORTH: PLA	6/10/2025 ers D DJECT NUMBER 240539 Date




()

J


0


eld

LL

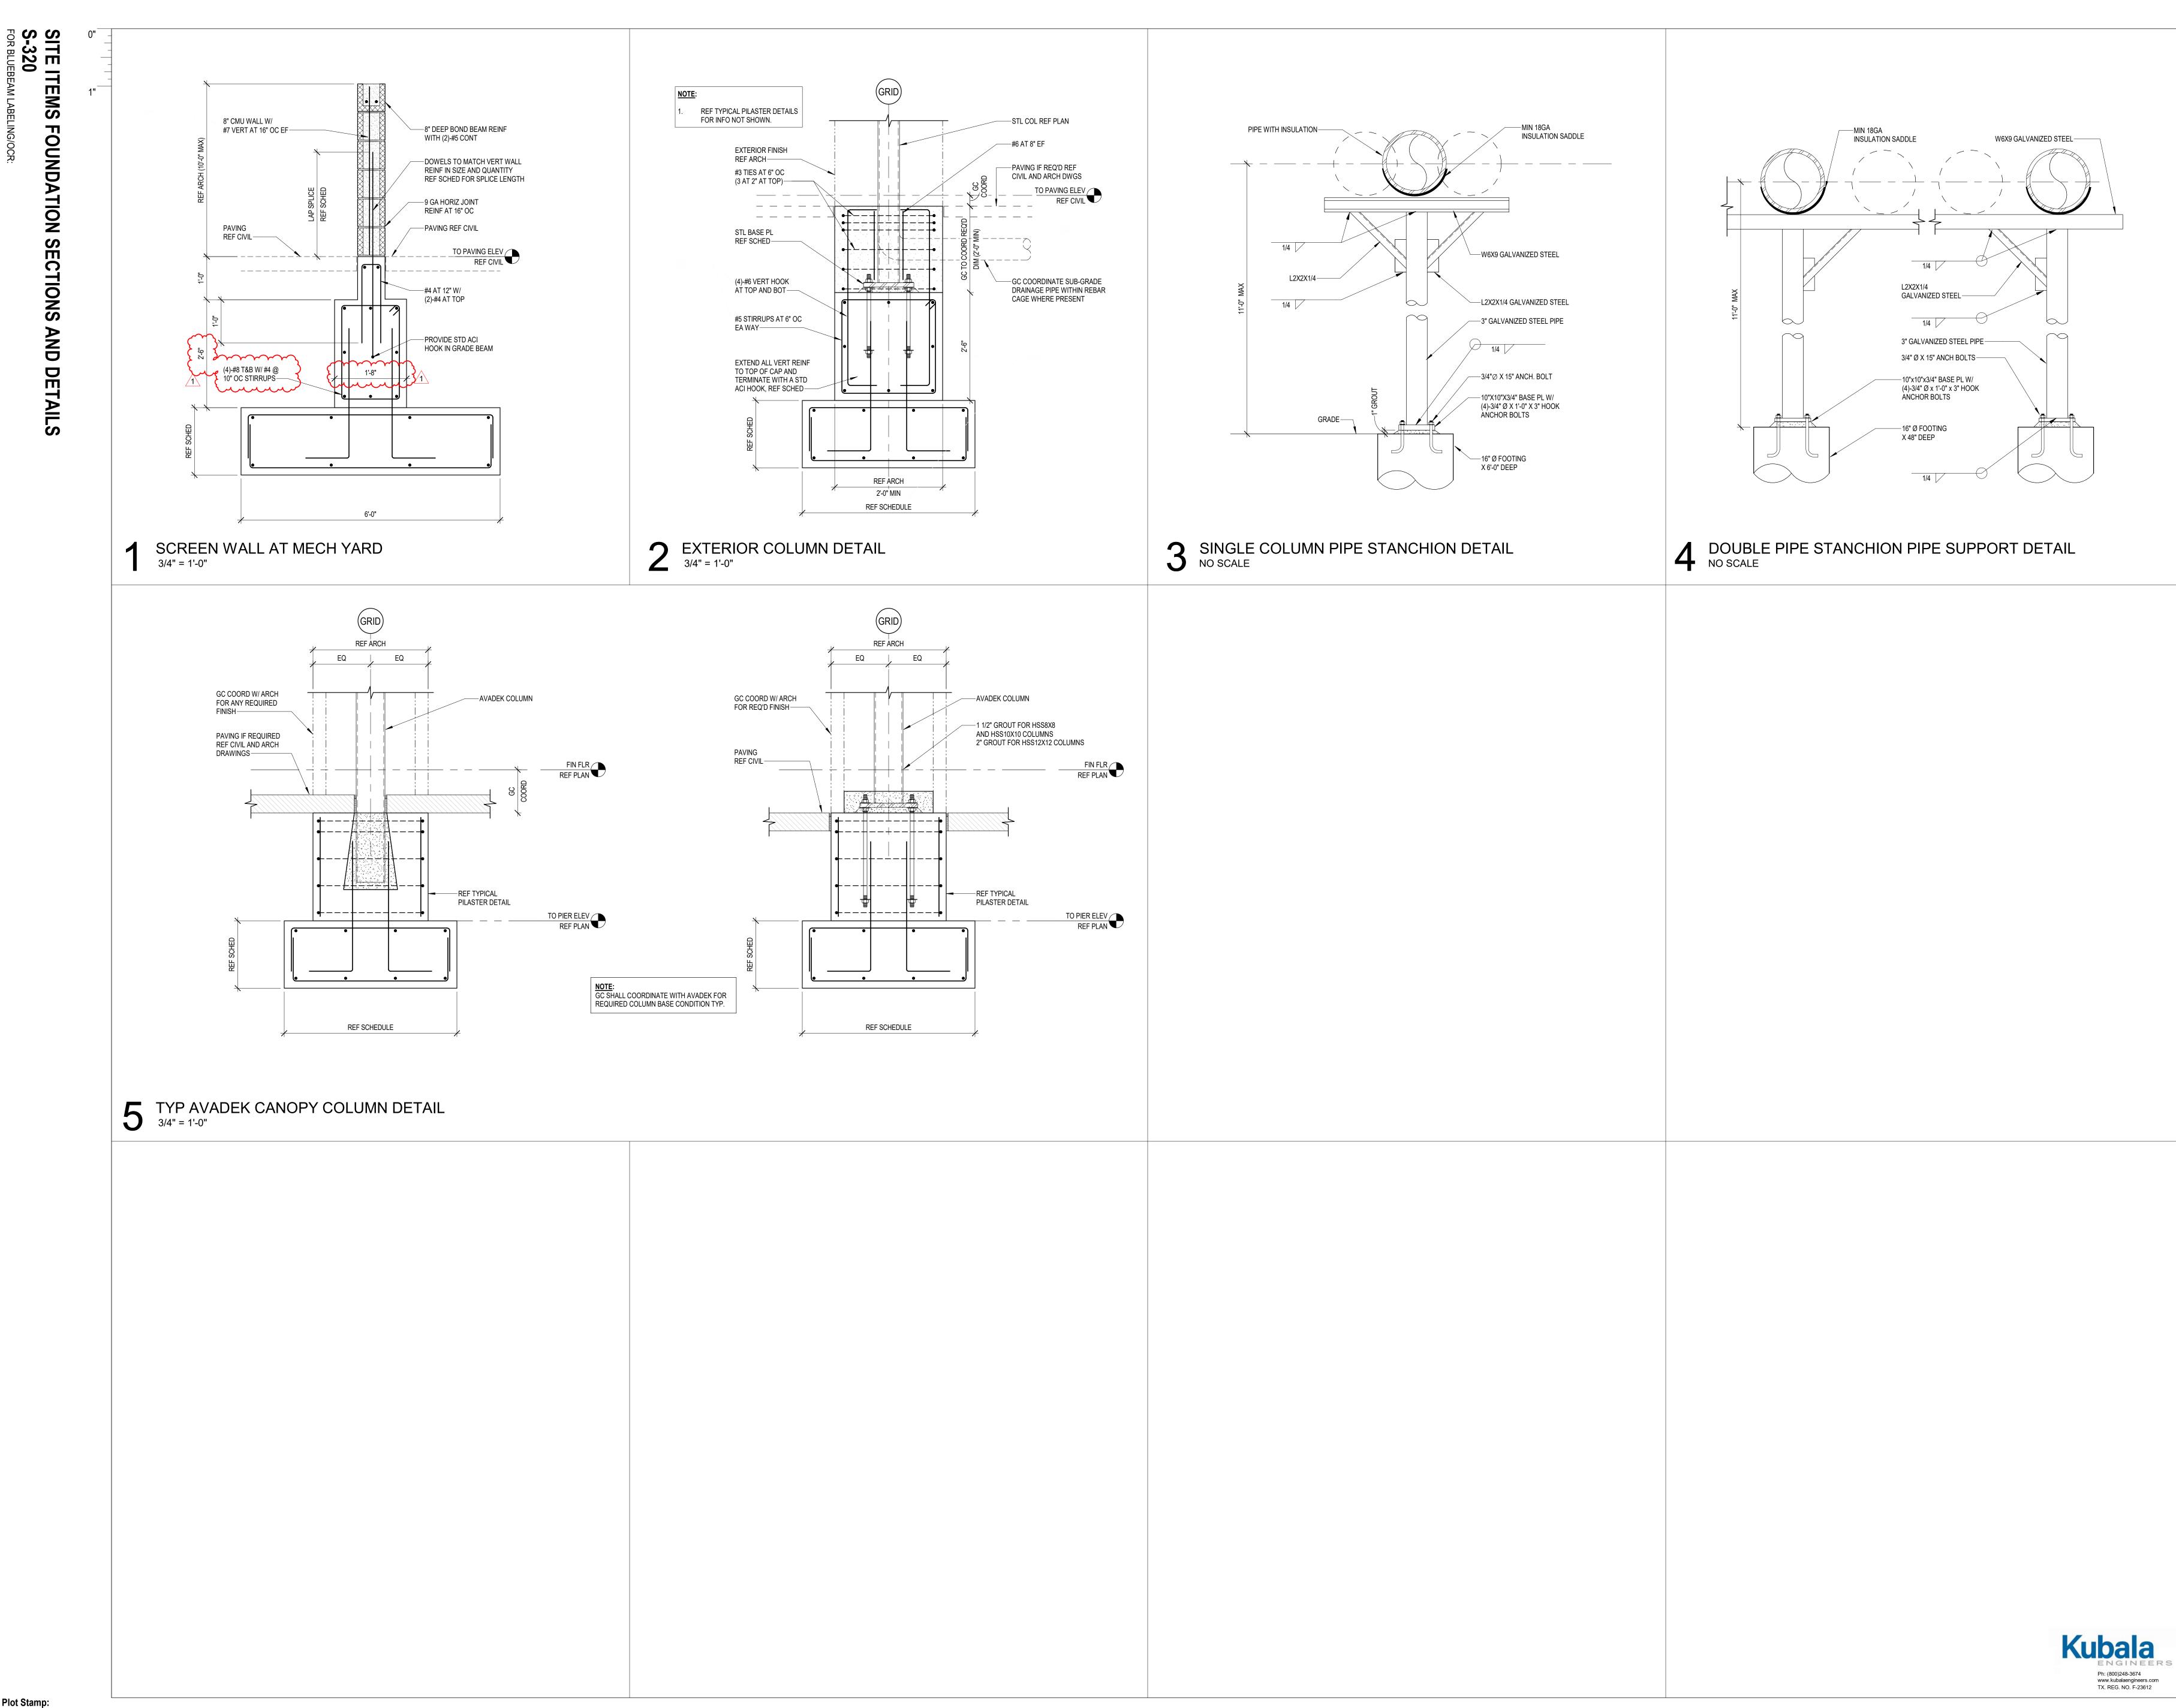


Plot Stamp: 6/24/2025 10:39:25 AM

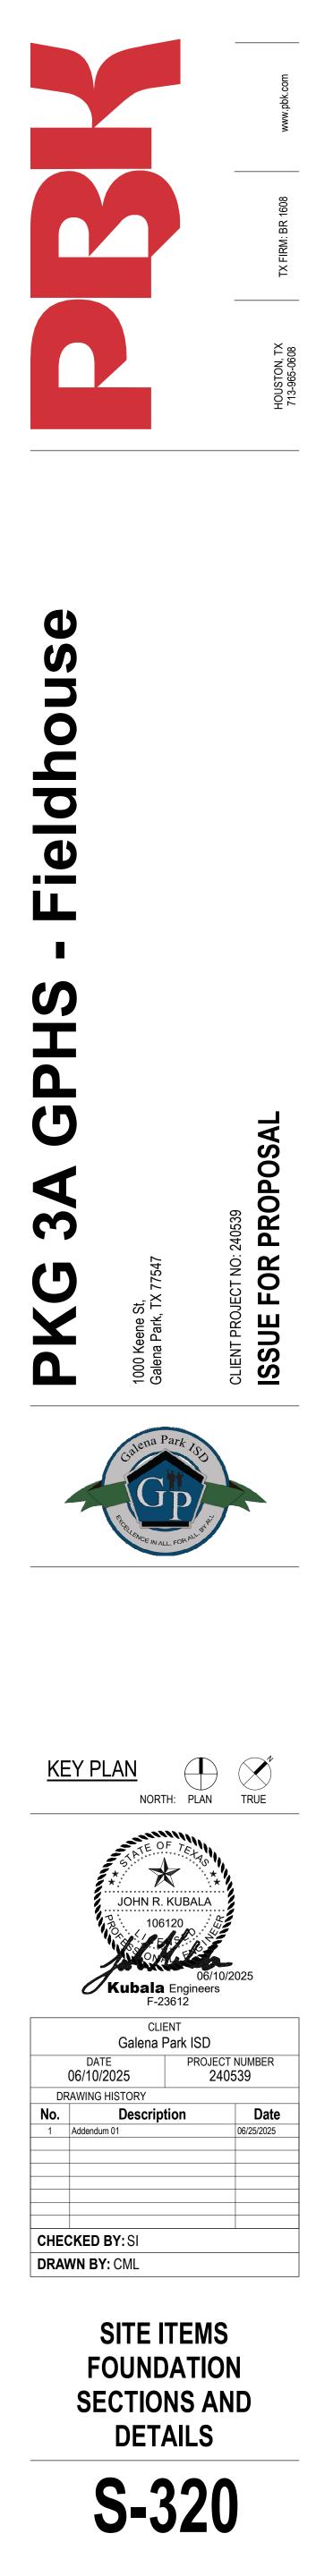

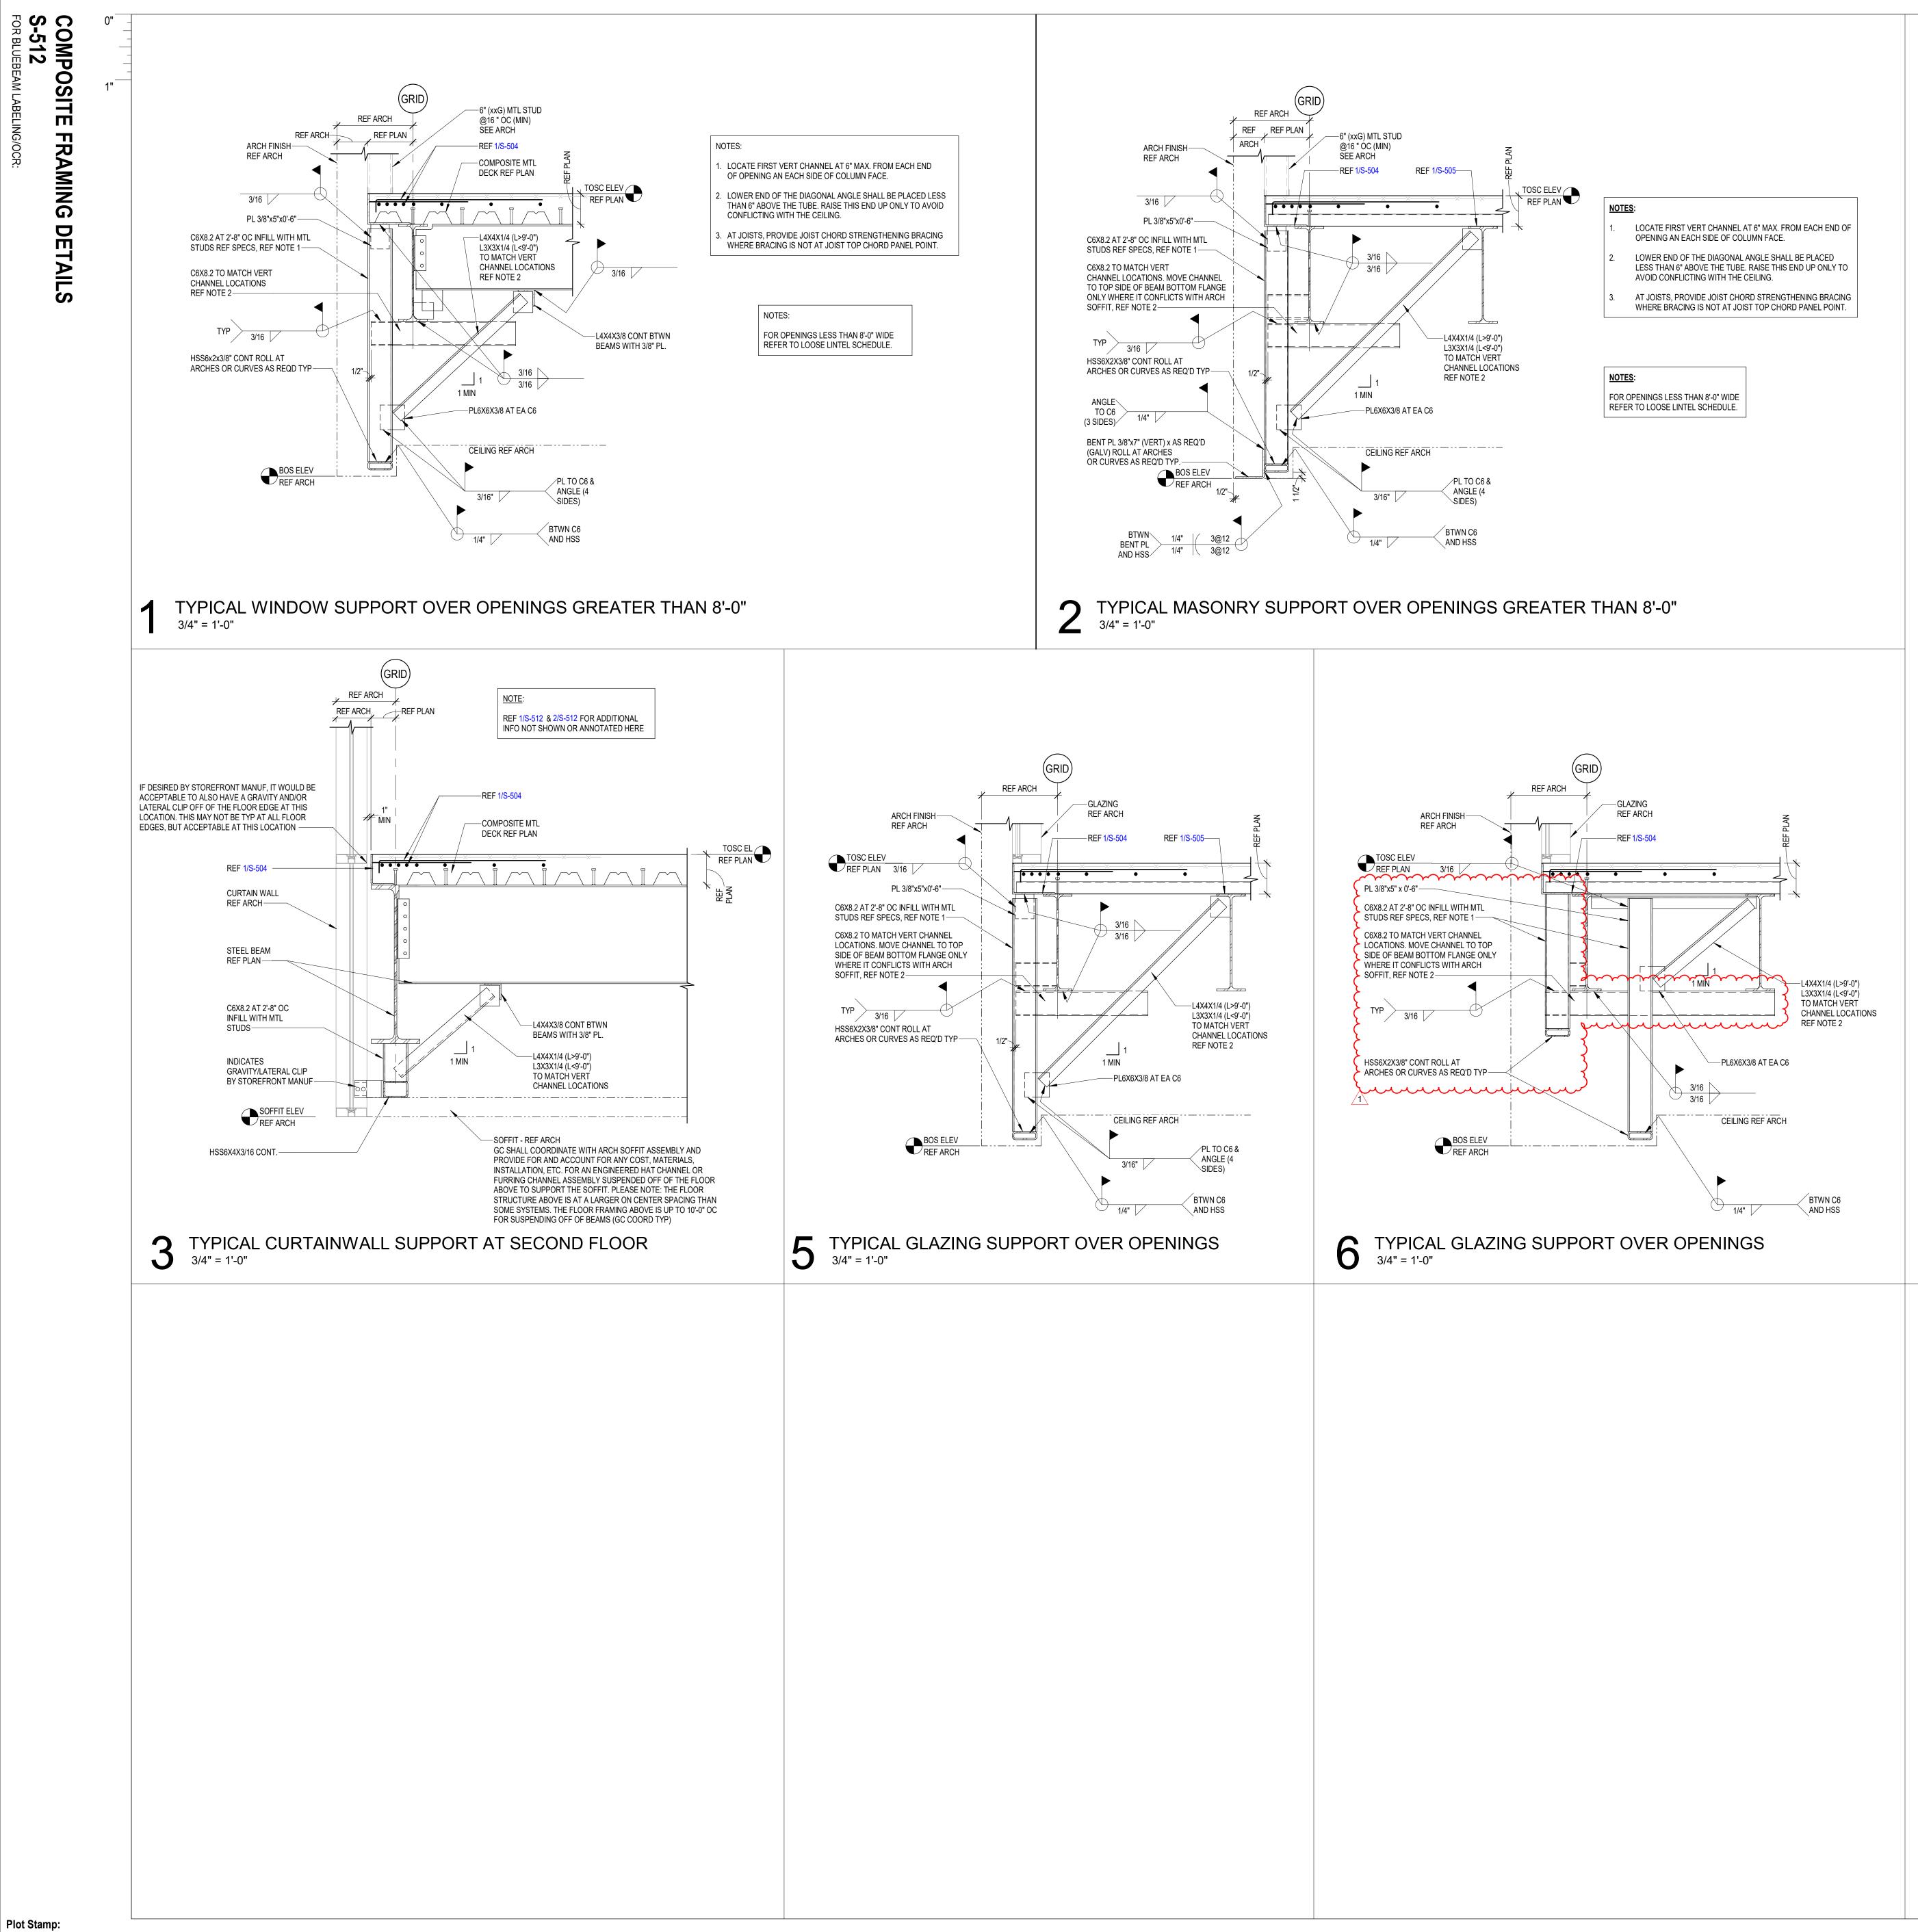

6/24/2025 10:39:26 AM

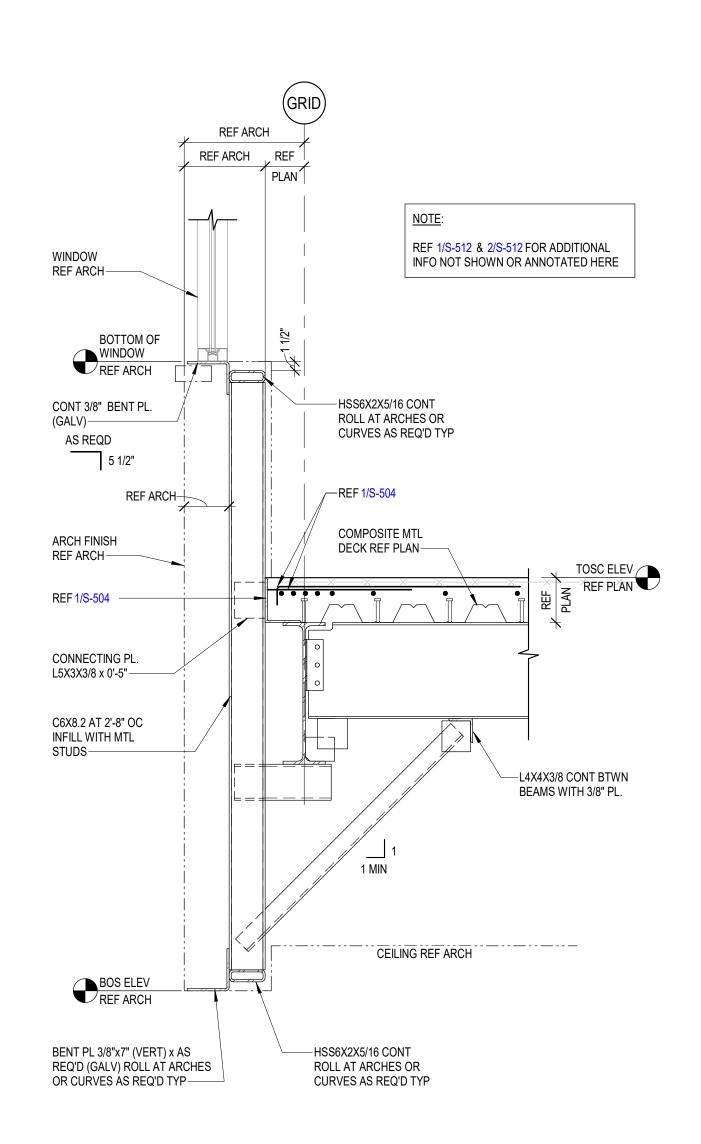

4 HANGING BRICK DETAIL 3/4" = 1'-0"






COMPOSITE FRAMING DETAILS

ieldh		
L L C		
S L		
Ъ С		AL
3 A		240539 PROPOSAI
U Y	t, TX 77547	CLIENT PROJECT NO: 240539
Д Х	1000 Keene St, Galena Park, TX 7754	CLIENT PROJECT NO: ISSUE FOR
	PCRUEINCE IN ALL, FOR ALL	
<u>KEY P</u>		
KEY PI	LAN NORTH: PL	
KEY PI	LAN NORTH: PL	AN TRUE
DAT 06/10/2	LAN NORTH: PL	AN TRUE
DAT	LAN NORTH: PL	AN TRUE
DAT 06/10/2 DRAWING No.	LAN NORTH: PL JOHN R. KUBA JOHN R. KUBA 106120 Kubala Engin F-23612 CLIENT Galena Park IS E PF 2025 HISTORY Description m01	AN TRUE TRUE



5

J

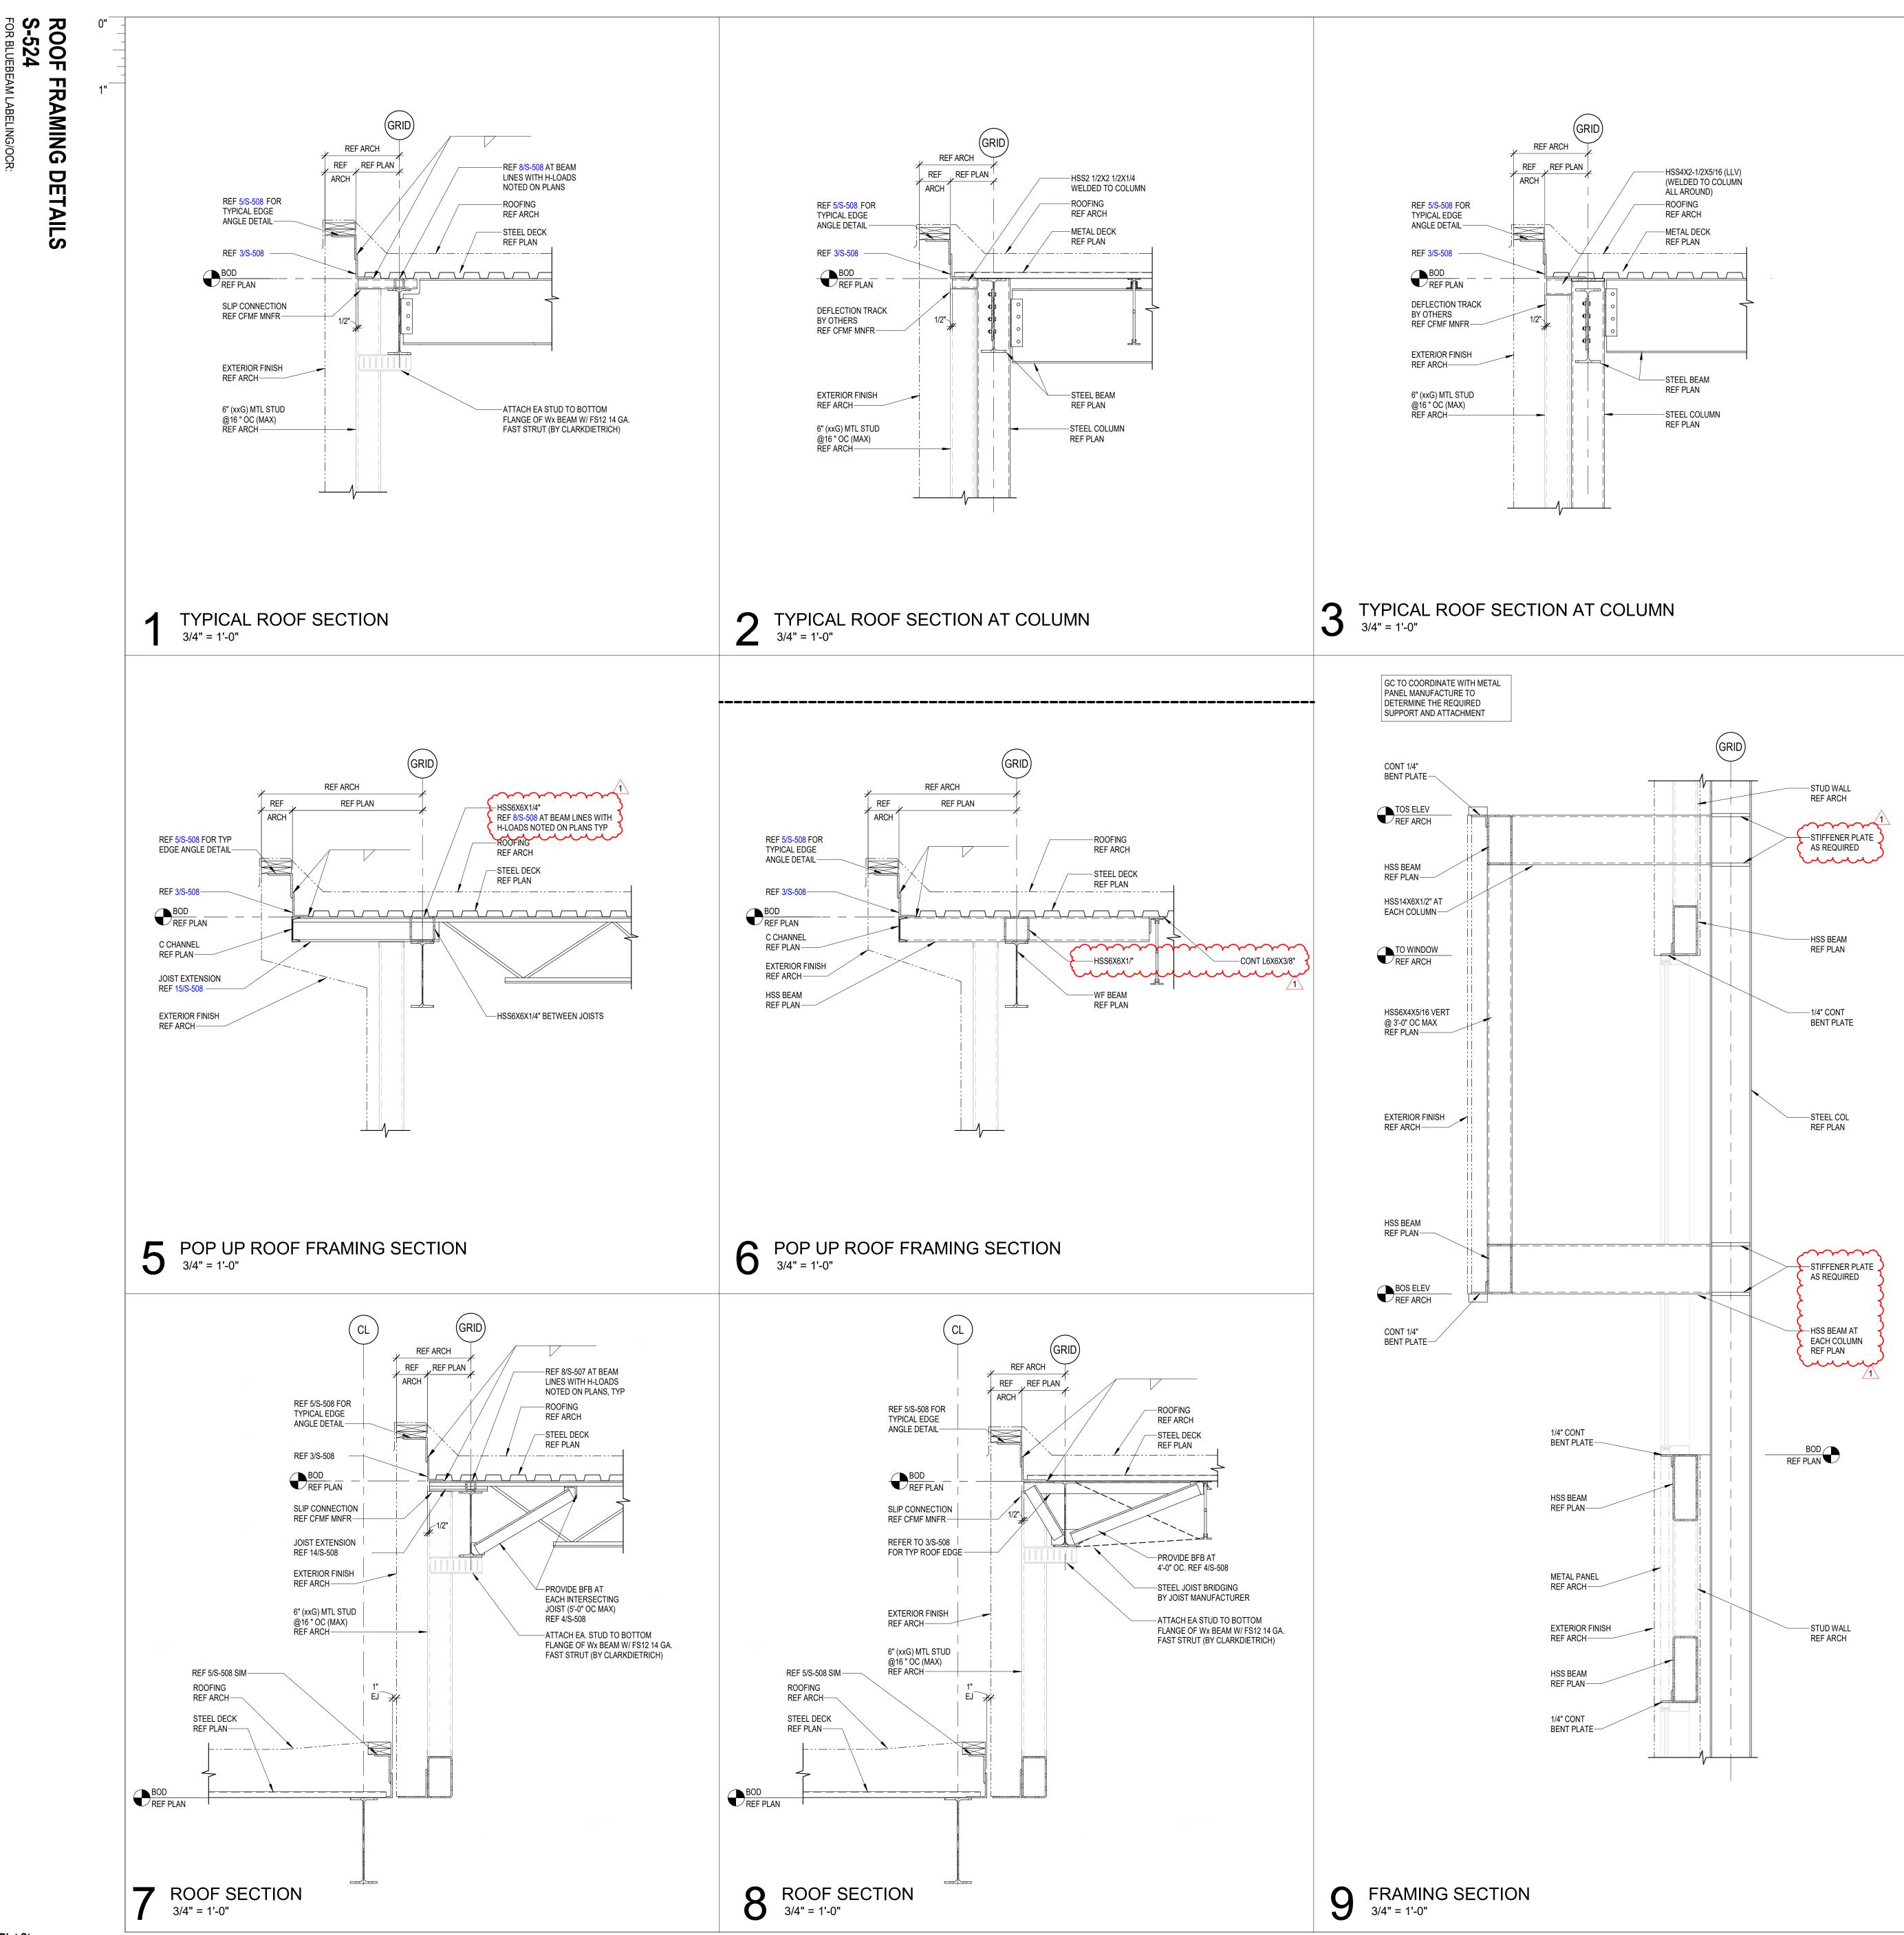


Plot Stamp:

6/24/2025 10:39:27 AM

1 O FRAMING SECTION 3/4" = 1'-0"



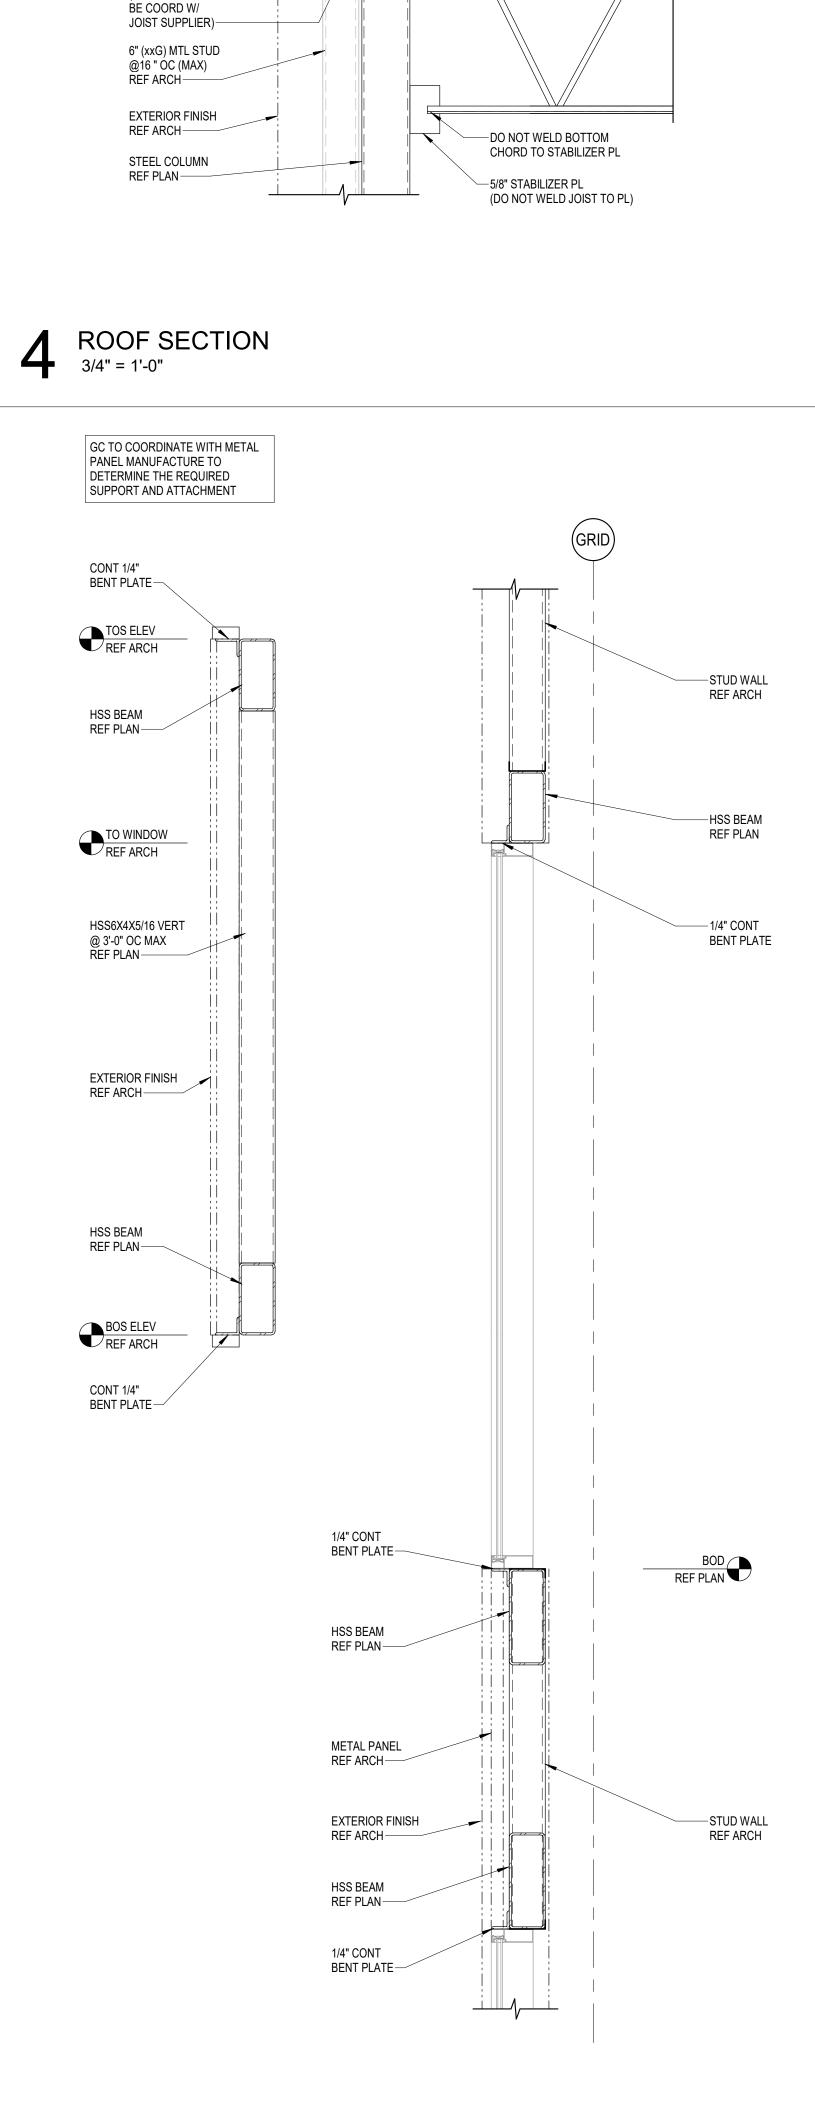

(GRID

—HSS2 1/2X2 1/2X5/16 @ 4'-0" OC MAX W/

1/4" CAP PL

-REFER TO

L6X4X5/16 X

@ 4'-0" OC—

0'-6" LONG

REF ARCH

REF 5/S-508 FOR

TYPICAL EDGE

ANGLE DETAIL-

REF 3/S-508

BOD REF PLAN


JOIST EXTENSION


SLIP CONNECTION REF CFMF MNFR-

REF 15/S-508 -

3/4" CAP PL

(DIMENSIONS TO

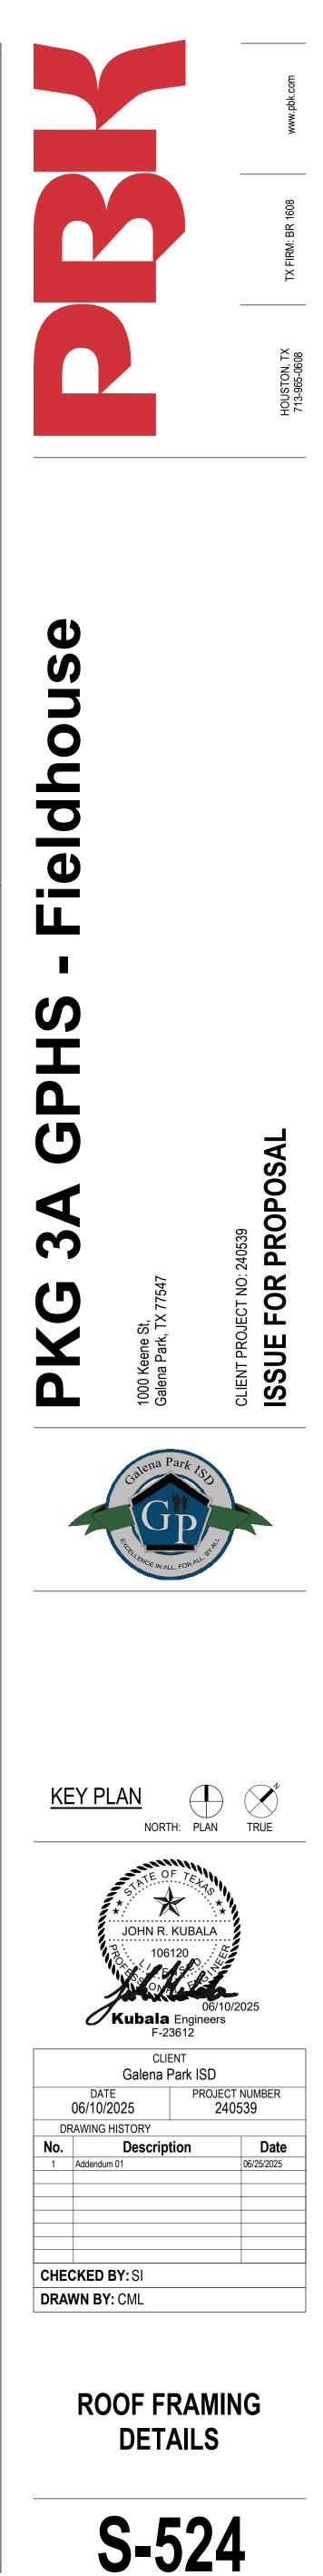

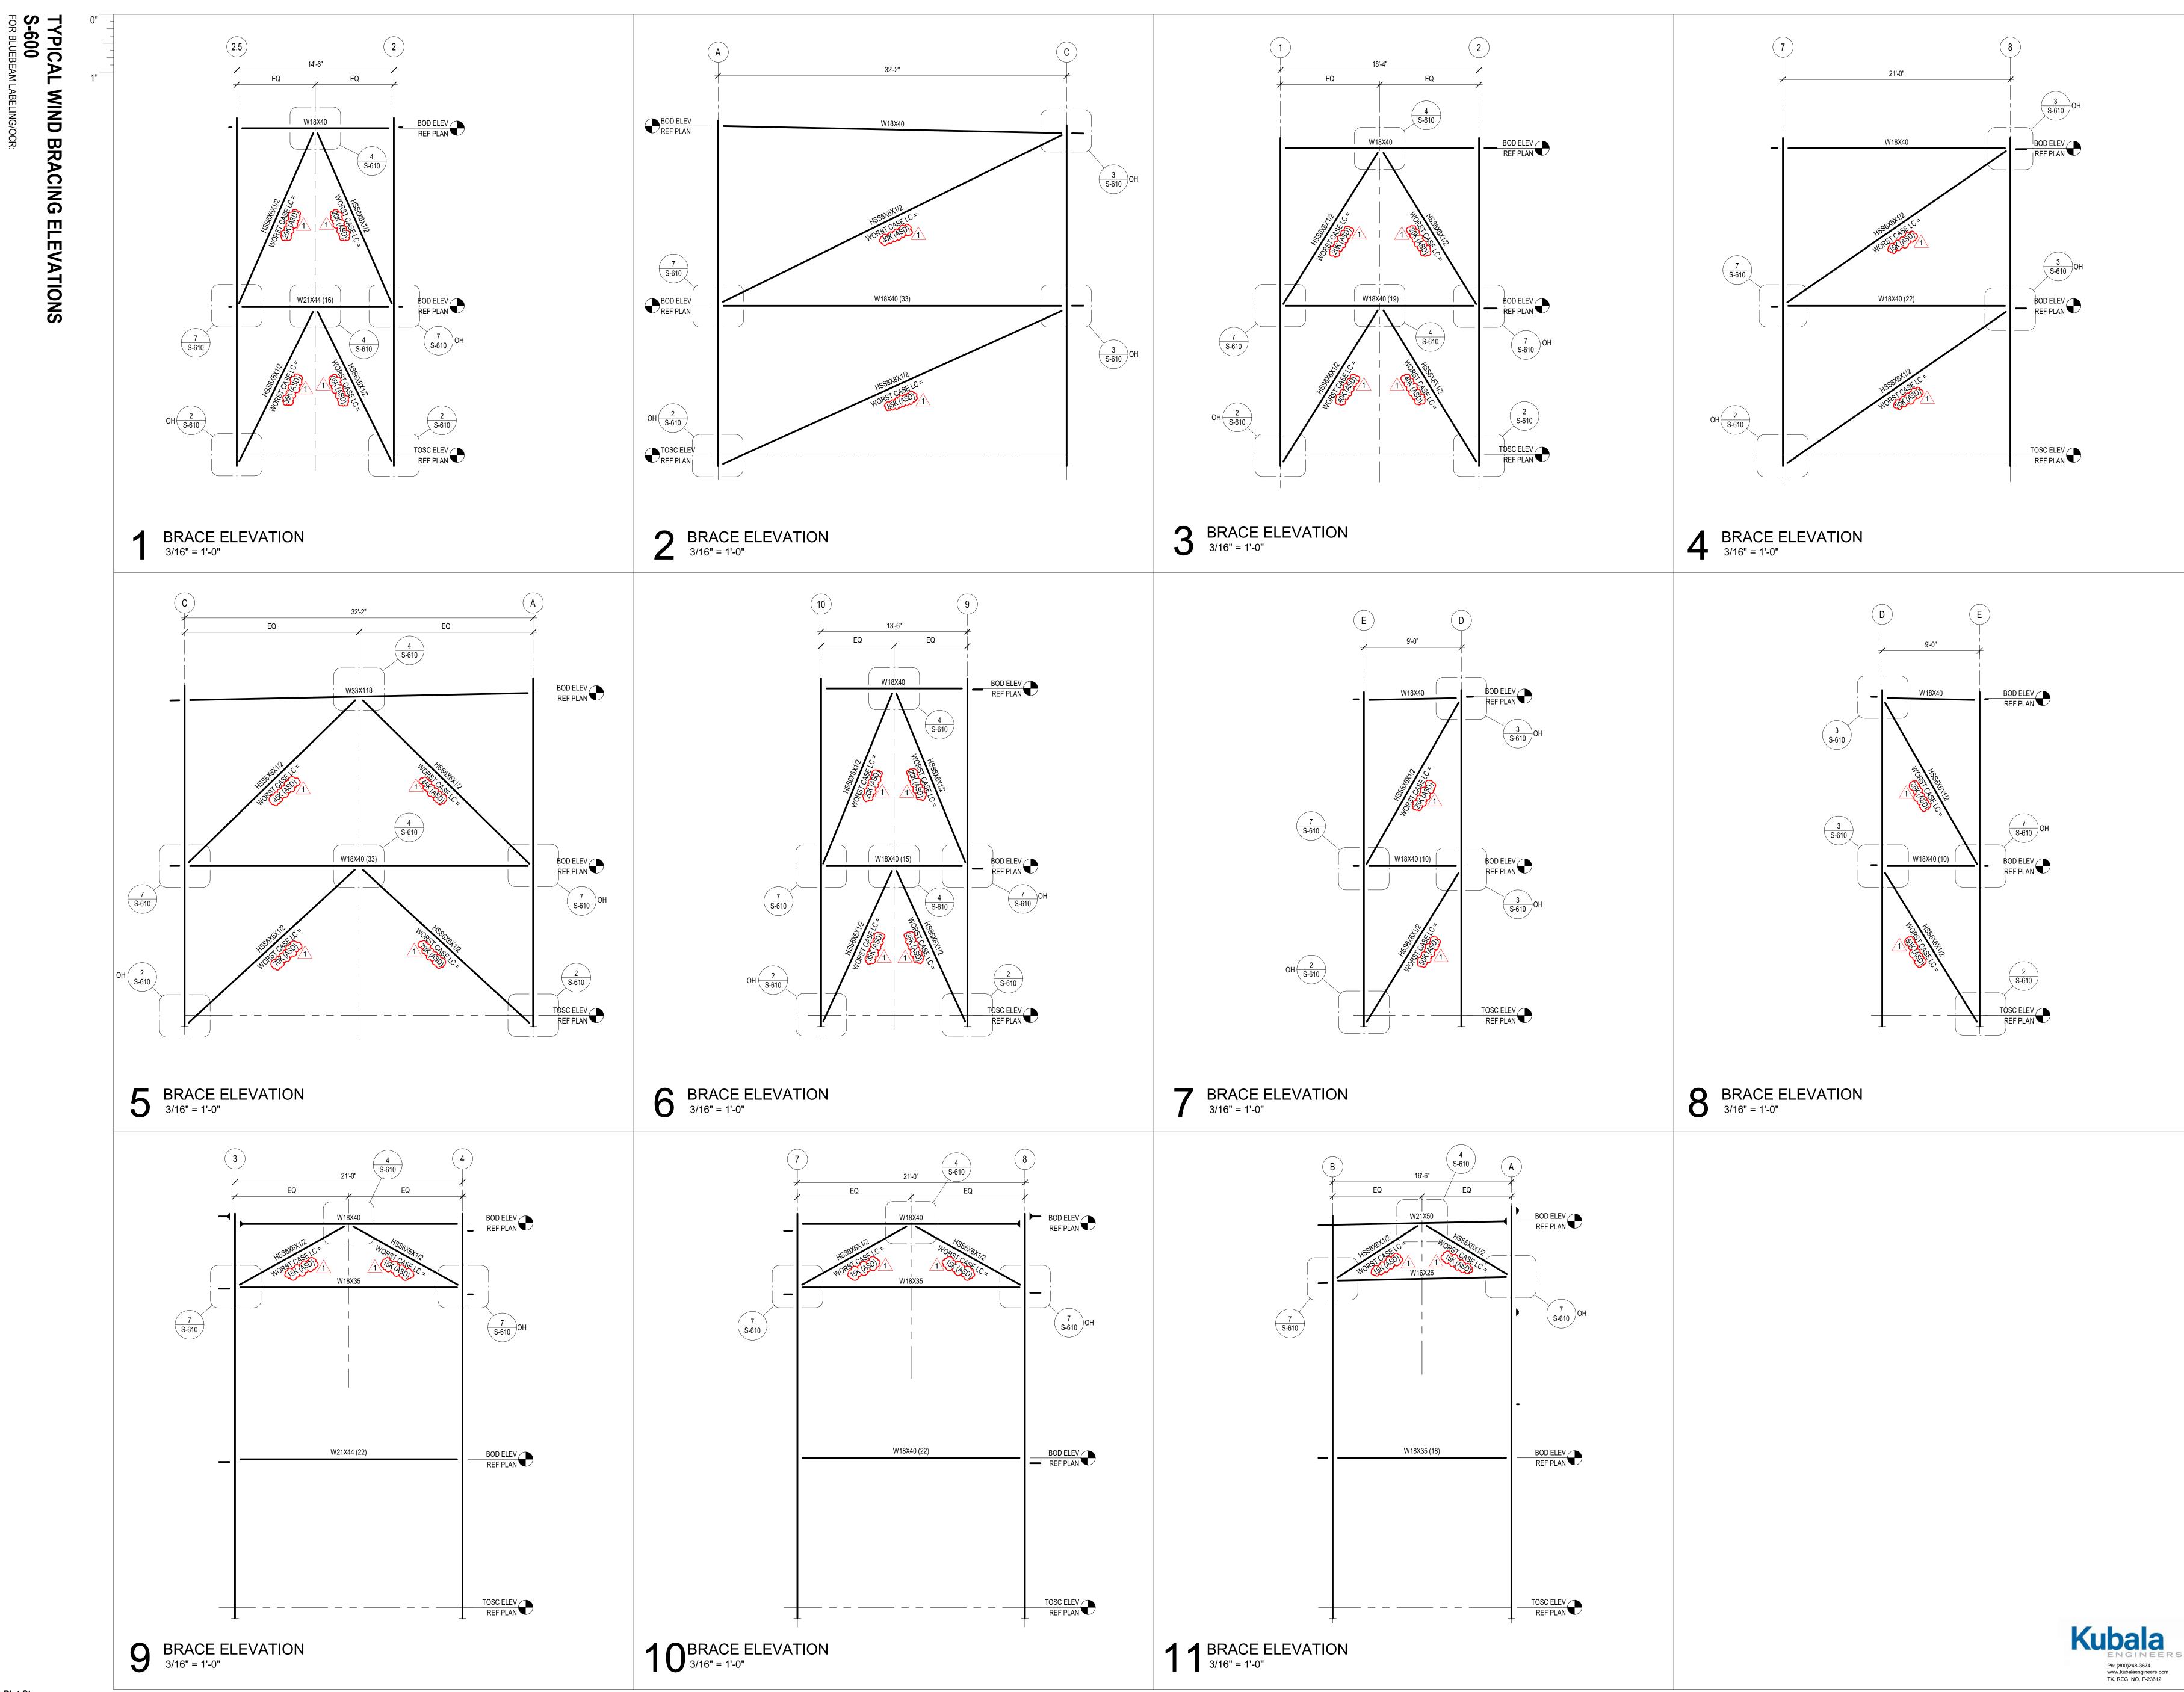


Plot Stamp: 6/24/2025 10:39:29 AM



S-600

- Fieldhouse		
PKG 3A GPHS	1000 Keene St, Galena Park, TX 77547	CLIENT PROJECT NO: 240539 ISSUE FOR PROPOSAL
KEY PL		
	Kubala Engin F-23612 CLIENT Galena Park IS	06/10/2025 neers
DAT 06/10/2 DRAWING I No. 1 Addendun	2025 HISTORY Description	ROJECT NUMBER 240539 Date 06/25/2025
	-	IG




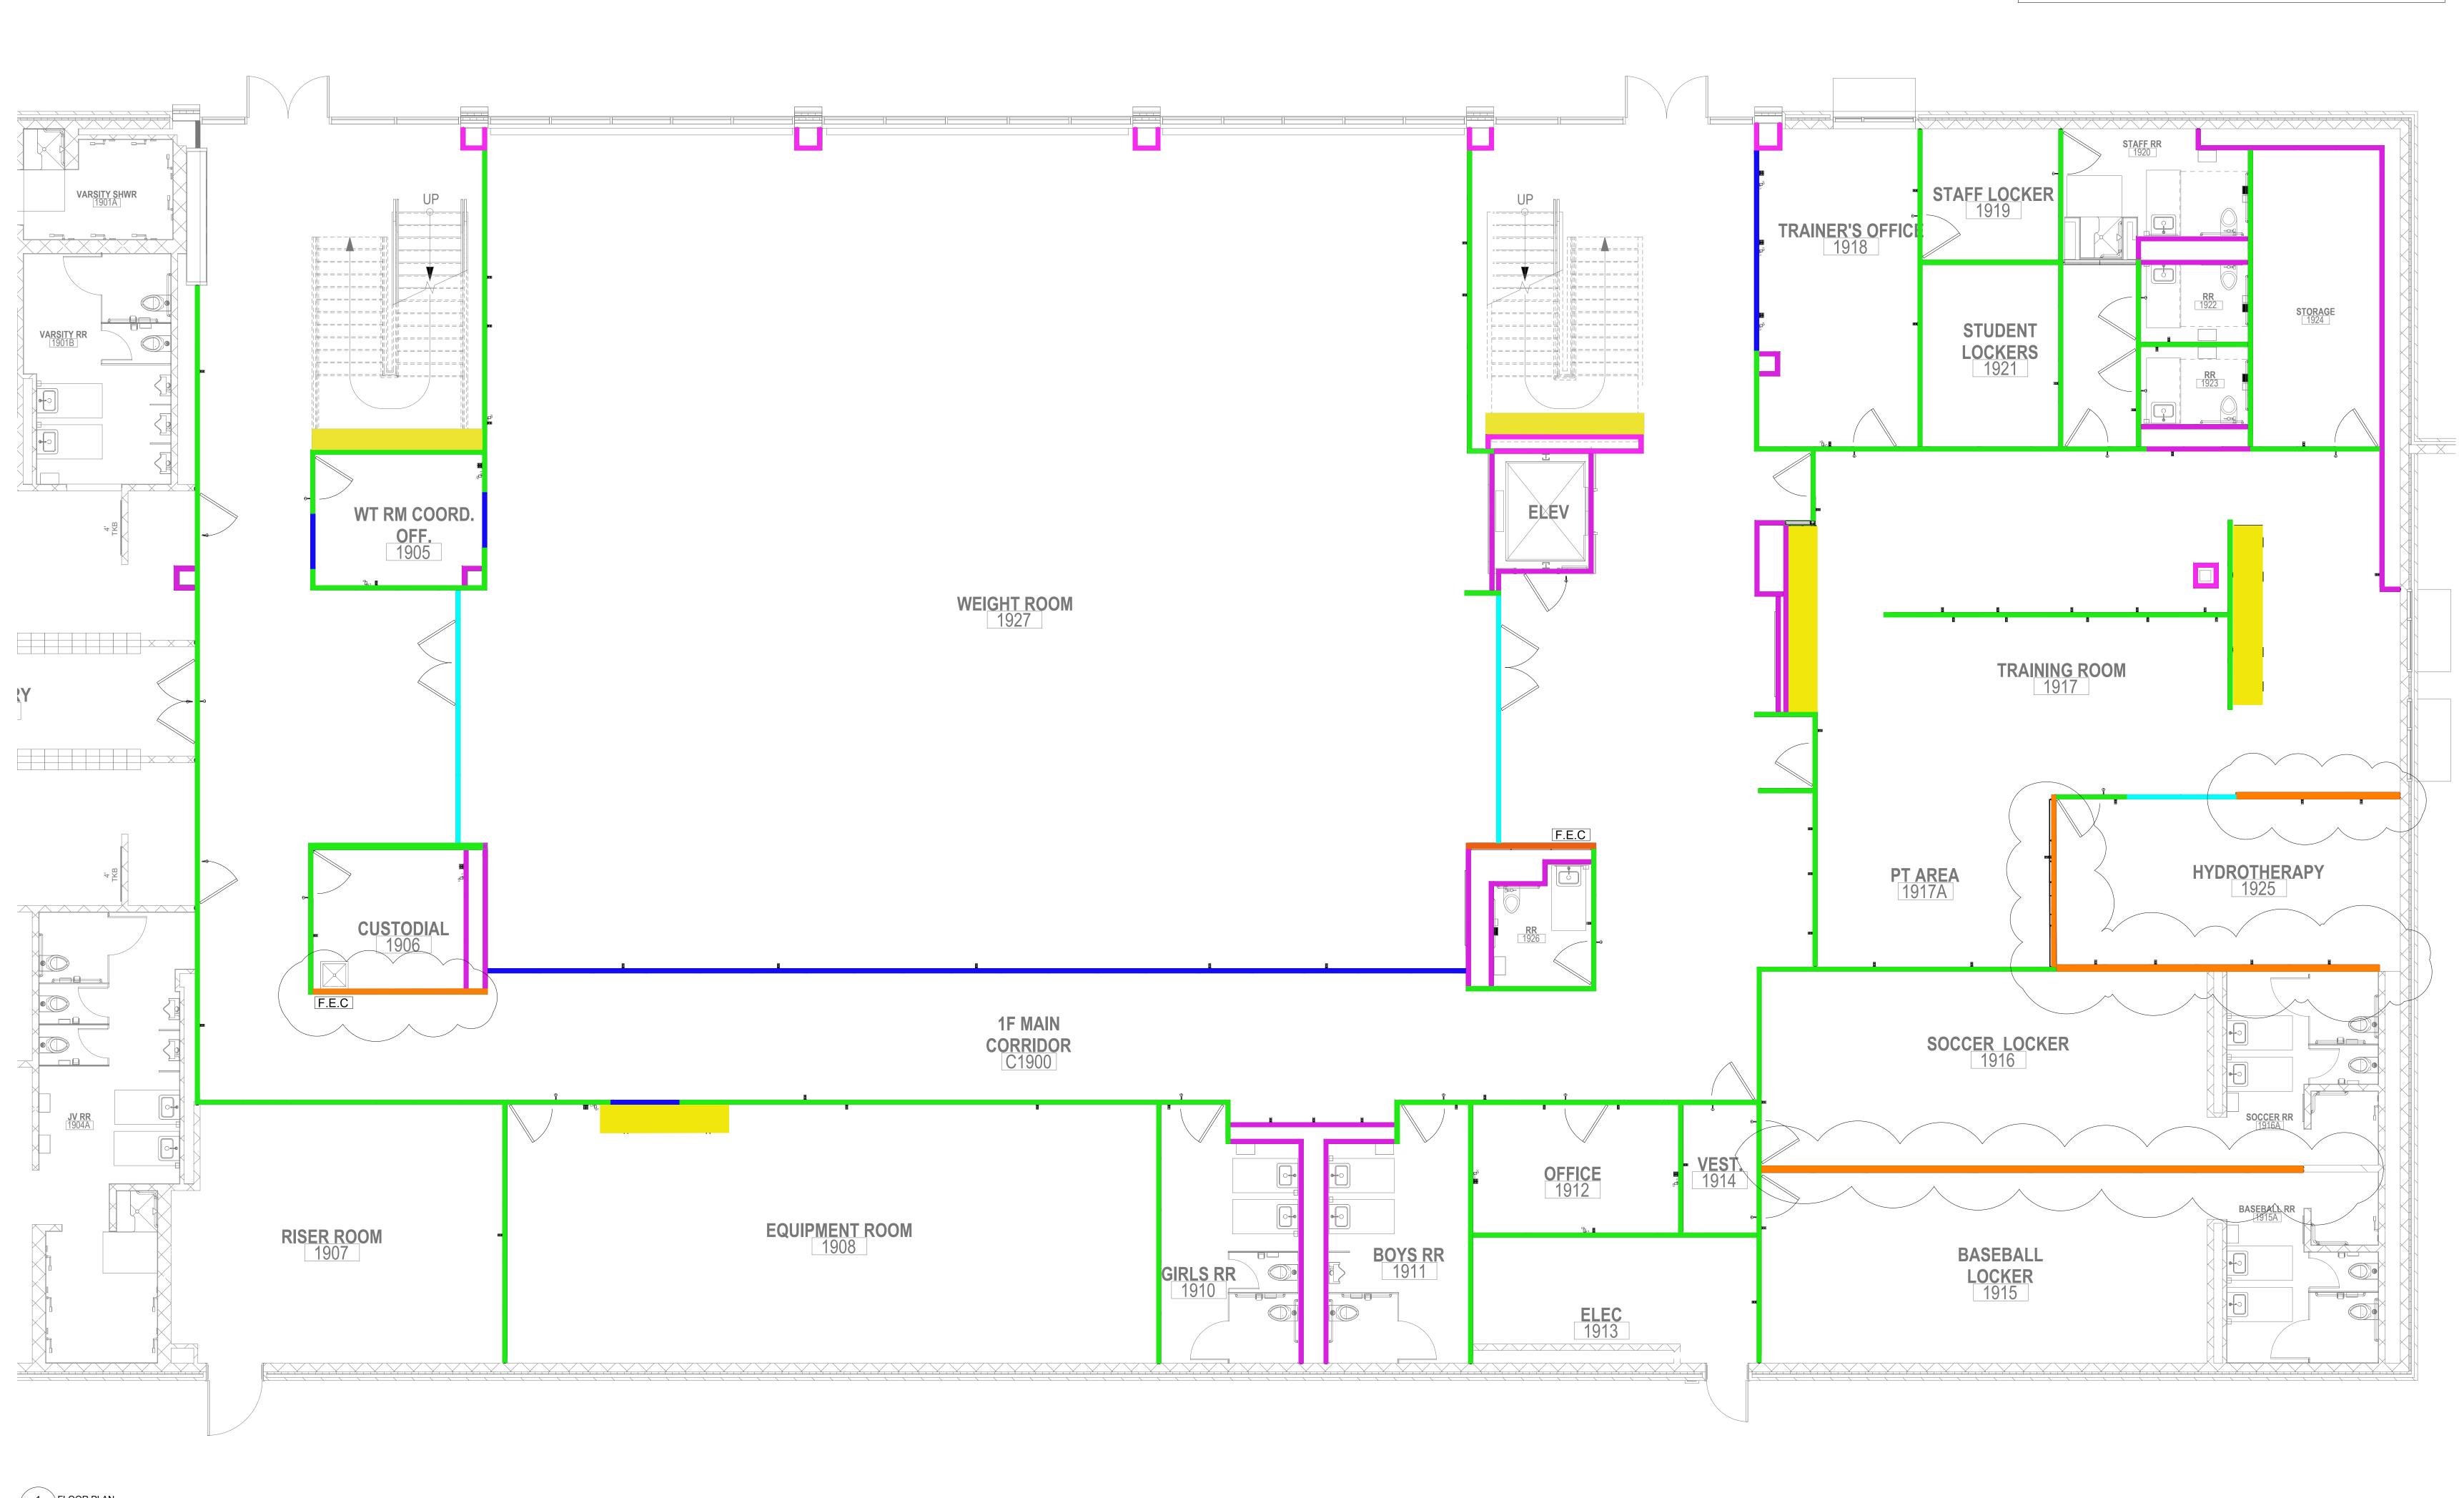


1 FLOOR PLAN DW-100.7

C:\Users\KARRED~1\AppData\Loca|\Temp\ICEcad-11f42af6-befc-4e61-8c45-9cd223870365\ICEcad.dwg 2025-6-25 8:00:56 AM



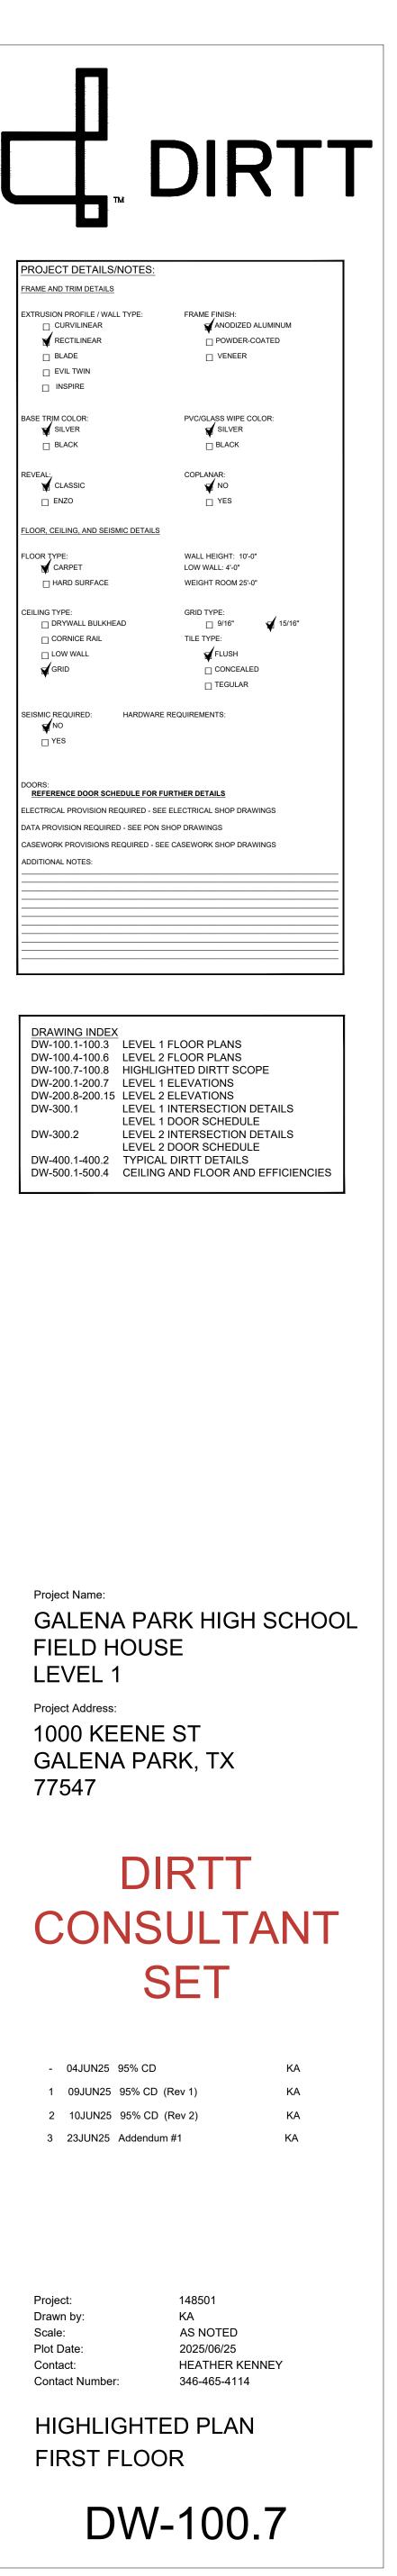

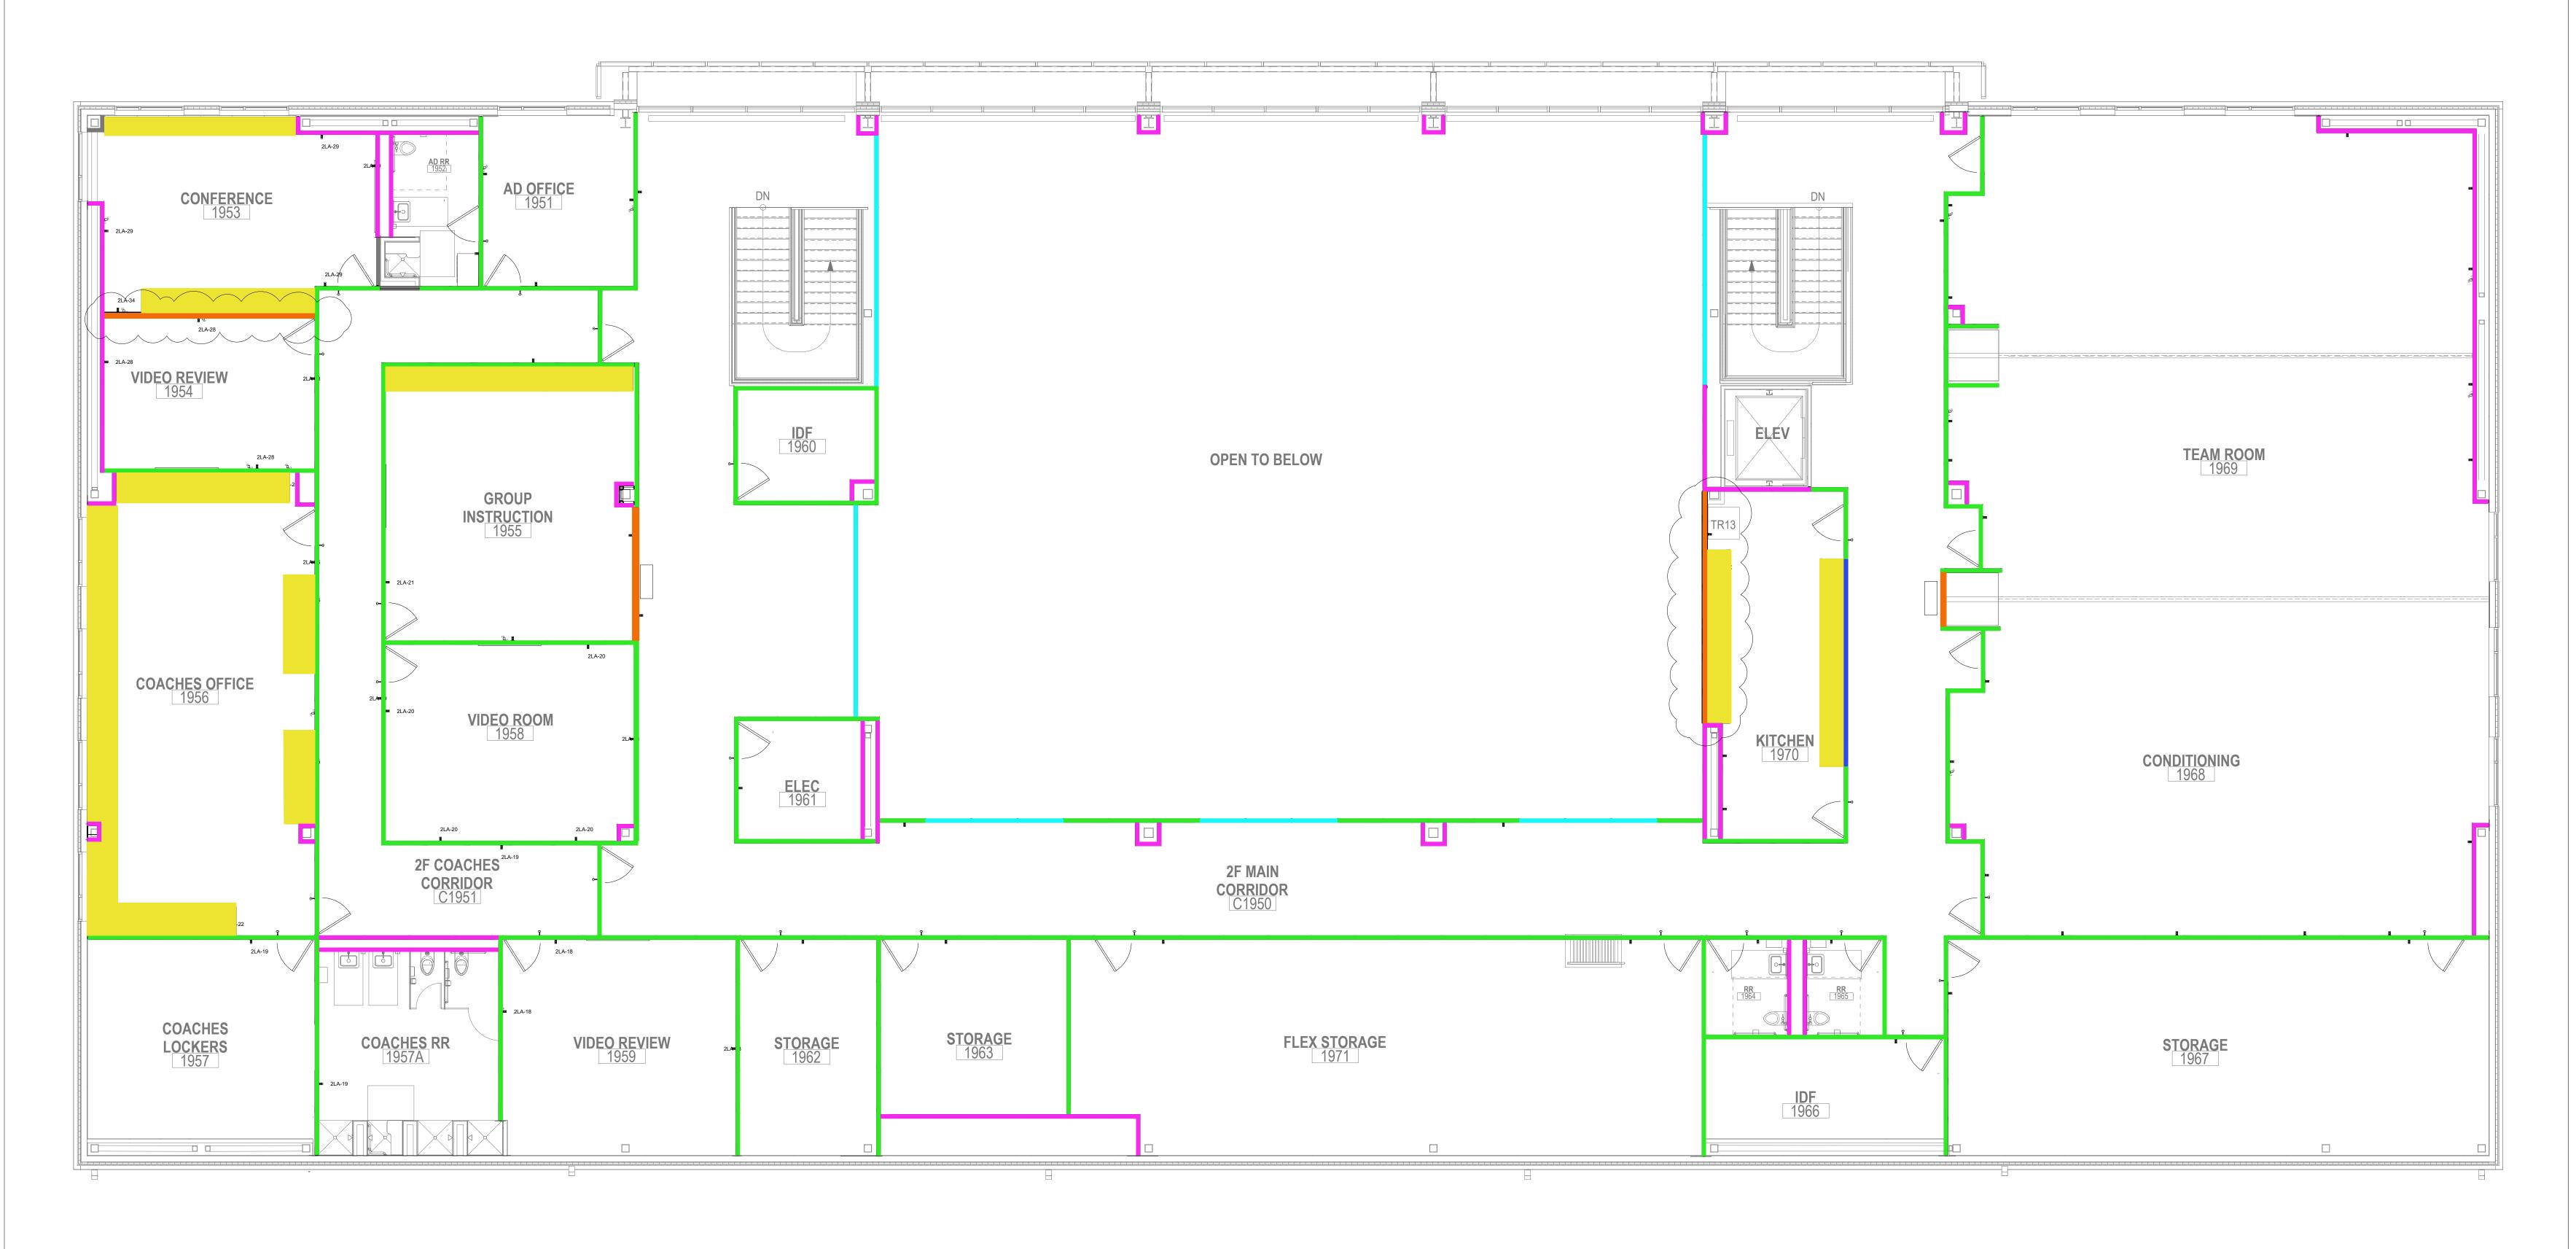



1 FLOOR PLAN DW-100.8

C:\Users\KARRED~1\AppData\Local\Temp\ICEcad-11f42af6-befc-4e61-8c45-9cd223870365\ICEcad.dwg 2025-6-24 12:00:17 PM





NOT TO SCALE

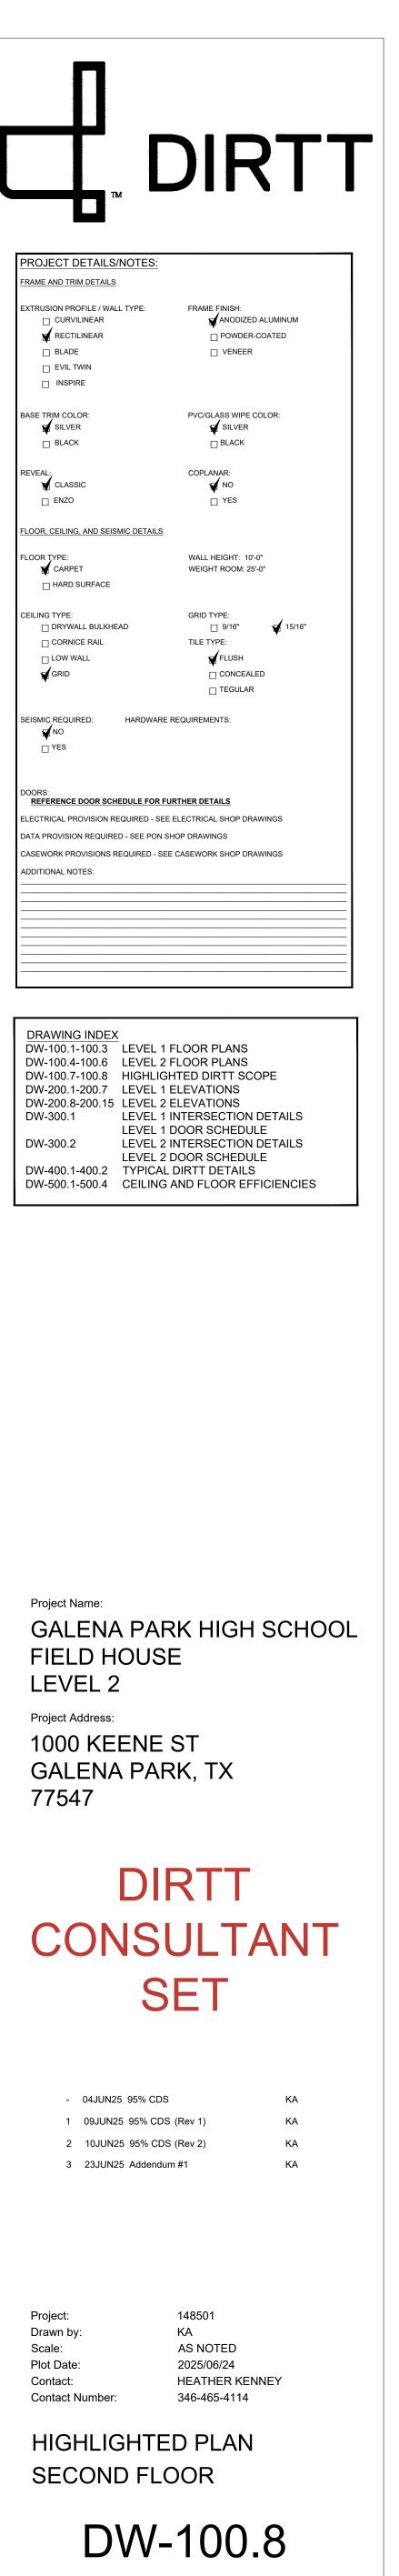

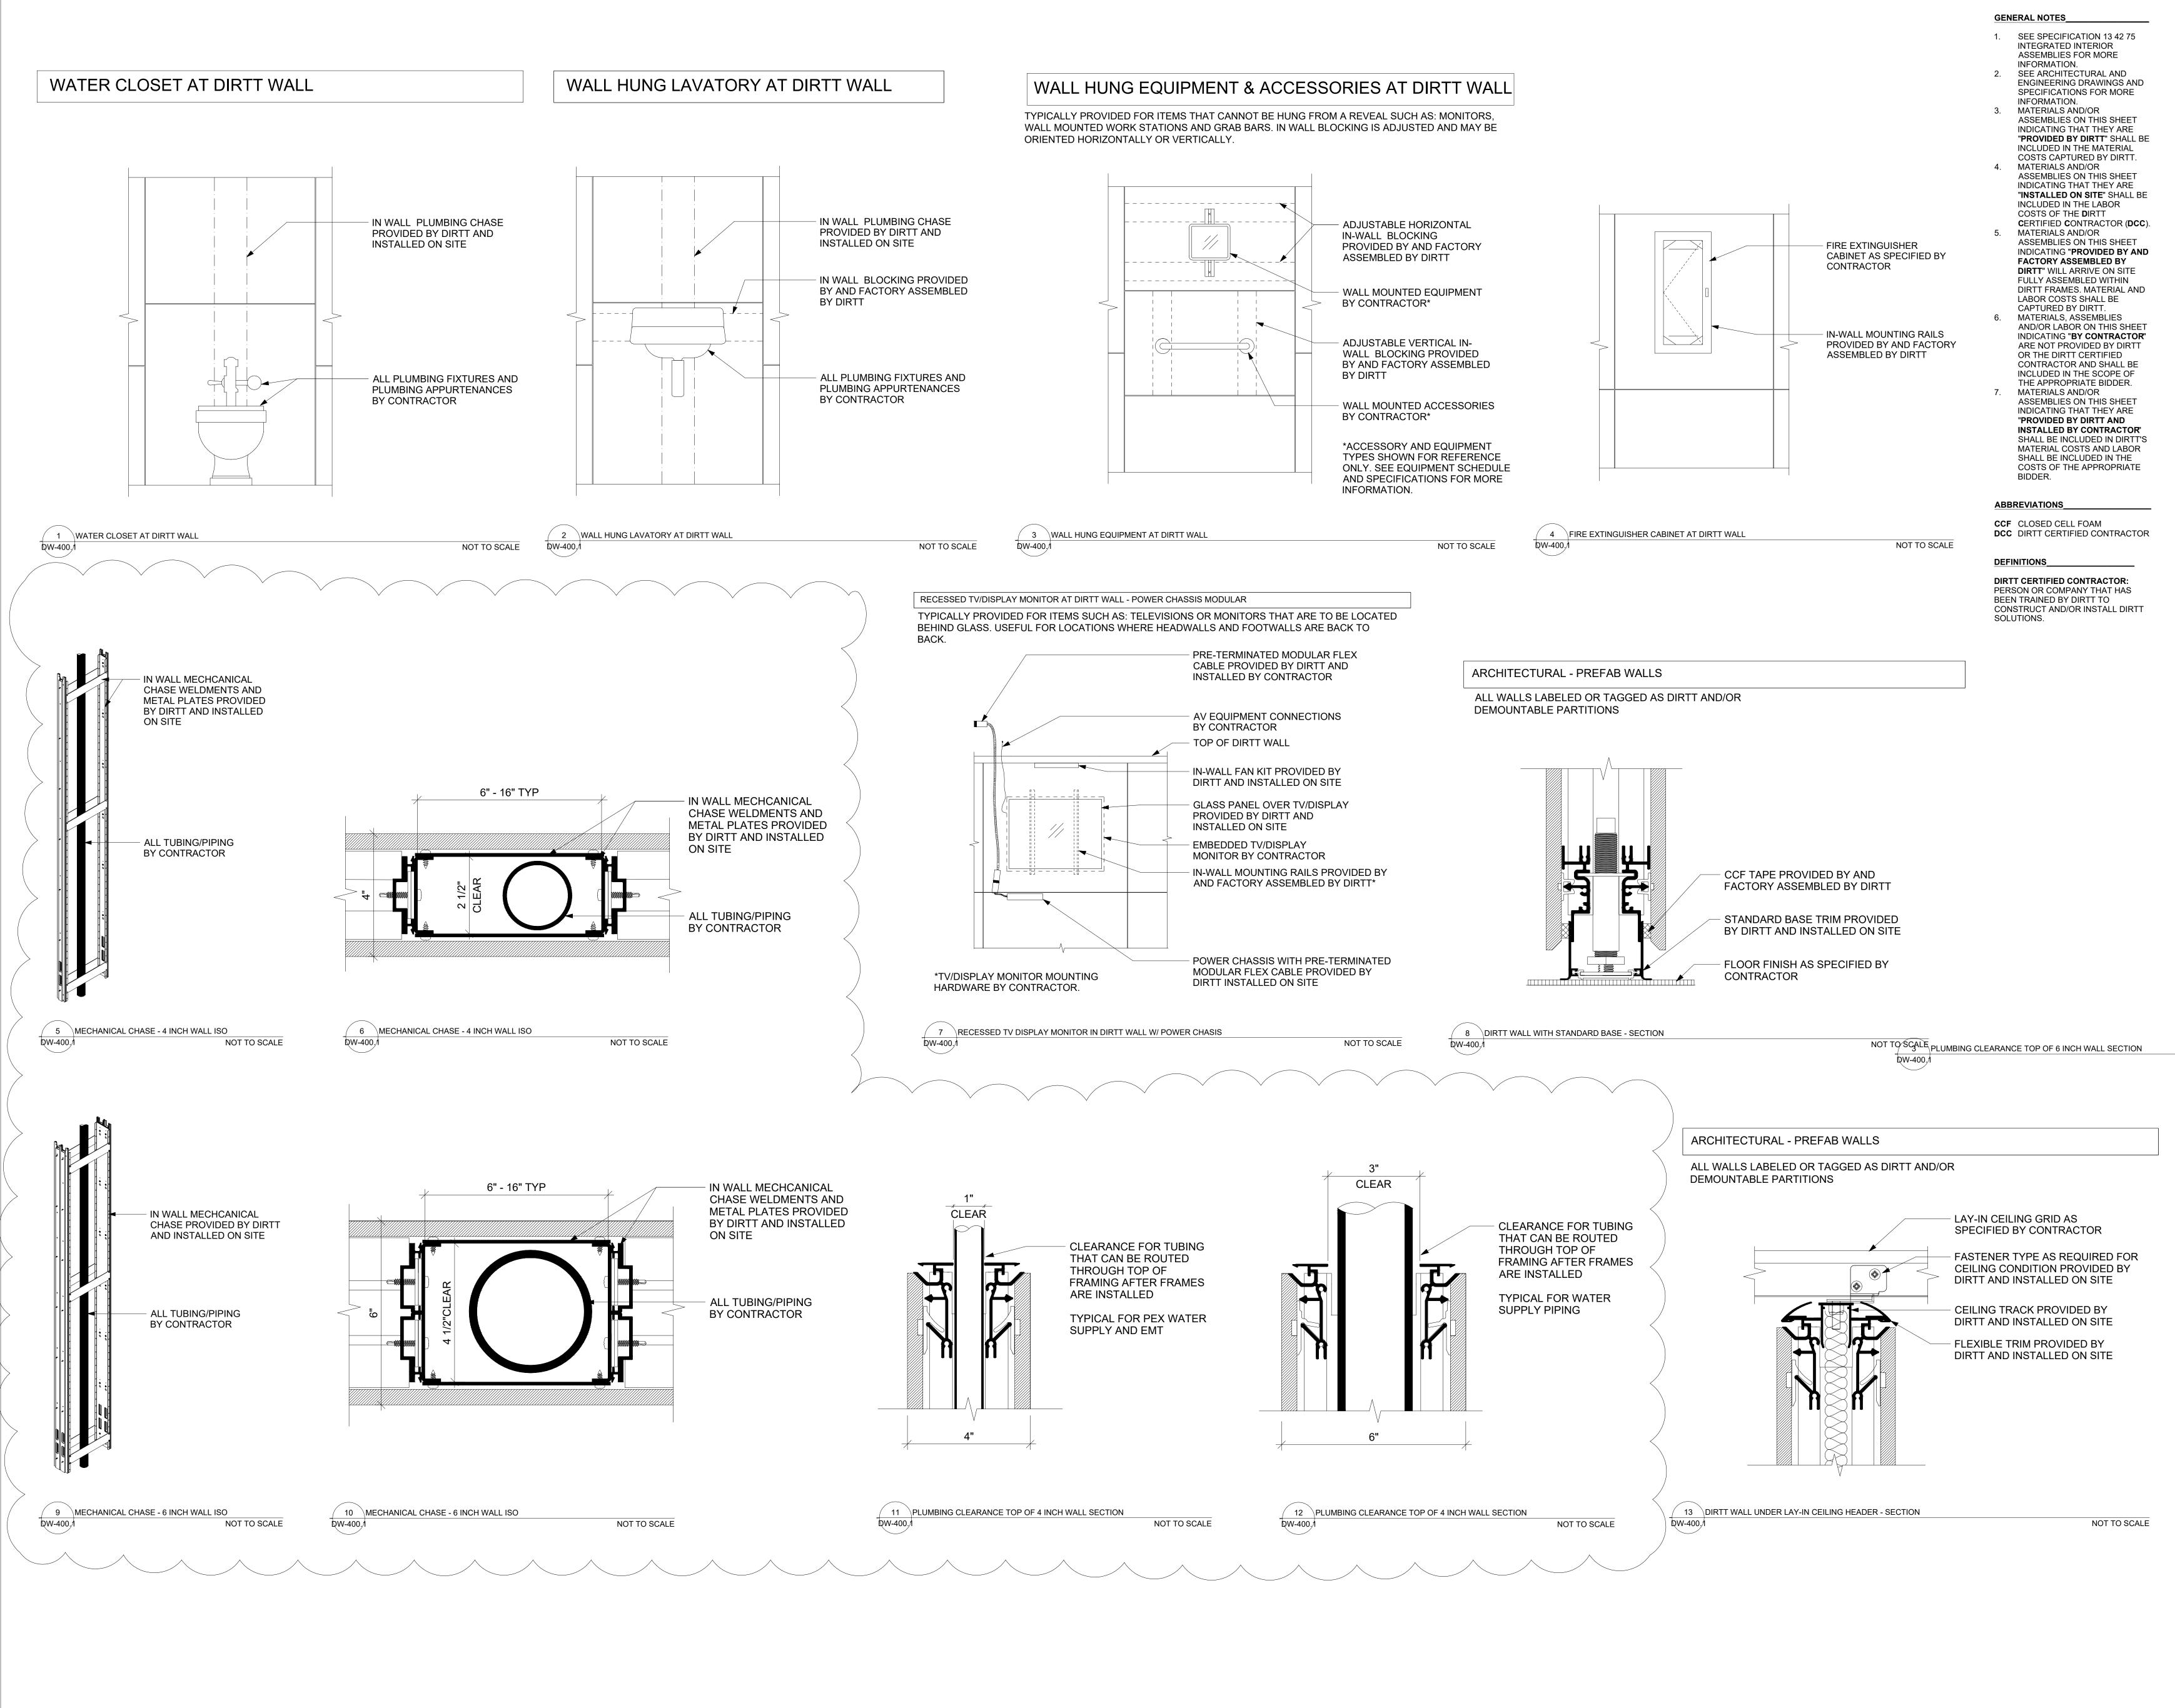

C:\Users\KARRED~1\AppData\Local\Temp\ICEcad-11f42af6-befc-4e61-8c45-9cd223870365\ICEcad.dwg 2025-6-24 11:48:08 AM

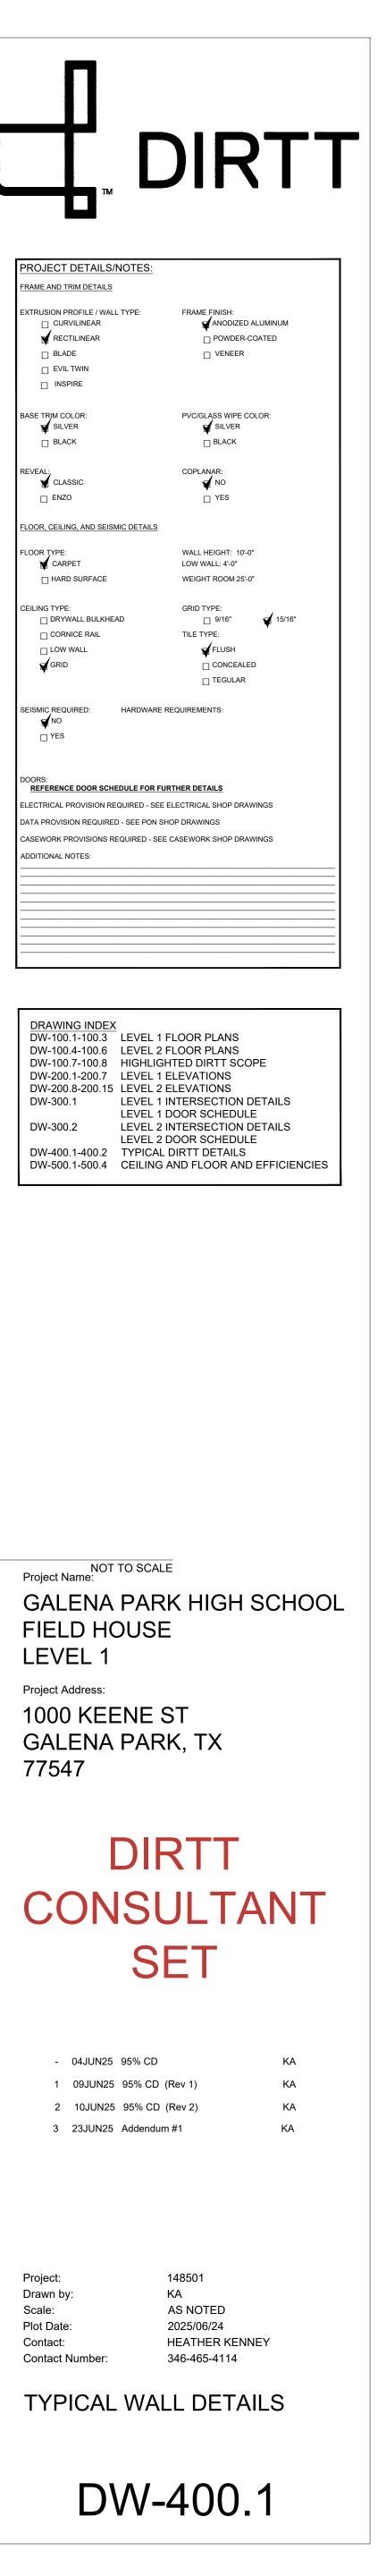

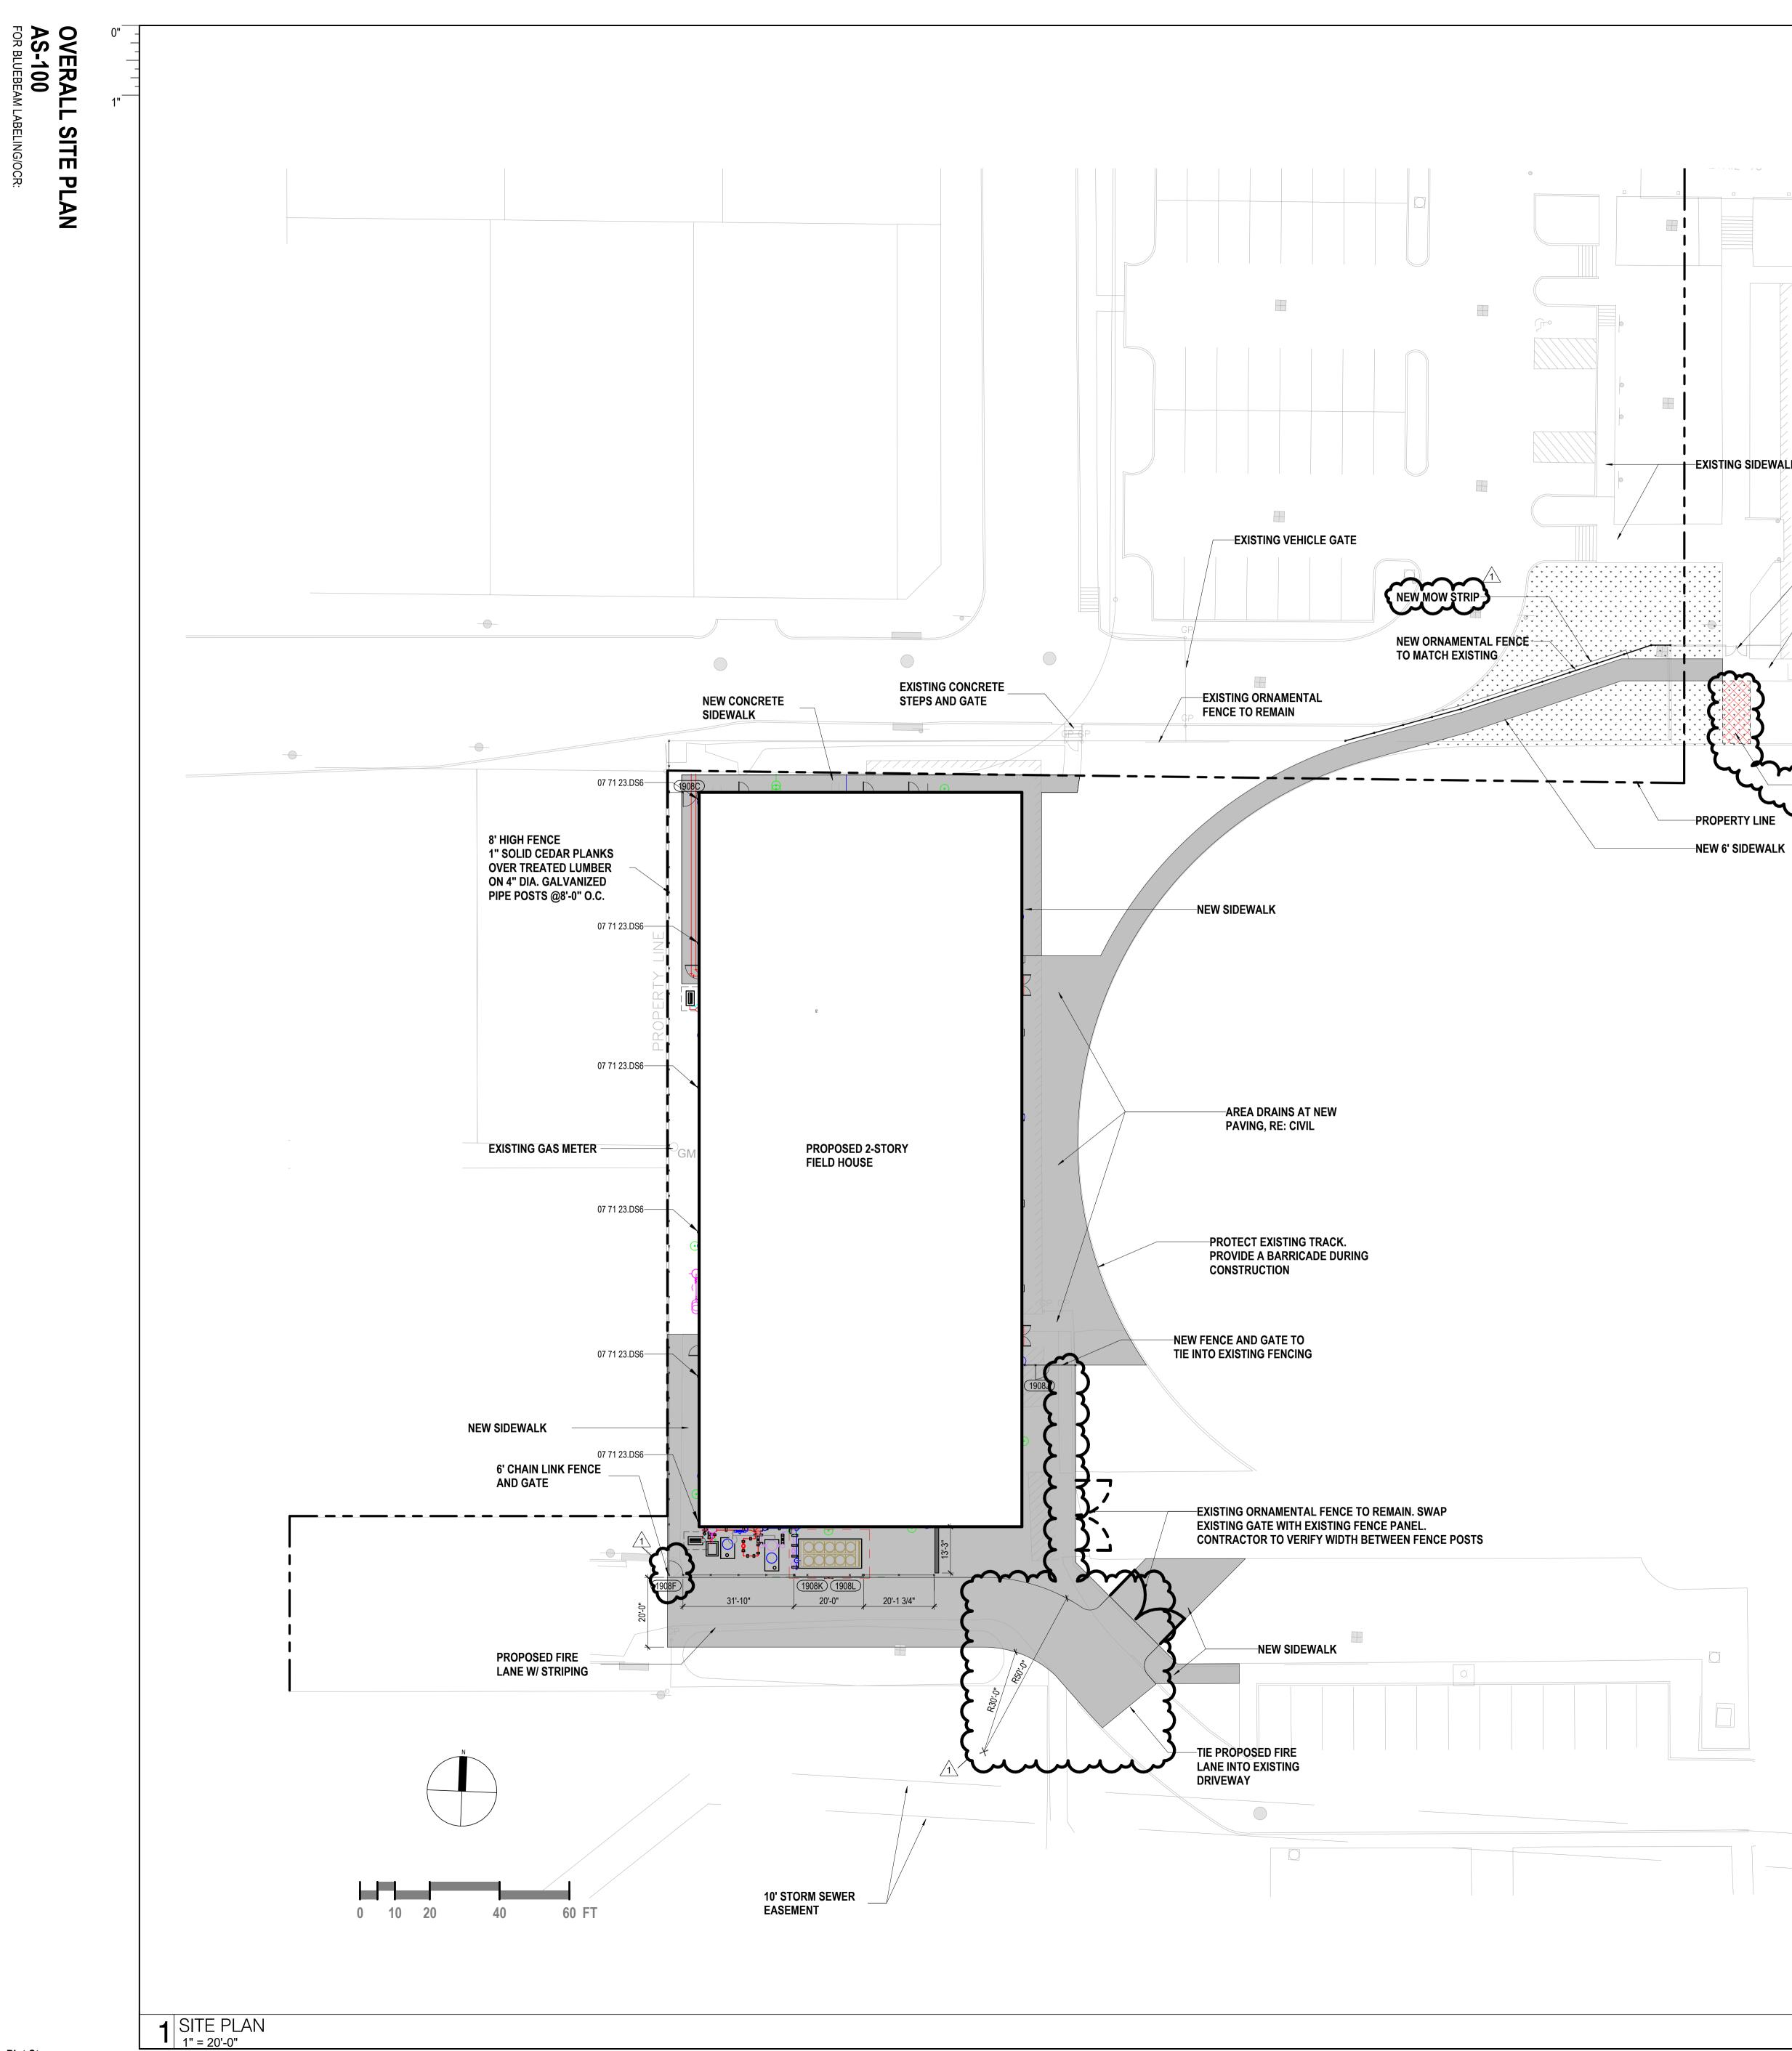

Plot Stamp: 6/24/2025 3:40:22 PM

- 0			
SIDEWALK	ATE	EXISTING BUILDING TO REMAI	N
EXISTING 6'S		O	
<u>}</u>	0	 	
SQD TO MATC	DEWALK AND PATC		

GENERAL SITE PLAN NOTES

1. REFER TO CIVIL DOCUMENTS.

NUMBER

- 2. COORDINATE ALL SPOT ELEVATIONS AND DIMENSIONS WITH CIVIL, LANDSCAPE, AND OR STRUCTURAL DOCUMENTS.
- PROVIDE POSITIVE DRAINAGE AWAY FROM ALL BUILDINGS OF 1% MINIMUM, 2% MAXIMUM AT ALL EXTERIOR PAVED PEDESTRIAN AREAS, INCLUDING BUT NOT LIMITED TO SIDEWALKS, PATIOS, STAIRS,
- PAVING, U.N.O. PROVING, U.N.O.
 PROVIDE AND INSTALL POSITIVE DRAINAGE AWAY FROM ALL BUILDINGS OF 5% FOR A HORIZONTAL DISTANCE OF 10 FEET AT ALL EXTERIOR NON-PAVED AREAS U.N.O.
 REFER TO CIVIL DOCUMENTS FOR CONCRETE SIDEWALK EXPANSION JOINTS AND CONCRETE
- SIDEWALK CONTROL JOINTS. 6. VERIFY AND CONFIRM ALL JOINT LAYOUTS AT ALL CONCRETE SIDEWALKS WITH ARCHITECT PRIOR TO
- POURING OF CONCRETE.
- PROVIDE AND INSTALL CONCRETE SIDEWALK EXPANSION JOINTS AT AREAS NOT SPECIFICALLY INDICATED AT 50 FEET ON-CENTER MAX. U.N.O.
 PROVIDE AND INSTALL CONCRETE SIDEWALK CONTROL JOINTS AT AREAS NOT SPECIFICALLY
- INDICATED AT DISTANCES EQUIVALENT TO SIDEWALK WIDTH, BUT NOT TO EXCEED 10 FEET ON-CENTER MAX.
- 9. VERIFY ALL SITE SIGNAGE LOCATIONS WITH ARCHITECT PRIOR TO INSTALLATION OF SITE SIGNAGE.

KEYNOTE LEGEND DESCRIPTION

6"X 6" PRE-FINISHED METAL DOWNSPOUT W/ HEAVY GAUGE BOOT, RE: CIVIL 7 71 23.DS6

GATE SCHEDULE							
GATE SUREDULE							
	SI	ZE		HARDWARE			
MARK	W	H	MTL	SET	REMARKS		
			1				
1908C	4'-0"	6'-0"	Metal - ChainLink	PAD LOCK			
1908F	4'-0"	6'-0"	Metal - ChainLink	PAD LOCK			
1908J	4'-0"	6'-0"	Metal - ChainLink	PAD LOCK	Knox Box		
1908K	10'-0"	6'-0"	Metal - ChainLink	PAD LOCK			
1908L	10'-0"	6'-0"	Metal - ChainLink	PAD LOCK			



OVERALL SITE PLAN

	6/10/2	PLOVEC		
	CLIE Galena F			
J	DATE une 10, 2025		PROJECT NUMBER 240539	
DF	RAWING HISTORY			
No.	Descrip	tion	Date	
1	ADDENDUM 1		2025-06-24	
CHE	CKED BY:TC			
DRA	WN BY: JA			








3


Ζ




ź

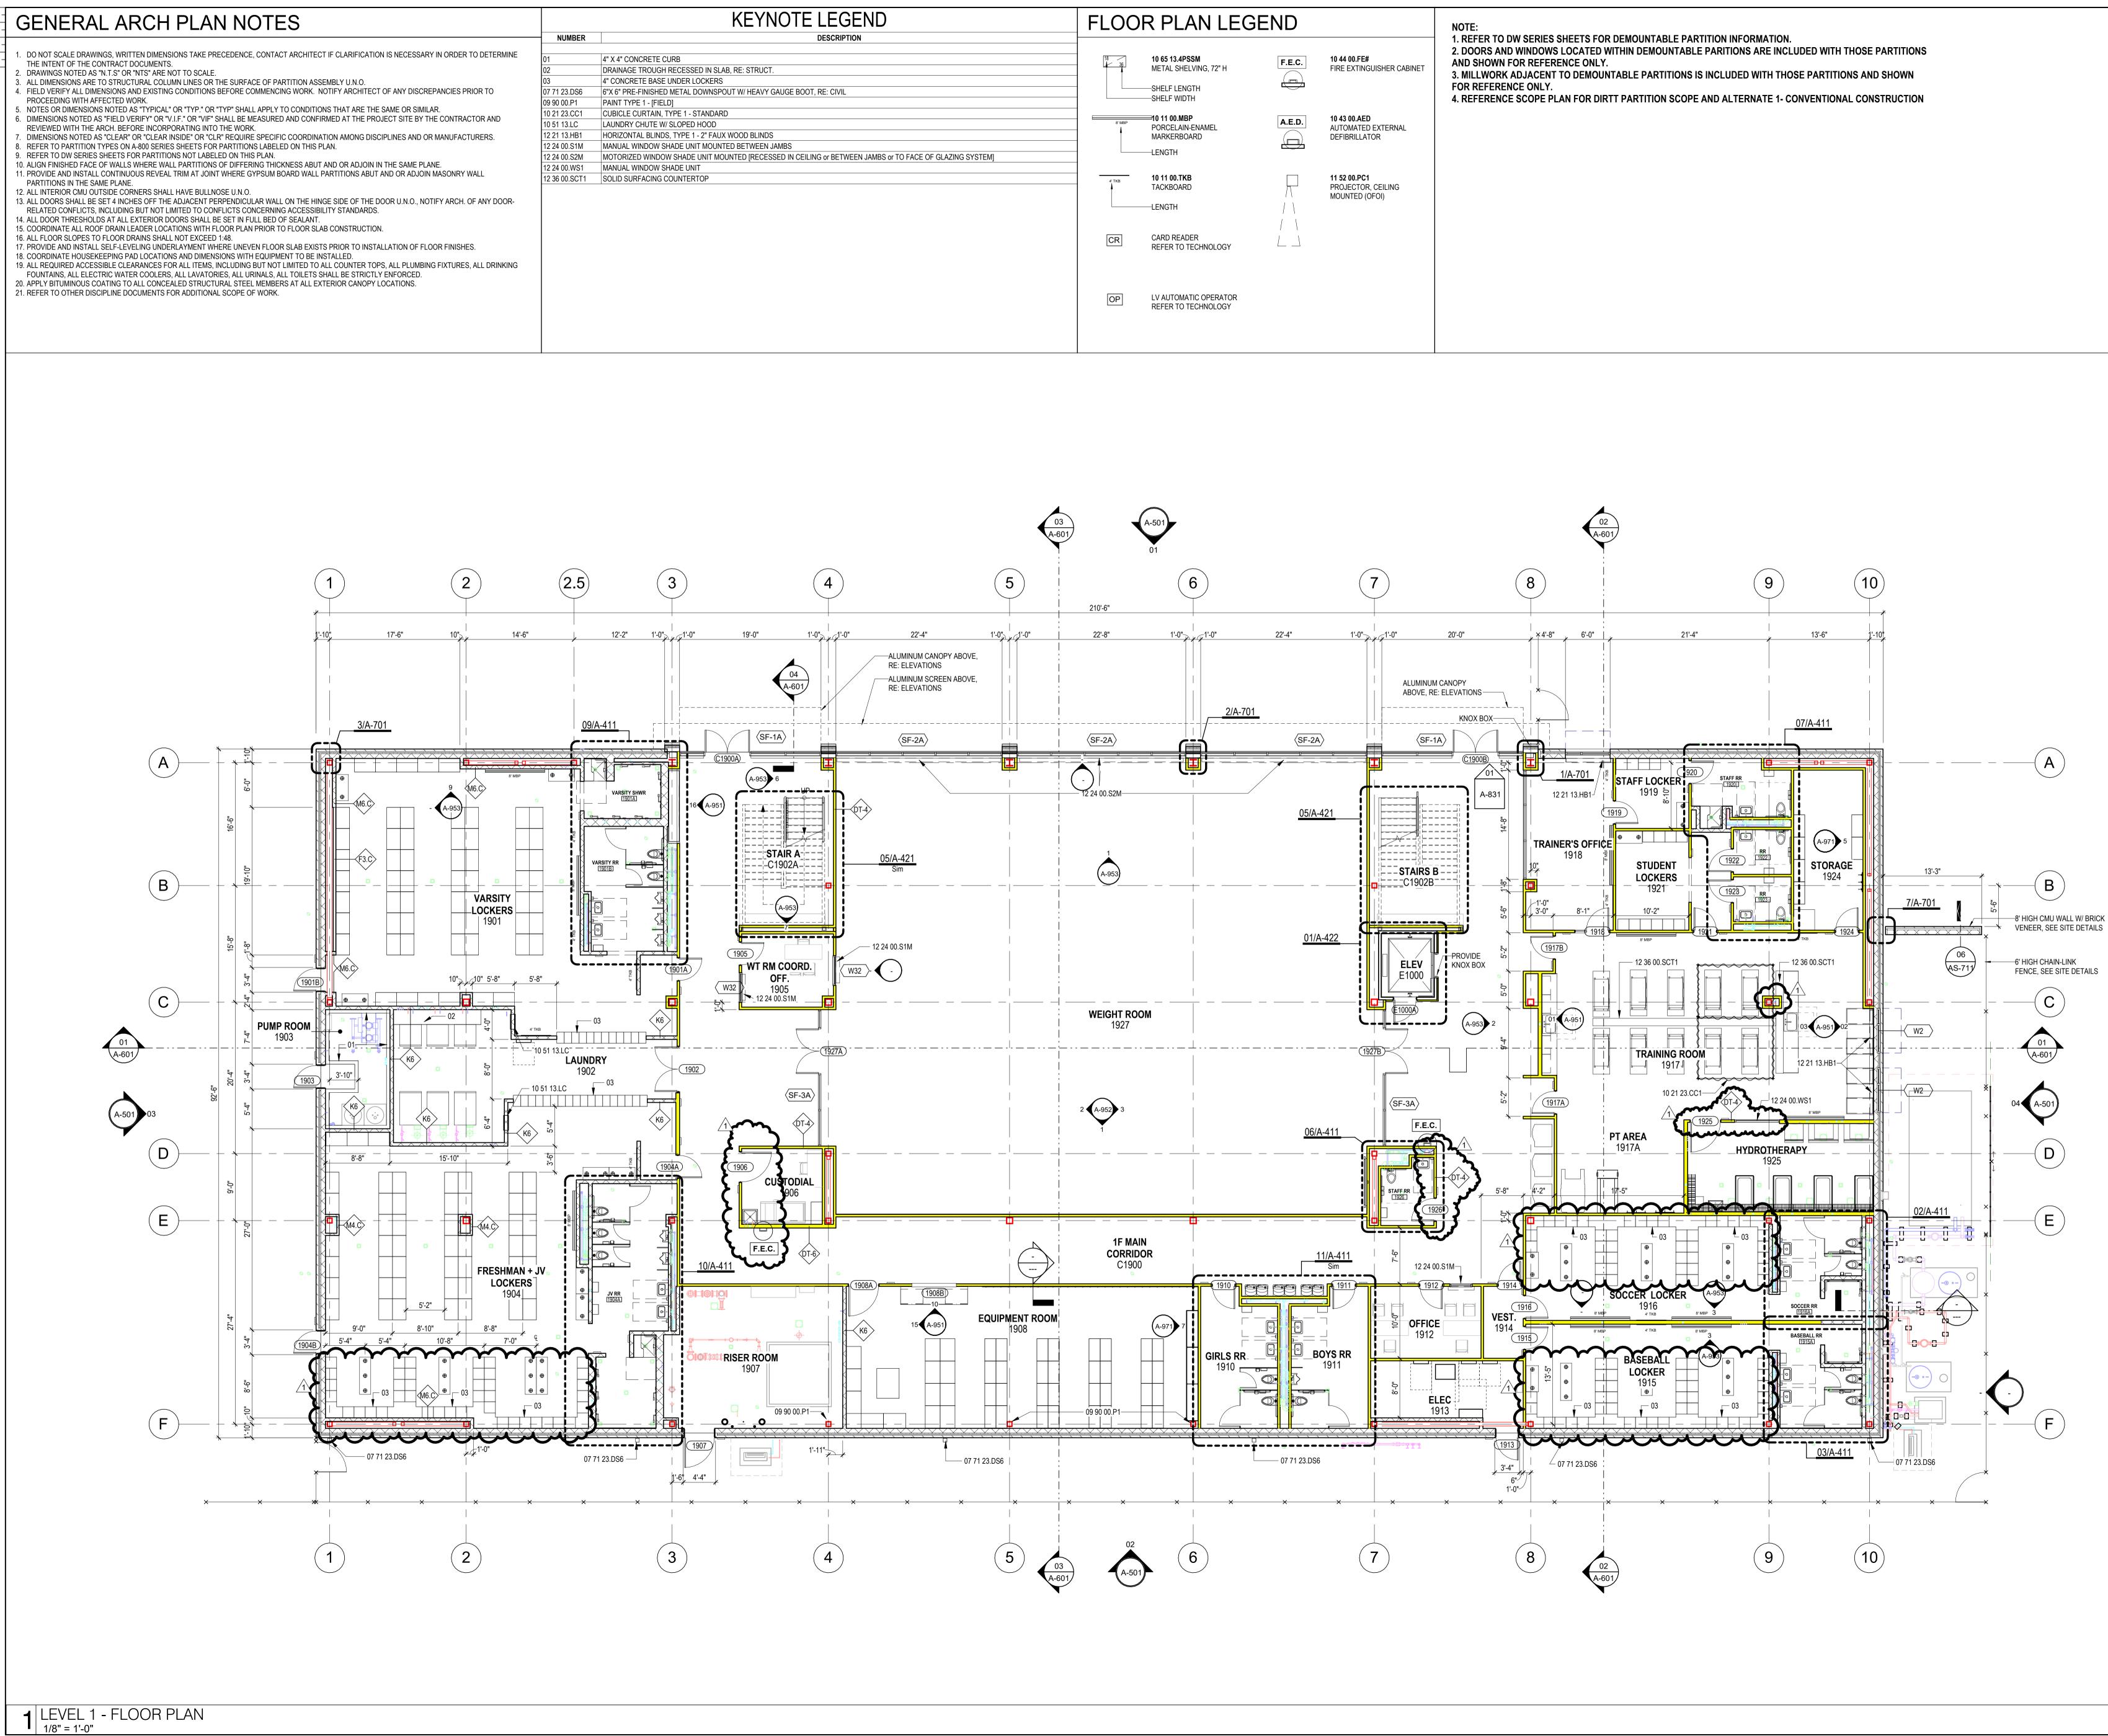

E# NGUISHER CABINET	NOTE: 1. REFER TO DW SERIES SHEETS FOR DEMOUNTABLE PARTITION INFORMATION. 2. DOORS AND WINDOWS LOCATED WITHIN DEMOUNTABLE PARITIONS ARE INCLUDED WITH THOSE PARTITIONS AND SHOWN FOR REFERENCE ONLY. 3. MILLWORK ADJACENT TO DEMOUNTABLE PARTITIONS IS INCLUDED WITH THOSE PARTITIONS AND SHOWN FOR REFERENCE ONLY. 4. REFERENCE SCOPE PLAN FOR DIRTT PARTITION SCOPE AND ALTERNATE 1- CONVENTIONAL CONSTRUCTION	
E D ED EXTERNAL ATOR		
C1 DR, CEILING (OFOI)		

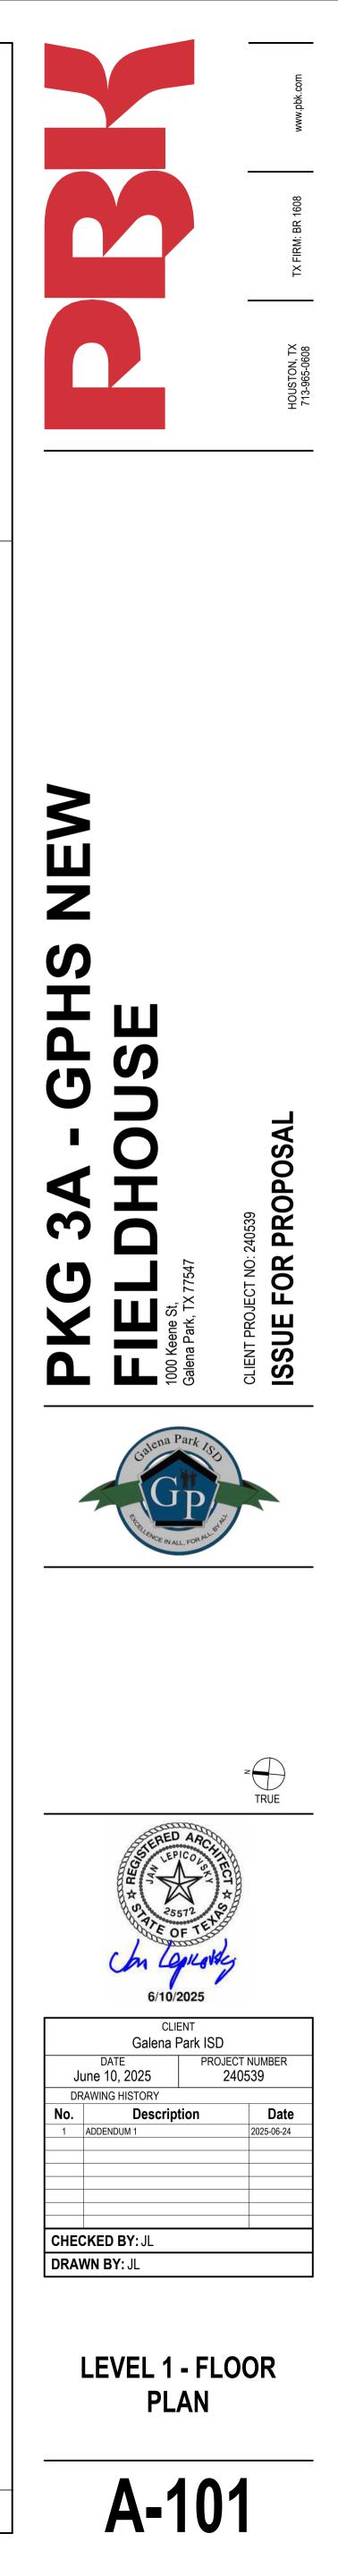

ź

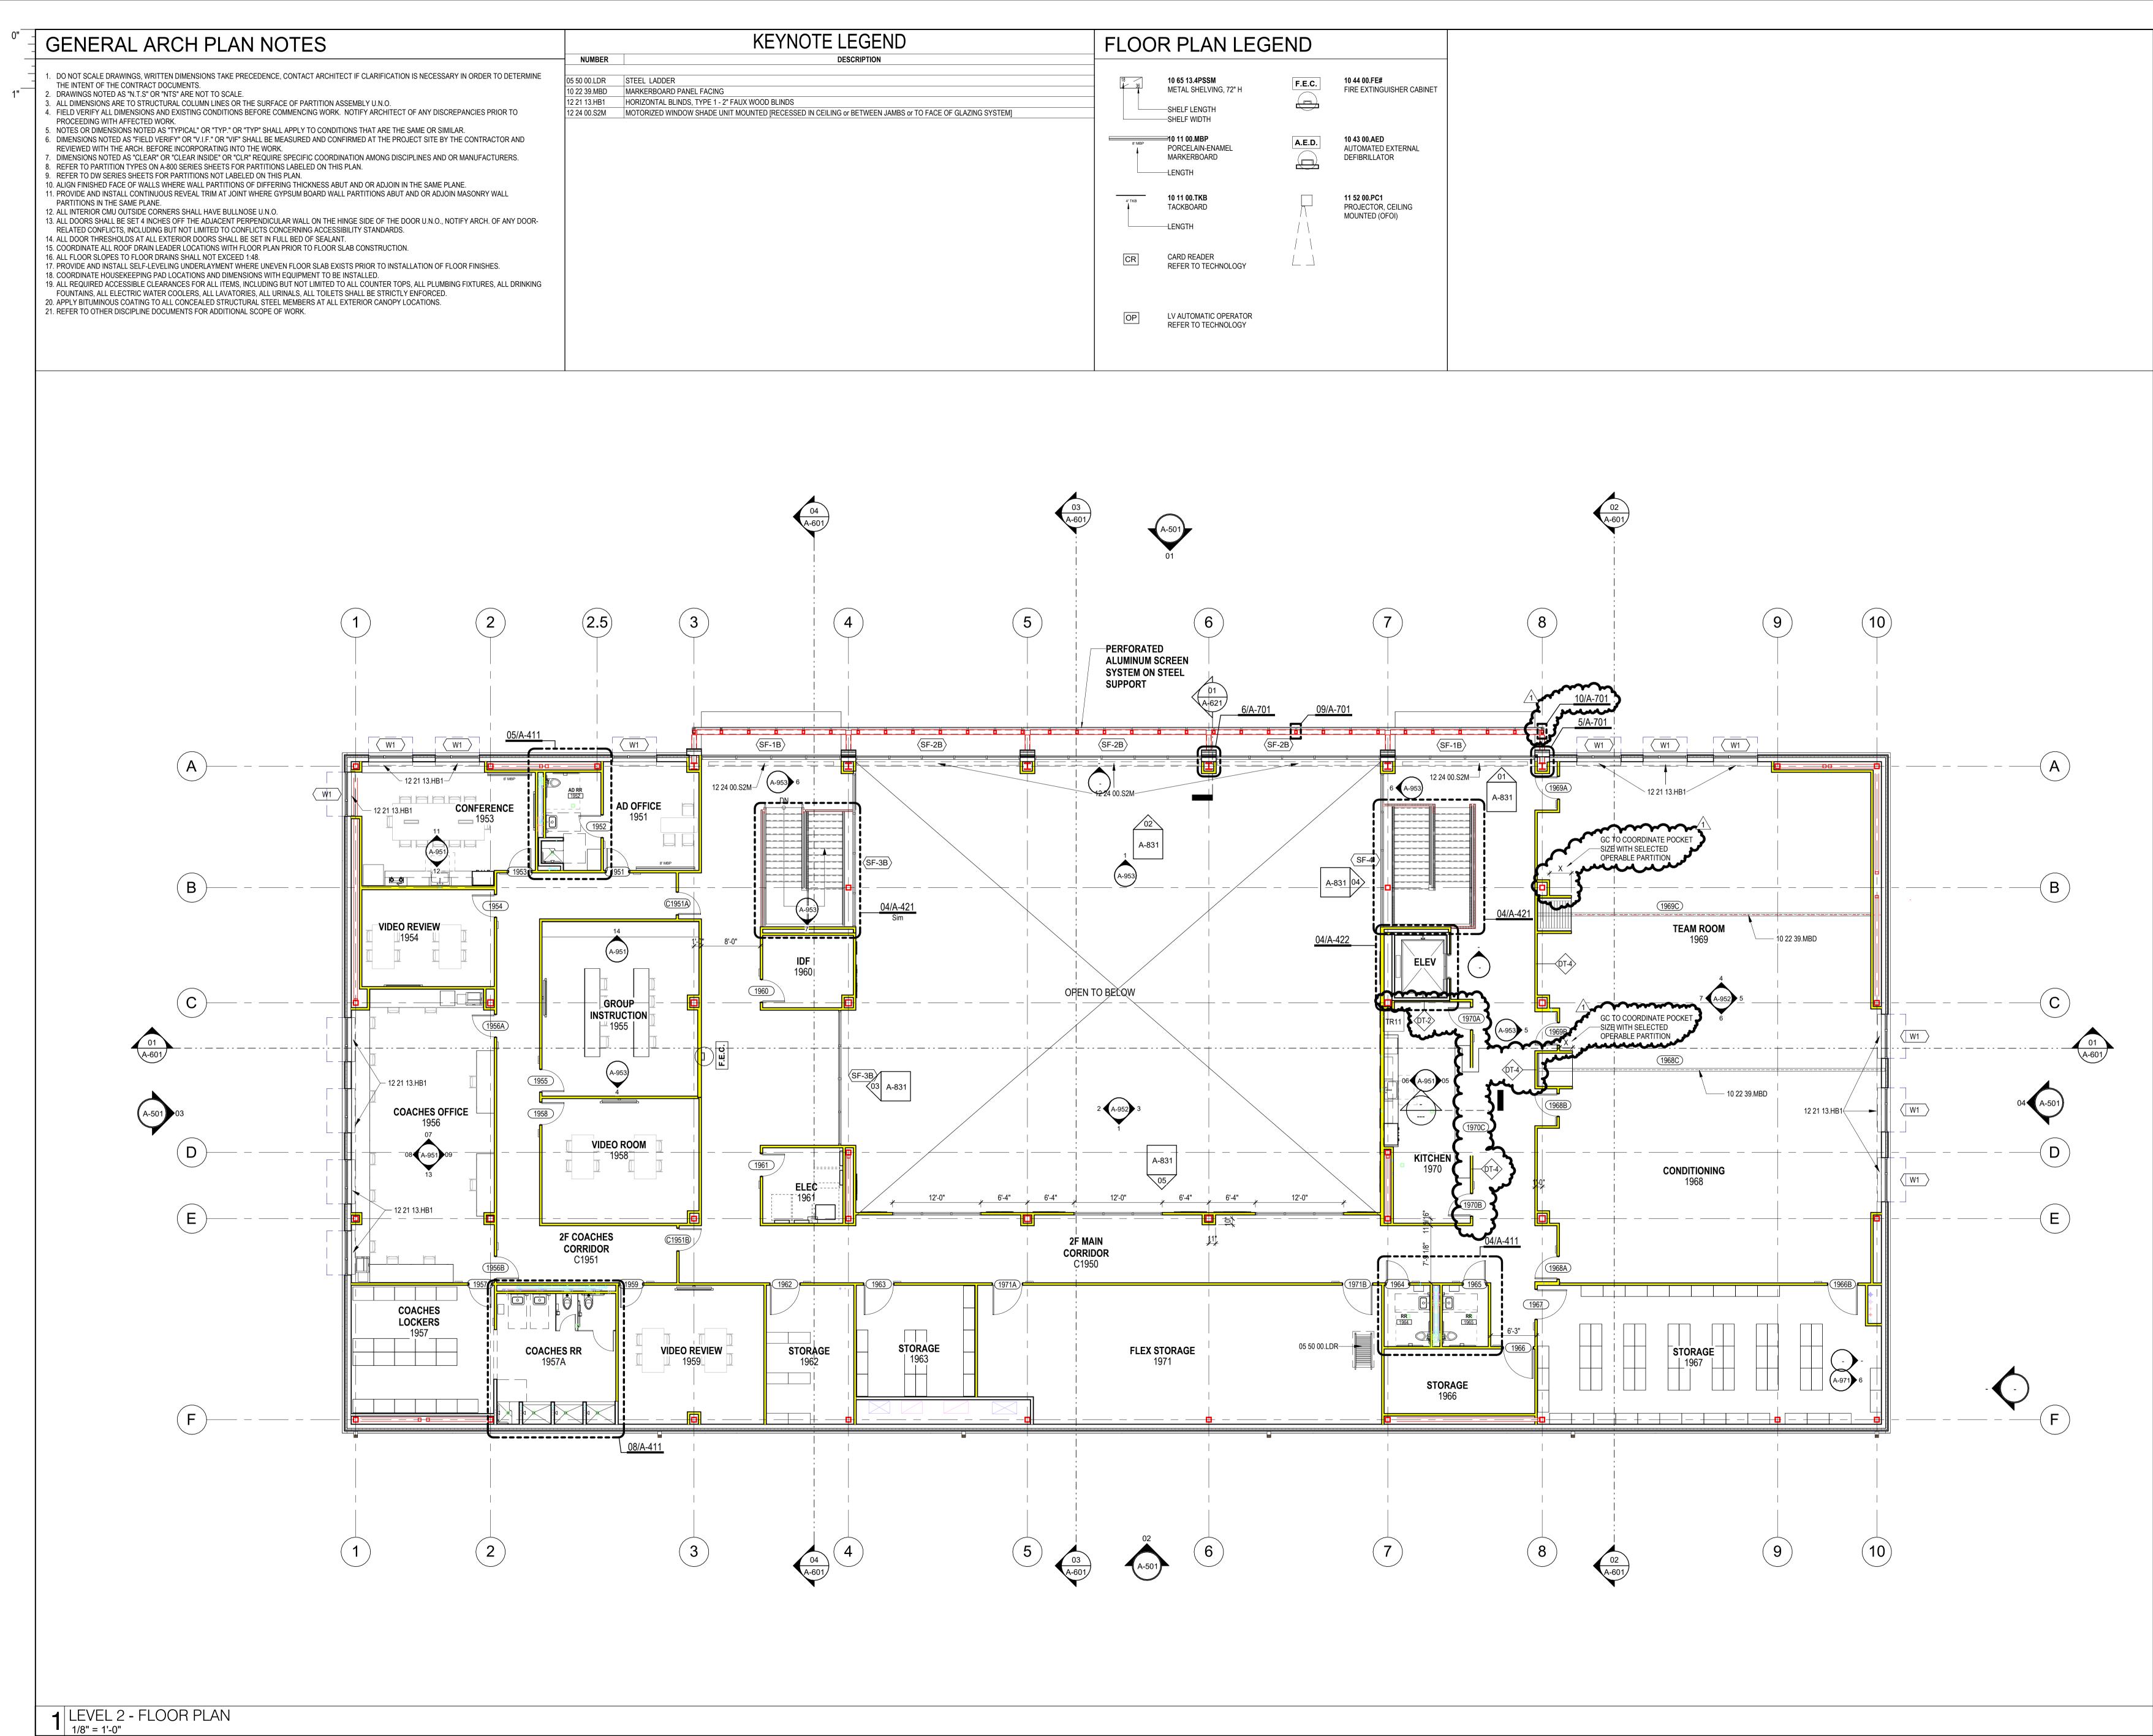




14. PROVIDE WALKWAY PROTECTION PADS AS SPECIFIED AROUND ALL ROOF H CONTRACTOR SHALL REVIEW AND COORDINATE WITH ARCHITECTURAL, MEP, AND STRUCTURAL DOCUMENTS TO ASCERTAIN EXACT CONDITIONS AND COMPONENTS RELATED TO THE WORK UNITS, DOORS THAT OPEN ONTO ROOF AND AT TOP AND BOTTOM OF ALL ROO DESCRIBED BY THESE DOCUMENTS. ALL WORK SHALL BE IN ACCORDANCE WITH ACCEPTED LOCATIONS. 15. ISOLATE ALL HEAT PIPES / FLUES AS DETAILED AND RECOMMENDED AND OU MANUFACTURER'S PRINTED INSTRUCTIONS AND NRCA STANDARDS. 2. DIMENSIONS, DETAILS, EQUIPMENT SIZE AND LOCATION SHOWN IN THESE CONSTRUCTION MANUAL FOR HOT STACK FLASHING AND AS DETAILED. DOCUMENTS ARE FOR CONVEYANCE OF DESIGN INTENT ONLY. EXACT SIZE, LOCATION, TYPE OF 16. ALL OUTSIDE AIR INTAKES SHALL BE COVERED TO ELIMINATE ODORS AND FU MATERIAL AND TYPE OF CONSTRUCTION OF EXISTING CONDITIONS ARE THE RESPONSIBILITY OF THE INTO THE BUILDING DURING CONSTRUCTION WORK. CONTRACTOR TO ASCERTAIN AND CONFIRM. 17. AFTER SUBSTANTIAL COMPLETION, THE GENERAL CONTRACTOR SHALL EXA DRAIN LINES AND NEW AND EXISTING (AS APPLICABLE) GUTTERS OF DEBRIS A 3. INDICATED ROOF HEIGHTS ARE GENERAL IN NATURE. RE: STRUCTURAL FOR FRAMING HEIGHTS. 4. REFER TO NOMENCLATURE FOR TYPE OF ROOF SYSTEM. AREAS ARE MARKED WITH DESIGNATED WITH WATER TO ENSURE THAT DRAINS AND GUTTERS FLOW FREELY. 18. PRIOR TO COMMENCEMENT OF WORK, COORDINATE WALK OF ENTIRE ROOF LETTER ON ROOF PLAN. 5. NOTE THAT THE DETAILS DRAWN ARE GENERIC IN NATURE AND ARE NOT NECESSARILY LOCATED AND MANUFACTURER'S TECHNICAL REPRESENTATIVE TO IDENTIFY AND LOCATE A KEYED TO THE ROOF PLANS. OR OTHER CONDITIONS WHICH MIGHT REQUIRE SPECIAL PROCEDURES FOR S 6. ALL NEW / EXISTING CRICKETS AND TAPERED INSULATION SHALL BE INSTALLED WITH A FINISHED 1/2" 19. REFER TO MEP DRAWINGS FOR SIZE AND LOCATION OF NEW ROOF DECK PE PER FOOT MIN. SLOPE. CRICKET THE UP SLOPE SIDE OF ALL SQUARE CURBS AND PROJECTIONS OVER TOP EQUIPMENT. 20. INSTALL NEW SPLASH PAN AT ALL LOCATIONS WHERE ROOF DRAINAGE DISC 20" IN WIDTH. 7. ALL CURB MOUNTED HVAC UNITS, EQUIPMENT, ETC. SHALL HAVE A MINIMUM 10" CURB HEIGHT. AREA. INSTALL NEW SPLASH BLOCKS WHERE ROOF DRAINAGE DISCHARGES (8. WORK TO ANY UTILITY CONDUIT OR PIPE SHALL BE PERFORMED BY SPECIFIC LICENSED 21. REFER TO GENERAL DETAILS FOR TYPICAL SPLASH PAN, ROOF DRAIN AND (SUBCONTRACTORS SPECIALIZING IN HVAC, PLUMBING AND ELECTRICAL WORK. PERMITS AND DETAILS. 22. GENERAL CONTRACTOR TO ENSURE ALL ROOFTOP PENETRATIONS (SOIL ST INSPECTIONS ARE REQUIRED. 9. UNLESS INDICATED OTHERWISE ON THE CONSTRUCTION DOCUMENTS, ALL EXISTING JOINTS / AREA INSTALLED MIN. 4'-0" FROM OTHER DECK PENETRATIONS, RISE WALLS, AND RC DIVIDERS / CURB MOUNTED EQUIPMENT / SKYLIGHTS SHALL BE MIN. 10" ABOVE ROOF DECK. EQUIPMENT TO BE LOCATED MIN. 10'-0" FROM PERIMETER EDGE AND NO CLOS


10. ALL SOIL STACK FLASHING SHALL BE A MIN. 10" ABOVE FINISHED ROOF SURFACE. COUPLE PVC PIPE WALLS, OR ANY OTHER ROOF PENETRATION. ABOVE DECK AND COUPLE CAST IRON PIPE BELOW DECK. PROPERLY SUPPORT PIPE BELOW ROOF DECK FROM LATERAL MOVEMENT. 1. ALL PIPING/ CONDUITS/ ETC. SHALL BE A MIN. 10" ABOVE ROOF SURFACE. PROVIDE PORTABLE PIPE 24. THROUGH WALL BASE FLASHING MIN. HEIGHT 10" AND MAX. HEIGHT 20" FROM HANGERS WITH PROTECTION PADS AS SPECIFIED. MEP CONTRACTORS SHALL PROVIDE SUPPORTS FOR UTILITY LINES. 12. PROVIDE "MERCURY" GAS LINE TEST (COORDINATE WITH OWNER AND ARCHITECT FOR WITNESS OF ACCESS LADDER. THE TEST). REPAIR ANY FOUND LEAKS AND RETEST AS REQUIRED. 13. PROVIDE SHEET METAL HOODED (WITH METAL FACE CLOSURE) CAPS, WOOD CURB, BOX COVER AT ALL GAS AND WATER PIPE ROOF PENETRATIONS AS DETAILED AND SPECIFIED. PROVIDE POSITIVE SLOPE AWAY FROM FACE COVER.

30 GENERAL NOTES (NEW)

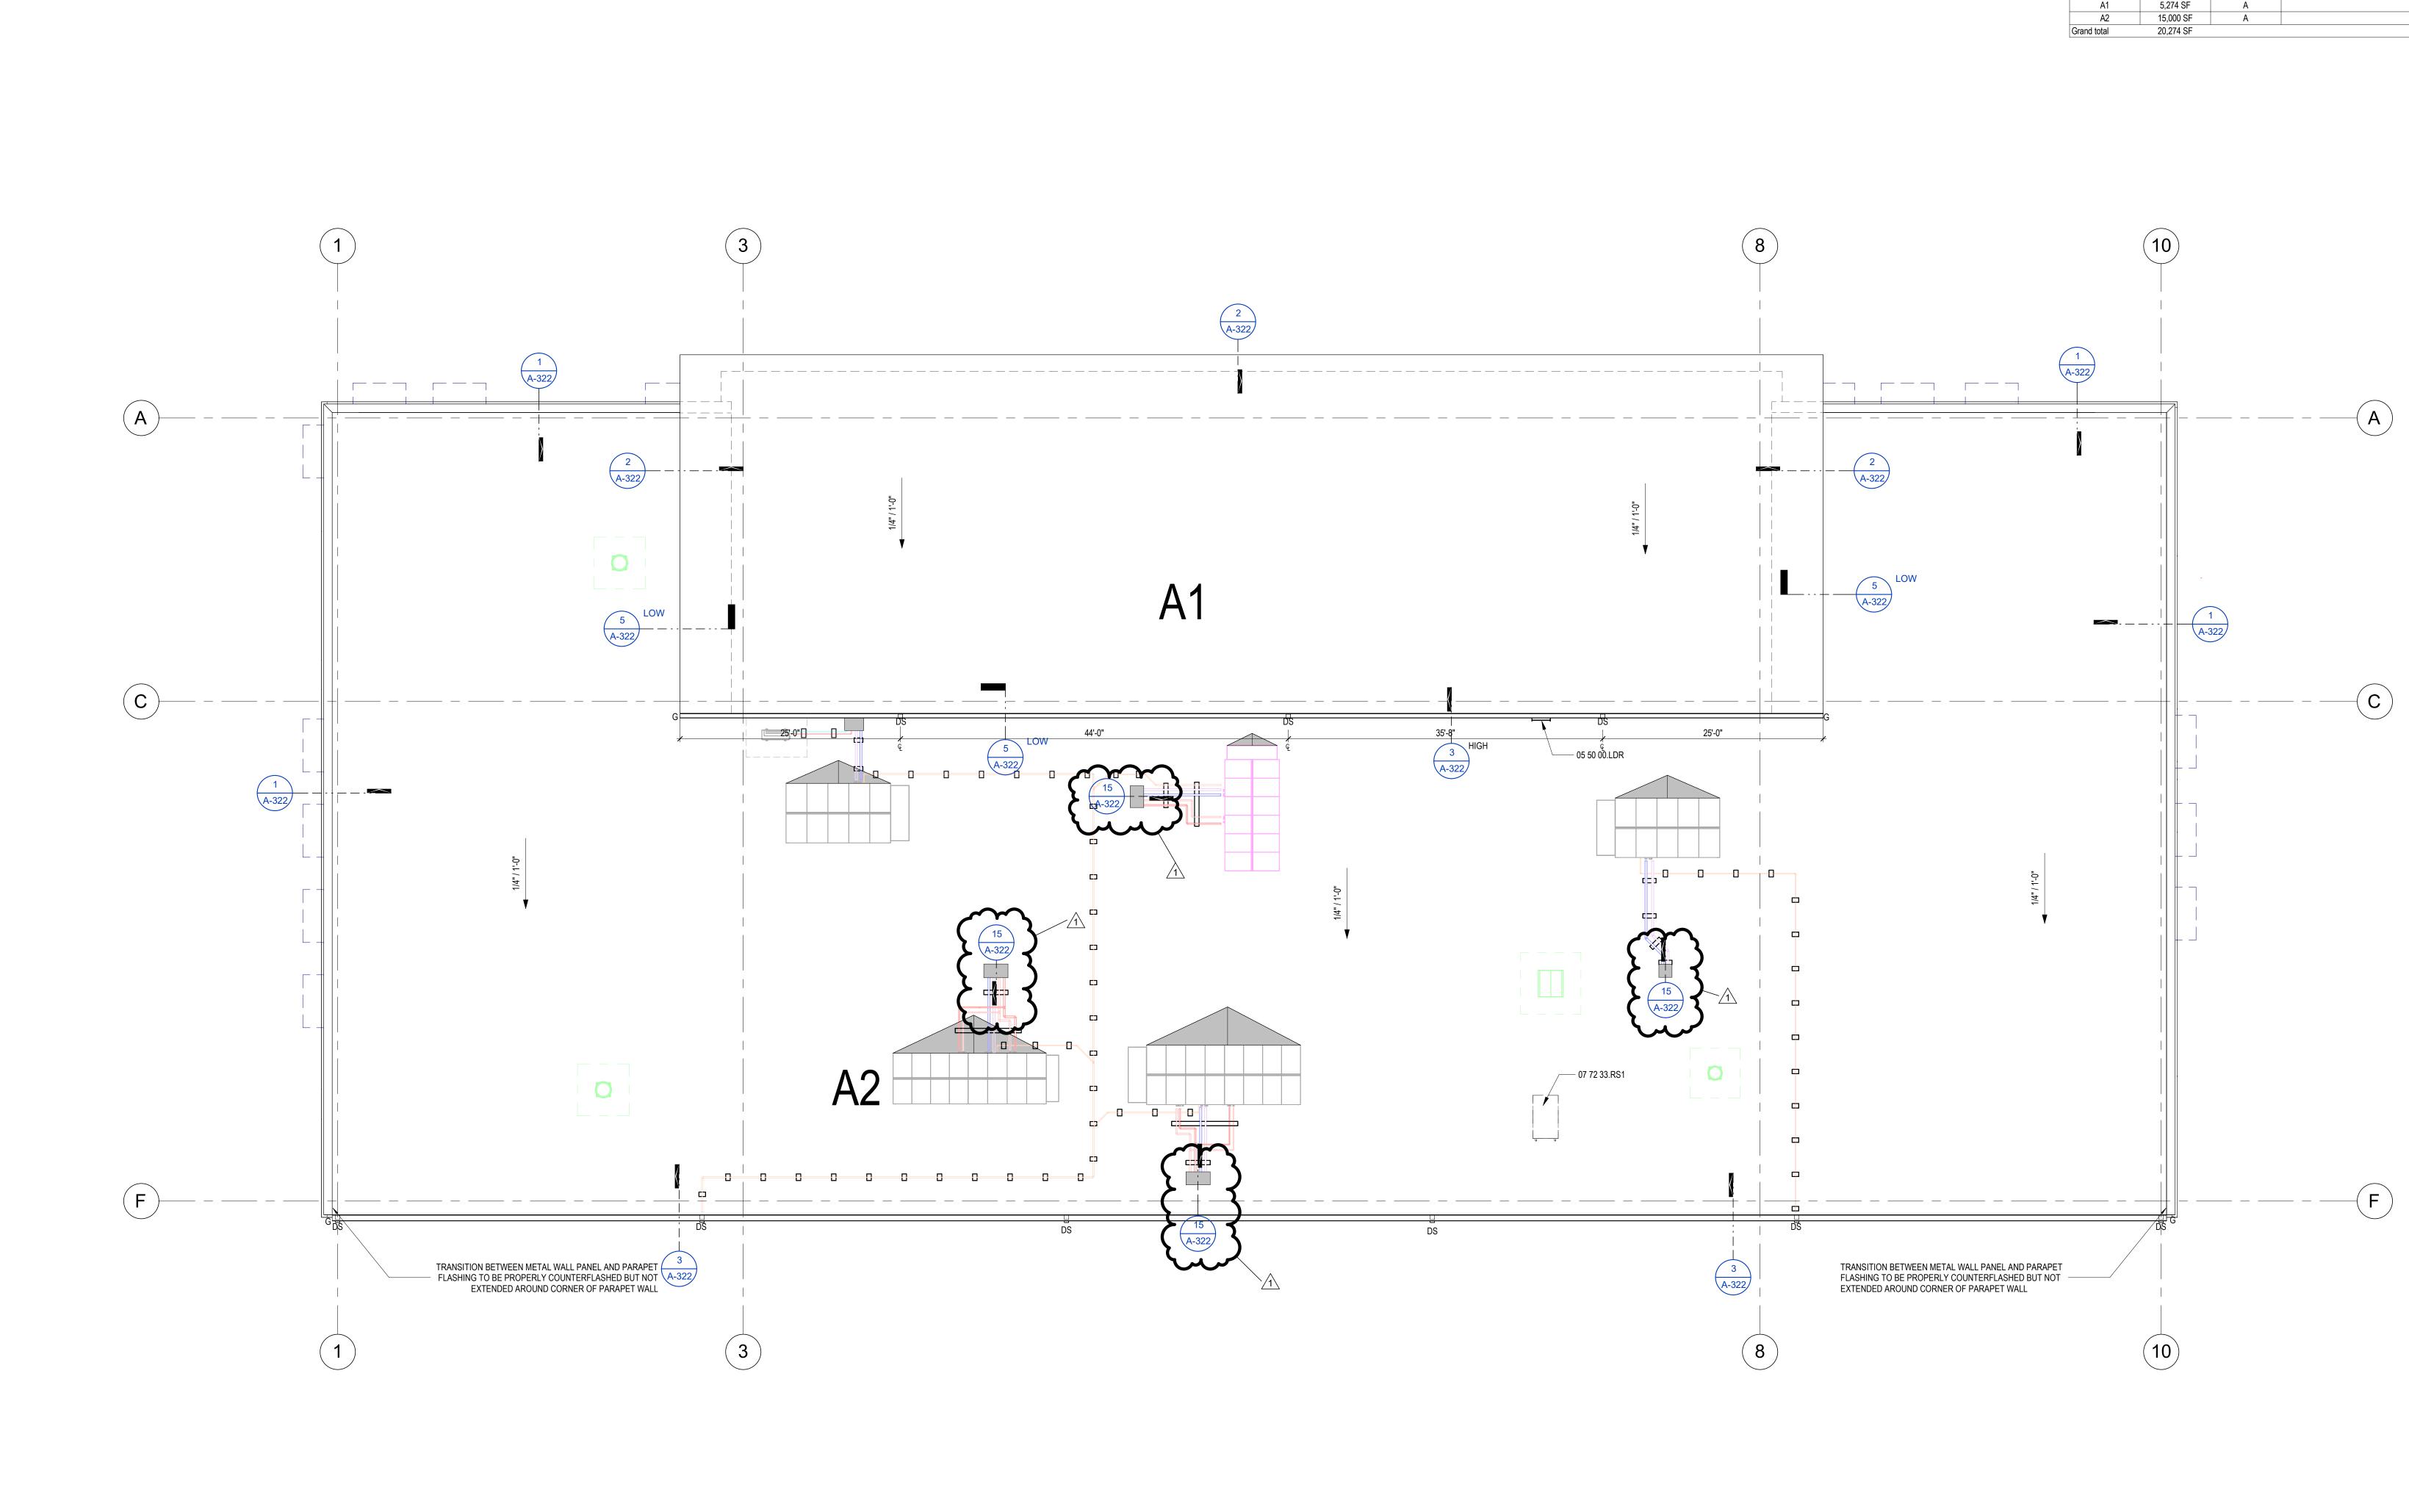


Plot Stamp: 6/24/2025 9:36:26 AM 6 OVERALL ROOF PLAN

	14. PROVIDE WALKWAY PROTECTION PADS AS SPECIFIED AROUND ALL ROOF HATCHES, HVAC ROOFTOP UNITS, DOORS THAT OPEN ONTO ROOF AND AT TOP AND BOTTOM OF ALL ROOF TOP ACCESS LOCATIONS.	INSULATION HATCHING SHOWN IS NOT INTENDED TO ILLUSTRATE THE ENTIRE LIMITS OF TAPERED		KEYNOTE LEGEND
	15. ISOLATE ALL HEAT PIPES / FLUES AS DETAILED AND RECOMMENDED AND OUTLINED IN THE NRCA	INSULATION. ROOF AREAS NOT SLOPED BY STRUCTURE SHALL BE SLOPED WITH TAPERED INSULATION TO ACHIEVE PROPER DRAINAGE.	NUMBER	DESCRIPTION
	MANUAL FOR HOT STACK FLASHING AND AS DETAILED.	28. PROVIDE ONE WAY MOISTURE VENTS AT ALL LIGHTWEIGHT CONCRETE OR GYPSUM OVER POUR		
	16. ALL OUTSIDE AIR INTAKES SHALL BE COVERED TO ELIMINATE ODORS AND FUMES FROM ENTERING		05 50 00.LDR	STEEL LADDER
=				
-	17. AFTER SUBSTANTIAL COMPLETION, THE GENERAL CONTRACTOR SHALL EXAMINE AND CLEAN NEW		07 72 33.RS1	ROOF HATCH
	DRAIN LINES AND NEW AND EXISTING (AS APPLICABLE) GUTTERS OF DEBRIS AND BLOCKAGE, FLUSH			
	WITH WATER TO ENSURE THAT DRAINS AND GUTTERS FLOW FREELY.			
	18. PRIOR TO COMMENCEMENT OF WORK, COORDINATE WALK OF ENTIRE ROOF WITH ROOFING			
ND	MANUFACTURER'S TECHNICAL REPRESENTATIVE TO IDENTIFY AND LOCATE ALL AREAS OF HIGH SLOPE			
	OR OTHER CONDITIONS WHICH MIGHT REQUIRE SPECIAL PROCEDURES FOR SYSTEM ATTACHMENT.			
2"	19. REFER TO MEP DRAWINGS FOR SIZE AND LOCATION OF NEW ROOF DECK PENETRATIONS AND ROOF			
ER	TOP EQUIPMENT.			
	20. INSTALL NEW SPLASH PAN AT ALL LOCATIONS WHERE ROOF DRAINAGE DISCHARGES ONTO ROOF			
	AREA. INSTALL NEW SPLASH BLOCKS WHERE ROOF DRAINAGE DISCHARGES ON GROUND.			
	21. REFER TO GENERAL DETAILS FOR TYPICAL SPLASH PAN, ROOF DRAIN AND OVERFLOW DRAIN			
	DETAILS.			
	22. GENERAL CONTRACTOR TO ENSURE ALL ROOFTOP PENETRATIONS (SOIL STACKS, VENTS, ETC.) ARE			
1	INSTALLED MIN. 4'-0" FROM OTHER DECK PENETRATIONS, RISE WALLS, AND ROOF EDGE. MECHANICAL EQUIPMENT TO BE LOCATED MIN. 10'-0" FROM PERIMETER EDGE AND NO CLOSER THAN 4'-0" FROM RISE.			
	WALLS, OR ANY OTHER ROOF PENETRATION.			
Ē	23. LOCATE PERIMETER DRAINS MAX. 6-0" FROM EDGE TYPICAL UNLESS SHOWN OTHERWISE. (GENERAL			
	CONTRACTOR TO COORDINATE WITH ROOFING AND PLUMBING CONTRACTOR.)			
F	24. THROUGH WALL BASE FLASHING MIN. HEIGHT 10" AND MAX. HEIGHT 20" FROM FINISH DECK. DO NOT			
	STEP THROUGH WALL FLASHING CLOSER THAN 5'-0" FROM CORNERS.			
	25. GENERAL CONTRACTOR SHALL COORDINATE LOCATION AND ORIENTATION OF ROOF HATCH AND			
)F	ACCESS LADDER.			
	26. GENERAL CONTRACTOR SHALL COORDINATE ALL TOP OF STEEL TO TOP OF BLOCKING AND			
Т	SUBSTRATE BOARD DIMENSIONS IN FIELD PRIOR TO ORDERING MATERIALS. NO ADDITIONAL			
	COMPENSATION WILL BE GRANTED FOR FAILURE TO COORDINATE THESE DIMENSIONS.			

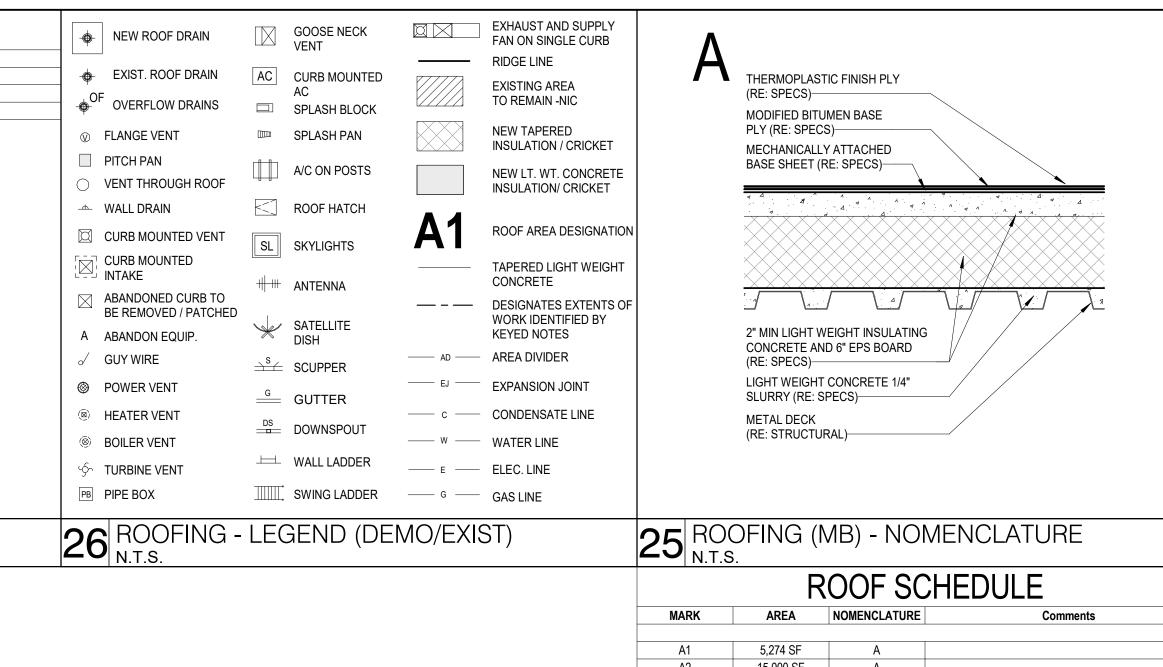



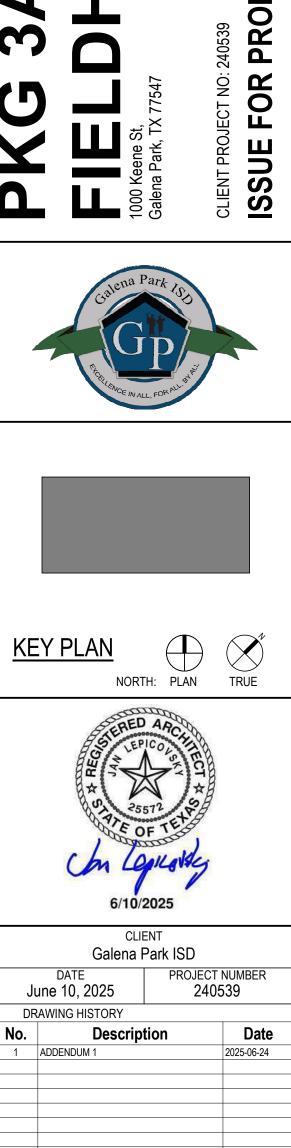


OVERALL ROOF PLAN


A-301

CHECKED BY: SL & BG


DRAWN BY: DAS

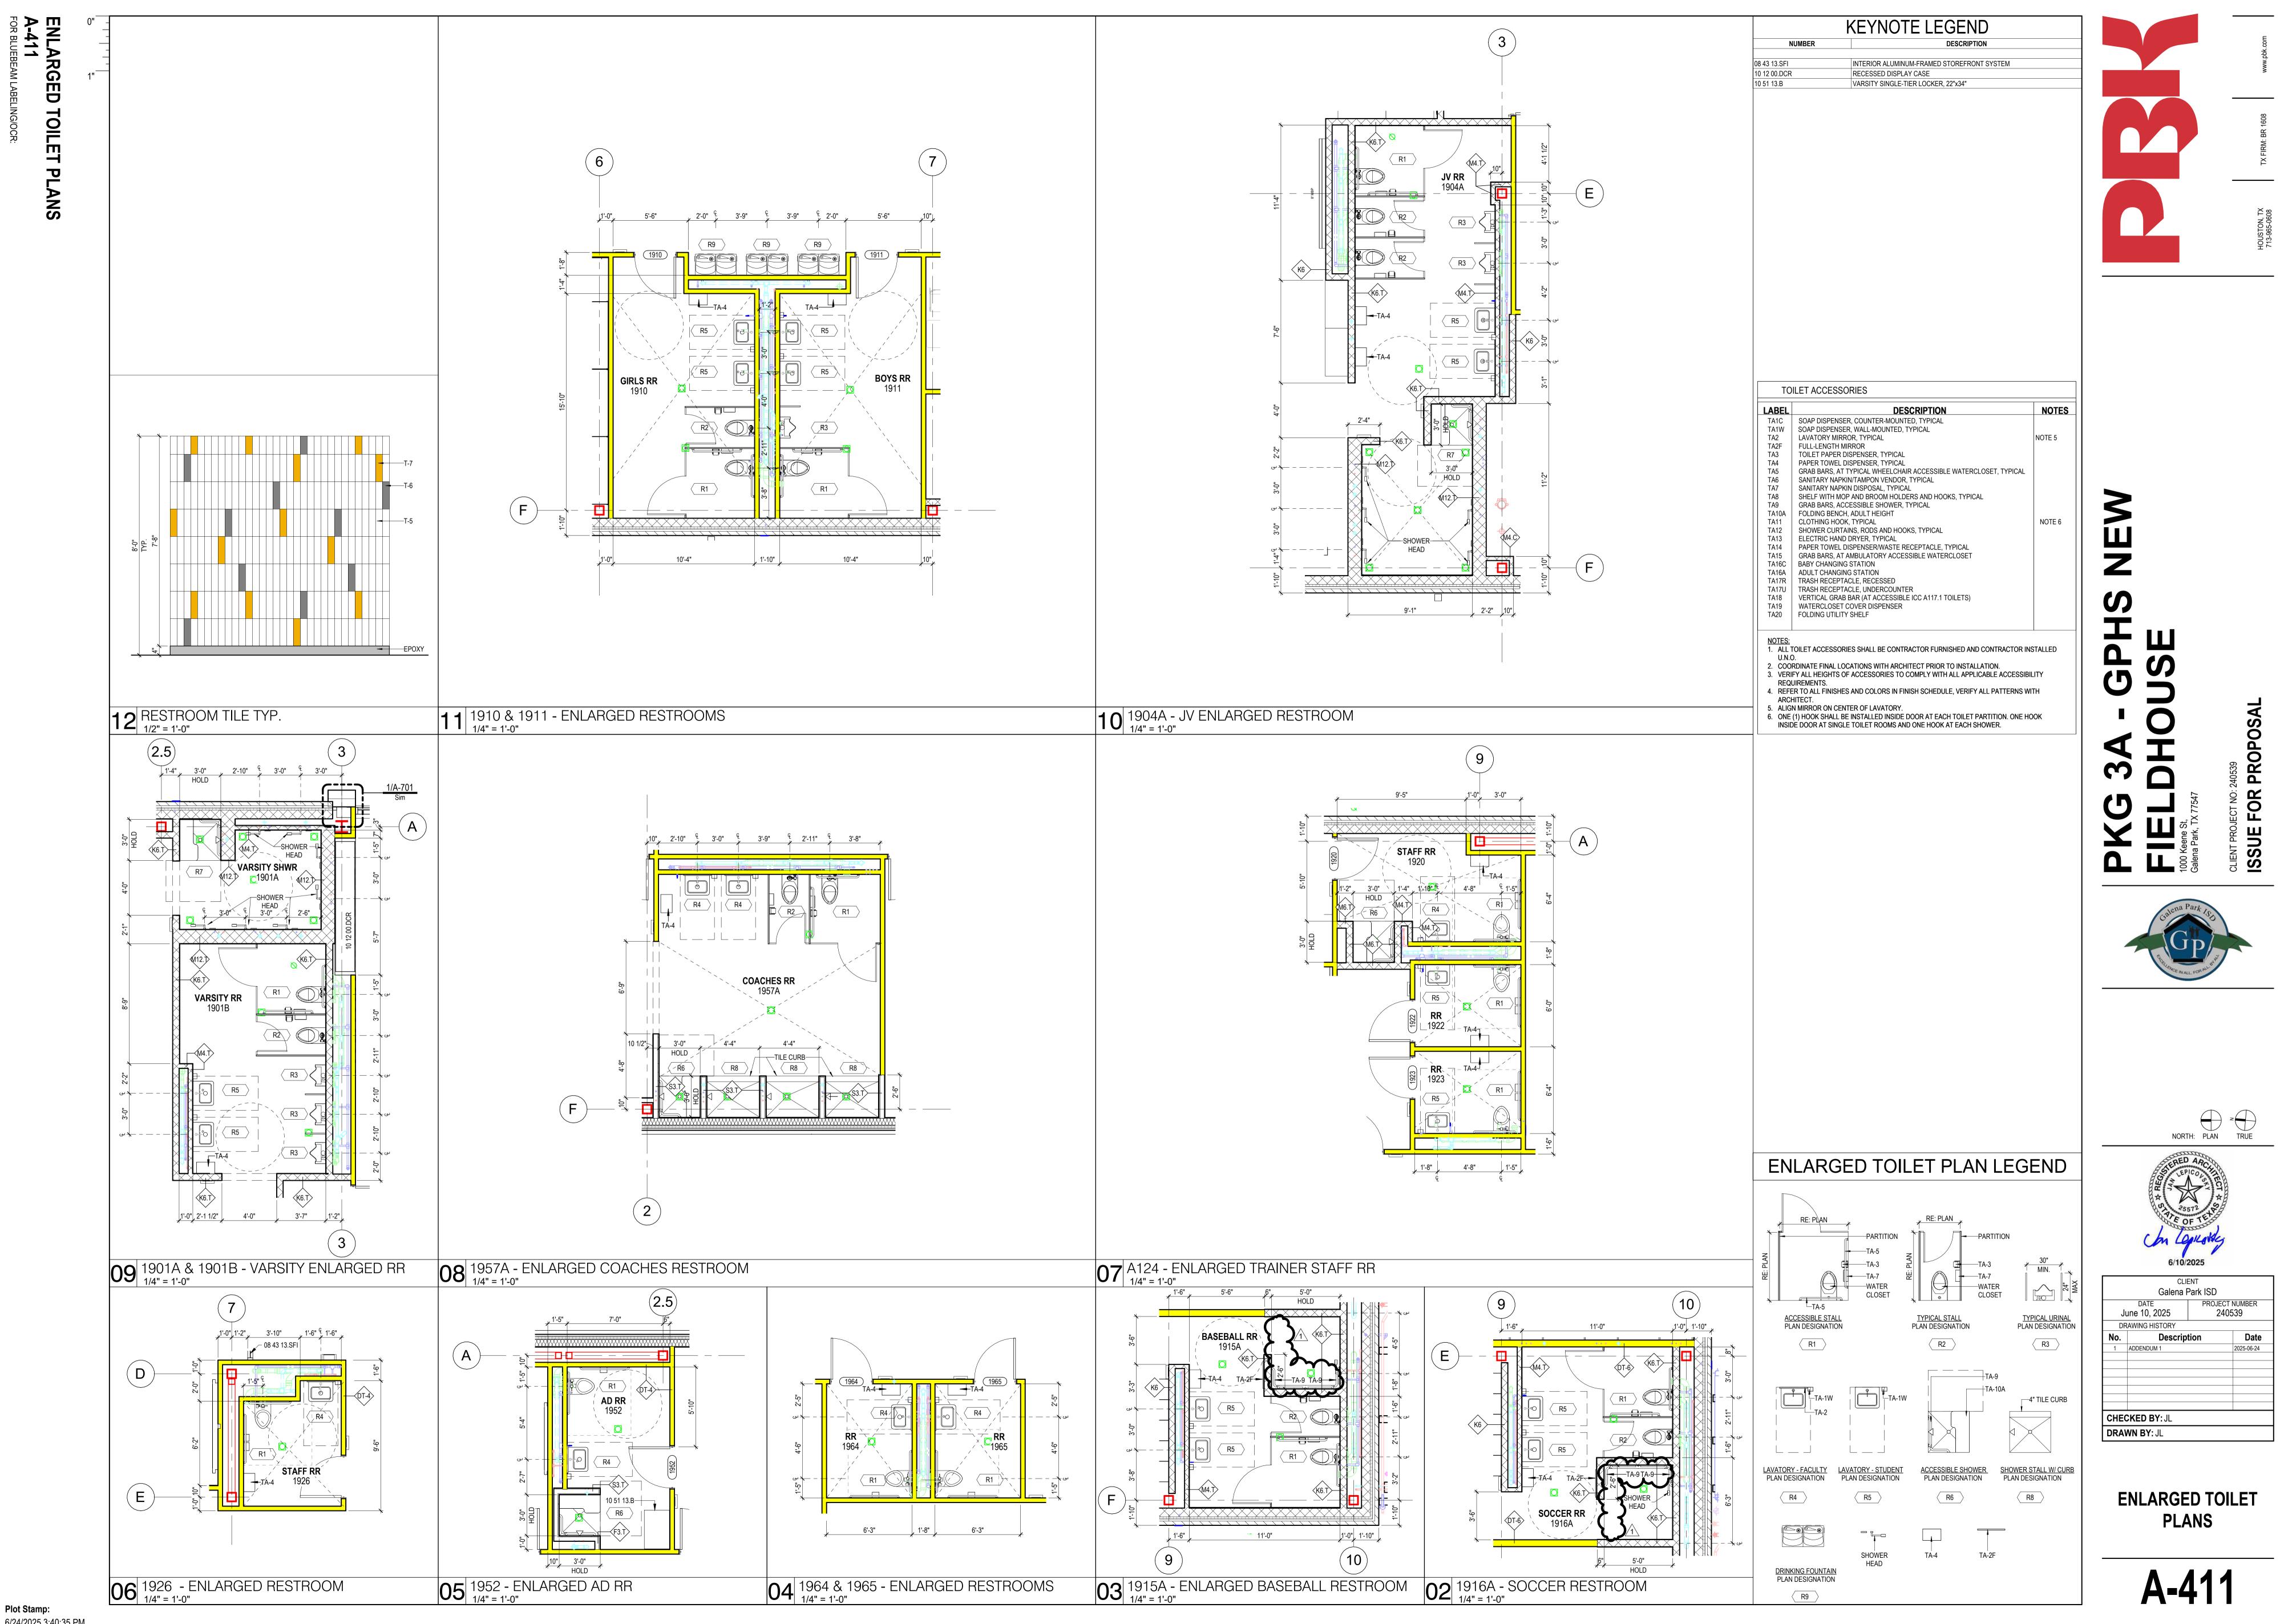

6/24/2025 3:40:35 PM

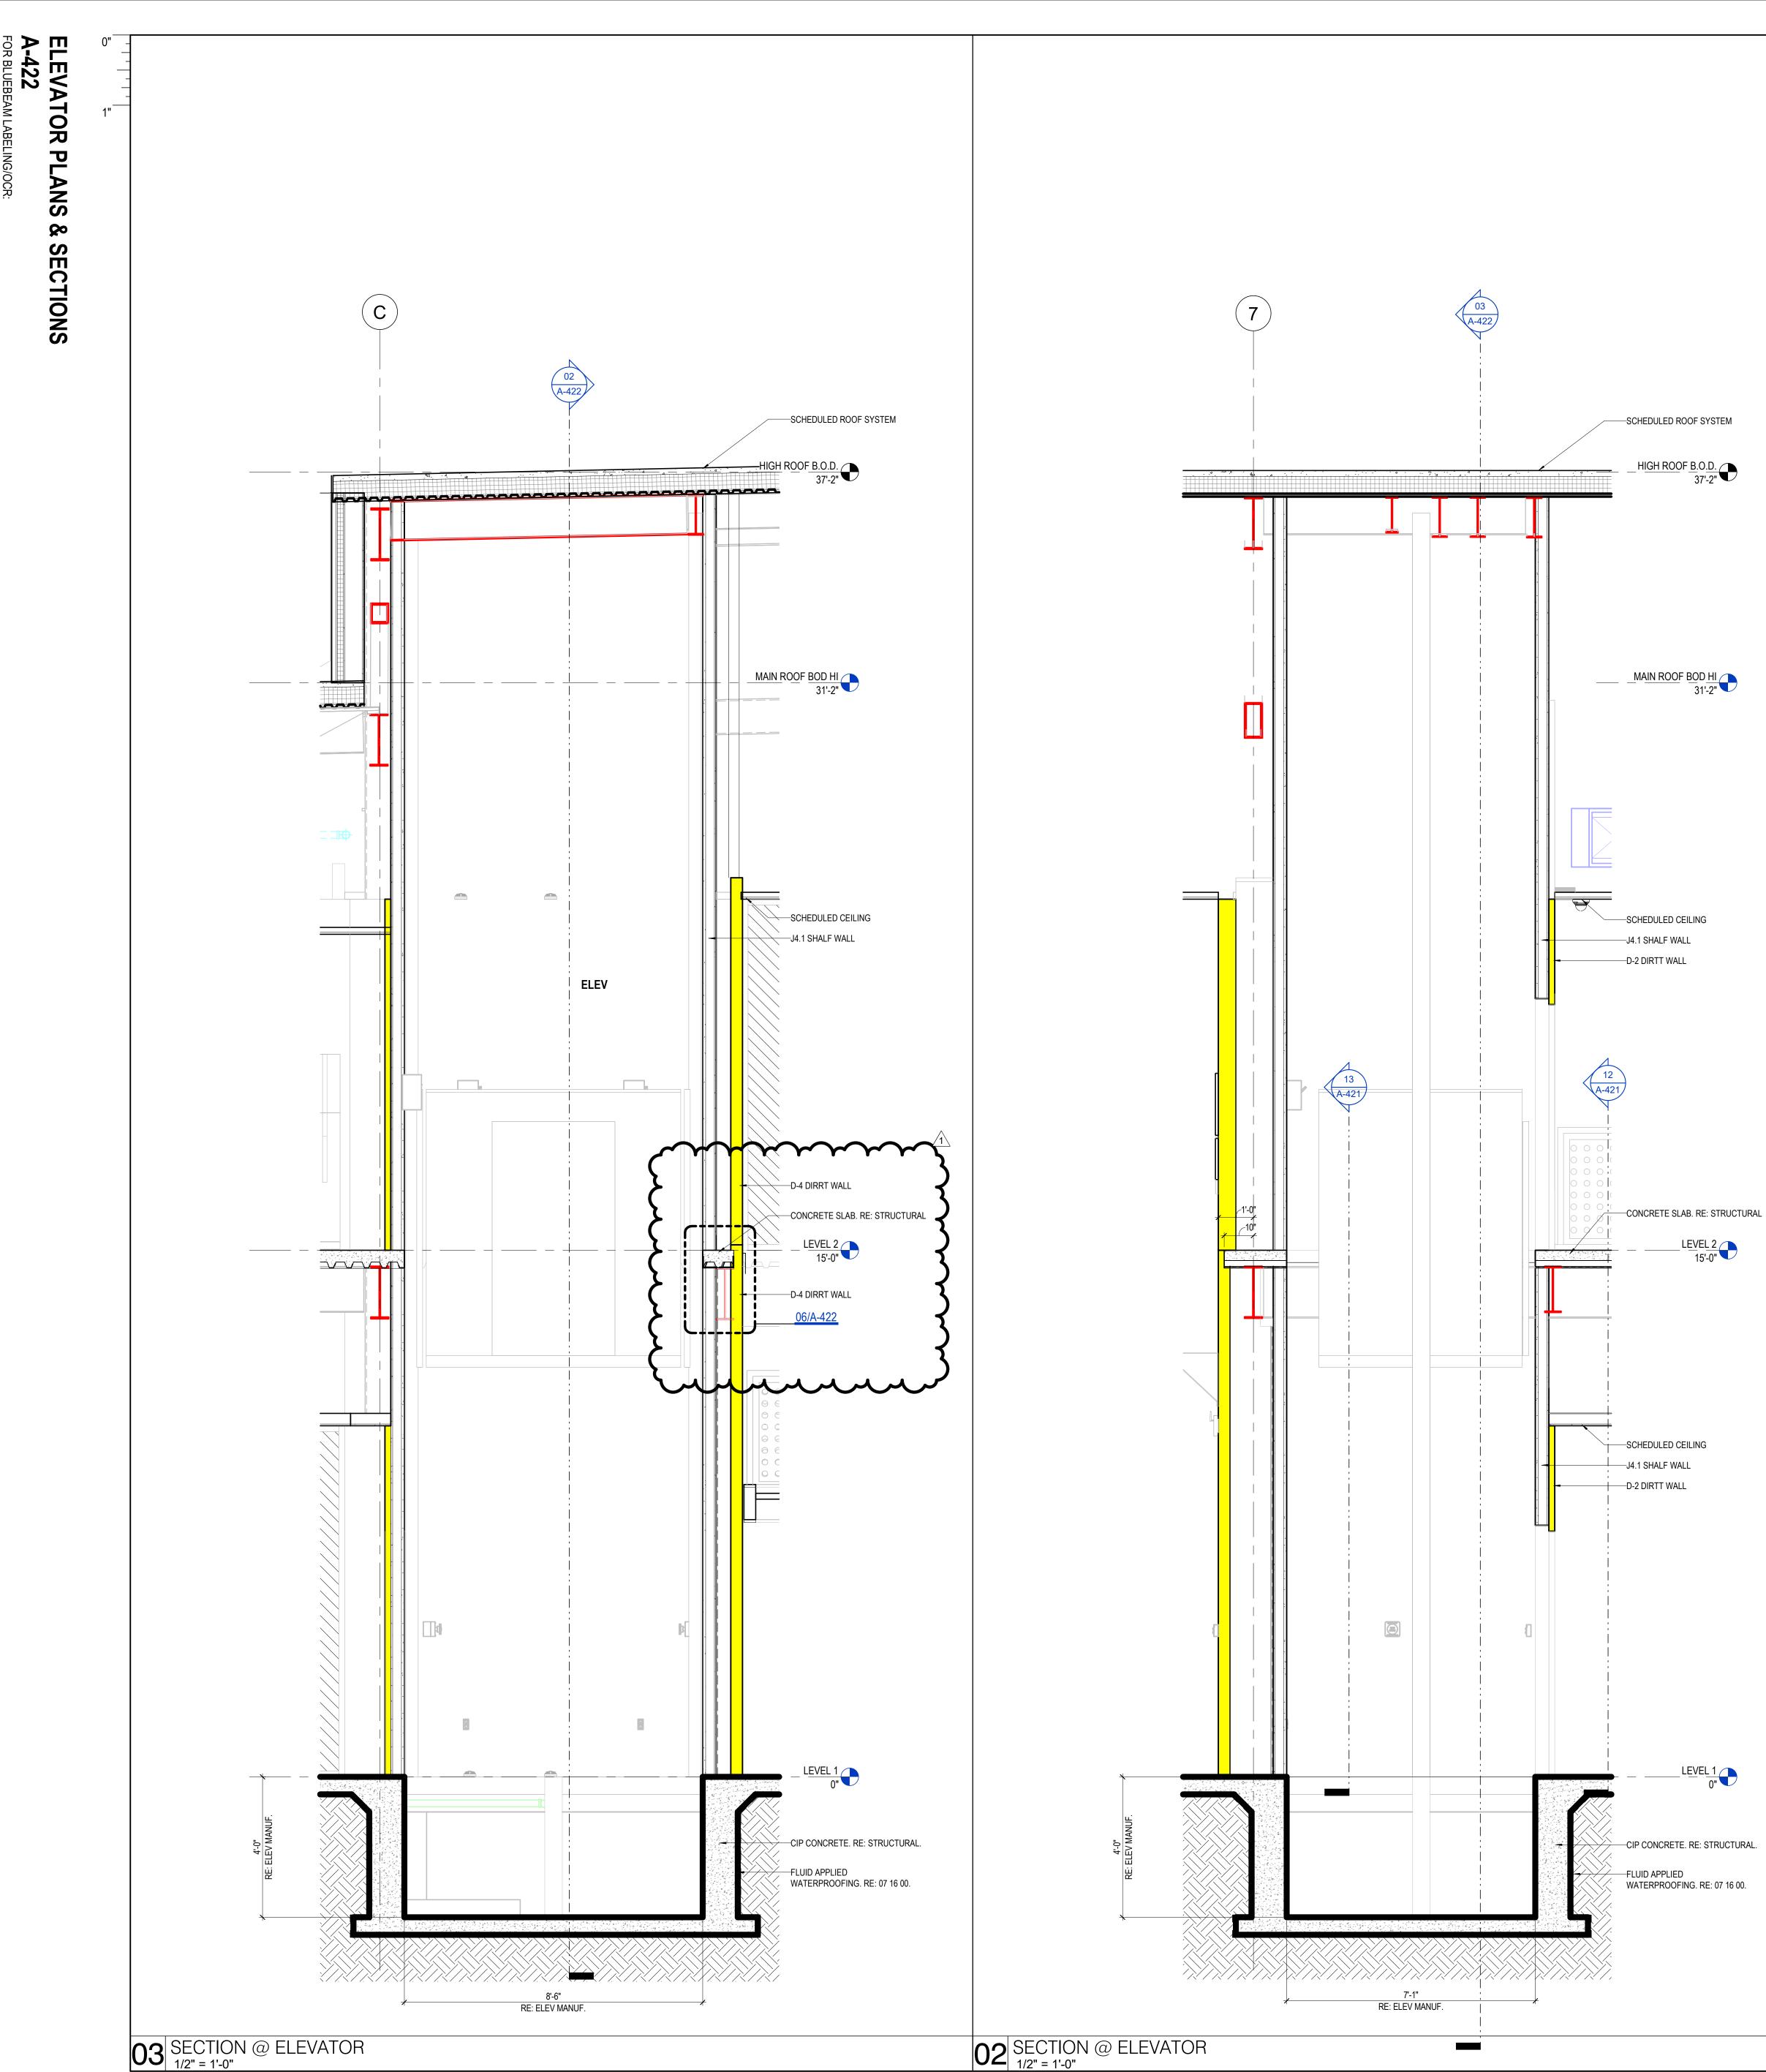


Plot Stamp: 6/25/2025 9:13:22 AM

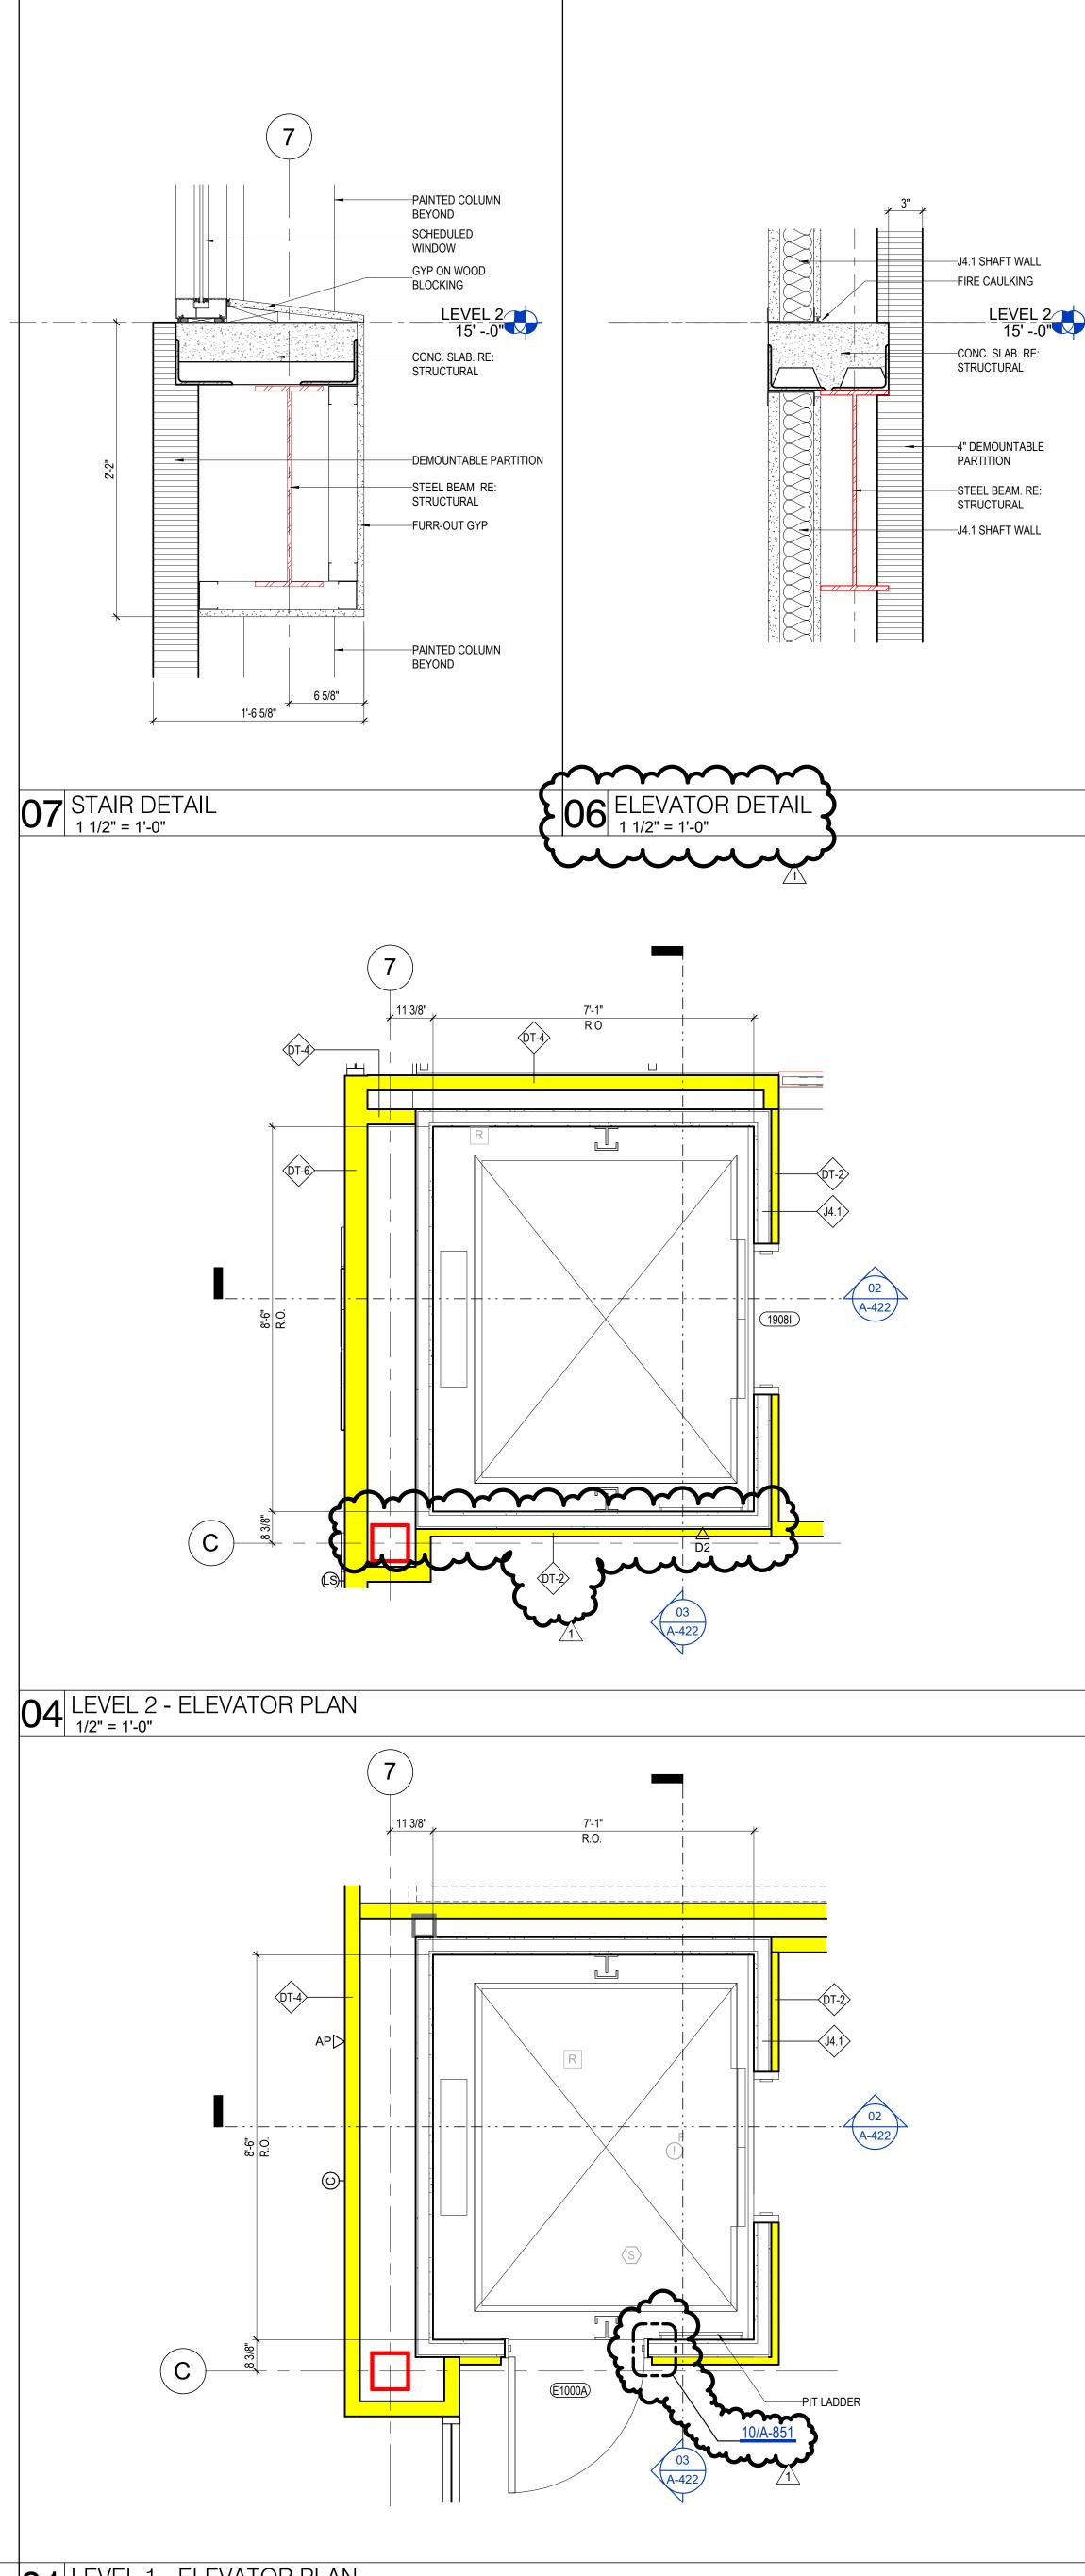






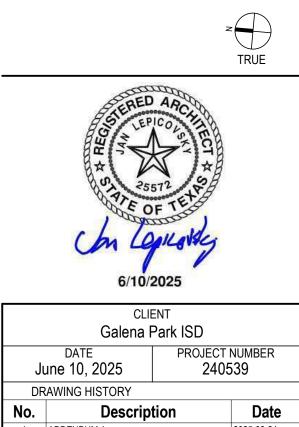

Ju	DATE June 10, 2025	PROJECT 2405	
DR	AWING HISTORY		
No.	Descrip	tion	Date
1	ADDENDUM 1		2025-06-24
CHEC	CKED BY: Checke	er	
DRAV	VN BY: Author		



A-422

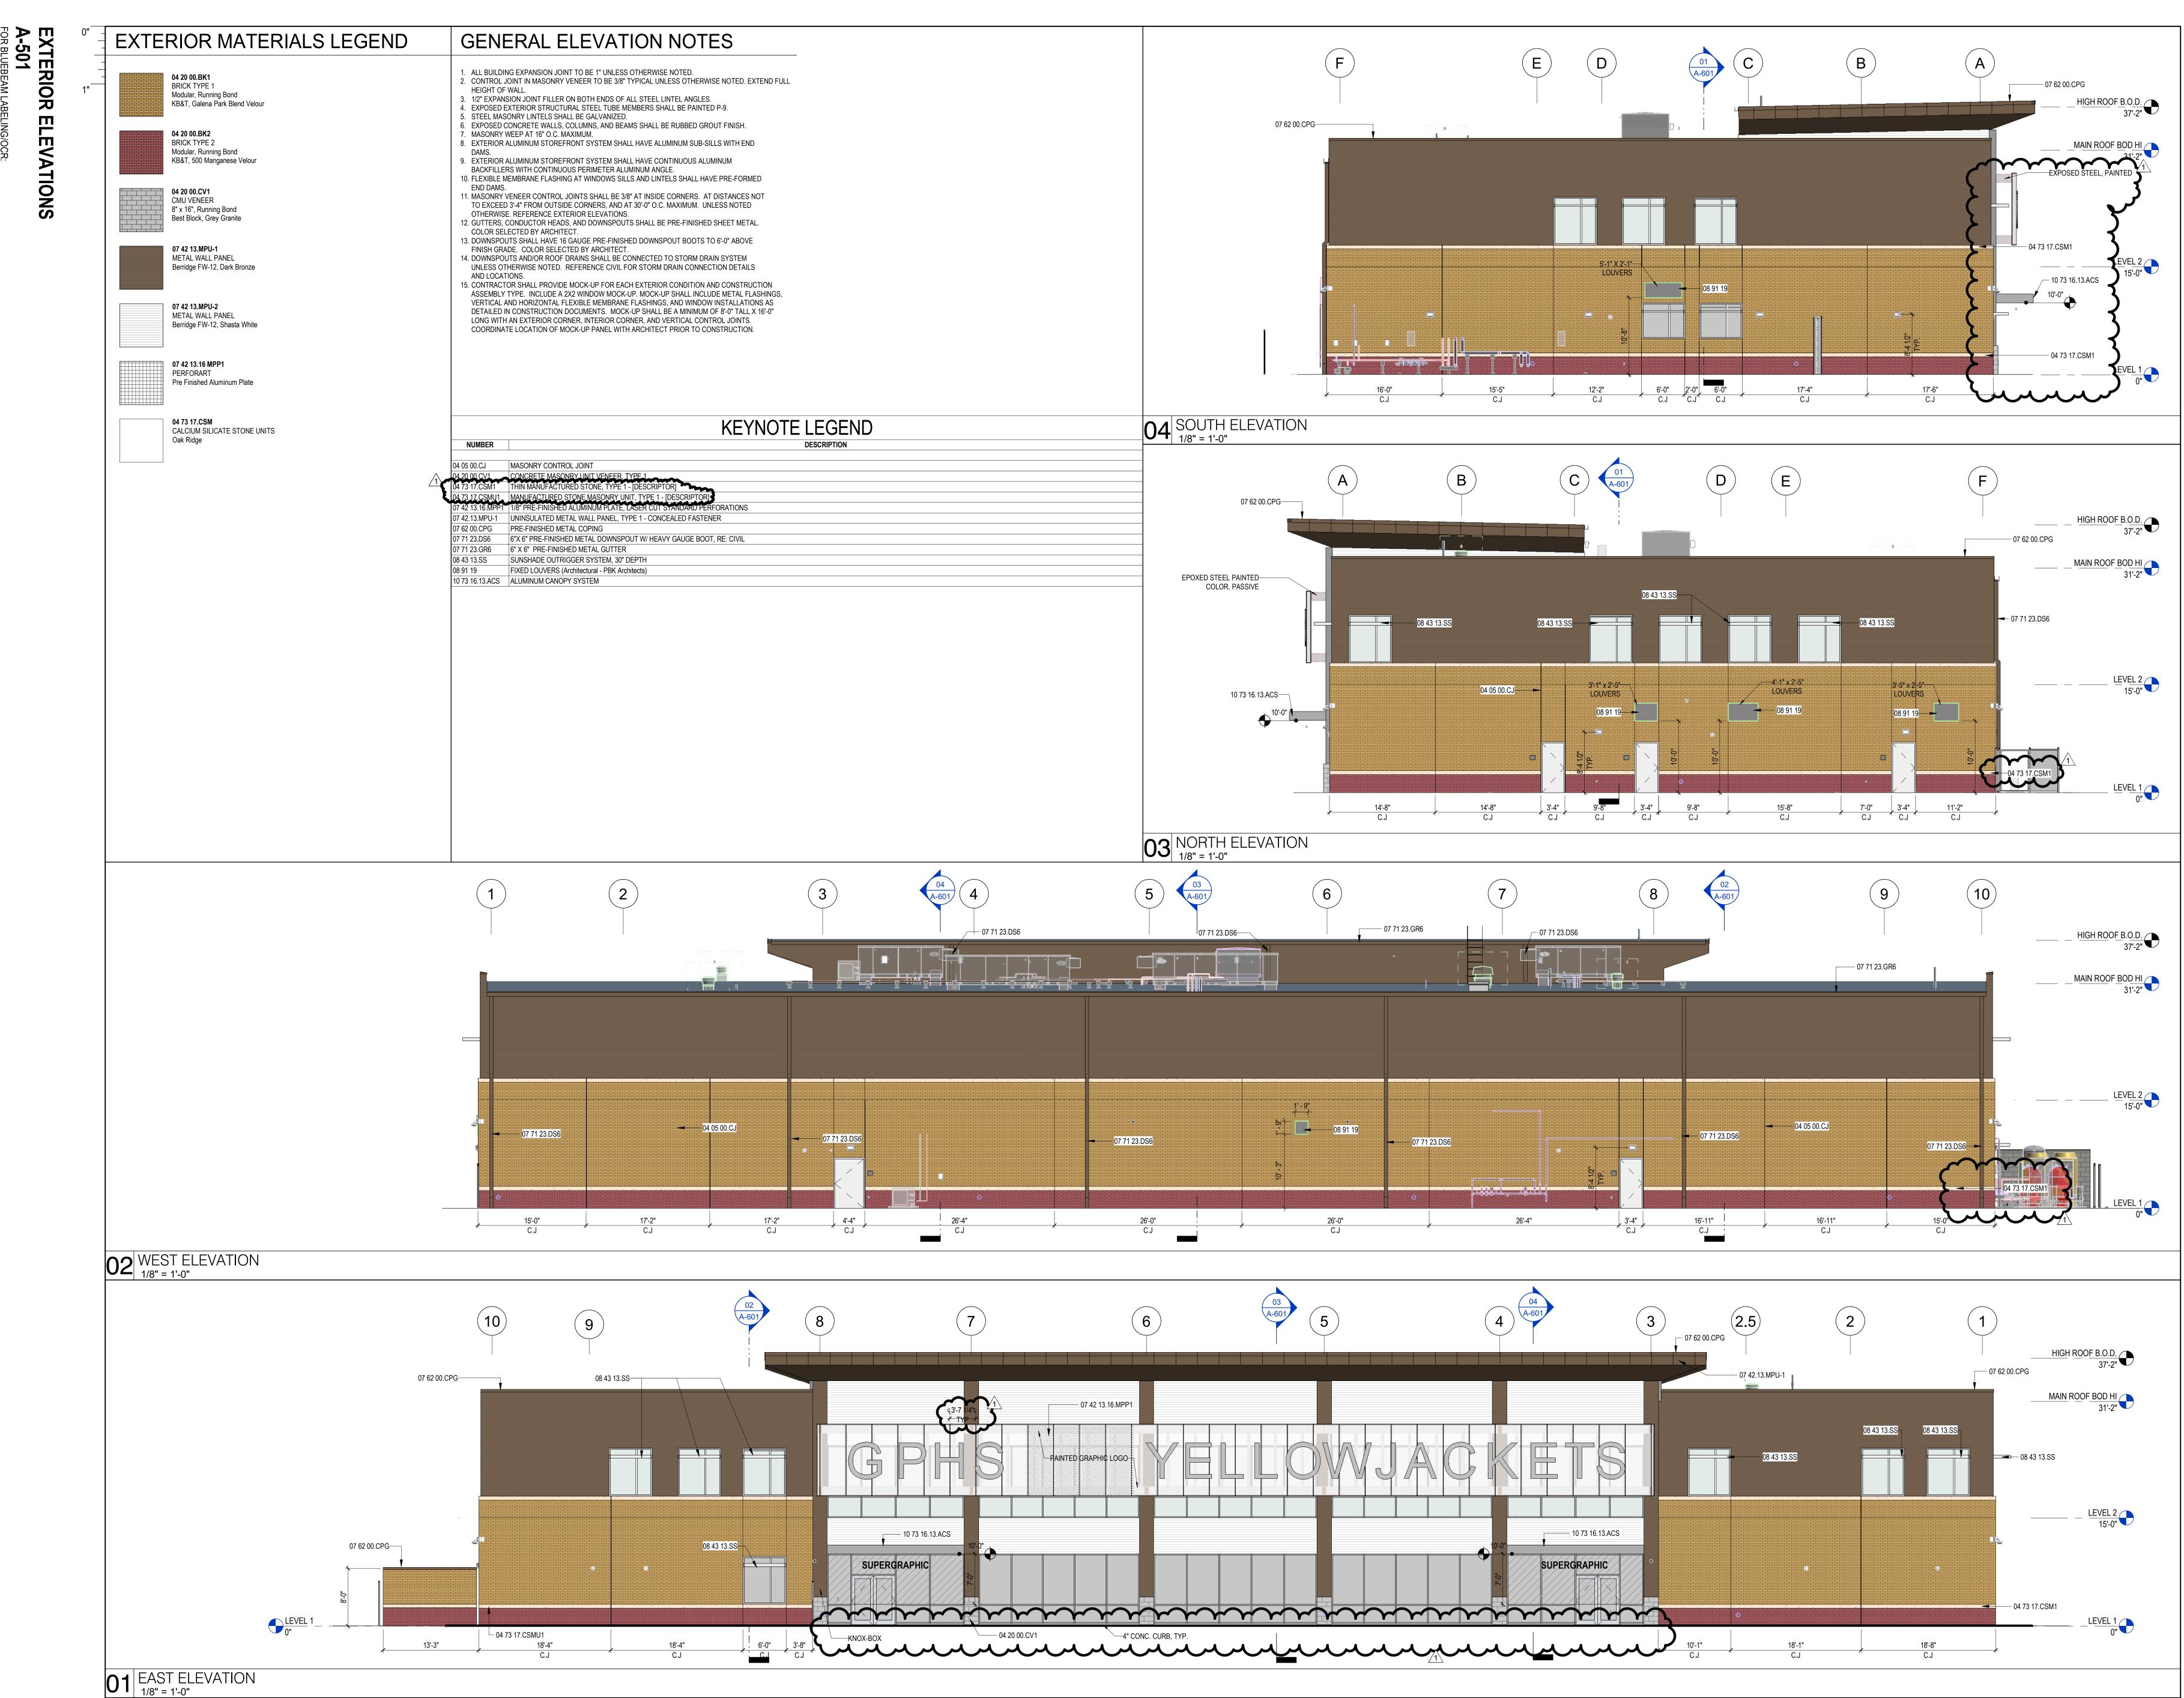



Plot Stamp:

6/25/2025 10:11:52 AM




EXTERIOR

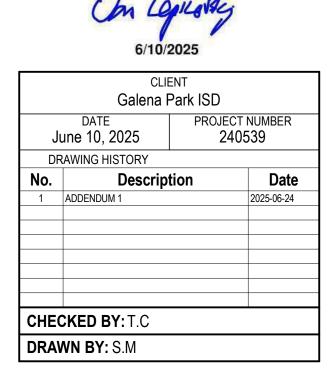


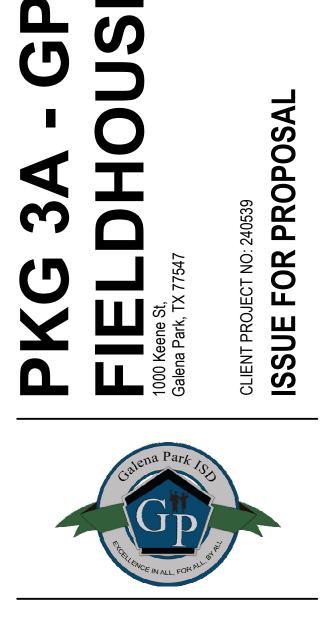






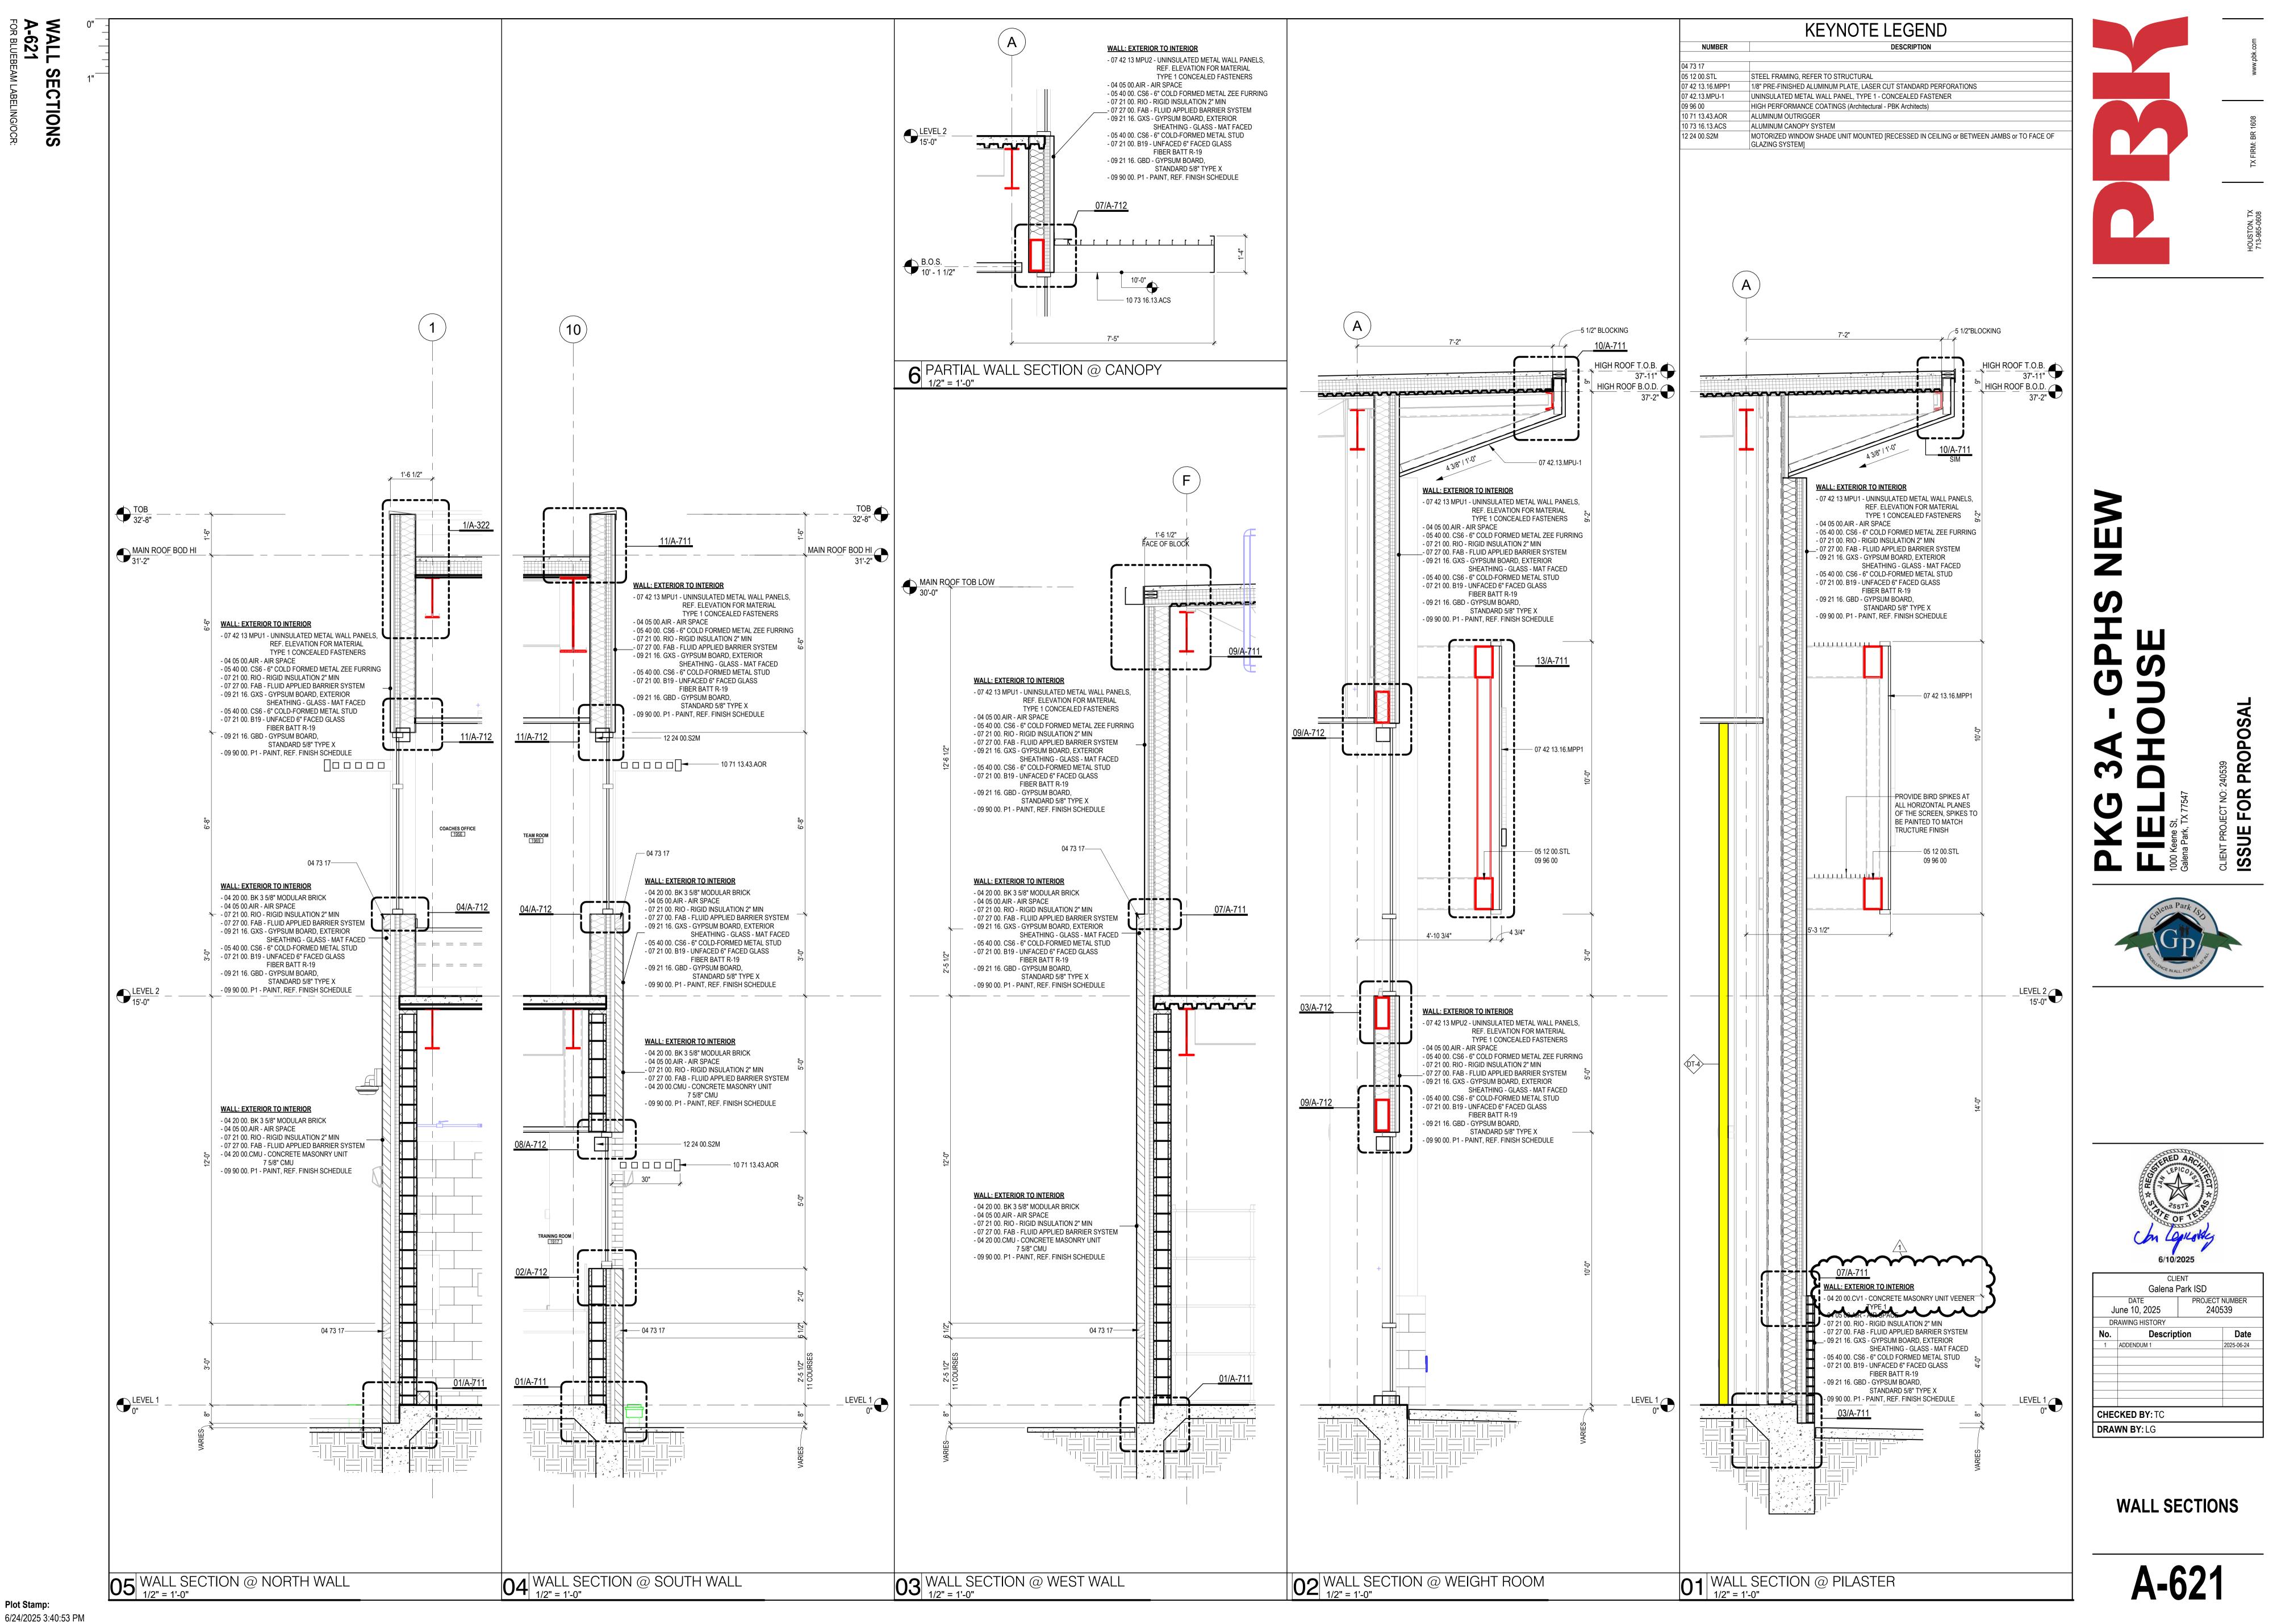

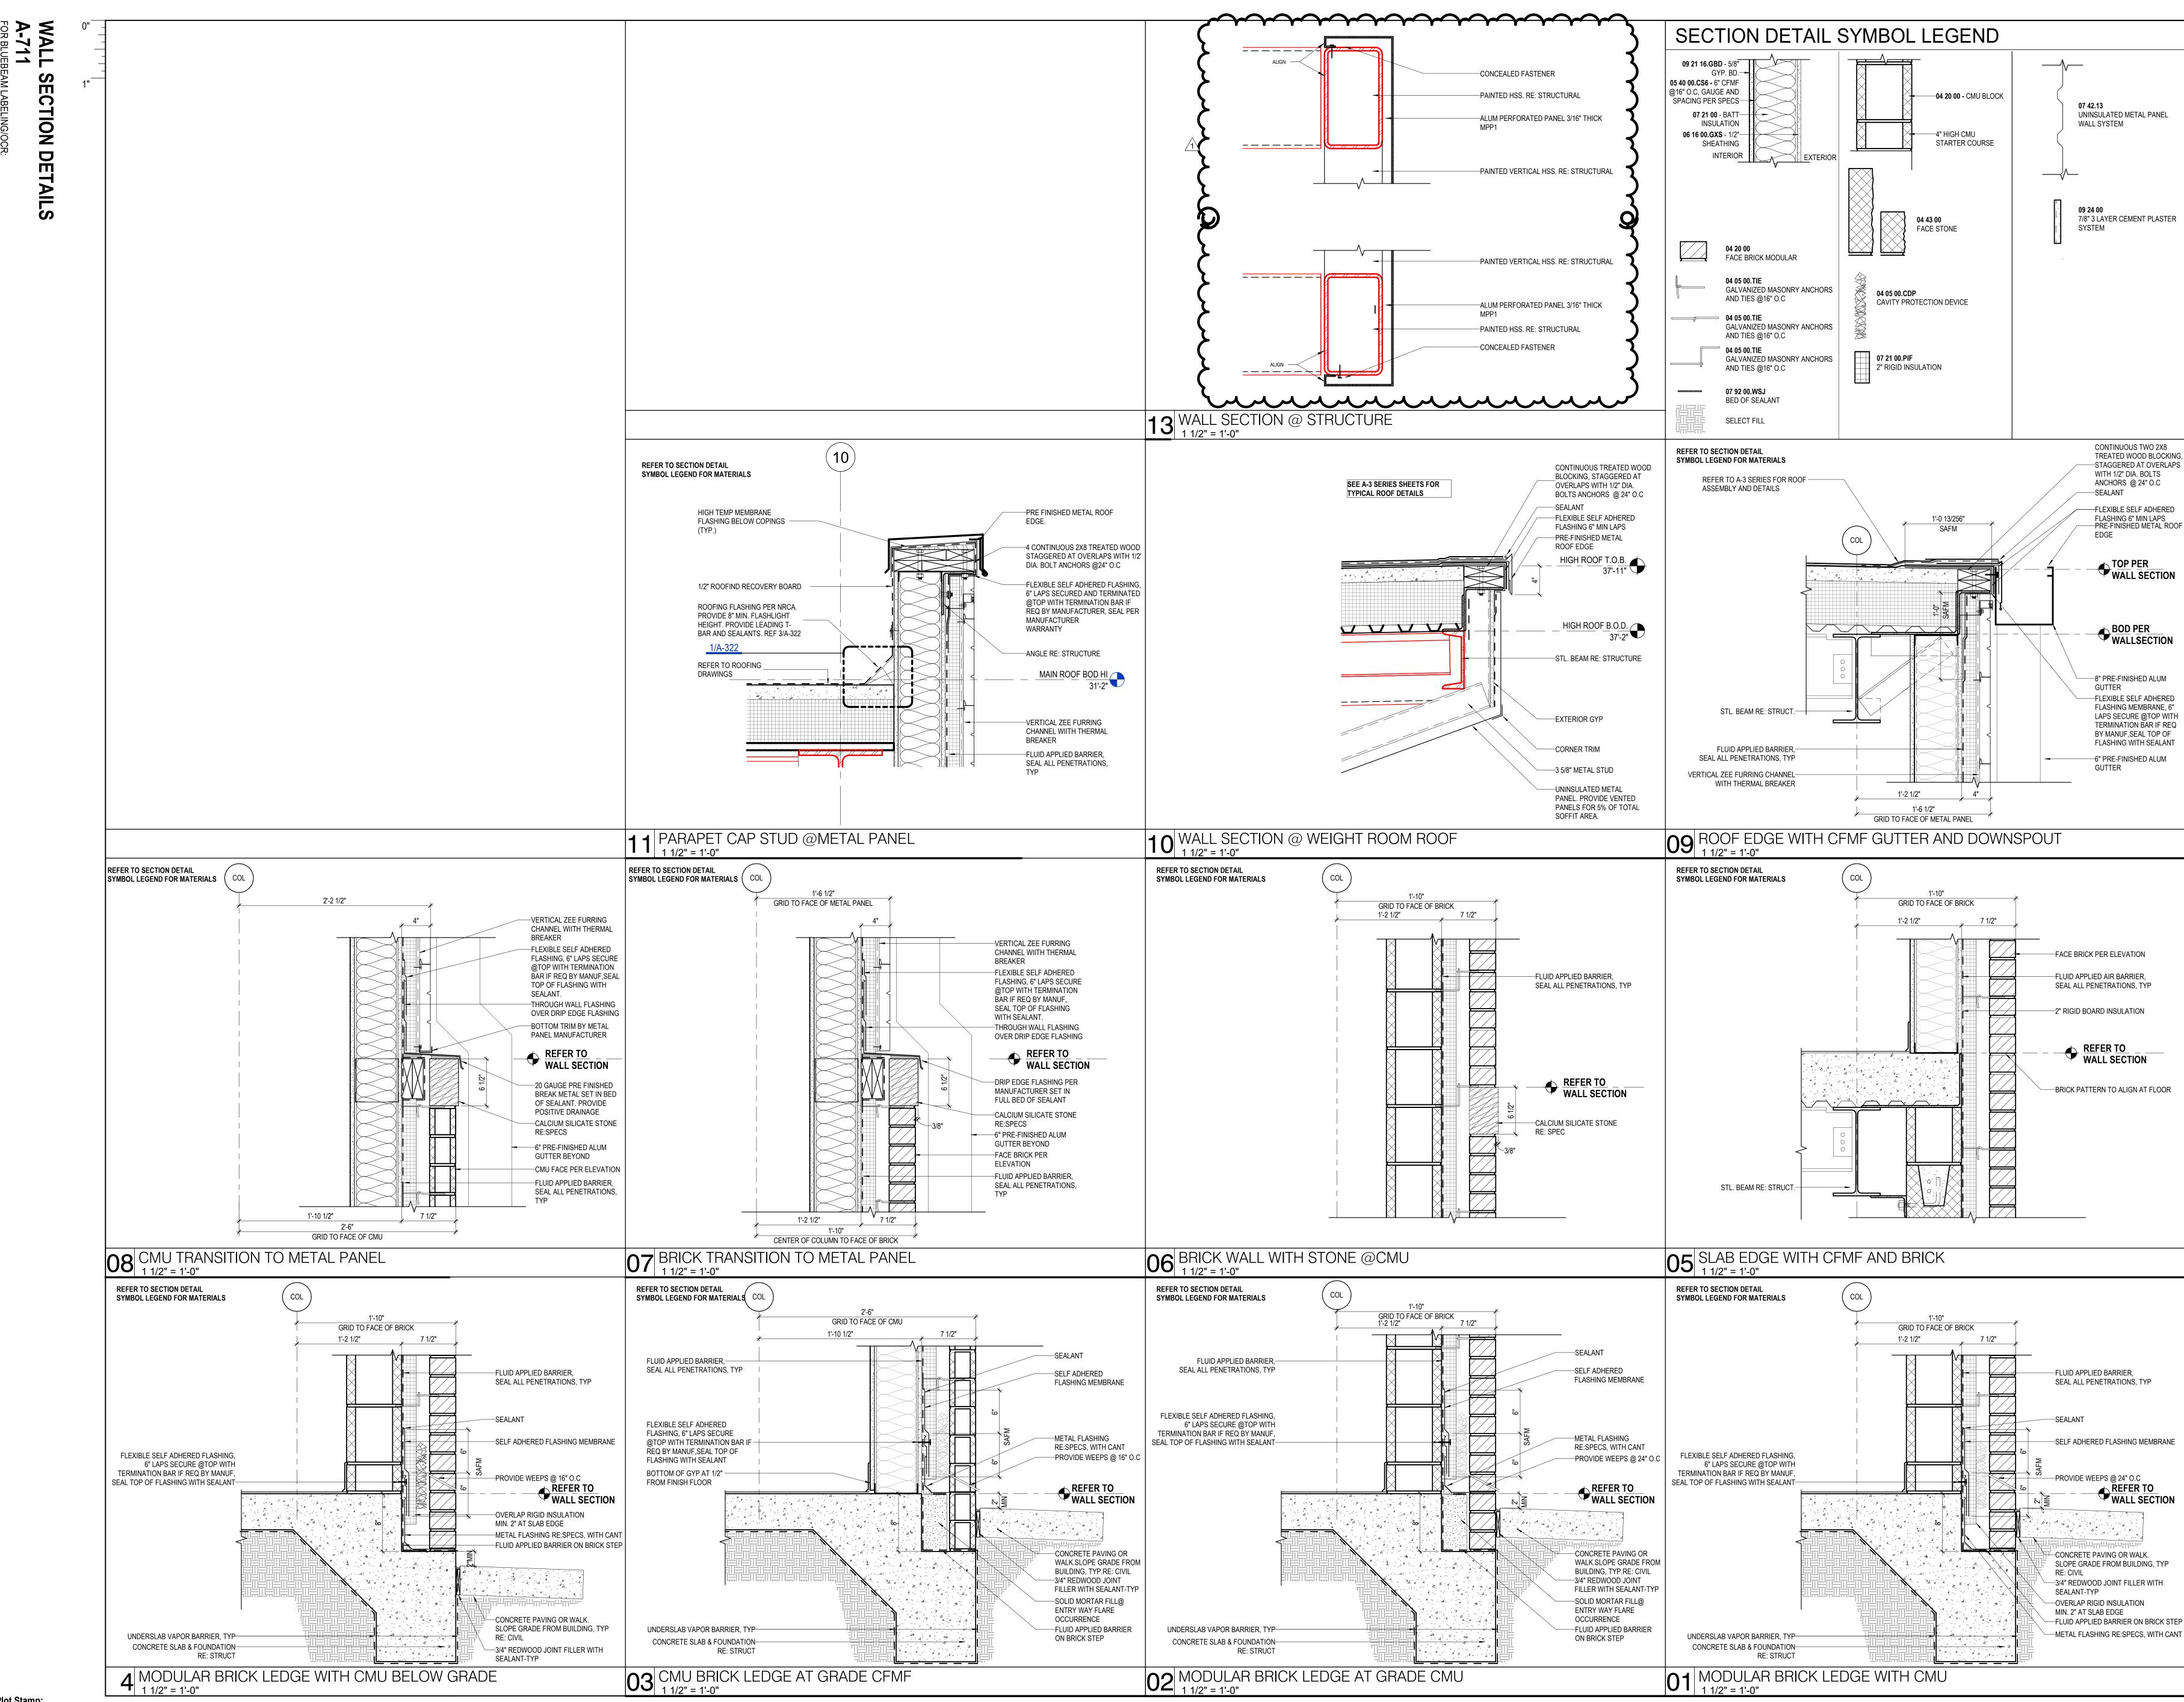



Plot Stamp:

6/25/2025 10:21:21 AM

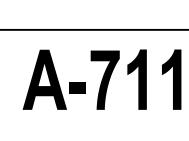




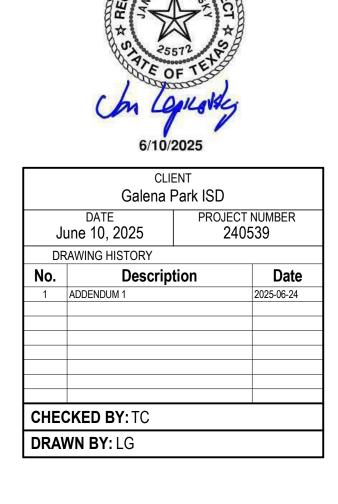


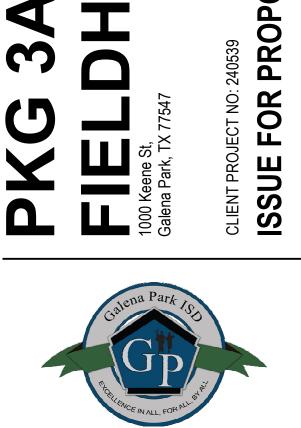



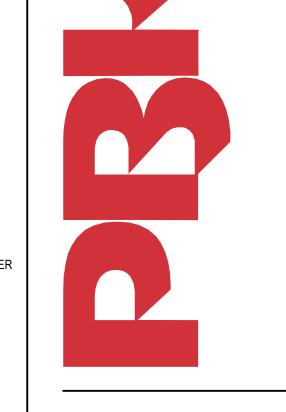



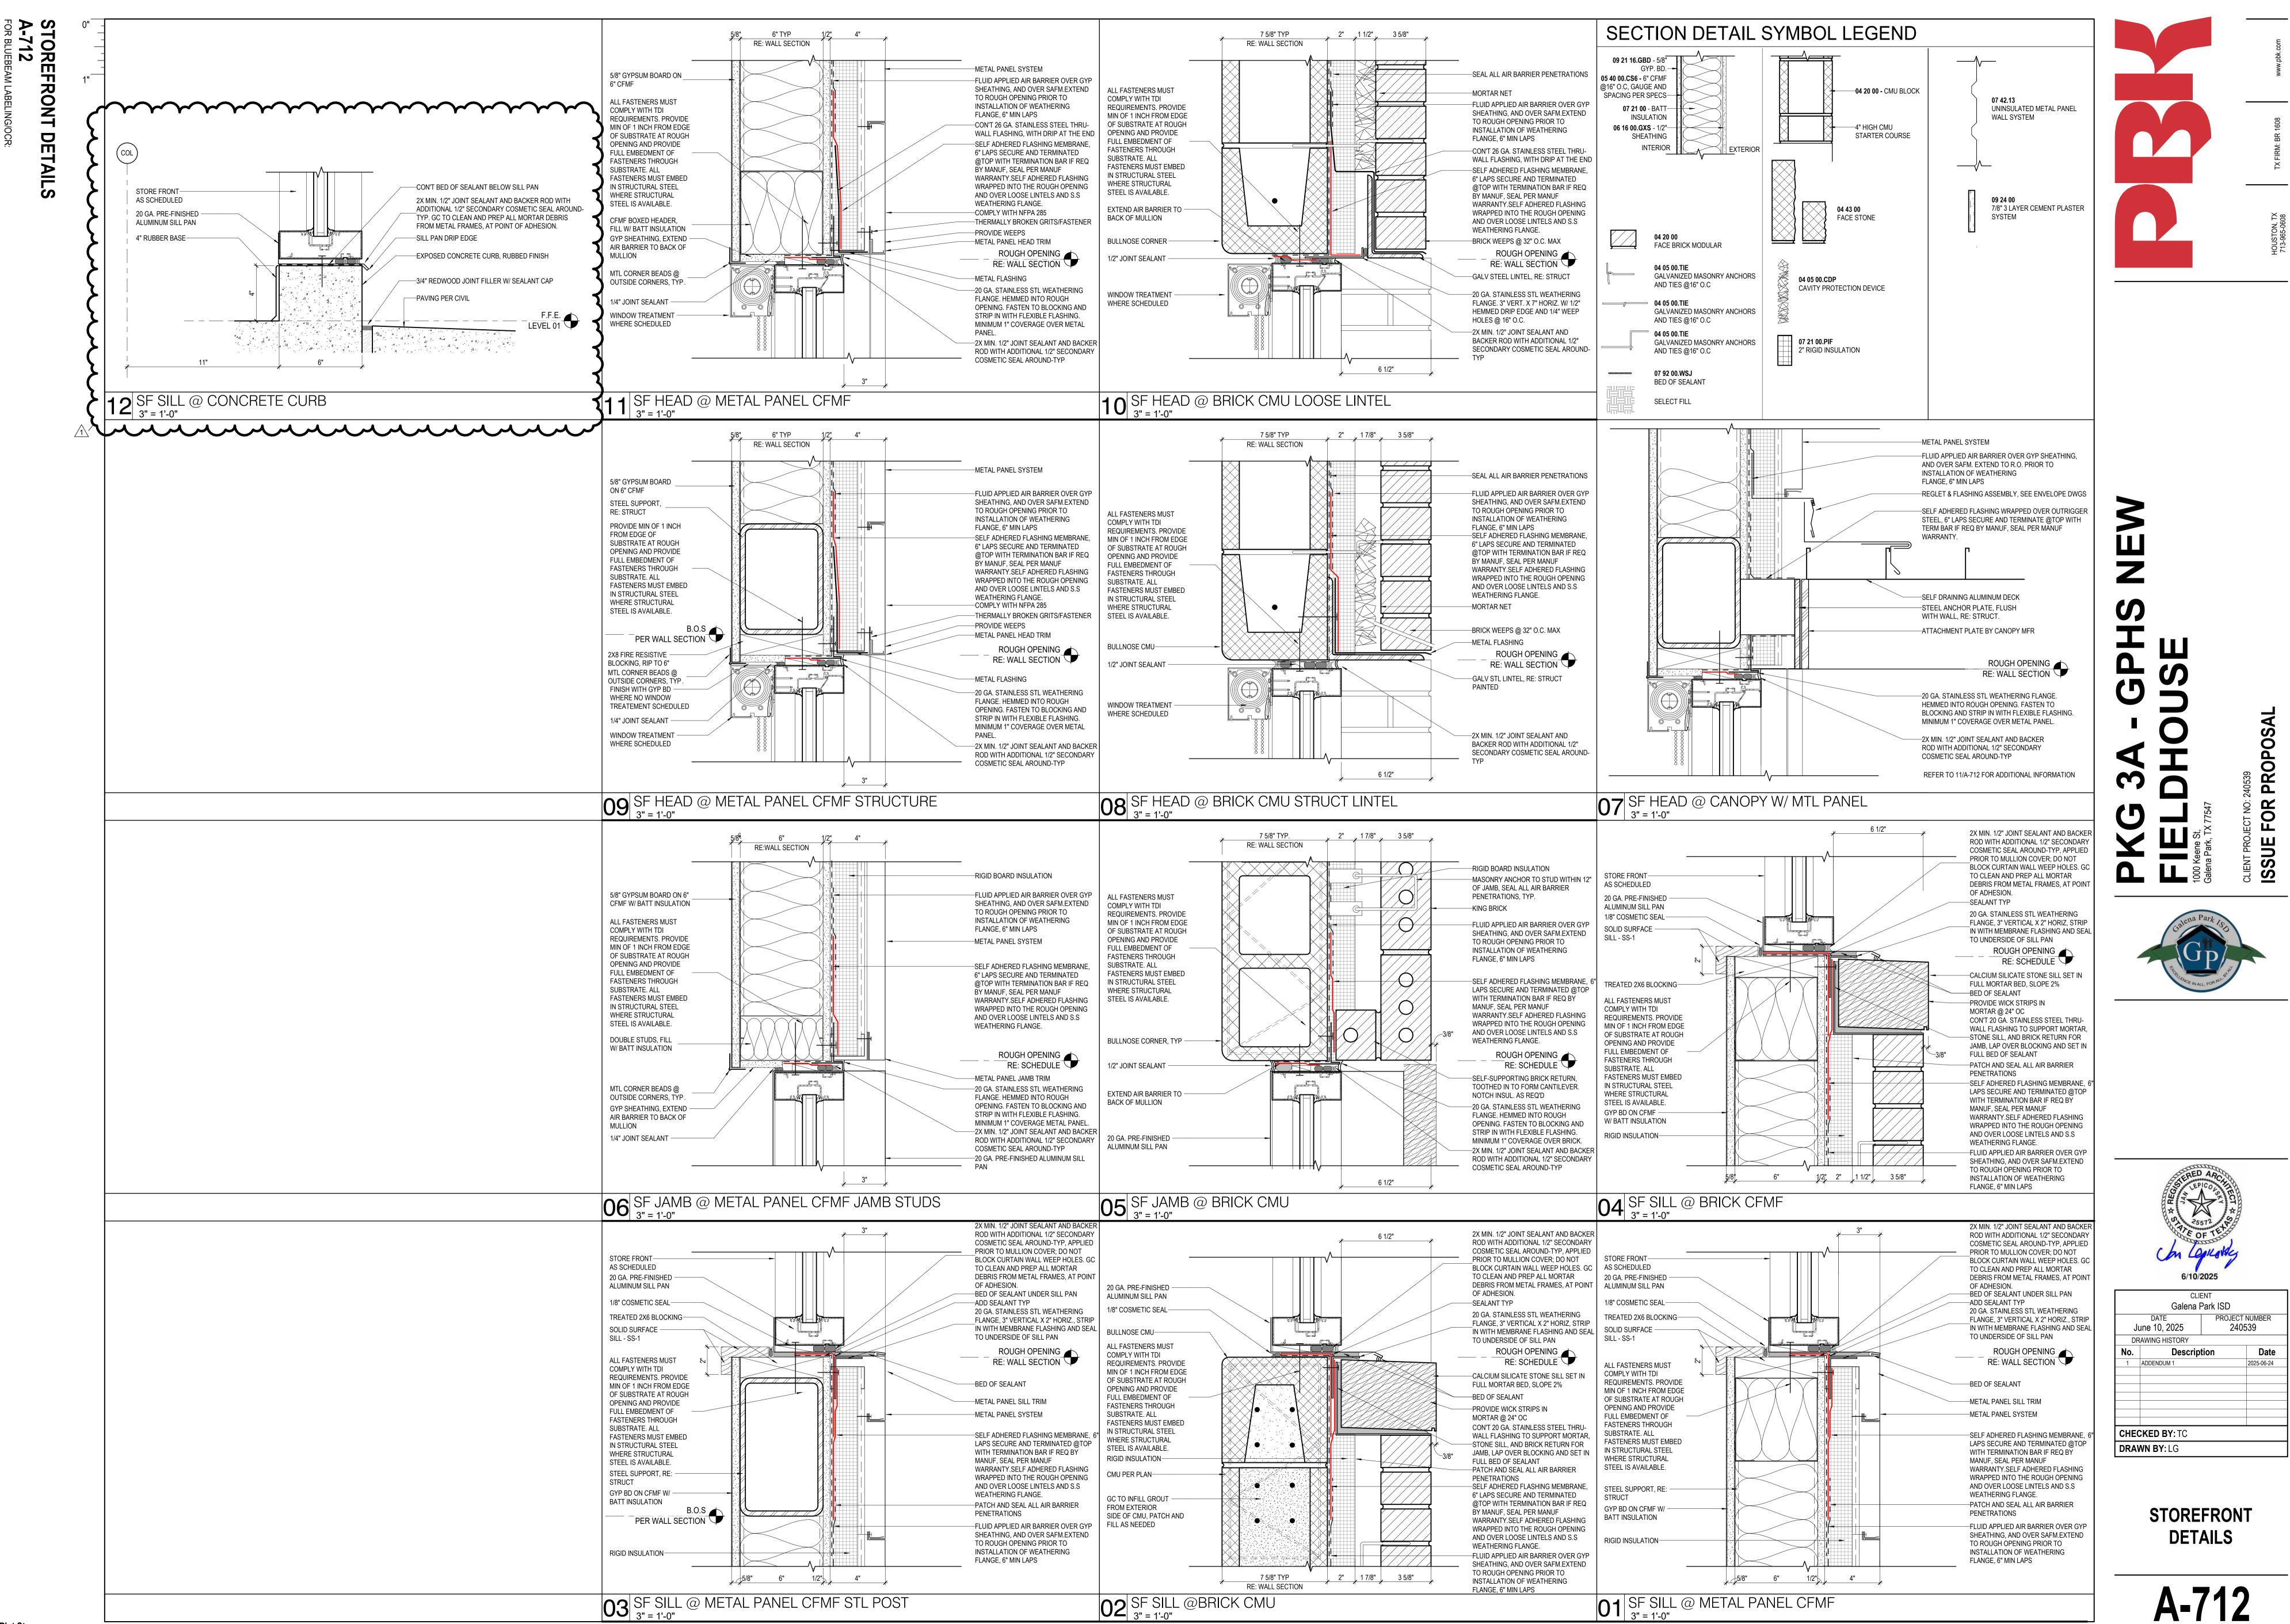

DOOR A-810 FOR BLUEBE

SCHEDULE


							DOOR SCHE	EDULE			
	DOOR			PANEL			FRAME				GENERAL
NUMBER	WIDTH	HEIGHT	TYPE	MATL	FINISH	ТҮРЕ	MATL	FIRE FINISH RATING	STC	HARDWARE SET	REMARKS
EVEL 1											
01A	3'-0"	6'-10"	F	Wood	TF-1 (Thermafoil)	001	AL-2	AL-2		111	BY DEMOUNTABLE WALL MFR
901B	3'-0"	6'-10"	F	08_Hollow Metal Doors, HM	09_Paint, PT-1	001	08_Hollow Metal Doors, HM	09_Paint, PT-1		102	
02	6'-0"	6'-10"	NV-1	08_Hollow Metal Doors, HM	09_Paint, PT-1	001	08_Hollow Metal Doors, HM	09_Paint, PT-1		101	
003	3'-0"	6'-10"	F	08_Hollow Metal Doors, HM	09_Paint, PT-1	001	08_Hollow Metal Doors, HM	09_Paint, PT-1		104	
904A	3'-0"	6'-10"	F	Wood	TF-1 (Thermafoil)	001	AL-2	AL-2		111	BY DEMOUNTABLE WALL MFR
04B	3'-0"	6'-10"	F	08_Hollow Metal Doors, HM	09_Paint, PT-1	001	08_Hollow Metal Doors, HM	09_Paint, PT-1		102	
905	3'-0"	6'-10"	F	Wood	TF-1 (Thermafoil)	001	AL-2	AL-2		107	BY DEMOUNTABLE WALL MFR
906	4'-0"	6'-10"	F	Wood	TF-1 (Thermafoil)	001	AL-2	AL-2		106	BY DEMOUNTABLE WALL MFR
907	4'-0"	6'-10"	F	08_Hollow Metal Doors, HM	09_Paint, PT-1	001	08_Hollow Metal Doors, HM	09_Paint, PT-1		104	
A800	4'-0"	6'-10"	F	Wood	TF-1 (Thermafoil)	001	AL-2	AL-2		103	
908B	6'-0"	4'-0"	OHCS	Stainless Steel	Stainless Steel		AL-2	AL-2		114	
910	3'-0"	6'-10"	F	Wood	TF-1 (Thermafoil)	001	AL-2	AL-2		111	BY DEMOUNTABLE WALL MFR
911	3'-0"	6'-10"	F	Wood	TF-1 (Thermafoil)	001	AL-2	AL-2		111	BY DEMOUNTABLE WALL MFR
912	3'-0"	6'-10"	F	Wood	TF-1 (Thermafoil)	001	AL-2	AL-2		107	BY DEMOUNTABLE WALL MFR
913	3'-0"	6'-10"	F	08_Hollow Metal Doors, HM	09_Paint, PT-1	001	08_Hollow Metal Doors, HM	09_Paint, PT-1		104	
914	3'-0"	6'-10"	F	Wood	TF-1 (Thermafoil)	001	AL-2	AL-2		111	BY DEMOUNTABLE WALL MFR
915	3'-0"	6'-10"	F	Wood	TF-1 (Thermafoil)	001	AL-2	AL-2		111	BY DEMOUNTABLE WALL MFR
916	3'-0"	6'-10"	F	Wood	TF-1 (Thermafoil)	001	AL-2	AL-2		111	BY DEMOUNTABLE WALL MFR
917A	3'-0"	6'-10"	HG-1	Wood	TF-1 (Thermafoil)	001	AL-2	AL-2		108	
917B	3'-0"	6'-10"	HG-1	Wood	TF-1 (Thermafoil)	001	AL-2	AL-2		108	
918	3'-0"	6'-10"	HG-1	Wood	TF-1 (Thermafoil)	012	AL-2	AL-2		108	
919	3'-0"	6'-10"	F	Wood	TF-1 (Thermafoil)	001	AL-2	AL-2		111	BY DEMOUNTABLE WALL MFR
920	3'-0"	6'-10"	F	Wood	TF-1 (Thermafoil)	001	AL-2	AL-2		110.1	BY DEMOUNTABLE WALL MFR
921	3'-0"	6'-10"	F	Wood	TF-1 (Thermafoil)	001	AL-2	AL-2		111	BY DEMOUNTABLE WALL MFR
922	3'-0"	6'-10"	F	Wood	TF-1 (Thermafoil)	001	AL-2	AL-2		110	
923	3'-0"	6'-10"	F	Wood	TF-1 (Thermafoil)	001	AL-2	AL-2		110	
924	3'-0"	6'-10"	F	Wood	TF-1 (Thermafoil)	001	AL-2	AL-2		106	BY DEMOUNTABLE WALL MFR
925	4'-0"	6'-10"	F	Wood	TF-1 (Thermafoil)	001	AL-2	AL-2		108	
926	3'-0"	6'-10"	F	Wood	TF-1 (Thermafoil)	001	AL-2	AL-2		110.2	BY DEMOUNTABLE WALL MFR
927A	6'-0"	7'-0"	FG-1	AL-1	ALUM	RE ELEV	AL-1	AL-1		113.1	
927B	6'-0"	7'-0"	FG-1	AL-1	ALUM	RE ELEV	AL-1	AL-1		113.1	
1900A	6'-0"	7'-0"	FG-1	AL-1	AL-1	RE ELEV	AL-1	AL-1		113	2
	6'-0"	7'-0" 7'-0"	FG-1 FG-1	AL-1	AL-1	RE ELEV RE ELEV			~~~		
							AL-1 08_Hollow Metal Doors, HM		~~~~	112	2 2 ELEVATOR MACHINE ACCESS
1900B 1000A 1 EVEL 2		7'-0" 6'-10"		AL-1 08_Hollow Metal Doors, HM	AL-1 09_Paint, PT-1		AL-1 08_Hollow Metal Doors, HM	08_Hollow Metal Doors, HM 45 Minute			
1900B 1000A EVEL 2 951	3'-0"	7'-0" 6'-10" 6'-10"	HG-1	AL-1 08_Hollow Metal Doors, HM Wood	AL-1 09_Paint, PT-1 TF-1 (Thermafoil)	NE EL EV 001	AL-2	AL-2		113 115 107	BY DEMOUNTABLE WALL MFR
1900B 1000A EVEL 2 951 952	3'-0" 3'-0"	7'-0" 6'-10" 6'-10" 6'-10"	HG-1 F	AL-1 08_Hollow Metal Doors, HM Wood Wood	AL-1 09_Paint, PT-1 TF-1 (Thermafoil) TF-1 (Thermafoil)	001 001	AL-2 AL-2	AL-2 AL-2 AL-2		113 115 107 110	BY DEMOUNTABLE WALL MFR BY DEMOUNTABLE WALL MFR
1900B 1000A EVEL 2 951 952 953	<u>6'-0"</u> <u>3'-0"</u> <u>3'-0"</u> <u>3'-0"</u>	7'-0" 6'-10" 6'-10" 6'-10" 6'-10"	HG-1 FG-1 FG-1	AL-1 08_Hollow Metal Doors, HM Wood Wood Wood	AL-1 09_Paint, PT-1 TF-1 (Thermafoil) TF-1 (Thermafoil) TF-1 (Thermafoil)	001 001 001 001 001	AL-2 AL-2 AL-2 AL-2 AL-2	AL-2 AL-2 AL-2 AL-2 AL-2		113 115 107 110 109	BY DEMOUNTABLE WALL MFR BY DEMOUNTABLE WALL MFR BY DEMOUNTABLE WALL MFR BY DEMOUNTABLE WALL MFR
1900B 1000A EVEL 2 951 952 953 954	6'-0" 3'-0" 3'-0" 3'-0" 3'-0" 3'-0"	7'-0" 6'-10" 6'-10" 6'-10" 6'-10" 6'-10"	FG-1 F HG-1 F FG-1 NV-1	AL-1 08_Hollow Metal Doors, HM Wood Wood Wood Wood	AL-1 09_Paint, PT-1 TF-1 (Thermafoil) TF-1 (Thermafoil) TF-1 (Thermafoil) TF-1 (Thermafoil) TF-1 (Thermafoil)	001 001 001 001 001 001 001	AL-2 AL-2 AL-2 AL-2 AL-2 AL-2 AL-2	AL-2 AL-2 AL-2 AL-2 AL-2 AL-2 AL-2		113 115 107 107 110 109 108	BY DEMOUNTABLE WALL MFR BY DEMOUNTABLE WALL MFR BY DEMOUNTABLE WALL MFR BY DEMOUNTABLE WALL MFR BY DEMOUNTABLE WALL MFR
1900B 1000A EVEL 2 951 952 953 954 955	3'-0" 3'-0" 3'-0" 3'-0" 3'-0" 3'-0" 3'-0"	7'-0" 6'-10" 6'-10" 6'-10" 6'-10" 6'-10" 6'-10"	FG-1 F HG-1 F FG-1 NV-1 NV-1	AL-1 08_Hollow Metal Doors, HM Wood Wood Wood Wood Wood	AL-1 09_Paint, PT-1 TF-1 (Thermafoil)	001 001 001 001 001 001 001 001	AL-2 AL-2 AL-2 AL-2 AL-2 AL-2 AL-2 AL-2	AL-2 AL-2 AL-2 AL-2 AL-2 AL-2 AL-2 AL-2		113 115 107 107 110 109 108 108	BY DEMOUNTABLE WALL MFR BY DEMOUNTABLE WALL MFR
1900B 1000A EVEL 2 951 952 953 954 955 956A	3'-0" 3'-0" 3'-0" 3'-0" 3'-0" 3'-0" 3'-0"	7'-0" 6'-10" 6'-10" 6'-10" 6'-10" 6'-10" 6'-10" 6'-10"	FG-1 F HG-1 F FG-1 NV-1 NV-1 HG-1	AL-1 08_Hollow Metal Doors, HM Wood Wood Wood Wood Wood Wood Wood	AL-1 09_Paint, PT-1 TF-1 (Thermafoil)	001 001 001 001 001 001 001 001 001	AL-1 08_Hollow Metal Doors, HM AL-2 AL-2 AL-2 AL-2 AL-2 AL-2 AL-2 AL-2	AL-2 AL-2 AL-2 AL-2 AL-2 AL-2 AL-2 AL-2		113 115 115 115 107 107 110 109 108 108 107 108	BY DEMOUNTABLE WALL MFR BY DEMOUNTABLE WALL MFR
1900B 1000A EVEL 2 951 952 953 954 955 956A 956B	6'-0" 3'-0" 3'-0" 3'-0" 3'-0" 3'-0" 3'-0" 3'-0" 3'-0" 3'-0" 3'-0" 3'-0" 3'-0" 3'-0" 3'-0" 3'-0"	7'-0" 6'-10" 6'-10" 6'-10" 6'-10" 6'-10" 6'-10" 6'-10" 6'-10"	FG-1 F FG-1 FG-1 NV-1 HG-1 HG-1	AL-1 08_Hollow Metal Doors, HM Wood Wood Wood Wood Wood Wood Wood Woo	AL-1 09_Paint, PT-1 TF-1 (Thermafoil) TF-1 (Thermafoil) TF-1 (Thermafoil) TF-1 (Thermafoil) TF-1 (Thermafoil) TF-1 (Thermafoil) TF-1 (Thermafoil)	RE ELEV 001 001 001 001 001 001 001 001 001 001 001 001 001 001 001	AL-2 AL-2 AL-2 AL-2 AL-2 AL-2 AL-2 AL-2	AL-2 AL-2 AL-2 AL-2 AL-2 AL-2 AL-2 AL-2		113 115 107 107 100 109 108 107 108 107 107	BY DEMOUNTABLE WALL MFR BY DEMOUNTABLE WALL MFR
1900B 1000A EVEL 2 951 952 953 954 955 956A 956B 957	6'-0" 3'-0" 3'-0" 3'-0" 3'-0" 3'-0" 3'-0" 3'-0" 3'-0" 3'-0" 3'-0" 3'-0" 3'-0" 3'-0" 3'-0" 3'-0"	7'-0" 6'-10" 6'-10" 6'-10" 6'-10" 6'-10" 6'-10" 6'-10" 6'-10"	FG-1 F FG-1 FG-1 NV-1 NV-1 HG-1 HG-1 F	AL-1 08_Hollow Metal Doors, HM Wood Wood Wood Wood Wood Wood Wood Woo	AL-1 09_Paint, PT-1 TF-1 (Thermafoil)	RE ELEV 001 001 001 001 001 001 001 001 001 001 001 001 001 001 001 001 001 001 001	AL-1 08_Hollow Metal Doors, HM AL-2 AL-2 AL-2 AL-2 AL-2 AL-2 AL-2 AL-2	AL-2 AL-2 AL-2 AL-2 AL-2 AL-2 AL-2 AL-2		113 115 107 107 100 109 108 107 108 107 108 107 108 107 108 107 108	BY DEMOUNTABLE WALL MFR BY DEMOUNTABLE WALL MFR
1900B 1000A EVEL 2 951 952 953 954 955 956A 956B 957 958	3'-0" 3'-0" 3'-0" 3'-0" 3'-0" 3'-0" 3'-0" 3'-0" 3'-0" 3'-0" 3'-0" 3'-0" 3'-0" 3'-0" 3'-0" 3'-0"	7'-0" 6'-10" 6'-10" 6'-10" 6'-10" 6'-10" 6'-10" 6'-10" 6'-10" 6'-10"	FG-1 F HG-1 F FG-1 NV-1 HG-1 HG-1 F NV-1 NV-1	AL-1 08_Hollow Metal Doors, HM Wood Wood Wood Wood Wood Wood Wood Woo	AL-1 09_Paint, PT-1 09_Faint, PT-1 TF-1 (Thermafoil)	BE ELEV 001 001	AL-1 08_Hollow Metal Doors, HM AL-2 AL-2 113 115 107 107 100 109 108 107 108 107 108 107 108 107 108 107 108 108 108 108	BY DEMOUNTABLE WALL MFR BY DEMOUNTABLE WALL MFR
1900B 1000A EVEL 2 951 952 953 954 955 956A 956A 956B 957 958 959	6'-0" 3'-0" 3'-0" 3'-0" 3'-0" 3'-0" 3'-0" 3'-0" 3'-0" 3'-0" 3'-0" 3'-0" 3'-0" 3'-0" 3'-0" 3'-0" 3'-0" 3'-0" 3'-0"	7'-0" 6'-10" 6'-10" 6'-10" 6'-10" 6'-10" 6'-10" 6'-10" 6'-10" 6'-10" 6'-10"	FG-1 F HG-1 F FG-1 NV-1 HG-1 HG-1 HG-1 HG-1 F NV-1 NV-1	AL-1 08_Hollow Metal Doors, HM Wood Wood Wood Wood Wood Wood Wood Woo	AL-1 09_Paint, PT-1 09_Paint, PT-1 TF-1 (Thermafoil)	BE ELEV 001 001	AL-1 08_Hollow Metal Doors, HM AL-2 AL-2 113 115 107 107 109 108 107 108 107 108 107 108 107 108 107 108 108 108 108 108	BY DEMOUNTABLE WALL MFR BY DEMOUNTABLE WALL MFR
1900B 1000A EVEL 2 951 952 953 954 955 956A 956B 957 958 959 960	6'-0" 3'-0"	7'-0" 6'-10" 6'-10" 6'-10" 6'-10" 6'-10" 6'-10" 6'-10" 6'-10" 6'-10" 6'-10" 6'-10"	FG-1 F FG-1 FG-1 NV-1 HG-1 HG-1 F NV-1 NV-1 NV-1 F	AL-1 08_Hollow Metal Doors, HM Wood Wood Wood Wood Wood Wood Wood Woo	AL-1 09_Paint, PT-1 09_Paint, PT-1 TF-1 (Thermafoil)	RE ELEV 001	AL-1 08_Hollow Metal Doors, HM AL-2 AL-2 113 115 107 107 100 109 108 107 108 107 108 107 108 107 108 107 108 108 108 108 108 108 108 108 108 108 108	BY DEMOUNTABLE WALL MFR BY DEMOUNTABLE WALL MFR
1900B 1000A EVEL 2 951 952 953 954 955 956A 956B 956B 957 958 959 960 960	3'-0" 3'-0"	7'-0" 6'-10" 6'-10" 6'-10" 6'-10" 6'-10" 6'-10" 6'-10" 6'-10" 6'-10" 6'-10" 6'-10" 6'-10" 6'-10"	FG-1 F HG-1 F FG-1 NV-1 HG-1 HG-1 F NV-1 NV-1 F NV-1 F F	AL-1 08_Hollow Metal Doors, HM Wood Wood Wood Wood Wood Wood Wood Woo	AL-1 09_Paint, PT-1 09_Faint, PT-1 TF-1 (Thermafoil)	BE ELEV 001 001	AL-1 08_Hollow Metal Doors, HM AL-2	AL-2 AL-2 AL-2 AL-2 AL-2 AL-2 AL-2 AL-2		113 115 107 107 100 109 108 107 108 107 108 107 108 107 108 108 108 108 108 108 108 108 108 108 108 108 108 106 106	BY DEMOUNTABLE WALL MFR BY DEMOUNTABLE WALL MFR
1900B 1000A EVEL 2 951 952 953 955 956A 9555 956A 9556B 957 958 959 960 960 961 962	6'-0" 3'-0"	7'-0" 6'-10" 6'-10" 6'-10" 6'-10" 6'-10" 6'-10" 6'-10" 6'-10" 6'-10" 6'-10" 6'-10" 6'-10" 6'-10"	FG-1 F HG-1 F FG-1 NV-1 HG-1 HG-1 HG-1 F NV-1 NV-1 F F F F	AL-1 08_Hollow Metal Doors, HM Wood Wood Wood Wood Wood Wood Wood Woo	AL-1 09_Paint, PT-1 09_Paint, PT-1 TF-1 (Thermafoil)	BE ELEV 001 001	AL-1 08_Hollow Metal Doors, HM AL-2	AL-1 45 Minute 08_Hollow Metal Doors, HM 45 Minute AL-2 45 Minute		113 115 107 107 110 109 108 107 108 107 108 107 108 107 108 108 108 108 108 108 108 108 108 108 106 106 106	BY DEMOUNTABLE WALL MFR BY DEMOUNTABLE WALL MFR
1900B 1000A EVEL 2 951 952 953 954 955 956A 956B 957 956B 957 958 959 960 961 962 963	6'-0" 3'-0" 4'-0" 4'-0"	7'-0" 6'-10" 6'-10" 6'-10" 6'-10" 6'-10" 6'-10" 6'-10" 6'-10" 6'-10" 6'-10" 6'-10" 6'-10" 6'-10" 6'-10"	FG-1 F HG-1 F FG-1 NV-1 HG-1 HG-1 HG-1 HG-1 HG-1 F NV-1 NV-1 F F F F F	AL-1 08_Hollow Metal Doors, HM Wood Wood Wood Wood Wood Wood Wood Woo	AL-1 09_Paint, PT-1 09_Paint, PT-1 TF-1 (Thermafoil)	BE ELEV 001 001	AL-1 08_Hollow Metal Doors, HM AL-2	AL-1 45 Minute 08_Hollow Metal Doors, HM 45 Minute AL-2 45 Minute		113 115 107 107 109 108 107 108 107 108 107 108 107 108 107 108 106 106 103	BY DEMOUNTABLE WALL MFR BY DEMOUNTABLE WALL MFR
1900B 1000A EVEL 2 951 952 953 954 955 956A 956B 957 958 959 960 960 961 962 963 964	6'-0" 3'-0"	7'-0" 6'-10" 6'-10" 6'-10" 6'-10" 6'-10" 6'-10" 6'-10" 6'-10" 6'-10" 6'-10" 6'-10" 6'-10" 6'-10" 6'-10" 6'-10"	FG-1 F HG-1 F FG-1 NV-1 HG-1 HG-1 HG-1 F NV-1 NV-1 F F F F	AL-1 08_Hollow Metal Doors, HM Wood Wood Wood Wood Wood Wood Wood Woo	AL-1 09_Paint, PT-1 09_Paint, PT-1 TF-1 (Thermafoil)	RE ELEV 001	AL-1 08_Hollow Metal Doors, HM AL-2	AL-1 45 Minute 08_Hollow Metal Doors, HM 45 Minute AL-2 41 Minute		113 115 107 107 110 109 108 107 108 107 108 107 108 107 108 107 108 106 106 103 110.3	BY DEMOUNTABLE WALL MFR BY DEMOUNTABLE WALL MFR
1900B 1000A EVEL 2 951 952 953 954 955 956A 956B 957 958 959 960 961 962 963 964 965	6'-0" 3'-0"	7'-0" 6'-10" 6'-10" 6'-10" 6'-10" 6'-10" 6'-10" 6'-10" 6'-10" 6'-10" 6'-10" 6'-10" 6'-10" 6'-10" 6'-10" 6'-10" 6'-10"	FG-1 F HG-1 F FG-1 NV-1 HG-1 HG-1 HG-1 F NV-1 F F F F F F F	AL-1 08_Hollow Metal Doors, HM Wood Wood Wood Wood Wood Wood Wood Woo	AL-1 09_Paint, PT-1 09_TF-1 (Thermafoil) TF-1 (Thermafoil) TF-1 (Thermafoil) <	BE ELEV 001 001	AL-1 08_Hollow Metal Doors, HM AL-2	AL-1 45 Minute 08_Hollow Metal Doors, HM 45 Minute AL-2 45 Minute		113 115 107 107 110 109 108 107 108 107 108 107 108 107 106 106 103 110.3	BY DEMOUNTABLE WALL MFR BY DEMOUNTABLE WALL MFR
1900B 1000A EVEL 2 951 952 953 955 956A 955 956B 957 958 959 960 961 962 966 963 964 965 966	6'-0" 3'-0" 4'-0" 3'-0" 3'-0" 4'-0" 3'-0" 3'-0"	7'-0" 6'-10" 6'-10" 6'-10" 6'-10" 6'-10" 6'-10" 6'-10" 6'-10" 6'-10" 6'-10" 6'-10" 6'-10" 6'-10" 6'-10" 6'-10" 6'-10" 6'-10"	FG-1 F HG-1 F FG-1 NV-1 NV-1 HG-1 HG-1 HG-1 F F F F F F F F F F F F F	AL-1 08_Hollow Metal Doors, HM Wood Wood Wood Wood Wood Wood Wood Woo	AL-1 09_Paint, PT-1 09_Paint, PT-1 TF-1 (Thermafoil) TF-1 (BE ELEV 001 001	AL-1 08_Hollow Metal Doors, HM AL-2	AL-1 45 Minute 08_Hollow Metal Doors, HM 45 Minute AL-2 45 Minut		113 115 107 107 110 109 108 107 108 107 108 107 108 107 108 106 103 110.3 106	ELEVATOR MACHINE ACCESS ELEVATOR MACHINE ACCESS BY DEMOUNTABLE WALL MFR BY DEMOUNTABLE WALL MFR
1900B 1000A EVEL 2 951 952 953 954 955 956A 956B 957 956B 957 958 959 960 961 962 963 964 965 966 966B	6'-0" 3'-0"	7'-0" 6'-10" 6'-10" 6'-10" 6'-10" 6'-10" 6'-10" 6'-10" 6'-10" 6'-10" 6'-10" 6'-10" 6'-10" 6'-10" 6'-10" 6'-10" 6'-10" 6'-10" 6'-10"	FG-1 F HG-1 F FG-1 NV-1 NV-1 HG-1 HG-1 HG-1 F F F F F F F F F F	AL-1 08_Hollow Metal Doors, HM Wood Wood Wood Wood Wood Wood Wood Woo	AL-1 09_Paint, PT-1 09_Paint, PT-1 TF-1 (Thermafoil) TF-1 (BE ELEV 001 001	AL-1 08_Hollow Metal Doors, HM AL-2	AL:1 45 Minute 08_Hollow Metal Doors, HM 45 Minute AL-2 45 Minut		113 115 115 115 107 110 109 108 108 107 108 107 107 108 107 106 106 103 110.3 110.3 106 106	ELEVATOR MACHINE ACCESS ELEVATOR MACHINE ACCESS BY DEMOUNTABLE WALL MFR BY DEMOUNTABLE WALL MFR
1900B 1000A EVEL 2 951 952 953 954 955 956A 956B 957 958 959 960 961 962 961 962 963 964 965 966 966 966 966 966 967	6'-0" 3'-0" 3'-0" 3'-0" 3'-0" 3'-0" 3'-0" 3'-0" 3'-0" 3'-0" 3'-0" 3'-0" 3'-0" 3'-0" 3'-0" 3'-0" 3'-0" 3'-0" 3'-0" 3'-0" 4'-0" 4'-0" 4'-0" 4'-0" 4'-0" 4'-0"	7'-0" 6'-10" 6'-10" 6'-10" 6'-10" 6'-10" 6'-10" 6'-10" 6'-10" 6'-10" 6'-10" 6'-10" 6'-10" 6'-10" 6'-10" 6'-10" 6'-10" 6'-10" 6'-10"	FG-1 F HG-1 F FG-1 NV-1 NV-1 HG-1 HG-1 F NV-1 NV-1 F F F F F F F F F F F F F F F	AL-1 08_Hollow Metal Doors, HM Wood Wood Wood Wood Wood Wood Wood Woo	AL-1 09_Paint, PT-1 09_Faint, PT-1 TF-1 (Thermafoil) TF-1 (BE ELEV 001 001	AL-1 08_Hollow Metal Doors, HM AL-2	AL-1 45 Minute 08_Hollow Metal Doors, HM 45 Minute AL-2 45 Minute AL-2 1 AL-2 1 <t< td=""><td></td><td>113 115 107 107 110 109 108 107 108 107 108 107 108 107 108 106 103 110.3 106</td><td>ELEVATOR MACHINE ACCESS ELEVATOR MACHINE ACCESS BY DEMOUNTABLE WALL MFR BY DEMOUNTABLE WALL MFR</td></t<>		113 115 107 107 110 109 108 107 108 107 108 107 108 107 108 106 103 110.3 106	ELEVATOR MACHINE ACCESS ELEVATOR MACHINE ACCESS BY DEMOUNTABLE WALL MFR BY DEMOUNTABLE WALL MFR
1900B 10000A EVEL 2 951 952 953 955 956A 9555 956B 957 958 959 960 961 962 9661 9662 9663 9665 9666 9666 9666 9667 968A	6'-0" 3'-0" 4'-0" 4'-0" 4'-0" 4'-0" 4'-0" 4'-0"	7'-0" 6'-10"	FG-1 F HG-1 F FG-1 NV-1 NV-1 HG-1 HG-1 HG-1 HG-1 F F F F F F F F F F F F F F F	AL-1 08_Hollow Metal Doors, HM Wood Wood Wood Wood Wood Wood Wood Woo	AL-1 09_Paint, PT-1 09_Paint, PT-1 TF-1 (Thermafoil) TF-1 (BE ELEV 001 001	AL-1 08_Hollow Metal Doors, HM AL-2	AL:1 45 Minute 08_Hollow Metal Doors, HM 45 Minute AL-2 45 Minut		113 115 107 107 110 109 108 107 108 107 108 107 108 107 108 107 108 107 108 108 108 108 108 108 108 108 108 108 108 108 108 108 108 106 1013 110.3 106 106 106 106 106	BY DEMOUNTABLE WALL MFR BY DEMOUNTABLE WALL MFR
1900B 1000A EVEL 2 951 952 953 954 955 956A 955 956B 957 958 959 960 961 962 960 961 962 963 964 965 966 966 966 966 966 966 966 966 966	6'-0" 3'-0" 4'-0" 4'-0" 4'-0" 4'-0" 4'-0" 3'-0"	7'-0" 6'-10" 6'-10" 6'-10" 6'-10" 6'-10" 6'-10" 6'-10" 6'-10" 6'-10" 6'-10" 6'-10" 6'-10" 6'-10" 6'-10" 6'-10" 6'-10" 6'-10" 6'-10"	FG-1 F HG-1 F FG-1 NV-1 NV-1 HG-1 HG-1 F F F F F F F F F F F F F F F F F F F	AL-1 08_Hollow Metal Doors, HM Wood Wood Wood Wood Wood Wood Wood Woo	AL-1 09_Paint, PT-1 09_Faint, PT-1 TF-1 (Thermafoil) TF-1 (BE ELEV 001 001	AL-1 08_Hollow Metal Doors, HM AL-2	AL:1 45 Minute 08_Hollow Metal Doors, HM 45 Minute AL-2 45 Minut		113 115 107 107 110 109 108 107 108 107 108 107 108 107 106 106 103 110.3 106 106 106 106 106 106 107	ELEVATOR MACHINE ACCESS ELEVATOR MACHINE ACCESS BY DEMOUNTABLE WALL MFR BY DEMOUNTABLE WALL MFR
1900B 1000A EVEL 2 951 952 953 954 955 956A 955 956A 955 956B 957 958 959 960 961 962 966 966 966 966 966 966 966 966 966	6'-0" 3'-0" 3'-0" 3'-0" 3'-0" 3'-0" 3'-0" 3'-0" 3'-0" 3'-0" 3'-0" 3'-0" 3'-0" 3'-0" 3'-0" 3'-0" 3'-0" 3'-0" 3'-0" 4'-0" 4'-0" 4'-0" 4'-0" 4'-0" 3'-0" 3'-0" 3'-0" 3'-0" 3'-0" 3'-0" 3'-0" 3'-0" 3'-0" 3'-0" 3'-0" 3'-0" 3'-0" 3'-0" 3'-0"	7'-0" 6'-10"	FG-1 F HG-1 F FG-1 NV-1 NV-1 HG-1 HG-1 F F F F F F F F F F F F F F HG-1 HG-1 HG-1	AL-1 08_Hollow Metal Doors, HM Wood Wood Wood Wood Wood Wood Wood Woo	AL-1 09_Paint, PT-1 09_Paint, PT-1 TF-1 (Thermafoil) TF-1 (BE ELEV 001 001	AL-1 08_Hollow Metal Doors, HM AL-2	AL:1 45 Minute 08_Hollow Metal Doors, HM 45 Minute AL-2 45 Minute AL-2 1 AL-2 1 <t< td=""><td></td><td>113 115 107 1 107 1 109 1 108 1 107 1 108 1 107 1 108 1 107 1 108 1 108 1 108 1 108 1 108 1 108 1 108 1 108 1 108 1 108 1 106 1 106 1 106 1 106 1 106 1 107 1 107 1 107 1</td><td>BY DEMOUNTABLE WALL MFR BY DEMOUNTABLE WALL MFR</td></t<>		113 115 107 1 107 1 109 1 108 1 107 1 108 1 107 1 108 1 107 1 108 1 108 1 108 1 108 1 108 1 108 1 108 1 108 1 108 1 108 1 106 1 106 1 106 1 106 1 106 1 107 1 107 1 107 1	BY DEMOUNTABLE WALL MFR BY DEMOUNTABLE WALL MFR
1900B 1000A EVEL 2 951 952 953 954 955 956A 955 956B 957 956B 957 958 959 960 961 962 961 962 963 964 965 966 966B 976B 976B 976B 976B 976B 976B 976B 976B 976B 976	6'-0" 3'-0" 4'-0" 4'-0" 4'-0" 4'-0" 3'-0" 3'-0" 3'-0" 3'-0" 3'-0" 3'-0" 3'-0" 3'-0" 3'-0" 3'-0" 3'-0" 3'-0" 3'-0" 3'-0"	7'-0" 6'-10"	FG-1 F HG-1 F FG-1 NV-1 NV-1 HG-1 HG-1 F F F F F F F F F F F F F F F F F F F	AL-1 08_Hollow Metal Doors, HM Wood Wood Wood Wood Wood Wood Wood Woo	AL-1 09_Paint, PT-1 09_Paint, PT-1 TF-1 (Thermafoil) TF-1 (BE ELEV 001 001	AL-1 08_Hollow Metal Doors, HM AL-2	AL:1 45 Minute 08_Hollow Metal Doors, HM 45 Minute AL-2 45 Minute AL-2 1 AL-2 1 <t< td=""><td></td><td>113 Image: mail of the system 107 1 107 1 109 1 108 1 107 1 108 1 107 1 108 1 107 1 108 1 108 1 108 1 108 1 108 1 108 1 108 1 108 1 108 1 108 1 106 1 106 1 106 1 106 1 107 1 107 1 107 1 107 1</td><td>ELEVATOR MACHINE ACCESS ELEVATOR MACHINE ACCESS BY DEMOUNTABLE WALL MFR BY DEMOUNTABLE WALL MFR</td></t<>		113 Image: mail of the system 107 1 107 1 109 1 108 1 107 1 108 1 107 1 108 1 107 1 108 1 108 1 108 1 108 1 108 1 108 1 108 1 108 1 108 1 108 1 106 1 106 1 106 1 106 1 107 1 107 1 107 1 107 1	ELEVATOR MACHINE ACCESS ELEVATOR MACHINE ACCESS BY DEMOUNTABLE WALL MFR BY DEMOUNTABLE WALL MFR
1900B 1000A EVEL 2 951 952 953 955 956A 955 956B 957 958 959 960 961 962 966 966 966 966 966B 967 968A 966B 967 968B 969A 969B 970A	3'-0" 3'-0" 3'-0" 3'-0" 3'-0" 3'-0" 3'-0" 3'-0" 3'-0" 3'-0" 3'-0" 3'-0" 3'-0" 3'-0" 3'-0" 3'-0" 3'-0" 3'-0" 3'-0" 4'-0" 4'-0" 4'-0" 4'-0" 3'-0" 3'-0" 3'-0" 3'-0" 3'-0" 3'-0" 3'-0" 3'-0" 3'-0" 3'-0" 3'-0" 3'-0" 3'-0" 3'-0" 3'-0" 3'-0" 3'-0"	7'-0" 6'-10"	FG-1 F FG-1 FG-1 NV-1 NV-1 HG-1 HG-1 F F F F F F F F F F F F F F F F F F F	AL-1 08_Hollow Metal Doors, HM Wood Wood Wood Wood Wood Wood Wood Woo	AL-1 09_Paint, PT-1 09_Paint, PT-1 TF-1 (Thermafoil) TF-1 (BE ELEV 001 001	AL-1 08_Hollow Metal Doors, HM AL-2	AL:1 45 Minute 08_Hollow Metal Doors, HM 45 Minute AL-2 45 Minute AL-2 1 AL-2 1 <t< td=""><td></td><td>113 115 107 1 107 1 109 1 108 1 107 1 108 1 107 1 108 1 107 1 108 1 107 1 108 1 108 1 108 1 108 1 108 1 108 1 106 1 106 1 106 1 106 1 106 1 107 1 107 1 107 1 107 1 107 1 107 1 107 1 107 1 107 1</td><td>BY DEMOUNTABLE WALL MFR BY DEMOUNTABLE WALL MFR</td></t<>		113 115 107 1 107 1 109 1 108 1 107 1 108 1 107 1 108 1 107 1 108 1 107 1 108 1 108 1 108 1 108 1 108 1 108 1 106 1 106 1 106 1 106 1 106 1 107 1 107 1 107 1 107 1 107 1 107 1 107 1 107 1 107 1	BY DEMOUNTABLE WALL MFR BY DEMOUNTABLE WALL MFR
1900B 1000A EVEL 2 351 352 353 354 355 355 356A 355 356B 357 358 359 360 360 360 360 360 360 360 360	6'-0" 3'-0" 3'-0" 3'-0" 3'-0" 3'-0" 3'-0" 3'-0" 3'-0" 3'-0" 3'-0" 3'-0" 3'-0" 3'-0" 3'-0" 3'-0" 3'-0" 3'-0" 3'-0" 3'-0" 4'-0" 4'-0" 4'-0" 4'-0" 3'-0" 3'-0" 3'-0" 3'-0" 3'-0" 3'-0" 3'-0" 3'-0" 3'-0" 3'-0" 3'-0" 3'-0" 3'-0" 3'-0" 3'-0" 3'-0" 3'-0" 3'-0"	7'-0" 6'-10"	FG-1 F FG-1 FG-1 NV-1 NV-1 HG-1 HG-1 F F F F F F F F F F F F F F F F F F F	AL-1 08_Hollow Metal Doors, HM Wood Wood Wood Wood Wood Wood Wood Woo	AL-1 09_Paint, PT-1 09_Paint, PT-1 TF-1 (Thermafoil) TF-1 (BE ELEV 001 001	AL-1 08_Hollow Metal Doors, HM AL-2	AL:1 45 Minute 08_Hollow Metal Doors, HM 45 Minute AL-2 45 Minute AL-2 1 AL-2 1 <t< td=""><td></td><td>113 115 107 1 107 1 109 1 108 1 107 1 108 1 107 1 108 1 107 1 108 1 107 1 108 1 108 1 106 1 106 1 106 1 106 1 107 1 107 1 106 1 107 1 107 1 107 1 107 1 107 1 107 1 107 1 107 1 108 1</td><td>BY DEMOUNTABLE WALL MFR BY DEMOUNTABLE WALL MFR</td></t<>		113 115 107 1 107 1 109 1 108 1 107 1 108 1 107 1 108 1 107 1 108 1 107 1 108 1 108 1 106 1 106 1 106 1 106 1 107 1 107 1 106 1 107 1 107 1 107 1 107 1 107 1 107 1 107 1 107 1 108 1	BY DEMOUNTABLE WALL MFR BY DEMOUNTABLE WALL MFR
1900B 1000A EVEL 2 951 952 953 954 955 956A 956B 957 956B 957 958 959 960 961 962 966 966 966 966 966B 967 966B 966B 967 967 968A 967 968B 967 967 967 968B 967 967 967 967 967 967 967 967	6'-0" 3'-0" 3'-0" 3'-0" 3'-0" 3'-0" 3'-0" 3'-0" 3'-0" 3'-0" 3'-0" 3'-0" 3'-0" 3'-0" 3'-0" 3'-0" 3'-0" 3'-0" 3'-0" 3'-0" 4'-0" 4'-0" 4'-0" 4'-0" 3'-0" 3'-0" 3'-0" 3'-0" 3'-0" 3'-0" 3'-0" 3'-0" 3'-0" 3'-0" 3'-0" 3'-0" 3'-0" 3'-0" 3'-0" 3'-0" 3'-0" 3'-0"	7'-0" 6'-10"	FG-1 F FG-1 FG-1 NV-1 NV-1 HG-1 HG-1 F F F F F F F F F F F F F F F F F F F	AL-1 08_Hollow Metal Doors, HM Wood Wood Wood Wood Wood Wood Wood Woo	AL-1 09_Paint, PT-1 09_TF-1 (Thermafoil) TF-1 (Thermafoil)	BE ELEV 001 001	AL-1 08_Hollow Metal Doors, HM AL-2	AL:1 45 Minute 08_Hollow Metal Doors, HM 45 Minute AL-2 45 Minute AL-2 1 AL-2 1 <t< td=""><td></td><td>113 Image: mail of the system 107 1 107 1 109 1 108 1 107 1 108 1 107 1 108 1 107 1 108 1 108 1 108 1 108 1 108 1 108 1 108 1 106 1 106 1 106 1 106 1 107 1 107 1 107 1 107 1 107 1 107 1 108 1 108 1 108 1 108 1</td><td>ELEVATOR MACHINE ACCESS BY DEMOUNTABLE WALL MFR BY DEMOUNTABLE WALL MFR</td></t<>		113 Image: mail of the system 107 1 107 1 109 1 108 1 107 1 108 1 107 1 108 1 107 1 108 1 108 1 108 1 108 1 108 1 108 1 108 1 106 1 106 1 106 1 106 1 107 1 107 1 107 1 107 1 107 1 107 1 108 1 108 1 108 1 108 1	ELEVATOR MACHINE ACCESS BY DEMOUNTABLE WALL MFR BY DEMOUNTABLE WALL MFR
1900B 1000A EVEL 2 251 252 253 255 255 256A 255 256B 257 258 259 260 261 262 263 264 265 266 266 266 266 266 266 266	6'-0" 3'-0" 3'-0" 3'-0" 3'-0" 3'-0" 3'-0" 3'-0" 3'-0" 3'-0" 3'-0" 3'-0" 3'-0" 3'-0" 3'-0" 3'-0" 3'-0" 3'-0" 3'-0" 4'-0" 4'-0" 4'-0" 3'-0"	7'-0" 6'-10"	FG-1 F HG-1 F FG-1 NV-1 HG-1 HG-1 F F F F F F F F F F F F F F F F F F F HG-1 HG-1	AL-1 08_Hollow Metal Doors, HM Wood	AL-1 09_Paint, PT-1 09_TF-1 (Thermafoil) TF-1 (Thermafoil)	BE ELEV 001 001	AL-1 08_Hollow Metal Doors, HM AL-2	AL-1 45 Minute 08_Hollow Metal Doors, HM 45 Minute AL-2 45 Minute AL-2 1 AL-2 1 <t< td=""><td></td><td>113 Image: style sty</td><td>ELEVATOR MACHINE ACCESS ELEVATOR MACHINE ACCESS BY DEMOUNTABLE WALL MFR BY DEMOUNTABLE WALL MFR</td></t<>		113 Image: style sty	ELEVATOR MACHINE ACCESS ELEVATOR MACHINE ACCESS BY DEMOUNTABLE WALL MFR BY DEMOUNTABLE WALL MFR
1900B 1000A EVEL 2 951 952 953 954 955 956A 956B	6'-0" 3'-0" 3'-0" 3'-0" 3'-0" 3'-0" 3'-0" 3'-0" 3'-0" 3'-0" 3'-0" 3'-0" 3'-0" 3'-0" 3'-0" 3'-0" 3'-0" 3'-0" 3'-0" 3'-0" 4'-0" 4'-0" 4'-0" 4'-0" 3'-0" 3'-0" 3'-0" 3'-0" 3'-0" 3'-0" 3'-0" 3'-0" 3'-0" 3'-0" 3'-0" 3'-0" 3'-0" 3'-0" 3'-0" 3'-0" 3'-0" 3'-0"	7'-0" 6'-10"	FG-1 F FG-1 F FG-1 NV-1 NV-1 HG-1 HG-1 F F F F F F F F F F F F F F F F F F F	AL-1 08_Hollow Metal Doors, HM Wood Wood Wood Wood Wood Wood Wood Woo	AL-1 09_Paint, PT-1 09_TF-1 (Thermafoil) TF-1 (Thermafoil)	BE ELEV 001 001	AL-1 08_Hollow Metal Doors, HM AL-2	AL:1 45 Minute 08_Hollow Metal Doors, HM 45 Minute AL-2 45 Minute AL-2 1 AL-2 1 <t< td=""><td></td><td>113 Image: mail of the system 107 1 107 1 109 1 108 1 107 1 108 1 107 1 108 1 107 1 108 1 108 1 108 1 108 1 108 1 108 1 108 1 106 1 106 1 106 1 106 1 107 1 107 1 107 1 107 1 107 1 107 1 108 1 108 1 108 1 108 1</td><td>ELEVATOR MACHINE ACCESS BY DEMOUNTABLE WALL MFR BY DEMOUNTABLE WALL MFR</td></t<>		113 Image: mail of the system 107 1 107 1 109 1 108 1 107 1 108 1 107 1 108 1 107 1 108 1 108 1 108 1 108 1 108 1 108 1 108 1 106 1 106 1 106 1 106 1 107 1 107 1 107 1 107 1 107 1 107 1 108 1 108 1 108 1 108 1	ELEVATOR MACHINE ACCESS BY DEMOUNTABLE WALL MFR BY DEMOUNTABLE WALL MFR

Grand Total: 64

Plot Stamp: 6/24/2025 3:40:57 PM

DOOR SCHEDULE REMARKS

- 1. ELEC. DOOR OPENER W/ HC BUTTON ON INSIDE AND OUTSIDE OF DOOR 2. ELEC. CONTROLLED ACCESS HARDWARE WITH CARD READER ELEC. CONTROLLED ACCESS HARDWARE WITH PUSH-BUTTON
 ELEC. CONTROLLED ACCESS HARDWARE, ROUGH-IN ONLY
- 5. DOOR BUZZER DOOR BUZZER
 DOOR CHIME ON OPEN
 MAGNETIC HOLD-OPEN, CONNECT TO FIRE ALARM
 MAGNETIC HOLD-OPEN, CONNECT TO SECURITY SYSTEM
 SOUND DOOR
- OPERABLE WALLS, OVERHEAD DOORS AND GRILLES 10. SOUND RATED DOOR ASSEMBLY, STC AS SPECIFIED 11. WINDSTORM DOOR HARDWARE SHALL BE TESTED AS PART OF A COMPLETE DOOR OPENING ASSEMBLY.
- THE WINDSTORM DOOR HARDWARE SHALL BE TESTED AS PART OF A COMPLETE DOOR OPENING ASSEMBLING THE TESTED DOOR OPENING ASSEMBLY SHALL INCLUDE DOOR HARDWARE. THE ENTIRE DOOR OPENING, INCLUDING DOOR HARDWARE, SHALL BE BY DOOR MANUF.
 12. ACOUSTICAL GLASS TO MEET FIRE DOOR ASSEMBLY REQUIREMENTS FOR FIRE RATING INDICATED
 13. MANUAL OPERATION
- 14. ELEC MOTOR OPERATION WITH KEY SWITCH CONTROL, KEY SWITCH ON ONE SIDE OF DOOR ONLY 15. ELEC MOTOR OPERATION WITH KEY SWITCH CONTROL, KEY SWITCH ON BOTH SIDES OF DOOR 16. ELEC MOTOR OPERATION WITH PUSH-BUTTON CONTROL ON ONE SIDE OF DOOR ONLY
- 17. AUTOMATIC OPEN ON FIRE ALARM ACTIVATION U.N.O. 18. AUTOMATIC CLOSE ON FIRE ALARM ACTIVATION

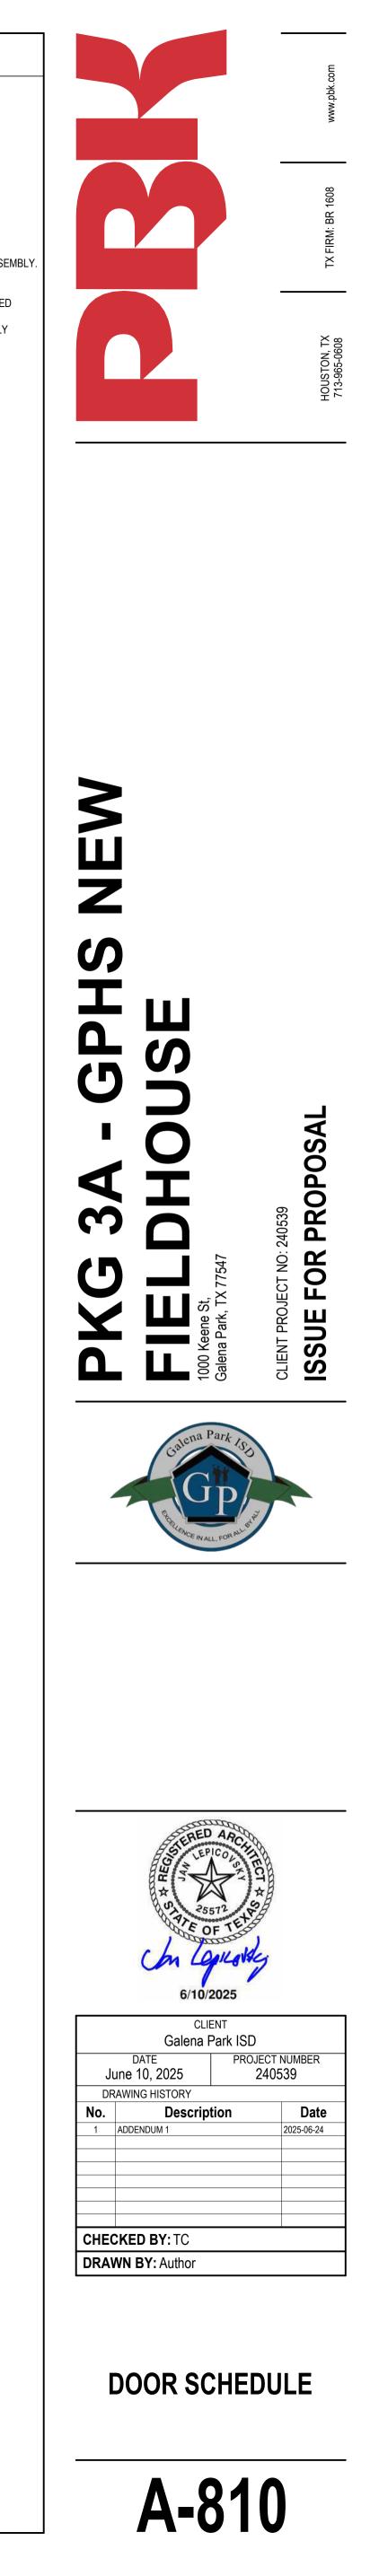


0

TEM	MANUFACTURER	DESCRIPTION	COLOR	SIZE	LOCATION	NC
5 00.SC1			CONCRETE	FINISHING	REF TO FINISH FLOOR PLAN	SE/
						35/
				DISTEM		
05 52 00.MRP 05 52 00.CDP		SLAT STEEL RAILING SYSTEM STEEL CANE DETECTION RAILING SYSTEM	ARCH TO SELECT STAINLESS STEEL FINISH	`	RAILING CANE DETECTION	
15 73 00.IM1	MCNICOLS	PERFORATED METAL	ARCH TO SELECT STAINLESS STEEL FINISH PRMARY MATERIAL: CARBON STEEL, ARCH TO SELECT POWDER COATED FINISH	GAUGE: 16: HOLE PATTERN: 1/2" HEX ON 9/16	" CTRS PERFORATED METAL INILL PANEL AND STAIR RISER	
5 75 00.DT1	SCHLUTER	JOLLY	AT, SATIN NICKEL ANODIZED ALUMINUM		TILE EDGES	
05 75 00.MT1	SCHLUTER	RENO-RAMP	AE, SATIN ANODIZED ALUMINUM		RAMP TRANSITION	_
05 75 00.MT2	SCHLUTER	RENO-T	AT, SATIN NICKEL ANODIZED ALUMINUM		SAME HEIGHT TRANSITION	
05 75 00.MT3 05 75 00.MT4	SCHLUTER	RENO-TK DILEX-AHK	AT, SATIN NICKEL ANODIZED ALUMINUM AT, SATIN NICKEL ANODIZED ALUMINUM		TILE TO CARPET TILED FLOOR TO WALL COVE	w
57500	SCHEDTER		AT, SATIN MICKLE ANODIZED ALOMINUM			
			п	ILE		
09 30 00.T1 09 30 00.T2	NOT IN USE NOT IN USE	NOT IN USE NOT IN USE				GR
9 30 00.T3	CROSSVILLE STUDIOS	URBANOLOGY BY STILE	COLOR: METROPOLIS CHISELED	24" X 48"	WALL TILE	GF
09 30 00.T4	CROSSVILLE STUDIOS	URBANOLOGY BY STILE	COLOR: TITANIUM CHISELED	24" X 48"	WALL TILE	GR
09 30 00.T5	EMSER	RAKU	COLOR: WHITE	3" X 12" MATTE	RESTROOM & SHOWER WALL TILE	GR
09 30 00.T6 09 30 00.T7	EMSER	RAKU	COLOR: CHARCOAL	3" X 12" GLOSSY	RESTROOM & SHOWER WALL TILE	GF
9 30 00.17	EMSER	RAKU	COLOR: MUSTARD	3" X 12" GLOSSY AL CEILINGS	RESTROOM & SHOWER WALL TILE	Gr
9 51 00.ACP1	ARMSTRONG - ACOUSTIC CEILING PANEL/TILE	OPTIMA	WHITE	24'X24", 15/16", 3152	HIGH NRC	RE
9 51 00.ACP2	NOT IN USE	NOT IN USE				
09 51 00.ACS1	ARMSTRONG - ACOUSTIC CEILING SYSTEM	PRELUDE XL	WHITE	15/16"	FIELD ACS	RE
09 51 00.XCT6	ARMSTRONG CEILINGS	AXIOM CLASSIC	WHITE	6"	CEILING CLOUDS	RE
			LINEAR WOO	OD CEILINGS		
9 54 26.WCS1	9 WOOD	1100 CROSS PIECE GRILLE	SPECIES: WESTERN HEMLOCK; FINISH: DRIFTWOOD STAIN	1"X4" WITH 4" SPACING	ENTRANCE TO WEIGHT ROOM ON LVL 1	
0 65 00 DET4	TADVETT	CONTOUR (COLOR REALA		VINYL TILE		
09 65 00.RFT1 09 65 00.RFT2	TARKETT	CONTOUR/ COLOR BEAM CONTOUR/ COLOR BEAM	C113 MOONLIGHT, EMBOSS: QUARRY C121 FLANNEL, EMBOSS: QUARRY	9" X 36" 9" X 36"	FIELD ACCENT	
9 65 00.RFT3	TARKETT	CONTOUR/ COLOR BEAM	C120 ECLIPSE, EMBOSS: QUARRY	9" X 36"	ACCENT	
0 CE 12 DB1	IOUNICONITE	TRADITIONAL WALL BASS	BOD: 1100 CROSS PI	IECE GRILLE; FINISH:		
09 65 13.RB1	JOHNSONITE	TRADITIONAL WALL BASE	CHARCOAL	4.	FIELD	
			RUBBER STAIR TRE	AD & RUBBER TILE		<u> </u>
9 65 13.RSR	NOT IN USE	NOT IN USE				
09 65 19 RT1	NOT IN USE	NOT IN USE	BECHIELT ATL	CTIC FLOOPING		
9 65 66.PRA1	TARKETT SPORTS	REPLAY	RA1 MELLOWED RA1 MELLOWED	18"MM THICKNESS, ROLLS	WEIGHT ROOM, FIELD	
9 65 66.PRA2	TARKETT SPORTS	REPLAY	517 CLOUD	18"MM THICKNESS, ROLLS	WEIGHT ROOM, ACCENT	
09 65 66.PRA3	TARKETT SPORTS	REPLAY	507 NIGHT	18"MM THICKNESS, ROLLS	WEIGHT ROOM, ACCENT	
			TERRAZZO	FLOORING		
09 66 00.TZE1 09 66 00.TZE2	TERRAZZO & MARBLE TERRAZZO & MARBLE	TERROXY TERROXY	TBD TBD		LEVEL 1 MAIN CORRIDOR ACCENT	ST/
						$\boldsymbol{\frown}$
09 67 00.FF1	PATCRAFT	RESIN FLAKE	STYLE: TRADITIONAL FLAKE, COLOR: F0130 GLINT		RESTROOMS AND TRAINING	
09 67 00.FF2	PATCRAFT	RESIN FLAKE	STYLE: TRADITIONAL FLAKE, COLOR: F0570 ASTRAL		LOCKER ROOMS	LO
/9 68 00.CP1	NOT IN USE	NOT IN USE				
9 68 00.CP2	NOT IN USE	NOT IN USE				
9 68 00.CP3	TARKETT	ASSERTIVE ACTION 04837	STEELWORK 26202	POWERBOND RS	WALK OFF CARPET	
			INTERIOR W	ALL PANELS		
			ACOUSTICAL			
09 84 00.ARC1	ACOUFELT	SHAPES WALLTILE, HEXAGON	COLOR: TU60 TURMERIC COLOR: GR02 GREY	LARGE 24"W X 20.78" H, THICKNESS: 1"	WEIGHT ROOM WEIGHT ROOM	
9 84 00.ARC2	ACOUFELT	SHAPES WALLTILE, HEXAGON SHAPES WALLTILE, HEXAGON	COLOR: CH01 CHARCOAL	LARGE 24"W X 20.78" H, THICKNESS: 1" LARGE 24"W X 20.78" H, THICKNESS: 1"	WEIGHT ROOM	
			PAI	INT		_
99 90 00.P1	SHERWIN WILLIAMS SHERWIN WILLIAMS		SW 7014 EIDER WHITE SW 7066 GRAY MATTERS		FIELD ACCENT	-
99 90 00.P2	SHERWIN WILLIAMS SHERWIN WILLIAMS		SW 7066 GRAY MATTERS SW 7068 GRIZZLE GRAY		ACCENT ACCENT, DOOR FRAMES, GYP CEILING AT WEIGHT ROOM	\vdash
09 90 00.P4	SHERWIN WILLIAMS		BRANDING GOLD		SPIRIT COLOR	co
09 90 00.P5	SHERWIN WILLIAMS		SW 6991 BLACK MAGIC		SPIRIT COLOR, EXPOSED STRUCTURE	
09 90 00.P6	SHERWIN WILLIAMS		SW7014 EIDER WHITE (EPOXY FINISH)		CMU WALLS WHERE INDICATED	
09 90 00.P7 09 90 00.P8	SHERWIN WILLIAMS SHERWIN WILLIAMS		SW 7066 GRAY MATTERS (EPOXY FINISH) BRANDING GOLD (EPOXY FINISH)		SPIRIT COLOR	co
99 90 00.P8	SHERWIN WILLIAMS		SW 6991 BLACK MAGIC (EPOXY FINISH)			0
			SIGN	NAGE		
LO 14 00.RID1	FORMICA		COLOR: TBD		ROOM SIGNAGE	TO
10 14 00.RID2	FORMICA		COLOR: TBD		ROOM SIGNAGE	BO
			TOILET COMPARTN	MENTS/PARTITIONS		
0 21 13.19.PTC1	SCRANTON	HINDY HIDERS	STAINLESS GRIP EX		RESTROOMS	
				WALL PROTECTION		
0 26 00.CG1	KOROSEAL	KOROGARD	COLOR TO BE SELECTED DURING SUBMITTALS		WHERE APPLICABLE	
2 21 42 1124			WINDOW T	REATMENT		
2 21 13.HB1 2 24 00.SB1	HUNTER DOUGLAS DRAPER	2" FAUX WOOD BLINDS SUNBLOC SERIES			REF TO DRAWINGS REF TO DRAWINGS	HO
2 24 00.SF1	DRAPER	SHEERWEAVE SERIES			REF TO DRAWINGS	W
			SOLID S	URFACE		
2 36 00.SCT1	WILSONART	SOLID SURFACE COUNTERTOPS SOLID SURFACE WINDOW SILLS	AVALANCHE MELANGE, 9175ML FROSTY WHITE, 1573SL		COUNTERTOPS WHERE APPLICABLE	WI
3 36 00 6073	A REFERENCE AND A REFERENCE AN	SOLD SUBLACE WINDOW SUIS	LEADER V WHILE 15 /251		WINDOW SILLS	AT
2 36 00 SCT2	WILSONARI	SOLID SORFACE WINDOW SILLS		SC.		
12 36 00 SCT2 10 51 13.AL	METAL LOCKERS	SOLID SORFACE WINDOW SILLS		SC.	LOCKER ROOM	ME

Plot Stamp: 6/25/2025 9:00:23 AM


2405398 GP FIELD HOUSE -	INTERIOR SCHEDULE OF FINISHES

NOTEC	
NOTES	
SEALED CONCRETE	
WALL TILE TO FLOOR TILE	
GROUT: GROUT:	
GROUT: GROUT:	
GROUT: GROUT:	
GROUT:	
RE: RCPS	
RE: RCPS	
RE: RCPS	
STAIR TREADS	
LOGO AT VARSITY LOCKER ROOM	
CONFIRM WITH DISTRICT	
CONFIRM WITH DISTRICT	
ТОР	
воттом	
HORIZONTAL BLINDS	
WINDOW SHADE BLACKOUT FABRIC WINDOW SHADE FABRIC	
WILL BE PROVIDED THROUGH DIRTT	
AT ALL WINDOWS EXCEPT CLERESTORY WINDOWS	
METAL LOCKERS	

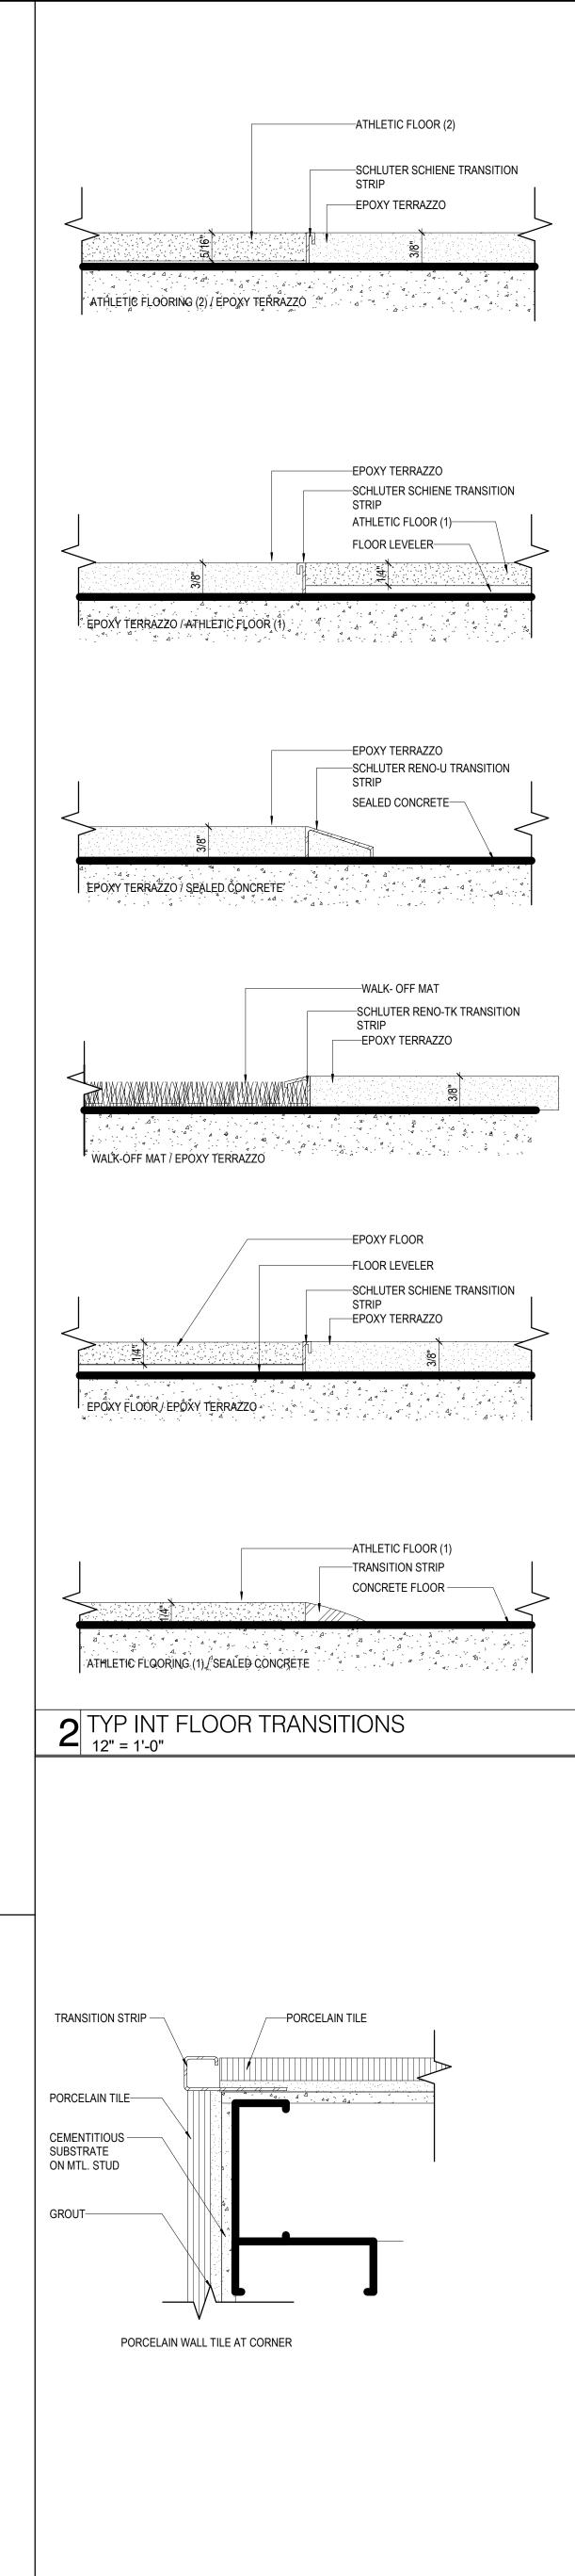




FINISH SCHEDULE

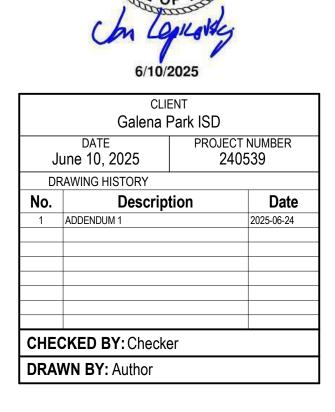




3

Ш Z

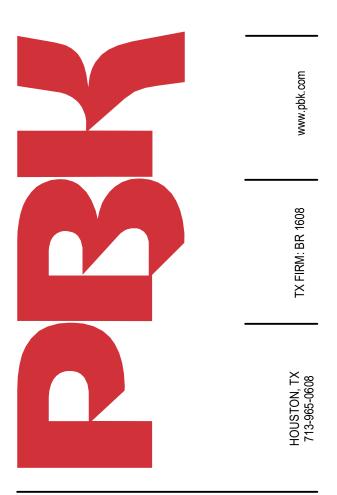

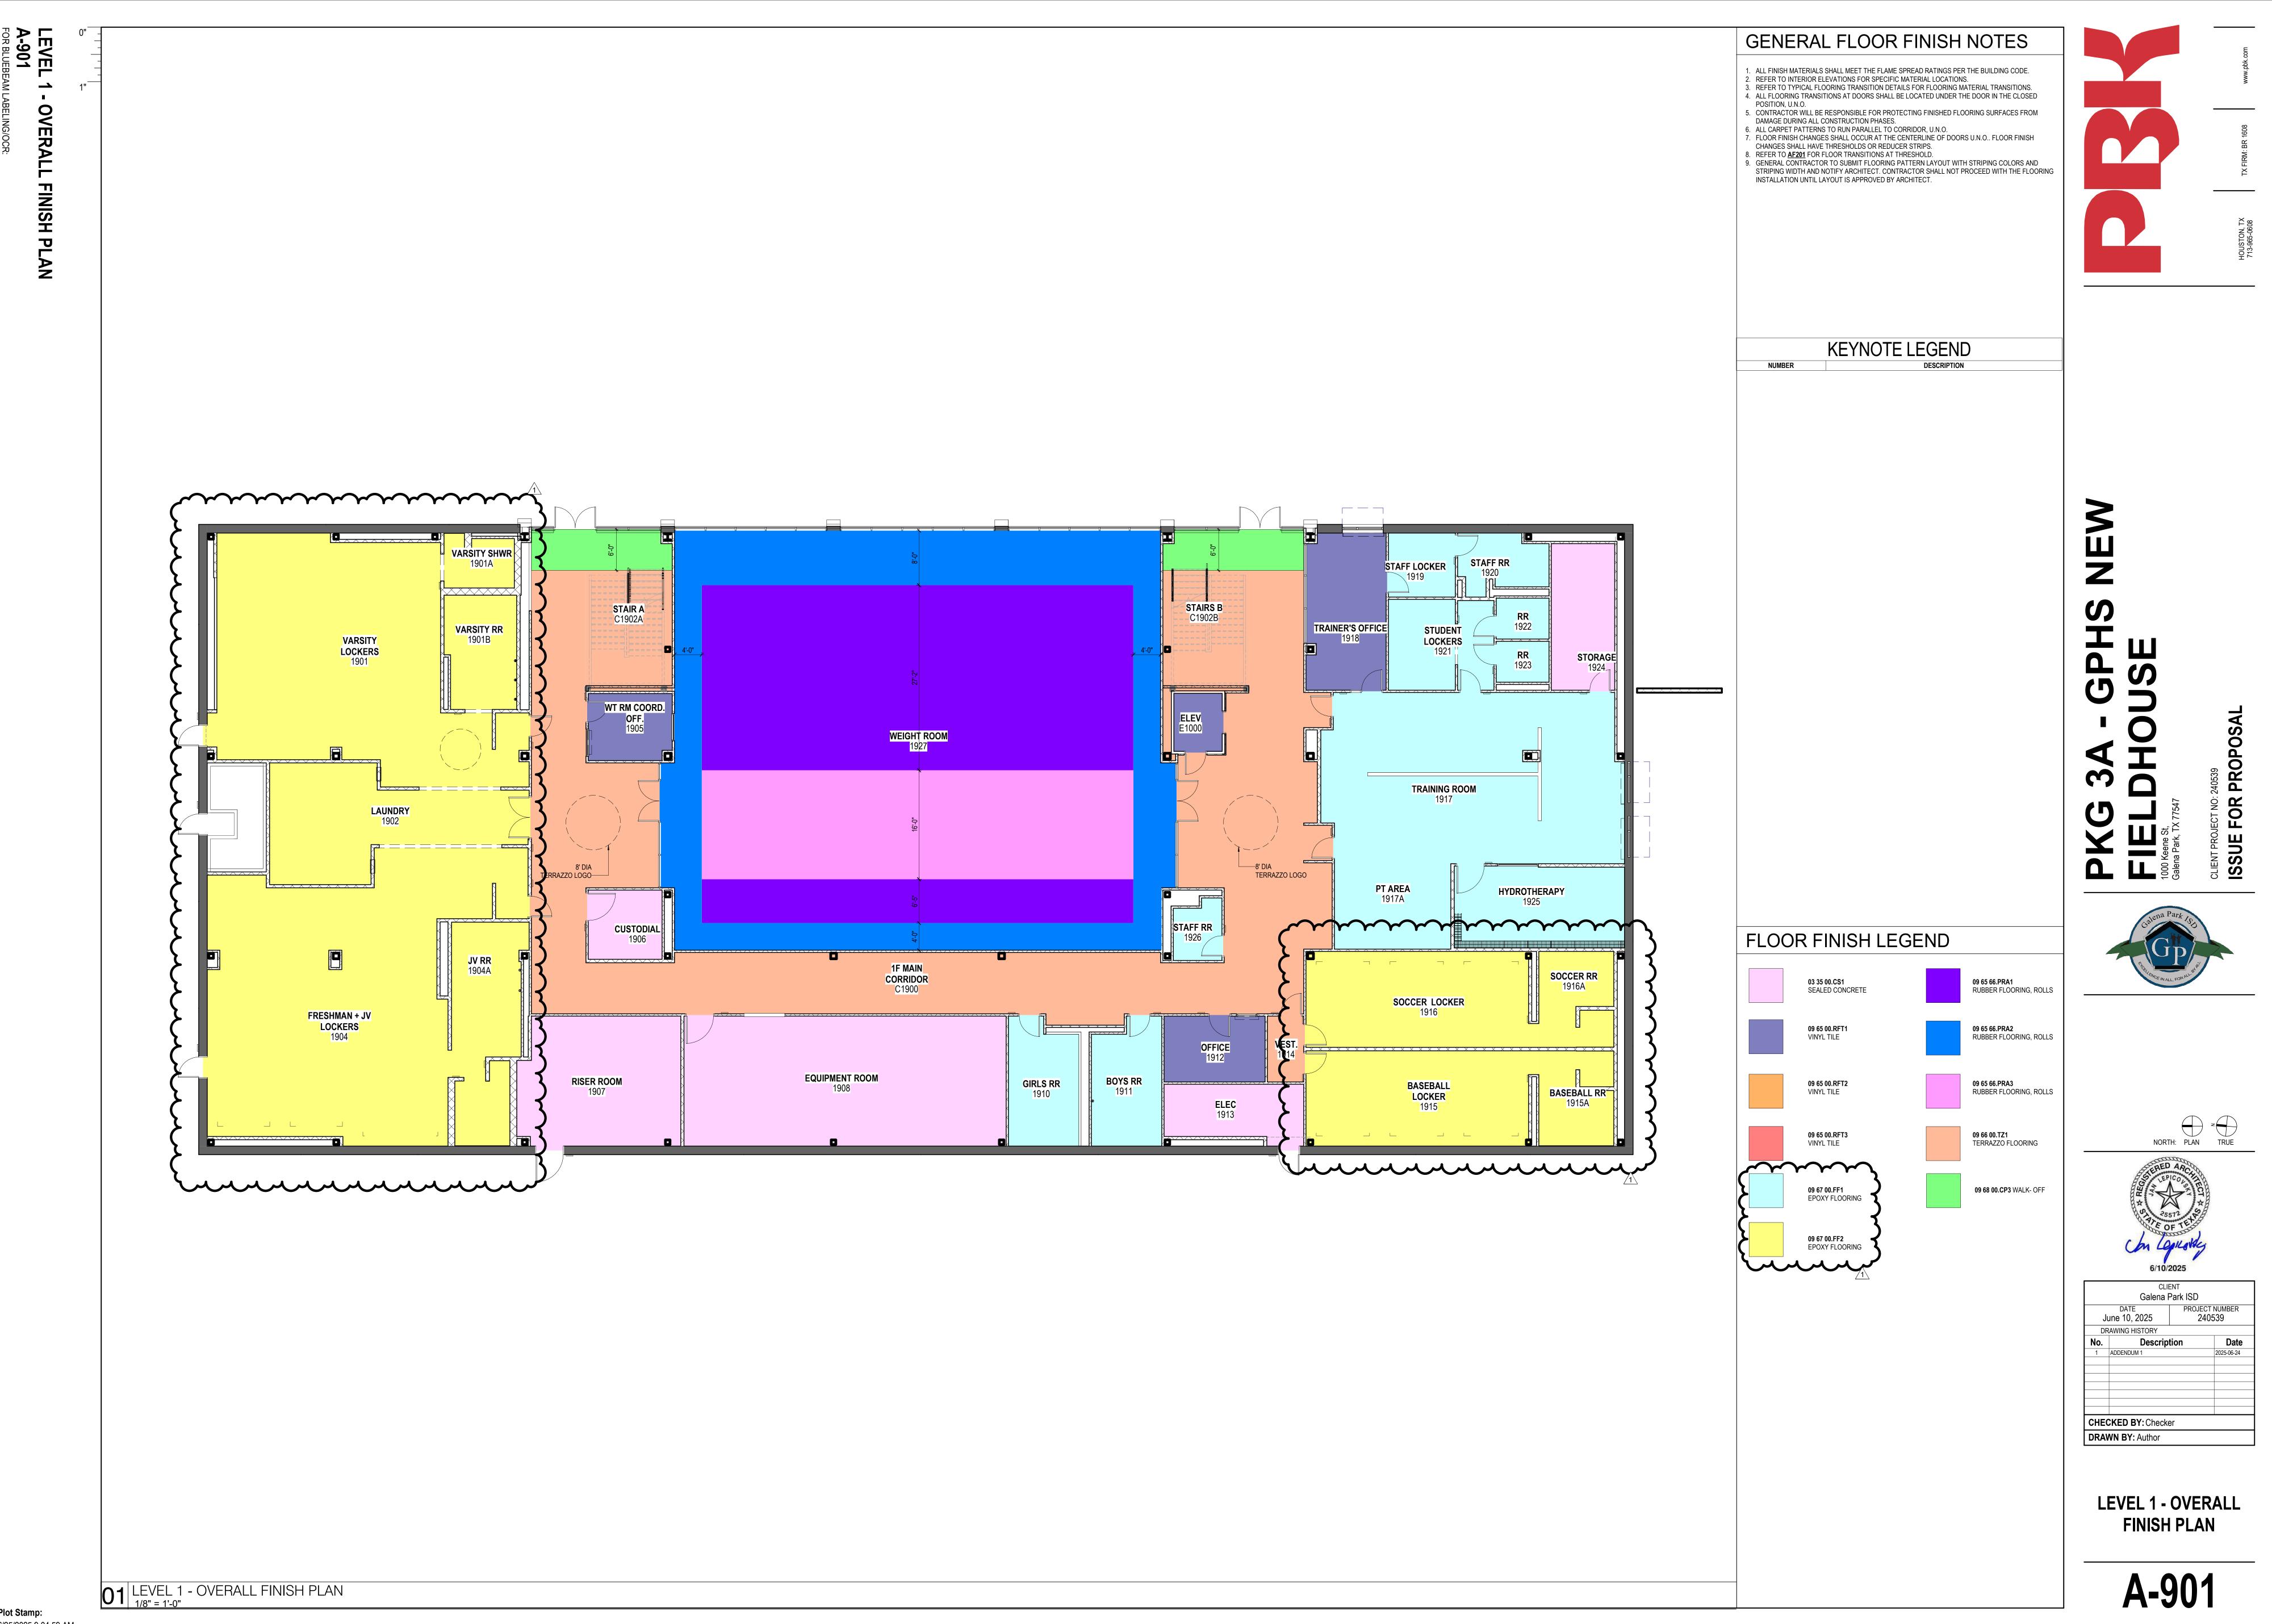


Plot Stamp: 6/25/2025 9:04:59 AM



N Ο п Ζ Т Ζ




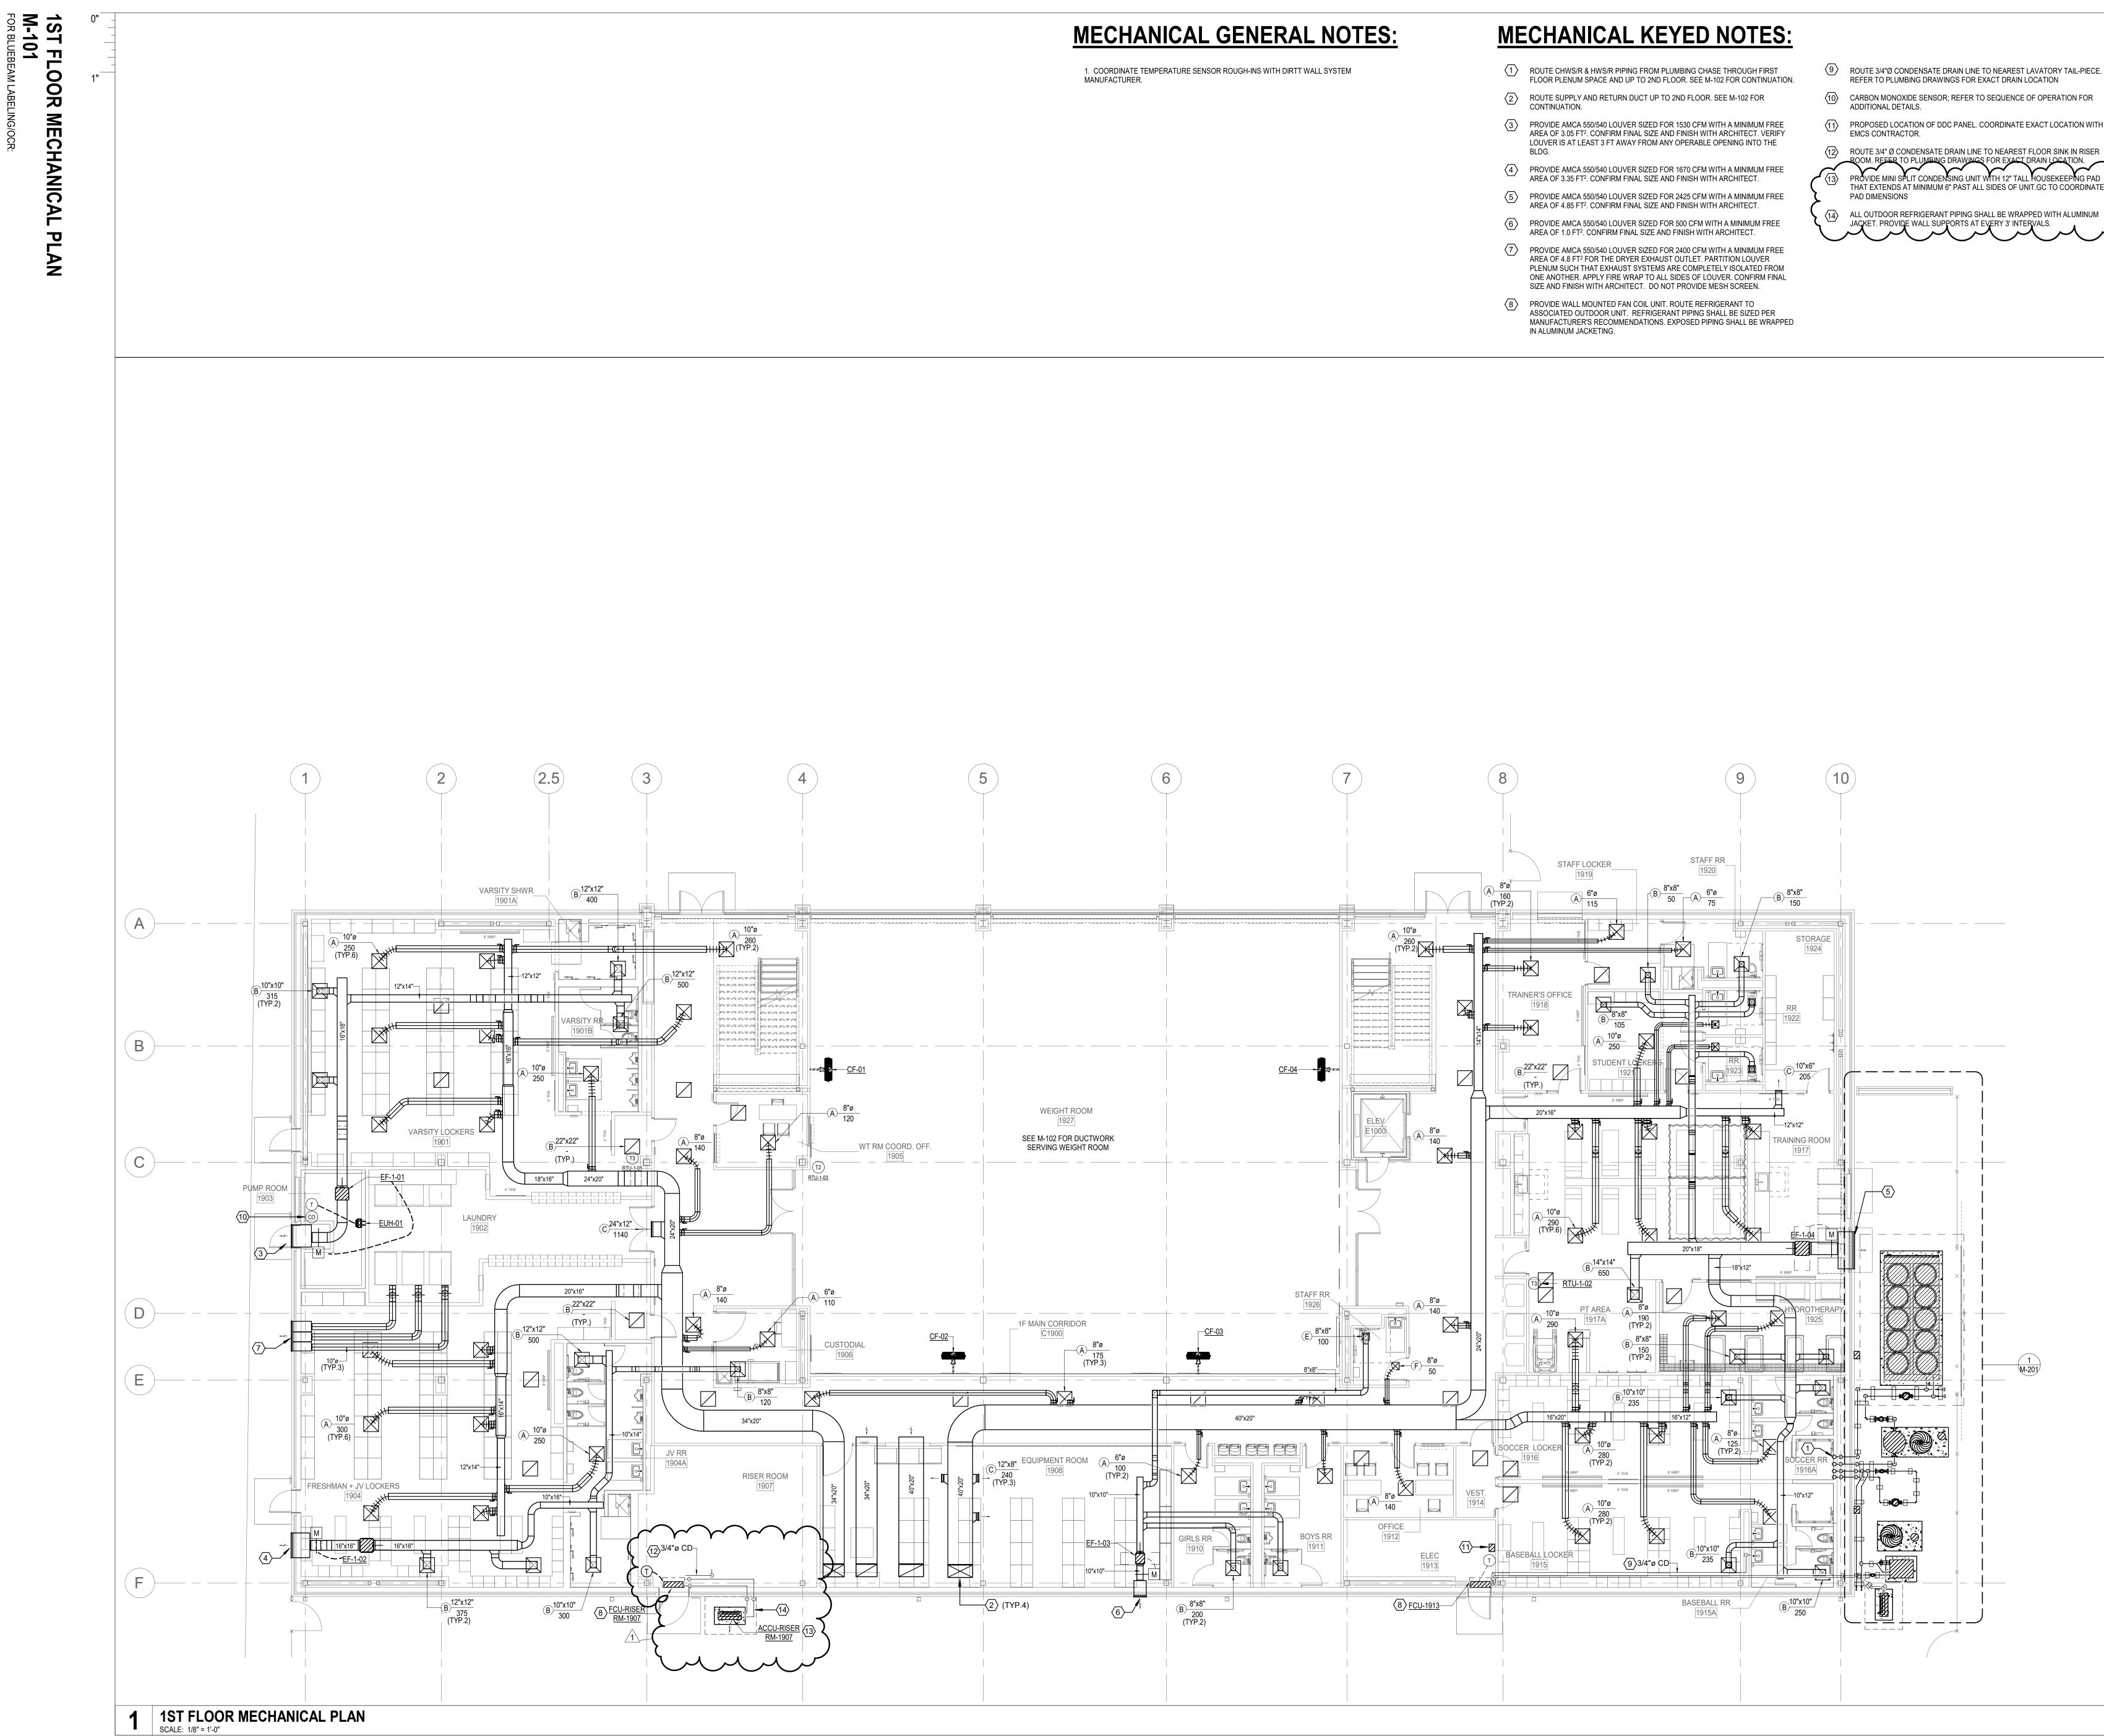


Plot Stamp: 6/25/2025 10:33:45 AM

- (9) ROUTE 3/4"Ø CONDENSATE DRAIN LINE TO NEAREST LAVATORY TAIL-PIECE. REFER TO PLUMBING DRAWINGS FOR EXACT DRAIN LOCATION
- (10) CARBON MONOXIDE SENSOR; REFER TO SEQUENCE OF OPERATION FOR ADDITIONAL DETAILS.
- (1) PROPOSED LOCATION OF DDC PANEL. COORDINATE EXACT LOCATION WITH
- ROOM. REFER TO PLUMBING DRAWINGS FOR EXACT DRAIN LOCATION. PROVIDE MINI SPLIT CONDENSING UNIT WITH 12" TALL HOUSEKEEPING PAD THAT EXTENDS AT MINIMUM 6" PAST ALL SIDES OF UNIT.GC TO COORDINATE

ALL OUTDOOR REFRIGERANT PIPING SHALL BE WRAPPED WITH ALUMINUM

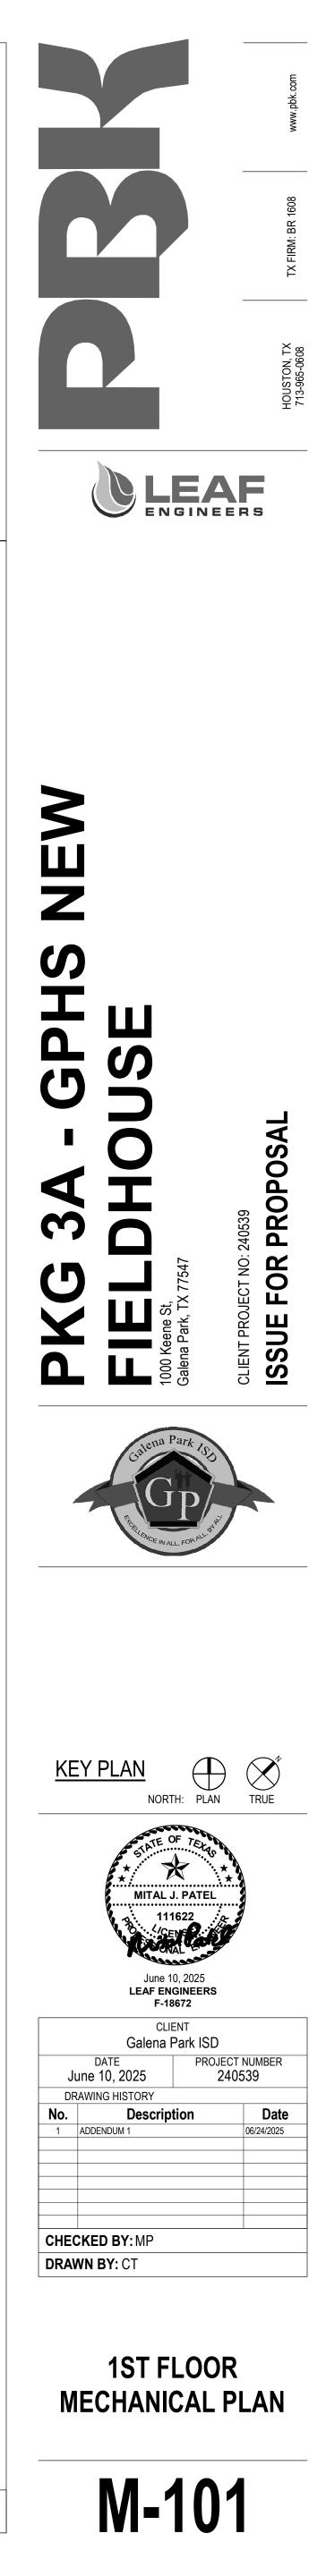

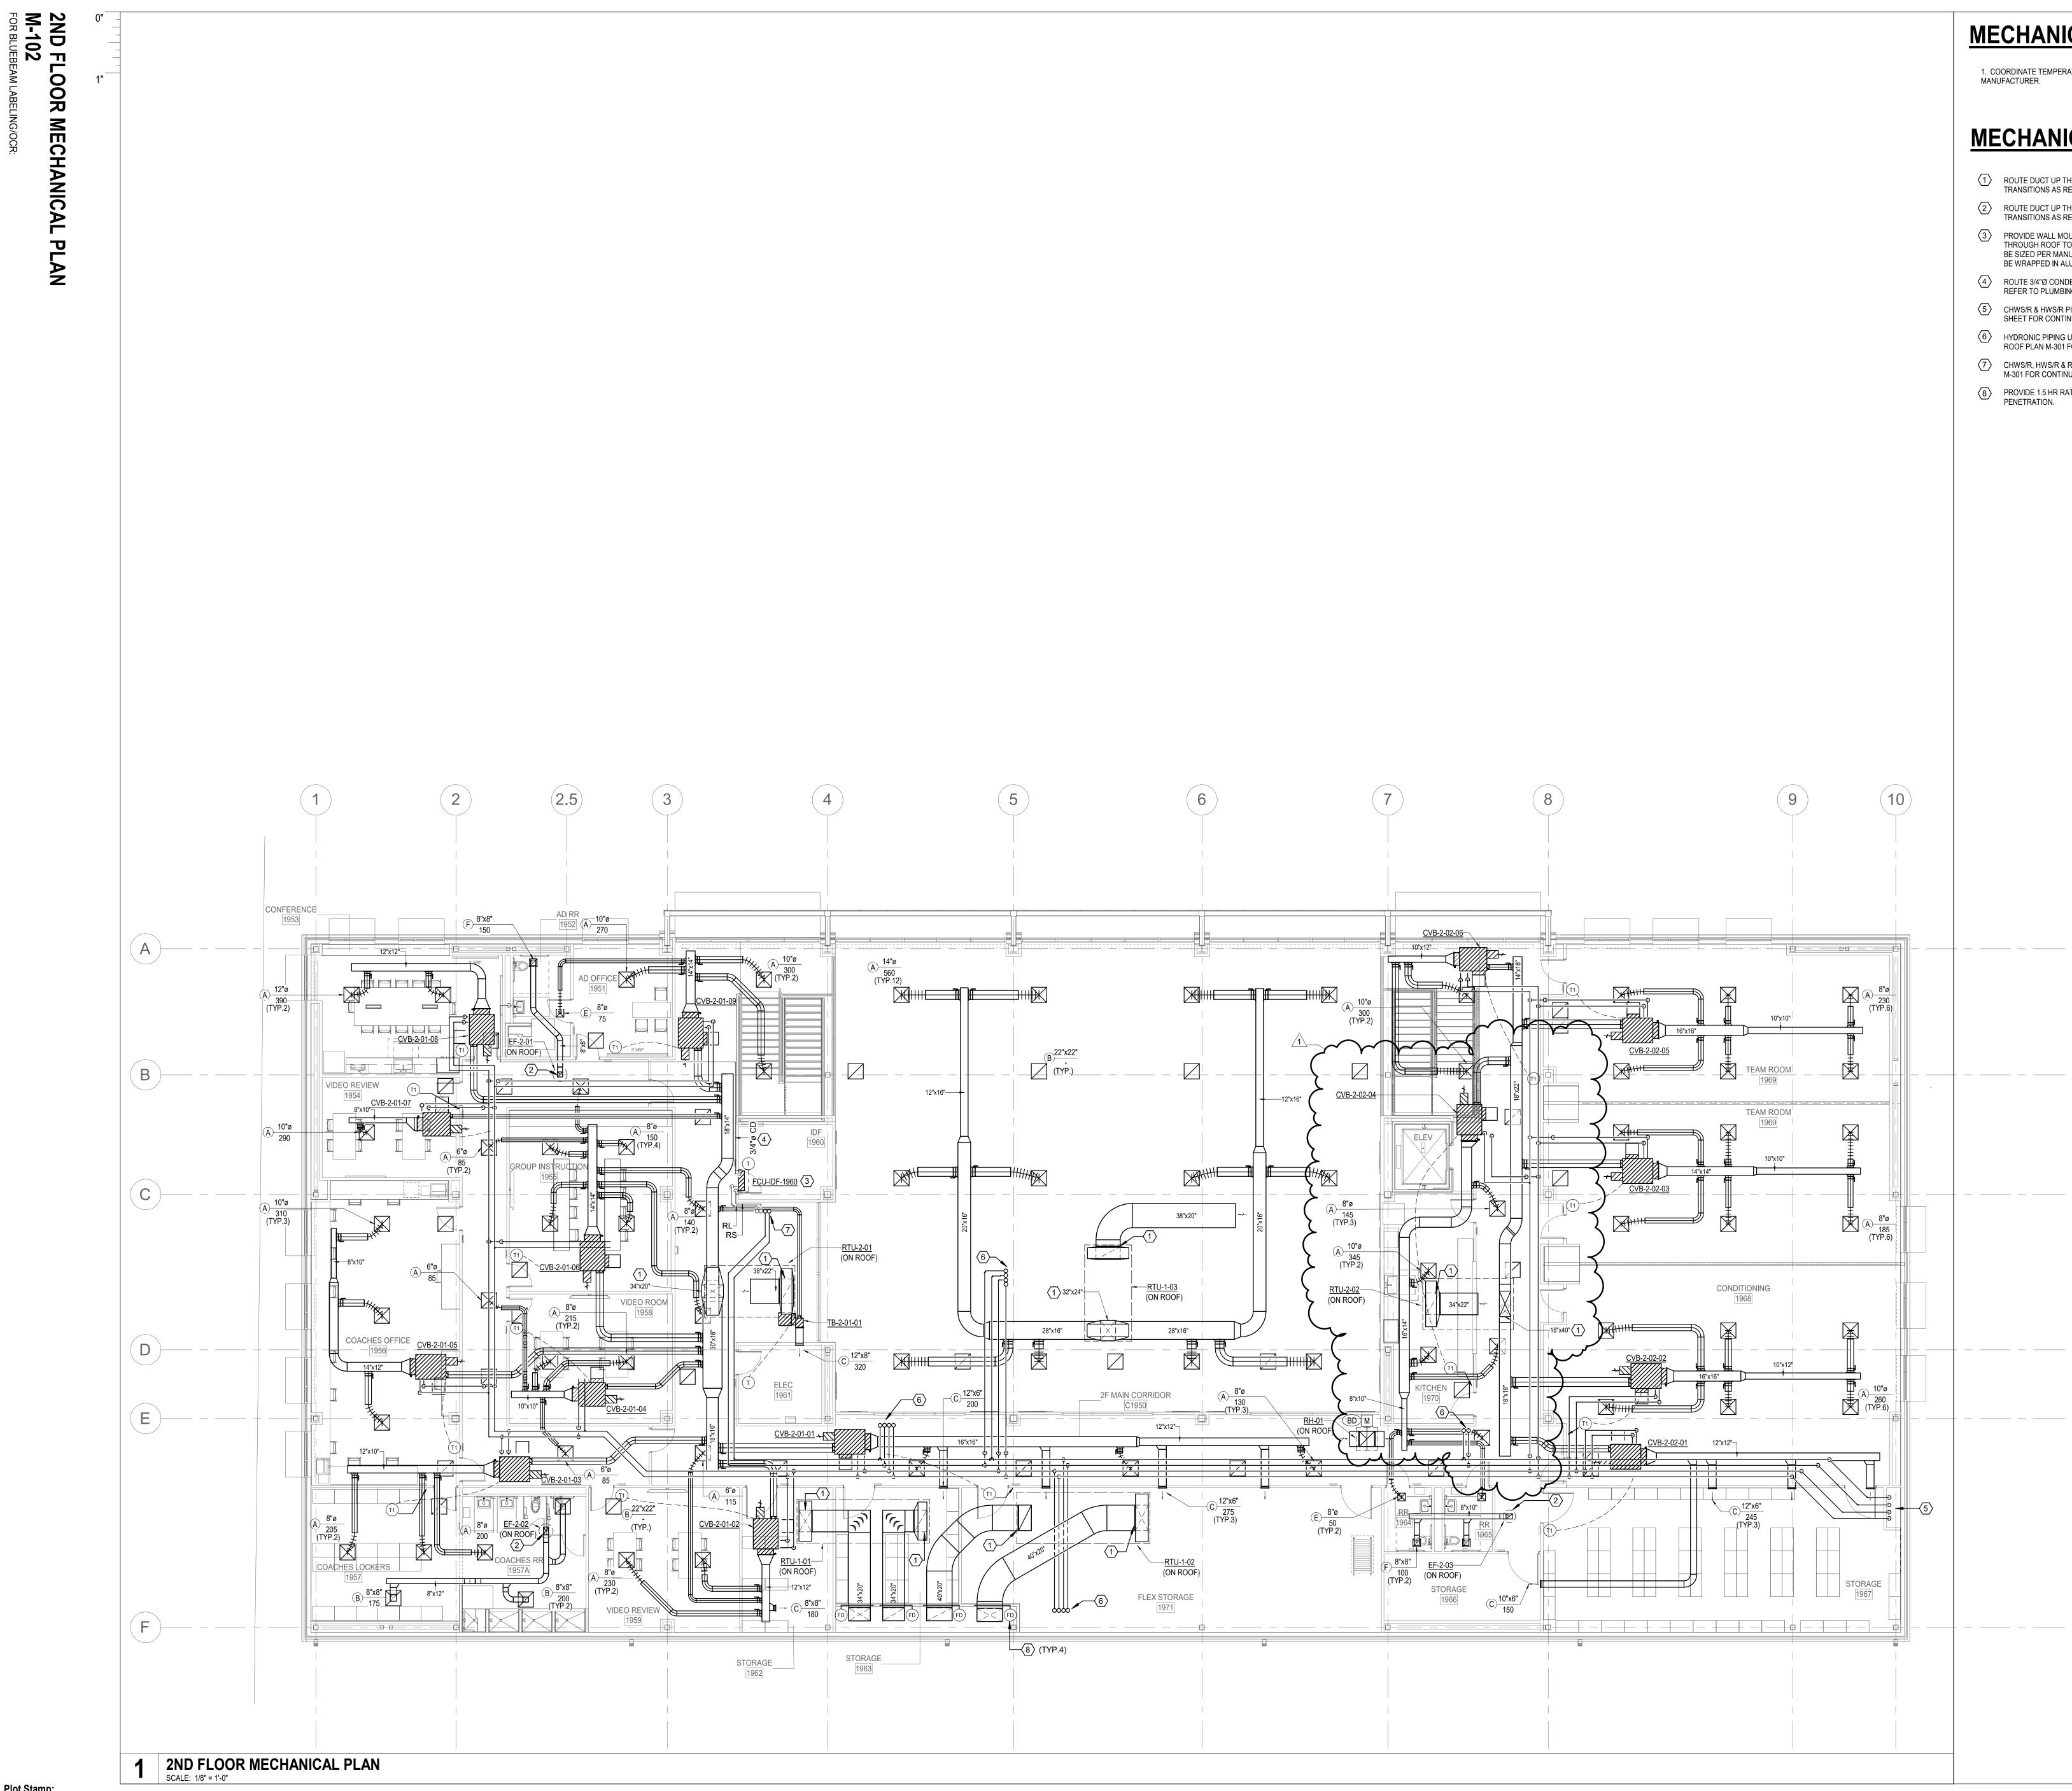


MECHANICAL GENERAL NOTES:


1. COORDINATE TEMPERATURE SENSOR ROUGH-INS WITH DIRTT WALL SYSTEM

MECHANICAL KEYED NOTES:


- (1) ROUTE DUCT UP THROUGH ROOF TO ASSOCIATED ROOFTOP UNIT. PROVIDE TRANSITIONS AS REQUIRED TO MAKE CONNECTION.
- 2 ROUTE DUCT UP THROUGH ROOF TO ASSOCIATED ROOFTOP UNIT. PROVIDE TRANSITIONS AS REQUIRED TO MAKE CONNECTION.
- PROVIDE WALL MOUNTED FAN COIL UNIT. ROUTE REFRIGERANT PIPING UP THROUGH ROOF TO ASSOCIATED OUTDOOR UNIT. REFRIGERANT PIPING SHALL BE SIZED PER MANUFACTURER'S RECOMMENDATIONS. EXPOSED PIPING SHALL BE WRAPPED IN ALUMINUM JACKETING.
- A ROUTE 3/4"Ø CONDENSATE DRAIN LINE TO NEAREST LAVATORY TAIL-PIECE. REFER TO PLUMBING DRAWINGS FOR EXACT DRAIN LOCATION.
- 5 CHWS/R & HWS/R PIPING FROM LOWER LEVEL THRU CHASE; REFER TO M-101 SHEET FOR CONTINUATION.
- 6 HYDRONIC PIPING UP TO ROOF TO HYDRONIC AIR HANDLING UNIT; REFER TO ROOF PLAN M-301 FOR CONTINUATION.
- (7) CHWS/R, HWS/R & REFRIGERANT PIPING UP TO ROOF; REFER TO ROOF PLAN M-301 FOR CONTINUATION.
- 8 PROVIDE 1.5 HR RATED FIRE DAMPER FOR DUCTWORK AT CHASE PENETRATION.

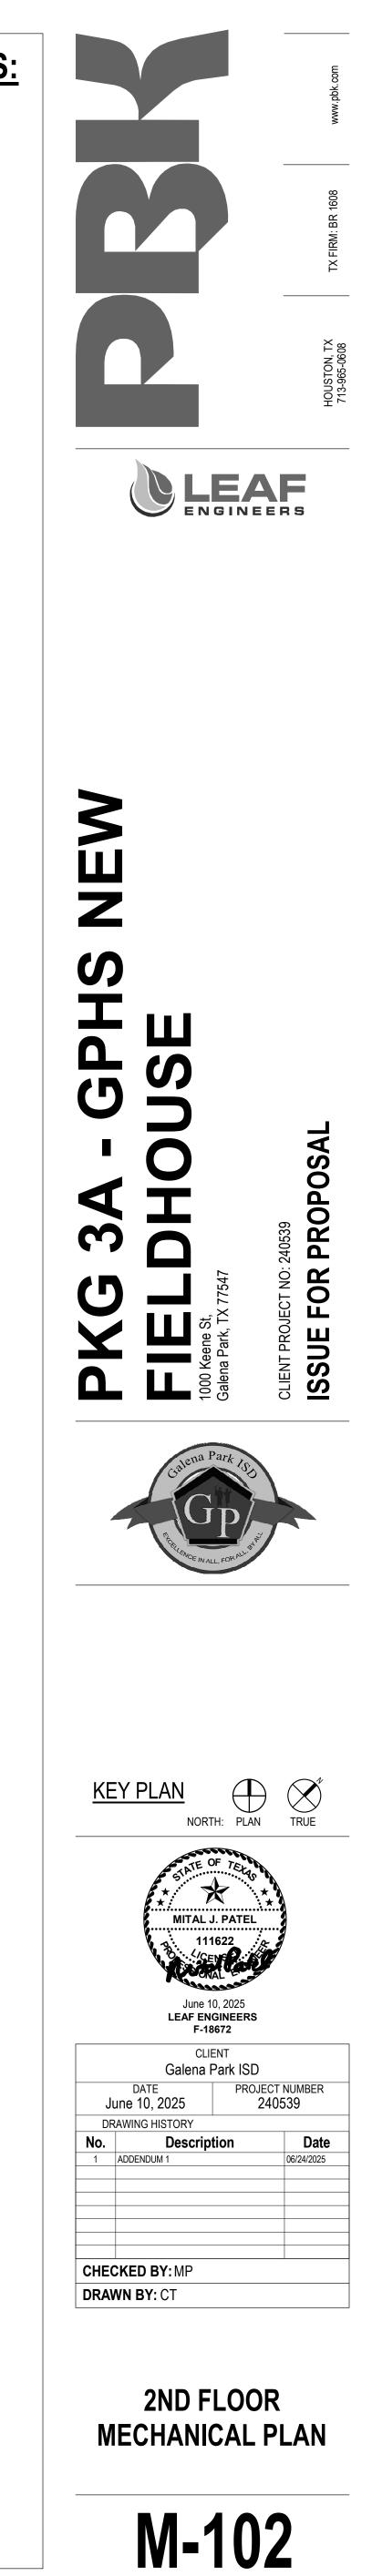



IECHA I-201	0"			
_ARGED PLANS				C
				D
				E
				F

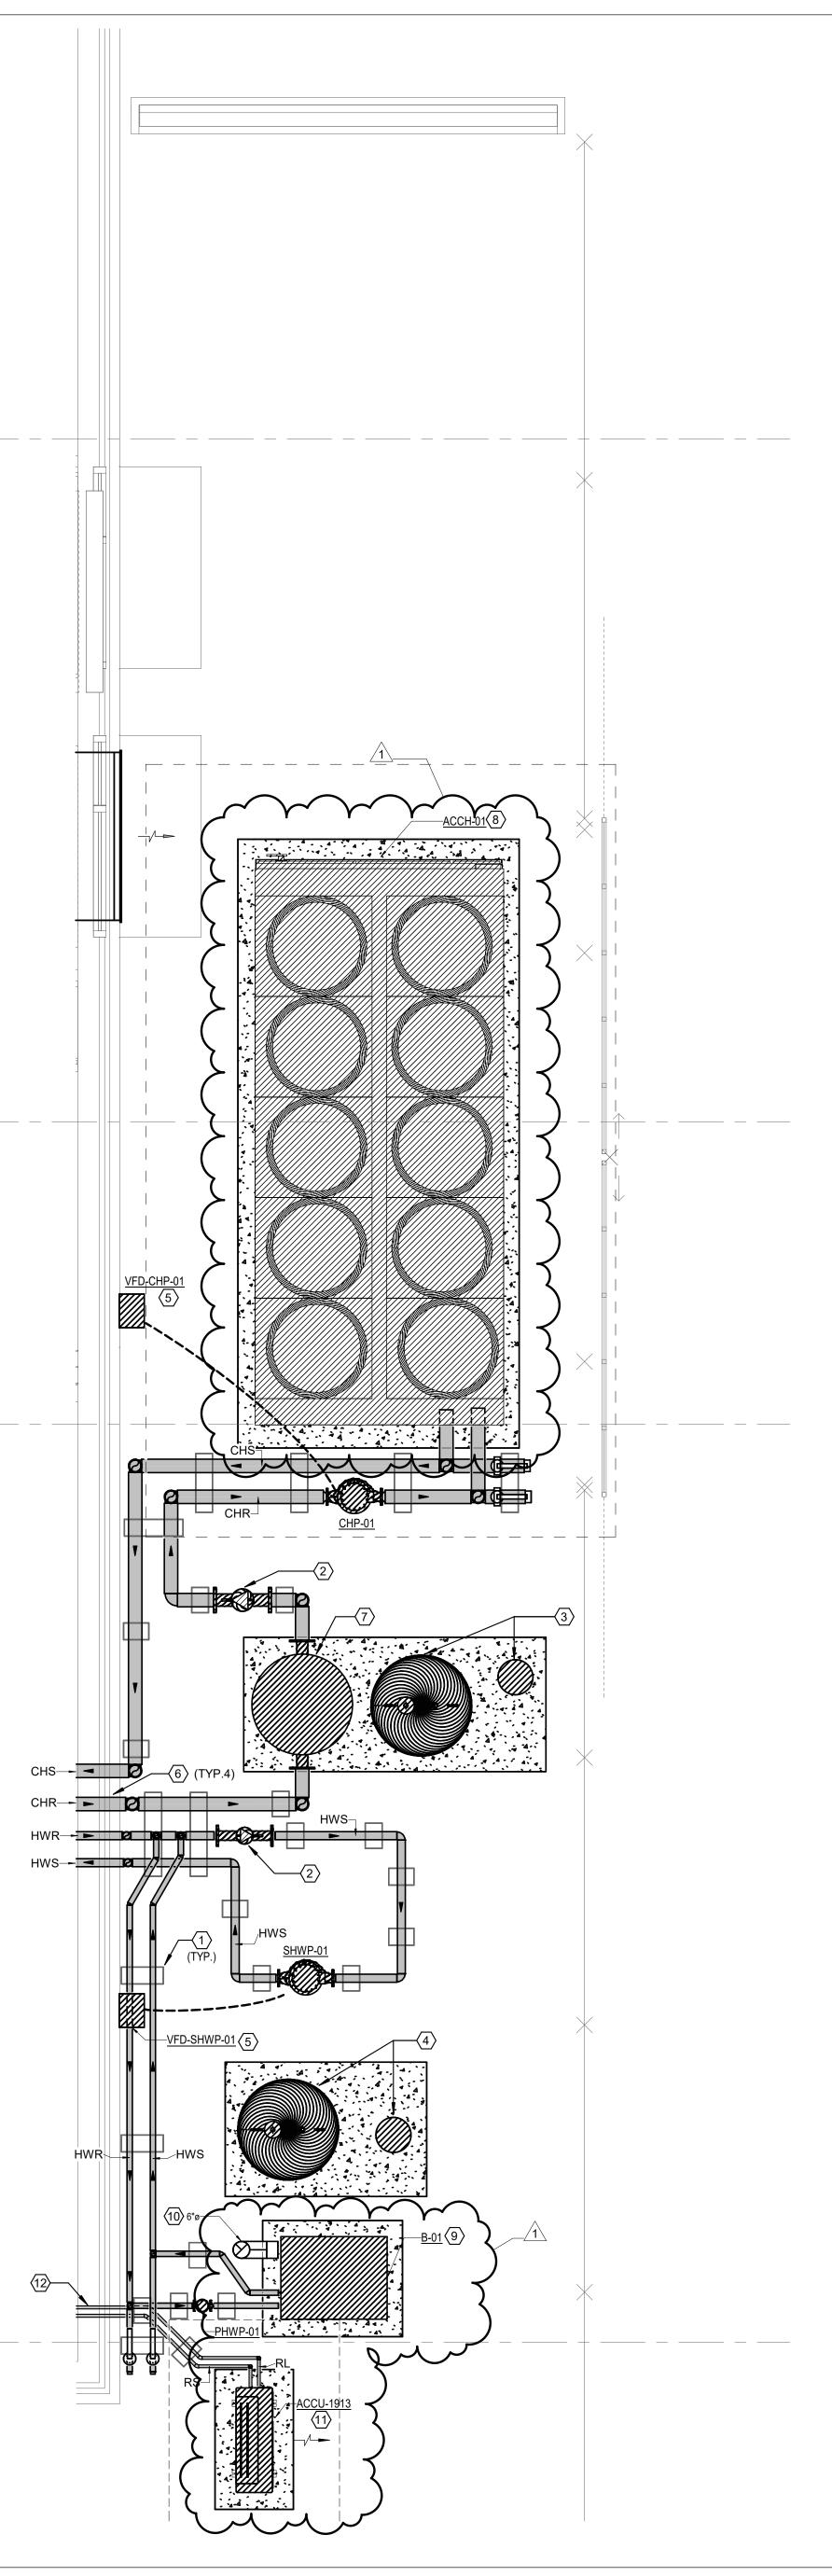

MECHANICAL KEYED NOTES:

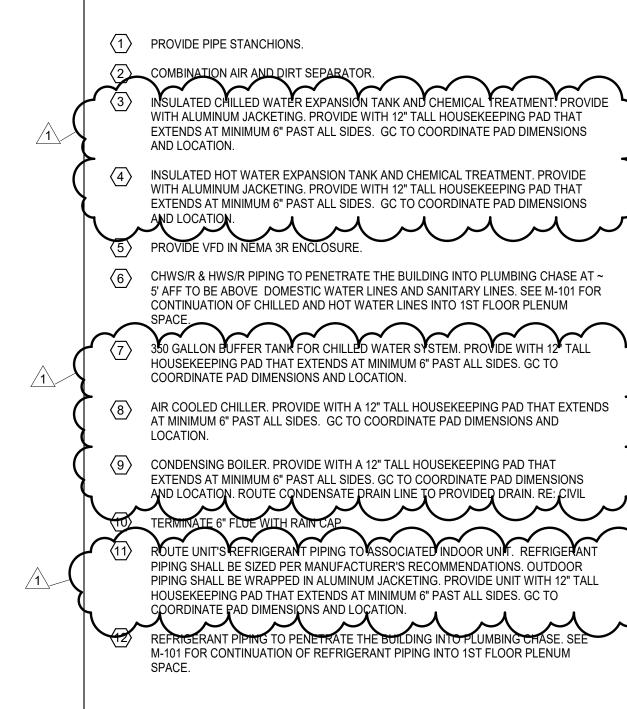


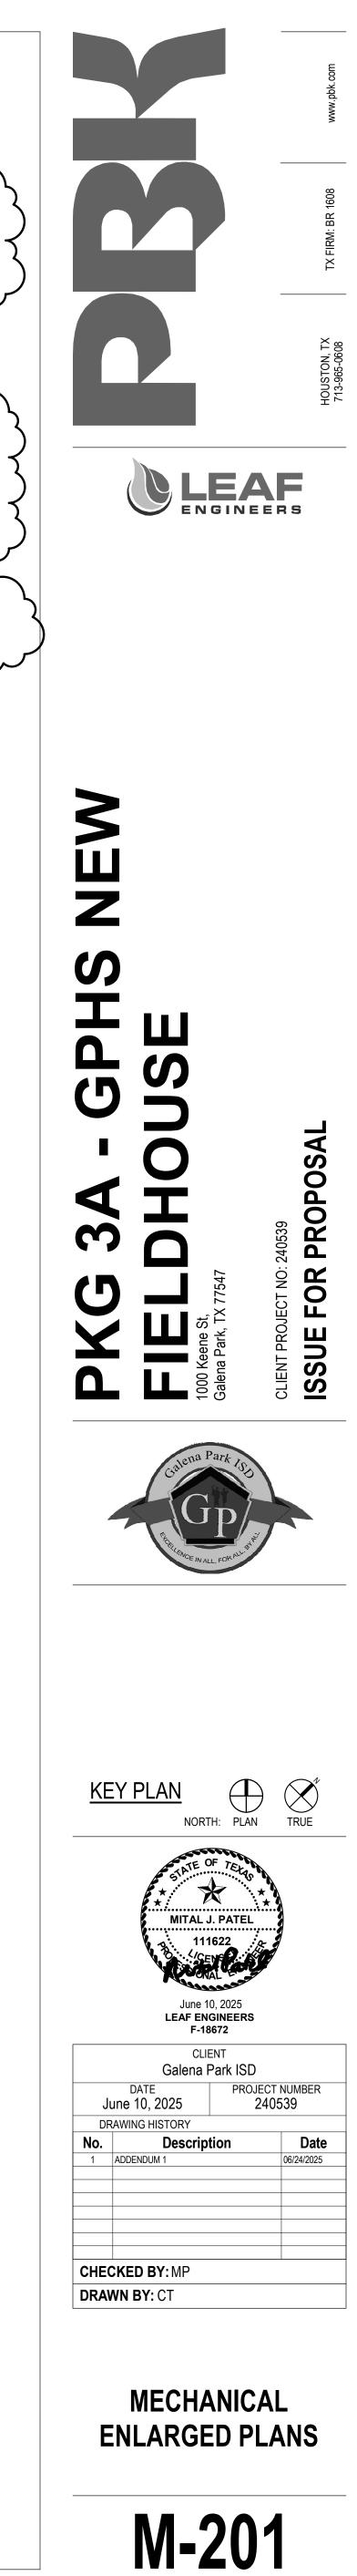

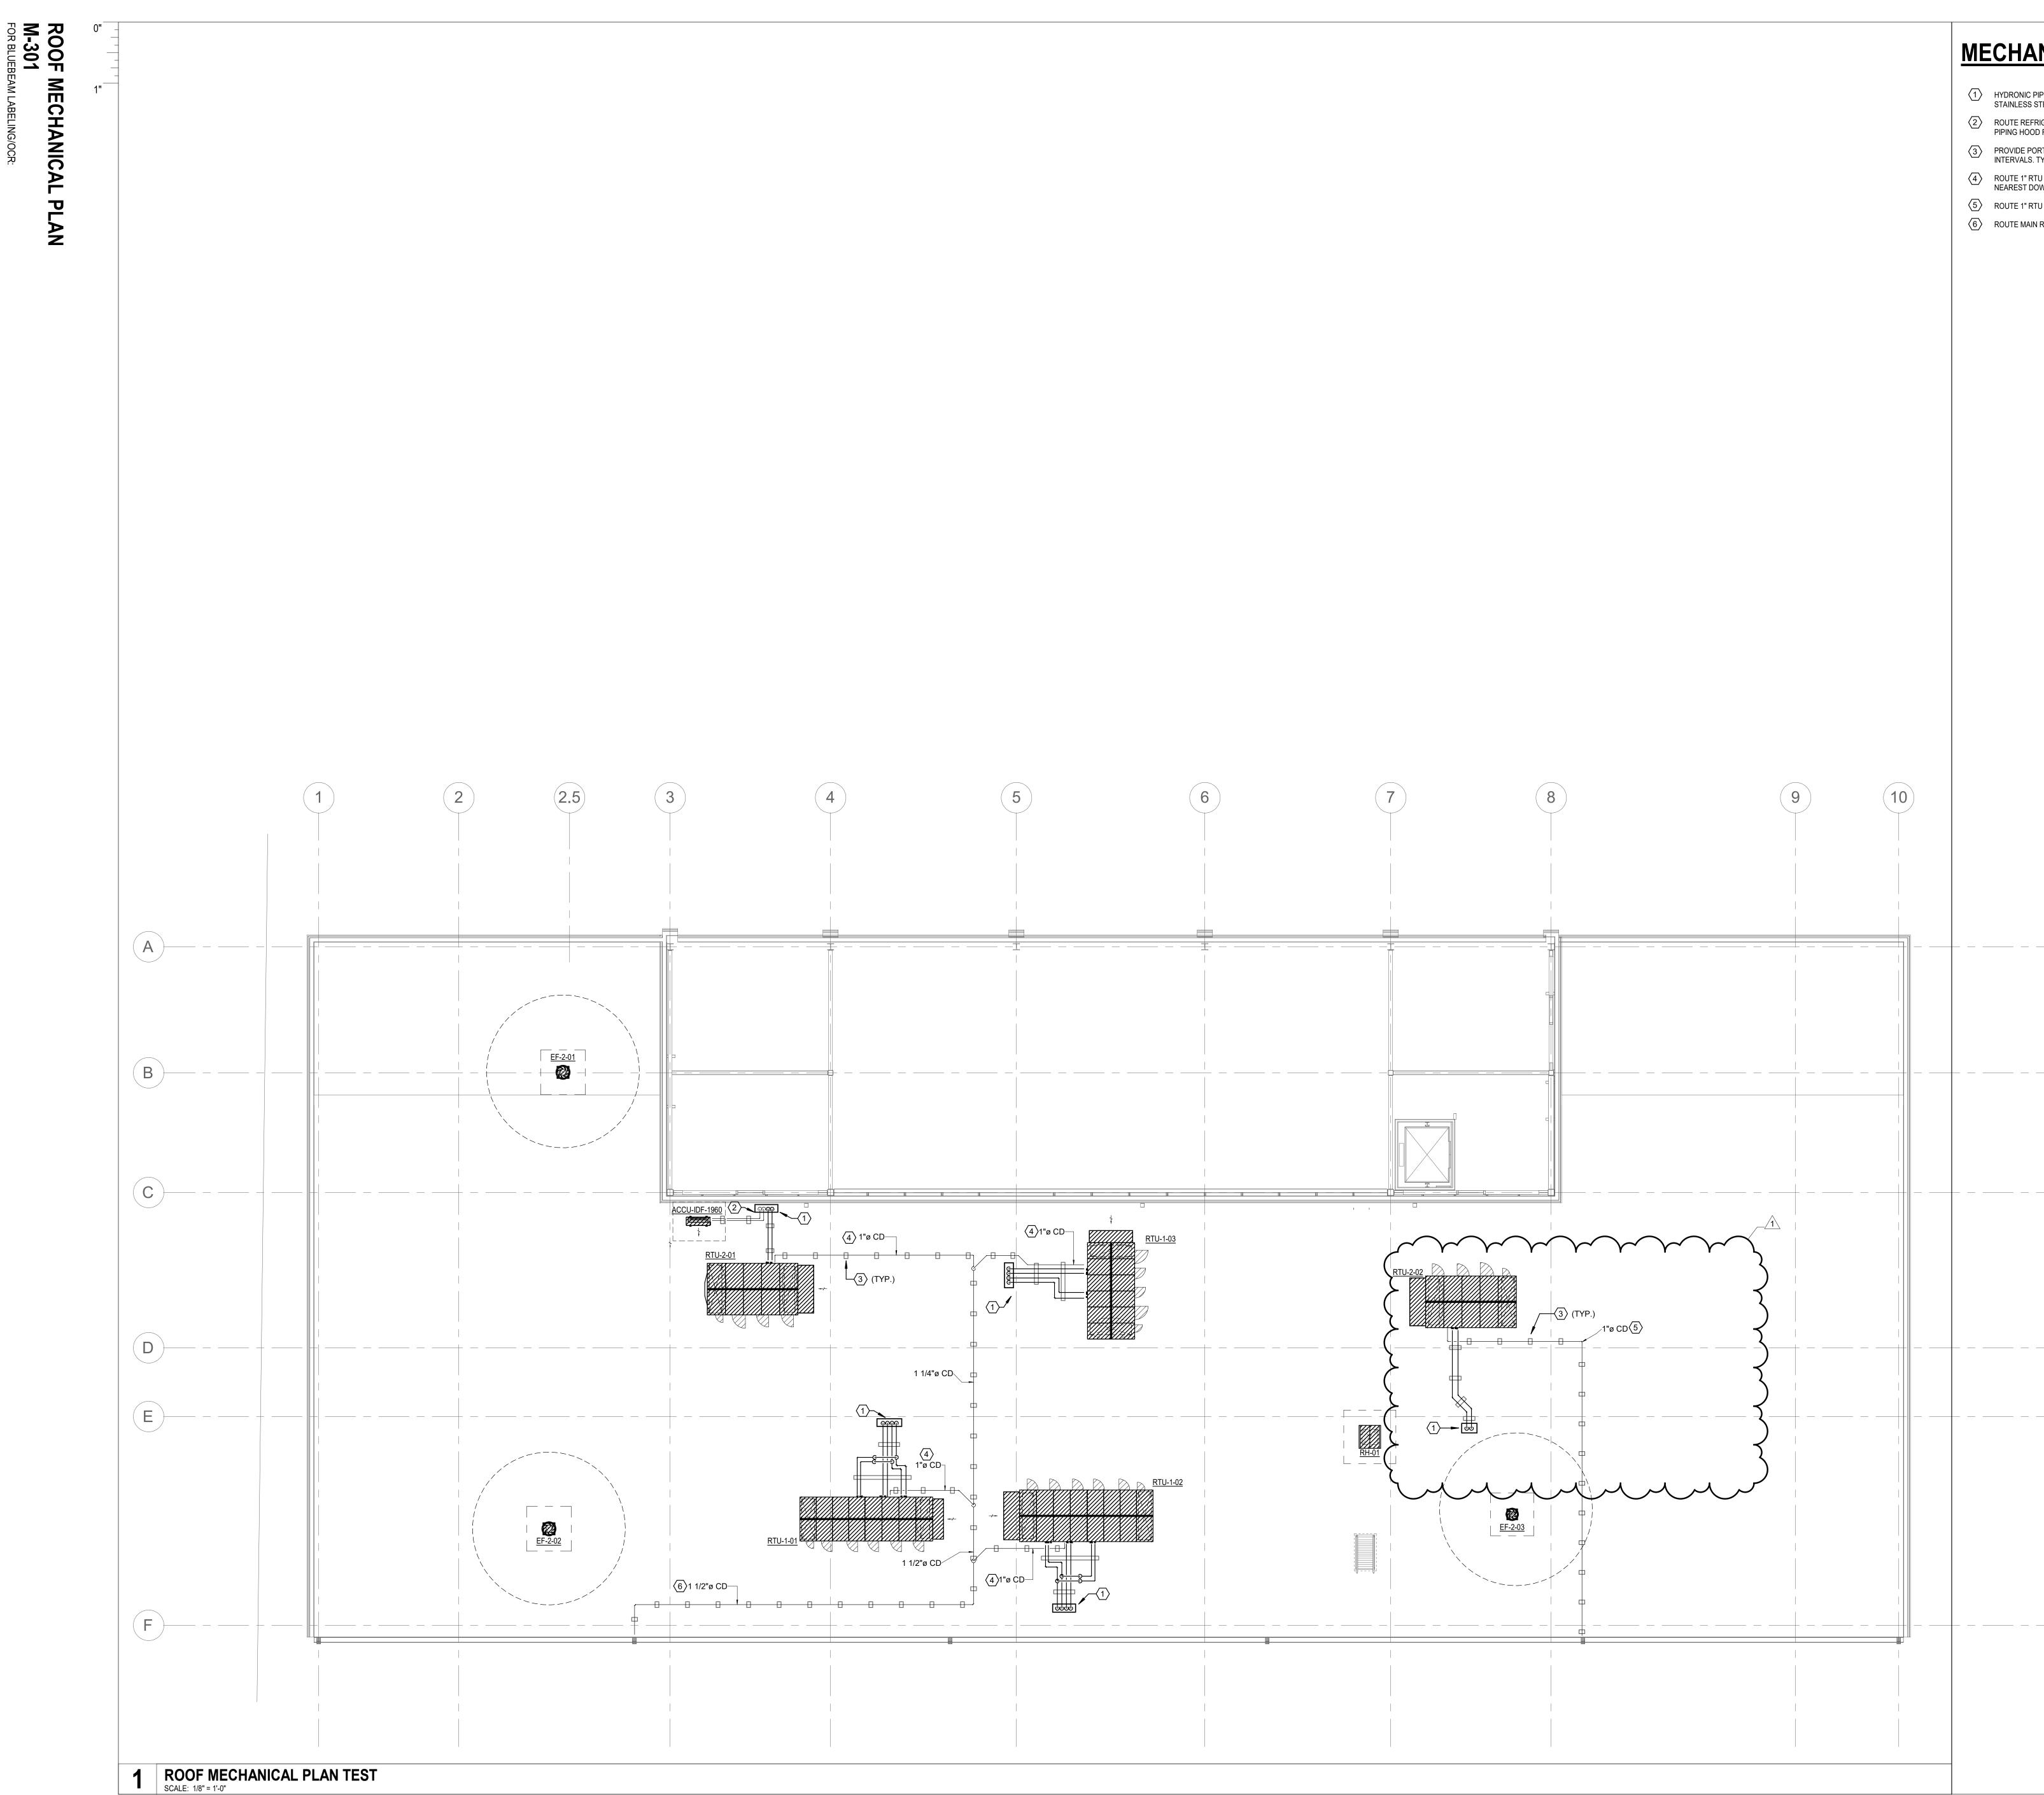

MECHANICAL KEYED NOTES:


- (1) HYDRONIC PIPING UP THROUGH ROOF TO ASSOCIATED UNIT. PROVIDE STAINLESS STEEL PIPING HOOD. REFER TO PIPING DIAGRAMS FOR ADDITIONAL DETAILS
- 2 ROUTE REFRIGERANT PIPING TO ASSOCIATED INDOOR UNIT. PROVIDE STAINLESS STEEL PIPING HOOD FOR PIPING ROOF PENETRATION.
- 3 PROVIDE PORTABLE PIPE SUPPORTS IN MAXIMUM HORIZONTAL SPACING OF 4'-0" INTERVALS. TYP.
- ROUTE 1" RTU CONDENSATE DRAIN LINE TO MAIN CONDENSATE LINE LEADING TO NEAREST DOWNSPOUT.
- 5 ROUTE 1" RTU CONDENSATE DRAIN LINE TO NEAREST DOWNSPOUT.
- 6 ROUTE MAIN RTU CONDENSATE DRAIN LINE TO DOWNSPOUT INDICATED.

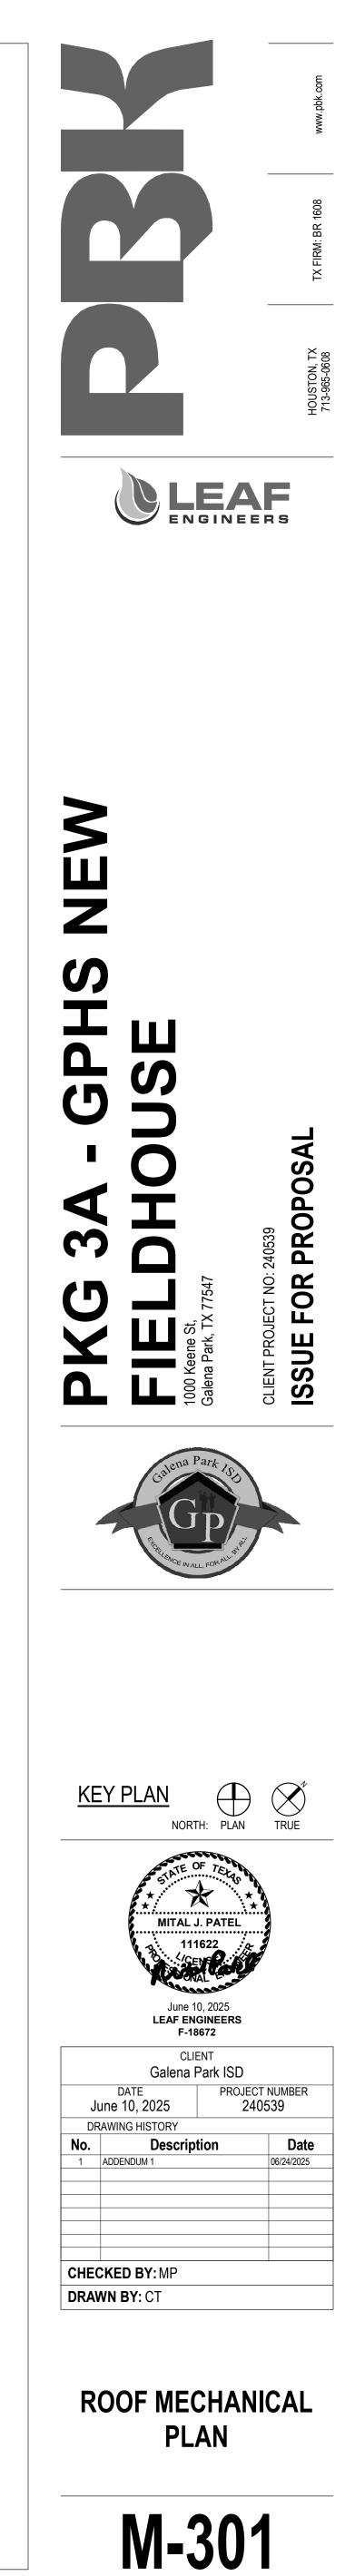

I HESPENCE LEIS PROVEC DUIN PROV	CAPACITY (TO R-454B / R-32 SCROLL 110.0 ELECTRICAL DRAWINGS FOR ELECTRICAL DATA. IIILER WITH SINGLE POINT POWER CONNECTION, FACTORY MALL BE PROVIDED WITH BACNET INTERFACE CARD. R COLS SHALL BE FULLY DIPPED AND BAKED (E-COAT) WITH L W AMBIENT HEAD PRESSURE CONTROL AS SPECIFIC. NALL SHALL BE NEC409 AND UL508A COMPLIANT (HIGH SHOR MPRESSOR SOUND BLANKETS; REFER TO SPECIFICATION 2.3 W SOUND CONDENSER FANS. ERIA 30'-0" FROM THE COIL SIDE OF THE CHILLER: A-WEIGHT DR ACOUSTIC BLANKETS AND LOW SOUND FANS SHALL BE PF COLS SHALL BE ALUMINUM / COPPER. MICROCHANNEL IS N CTORY INSTALLED HEAT FRACE FOR EVAPORATOR: ELECTRI INT WITH MULTIPLE REFRIGERANT CIRCUITS CT DRIVE-PLENUM FAN 7,180 CT DRIVE-PLENUM FAN 7,180 CT DRIVE-PLENUM FAN 7,685 CT DRIVE-PLENUM FAN 7,685 CT DRIVE-PLENUM FAN 7,685 CT DRIVE-PLENUM FAN 7,685 CT DRIVE-PLENUM FAN 6,755	2 56% 42% 189 2 189 189 2 180 180 2 180 180 2 180 180 3 180 180 3 180 180 3 180 180 3 180 180 3 180 180 3 180 180 4 180 180 3 180 180 4 180 180 4 180 180 4 180 180 5 180 180 4 180 180 4 180 180 4 180 180 5 180 180 5 180 190 5 190 190 190 190 190 190 190 190 190 190 190	175 SCONNECT SWITCH, AND FACTORY MOUN OR CONTROL REQUIREMENTS. T EXCEED 70 DBA. IBA IS MET WITHOUT. ARATE 120/1/60 CIRCUIT TO THE EVAPOR OR COOLING COIL DATA AIR HANDLING UNIT S COOLING COIL DATA AND TOTAL BTUH EAT (°F DB) EAT (°F V) 364,362 300,955 300,412 AIR SALE AND TOTAL BTUH EAT (°F DB) EAT (°F V) AUX OF TOTAL BTUH EAT (°F DB) EAT (°F V) AUX OF TOTAL BTUH EAT (°F DB) EAT (°F V) 300,955 300,412 82.3° AUX OF TOTAL BTUH EAT (°F DB) EAT (°F V) AUX OF TOTAL BTUH EAT (°F DB) EAT (°F V) AUX OF TOTAL BTUH EAT (°F DB) EAT (°F V) AUX OF TOTAL BTUH EAT (°F V) </th <th>TE (GPM) FOULING FACTOR NO. OF PAR 0.0001 1.00 0.0001 1.00 0.0001 1.00 0.0001 1.00 0.0001 1.00 0.0001 1.00 0.0001 1.00 0.0001 0.001 0.0001 0.001 0.0001 0.001 0.0001 0.001 0.0001 0.001 0.0001 0.001 0.0001 0.001 0.0001 0.001 0.0001 0.001 0.001 0</th> <th>ASS MAX. P.D. (FEET) 6.33 6.33 0 0 6.33 0 0 0 0 0 0 0 0 0 0 0 0 0</th> <th>RS AIR-COOLED SCHEDUL INT TEMP. (*F) MAX. UNIT KW / TON (@ DESIG 105°F 1.23 RE-HEATING COL DATA VELOCITY (FPM) GRAND TOTAL BTUH EAT (*F DB) 750 280,794 40.5° 750 294,516 47.0° 750 204,904 NO RE-HEAT COIL NO RE-HEAT COIL NO RE-HEAT COIL</th> <th>GN CONDITIONS)</th> <th>MANUFACTURER</th> <th></th> <th>EAT (°F DB) LAT (°F DB) GPM EWT (°F DB) LWT (°F 37.8° 55.0° 6 140.0° 100.1 44.9° 55.0° 4 140.0° 100.1 OIL</th>	TE (GPM) FOULING FACTOR NO. OF PAR 0.0001 1.00 0.0001 1.00 0.0001 1.00 0.0001 1.00 0.0001 1.00 0.0001 1.00 0.0001 1.00 0.0001 0.001 0.0001 0.001 0.0001 0.001 0.0001 0.001 0.0001 0.001 0.0001 0.001 0.0001 0.001 0.0001 0.001 0.0001 0.001 0.001 0	ASS MAX. P.D. (FEET) 6.33 6.33 0 0 6.33 0 0 0 0 0 0 0 0 0 0 0 0 0	RS AIR-COOLED SCHEDUL INT TEMP. (*F) MAX. UNIT KW / TON (@ DESIG 105°F 1.23 RE-HEATING COL DATA VELOCITY (FPM) GRAND TOTAL BTUH EAT (*F DB) 750 280,794 40.5° 750 294,516 47.0° 750 204,904 NO RE-HEAT COIL NO RE-HEAT COIL NO RE-HEAT COIL	GN CONDITIONS)	MANUFACTURER		EAT (°F DB) LAT (°F DB) GPM EWT (°F DB) LWT (°F 37.8° 55.0° 6 140.0° 100.1 44.9° 55.0° 4 140.0° 100.1 OIL
	CAPACITY (TO R-454B / R-32 SCROLL 110.0 ELECTRICAL DRAWINGS FOR ELECTRICAL DATA. IIILER WITH SINGLE POINT POWER CONNECTION, FACTORY MALL BE PROVIDED WITH BACNET INTERFACE CARD. R COLS SHALL BE FULLY DIPPED AND BAKED (E-COAT) WITH L W AMBIENT HEAD PRESSURE CONTROL AS SPECIFIC. NALL SHALL BE NEC409 AND UL508A COMPLIANT (HIGH SHOR MPRESSOR SOUND BLANKETS; REFER TO SPECIFICATION 2.3 W SOUND CONDENSER FANS. ERIA 30'-0" FROM THE COIL SIDE OF THE CHILLER: A-WEIGHT DR ACOUSTIC BLANKETS AND LOW SOUND FANS SHALL BE PF COLS SHALL BE ALUMINUM / COPPER. MICROCHANNEL IS N CTORY INSTALLED HEAT FRACE FOR EVAPORATOR: ELECTRI INT WITH MULTIPLE REFRIGERANT CIRCUITS CT DRIVE-PLENUM FAN 7,180 CT DRIVE-PLENUM FAN 7,180 CT DRIVE-PLENUM FAN 7,685 CT DRIVE-PLENUM FAN 7,685 CT DRIVE-PLENUM FAN 7,685 CT DRIVE-PLENUM FAN 7,685 CT DRIVE-PLENUM FAN 6,755	3 56°F 42°F 189 APP MOUNTED NON-FUSED MOLDED CASE DISC APP MOUNTED NON-FUSED MOLDED CASE DISC TH UV TOP COAT. NORT CIRCUIT CURRENT RATING.) N2.3.C FOR ULTRA LOW SOUND COMPRESSOF SHTED SOUND PRESSURE LEVEL SHALL NOT I E PROVIDED REGARDLESS IF SCHEDULED DB/ IS NOT ALLOWED. TRICAL CONTRACTOR SHALL PROVIDE SEPAF STATION HYDRONIC AI MAIN CO COCITY (FPM) GRAND SENSIBLE BTUH GRAND 210,503 2210,503 236,671 3 210,503 3 214,472 3 3 214,472 3 3 4 198,898	MINIMUM EVAPORATOR FLOW RATE 175 SCONNECT SWITCH, AND FACTORY MOUN OR CONTROL REQUIREMENTS. T EXCEED 70 DBA. BA IS MET WITHOUT. ARATE 120/1/60 CIRCUIT TO THE EVAPOR AIR HANDLING UNIT S COOLING COIL DATA AND TOTAL BTUH EAT (°F DB) EAT (°F N 364,362 87.6° 73.0° 390,955 85.5° 71.3° 299,0° 82.3° 68.6° 308,135 80.8° 67.3° 300,412 82.3° 68.6° 300,412 82.3° 68.6°	TE (GPM) FOULING FACTOR NO. OF PAR 0.0001 1.00 0.0001 1.00 0.001 1.00 0.001 1.00 0.001 1.00 0.001 1.00 0.001 1.00 0.001 1.00 0.001 1.00 0.001 0.001 </th <th>ASS MAX. P.D. (FEET) 6.33 </th> <th>105°F 1.23 105°F 1.23 RE-HEATING COL DATA RE-HEATING COL DATA VELOCITY (FPM) GRAND TOTAL BTUH EAT (°F DB) 750 286,794 40.5° 750 294,516 47.0° 750 294,516 47.0° 750 294,516 47.0° 750 294,516 47.0° 750 294,516 47.0° 750 294,516 47.0° 750 294,516 47.0° 750 294,516 47.0° 750 204,904 6.9° NO RE-HEAT COIL NO RE-HEAT COIL</th> <th>GN CONDITIONS) FULL LOAD (EER) IP</th> <th>MANUFACTURER PLV (EER)</th> <th>CGAM 205.2' CGAM 205.2' PRE-HEATING COLL I COCITY (FPM) GRAND TOTAL BTUH 0 110,646 0 78,084 NO PRE-HEAT CO NO PRE-HEAT CO</th> <th>INS (L x W x H) INCHES WEIGHT (lbs) INCA I .2" x 88.4" x 92.5" 8,300 262 </th>	ASS MAX. P.D. (FEET) 6.33	105°F 1.23 105°F 1.23 RE-HEATING COL DATA RE-HEATING COL DATA VELOCITY (FPM) GRAND TOTAL BTUH EAT (°F DB) 750 286,794 40.5° 750 294,516 47.0° 750 294,516 47.0° 750 294,516 47.0° 750 294,516 47.0° 750 294,516 47.0° 750 294,516 47.0° 750 294,516 47.0° 750 294,516 47.0° 750 204,904 6.9° NO RE-HEAT COIL NO RE-HEAT COIL	GN CONDITIONS) FULL LOAD (EER) IP	MANUFACTURER PLV (EER)	CGAM 205.2' CGAM 205.2' PRE-HEATING COLL I COCITY (FPM) GRAND TOTAL BTUH 0 110,646 0 78,084 NO PRE-HEAT CO NO PRE-HEAT CO	INS (L x W x H) INCHES WEIGHT (lbs) INCA I .2" x 88.4" x 92.5" 8,300 262
	ELECTRICAL DRAWINGS FOR ELECTRICAL DATA. IILLER WITH SINGLE POINT POWER CONNECTION, FACTORY M ALL BE PROVIDED WITH BACNET INTERFACE CARD. R COLS SHALL BE FULLY DIPPED AND BAKED (E-COAT) WITH L W AMBIENT HEAD PRESSURE CONTROL AS SPECIFIED. ANEL SHALL BE NEC409 AND UL508A COMPLIANT (HIGH SHOR MPRESSOR SOUND BLANKETS; REFER TO SPECIFICATION 2.3 W SOUND CONDENSER FANS. ERIA 30'-0' FROM THE COIL SIDE OF THE CHILLER: A-WEIGHT DR ACOUSTIC BLANKETS AND LOW SOUND FANS SHALL BE PR VOOLS SHALL BE ALLMINUM / COPPER. MICROCHANNEL IS N CTORY INSTALLED HEAT FRACE FOR EVAPORATOR. ELECTRI IT WITH MULTIPLE REFRIGERANT CIRCUITS KAGED, OUTDOOR, CENTRAL-S TYPE CFM OVER COIL MAX. FACE VELOC CT DRIVE-PLENUM FAN 7,180 500 CT DRIVE-PLENUM FAN 7,695 500 CT DRIVE-PLENUM FAN 7,695 500 CT DRIVE-PLENUM FAN 7,695 500	RY MOUNTED NON-FUSED MOLDED CASE DISC TH UV TOP COAT. NORT CIRCUIT CURRENT RATING.) N 2.3.C FOR ULTRA LOW SOUND COMPRESSOF SHTED SOUND PRESSURE LEVEL SHALL NOT I E PROVIDED REGARDLESS IF SCHEDULED DB/ IS NOT ALLOWED. TRICAL CONTRACTOR SHALL PROVIDE SEPAF STATION HYDRONIC AL MAIN CC OCITY (FPM) GRAND SENSIBLE BTUH GRA 2 210,503 2 210,503 2 210,503 2 214,472 3 198,898	OR CONTROL REQUIREMENTS. T EXCEED 70 DBA. BA IS MET WITHOUT. ARATE 120/1/60 CIRCUIT TO THE EVAPOR AIR HANDLING UNIT S COOLING COIL DATA AND TOTAL BTUH EAT (°F DB) EAT (°F V 364,362 87.6° 73.0° 390,955 85.5° 71.3° 299,01 82.2 68.6° 308,135 80.8° 67.3° 300,412 82.3° 68.6°	DUNTED 120V RECEPTICLE.	OB) CFM OVER COIL MAX. FACE 0 5,970 0 0 7,180 0 0 6,720 0	RE-HEATING COL DATA VELOCITY (FPM) GRAND TOTAL BTUH EAT (°F DB) 750 286,794 40.5° 750 294,516 47.0° 750 294,516 47.0° 750 294,516 47.0° 750 294,516 47.0° 750 209,904 46.9° NO RE-HEAT COIL NO RE-HEAT COIL	LAT ("F DB) GPM EWT ("F DB) LWT ("F DB) 85.0° 14 140.0° 100.0° 85.0° 15 140.0° 100.0° 85.0° 10 100.0° 100.0°	CFM OVER COIL 5,970 7,180 7,180 750 7,180 750 7,180 750	PRE-HEATING COLL I LOCITY (FPM) GRAND TOTAL BTUH EA 0 110,646 0 78,084 NO PRE-HEAT CO NO PRE-HEAT CO	DATA EAT (°F DB) LAT (°F DB) GPM EWT (°F DB) LWT (°F 37.8° 55.0° 6 140.0° 100.1 44.9° 55.0° 4 140.0° 100.1 OIL
	IILLER WITH SINGLE POINT POWER CONNECTION, FACTORY M ALL BE PROVIDED WITH BACNET INTERFACE CARD. R COLS SHALL BE FULLY DIPPED AND BAKED (E-COAT) WITH U WAMBIENT HEAD PRESSURE CONTROL AS SPECIFIED. ANEL SHALL BE NEC409 AND UL508A COMPLIANT (HIGH SHOR MORESSOR SOUND BLANKETS; REFER TO SPECIFICATION 2.3 W SOUND CONDENSER FANS. ERIA 30'-0" FROM THE COLL SIDE OF THE CHILLER: A-WEIGHT OR ACOUSTIC BLANKETS AND LOW SOUND FANS SHALL BE PR COLLS SHALL BE ALLINIUMU / COPPER, MICROCHANNEL IS N CTORY INSTALLED HEAT TRACE FOR EVAPORATOR. ELECTRI IT WITH MULTIPLE REFRIGERANT CIRCUITS KAGGED, OUTDOOR, CENTRAL-S TYPE CFM OVER COLI MAX. FACE VELOC CT DRIVE-PLENUM FAN 5.970 500 CT DRIVE-PLENUM FAN 7,180 500 CT DRIVE-PLENUM FAN 7,180 500 CT DRIVE-PLENUM FAN 7,180 500 CT DRIVE-PLENUM FAN 7,180 500	TH UV TOP COAT.	OR CONTROL REQUIREMENTS. T EXCEED 70 DBA. BA IS MET WITHOUT. ARATE 120/1/60 CIRCUIT TO THE EVAPOR AIR HANDLING UNIT S COOLING COIL DATA AND TOTAL BTUH EAT (°F DB) EAT (°F V 364,362 87.6° 73.0° 390,955 85.5° 71.3° 299,01 82.2 68.6° 308,135 80.8° 67.3° 300,412 82.3° 68.6°	DRATOR. Drator. DRATOR. Drator. SCHEDULE EWT (°F DB) LWT (°F DB) 0° 55.0° 52 42.0° 56.0° 3° 55.0° 56 42.0° 56.0° 3° 55.0° 44 42.0° 56.0°		EVELOCITY (FPM) GRAND TOTAL BTUH EAT (°F DB) 750 286,794 40.5° 750 294,516 47.0° 750 209,904 66.9° NO RE-HEAT COIL NO RE-HEAT COIL	LAT (°F DB) GPM EWT (°F DB) LWT (°F DB) 85.0° 14 140.0° 100.0° 85.0° 15 140.0° 100.0° 85.0° 15 140.0° 100.0° 85.0° 10 100.0° 100.0°	CFM OVER COIL MAX. FACE VELO 5,970 750 7,180 750	LOCITY (FPM) GRAND TOTAL BTUH EA 0 110,646 0 78,084 NO DRE-HEAT CO NO PRE-HEAT CO	EAT (°F DB) LAT (°F DB) GPM EWT (°F DB) LWT (°F 37.8° 55.0° 6 140.0° 100.1 44.9° 55.0° 4 140.0° 100.1 OIL
	W AMBIENT HEAD PRESSURE CONTROL AS SPECIFICA ANEL SHALL BE NEC409 AND UL508A COMPLIANT (HIGH SHOR MPRESSOR SOUND BLANKETS; REFER TO SPECIFICATION 2.3 W SOUND CONDENSER FANS. ERIA 30'-0" FROM THE COIL SIDE OF THE CHILLER: A-WEIGHT DR ACOUSTIC BLANKETS AND LOW SOUND FANS SHALL BE PR COOLS SHALL BE ALLMINUM / COPPER_MICROCHANNEL IS N CTORY INSTALLED HEAT TRACE FOR EVAPORATOR. ELECTRI IT WITH MULTIPLE REFRIGERANT CIRCUITS ACOUSTIC BLANKETS AND LOW SOUND FANS SHALL BE PR COOLS SHALL BE ALLMINUM / COPPER_MICROCHANNEL IS N CTORY INSTALLED HEAT TRACE FOR EVAPORATOR. ELECTRI IT WITH MULTIPLE REFRIGERANT CIRCUITS ACAGED, OUTDOOR, CENTRAL-S CT DRIVE-PLENUM FAN 5,970 500 CT DRIVE-PLENUM FAN 7,180 500 CT DRIVE-PLENUM FAN 7,695 500 CT DRIVE-PLENUM FAN 6,755 500	IORT CIRCUIT CURRENT RATING.) SHTED SOUND PRESSURE LEVEL SHALL NOT I E PROVIDED REGARDLESS IF SCHEDULED DB/ IS NOT ALLOWED. TRICAL CONTRACTOR SHALL PROVIDE SEPAF -STATION HYDRONIC AI MAIN CC OCITY (FPM) GRAND SENSIBLE BTUH GRAN 0 210,503 0 214,472 0 214,472 0 198,898 0 214,472	T EXCEED 70 DBA. BA IS MET WITHOUT. ARATE 120/1/60 CIRCUIT TO THE EVAPOR ARATE 120/1/60 CIRCUIT TO THE EVAPOR ARATE 120/1/60 CIRCUIT TO THE EVAPOR COOLING COIL DATA AND TOTAL BTUH EAT (°F DB) EAT (°F V 364,362 87.6° 73.0° 390,955 85.5° 71.3° 299,0 82.3° 68.6° 308,135 80.8° 67.3° 300,412 82.3° 68.6° 1000000000000000000000000000000000000	SCHEDULE F WB) LAT (°F DB) GPM EWT (°F DB) LWT (°F D 0° 55.0° 52 42.0° 56.0° 3° 55.0° 56 42.0° 56.0° 3° 55.0° 44 42.0° 56.0°		EVELOCITY (FPM) GRAND TOTAL BTUH EAT (°F DB) 750 286,794 40.5° 750 294,516 47.0° 750 209,904 66.9° NO RE-HEAT COIL NO RE-HEAT COIL	LAT (°F DB) GPM EWT (°F DB) LWT (°F DB) 85.0° 14 140.0° 100.0° 85.0° 15 140.0° 100.0° 85.0° 15 140.0° 100.0° 85.0° 15 140.0° 100.0° 10 10 100.0° 100.0°	CFM OVER COIL MAX. FACE VELO 5,970 750 7,180 750	LOCITY (FPM) GRAND TOTAL BTUH EA 0 110,646 0 78,084 NO DRE-HEAT CO NO PRE-HEAT CO	EAT (°F DB) LAT (°F DB) GPM EWT (°F DB) LWT (°F 37.8° 55.0° 6 140.0° 100.1 44.9° 55.0° 4 140.0° 100.1 OIL OIL 0 0 100.1
	MPRESSOR SOUND BLANKETS; REFER TO SPECIFICATION 2.3 W SOUND CONDENSER FANS. TERIA 30-0° FROM THE COIL SIDE OF THE CHILLER: A-WEIGHT OR ACOUSTIC BLANKETS AND LOW SOUND FANS SHALL BE PF COUSS SHALL BE A-LUNINUM / COUPER, MICROCHANNEL IS N CTORY INSTALLED HEAT FRACE FOR EVAPORATOR. ELECTRI IT WITH MULTIPLE REFRIGERANT CIRCUITS AGGED, OUTDOOR, CENTRAL-S TYPE CFM OVER COL MAX. FACE VELOC CT DRIVE-PLENUM FAN 5,970 500 CT DRIVE-PLENUM FAN 7,180 500 CT DRIVE-PLENUM FAN 7,695 500 CT DRIVE-PLENUM FAN 7,695 500	A 2.3.C FOR ULTRA LOW SOUND COMPRESSOR SHTED SOUND PRESSURE LEVEL SHALL NOT I E PROVIDED REGARDLESS IF SCHEDULED DB/ IS NOT ALLOWED. TRICAL CONTRACTOR SHALL PROVIDE SEPAR -STATION HYDRONIC AI MAIN CC 0 210,503 2 2 2 2 2 2 2 2 2 2 2 2 2 2 2 2 2 2 2	T EXCEED 70 DBA. BA IS MET WITHOUT. ARATE 120/1/60 CIRCUIT TO THE EVAPOR ARATE 120/1/60 CIRCUIT TO THE EVAPOR ARATE 120/1/60 CIRCUIT TO THE EVAPOR COOLING COIL DATA AND TOTAL BTUH EAT (°F DB) EAT (°F V 364,362 87.6° 73.0° 390,955 85.5° 71.3° 299,0 82.3° 68.6° 308,135 80.8° 67.3° 300,412 82.3° 68.6° 1000000000000000000000000000000000000	SCHEDULE F WB) LAT (°F DB) GPM EWT (°F DB) LWT (°F D 0° 55.0° 52 42.0° 56.0° 3° 55.0° 56 42.0° 56.0° 3° 55.0° 44 42.0° 56.0°		EVELOCITY (FPM) GRAND TOTAL BTUH EAT (°F DB) 750 286,794 40.5° 750 294,516 47.0° 750 209,904 66.9° NO RE-HEAT COIL NO RE-HEAT COIL	LAT ('F DB) GPM EWT ('F DB) LWT ('F DB) 85.0° 14 140.0° 100.0° 85.0° 15 140.0° 100.0° 85.0° 15 140.0° 100.0° 100.0°	CFM OVER COIL MAX. FACE VELO 5,970 750 7,180 750	LOCITY (FPM) GRAND TOTAL BTUH EA 0 110,646 0 78,084 NO DRE-HEAT CO NO PRE-HEAT CO	EAT (°F DB) LAT (°F DB) GPM EWT (°F DB) LWT (°F 37.8° 55.0° 6 140.0° 100.1 44.9° 55.0° 4 140.0° 100.1 OIL OIL 0 0 100.1
	TYPE CFM OVER COIL MAX. FACE VELOC CT DRIVE-PLENUM FAN 7,695 500 CT DRIVE-PLENUM FAN 7,695 500 CT DRIVE-PLENUM FAN 7,695 500	E PROVIDED REGARDLESS IF SCHEDULED DB/	BA IS MET WITHOUT. ARATE 120/1/60 CIRCUIT TO THE EVAPOR AIR HANDLING UNIT S COOLING COIL DATA AND TOTAL BTUH EAT (°F DB) EAT (°F V 364,362 87.6° 73.0° 390,955 85.5° 71.3° 299,0° 82.3° 68.6° 308,135 80.8° 67.3° 300,412 82.3° 68.6°	SCHEDULE F WB) LAT (°F DB) GPM EWT (°F DB) LWT (°F D 0° 55.0° 52 42.0° 56.0° 3° 55.0° 56 42.0° 56.0° 3° 55.0° 44 42.0° 56.0°		EVELOCITY (FPM) GRAND TOTAL BTUH EAT (°F DB) 750 286,794 40.5° 750 294,516 47.0° 750 209,904 66.9° NO RE-HEAT COIL NO RE-HEAT COIL	LAT ('F DB) GPM EWT ('F DB) LWT ('F DB) 85.0° 14 140.0° 100.0° 85.0° 15 140.0° 100.0° 85.0° 15 140.0° 100.0° 85.0° 15 140.0° 100.0°	CFM OVER COIL MAX. FACE VELO 5,970 750 7,180 750	LOCITY (FPM) GRAND TOTAL BTUH EA 0 110,646 0 78,084 NO DRE-HEAT CO NO PRE-HEAT CO	EAT (°F DB) LAT (°F DB) GPM EWT (°F DB) LWT (°F 37.8° 55.0° 6 140.0° 100.1 44.9° 55.0° 4 140.0° 100.1 OIL OIL 0 0 100.1
	CORS SHALL BE ALUMINUM / CORPER. MICROCHANNEL IS N CTORY INSTALLED HEAT FRACE FOR EVAPORATOR. ELECTRI IT WITH MULTIPLE REFRIGERANT CIRCUITS AGGED, OUTDOOR, CENTRAL-S TYPE CFM OVER COL MAX. FACE VELOC CT DRIVE-PLENUM FAN 5,970 500 CT DRIVE-PLENUM FAN 7,180 500 CT DRIVE-PLENUM FAN 7,180 500 CT DRIVE-PLENUM FAN 6,755 500	IS NOT ALLOWED. TRICAL CONTRACTOR SHALL PROVIDE SEPAR -STATION HYDRONIC AI MAIN CO OCITY (FPM) GRAND SENSIBLE BTUH GRAN 0 210,503 0 210,503 0 214,472 0 214,472 0 198,898 	ARATE 120/1/60 CIRCUIT TO THE EVAPOR ARATE 120/1/60 CIRCUIT TO THE EVAPOR AIR HANDLING UNIT S COOLING COIL DATA AND TOTAL BTUH EAT (°F DB) EAT (°F V 364,362 87.6° 73.0° 399,955 85.5° 71.3° 299,0 82.3° 68.6° 308,135 80.8° 67.3° 300,412 82.3° 68.6°	SCHEDULE F WB) LAT (°F DB) GPM EWT (°F DB) LWT (°F D 0° 55.0° 52 42.0° 56.0° 3° 55.0° 56 42.0° 56.0° 3° 55.0° 44 42.0° 56.0°		EVELOCITY (FPM) GRAND TOTAL BTUH EAT (°F DB) 750 286,794 40.5° 750 294,516 47.0° 750 209,904 66.9° NO RE-HEAT COIL NO RE-HEAT COIL	LAT ('F DB) GPM EWT (°F DB) LWT ('F DB) 85.0° 14 140.0° 100.0° 85.0° 15 140.0° 100.0° 85.0° 15 140.0° 100.0° 85.0° 15 140.0° 100.0° 85.0° 15 140.0° 100.0° 85.0° 15 140.0° 100.0° 85.0° 15 140.0° 100.0° 85.0° 15 140.0° 100.0° 85.0° 10 10 100.0°	CFM OVER COIL MAX. FACE VELU 5,970 750 7,180 750	LOCITY (FPM) GRAND TOTAL BTUH EA 0 110,646 0 78,084 NO DRE-HEAT CO NO PRE-HEAT CO	EAT (°F DB) LAT (°F DB) GPM EWT (°F DB) LWT (°F 37.8° 55.0° 6 140.0° 100.1 44.9° 55.0° 4 140.0° 100.1 OIL OIL 0 0 100.1
	AGGED, OUTDOOR, CENTRAL-S	STATION HYDRONIC AI	AR HANDLING UNIT S COOLING COIL DATA AND TOTAL BTUH EAT (°F DB) EAT (°F V 364,362 87.6° 73.0° 390,955 85.5° 71.3° 299,0° 82.3° 68.6° 308,135 80.8° 67.3° 300,412 82.3° 68.6°	SCHEDULE F WB) LAT (°F DB) GPM EWT (°F DB) LWT (°F D 0° 55.0° 52 42.0° 56.0° 3° 55.0° 56 42.0° 56.0° 3° 55.0° 44 42.0° 56.0°		EVELOCITY (FPM) GRAND TOTAL BTUH EAT (°F DB) 750 286,794 40.5° 750 294,516 47.0° 750 209,904 66.9° NO RE-HEAT COIL NO RE-HEAT COIL	LAT (°F DB) GPM EWT (°F DB) LWT (°F DB) 85.0° 14 140.0° 100.0° 85.0° 15 140.0° 100.0° 85.0° 15 140.0° 100.0° 85.0° 15 140.0° 100.0° 85.0° 15 140.0° 100.0°	CFM OVER COIL MAX. FACE VELO 5,970 750 7,180 750	LOCITY (FPM) GRAND TOTAL BTUH EA 0 110,646 0 78,084 NO DRE-HEAT CO NO PRE-HEAT CO	EAT (°F DB) LAT (°F DB) GPM EWT (°F DB) LWT (°F 37.8° 55.0° 6 140.0° 100.1 44.9° 55.0° 4 140.0° 100.1 OIL OIL 0 0 100.1
	TYPE CFM OVER COIL MAX. FACE VELOC CT DRIVE-PLENUM FAN 5,970 500 CT DRIVE-PLENUM FAN 7,180 500 CT DRIVE-PLENUM FAN 6,720 500 CT DRIVE-PLENUM FAN 7,695 500 CT DRIVE-PLENUM FAN 6,755 500	MAIN CC OCITY (FPM) GRAND SENSIBLE BTUH GRAND 0 210,503 0 0 236,671 0 0 214,472 0 0 198,898 0	COOLING COIL DATA	F WB) LAT (°F DB) GPM EWT (°F DB) LWT (°F D .0° 55.0° 52 42.0° 56.0° .3° 55.0° 56 42.0° 56.0° .3° 55.0° 44 42.0° 56.0°		EVELOCITY (FPM) GRAND TOTAL BTUH EAT (°F DB) 750 286,794 40.5° 750 294,516 47.0° 750 209,904 66.9° NO RE-HEAT COIL NO RE-HEAT COIL	LAT (°F DB) GPM EWT (°F DB) LWT (°F DB) 85.0° 14 140.0° 100.0° 85.0° 15 140.0° 100.0° 85.0° 15 140.0° 100.0° 85.0° 15 140.0° 100.0° 85.0° 10 10 100.0°	CFM OVER COIL 5,970 7,180 7,180 5,970 7,180 750 750 750 750 750 750 750 750 750	LOCITY (FPM) GRAND TOTAL BTUH EA 0 110,646 0 78,084 NO DRE-HEAT CO NO PRE-HEAT CO	EAT (°F DB) LAT (°F DB) GPM EWT (°F DB) LWT (°F 37.8° 55.0° 6 140.0° 100.1 44.9° 55.0° 4 140.0° 100.1 OIL OIL 0 0 100.1
	CT DRIVE-PLENUM FAN 6,755 500	OCITY (FPM) GRAND SENSIBLE BTUH GRAND 0 210,503 0 0 236,671 0 0 214,472 0 0 198,898 0	AND TOTAL BTUH 364,362 87.6° 73.0° 390,955 85.5° 71.3° 299,0° 82.3° 68.6° 308,135 80.8° 67.3° 300,412 82.3° 68.6°			EVELOCITY (FPM) GRAND TOTAL BTUH EAT (°F DB) 750 286,794 40.5° 750 294,516 47.0° 750 209,904 66.9° NO RE-HEAT COIL NO RE-HEAT COIL	LAT (°F DB) GPM EWT (°F DB) LWT (°F DB) 85.0° 14 140.0° 100.0° 85.0° 15 140.0° 100.0° 85.0° 10 00.0° 100.0° 85.0° 15 140.0° 100.0° 10 00.0° 100.0° 100.0°	CFM OVER COIL MAX. FACE VELO 5,970 750 7,180 750	LOCITY (FPM) GRAND TOTAL BTUH EA 0 110,646 0 78,084 NO DRE-HEAT CO NO PRE-HEAT CO	EAT (°F DB) LAT (°F DB) GPM EWT (°F DB) LWT (°F 37.8° 55.0° 6 140.0° 100.1 44.9° 55.0° 4 140.0° 100.1 OIL OIL 0 0 100.1
	CT DRIVE-PLENUM FAN 6,755 500		300,412 82.3° 68.6°			750 294,516 47.0° 75 209,904 66.9° NO RE-HEAT COIL		7,180	0 78,084 NO PRE-HEAT CO	
Ltt 240 FLOOR BALE DUCT VIV HCRONTAL DRAWINGS FOR ELECTRICAL DATA. UNRECE ELECTRICAL DRAWINGS FOR ELECTRICAL DATA. INVEDED ELECTRICAL DRAWINGS FOR ELECTRICAL DATA. UNRECE ELECTRICAL DRAWINGS FOR ELECTRICAL DATA. INVEDED ELECTRICAL DRAWINGS FOR ELECTRICAL DATA. UNRECE ELECTRICAL DRAWINGS FOR ELECTRICAL DATA. INVEDED ELECTRICAL DRAWINGS FOR ELECTRICAL DATA. UNRECE ELECTRICAL DRAWINGS FOR ELECTRICAL DATA. INVEDED ELECTRICAL DRAWINGS FOR ELECTRICAL DATA. UNRECE ELECTRICAL DRAWINGS FOR ELECTRICAL DATA. INVEDED ELECTRICAL DRAWINGS FOR ELECTRICAL DATA. UNRECE DUCTIONS AND A MAD AMADINAND OF FORING REINGL RESIDENCE DRAWING FOR THERING. DRAWERS REING 0.075 W. G. FOR DIRTY FLIERS. INVED ELECTRICAL DRAWING FOR THERING. DRAWING FOR THERING. DRAWERS REING 0.075 W. G. FOR DIRTY FLIERS. UNREC DURIT DRAWING FOR THE MUNDAL DRAWERS REING DRAWING FOR THE STORE DRAWERS FOR THE UNCLUGHT. VIDE AND THE STORE DRAWERS AND STAND. SECONT DRAWERS STEEL COLL CARREES STEEL COLL CARREES STEEL DRAW PAN. FRONDE WITH ACCESS DOOR NULL SWITCHES FOR THE UNCLUGHT. VIDE AND THE STORE DRAWERS AND THE AND DRAWERS FOR THE UNCLUGHT. VIDE AND THE SECOND DRAWERS FOR THE UNCLUGHT. VIDE AND THE SECOND DRAWERS AND TRANSFERS AND DRAWER FROME OR EQUIL TO A COMPANY. VIDE AND THAN AND AND DIFCO THE AND AND AND THE SECOND DRAWERS CONTRACTOR. </td <td></td> <td></td> <td>300,412 82.3° 68.6°</td> <td></td> <td></td> <td></td> <td></td> <td></td> <td></td> <td></td>			300,412 82.3° 68.6°							
INATED EXTERNAL STATIC PRESSURE INCLUDES LOSSES THROUGH OUTWORK, AIR DEVICES, SOUND ATTENUATORS, ETC. DEPTOP UNIT INTERNAL STATIC PRESSURE SHALL INCLUDE LOSSES THROUGH COLS, CASING, INTERNAL DAMPERS, AND 0.79 W.G. FOR DIRTY FILTERS. DURG COLLS SHALL HAVE A MINIMUM OF 6ROWS AND A MAXIMUM OF 10 FINS PER INCH. PRESSURE DROP THROUGH COL SHALL NOT EXCEED 16 FT. AT SCHEDULED GPM. WIDE URPOWREED 120WHA GPIC COMPRIENCE OUTLET. WIDE MERV 16 FT. COLD CASINGS AND A MAXIMUM OF 10 FINS PER INCH. PRESSURE DROP THROUGH COL SHALL NOT EXCEED 16 FT. AT SCHEDULED GPM. WIDE URPOWREED 120WHA GPIC COMPRIENCE OUTLET. WIDE MERV 16 FT. COLD CASINGS AND TANNESS STELL COLL SUPPORTS. WIDE FACTORY WEMA SPELECTRIC PANEL MOUNTED AN UNIT FOR FIELD SUPPLIED VARIABLE FREQUENCY DRIVE. CONTRACTOR TO INSTALL VARIABLE FREQUENCY DRIVE IN THE NEWS SPEAKE PROVIDED BY THE AND MANUFACTURER. DURG COLLS SHALL HAVE TAINLESS STELL COLL CASINGS AND TAINLESS STELL COLL SUPPORTS. WIDE FACTORY WOUNTED AND TESTED UVC LIGHT SECTION DOWNSTREAM OF COOLING COLL WITH STAINLESS STELL DRIVE PROVIDED WITH ACCESS DOOR NLL SWITCHES FOR THE UVC LIGHT. WIDE FACTORY WOUNTED SHAFT GROUNDING KIT FOR AIR MANDUNG UNT MOTOR, NO EXCEPTIONS. WIDE MONDULTING MICTORY MOUNTED AND TESTED UVC LIGHT SECTION DOWNSTREAM OF COOLING COLL WITH STAINLESS STELL DRIVE PROVIDED WITH ACCESS DOOR NLL SWITCHES FOR THE UVC LIGHT. WIDE FACTORY WOUNTED SHAFT GROUNDING KIT FOR AIR MANDUM UNT MOTOR, NO EXCEPTIONS. WIDE RUDD TESTED UVTOR AIR MANDUM ON TO PO CAR. WIDE FACTORY WOUNTED SHAFT GROUNDING KIT FOR AIR MANDUM ON THOUS ON TRACTOR. WIDE FACTORY WOUNTED SHAFT GROUNDING KIT FOR AIR MANDUM TO FOR IN EXCEPTIONS. WIDE RUTD THRUNG SWITCH NAME DUCT SYSTEM (GREATER THAN OR EQUAL TO 2000 GFM). THRU DUTTORE AIR DATABALL DUCT SYSTEM (GREATER THAN OR EQUAL TO 2000 GFM). THRU DUTTORE AIR MARE STILL DUCT ON THE DUCT HID TO PERTURE WITHOUT THRUTTORY FILTER/HOTTORY BE SPECIFICAL Y DESWEED O OPERATERY RUBULEMENTS OF THE 2018 BC. PATED FOR 156 MPH, THREE SECOND GUST, MANUFACTURER TO PROVIDE SIONED A										
DUING COLS SHALL HAVE A MINIMUM OF 6 ROWS AND A MAXIMUM OF 10 FINS PER INCH. PRESSURE DROP THROUGH COL SHALL NOT EXCEED 15 FT. AT SCHEDULED GPM. 2010E UNPOWERED 120/15A GFCI CONVENIENCE OUTLET. 2010E MERY 13 FILTERS. 2010E FACTORY NEMA SR ELECTRICAL PANEL MOUNTED ON UNIT FOR FIELD SUPPLIED VARIABLE FREQUENCY DRIVE. CONTRACTOR TO INSTALL VARIABLE FREQUENCY DRIVE IN THE NEMA SR PANEL PROVIDED BY THE AHU MANUFACTURER. 2010B COLS SHALL HAVE STANLESS STEEL. COL. CASINGS AND STAILESS STEEL. COL. SUPPLIED VARIABLE FREQUENCY DRIVE. CONTRACTOR TO INSTALL VARIABLE FREQUENCY DRIVE IN THE NEMA SR PANEL PROVIDED BY THE AHU MANUFACTURER. 2010B CASINGS AND STAILESS STEEL. COL. SUPPLIED VARIABLE FREQUENCY DRIVE. CONTRACTOR TO INSTALL VARIABLE FREQUENCY DRIVE IN THE NEMA SR PANEL PROVIDED BY THE AHU MANUFACTURER. 2010B CASINGS SHOL TAKES STEEL. COL. CASINGS AND STAILESS STEEL. COL. SUPPORTS. 2010B CAR HANDLERS WITH FACTORY MOUNTED AND TESTED UVC LIGHT SECTION DOWNSTREAM OF COOLING COL WITH STAINLESS STEEL DRIN PAN PROVIDE WITH ACCESS DOOR KILL SWITCHES FOR THE UVC LIGHT. 2010B FACTORY MOUNTED SHAFT GROUNDING KIT FOR AIR HANLDING UNIT MOTOR. NO EXCEPTIONS. 2010B FACTORY MOUNTED SHAFT GROUNDING KIT OP COAT. 2010B FLOAT SWITCH IN DRAIN PAN. 2010B FLOAT SWITCH IN DRAIN PAN. 2010B EXCERS DOOR ON THE OPPOSITE SIDE OF THE PREIME GENERATION. CONFERCE OF THE VIEW OF EQUIL TO 2,000 CFM. 2010B FLOAT SWITCH IN DRAIN PAN. 2010B ENDER DETTER IN AIR DUCT SYSTEM. (GREATER THAN OR EQUIL TO 2,000 CFM.) 2010B ENDER DETTER DIVCLIBURG STITUS OF THE OPPOSITE SIDE OF THE PREMISE TO THE PREMISE OF THE PREMISE OF THE PREMISE OF THE PREMISE TO MERTING. STITUS OF THE CONSTINUE AND RESPRESITENCE OF DESPRESITENCE OF THE PREMISE OF T										
Device MeRV 13 Filters. UNDE FACTORY NEMS ARE LECTRICAL PANEL MOUNTED ON UNIT FOR FIELD SUPPLIED VARIABLE FREQUENCY DRIVE. CONTRACTOR TO INSTALL VARIABLE FREQUENCY DRIVE IN THE NEMS AR PANEL PROVIDED BY THE AHU MANUFACTURER. UNDE COLL SAINGS AND STAINLESS STEEL COLL CASINGS AND STAINLESS STEEL COLL SUPPORTS. UNDE AIR HANDLERS WITH FACTORY MOUNTED AND TESTED UVC LIGHT SECTION DOWNSTREAM OF COOLING COLL WITH STAINLESS STEEL DRIAN PAN. PROVIDE WITH ACCESS DOOR KILL SWITCHES FOR THE UVC LIGHT. UNDE FACTORY MOUNTED SHAFT GROUNDING KIT FOR AIR HANLDING UNIT MOTOR, NO EXCEPTIONS. UNDE MODULATING MOTORIZED OUTSIDE AIR DAMPER. ACTUATOR BY CONTROLS CONTRACTOR. UNDE FACTORY MOUNTED SHAFT GROUNDING KIT FOR AIR HANLDING UNIT MOTOR, NO EXCEPTIONS. UNDE FACTORY MOUNTED SHAFT GROUNDING KIT FOR AIR HANLDING UNIT MOTOR, NO EXCEPTIONS. UNDE FACTORY MOUNTED SHAFT GROUNDING KIT FOR AIR HANLDING UNIT MOTOR, NO EXCEPTIONS. UNDE FACTORY MOUNTED SHAFT GROUNDING KIT FOR AIR HANLDING UNIT MOTOR, NO EXCEPTIONS. UNDE MODULATING MOTORIZED OUTSIDE AIR DAMPER. ACTUATOR BY CONTROLS CONTRACTOR. UNDE FLOAT SWITCH IN DRAIN PAN. UNDE FLOAT SWITCH IN DRAIN PAN. UNDE SMOKE DETECTOR IN THE RETURN AIR DUCT SYSTEM. (GREATER THAN OR EQUAL TO 2.000 CFM.) UNDE SMOKE DETECTOR IN THE RETURN AIR DUCT SYSTEM. (GREATER THAN OR EQUAL TO 2.000 CFM.) UNDE SMOKE DETECTOR IN THE RETURN AIR DUCT SYSTEM. (GREATER THAN OR EQUAL TO 2.000 CFM.) UNDE SMOKE DETECTOR IN THE RETURN AIR DUCT SYSTEM. (GREATER THAN OR EQUAL TO 2.000 CFM.) UNDE SMOKE DETECTOR IN THE RETURN AIR DUCT SYSTEM. (GREATER THAN OR EQUAL TO 2.000 CFM.) UNDE ACCESS DOOR ON THE OPPOSITE SIDE OF THE PIPING CONNECTION. UNDE ACCESS DOOR ON THE OPPOSITE SIDE OF THE PIPING CONNECTION. UNDE WITH OUTSIDE AIR INTAKE RAIN HOOD. UNDE WITH OUTSIDE AIR INTAKE RAIN HOOD. UNDE WITH OUTSIDE AIR INTAKE RAIN HOD. UNDE YOU TALL INSULATED AND FULL PREIMETER FULLY VELEDED WIND RATEED COURS WITH BID ACCESTS, STRUCTURALLY CALCULATED TO MEET THE WIND REQUIREMENTS OF THE 2018 IBC. RATED FOR 155 MPH, THREE SECOND GUST. MANUFACTUR										
De factory nema 3R electrical panel mounted on unit for field supplied variable frequency drive. Contractor to install variable frequency drive in the nema 3R panel provided by the Ahu manufacturer.										
DVIDE AIR HANDLERS WITH FACTORY MOUNTED AND TESTED UVC LIGHT SECTION DOWNSTREAM OF COOLING COIL WITH STAINLESS STEEL DRAIN PAN. PROVIDE WITH ACCESS DOOR KILL SWITCHES FOR THE UVC LIGHT. DVIDE FACTORY MOUNTED SHAFT GROUNDING KIT FOR AIR HANLDING UNIT MOTOR, NO EXCEPTIONS. DVIDE MODULATING MOTORIZED OUTSIDE AIR DAMPER. ACTUATOR BY CONTROLS CONTRACTOR. COLLS SHALL BE FULLY DIPPED AND BAKED (E-COAT) WITH UV TOP COAT. DVIDE FLOAT SWITCH IN DRAIN PAN. DVIDE FLOAT SWITCH IN THE RETURN AIR DUCT SYSTEM. (GREATER THAN OR EQUAL TO 2,000 CFM). DVIDE SMOKE DETECTOR IN THE RETURN AIR DUCT SYSTEM. (GREATER THAN OR EQUAL TO 2,000 CFM). DVIDE SMOKE DETECTOR IN THE RETURN AIR DUCT SYSTEM. (GREATER THAN OR EQUAL TO 2,000 CFM). DVIDE SMOKE DETECTOR IN THE RETURN AIR DUCT SYSTEM. (GREATER THAN OR EQUAL TO 2,000 CFM). DVIDE SMOKE DETECTOR IN THE RETURN AIR DUCT SYSTEM. (GREATER THAN OR EQUAL TO 2,000 CFM). DVIDE ACCESS DOOR ON THE OPPOSITE SIDE OF THE PIPING CONNECTION. DVIDE ACCESS DOOR ON THE OPPOSITE SIDE OF THE PIPING CONNECTION. DVIDE ACCESS DOOR ON THE OPPOSITE SIDE OF THE PIPING CONNECTION. DVIDE IN THALL BE TAILLY BE DETENDED AND REACHTS, STRUCTURALLY CALCULATED TO MEET THE WIND REQUIREMENTS OF THE 2018 IBC. RATED FOR 155 MPH, THREE SECOND GUST. MANUFACTURER TO PROVIDE SIGNED AND SEALED DRAWINGS BY F DVIDE ACCUSTICAL STYLE ROOF CURBS WITH BRD ACOUSTICAL ROOF CURB TREATMENT: REFER TO DETAIL AND SPECIFICATION.										
DVIDE MODULATING MOTORIZED OUTSIDE AIR DAMPER. ACTUATOR BY CONTROLS CONTRACTOR. C.COLS SHALL BE FULLY DIPPED AND BAKED (E-COAT) WITH UV TOP COAT. DVIDE FLOAT SWITCH IN DRAIN PAN. DVIDE SMOKE DETECTOR IN THE RETURN AIR DUCT SYSTEM. (GREATER THAN OR EQUAL TO 2,000 CFM). DVIDE SMOKE DETECTOR IN THE RETURN AIR DUCT SYSTEM. (GREATER THAN OR EQUAL TO 2,000 CFM). DVIDE ARRELOW MERSURING SWITTON AFMS) AT OUTSIDE AIR WITARE OPENING. AFMS SHALL BE DESIGNED TO OPERATE WITHOUT PRE-FILITRATION PRO BE SPECIFICALLY DESIGNED TO OPERATE IN TROULENT AIRSTREAMS DVIDE ACCESS DOOR ON THE OPPOSITE SIDE OF THE PIPING CONNECTION. DVIDE ACCESS DOOR ON THE OPPOSITE SIDE OF THE PIPING CONNECTION. DVIDE WITH OUTSIDE AIR INTAKE RAIN HOOD. DVIDE 14" TALL INSULATED AND FULL PRIMETER FULLY WELDED WIND RATED CURB WITH HOLD DOWN BRACKETS; STRUCTURALLY CALCULATED TO MEET THE WIND REQUIREMENTS OF THE 2018 IBC. RATED FOR 155 MPH, THREE SECOND GUST. MANUFACTURER TO PROVIDE SIGNED AND SEALED DRAWINGS BY F DVIDE ACCUSSTICAL STYLE ROOF CURBS WITH BRD ACOUSTICAL ROOF CURB TREATMENT: REFER TO DETAIL AND SPECIFICATION.)						
DVIDE FLOAT SWITCH IN DRAIN PAN. DVIDE SMOKE DETECTOR IN THE RETURN AIR DUCT SYSTEM. (GREATER THAN OR EQUAL TO 2,000 CFM). DVIDE AIRFLOW MEASURING SPATTON (AFMS) AT OUTSIDE AIR WTARE OPENING AFMS SHALL BE DESIGNED TO OPERATE WITHOUT PNS-FILTRATION AND BE SPECIFICALLY DESIGNED TO OPERATE INSURBULENT AIRSTREAMS DVIDE AIRFLOW MEASURING SPATTON (AFMS) AT OUTSIDE AIR WTARE OPENING AFMS SHALL BE DESIGNED TO OPERATE WITHOUT PNS-FILTRATION AND BE SPECIFICALLY DESIGNED TO OPERATE INSURBULENT AIRSTREAMS DVIDE ACCESS DOOR ON THE OPPOSITE SIDE OF THE PIPING CONNECTION. DVIDE WITH OUTSIDE AIR INTAKE RAIN HOOD. DVIDE 14" TALL INSULATED AND FULL PERIMETER FULLY WELDED WIND RATED CURB WITH HOLD DOWN BRACKETS; STRUCTURALLY CALCULATED TO MEET THE WIND REQUIREMENTS OF THE 2018 IBC. RATED FOR 155 MPH, THREE SECOND GUST. MANUFACTURER TO PROVIDE SIGNED AND SEALED DRAWINGS BY F DVIDE ACCUSTICAL STYLE ROOF CURBS WITH BRD ACOUSTICAL ROOF CURB TREATMENT: REFER TO DETAIL AND SPECIFICATION.			>)						
DVIDE SMOKE DETECTOR IN THE RETURN AIR DUCT SYSTEM. (GREATER THAN OR EQUAL TO 2,000 CFM). DVIDE AIR LOW MERSURING SPATTON AFMS) AT OUTSIDE AIR INTARE OPENING, AFMS SHALL BE DESIGNED TO OPERATE WITH OT PRE-FILTRATION AND BE SPECIFICALLY DESIGNED TO OPERATE INTURBULENT AIRSTREAMS DVIDE ACCESS DOOR ON THE OPPOSITE SIDE OF THE PIPING CONNECTION. DVIDE WITH OUTSIDE AIR INTAKE RAIN HOOD. DVIDE 14" TALL INSULATED AND FULL PERIMETER FULLY WELDED WIND RATED CURB WITH HOLD DOWN BRACKETS; STRUCTURALLY CALCULATED TO MEET THE WIND REQUIREMENTS OF THE 2018 IBC. RATED FOR 155 MPH, THREE SECOND GUST. MANUFACTURER TO PROVIDE SIGNED AND SEALED DRAWINGS BY F DVIDE ACCUSTICAL STYLE ROOF CURBS WITH BRD ACOUSTICAL ROOF CURB TREATMENT: REFER TO DETAIL AND SPECIFICATION.)						
DVIDE ACCESS DOOR ON THE OPPOSITE SIDE OF THE PIPING CONNECTION. DVIDE WITH OUTSIDE AIR INTAKE RAIN HOOD. DVIDE 14" TALL INSULATED AND FULL PERIMETER FULLY WELDED WIND RATED CURB WITH HOLD DOWN BRACKETS; STRUCTURALLY CALCULATED TO MEET THE WIND REQUIREMENTS OF THE 2018 IBC. RATED FOR 155 MPH, THREE SECOND GUST. MANUFACTURER TO PROVIDE SIGNED AND SEALED DRAWINGS BY P DVIDE ACCUSTICAL STYLE ROOF CURBS WITH BRD ACOUSTICAL ROOF CURB TREATMENT: REFER TO DETAIL AND SPECIFICATION.			$\langle \rangle$)						
DVIDE 14" TALL INSULATED AND FULL PERIMETER FULLY WELDED WIND RATED CURB WITH HOLD DOWN BRACKETS; STRUCTURALLY CALCULATED TO MEET THE WIND REQUIREMENTS OF THE 2018 IBC. RATED FOR 155 MPH, THREE SECOND GUST. MANUFACTURER TO PROVIDE SIGNED AND SEALED DRAWINGS BY F	S BY PROFESSIONAL ENGINEER OF THE RATED ASSEMBLY. C	7. CURB SHALL BE PROVIDED BY THE MANUF))						
DVIDE ACOUSTICAL STYLE ROOF CURBS WITH BRD ACOUSTICAL ROOF CURB TREATMENT: REFER TO DETAIL AND SPECIFICATION.			FACTURER AND NOT BY OTHERS							
)						
						CONDENSING BOILER	R SCHEDULE			
	_	DESIGNATION TYPE LOC	DCATION BURNER FUEL MIN. O	OUTPUT (BTUH) MIN. EFFICIENCY FUE	EL CONSUMPTION (BTUH) MA	ANUFACTURER MODEL NUMBER GPM E.W	V.T. (°F) L.W.T. (°F) FLUE SIZE (DIA.) D	DIMENSIONS (L x W x H) WEIG		
	-				4 500 000					VOLT / Ø / HZ DESIGNATION MAX H.P.
	-	B-01 CONDENSING MECH	CH YARD NAT. GAS 1	1,416,000 94%	1,500,000	CAMUS AVENGER 47 1	100°F 160°F 6"	38" x 29.5" x 83" 1	1,530 8	120/1/60 <u>PHWP-01</u> 3/4
		1. REFERENCE ELECTRICAL DRAWINGS								
		3. PROVIDE CATEGORY IV FLUE PIPE, IN		ITE WATER AT BYPASS CONDITIONS. REFER TO EL PE OF 430 STAINLESS STEEL.	ELECTRICAL DRAWINGS.					
		 PROVIDE WITH A CONDENSATE NEUTR CONDENSING BOILER HEAT EXCHANG 		PVC CONDENSATE PIPING. DR CAST IRON. COPPER HEAT EXCHANGERS ARE I	E NOT ACCEPTABLE; REFER TO SPE	ECIFICATION.				
				NCING AND CONTROL. BAS SHALL INTERFACE TO ORIES REQUIRED TO FACILITATE 2-WAY COMMUNI		CTOR'S SYSTEM. THIS INCLUDES, BUT IS NOT LIMITED	D TO, FURNISHING, INSTALLING AND PROGRAMMI	ING OF COMMUNICATION CARD (i e	.e. BACnet)	
		8. BOILER TO ENABLE RESPECTIVE CIRC	RCULATING PUMP. IF SEPARATE POWER	R CONNECTION IS REQUIRED, THE BOILER REPRE	RESENTATIVE IS RESPONSIBLE FOR	R PROVIDING LABOR + MATERIALS TO PROPERLY CON	NTROL.	,		
		9. FLUE PIPING SHALL BE PROVIDED AND 10. PROVIDE FIRE-TUBE BOILER RATED FO		VIN AFTER DUILER SUBMITTAL HAS BEEN APPROVE	VED DT ENGINEEK. FLUË PIPE SHAL	ALL NOT BE SUBMITTED BY ANY OTHER PARTY OTHER	IN THAN THE DUILER SALES KEPRESENTATIVE AN	יאמעשע וחב אנטובטו. FLUE PIP	L SHALL DE INSTALLED BY MECHANICA	
	HYDRONIC PU	PUMP SCHEDULE				SERIES	FAN-POWERED AIR TER	MINAL UNITS WIT	TH HOT WATER HEA	AT SCHEDULE
DESIGNATION SERVICE TYPE	NOTES GPM HEAD (FT. H20) EFFICIENCY F	RPM (MAX.) MAX. BHP MOTOR H.P.			R (FT.) TAG	INLET SIZE	PRESSURE	HOT WATER HEATING COIL	L	VOLTAGE (V / PH / HZ) MANUEA
CHP-01 CH-01 SPLIT COUPLED VERTICAL IN-LINE SHWP-01 BUILDING LOOP SPLIT COUPLED VERTICAL IN-LINE		1,800 4.49 7.5 1,800 1.77 3	460 / 3 / 60 PENTAIRE 460 / 3 / 60 PENTAIRE		<u></u>	MAX MIN INLET	UNIT P.D. CFM MAX. FACE VELOCIT 0.3 1415 750		AT LAT GPM EWT / LWT (°F) 4.1 85 1.6 140 / 100	F)
					<u>CVB-02-01</u> <u>CVB-02-01</u>		0.3 755 750 0.3 610 750		4.1 85 1.0 140 / 100 4.1 85 0.8 140 / 100	
 REFERENCE ELECTRICAL DRAWINGS FOR ELECTRICAL DATA. PROVIDE PUMP RATED FOR OUTDOOR ENVIRONMENT AND WITH TEFC M 	FC MOTOR ENCLOSURE.				<u>CVB-02-01</u>	<u>1-04</u> 8 600 180 1	0.3 600 750	16,200 64.	4.1 85 0.8 140 / 100	277 / 1 / 60 TITU
 3. PROVIDE VARIABLE FREQUENCY DRIVE FOR SOFT START AND BALANCIN 4. GREASABLE BEARINGS WITH ALEMITE FITTINGS ARE TO BE PROVIDED. S 					<u>CVB-02-01</u> <u>CVB-02-01</u>		0.3 930 750 0.3 1050 750		4.1 85 1.3 140 / 100 4.1 85 1.4 140 / 100	
					<u>CVB-02-01</u> <u>CVB-02-01</u>		0.3 290 750 0.3 780 750		4.1 85 0.4 140 / 100 4.1 85 1.1 140 / 100	
	Γ				<u></u> <u>CVB-02-01</u>		0.3 945 750		4.1 85 1.3 140 / 100	
			T AIR TERMINAL UNI		<u>CVB-02-02</u> <u>CVB-02-02</u>		0.3 880 750 0.3 1560 750		4.1 85 1.2 140 / 100 4.1 85 2.1 140 / 100	
	TAG	INLET SIZE MAX MIN I	INLET UNIT P.D. RAD. DISCH	CH. VOLTAGE MANUFACTURER M	MODEL <u>CVB-02-02</u>	<u>2-03</u> 12 1,110 333 1	0.3 1110 750	29,970 64.	4.1 85 1.5 140 / 100	277 / 1 / 60 TITU
	<u>TB-2-01-01</u>		1 0.35 13 13	3 120 / 1 / 60 TITUS D	DESV <u>CVB-02-02</u> <u>CVB-02-02</u>		0.3 1225 750 0.3 1380 750		4.1 85 1.7 140 / 100 4.1 85 1.9 140 / 100	
		IUM NC LEVEL SHALL NOT EXCEED 25 AT 1 IN. RENCE ELECTRICAL DRAWINGS FOR ELECTRIC				<u>2-06</u> 8 600 180 1	0.3 600 750	16,200 64.	4.1 85 0.8 140 / 100	277 / 1 / 60 TITU
	3. PROVIDE	DE VOLUME CONTROL DAMPER, MULTI-POINT		OSURE, POWER TRANSFORMER.	1. MAXIMUN	IM NC LEVEL SHALL NOT EXCEED 35 AT 1 IN. STATIC F	PRESSURE.			
		R TO AIR TERMINAL UNITS SPECIFICATION. DINATE WITH DRAWINGS FOR RIGHT OR LEFT-	T-HAND CASING CONFIGURATION PRIOR	DR TO ORDERING.		E FACTORY MOUNTED INDUCED AIR INLET SOUND SO		AN POWERED VARIABLE VOLUME	UNITS WITH HOT WATER HEAT DETAIL.	L.
					4. HOT WAT	ATER COILS SHALL BE 1 OR 2 ROWS AND A MAXIMUM		SHALL NOT EXCEED 5 FT AT SCHE	EDULED GPM AND AIR PRESSURE	
						'HROUGH THE COIL SHALL NOT EXCEED 0.24" W.G. INATE WITH DRAWINGS FOR RIGHT OR LEFT-HAND C/	ASING CONFIGURATION PRIOR TO ORDERING.			

Plot Stamp: 6/25/2025 10:33:50 AM

DESIGNATION	ON REFRIGERANT	ANT COMPRESSOR TYPE					EVAPORATOR DATA			AMBIENT TEMP. (°F)		EER AT AHRI CONDITIONS		MANUEACTURER			WEIGHT (lbs)		ELECTRIC	AL DATA	
JESIGNATION	REFRIGERANI	COMPRESSOR TYPE	CAPACITY (TONS)	E.W.T. (°F)	L.W.T. (°F)	GPM	MINIMUM EVAPORATOR FLOW RATE (GPM)	FOULING FACTOR	NO. OF PASS	MAX. P.D. (FEET)	AMBIENT TEMP. ('F)	MAX. UNIT KW / TON (@ DESIGN CONDITIONS)	FULL LOAD (EER)	IPLV (EER)	MANUFACTURER	MODEL NUMBER	DIMENSIONS (L x W x H) INCHES		МСА	MOCP	VOLTS / Ø / I
<u>ACCH-01</u>	R-454B / R-32	SCROLL	110.0	56°F	42ºF	189	175	0.0001	1.00	6.33	105ºF	1.23	10.30	16.94	TRANE	CGAM	205.2" x 88.4" x 92.5"	8,300	262	350	460 / 3 / 60
 PROVIDE C CHILLER SH CONDENSE PROVIDE L CONTROL F PROVIDE C 	HILLER WITH SINGL IALL BE PROVIDED R COILS SHALL BE DW AMBIENT HEAD PANEL SHALL BE NE	WITH BACNET INTERFACE FULLY DIPPED AND BAKED PRESSURE CONTROL AS S C409 AND UL508A COMPLI D BLANKETS; REFER TO S	TION, FACTORY MOUN CARD. D (E-COAT) WITH UV TH SPECIFIED. ANT (HIGH SHORT CIF	OP COAT. RCUIT CURREN	T RATING.)		CONNECT SWITCH, AND FACTORY MOUNTED 120V F	RECEPTICLE.													
		THE COIL SIDE OF THE CH																			
2. PROVIDE F	ACTORY INSTALLED	ALUMINUM / COPPER. MIC	ROCHANNEL IS NOT				RATE 120/1/60 CIRCUIT TO THE EVAPORATOR.	\sim													

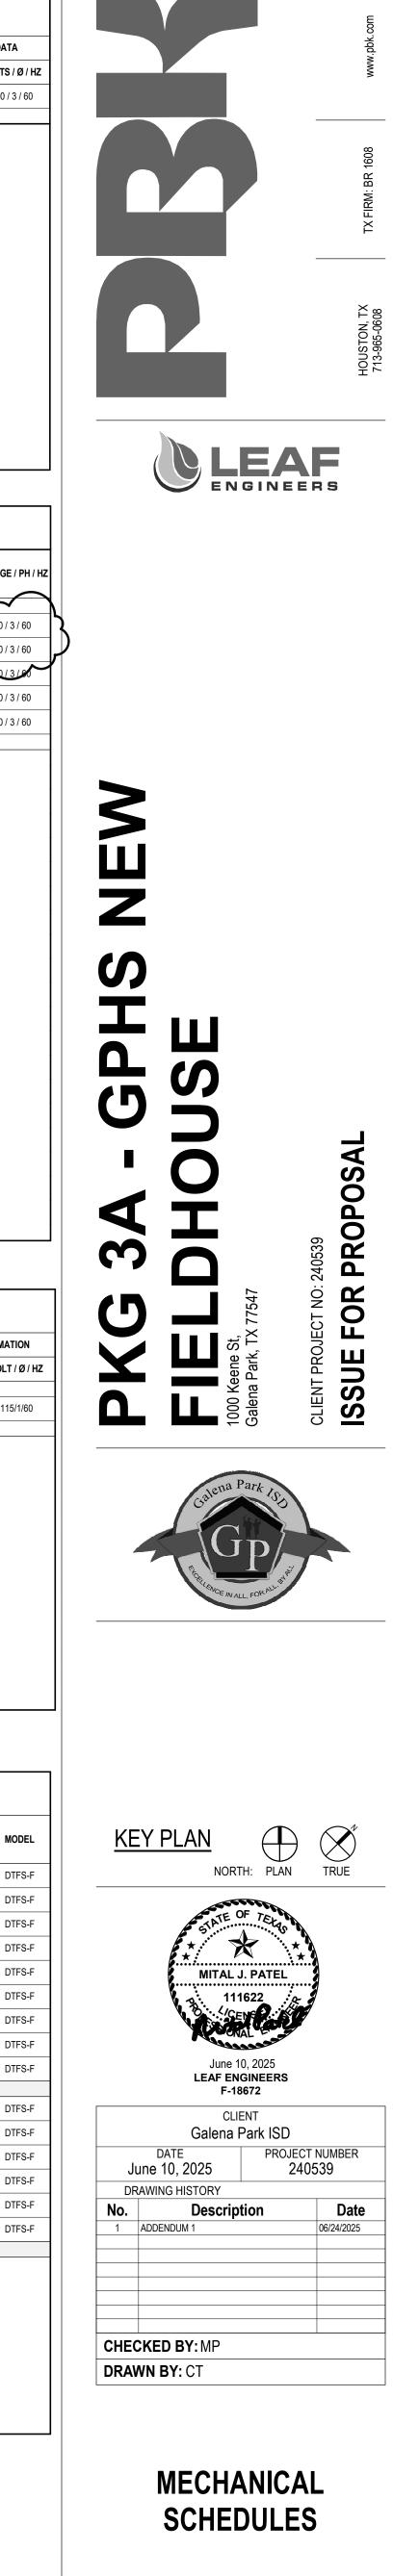

M-501

MECHANICAL SCHEDULES M-502 FOR BLUEBEAM LABELING/OCR:	0"	
HAT	 1"	
	I	
CHE		
EDU		
LES		
•••		

DUCTLESS MINI-SPLIT SYSTEM AIR-CONDITIONERS SCHEDULE

EVAPORATOR SECTION			
INDOOR EVAPORATOR DESIGNATION	FCU-1913	FCU-IDF-1960	FCU-RISER RM-1907
SERVICE	1913-ELEC	1960-IDF	1907-RISER ROOM
MANUFACTURER	MITSUBISHI	MITSUBISHI	MITSUBISHI
MODEL NUMBER	РКА	РКА	MSZ
ТҮРЕ	WALL MOUNTED	WALL MOUNTED	WALL MOUNTED
WEIGHT (LBS.)	28	28	28
NOTES	ALL	ALL	ALL
FAN DATA			
SUPPLY CFM (HIGH / MEDIUM / LOW) SPEED	455 / 385 / 310 / 265	455 / 385 / 310 / 265	455 / 385 / 310 / 265
COOLING / HEATING COIL	DX	DX	DX
NOMINAL TONNAGE	1.5 TONS	1.5 TONS	1.5 TONS
ENTERING AIR EVAP (DB/WB) °F - COOLING MODE	80°F / 67°F	80°F / 67°F	80°F / 67°F
ENTERING AIR EVAP (DB/WB) °F - HEATING MODE	-	-	70°F / 60°F
NOMINAL BTUH COOLING (BTU/H)	18,000	18,000	18,000
NOMINAL BTUH HEATING (BTU/H)	-	-	19,000
AIR-COOLED CONDENSER			
DESIGNATION	ACCU-1913	ACCU-IDF-1960	ACCU-RISER RM-1907
SERVES	FCU-1913	FCU-IDF-1960	FCU-RISER RM-1907
LOCATION	GROUND	ROOF	GROUND
MANUFACTURER	MITSUBISHI	MITSUBISHI	MITSUBISHI
MODEL NUMBER	PUY	PUY	MUZ
EFFICIENCY (SEER)	20.2	20.2	20.2
VOLTS/PH/HZ	208 / 1 / 60	208 / 1 / 60	208 / 1 / 60
мса	11.0	11.0	11.0
моср	28	28	28
AMBIENT TEMPERATURE °F	105°F	105°F	105°F
WEIGHT (LBS.)	99	99	99
NOTES	·	-	

NOTES

1. REFERENCE ELECTRICAL DRAWINGS FOR ELECTRICAL DATA.

2. ESTIMATED EXTERNAL STATIC PRESSURE INCLUDES LOSSES THROUGH PLENUM, AIR DEVICES, ETC.

3. REFER TO SPECIFICATIONS FOR ADDITIONAL REQUIREMENTS.

4. PROVIDE REMOTE WALL MOUNTED PROGRAMMABLE THERMOSTAT WITH BACnet INTERFACE.

5. PROVIDE INVERTER DRIVEN COMPRESSOR.

6. INDOOR UNIT IS POWERED BY THE OUTDOOR UNIT. INTERCONNECTING POWER WIRING FROM OUTDOOR TO INDOOR UNIT

IS BY ELECTRICAL CONTRACTOR. REFER TO ELECTRICAL DRAWINGS.

. PROVIDE MATCHING CONDENSING UNIT FROM SAME MANUFACTURER.

8. MANUFACTURER SHALL PROVIDE A CONDENSATE PUMP. PUMP SHALL BE POWERED BY THE UNIT AND SHALL NOT START / STOP UNLESS THE UNIT IS

ENERGIZED / DE-ENERGIZED.

		HVAC G	RAVIT	TY VE	NTILATORS SCHEDULE				E		INIT H	EATE	ER SC	HEDULE			
DESIGNATION	SERVICE	MANUFACTURER	MODEL	CFM	MAX. THROAT AREA (FT.2)/ THROAT SIZE (DIA./LxW)	P.D. (INCHES WG)	NOTES	DESIGNATION	SERVICE	MANUFACTURER	MODEL	NOTES	BTUs	WEIGHT (LBS)	ĸw	AMPS	VOLT / Ø / HZ
<u>RH-01</u>	BUILDING RELIEF	GREENHECK	FGR	-	3.24 / 24" x 24"	-	1-4	<u>EUH-1</u>	PUMP ROOM	REZNOR	EUH	1-5	10,230	36	3.0	4.4	480 / 3 / 60
 PROVIDE ST/ PROVIDE WIT 	IROAT VELOCITY SHALL AINLESS STEEL BIRD SC TH GRAVITY WEIGHTED OF HOOD DESIGNED TC	CREEN AND 12" PREFA DAMPER SET TO OPEI	BRICATED N AT 0.10"	W.G.				2. PROVIDE DI	RECTIONAL LOUV	WINGS FOR ELECTRIC ER OUTLET. MOUNTED THERMOST	TAT AS INDI	CATED ON	N DRAWIN		<u>}</u>		

	<u>EF-1-02</u>
	EF-1-03
	<u>EF-1-04</u>
	EF-2-01
	EF-2-02
	EF-2-03
	<u>CF-01</u>
	<u>CF-02</u>
	<u>CF-03</u>
	<u>CF-04</u>
1.	REFEREN
2.	REFEREN
3.	FAN SHAL
4.	REFEREN
5.	PROVIDE
6.	PROVIDE
7.	PROVIDE
DES	SIGNATION
	A
	A
	_

В С D _____ Е

F

	HVAC FANS SCHEDULE																
							FAN DATA										
DESIGNATION	LOCATION	SERVICE	MANUFACTURER	MODEL NUMBER	NOTES	WEIGHTS (LBS)	ТҮРЕ	DRIVE	CFM (LOW/HIGH)	STATIC PRESSURE (" W.G.)	MOTOR HP. (MIN.)	RPM (MAX.)	VOLT / Ø / HZ				
EF-1-01	VARSITY LOCKERS	VARSITY LOCKERS	GREENHECK	SQ	1-3	76	CENTRIFUGAL	DIRECT	1,530	0.35	3/4	980	120 / 1 / 60				
EF-1-02	JV LOCKERS	JV LOCKERS	GREENHECK	SQ	1-3	76	CENTRIFUGAL	DIRECT	1,670	0.35	3/4	1,065	120 / 1 / 60				
EF-1-03	1909-GIRLS RR	RESTROOMS	GREENHECK	SQ	1-3	34	CENTRIFUGAL	DIRECT	450	0.35	1/10	1,520	120 / 1 / 60				
EF-1-04	1914A-BBALL RR	LOCKERS AND RESTROOMS	GREENHECK	SQ	1-3	76	CENTRIFUGAL	DIRECT	2,500	0.35	3/4	1,130	120 / 1 / 60				
EF-2-01	ROOF	AD OFFICE RR	GREENHECK	CUE	1-5	45	CENTRIFUGAL	DIRECT	150	0.25	1/10	1,030	120 / 1 / 60				
EF-2-02	ROOF	COACH LOCKERS	GREENHECK	CUE	1-5	45	CENTRIFUGAL	DIRECT	575	0.30	1/10	1,460	120 / 1 / 60				
<u>EF-2-03</u>	ROOF	RESTROOMS	GREENHECK	CUE	1-5	38	CENTRIFUGAL	DIRECT	200	0.25	1/15	1,390	120 / 1 / 60				
<u>CF-01</u>	WEIGHT ROOM	WEIGHT ROOM	GREENHECK	CUE	1,6,7	50	CENTRIFUGAL	AXIAL	8674 / 9612	-	1/2	1,075	120 / 1 / 60				
<u>CF-02</u>	WEIGHT ROOM	WEIGHT ROOM	GREENHECK	CUE	1,6,7	50	CENTRIFUGAL	AXIAL	8674 / 9612	-	1/2	1,075	120 / 1 / 60				
<u>CF-03</u>	WEIGHT ROOM	WEIGHT ROOM	GREENHECK	CUE	1,6,7	50	CENTRIFUGAL	AXIAL	8674 / 9612	-	1/2	1,075	120 / 1 / 60				
<u>CF-04</u>	WEIGHT ROOM	WEIGHT ROOM	GREENHECK	CUE	1,6,7	50	CENTRIFUGAL	AXIAL	8674 / 9612	-	1/2	1,075	120 / 1 / 60				

RENCE ELECTRICAL DRAWINGS FOR ELECTRICAL DATA.

RENCE SPECIFICATIONS FOR SEQUENCE OF OPERATIONS.

HALL BE PROVIDED WITH GREENHECK VARI-FLOW® CONTROL AND ECM MOTOR. STARTER SHALL BE PROVIDED BY FAN MANUFACTURER. JUNCTION BOX AND VARI-FLOW TRANSFORMER SHALL BE FACTORY MOUNTED AND WIRED.

RENCE ARCHITECTURAL DRAWINGS FOR ROOF CURB DETAIL.

DE UPBLAST FAN DESIGNED TO WITHSTAND HIGH WIND SPEEDS UP TO 155 MPH.

DE WITH 2-SPEED FAN, TOTALLY ENCLOSED AND PERMANENTLY LUBRICATED MOTOR, OSCILLATING FAN, WITH WIRE GUARDS, OSHA COMPLIANT AND WALL BRACKET.


DE WALL MOUNTED CONTROLLER.


DIFFUSERS, REGISTERS & GRILLES SCHEDULE

ON	MODEL NUMBER	NOISE CRITERIA (NC)	DESCRIPTION
	TITUS TDCA-AA		24x24 MODULE SIZE, LAY-IN BORDER TYPE, 18"x18" NECK SIZE WITH ROUND DUCT CONNECTION SIZED AS INDICATED oN PLANS. NO OPPOSED BLADE DAMPER, ALL ALUMINUM CONSTRUCTION. FOR SHEETROCK CEILING INSTALLATION,PROVIDE WITH TITUS TRM ALUMINUM RAPID MOUNT FRAME.
	TITUS PAR-AA	25	24x24 MODULE SIZE, LAY-IN BORDER TYPE, 22"x22" NECK SIZE UNLESS NOTED OTHERWISE. NO OPPOSED BLADE DAMPER, ALL ALUMINUM CONSTRUCTION. FOR SHEETROCK CEILING INSTALLATION, PROVIDE WITH TITUS TRM ALUMINUM RAPID MOUNT FRAME.
	TITUS 300FS	25	DOUBLE DEFLECTION, 3/4" BLADE SPACING, FRONT BLADES PARALLEL TO SHORT DIMENSION, NO OPPOSED BLADEDAMPER, SURFACE MOUNTING BORDER TYPE WITH COUNTERSUNK HOLES, ALL ALUMINUM CONTSTRUCTION.
	TITUS 350FL	25	3/4" BLADE SPACING, FRONT BLADES PARALLEL TO LONG DIMENSION, 35° FIXED DEFLECTION, NO OPPOSED BLADE DAMPER, SURFACE MOUNTING BORDER TYPE WITH COUNTERSUNK HOLES, ALL ALUMINUM CONSTRUCTION.
	TITUS TDC-AA	25	12X12 MODULE SIZE, LAY-IN BORDER TYPE, 10"X10" NECK SIZE WITH ROUND DUCT CONNECTION SIZED AS INDICATED ON PLANS. NO OPPOSED BLADE DAMPER, ALL ALUMINUM CONSTRUCTION. FOR SHEETROCK CEILING INSTALLATION, PROVIDE WITH TITUS TRM ALUMINUM RAPID MOUNT FRAME.
	TITUS PAR-AA	25	12X12 MODULE SIZE, LAY-IN BORDER TYPE, 10"x10" NECK SIZE UNLESS NOTED OTHERWISE. NO OPPOSED BLADE DAMPER, ALL ALUMINUM CONSTRUCTION. FOR SHEETROCK CEILING INSTALLATION, PROVIDE WITH TITUS TRM ALUMINUM RAPID MOUNT FRAME.

1. ALL DIFFUSER DESIGNATIONS MAY NOT BE USED ON PROJECT.

2. PROVIDE ROTO-TWIST CABLE OPERATED DAMPERS AT IN GYP BOARD CEILINGS.

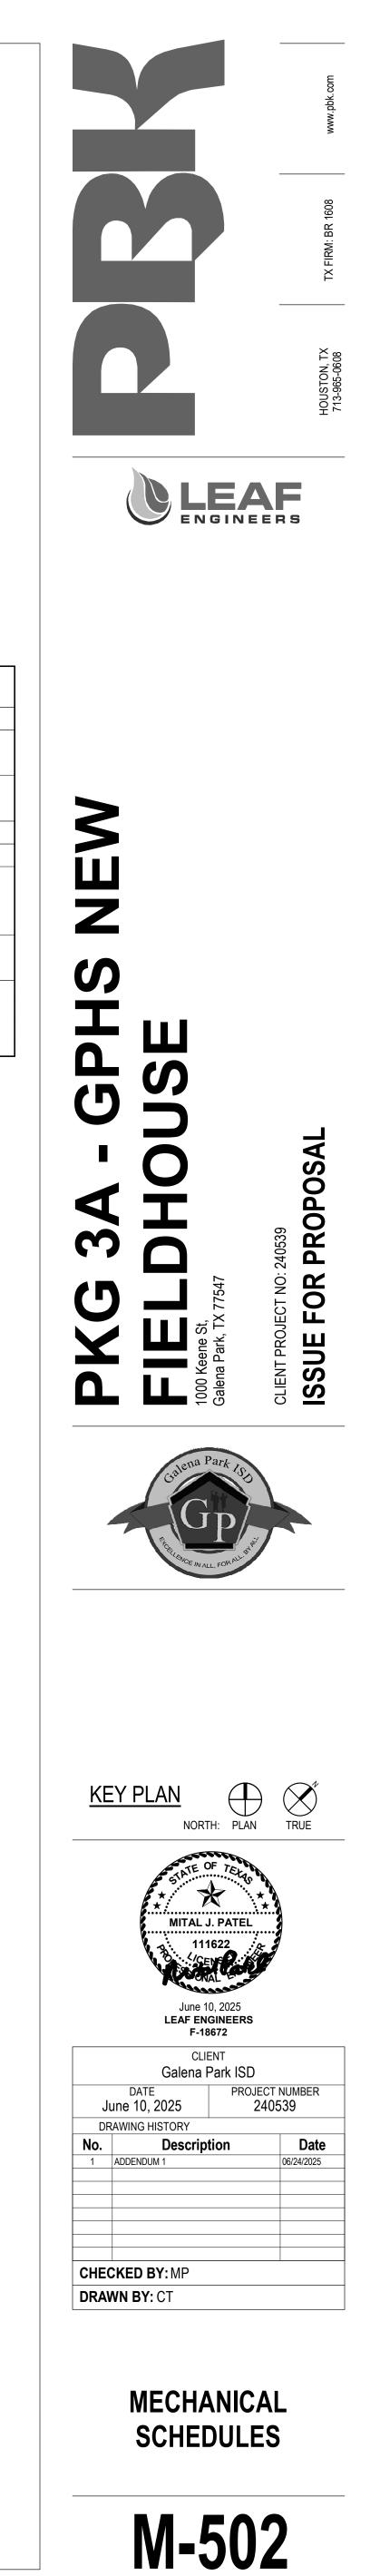

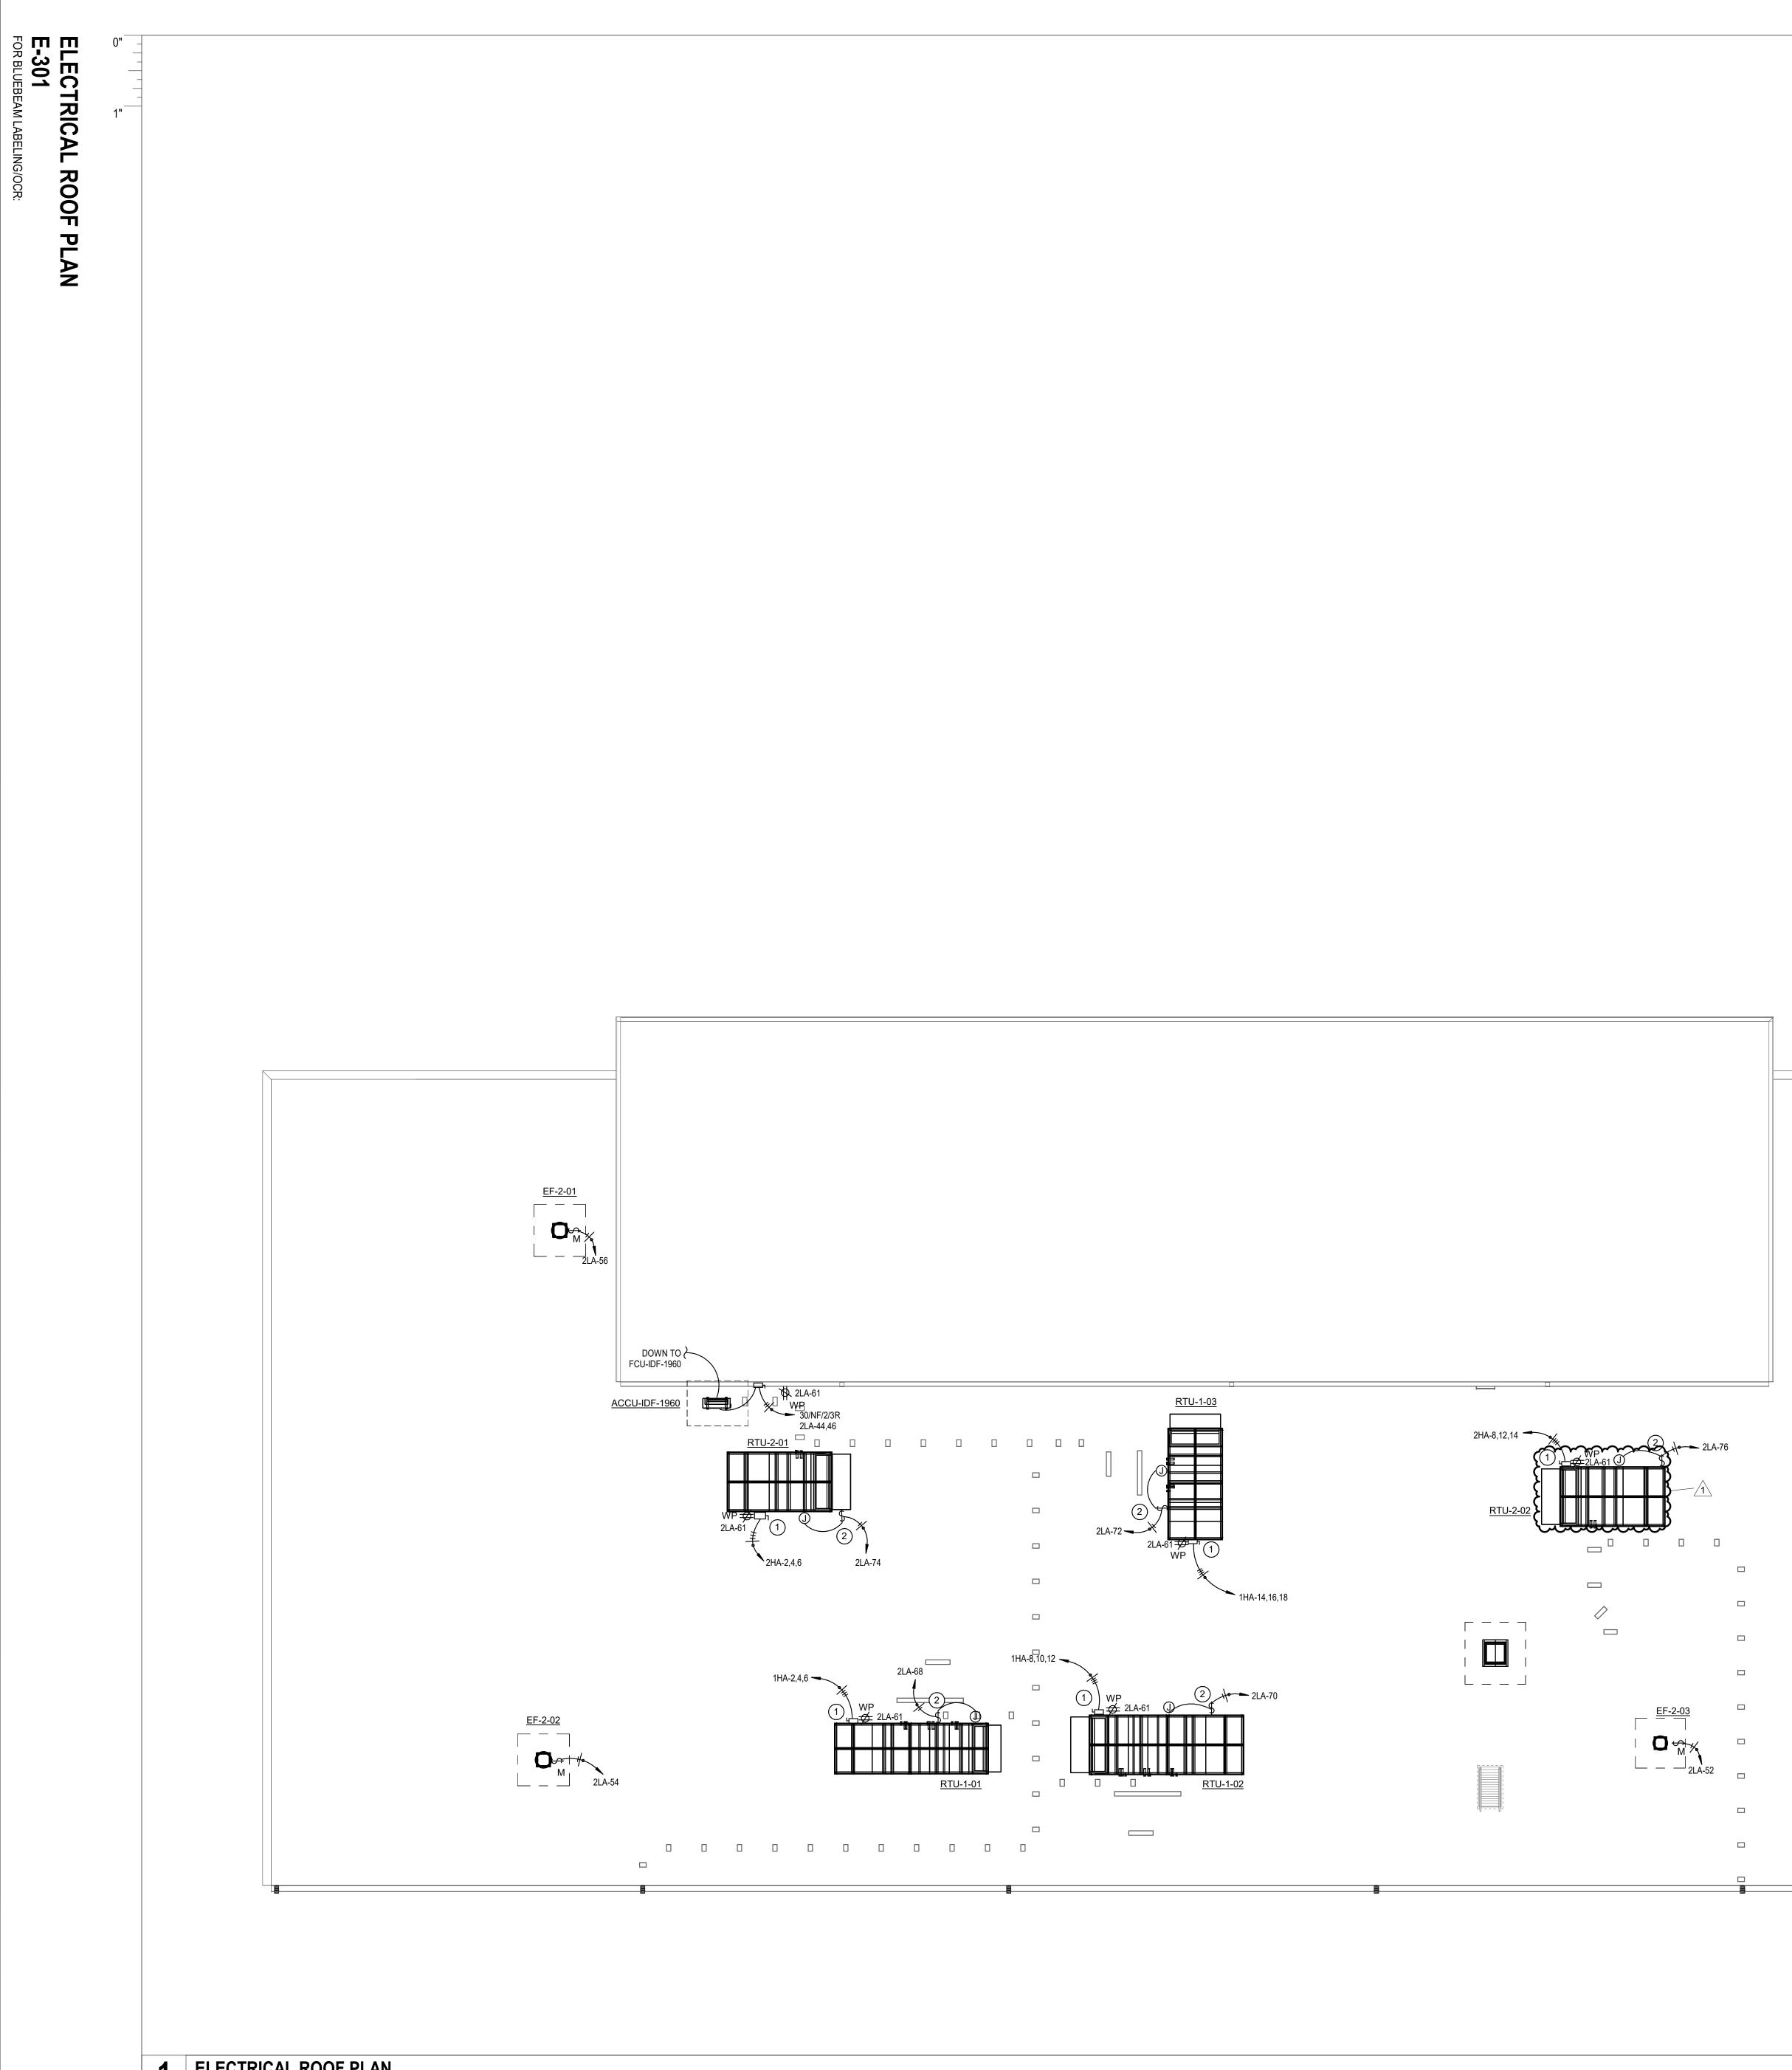


POWER PLAN GENERAL NOTES:

- 1. FOR EQUIPMENT OR DEVICES SHOWN ON ARCHITECTURAL DRAWINGS THAT REQUIRE POWER AND NOT IDENTIFIED ON ELECTRICAL PLANS, ASSUME AT A MINIMUM A DUPELX OUTLET, A DEDICATED CIRCUIT WITH 2#12,1#12G,3/4"C. WITH HOMERUN TO NEAREST 120/208V PANEL. ITEMS SUCH AS BUT NOT LIMITED TO ROLL DOWN DOORS, COUNTER DOORS, OVERHEAD GRILLES, DISPLAY CASES, HAND DRYERS, WATER COOLERS, ICE MAKERS, GARBAGE DISPOSALS, OSCILLATING FANS, LCD's, PROJECTORS, DISHWASHERS, MOTORIZED PROJECTION SCREENS, ETC.
- 2. DATA/COMMUNICATION OUTLETS ARE SHOWN ON THIS DRAWING FOR COORDINATION PURPOSES ONLY. PROVIDE AND INSTALL ALL CONDUITS AND BACK BOXES REQUIRED BY LOW VOLTAGE SYSTEMS. COORDINATE WITH 'TS' DRAWINGS, DETAILS, ETC. AND ARCHITECTURAL DRAWINGS FOR EXACT QUANTITIES, LOCATIONS, AND REQUIREMENTS PRIOR TO ROUGH-IN.
- CONTRACTOR TO PROVIDE CONNECTION FROM EXHAUST FANS TO ALL MOTORIZED BACKDRAFT DAMPERS AS REQUIRED, COORDINATE WITH MECHANICAL.
 UNLESS OTHERWISE NOTED, ALL DISCONNECT SHOWN SHALL BE 30/NF/3 DISCONNECT.
- CONTRACTOR SHALL NOTE THAT ALL 15 AMP AND 20 AMP NON-LOCKING TYPE RECEPTACLES THAT ARE NOT LOCATED WITHIN DEDICATED APPLIANCE SPACE AND ARE BELOW 66" ABOVE FINISHED FLOOR SHALL BE TAMPER RESISTANT TYPE RECEPTACLES. PER NEC 406.12.
- 6. FOR EACH DIRTT WALL CONTAINING ELECTRICAL DEVICES CONTRACTOR SHALL PROVIDE ONE HARDWIRED CONNECTION LOCATED ABOVE CEILING FOR EACH CIRCUIT LOCATED IN THAT WALL UNLESS OTHERWISE NOTED IN DRAWINGS. CONNECTION LOCATION SHALL BE COORDINATED WITH DIRTT SHOP DRAWINGS.
- 7. FOR EACH ROOM WITH CONTROLLED RECEPTACLES ONE 20 A POWER PACK COMPATIBLE WITH THE LIGHTING CONTROL SYSTEM SHALL BE PROVIDE FOR EACH CIRCUIT PROVIDING POWER TO CONTROLLED RECEPTACLES. BOTH SWITCHED AND UNSWITCHED POWER FOR THE CIRCUIT SHALL BE PROVIDED WITH A HARDWIRED CONNECTION AT EACH DIRTT WALL. ALL OTHER CONTROLLED RECEPTACLES SHALL BE SPLIT YOLK AND PROVIDED WITH BOTH SWITCHED AND UNSWITCHED POWER. SWITCHED RECEPTACLES SHALL BE CONTROLLED BY THE DIGITAL LIGHTING CONTROL SYSTEM AND SHALL A FOLLOW TIME CLOCK SCHEDULE PROVIDED BY OWNER.

POWER PLAN KEYED NOTES:

1 EQUIPMENT STARTER DISCONNECT AND WEATHERPROOF RECEPTACLE ARE TO BE PROVIDED WITH THE UNIT. REFER TO MECHANICAL DRAWINGS FOR ADDITIONAL INFORMATION. CONTRACTOR SHALL NOTE THAT THE WEATHERPROOF RECEPTACLE SHALL NOT BE POWERED FROM THE UNIT POWER.

2 UVC LIGHT. ACCESS DOOR KILL SWITCH BY MECHANICAL. CONTRACTOR SHALL FIELD VERIFY MANUFACTURER ELECTRICAL REQUIREMENTS.

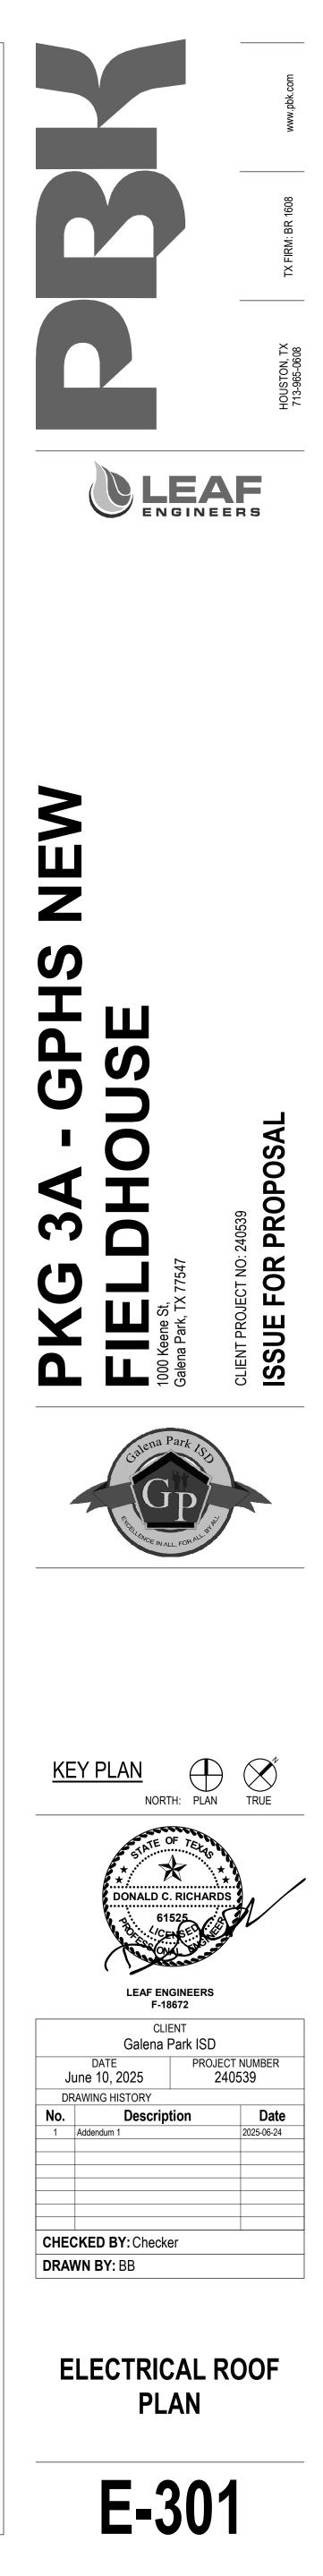

ELECTRICAL PANEL SCHEDULES E-701 FOR BLUEBEAM LABELING/OCR:


Electrical												AIC Rating:	65000		
Job:	GPISD Field House											Volts - Phase:	480Y/277V-3F	PH 4W	
Job No.:	240539				ſ	DISTRIBUTI	DPA					Served From:	UTILITY CO T	RANSFORME	R
					Со	nnected Load	(KVA)								
			Wire and							Elect.	Spare/				
Cir. No.	Load Served	Amp/Poles	Conduit Size	Lighting	Conv. Outlets	Motors	Heating	Cooling	Others	Cooking	Spaces	Elevators	Residential	Total KVA	Total An
1	2HA	225/3	SEE RISER	5.2	20.7	59.9	0.0	13.7	27.0	0.0				126.4	152.0
2	1HA	100/3	SEE RISER	7.2	0.0	9.6	3.0	0.0	0.0	0.0				19.8	23.9
3	ACCH-01	350/3	4#500, 1#3G, 3-1/2" C					217.7						217.7	261.9
4	RTU-01-01 (5 HP)	20/3	3#12, 1#12G, 1"C			6.3								6.3	7.6
5	RTU-01-02 (5 HP)	20/3	3#12, 1#12G, 1"C			6.3								6.3	7.6
6	RTU-01-03 (5 HP)	20/3	3#12, 1#12G, 1"C			6.3								6.3	7.6
7	XFMR 1TA	125/3	SEE RISER	1.9	17.7	17.8	0.0	0.0	34.7	0.0				72.0	86.6
8	SPACE													0.0	0.0
9	SPACE													0.0	0.0
	SPACE													0.0	0.0
11	SPACE													0.0	0.0
12	SPACE													0.0	0.0
Total				14.3	38.3	106.2	3.0	231.5	61.6	0.0	0.0	0.0	0.0	454.9	547.2
Demand				1.25	*	**	1.0	1.0	1.00	0.65	0.5	***	****		
Total				17.9	24.2	106.2	0.0	231.5	61.6	0.0	0.0	0.0	0.0	441.4	530.9
* 100% of							Largest		KVA						
** 125% of							0		-		DISTRIBUTION	PANEL:		D	PA
*** Elevator												TYPE:	MAIN BREA	KER	
****											MAINS (1)	SIZE:	800 AMP		
	METER MAIN, SEE ELECTRICAL RIS	SER DIAGRAM FOR	ADDITIONAL INFORMATIO	N.								PHASE:	800 AMP		
()	6/24/2025			By:	Designer]				BUS SIZE		800 AMP		
					-								PER NEC		


		Mounting	SURFACE				Job	: GPISD Field House							Job No.	240539			AIC	10000				
		Main							Voltage:		208Y/120	V-3PH 4V	N							-				_
		Neutral	200%						Main		100 AM	PS				-			Ground	Equipme	nt Ground			
																-			Lugs	FEED TH	RU			_
ANEL:								-				LOADS												
Ltg.	Recept	Motor	Heat	Cool	Other	Kitchen	S/S	Description	Amp/P	Wire	Cir. No.	Ph	Cir. No.	Wire	Amp/P	Description	Ltg.	Recept	Motor	Heat	Cool	Other	Kitchen	S/5
					1664		0.00	WASHER #1-LAUNDRY	20/2	12	1	Α	2	12	20/2	DRYER #1-LAUNDRY						790		0.0
					1664		0.00	-	-	-	3	B	4	-	-	-						790		0.0
					1664		0.00	WASHER #2-LAUNDRY	20/2	12	5	C	6	12		DRYER #2-LAUNDRY						790		0.00
					1664		0.00	-	-	-	7	A	8	-	-	-						790		0.00
					1664		0.00	WASHER #3-LAUNDRY	20/2	12	9	В	10	12		DRYER #3-LAUNDRY						790		0.00
					1664		0.00	-	-	-	11	C	12	-	-	-						790		0.00
							1.00	SPARE	20/1		13	A	14			SPARE								1.00
							1.00	SPARE	20/1		15	B	16			SPARE								1.00
							1.00	SPARE	20/1		17	C	18			SPARE								1.00
							1.00	SPARE	20/1		19	A	20			SPARE								1.00
							1.00	SPARE	20/1		21	B	22			SPARE								1.00
							1.00	SPARE	20/1		23	C	24			SPARE								1.00
							1.00	SPARE	20/1		25	A	26			SPARE								1.00
							1.00	SPARE	20/1		27	B	28			SPARE								1.00
							1.00	SPARE	20/1		29	C	30			SPARE								1.00
							1.00	SPARE	20/1		31	A	32			SPARE								1.00
							1.00	SPARE	20/1		33	B	34			SPARE								1.00
							1.00	SPARE	20/1		35	C	36	40		SPARE								1.00
							1.00	SPARE	20/1		37	A	38	10	30/3	SPD								0.00
							1.00	SPARE	20/1		39	B	40	•	-	-								0.00
	0	0	0	0	0004	0	1.00	SPARE	20/1		41	C	42	-	-	-		-	0	0	0	4740	0	0.00
0	0	0	0	0	9984	0	15.00	TOTALS								TOTALS	0	0	0	0	0	4742	0	12.0
			LOAD SU									Dhac	se Load						Panel Rer	norke:				
l ta	Recept	Motor	Heat	Cool	Other	Kitchen	S/S	 Description				Ph	KVA							1101 NS.				
Ltg. 0.0	0.0	0.0	0.0	0.0	14.7	0.0	27.0	Connected KVA				A	4.9											
1.25	**	1.00	1.00	1.00	14.7	0.65	0.50	*Design Factors				B	4.9											
0.0	0.0	0.0	0.0	0.0	14.7	0.05	13.5	Design KVA				C	4.9											
0.0	0.0	0.0	0.0	0.0	14.7	0.0	13.5	Design KVA				U	4.9											
nput di																								
100%																								
0070																								
[Con.	Con.		Des.	Des.														PANEL:	1LG				
	KVA	Amps		KVA	Amps																	1		
) TAL	41.7	115.8		28.2	78.3						Date:	6/24	4/2025		By:	Designer						10/22/03		


		Mounting	SURFACE MCB (225				Job -	GPISD Field House			480Y/277	/_3DH //M	,		Job No.	240539			AIC	42000				
		Neutral		H)(I)			-		Main		225 AM							~	Ground	Equipme	nt Ground			
							-				220741					- //1		∕1∖		FEED TH	RU			•
PANEL:	2HA										ALL	LOADS I	N VA			1//		$\overline{}$	Ū					
Ltg.	Recept	Motor	Heat	Cool	Other	Kitchen	S/S	Description	Amp/P	Wire	Cir. No.	Ph	Cir. No.	Wire	Amp/R	Description	Ltg.	Recept	Mator	Heat	Cool	Other	Kitchen	S/S
		1524					0.00	CVB-2-01-01	15/1	12	1	Α	2	12	20/3	/RTU-2-01			2632	8				0.00
		803					0.00	CVB-2-01-02	15/1	12	3	В	4	-	مب	(7.5 HP)			2632	(0.00
		803					0.00	CVB-2-01-03	15/1	12	5	C	6	-	20/3	-			2632	2				0.00
		803					0.00	CVB-2-01-04	15/1	12	7	<u>A</u>	8	12		RTU-2-02			2632)				0.00
		803					0.00	CVB-2-01-05	15/1	12	9	B	10	-	-	(7.5 HP)			2632	<u> </u>				0.00
		1080 803					0.00	CVB-2-01-06 CVB-2-01-07	15/1	12	11 13	C	12 14	- 12	- 15/3	- CVB-2-02-03			2632 1080					0.00
		803					0.00	CVB-2-01-07 CVB-2-01-08	15/1 15/1	12 12	15	A B	14	12		CVB-2-02-03 CVB-2-02-04			1080		+			0.00
		803					0.00	CVB-2-01-08	15/1	12	15	C	18	12		CVB-2-02-04 CVB-2-02-05			1080					0.00
		803					0.00	CVB-2-01-09	15/1	12	19	A	20	12		CVB-2-02-05			803					0.00
		1524					0.00	CVB-2-02-02	15/1	12	21	B	22		10/0	SPACE			000					0.00
							0.00	SPACE			23	C	24			SPACE								0.00
0	0	10554	0	0	0	0	0.00	TOTALS								TOTALS	0	0	19833	0	0	0	0	0.00
													1											
PANEL:	2H	A	2	(Sectio							ALL	LOADS I	N VA											
Ltg.	Recept	Motor	Heat	Cool	Other	Kitchen	S/S	Description	Amp/P	Wire	Cir. No.	Ph	Cir. No.	Wire	Amp/P	Description	Ltg.	Recept	Motor	Heat	Cool	Other	Kitchen	S/S
2400							0.00	2ND FLOOR LTG	20/1	12	25	Α	26	6	70/3	ELEVATOR			9412					0.00
1300							0.00	2ND FLOOR CORR LTG	20/1	12	27	В	28	-	-	(25HP)			9412					0.00
							0.00	SPACE			29	С	30	-	-	-			9412					0.00
							0.00	SPACE			31	Α	32			SPACE								0.00
							0.00	SPACE			33	B	34			SPACE								0.00
							0.00	SPACE			35	<u>с</u>	36			SPACE								0.00
							0.00	SPACE SPACE			37 39	A B	38 40			SPACE SPACE								0.00
							0.00	SPACE			41	C	40			SPACE								0.00
							0.00	SPACE			41	A	44	SEE	125/3	XFMR 2LA	500	6883	413	0	4576	8983	0	0.00
							0.00	SPACE			45	B	46	RISER	-	-	500	6883	413	0	4576	8983	0	0.00
							0.00	SPACE			47	c	48	-	-	-	500	6883	413	0	4576	8983	0	0.00
3700	0	0	0	0	0	0	0.00	TOTALS								TOTALS		20650	29476	0	13728	26950	0	0.00
	-		-	-	-					I	1		1		1					-				
			LOAD S	JMMARY								Phas	e Load						Panel Rer	narks:				
Ltg.	Recept	Motor	Heat	Cool	Other	Kitchen	S/S	Description				Ph	KVA]					(1) PRO	VIDE M	ETER MA	AIN, SEE	ELECTRI	CAL
5.2	20.7	59.9	0.0	13.7	27.0	0.0	0.0	Connected KVA				Α	44.2									DDITION	AL	
1.25	**	1.00	1.00	1.00	1.00	0.65	0.50	*Design Factors				В	42.3	-					INFORM	IATION.				
6.5	15.3	59.9	0.0	13.7	27.0	0.0	0.0	Design KVA				C	39.8											
1																								
Input di *100%																								
100%																								
	Con.	Con.		Des.	Des.]													PANEL:	2H∆				
	KVA	Amps		KVA	Amps																		-	
OTAL	126.4	152.0		122.4	147.2	1					Date:	6/04	/2025		By:	Designer						10/22/03		


Plot Stamp: 6/24/2025 11:51:00 AM

		Mounting Main Neutral	MCB (225			
PANEL:	1HA					
Ltg.	Recept	Motor	Heat	Cool	Other	Kitcher
		943				
		943				
		943 1328				
		1328				
		1328				
0	0	6813	0	0	0	0
PANEL:	11	łA	2	(Sectio		
Ltg.	Recept	Motor	Heat	Cool	Other	Kitcher
2400 1300						
3700	0	0	0	0	0	0
				UMMARY		
Ltg.	Recept	Motor	Heat	Cool	Other	Kitcher
7.2	0.0	9.6	3.0	0.0	0.0	0.0
1.25	**	1.00	1.00	1.00	1.00	0.65
9.0	0.0	9.6	3.0	0.0	0.0	0.0
*Input di **100%		Con.		Des.	Des.	1
	KVA	Amps		KVA	Amps	

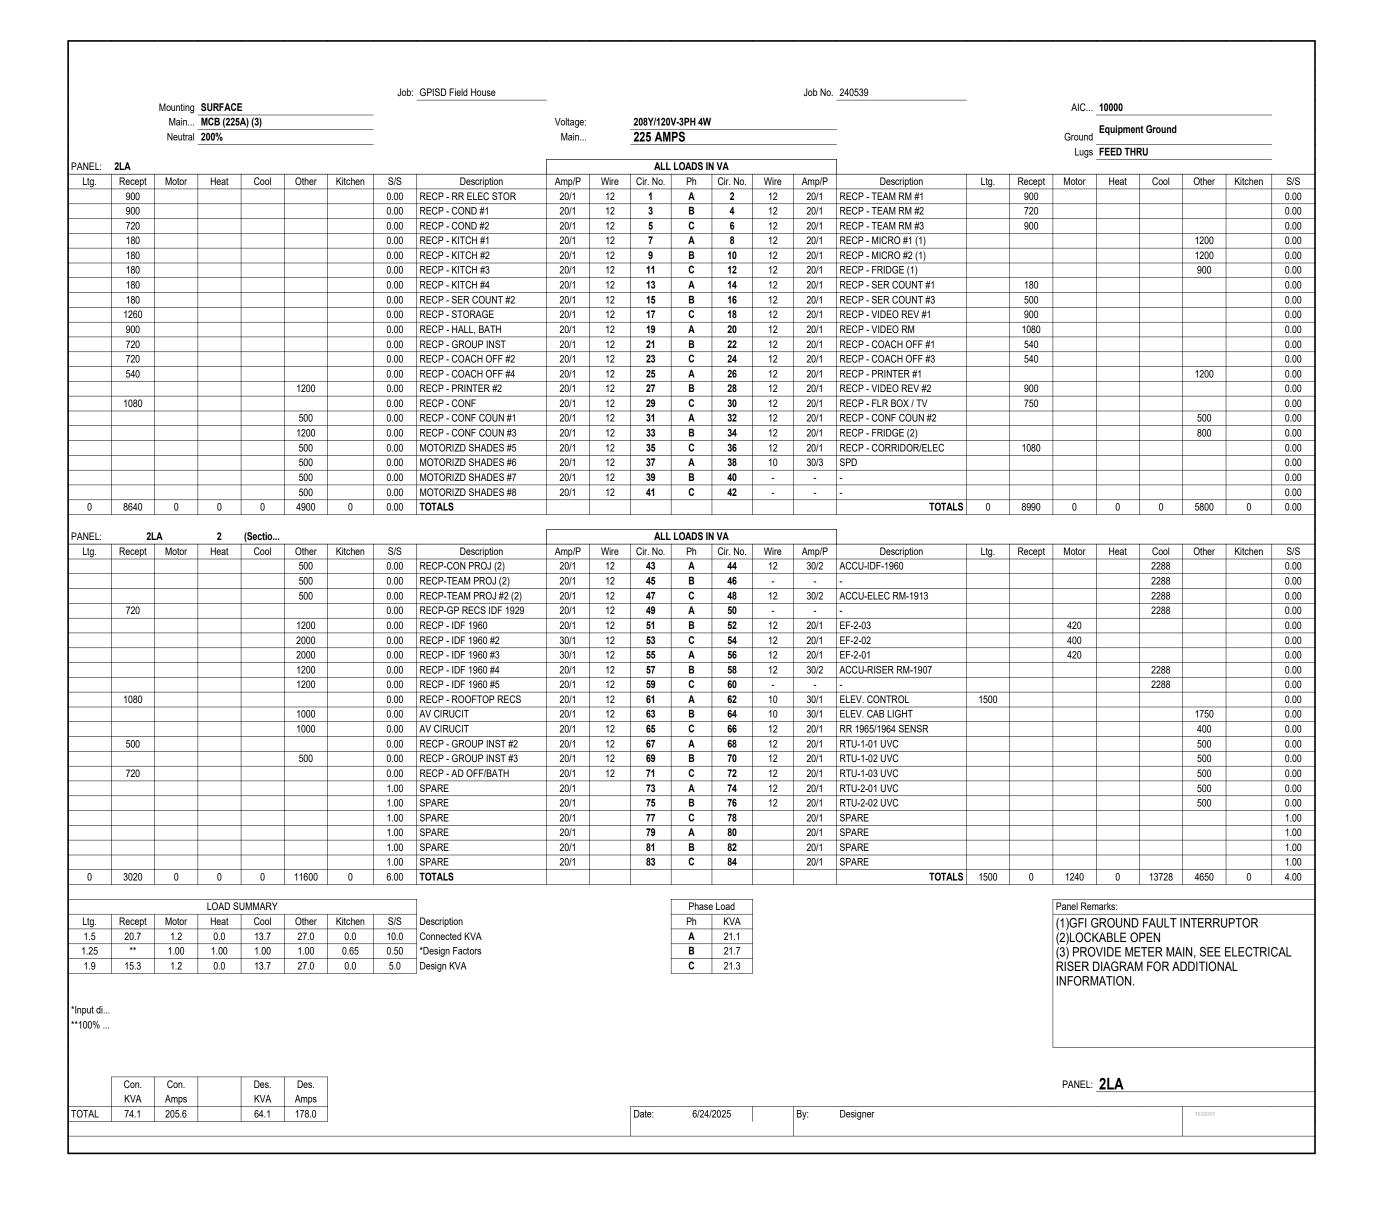

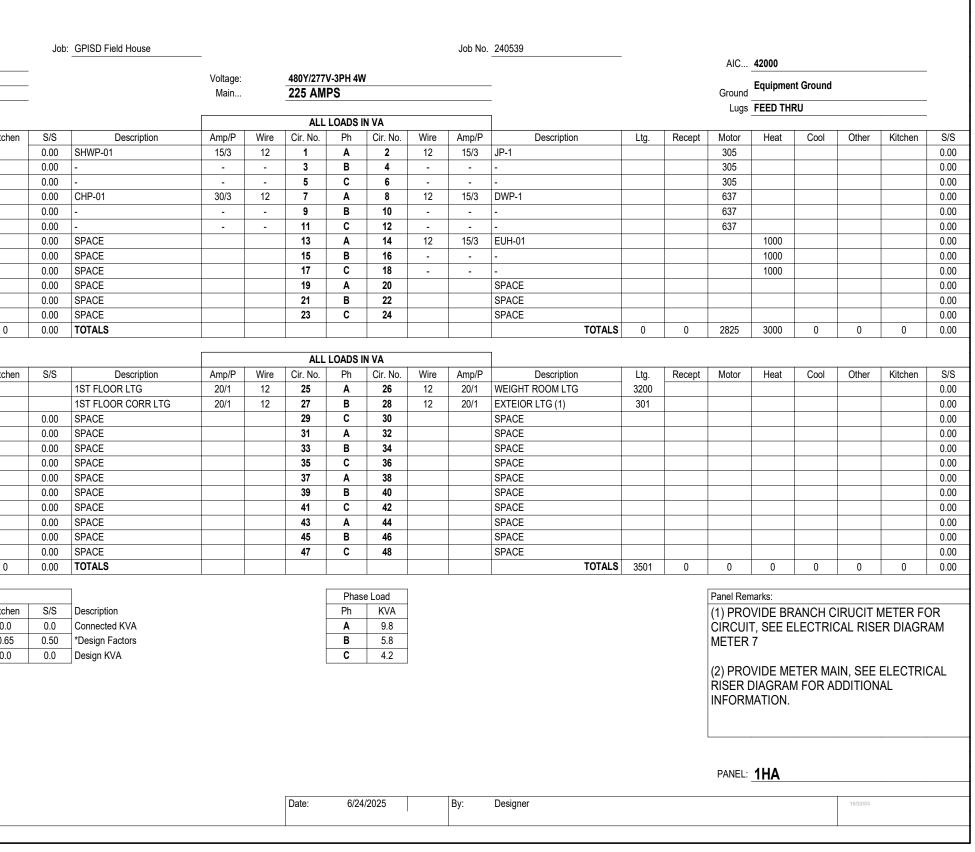

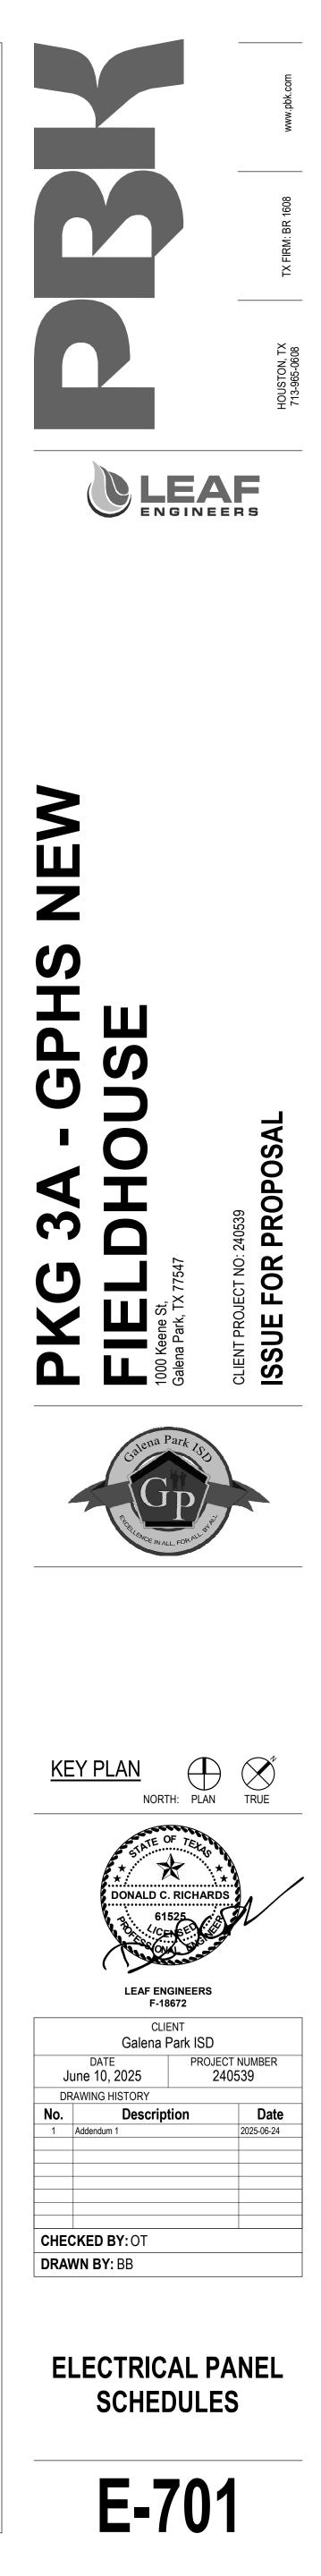

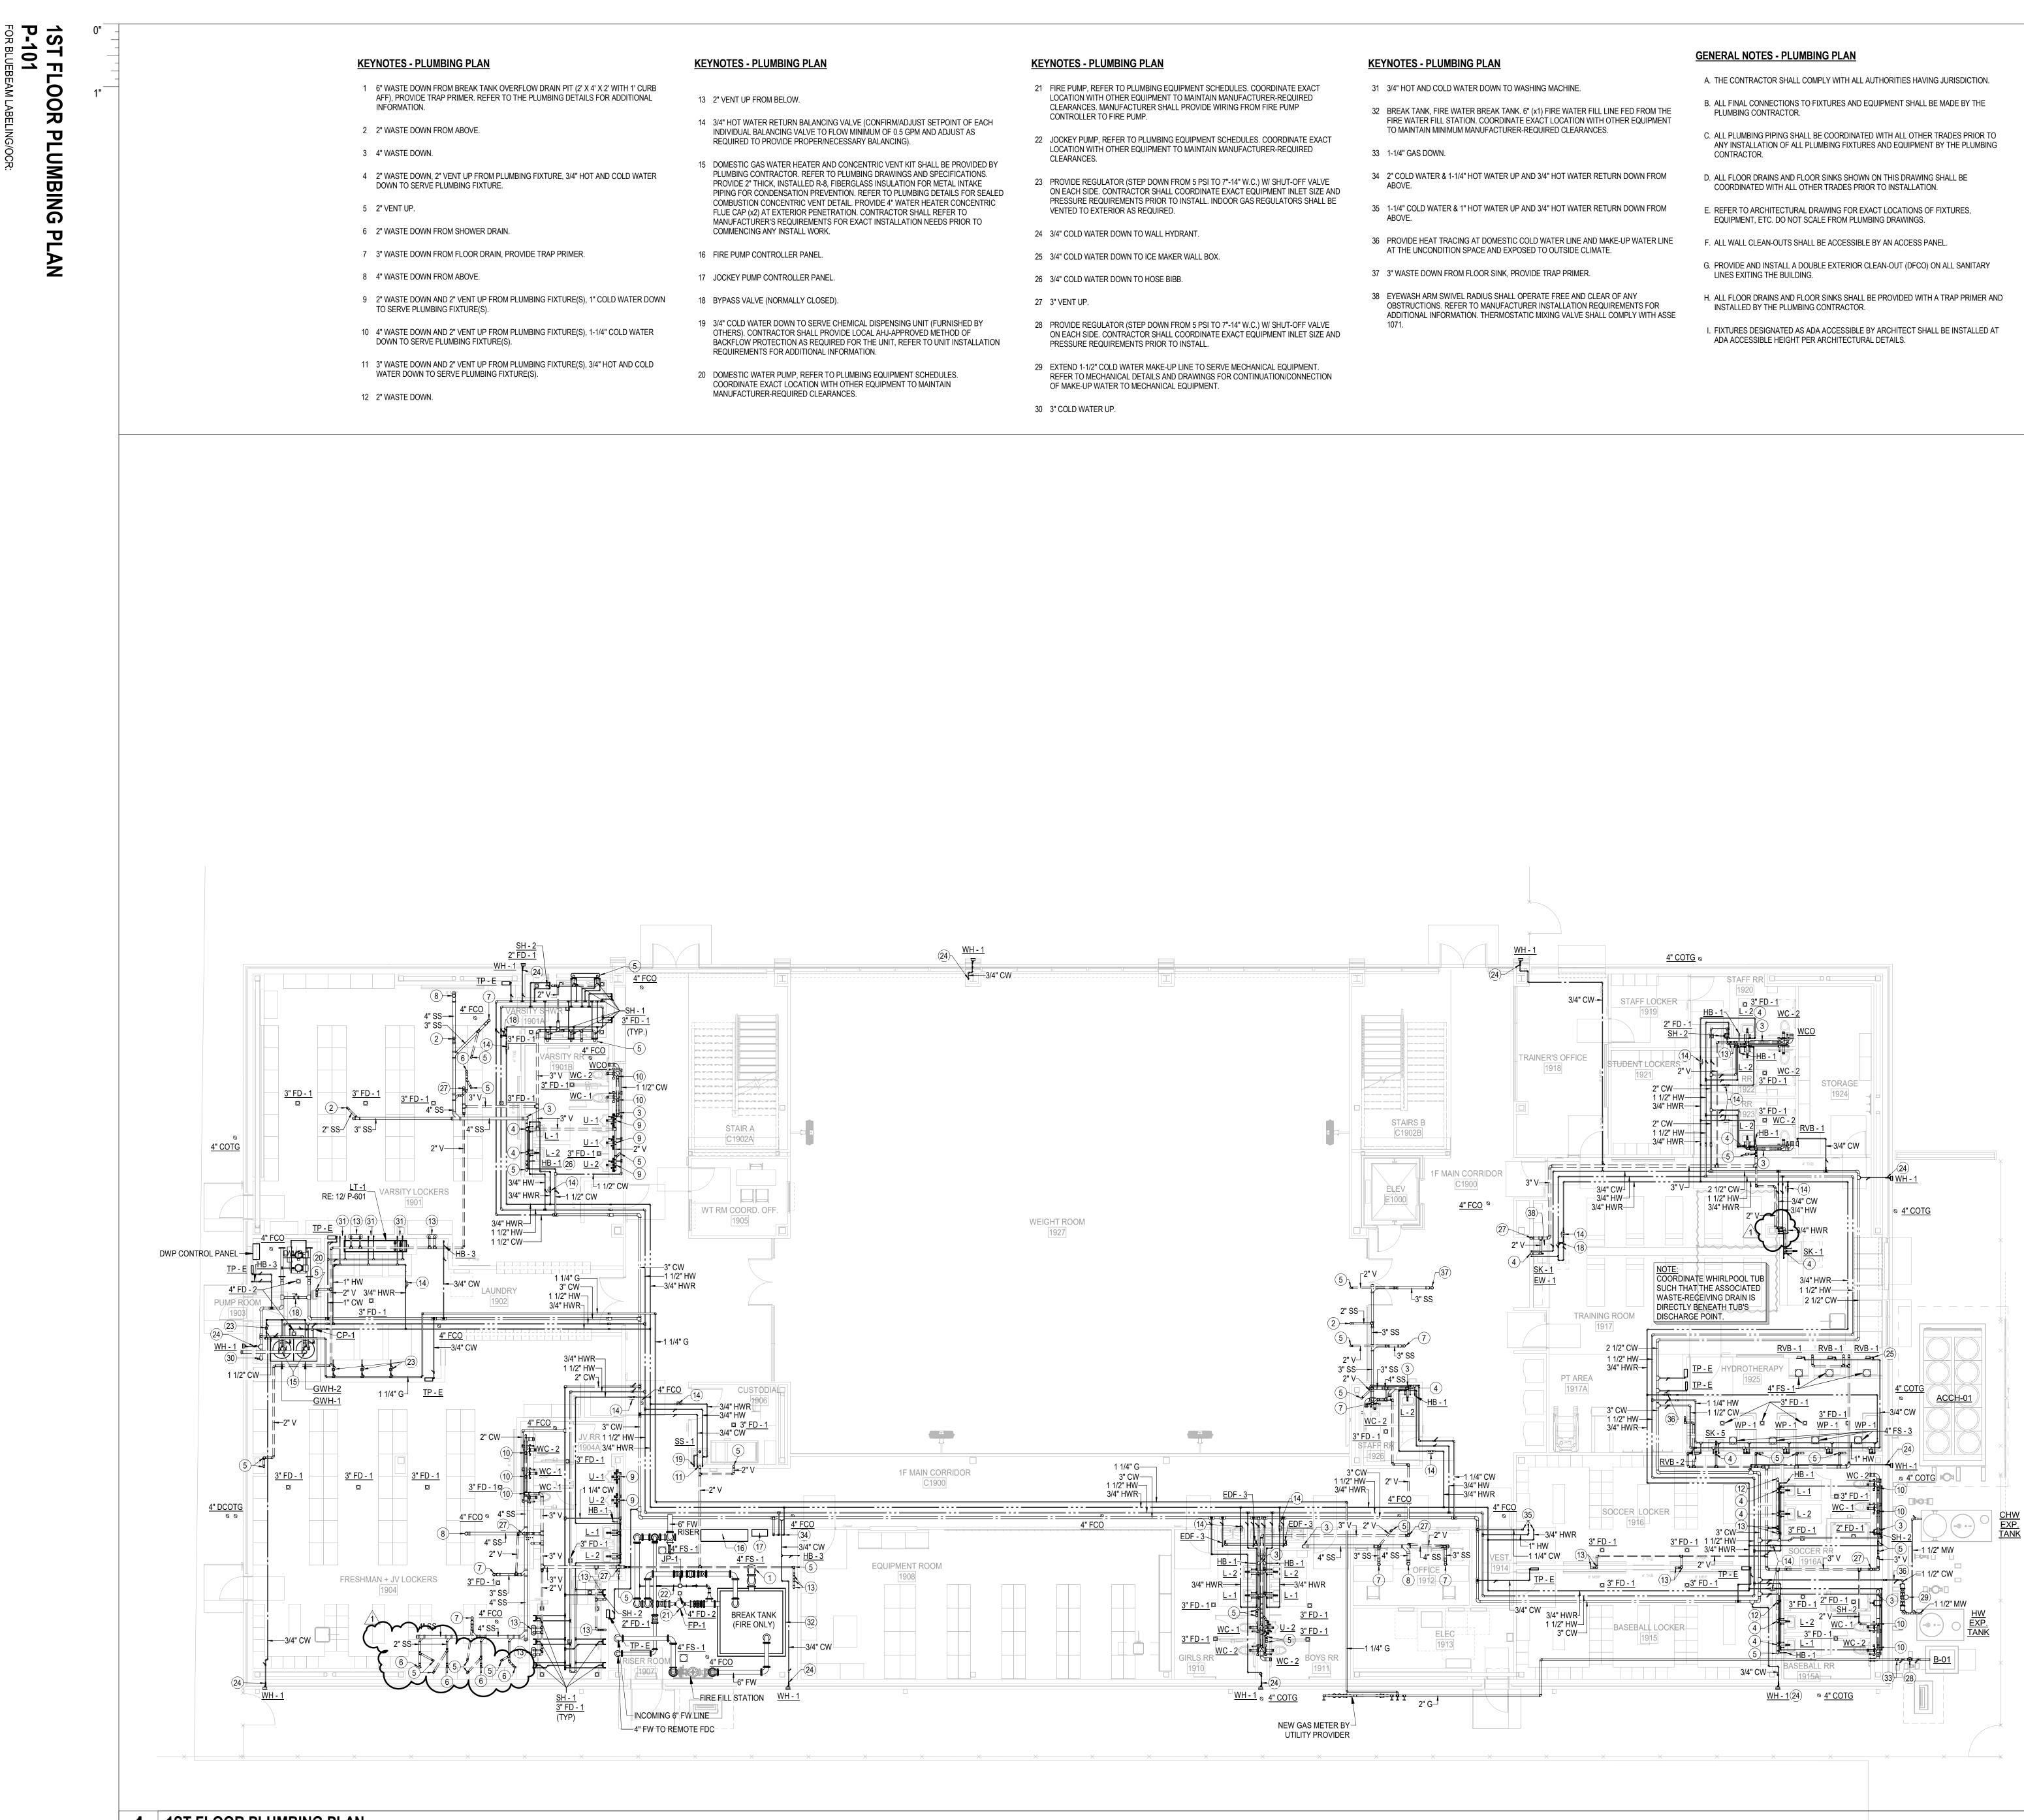



Plot Stamp: 6/24/2025 10:57:57 AM **1ST FLOOR PLUMBING PLAN** SCALE: 1/8" = 1'-0"

SHUT-OFF VALVE. EQUIPMENT. HB-3, IN ALL MECHANICAL ROOMS. MECHANICAL ROOMS, HB-3. AND HEAT TRACED TO PREVENT FREEZING. SUBSTANTIAL COMPLETION.

GENERAL NOTES - PLUMBING PLAN

- J. ALL DOMESTIC COLD AND HOT WATER TAKE-OFFS SHALL HAVE AN ISOLATION
- K. FLOOR DRAINS AND FLOOR SINKS IN MECHANICAL ROOMS SHALL BE SET NOT LESS THAN 6" FROM HOUSEKEEPING PADS. RE: MECHANICAL DRAWINGS. DO NOT PLACE ON, OR IN, HOUSEKEEPING PAD, OR UNDERNEATH EQUIPMENT.
- L. CONTRACTOR SHALL DEWATER ANY AREA AT OR BELOW GRADE PRIOR TO SETTING
- M. CONTRACTOR SHALL PROVIDE AND INSTALL A TRAP PRIMER, TP-1, AND A HOSE BIBB,
- N. CONTRACTOR SHALL PROVIDE AND INSTALL A HOSE BIBB WITH WHEEL HANDLE IN ALL
- O. ANY AND ALL WATER PIPING EXPOSED TO OUTSIDE ELEMENTS SHALL BE INSULATED
- P. ALL SANITARY 3" OR ABOVE SHALL BE INSPECTED BY A CAMERA PRIOR TO
- Q. ALL RVB-1 SHALL HAVE FILTER

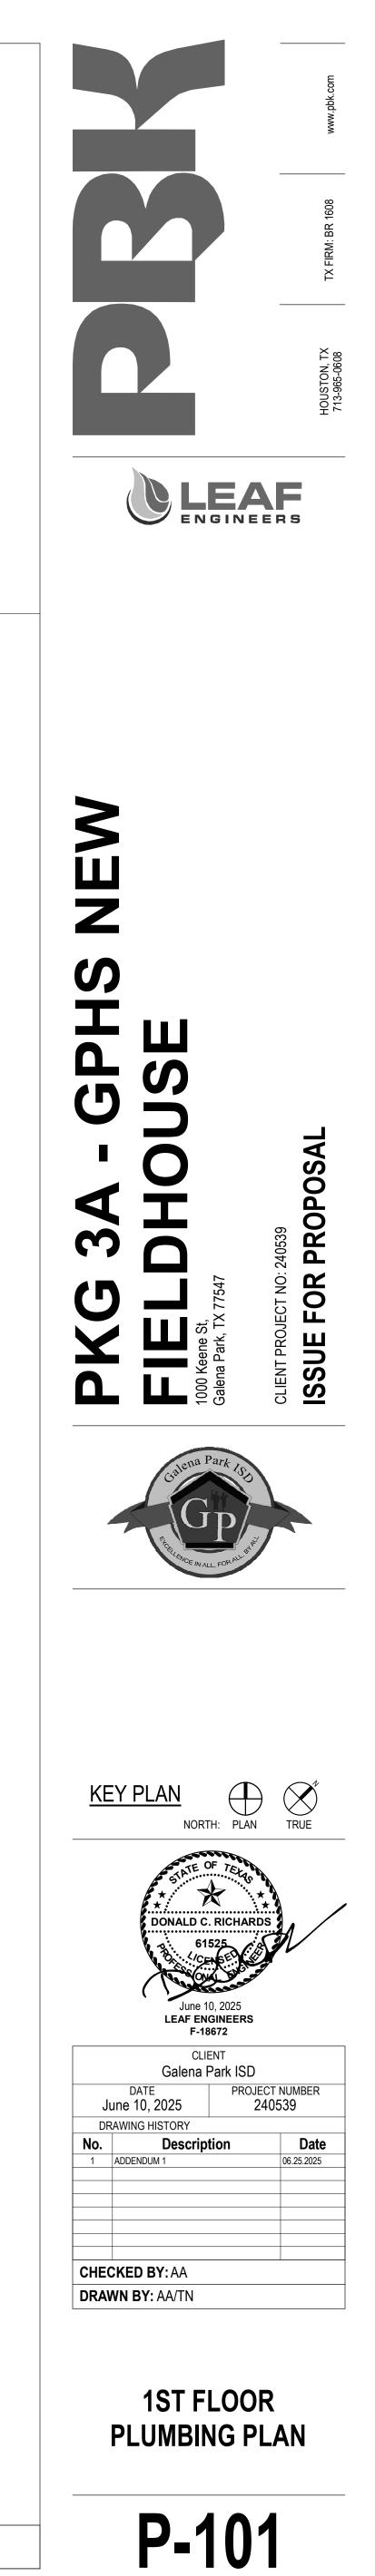

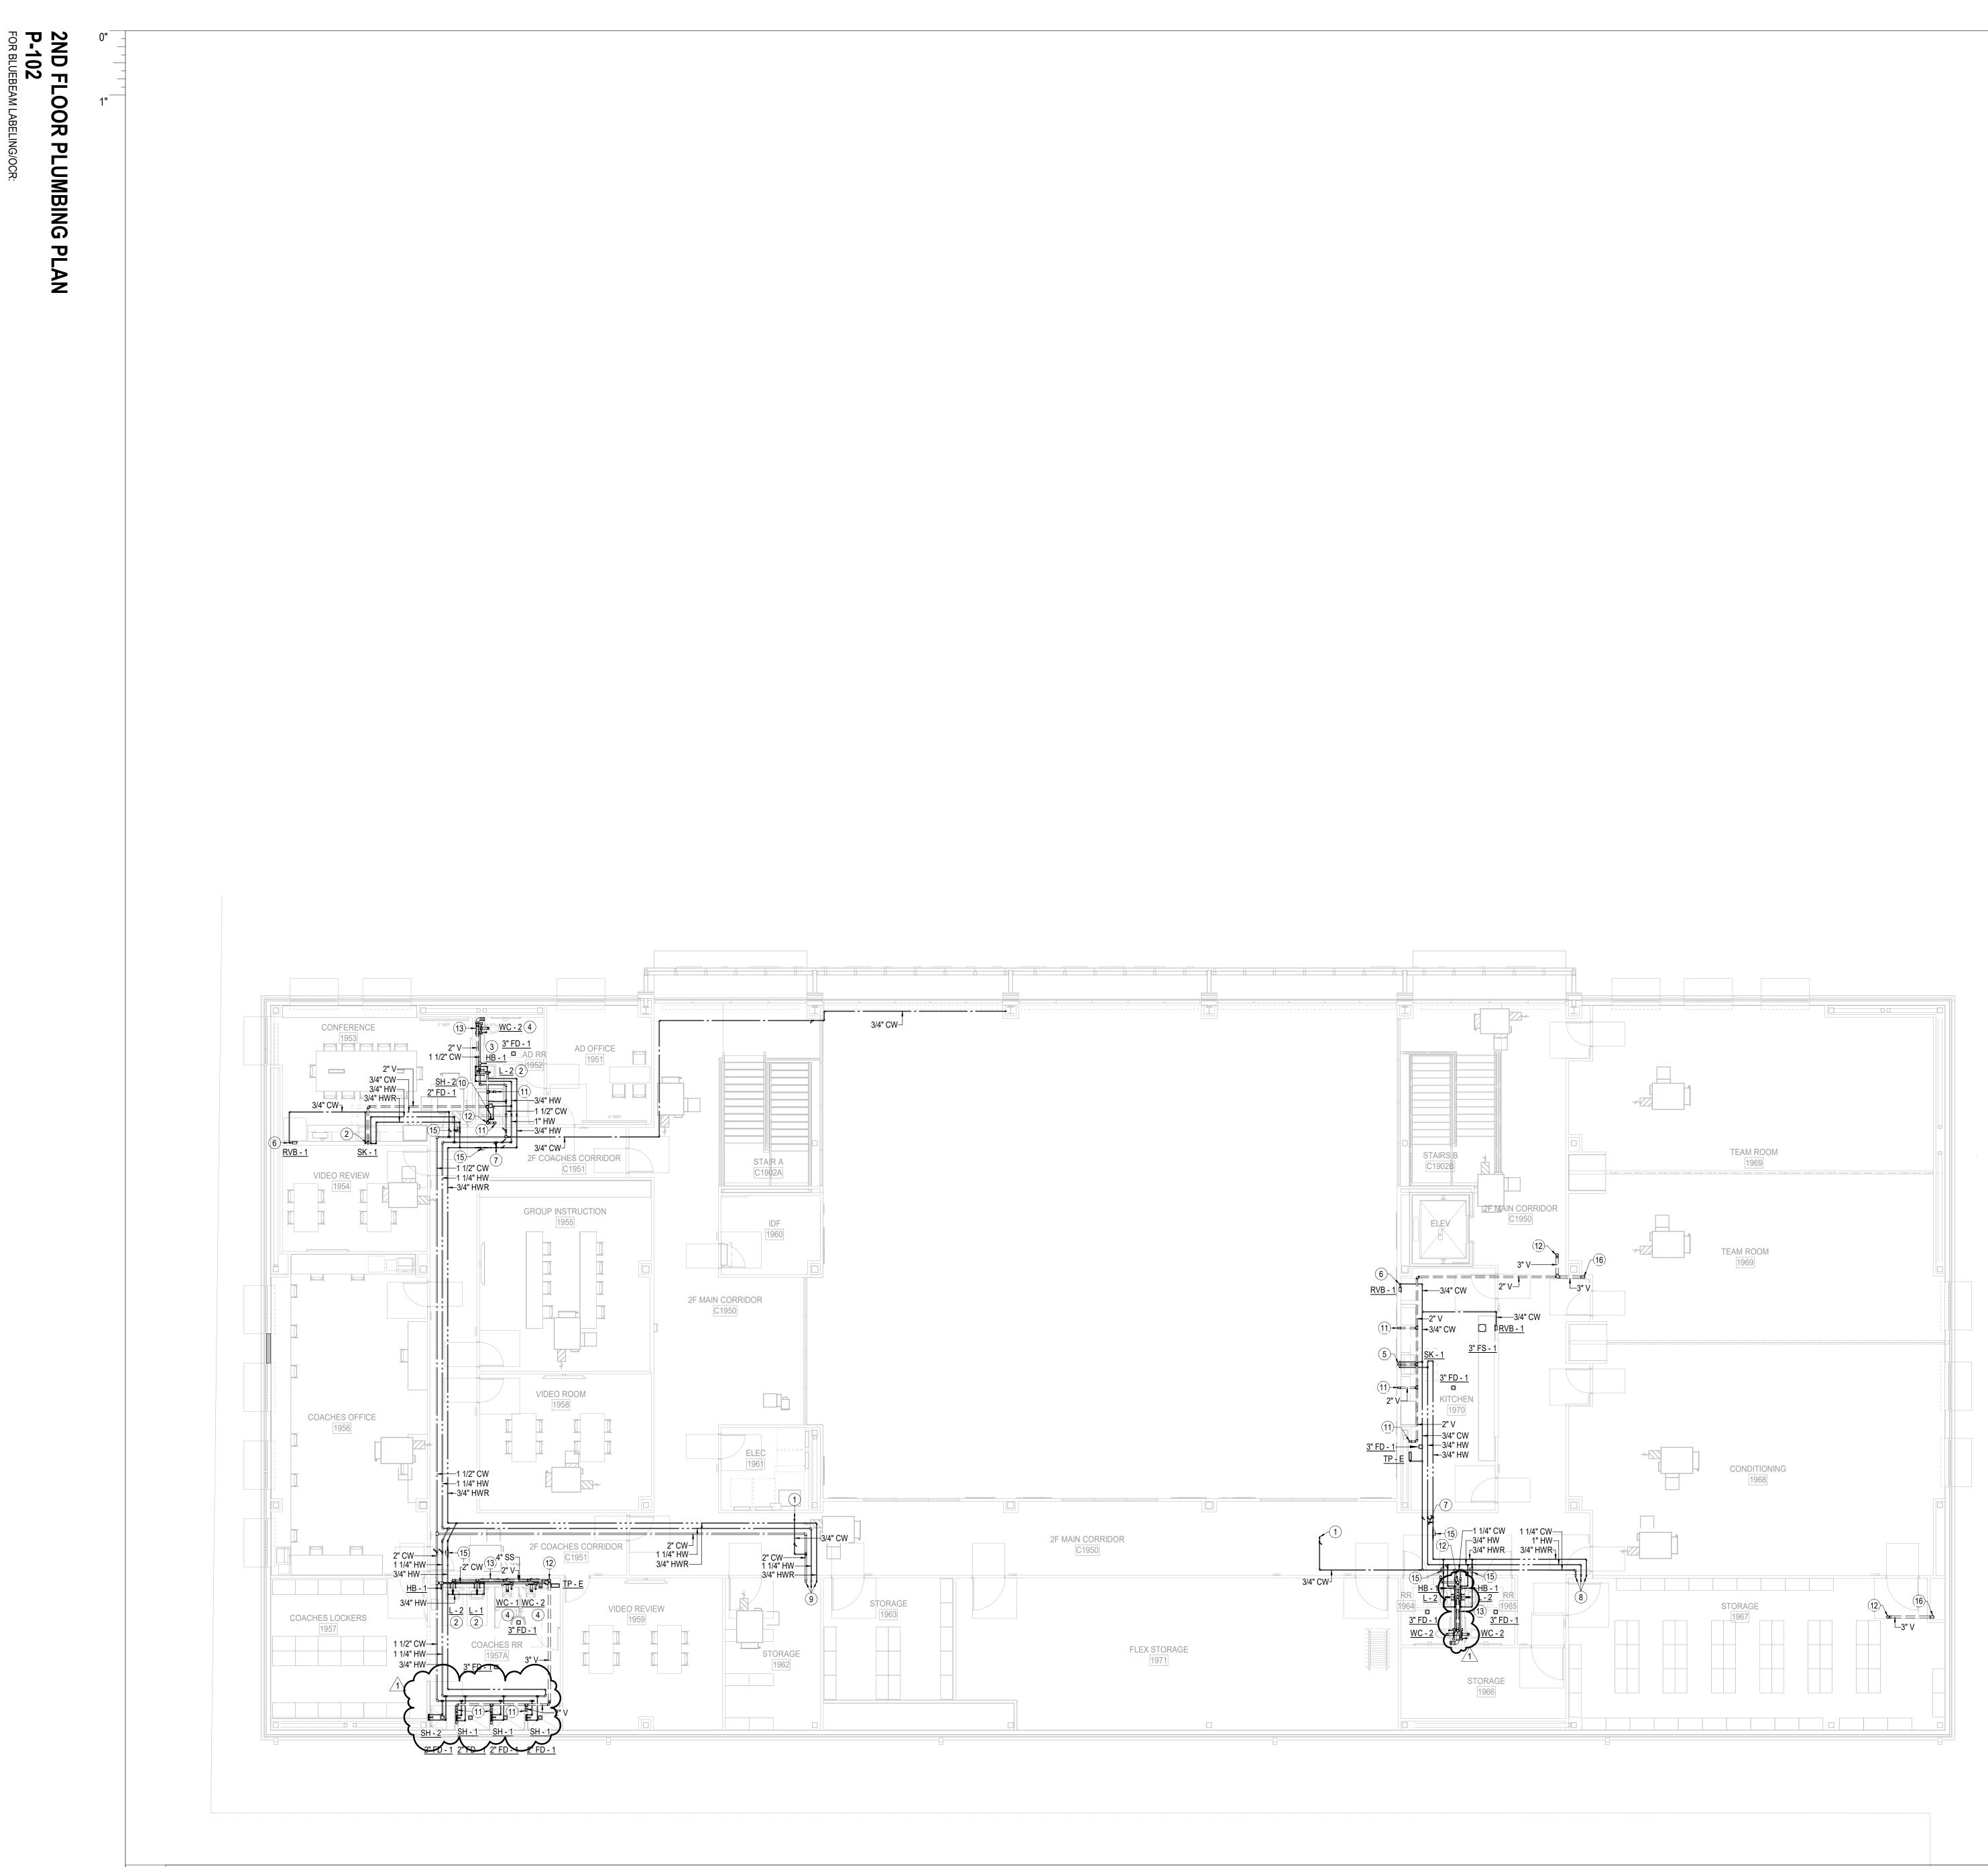

Plot Stamp: 6/24/2025 10:58:13 AM **2ND FLOOR PLUMBING PLAN** SCALE: 1/8" = 1'-0"

GENERAL NOTES - PLUMBING PLAN

- A. THE CONTRACTOR SHALL COMPLY WITH ALL AUTHORITIES HAVING JURISDICTION.
- B. ALL FINAL CONNECTIONS TO FIXTURES AND EQUIPMENT SHALL BE MADE BY THE PLUMBING CONTRACTOR.
- C. ALL PLUMBING PIPING SHALL BE COORDINATED WITH ALL OTHER TRADES PRIOR TO ANY INSTALLATION OF ALL PLUMBING FIXTURES AND EQUIPMENT BY THE PLUMBING CONTRACTOR.
- D. ALL FLOOR DRAINS AND FLOOR SINKS SHOWN ON THIS DRAWING SHALL BE COORDINATED WITH ALL OTHER TRADES PRIOR TO INSTALLATION.
- E. REFER TO ARCHITECTURAL DRAWING FOR EXACT LOCATIONS OF FIXTURES, EQUIPMENT, ETC. DO NOT SCALE FROM PLUMBING DRAWINGS.
- F. ALL WALL CLEAN-OUTS SHALL BE ACCESSIBLE BY AN ACCESS PANEL.
- G. PROVIDE AND INSTALL A DOUBLE EXTERIOR CLEAN-OUT (DFCO) ON ALL SANITARY LINES EXITING THE BUILDING.
- H. ALL FLOOR DRAINS AND FLOOR SINKS SHALL BE PROVIDED WITH A TRAP PRIMER AND
- INSTALLED BY THE PLUMBING CONTRACTOR.
- I. FIXTURES DESIGNATED AS ADA ACCESSIBLE BY ARCHITECT SHALL BE INSTALLED AT ADA ACCESSIBLE HEIGHT PER ARCHITECTURAL DETAILS.
- J. ALL DOMESTIC COLD AND HOT WATER TAKE-OFFS SHALL HAVE AN ISOLATION SHUT-OFF VALVE.
- K. FLOOR DRAINS AND FLOOR SINKS IN MECHANICAL ROOMS SHALL BE SET NOT LESS THAN 6" FROM HOUSEKEEPING PADS. RE: MECHANICAL DRAWINGS. DO NOT PLACE ON, OR IN, HOUSEKEEPING PAD, OR UNDERNEATH EQUIPMENT.
- L. CONTRACTOR SHALL DEWATER ANY AREA AT OR BELOW GRADE PRIOR TO SETTING EQUIPMENT.
- M. CONTRACTOR SHALL PROVIDE AND INSTALL A TRAP PRIMER, TP-1, AND A HOSE BIBB, HB-3, IN ALL MECHANICAL ROOMS.
- N. CONTRACTOR SHALL PROVIDE AND INSTALL A HOSE BIBB WITH WHEEL HANDLE IN ALL MECHANICAL ROOMS, HB-3.
- O. ANY AND ALL WATER PIPING EXPOSED TO OUTSIDE ELEMENTS SHALL BE INSULATED
- AND HEAT TRACED TO PREVENT FREEZING.
- P. ALL SANITARY 3" OR ABOVE SHALL BE INSPECTED BY A CAMERA PRIOR TO SUBSTANTIAL COMPLETION.
- Q. ALL RVB-1 SHALL HAVE FILTER.

KEYNOTES - PLUMBING PLAN

- 1 3/4" COLD WATER UP TO NON-FREEZE ROOF HYDRANT.
- 2 2" WASTE DOWN, 2" VENT UP FROM PLUMBING FIXTURE, 3/4" HOT AND COLD WATER DOWN TO SERVE PLUMBING FIXTURE.
- 3 3/4" COLD WATER DOWN TO HOSE BIBB.
- 4 4" WASTE DOWN AND 2" VENT UP FROM PLUMBING FIXTURE(S), 1-1/4" COLD WATER DOWN TO SERVE PLUMBING FIXTURE(S).
- 5 2" WASTE DOWN AND 2" VENT UP FROM PLUMBING FIXTURE. 3/4" COLD/HOT WATER DOWN TO SERVE SINK AND DISHWASHER. PROVIDE WATTS "288A" VACUUM BREAKER PRIOR TO CONNECTION TO DISHWASHER. CONNECT INDIRECT WASTE FROM DISHWASHER TO HAND SINK.
- 6 3/4" COLD WATER DOWN TO REFRIGERATOR VALVE BOX.
- 7 SHUTOFF VALVE FOR HOT WATER RETURN BYPASS TO REMAIN IN THE CLOSED POSITION. VALVE SHALL BE OPENED MANUALLY ON AN AS NEEDED BASIS BY MAINTANCE PERSONNEL, AND SHALL BE CLOSED WHEN MAINTENANCE IS COMPLETED.
- 8 1-1/4" COLD WATER & 1" HOT WATER UP AND 3/4" HOT WATER RETURN DOWN FROM ABOVE.
- 9 2" COLD WATER & 1-1/4" HOT WATER UP AND 3/4" HOT WATER RETURN DOWN FROM
- 10 3/4" HOT AND COLD WATER DOWN TO SERVE PLUMBING FIXTURE(S).
- 11 2" VENT UP.

ABOVE.

- 12 3" VENT THRU ROOF.
- 13 4" WASTE DOWN.
- 15 3/4" HOT WATER RETURN BALANCING VALVE (CONFIRM/ADJUST SETPOINT OF EACH INDIVIDUAL BALANCING VALVE TO FLOW MINIMUM OF 0.5 GPM AND ADJUST AS REQUIRED TO PROVIDE PROPER/NECESSARY BALANCING).
- 16 3" VENT UP.

