

## ADDENDUM NO. 2

October 02, 2024

### NEW CANEY INDEPENDENT SCHOOL DISTRICT

### NEW CANEY ELEMENTARY

New Caney, TX



BRW Project No.: 223117.00

---

The Construction Documents for the above referenced project, dated **September 9, 2024**, shall be amended as follows:

### CLARIFICATIONS

- 2.01 A pre-proposal meeting was held at 9:30AM September 25, 2024, at 22784 Hwy 59S Building E, Porter, TX 77365. Attached is the sign in sheet.

### SPECIFICATIONS

#### 2.02 TABLE OF CONTENTS

- A. Add Section 03 52 16.19 Lightweight Insulating Concrete
- B. Revise section 10 26 13 to read Corner Guards and Wall Covering
- C. Add section 22 32 01 SANITARY SEWERAGE to table of contents only
- D. Add section 31 32 13.26 LIME-FLY ASH OR FLY ASH STABILIZATION
- E. Revise section 31 17 23.13 Painted Pavement markings to read 32 17 23.13 PAINTED PAVEMENT MARKINGS.
- F. Revise section 32 13 73.19 CAST IN PLACE CONCRETE to 32 13 73.19 CAST IN PLACE CONCRETE - SITE

#### 2.03 SECTION 00 20 00 NCISD REQUEST FOR COMPETITIVE SEALED PROPOSALS

- A. Replace Attachment A: Proposal Form – Base Proposal (page 25)

#### 2.04 SECTION 00 30 00 INFORMATION AVAILABLE TO BIDDERS

- A. Add letter dated September 26, 2024 from Ninyo & Moore to the end of section.

#### 2.05 SECTION 03 30 00 CAST-IN-PLACE CONCRETE

- A. Replace section in its entirety.

#### 2.06 SECTION 03 52 16.19 LIGHTWEIGHT INSULATING CONCRETE

- A. Add section in its entirety.

#### 2.07 SECTION 04 20 22 UNIT MASONRY

- A. Revise 2.02 C. 1.a. to read “Acme Stonebrook Natural Stone”
- B. Revise 2.02 C.1.b to read “Stone color to be Khaki”
- C. Add 2.02 C.1.c “Sizes and shapes to be approved by Owner and architect.”

#### 2.08 SECTION 05 12 00 STRUCTURAL STEEL FRAMING

- A. Replace section in its entirety.

#### 2.09 SECTION 05 31 23 STEEL ROOF DECKING

- A. Replace section in its entirety.

#### 2.10 SECTION 09 21 13 PLASTER ASSEMBLIES

## **ADDENDUM NO. 2**

OCTOBER 03, 2024

### **NEW CANEY INDEPENDENT SCHOOL DISTRICT**

NEW CANEY ELEMENTARY SCHOOL

NEW CANEY, TEXAS

BRW Project No.: 223117.00

- A. Revise paragraph 3.02.A.3 to read “All galvanized hanger wires to be 9-gauge wire spaced 4'-0" O.C. maximum. Do not use power actuated anchors through metal deck for wire supports”
- 2.11 SECTION 09 51 13 ACOUSTICAL CEILING TILES
  - A. Revise 2.03 A. 1. To read “Design is based on Armstrong “Cortega” acoustical ceiling tile.
- 2.12 SECTION 09 65 19 RESILIENT TILE FLOORING
  - A. Revise paragraph 2.04 D to read “Waterproof, must meet 99.9% relative humidity, stabilized type as manufactured by resilient material manufacturer.
- 2.13 SECTION 09 77 30 ACOUSTICAL DECK-MOUNTED PANELS
  - A. Revise 2.02.A.3. “Color: Manufacture’s white, painted to match the deck.”
- 2.14 SECTION 10 26 13 CORNER GUARDS
  - A. Revise section to read Corner Guards and Wall Covering
  - B. Add paragraph 2.01D
    - 1. Wall Covering (WC 1 and WC2)
      - a. Size: 4' x 10' typical
      - b. Material: High impact rigid sheet nominal thickness .040"
      - c. Texture: Sued texture
      - d. Color match trims as needed for joints / transitions
      - e. Color: to be selected by architect from the manufacturer’s full range of colors
- 2.15 SECTION 10 44 00 TOILET, BATH, AND LAUNDRY ACCESSORIES
  - A. Revise 4.01 A.8 TA-8 Feminine Napkin Disposal (4<sup>th</sup>, 5<sup>th</sup>, Special Education and Staff Restrooms only)
- 2.16 SECTION 11 52 13 PROJECTION SCREENS
  - A. 2.02 Remove 3.b Library A103: Viewing Size 78" high x 139" wide.
- 2.17 Section 11 66 23 GYMNASIUM EQUIPMENT
  - A. Remove 2.02.C.5 in its entirety.
- 2.18 SECTION 12 21 13 HORIZONTAL LOUVER BLINDS
  - A. Add 3.02 E. Coordinate glass stops to allow “inset” mounting of blinds where shown.
- 2.19 SECTION 12 32 16 MANUFACTURED PLASTIC-LAMINATED-CLAD CASEWORK
  - A. Revise 2.06 A.4 to read “ Sub-base assemblies shall be fabricated from 2" x 4" dimensional lumber. No plywood.
- 2.20 SECTION 27 05 43 UNDERGROUND DUCTS AND RACEWAYS FOR COMMUNICATIONS SYSTEMS
  - A. Revise paragraph 3.03.B.1 to read the minimum size of hand-holes to be 4'-0" X 4'-0" X 3'-0"
- 2.21 SECTION 27 13 00 COMMUNICATIONS BACKBONE CABLING
  - A. Add sub-paragraph 1.03.B.f to read as:



## ADDENDUM NO. 2

OCTOBER 03, 2024

### NEW CANEY INDEPENDENT SCHOOL DISTRICT

NEW CANEY ELEMENTARY SCHOOL

NEW CANEY, TEXAS

BRW Project No.: 223117.00

- “f. Shop drawing submittal must include port numbering/labeling scheme. Must be owner approved prior to any cabling being installed. “*
- B. Remove sub-paragraph 2.03.A. Fiber optic terminations are to be completed in splicing cassette. Only Fusion splicing is acceptable.
- C. Removed all mentions of Cat3 Copper cabling and multi-mode fiber optic cabling
- 2.22 SECTION 27 15 00 COMMUNICATIONS HORIZONTAL CABLING
- A. Reissue section in its entirety
- 2.23 SECTION 27 41 00 INTERCOMMUNICATION SYSTEM
- A. Remove sub-paragraph 2.01.B Atlas/Soundolier – Speakers and Attenuators
- B. Revise paragraph 2.02.A “shall be mounted in a 19” equipment rack with casters” to read as, “shall be mounted in a standard equipment rack in MDF”
- C. Revise paragraph 2.04.A model number “DN-300Z” to read as, “DN-500 CB”
- D. Revise paragraph 2.07.A.2 to include, “Classroom speakers must be enabled to provide ‘Talk Back’”
- E. Rewrite paragraph 2.07.B in its entirety to read as:
- “B. Wall mounted volume control: Soundolier AT-1O-PA or Quam QC-10P qual recessed autotransformer volume control. Volume control shall have public address (PA) emergency override of volume control. Volume controls are to be installed in all offices, and teacher workrooms.”*
- F. Rewrite paragraph 2.07.C in its entirety to read as:
- “C. All Exterior Speakers are to be Recessed Vandal proof Wall Speaker Quam H16/SVPS Flush Mount horn with multitap line matching transformer. Provide each unit with Quam Stainless Steel recessed backbox / Stainless Steel screws. Tap at 2.0 watts”*
- G. Add sub-paragraph 2.08.B to read as, “Admin consoles shall be Telecor E300 and are to be provided at main reception and principals office.”
- H. Revise paragraph 2.09.A to read as, “eSeries Mic MCC-PM-MA (connect to e300 console) Provide at main reception and Principals Office.”
- I. Revise paragraph 2.11.A, Master Clock System shall be Telecor eMessage Host (eMH)
- J. Rewrite paragraph 2.12.A in its entirety to read as, “Provide UPS Battery backup in every IDF/MDF for the communications system to operate a minimum of 20 minutes upon loss of power. Acceptable Manufacturers: APC or Tripplite.”
- K. Delete sub-paragraph 3.01.H.6 “Zone 6: SPORTS FIELDS”
- 2.24 SECTION 27 41 16 INTEGRATED AUDIO-VIDEO SYSTEM AND EQUIPMENT
- A. Reissue section in its entirety
- 2.25 SECTION 27 51 19 SOUND REINFORCEMENT SYSTEM
- A. Delete section in its entirety; all sound reinforcement components included in 27 41 16
- 2.26 SECTION 28 10 00 ACCESS CONTROL SYSTEM
- A. Revise paragraph 2.02.B, card reader Model Number to HID Signo 20 or Signo 40

## **ADDENDUM NO. 2**

OCTOBER 03, 2024

### **NEW CANEY INDEPENDENT SCHOOL DISTRICT**

NEW CANEY ELEMENTARY SCHOOL

NEW CANEY, TEXAS

BRW Project No.: 223117.00

B. Revise paragraph 2.02.C "(By Division 08)" to read as, "(By Division 28)"

#### **2.27 SECTION 28 20 00 VIDEO SURVEILLANCE SYSTEM**

A. Reissue section in its entirety

#### **2.28 SECTION 28 31 00 INTRUSION DETECTION SYSTEM**

A. Reissue section in its entirety

#### **2.29 Section 31 32 13.26 LIME-FLY ASH OR FLY ASH STABILIZATION**

A. Add this section in its entirety.

### **DRAWINGS**

#### **2.30 SHEET G1.1 TITLE SHEET**

A. Replace rendering with updated image

#### **2.31 SHEET G1.2 MASTER KEYNOTE LIST**

A. Reissue sheet in its entirety

#### **2.32 SHEET G1.4 LIFE SAFETY PLAN**

A. Shift door in 100N IDF down 1 ft

#### **2.33 SHEET AS1.4 CANOPY PLANS AND DETAILS**

A. View 5 Canopy Plan – add light fixtures above all three entrances

#### **2.34 SHEET C6.0 UTILITY PLAN**

A. Reflected the revised underground electrical line routing received from MEP

B. Revised sanitary line to not be outside of transformer location near mechanical yard

C. Revised water line layout based on sanitary line adjustments at mechanical yard

D. Added two additional inlets per request of owner near playground areas

#### **2.35 SHEET C7.0 GRADING PLAN**

A. Added TR/TG elevations at proposed storm inlets and revised sanitary manhole locations

#### **2.36 SHEET S4.1 DRILLED PIER & PLINTH SCHEDULE & DETAILS**

A. Reissue sheet in its entirety.

#### **2.37 SHEET S4.5 TYPICAL SITE FOUNDATION DETAILS**

A. Reissue sheet in its entirety.

#### **2.38 SHEET A1.1 COMPOSITE PLAN**

A. Shift door in 100N IDF down 1 ft

#### **2.39 SHEET A1.1A FLOOR PLAN AREA A**

A. Shift door in 100N IDF down 1 ft

B. Add south-facing interior elevation to existing marker A5.3/16 in Room 100W

#### **2.40 SHEET A1.4 ROOF PLAN**

A. Reissue sheet in its entirety

#### **2.41 SHEET A1.5 ROOF DETAILS**

A. Reissue sheet in its entirety

#### **2.42 SHEET A4.1 DOOR SCHEDULE**

A. Update Door type of 118-1 through 118-4 to read as: A9

## **ADDENDUM NO. 2**

OCTOBER 03, 2024

### **NEW CANEY INDEPENDENT SCHOOL DISTRICT**

NEW CANEY ELEMENTARY SCHOOL

NEW CANEY, TEXAS

BRW Project No.: 223117.00

- B. Update Door type of 118-5 and 118-6 to read as: A8
- 2.43 SHEET A5.5 INTERIOR ELEVATIONS
  - A. View 4 Elevation
    - 1. Shift display cases up 1 ft from the ground for a total of 3ft from the finish floor
- 2.44 SHEET A5.7 INTERIOR ELEVATIONS
  - A. Reissue sheet in its entirety
- 2.45 SHEET A5.9 CASEWORK SECTIONS
  - A. Keynote Legend
    - 1. Remove keynotes: 0920.26, 1230.19, 1230.50, 1230.61, 1230.62, 1230.63, 1230.64, 1230.66, and 1230.72
    - 2. Add keynotes: 1010.59, 1010.60, and 1010.61
  - B. View 6 CSK "U300" – Reissue view in its entirety
  - C. View 7 CSK "U301" – Reissue view in its entirety
  - D. View 8 CSK "T700" Mail @ Wall – revise keynote 0640.71 to read as 1230.67
  - E. View 9 CSK Mailbox Detail – revise keynote 1230.68 to point to correct item
  - F. View 10 MISC Display Case Glass 1-Side – Reissue view in its entirety
  - G. View 11 MISC TLT counter-sink @ GYP – Remove view in its entirety
- 2.46 SHEET A6.1A REFLECTED CEILING PLAN AREA A
  - A. Reissue sheet in its entirety
- 2.47 SHEET A6.1B REFLECTED CEILING PLAN AREA B
  - A. Add light fixtures above entrances into 117 Cafe
  - B. Revise both projection screen keynotes in 117 CAFE "Ceiling-Mounted Projection Screen" to read as "Recessed Projection Screen"
- 2.48 SHEET A7.1 COMPOSITE FINISH PLAN
  - A. Finish Legend
    - 1. P-PAINT – add P8 PAINT (GYM CEILING), SHERWIN WILLIAMS, COLOR: FELTED WOOL SW9171
    - 2. RF – RESILIENT FLOORING – Revise RF7 Brand "Tarkeet" to read as "Tarkett"
    - 3. SF – SPORTS FLOORING – Revise "COLOR: MANDARIN 3278" to read as, "COLOR: GOLDEN MAPLE 26528002"
    - 4. T – TILE
      - a. Revise T7 (Field) "COLOR: CHALKBOARD 0180" to read as, "DESERT GRAY X114"
      - b. Revise T9 (Gray Accent) "COLOR: DESERT GRAY X114" to read as, "COLOR: CHALKBOARD 0180"
    - 5. WC – WALL COVERING
      - a. Add WC2 in its entirety
  - B. Composite Finish Plan
    - 1. Shift door in 100N IDF down 1 ft

## **ADDENDUM NO. 2**

OCTOBER 03, 2024

### **NEW CANEY INDEPENDENT SCHOOL DISTRICT**

NEW CANEY ELEMENTARY SCHOOL

NEW CANEY, TEXAS

BRW Project No.: 223117.00

2. 100K ISS – replace RF1 flooring with CPT1

#### **2.49 SHEET A7.1A FINISH PLAN AREA A**

##### **A. Finish Legend**

1. P-PAINT – add P8 PAINT (GYM CEILING), SHERWIN WILLIAMS, COLOR: FELTED WOOL SW9171
2. RF – RESILIENT FLOORING – Revise RF7 Brand “Tarkeet” to read as “Tarkett”
3. SF – SPORTS FLOORING – Revise “COLOR: MANDARIN 3278” to read as, “COLOR: GOLDEN MAPLE 26528002”
4. T – TILE
  - a. Revise T7 (Field) “COLOR: CHALKBOARD 0180” to read as, “DESERT GRAY X114”
  - b. Revise T9 (Gray Accent) “COLOR: DESERT GRAY X114” to read as, “COLOR: CHALKBOARD 0180”
5. WC – WALL COVERING
  - a. Add WC2 in its entirety

##### **B. Finish Plan Area A**

1. Shift door in 100N IDF down 1 ft
2. 100K ISS – replace RF1 flooring with CPT1
3. Room Tag 108 Gym – revise ceiling finish “P1” to read as, “P8”
4. Room Tag 301 LIP Classroom – revise wall finish “P1” to read as, “WC2”

#### **2.50 SHEET 7.1B FINISH PLAN AREA B**

##### **A. Finish Legend**

1. P-PAINT – add P8 PAINT (GYM CEILING), SHERWIN WILLIAMS, COLOR: FELTED WOOL SW9171
2. RF – RESILIENT FLOORING – Revise RF7 Brand “Tarkeet” to read as “Tarkett”
3. SF – SPORTS FLOORING – Revise “COLOR: MANDARIN 3278” to read as, “COLOR: GOLDEN MAPLE 26528002”
4. T – TILE
  - a. Revise T7 (Field) “COLOR: CHALKBOARD 0180” to read as, “DESERT GRAY X114”
  - b. Revise T9 (Gray Accent) “COLOR: DESERT GRAY X114” to read as, “COLOR: CHALKBOARD 0180”
5. WC – WALL COVERING
  - a. Add WC2 in its entirety

#### **2.51 SHEET 7.1C FINISH PLAN AREA C**

##### **A. Finish Legend**

1. P-PAINT – add P8 PAINT (GYM CEILING), SHERWIN WILLIAMS, COLOR: FELTED WOOL SW9171
2. RF – RESILIENT FLOORING – Revise RF7 Brand “Tarkeet” to read as “Tarkett”

## **ADDENDUM NO. 2**

OCTOBER 03, 2024

### **NEW CANEY INDEPENDENT SCHOOL DISTRICT**

NEW CANEY ELEMENTARY SCHOOL

NEW CANEY, TEXAS

BRW Project No.: 223117.00

3. SF – SPORTS FLOORING – Revise “COLOR: MANDARIN 3278” to read as, “COLOR: GOLDEN MAPLE 26528002”
4. T – TILE
  - a. Revise T7 (Field) “COLOR: CHALKBOARD 0180” to read as, “DESERT GRAY X114”
  - b. Revise T9 (Gray Accent) “COLOR: DESERT GRAY X114” to read as, “COLOR: CHALKBOARD 0180”
5. WC – WALL COVERING
  - a. Add WC2 in its entirety

#### **2.52 SHEET 7.1D FINISH PLAN AREA D**

##### **A. Finish Legend**

1. P-PAINT – add P8 PAINT (GYM CEILING), SHERWIN WILLIAMS, COLOR: FELTED WOOL SW9171
2. RF – RESILIENT FLOORING – Revise RF7 Brand “Tarkeet” to read as “Tarkett”
3. SF – SPORTS FLOORING – Revise “COLOR: MANDARIN 3278” to read as, “COLOR: GOLDEN MAPLE 26528002”
4. T – TILE
  - a. Revise T7 (Field) “COLOR: CHALKBOARD 0180” to read as, “DESERT GRAY X114”
  - b. Revise T9 (Gray Accent) “COLOR: DESERT GRAY X114” to read as, “COLOR: CHALKBOARD 0180”
5. WC – WALL COVERING
  - a. Add WC2 in its entirety

##### **B. Finish Plan Area D**

1. Room Tag 305 LIP Classroom – revise wall finish “P1” to read as, “WC2”
2. Room Tag 315 SPEC ED Classroom – revise wall finish “P1” to read as, “WC2”, and remove ceiling finish “WC1”
3. Room Tag 317 SPEC ED Classroom – revise wall finish “P1” to read as, “WC2”

#### **2.53 SHEET A7.1E FINISH PLAN AREA E**

##### **A. Finish Legend**

1. P-PAINT – add P8 PAINT (GYM CEILING), SHERWIN WILLIAMS, COLOR: FELTED WOOL SW9171
2. RF – RESILIENT FLOORING – Revise RF7 Brand “Tarkeet” to read as “Tarkett”
3. SF – SPORTS FLOORING – Revise “COLOR: MANDARIN 3278” to read as, “COLOR: GOLDEN MAPLE 26528002”
4. T – TILE
  - a. Revise T7 (Field) “COLOR: CHALKBOARD 0180” to read as, “DESERT GRAY X114”

## ADDENDUM NO. 2

OCTOBER 03, 2024

### NEW CANEY INDEPENDENT SCHOOL DISTRICT

NEW CANEY ELEMENTARY SCHOOL

NEW CANEY, TEXAS

BRW Project No.: 223117.00

- b. Revise T9 (Gray Accent) "COLOR: DESERT GRAY X114" to read as, "COLOR: CHALKBOARD 0180"
- 5. WC – WALL COVERING
  - a. Add WC2 in its entirety
- 2.54 SHEET M2.1A MECHANICAL PLAN AREA A
  - A. Clarification: shifted AC-1 to be centered above the IDF room door.
- 2.55 SHEET P2.1B PLUMBING PLAN AREA B
  - A. Added keynote P8.7 to room 302A
- 2.56 SHEET P2.1C PLUMBING PLAN AREA C
  - A. All Pre-K and Kindergarten classroom sinks with designation tag SK-1 between CORR 360 and CORR 363 shall be an SK-4 with bubbler as described in the plumbing fixture schedule.
- 2.57 SHEET P2.1D PLUMBING PLAN AREA D
  - A. In SCIENCE CLASSROOM 230 plan north SK-8 designation tag shall switch with plan south SK-1 for ADA sink location.
  - B. In SCIENCE CLASSROOM 243 plan north SK-8 designation tag shall switch with plan south SK-1 for ADA sink location.
  - C. In SCIENCE PREP 228 plan north sink shall have designation tag SK-1 in lieu of SK-8 for ADA sink purposes.
  - D. In SCIENCE CLASSROOM 235, the sink closest to CORR 264 shall be SK-1 in lieu of SK-8 for ADA sink purposes.
- 2.58 SHEET E0.2 ELECTRICAL GENERAL NOTES
  - A. Added general note "J" to the fire alarm general notes to read as:  
*"CONTRACTOR SHALL ADD TEST SWITCH AT SWITCH HEIGHT ON WALL FOR EACH DUCT SMOKE DETECTOR. TYPICAL OF ALL DUCT SMOKE DETECTORS IN MECHANICAL ROOMS."*
- 2.59 SHEET E1.1 ELECTRICAL SITE PLAN
  - A. Revised service power routing.
  - B. Added power for exterior fan receptacles.
  - C. Added keyed note E4.16 and associated tags.
  - D. Removed keyed note E7.5 and associated tags.
  - E. Revised keyed notes E7.2, E7.27, and E7.28
- 2.60 SHEET E5.1 ELECTRICAL SCHEDULES
  - A. Added lighting contractor schedule
- 2.61 SHEET E5.2 ELECTRICAL PANEL SCHEDULES
  - A. Added circuit to panel 1LA1-18.
  - B. Added circuit to panel 1LA1-20.
  - C. Added circuit to panel 1LA1-29.
  - D. Added circuit to panel 1LA1-30.

## **ADDENDUM NO. 2**

OCTOBER 03, 2024

### **NEW CANEY INDEPENDENT SCHOOL DISTRICT**

NEW CANEY ELEMENTARY SCHOOL

NEW CANEY, TEXAS

BRW Project No.: 223117.00

- E. Added circuit to panel 1LA1-31.
- F. Added circuit to panel 1LA1-33.
- G. Added circuit to panel 1LB1-35.
- H. Added circuit to panel 1LB1-37.
- I. Added circuit to panel 1LB1-39.
- J. Added circuit to panel 1LB1-41.
- K. Added circuit to panel 1LB1-63.
- 2.62 SHEET E5.3 ELECTRICAL PANEL SCHEDULES
  - A. Added circuit to panel 1LC1-60.
- 2.63 SHEET EL2.1A ELECTRICAL LIGHTING AND SPECIAL SYSTEMS PLAN AREA A
  - A. Added voice evac mic adjacent to the annunciator panel.
  - B. Removed smoke detectors.
  - C. Added switches for exterior fan receptacles.
  - D. Added keyed note E10.12, and E10.13 and associated tags
- 2.64 SHEET EL2.1B ELECTRICAL LIGHTING AND SPECIAL SYSTEMS PLAN AREA B
  - A. Removed smoke detectors
- 2.65 SHEET EL2.1C ELECTRICAL LIGHTING AND SPECIAL SYSTEMS PLAN AREA C
  - A. Removed smoke detectors.
  - B. Added smoke detectors.
- 2.66 SHEET EL2.1D ELECTRICAL LIGHTING AND SPECIAL SYSTEMS PLAN AREA D
  - A. Added voice evac mic adjacent to the annunciator panel.
  - B. Removed smoke detectors.
  - C. Added smoke detectors.
  - D. Added keyed note FA1.2 and associated tags.
- 2.67 SHEET EL2.1E ELECTRICAL LIGHTING AND SPECIAL SYSTEMS PLAN AREA E
  - A. Removed smoke detectors.
- 2.68 SHEET EP2.1B ELECTRICAL POWER PLAN AREA B
  - A. Added power for local sounds speakers.
  - B. Added keyed note E5.19 and associated tags.
- 2.69 SHEET T0.1 TECHNOLOGY SYMBOL LEGEND
  - A. Updated wording from Cat6 to Cat6A for Cameras and Access Points.
  - B. Added symbol for Sounder Strobe
  - C. Revised Audio Video Legend
  - D. Edited Communication legend
  - E. Added Intercommunication System to responsibility matrix.
- 2.70 SHEET T1.1 TECHNOLOGY SITE PLAN
  - A. Moved pull boxes closer in to building.
  - B. Updated Keynotes
  - C. Added general site plan notes.

## **ADDENDUM NO. 2**

OCTOBER 03, 2024

### **NEW CANEY INDEPENDENT SCHOOL DISTRICT**

NEW CANEY ELEMENTARY SCHOOL

NEW CANEY, TEXAS

BRW Project No.: 223117.00

- 2.71 SHEET T2.1A TECHNOLOGY PLAN AREA A
  - A. Reissue sheet in its entirety
- 2.72 SHEET T2.1B TECHNOLOGY PLAN AREA B
  - A. Reissue sheet in its entirety
- 2.73 SHEET T2.1C TECHNOLOGY PLAN AREA C
  - A. Reissue sheet in its entirety
- 2.74 SHEET T2.1D TECHNOLOGY PLAN AREA D
  - A. Reissue sheet in its entirety
- 2.75 SHEET T2.1E TECHNOLOGY PLAN AREA E
  - A. Reissue sheet in its entirety
- 2.76 SHEET T3.1 TECHNOLOGY ENLARGED
  - A. Revised view titles.
  - B. Rearranged IDF 1 layout.
- 2.77 SHEET T6.1 TECHNOLOGY DETAILS
  - A. Deleted detail 1
  - B. Revised detail 4
- 2.78 SHEET T6.3 SECURITY DETAIL
  - A. Revised details 5 and 6
- 2.79 SHEET T6.4 SECURITY DETAIL
  - A. Revised details 1 and 2



# MEETING SIGN-IN SHEET

Date: 9/25/2024 Time: 9:30 a.m.

Project:

NCISD – New Caney Elementary School No.12

Project No: 22311700

# BRW ARCHITECTS

**FOCUSED ON WHAT MATTERS.**

	NAME	INITIALS	COMPANY	PHONE	E-MAIL
1	Richard Ressler	✓	New Caney ISD	(281) 577-8628	ressler@newcaneyisd.org
2	Mark Smith		New Caney ISD		msmith5@newcaneyisd.org
3	T. M. Stewart	✓	New Caney ISD		tstewart@newcaneyisd.org
4	Isai Lemus (Jesse)	HL	New Caney ISD		ilemus@newcaneyisd.org
5	Tanci Foster	TF	New Caney ISD		tfoster@newcaneyisd.org
6	Jeffrey Choyce	JX	BRW Architects	(281) 361-3800	jchoyce@brwarch.com
7	Adriana Haces	AH	BRW Architects	(281) 361-3800	ahaces@brwarch.com
8	Molly Rall	MR	BRW Architects	(281) 361- 3800	mrall@brwarch.com
9	Jeff Schafer	JS	ICI Construction	281 355 5151	bids@iciconstructioninc.com
10	Roland Parker	RP	Prime Contractors	281-999-0875	estimating@primecontractorsinc.com
11	Pete Greigear	PG	GTT Const	832-728-8499	estimating@GTTConstruction.com
12	Tad Bourgeois	TB	Crain Group	214-701-3690	bids@craingroup.com
13	Nestor Gonzalez	N.G	C.A. Walker	713-956-7070	bids@cawalker.net
14	Brandon Watson	BW	DivisionOne Construction	713-688-7330	bid@d1construction.com
15	Carlos Garza	CG	SEDALCO	713-205-3724	cgarza@sedaco.com
16	Fredy Amador	FA	Amador Builders	281-7292231	amadorbuildersllc@gmail.com
17					
18					
19					
20					

September 26, 2024  
Project No. 701551002

Mr. Richard Ressler  
New Caney Independent School District (NCISD)  
22784 US Highway 59, Building E  
Porter, Texas 77365

Subject: Summary of Building Pad Preparation Recommendations  
Tavola West Elementary School  
Highway 59 and Future Via Corsica Drive  
New Caney, Texas

Dear Mr. Ressler:

As you know, Ninyo & Moore performed a geotechnical study for the referenced project and presented our findings in our report "Geotechnical Evaluation, Tavola West Elementary School, Highway 59 and Future Via Corsica Drive, New Caney, Texas", dated July 27, 2023. NCISD has requested us to summarize our recommendations for preparation of the building pad. Based on emails from the design team, we understand that finished grade will be about 2 feet above existing grade.

As stated in our report, there are two conditions that must be addressed in preparing the building pad. The existing potential vertical rise (PVR) must be reduced to 1-inch. As such, our report recommends the building pad consist of 3½ feet of select fill extending 5 feet beyond the building footprint. In addition, existing undocumented fill soils, encountered to up to 2 feet below grade in portions of the building footprint, must be remediated.

We recommend the following pad preparation procedure be followed:

- About 1½ feet of existing soils should be excavated from the building footprint and extending 5 feet or more beyond the building footprint;
- To remediate undocumented fill remaining in the proposed building area, the bottom of the excavation be scarified to a depth of 8 inches, and then moisture conditioned and recompacted as per our report.
- 3½ feet of select, engineered fill (as defined our report) should be placed in lifts per our report to finished pad elevation.

We appreciate the opportunity to be of continuing service to you during this phase of the project.

Sincerely,  
**NINYO & MOORE**  
TBPE Firm No. F-9782



**Richard J. Whitt, PE**  
Senior Engineer

RJW/JTS/tah



9/26/2024

## **SECTION 03 30 00 - CAST-IN-PLACE CONCRETE**

---

### **PART 1 - GENERAL**

#### **1.01 RELATED DOCUMENTS**

- A. Drawings and general provisions of the Contract, including Division 01 General Requirements and NCISD Procurement and Contracting Requirements, apply to this Section.

#### **1.02 SUMMARY**

- A. Section includes cast-in-place concrete, including formwork, reinforcement, concrete materials, mixture design, placement procedures, and finishes, for the following:
  - 1. Footings.
  - 2. Foundation walls.
  - 3. Slabs-on-grade.
  - 4. Suspended slabs.
  - 5. Concrete toppings.
  - 6. Building frame members.
  - 7. Building walls.
- B. Related Sections:
  - 1. Section 01 45 23 "Structural Testing and Inspection Services".
  - 2. Section 03 20 00 "Concrete Forming and Accessories".
  - 3. Section 03 10 00 "Concrete Reinforcing".
  - 4. Section 03 15 13 "Waterstops".
  - 5. Section 03 05 80 "Under-slab Vapor Barrier – Retarder".
  - 6. Section 31 63 29 "Drilled Concrete Piers and Shafts".

#### **1.03 REFERENCES**

- A. The latest adopted edition of all standards referenced in this section shall apply, unless noted otherwise.
  - 1. ACI 301 – Specification for Structural Concrete.
  - 2. ACI 302 – Guide for Concrete Floor Slab Construction.
  - 3. ACI 304 – Guide for Measuring, Mixing, Transporting and Placing Concrete.
  - 4. ACI 305 – Hot Weather Concreting.
  - 5. ACI 306 – Cold Weather Concreting.
  - 6. ACI 308 – Guide to Curing Concrete.
  - 7. ACI 309 – Guide for Consolidating Concrete.
  - 8. ACI 311 – ACI Manual for Concrete Inspection.
  - 9. ACI 318 – Building Code Requirements for Reinforced Concrete.
  - 10. ACI 347 – Guide to Concrete Formwork.
  - 11. ACI 207 – Mass Concrete.
  - 12. ACI 211.1 – Standard Practice for Selecting Proportions for Normal, Heavyweight, and Mass Concrete.
  - 13. ACI 211.2 – Standard Practice for Selecting Proportions for Structural Lightweight Concrete.
  - 14. ACI 212.3 – Chemical Admixture for Concrete.
  - 15. ACI 212.4 – Guide for the use of High Range Water Reducing Admixtures in Concrete.
  - 16. ACI 214 – Evaluation of Strength Test Results of Concrete.
  - 17. ACI 303 – Guide to Cast in Place Architectural Concrete Practice.
  - 18. Concrete Reinforcing Steel Institute, "Manual of Standard Practice".

- B. In the case of conflict between the Contract Documents and a referenced standard, the Contract Documents shall govern. In the case of a conflict between the Contract Documents and the Building Code, the more stringent shall govern.

#### **1.04 DEFINITIONS**

- A. Cementitious Materials: Portland cement alone or in combination with one or more of the following: blended hydraulic cement, fly ash and other pozzolans, ground granulated blast-furnace slag, and silica fume; subject to compliance with requirements.

#### **1.05 ACTION SUBMITTALS**

- A. Product Data: For each type of product indicated.
- B. Design Mixtures: For each concrete mixture include the following information. Submit alternate design mixtures when characteristics of materials, Project conditions, weather, test results, or other circumstances warrant adjustments.
  - 1. Each proposed mix design shall be accompanied by a complete standard deviation analysis based on at least 30 consecutive strength tests, or by three laboratory trial mixtures with confirmation tests.
  - 2. Proportions of cement, fine, and coarse aggregate, and water.
  - 3. Design strength.
  - 4. Maximum slump.
  - 5. Air Content.
  - 6. Maximum water / cement ratio.
  - 7. Maximum and minimum concrete temperature that is acceptable at time of placement for which the manufacturer can guarantee the strength of the concrete.
  - 8. Type cement and aggregates.
  - 9. Type and quantities of all admixtures.
  - 10. Air dry density and splitting tensile strength for lightweight concrete determined in accordance with ASTM 330.
  - 11. Type, color, and quantities of integral coloring compounds, where applicable.
  - 12. Indicate amounts of mixing water to be withheld for later addition at Project site.
- C. Steel Reinforcement Shop Drawings: Refer Section 03 20 00.
- D. Formwork Shop Drawings: Refer Section 03 10 00.
- E. Provide Mockup 2'-0" x 2'-0" for concrete finishes.
- F. Construction Joint Layout: Indicate proposed construction joints required to construct the structure.
  - 1. Location of construction joints is subject to approval of the Architect.

#### **1.06 INFORMATIONAL SUBMITTALS**

- A. Qualification Data: For Installer and manufacturer.
- B. Welding certificates.
- C. Material Certificates: For each of the following, signed by manufacturers:
  - 1. Cementitious materials.
  - 2. Admixtures.
  - 3. Fiber reinforcement.
  - 4. Curing compounds.
  - 5. Floor and slab treatments.
  - 6. Bonding agents.
  - 7. Adhesives.
  - 8. Semi rigid joint filler.

- 9. Joint-filler strips.
- 10. Repair materials.
- D. Material Test Reports: For the following, from a qualified testing agency, indicating compliance with requirements:
  - 1. Aggregates. Include service record data indicating absence of deleterious expansion of concrete due to alkali aggregate reactivity.
- E. Floor surface flatness and levelness measurements indicating compliance with specified tolerances.
- F. Field quality-control reports.
- G. Minutes of preinstallation conference.

## **1.07 QUALITY ASSURANCE**

- A. Installer Qualifications: A qualified installer who employs on Project personnel qualified as ACI-certified Flatwork Technician and Finisher and a supervisor who is an ACI-certified Concrete Flatwork Technician.
- B. Manufacturer Qualifications: A firm experienced in manufacturing ready-mixed concrete products and that complies with ASTM C 94 requirements for production facilities and equipment.
  - 1. Manufacturer certified according to NRMCA's "Certification of Ready Mixed Concrete Production Facilities."
- C. Testing Agency Qualifications: See Section 01 45 23.
  - 1. Contractor's responsibility to testing laboratory.
    - a. Furnish all labor and materials as required to assist testing agency in obtaining, making and handling samples at the jobsite.
    - b. Advise the Owner's Testing Laboratory sufficiently in advance of operations to allow adequate time for the assignment of testing personnel.
    - c. Furnish and maintain adequate facilities for proper curing of concrete test specimens on the project site in accordance with ASTM C31.
- D. Source Limitations: Obtain each type or class of cementitious material of the same brand from the same manufacturer's plant, obtain aggregate from single source, and obtain admixtures from single source from single manufacturer.
- E. Welding Qualifications: Qualify procedures and personnel according to AWS D1.4, "Structural Welding Code - Reinforcing Steel."
- F. ACI Publications: Comply with the following unless modified by requirements in the Contract Documents:
  - 1. ACI 301, "Specifications for Structural Concrete."
  - 2. ACI 117, "Specifications for Tolerances for Concrete Construction and Materials."
- G. Mockups: Cast concrete slab-on-grade and formed-surface panels to demonstrate typical joints, surface finish, texture, tolerances, floor treatments, and standard of workmanship.
  - 1. Build panel approximately 200 sq. ft. for slab-on-grade and 100 sq. ft. for formed surface in the location indicated or, if not indicated, as directed by Architect.
- H. Preinstallation Conference: Conduct conference at Project site.
  - 1. Before submitting design mixtures, review concrete design mixture and examine procedures for ensuring quality of concrete materials. Require representatives of each entity directly concerned with cast-in-place concrete to attend, including the following:
    - a. Contractor's superintendent.
    - b. Independent testing agency responsible for concrete design mixtures.
    - c. Ready-mix concrete manufacturer.

- d. Concrete subcontractor.

## **1.08 DELIVERY, STORAGE, AND HANDLING**

- A. Steel Reinforcement: Deliver, store, and handle steel reinforcement to prevent bending and damage. Avoid damaging coatings, if any, on steel reinforcement.
- B. Waterstops: Store waterstops under cover to protect from moisture, sunlight, dirt, oil, and other contaminants.

## **PART 2 - PRODUCTS**

### **2.01 FORM-FACING MATERIALS**

- A. See Section 03 10 00.

### **2.02 STEEL REINFORCEMENT**

- A. See Section 03 20 00.

### **2.03 REINFORCEMENT ACCESSORIES**

- A. See Section 03 20 00.

### **2.04 CONCRETE MATERIALS**

- A. Cementitious Material: Use the following cementitious materials, of the same type, brand, and source, throughout Project:
  - 1. Portland Cement: ASTM C 150, Type I or Type I/II, gray. Supplement with the following
    - a. Fly Ash: ASTM C 618, Class F or C. Carbon content shall not exceed 3 percent by volume.
    - b. Ground Granulated Blast-Furnace Slag: ASTM C 989, Grade 100 or 120.
- B. Normal-Weight Aggregates: ASTM C 33, coarse aggregate or better, graded. Provide aggregates from a single source with documented service record data of at least 10 years of satisfactory service in similar applications and service conditions using similar aggregates and cementitious materials.
  - 1. Maximum Coarse-Aggregate Size: 1-1/2 inches, 1 inch, or 3/4 inch nominal as indicated on Drawings for specific uses.
  - 2. Fine Aggregate: Free of materials with deleterious reactivity to alkali in cement.
- C. Lightweight Aggregate: ASTM C 330, 3/4-inch nominal maximum aggregate size.
- D. Water: ASTM C 94 and potable.

### **2.05 ADMIXTURES**

- A. Air-Entraining Admixture: ASTM C 260.
- B. Chemical Admixtures: Provide admixtures certified by manufacturer to be compatible with other admixtures and that contain not more than 0.05 percent water soluble chloride ions. Do not use calcium chloride or admixtures containing calcium chloride.
  - 1. Water-Reducing Admixture: ASTM C 494, Type A.
  - 2. Retarding Admixture: ASTM C 494, Type B.
  - 3. Water-Reducing and Retarding Admixture: ASTM C 494, Type D.
  - 4. High-Range, Water-Reducing Admixture: ASTM C 494, Type F.
  - 5. High-Range, Water-Reducing and Retarding Admixture: ASTM C 494, Type G.
  - 6. Plasticizing and Retarding Admixture: ASTM C 1017, Type II.
- C. Color Pigment: ASTM C 979, synthetic mineral-oxide pigments or colored water-reducing admixtures; color stable, free of carbon black, nonfading, and resistant to lime and other alkalis.

1. Manufacturers: Subject to compliance with requirements, provide products by one of the following:
  - a. ChemMasters.
  - b. Davis Colors.
  - c. Dayton Superior Corporation.
  - d. Hoover Color Corporation.
  - e. Lambert Corporation.
  - f. QC Construction Products.
  - g. Rockwood Pigments NA, Inc.
  - h. Scofield, L. M. Company.
  - i. Solomon Colors, Inc.
2. Color: As selected by Architect from manufacturer's full range.

## **2.06 CONCRETE MIX DESIGNS**

- A. Selection of Proportions: Proportions of ingredients for concrete mixes shall be determined by a qualified concrete supplier in accordance with the requirements of ACI 301.
- B. Required average strength above specified strength: Determination of required average strength above specified strength shall be based on the standard deviation record of the production facility in accordance with ACI 301. Calculation of standard deviation of compressive strength results shall be made in accordance with ACI 214. If a suitable record of strength tests is not available, proportions shall be selected on the basis of laboratory trial batches to produce an average strength greater than the strength  $f'_c$  by the amount defined in ACI 301.

## **2.07 VAPOR RETARDERS**

- A. See Section 03 05 80

## **2.08 FLOOR AND SLAB TREATMENTS**

- A. Removed

## **2.09 LIQUID FLOOR TREATMENTS**

- A. VOC Content: Liquid floor treatments shall have a VOC content of 200 g/L or less when calculated according to 40 CFR 59, Subpart D (EPA Method 24).
- B. Penetrating Liquid Floor Treatment: Clear, chemically reactive, waterborne solution of inorganic silicate or silicate materials and proprietary components; odorless; that penetrates, hardens, and densifies concrete surfaces.
  1. Products: Subject to compliance with requirements.
- C. Penetrating Liquid Floor Treatments for Polished Concrete Finish: Clear, waterborne solution of inorganic silicate or silicate materials and proprietary components; odorless; that penetrates, hardens, and is suitable for polished concrete surfaces.
  1. Products: Subject to compliance with requirements, provide one of the following:
    - a. Advanced Floor Products; Retro-Plate 99.
    - b. L&M Construction Chemicals, Inc.; FGS Hardener Plus.
    - c. QuestMark, a division of CentiMark Corporation; DiamondQuest Densifying Impregnator Application.

## **2.10 RELATED MATERIALS**

- A. Expansion and Isolation Joint Filler Strips: ASTM D 1751, asphalt-saturated cellulosic fiber or ASTM D 1752, cork or self-expanding cork.



- B. Semi-rigid Joint Filler: Two-component, semi-rigid, 100 percent solids, epoxy resin with a Type A shore durometer hardness of 80 per ASTM D 2240.
- C. Bonding Agent: ASTM C 1059, Type II, non-redispersible, acrylic emulsion or styrene butadiene.
- D. Epoxy Bonding Adhesive: ASTM C 881, two-component epoxy resin, capable of humid curing and bonding to damp surfaces, of class suitable for application temperature and of grade to suit requirements, and as follows:
  - 1. Types IV and V, load bearing, for bonding hardened or freshly mixed concrete to hardened concrete.
- E. Dovetail Anchor Slots: Hot-dip galvanized-steel sheet, not less than 0.034 inch thick, with bent tab anchors. Temporarily fill or cover face opening of slots to prevent intrusion of concrete or debris.

## **2.11 REPAIR MATERIALS**

- A. Repair Underlayment: Cement-based, polymer-modified, self-leveling product that can be applied in thicknesses from 1/8 inch and that can be feathered at edges to match adjacent floor elevations.
  - 1. Cement Binder: ASTM C 150, Portland cement or hydraulic or blended hydraulic cement as defined in ASTM C 219.
  - 2. Primer: Product of underlayment manufacturer recommended for substrate, conditions, and application.
  - 3. Aggregate: Well-graded, washed gravel, 1/8 to 1/4 inch or coarse sand as recommended by underlayment manufacturer.
  - 4. Compressive Strength: Not less than 4100 psi at 28 days when tested according to ASTM C 109.
- B. Repair Overlayment: Cement-based, polymer-modified, self-leveling product that can be applied in thicknesses from 1/4 inch and that can be filled in over a scarified surface to match adjacent floor elevations.
  - 1. Cement Binder: ASTM C 150, Portland cement or hydraulic or blended hydraulic cement as defined in ASTM C 219.
  - 2. Primer: Product of topping manufacturer recommended for substrate, conditions, and application.
  - 3. Aggregate: Well-graded, washed gravel, 1/8 to 1/4 inch or coarse sand as recommended by topping manufacturer.
  - 4. Compressive Strength: Not less than 5000 psi at 28 days when tested according to ASTM C 109.

## **2.12 CONCRETE MIXTURES, GENERAL**

- A. Prepare design mixtures for each type and strength of concrete, proportioned on the basis of laboratory trial mixture or field test data, or both, according to ACI 301.
  - 1. Use a qualified independent testing agency for preparing and reporting proposed mixture designs based on laboratory trial mixtures.
- B. Cementitious Materials: Use fly ash, pozzolan, ground granulated blast-furnace slag, and silica fume as needed to reduce the total amount of Portland cement, which would otherwise be used, as indicated in Structural General Notes.
- C. Limit water-soluble, chloride-ion content in hardened concrete to 0.06 percent by weight of cement.
- D. Admixtures: Use admixtures according to manufacturer's written instructions.

1. Use water-reducing, high-range water-reducing, or plasticizing admixture in concrete, as required, for placement and workability.
  2. Use water-reducing and retarding admixture when required by high temperatures, low humidity, or other adverse placement conditions.
  3. Use water-reducing admixture in pumped concrete, concrete for heavy-use industrial slabs and parking structure slabs, concrete required to be watertight, and concrete with a water-cementitious materials ratio below 0.50.
  4. Use corrosion-inhibiting admixture in concrete mixtures where indicated.
- E. Color Pigment: Add color pigment to concrete mixture according to manufacturer's written instructions and to result in hardened concrete color consistent with approved mockup.

## **2.13 NON-SHRINK GROUT**

- A. Grout shall be prepackaged, non metallic, and non gaseous. It shall be non-shrink when tested in accordance with ASTM-C1107 Grade B or C at a fluid consistency (flow cone) of 20 to 30 seconds. Thirty-minute-old grout shall flow through the flow cone after slight agitation, in temperatures of 40 degrees to 90 degrees Fahrenheit. Grout shall be bleed free and attain 7,500 psi compressive strength in 28 days at fluid consistency. Certified independent test data required. Approved products include the following:
1. "Euco NS" by Euclid Chemical Company
  2. "Masterflow 713" by Master Builders.

## **2.14 CONCRETE MIXTURES FOR BUILDING ELEMENTS**

- A. Proportion normal-weight concrete mixture as indicated in Structural General Notes:

## **2.15 FABRICATING REINFORCEMENT**

- A. Fabricate steel reinforcement according to CRSI's "Manual of Standard Practice."

## **2.16 CONCRETE MIXING**

- A. Ready-Mixed Concrete: Measure, batch, mix, and deliver concrete according to ASTM C 94 and ASTM C 1116, and furnish batch ticket information.
1. When air temperature is between 85 and 90 deg F, reduce mixing and delivery time from 1-1/2 hours to 75 minutes; when air temperature is above 90 deg F, reduce mixing and delivery time to 60 minutes.

# **PART 3 - EXECUTION**

## **3.01 FORMWORK**

- A. See Section 03 10 00.

## **3.02 EMBEDDED ITEMS**

- A. Place and secure anchorage devices and other embedded items required for adjoining work that is attached to or supported by cast-in-place concrete. Use setting drawings, templates, diagrams, instructions, and directions furnished with items to be embedded.
1. Install anchor rods, accurately located, to elevations required and complying with tolerances in Section 7.5 of AISC's "Code of Standard Practice for Steel Buildings and Bridges."
  2. Install dovetail anchor slots in concrete structures as indicated.

## **3.03 REMOVING AND REUSING FORMS**

- A. See Section 03 10 00.

### **3.04 SHORES AND RESHORES**

A. See Section 03 10 00.

### **3.05 VAPOR RETARDERS/BARRIERS**

A. See Section 03 05 80.

### **3.06 STEEL REINFORCEMENT**

A. See Section 03 20 00

### **3.07 JOINTS**

- A. General: Construct joints true to line with faces perpendicular to surface plane of concrete.
- B. Construction Joints: Install so strength and appearance of concrete are not impaired, at locations indicated or as approved by Architect.
  - 1. Place joints perpendicular to main reinforcement. Continue reinforcement across construction joints unless otherwise indicated. Do not continue reinforcement through sides of strip placements of floors and slabs.
  - 2. Form keyed joints as indicated. Embed keys at least 1-1/2 inches into concrete.
  - 3. Locate joints for beams, slabs, joists, and girders in the middle third of spans. Offset joints in girders a minimum distance of twice the beam width from a beam-girder intersection.
  - 4. Locate horizontal joints in walls and columns at underside of floors, slabs, beams, and girders and at the top of footings or floor slabs.
  - 5. Space vertical joints in walls as indicated. Locate joints beside piers integral with walls, near corners, and in concealed locations where possible.
  - 6. Use a bonding agent at locations where fresh concrete is placed against hardened or partially hardened concrete surfaces.
  - 7. Use epoxy-bonding adhesive at locations where fresh concrete is placed against hardened or partially hardened concrete surfaces.
- C. Contraction Joints in Slabs-on-Grade: Form weakened-plane contraction joints, sectioning concrete into areas as indicated. Construct contraction joints for a depth equal to at least one-fourth of concrete thickness as follows:
  - 1. Grooved Joints: Form contraction joints after initial floating by grooving and finishing each edge of joint to a radius of 1/8 inch. Repeat grooving of contraction joints after applying surface finishes. Eliminate groover tool marks on concrete surfaces.
  - 2. Sawed Joints: Form contraction joints with power saws equipped with shatterproof abrasive or diamond-rimmed blades. Cut 1/8-inch wide joints into concrete when cutting action will not tear, abrade, or otherwise damage surface and before concrete develops random contraction cracks.
- D. Isolation Joints in Slabs-on-Grade: After removing formwork, install joint-filler strips at slab junctions with vertical surfaces, such as column pedestals, foundation walls, grade beams, and other locations, as indicated.
  - 1. Extend joint-filler strips full width and depth of joint, terminating flush with finished concrete surface unless otherwise indicated.
  - 2. Terminate full-width joint-filler strips not less than 1/2 inch or more than 1 inch below finished concrete surface where joint sealants are specified or otherwise indicated.
  - 3. Install joint-filler strips in lengths as long as practicable. Where more than one length is required, lace or clip sections together.
- E. Doweled Joints: Install dowel bars and support assemblies at joints where indicated. Lubricate or asphalt coat one-half of dowel length to prevent concrete bonding to one side of joint.

### **3.08 CONCRETE PLACEMENT**

- A. Before placing concrete, verify that installation of formwork, reinforcement, and embedded items is complete and that required inspections have been performed.
- B. Do not add water to concrete during delivery, at Project site, or during placement unless approved by Architect.
- C. Before test sampling and placing concrete, water may be added at Project site, subject to limitations of ACI 301.
  - 1. Do not add water to concrete after adding high-range water-reducing admixtures to mixture.
- D. Deposit concrete continuously in one layer or in horizontal layers of such thickness that no new concrete will be placed on concrete that has hardened enough to cause seams or planes of weakness. If a section cannot be placed continuously, provide construction joints as indicated. Deposit concrete to avoid segregation.
  - 1. Deposit concrete in horizontal layers of depth to not exceed formwork design pressures and in a manner to avoid inclined construction joints.
  - 2. Consolidate placed concrete with mechanical vibrating equipment according to ACI 301.
  - 3. Do not use vibrators to transport concrete inside forms. Insert and withdraw vibrators vertically at uniformly spaced locations to rapidly penetrate placed layer and at least 6 inches into preceding layer. Do not insert vibrators into lower layers of concrete that have begun to lose plasticity. At each insertion, limit duration of vibration to time necessary to consolidate concrete and complete embedment of reinforcement and other embedded items without causing mixture constituents to segregate.
- E. Do not permit concrete to drop freely any distance greater than 10'-0" for concrete containing a high range water reducing admixture or 5'-0" for other concrete. Provide chute or tremie to place concrete where longer drops are necessary. Do not place concrete into excavations with standing water. If place of deposit cannot be pumped dry, pour concrete through a tremie with its outlet near the bottom of the place of deposit.
- F. Deposit and consolidate concrete for floors and slabs in a continuous operation, within limits of construction joints, until placement of a panel or section is complete.
  - 1. Consolidate concrete during placement operations so concrete is thoroughly worked around reinforcement and other embedded items and into corners.
  - 2. Maintain reinforcement in position on chairs during concrete placement.
  - 3. Screed slab surfaces with a straightedge and strike off to correct elevations.
  - 4. Slope surfaces uniformly to drains where required.
  - 5. Begin initial floating using bull floats or darbies to form a uniform and open-textured surface plane, before excess bleed water appears on the surface. Do not further disturb slab surfaces before starting finishing operations.
- G. Cold-Weather Placement: Comply with ACI 306.1 and as follows. Protect concrete work from physical damage or reduced strength that could be caused by frost, freezing actions, or low temperatures.
  - 1. When average high and low temperature is expected to fall below 40 deg F for three successive days, maintain delivered concrete mixture temperature within the temperature range required by ACI 301.
  - 2. Do not use frozen materials or materials containing ice or snow. Do not place concrete on frozen subgrade or on subgrade containing frozen materials.
  - 3. Do not use calcium chloride, salt, or other materials containing antifreeze agents or chemical accelerators unless otherwise specified and approved in mixture designs.
- H. Hot-Weather Placement: Comply with ACI 305 and as follows:
  - 1. Maintain concrete temperature below 90 deg F at time of placement. Chilled mixing water or chopped ice may be used to control temperature, provided water equivalent of ice is

calculated to total amount of mixing water. Using liquid nitrogen to cool concrete is Contractor's option.

2. Fog-spray forms, steel reinforcement, and subgrade just before placing concrete. Keep subgrade uniformly moist without standing water, soft spots, or dry areas.

### **3.09 FINISHING FORMED SURFACES**

- A. See Section 03 10 00.

### **3.10 FINISHING FLOORS AND SLABS**

- A. General: Comply with ACI 302.1R recommendations for screeding, re-straightening, and finishing operations for concrete surfaces. Do not wet concrete surfaces.
- B. Scratch Finish (CF-1): While still plastic, texture concrete surface that has been screeded and bull-floated or darbied. Use stiff brushes, brooms, or rakes to produce a profile amplitude of 1/4 inch in one direction.
  1. Apply scratch finish to surfaces indicated and/or to receive concrete floor toppings or to receive mortar setting beds for bonded cementitious floor finishes.
- C. Float Finish (CF-2): Consolidate surface with power-driven floats or by hand floating if area is small or inaccessible to power driven floats. Restraighten, cut down high spots, and fill low spots. Repeat float passes and restraightening until surface is left with a uniform, smooth, granular texture.
  1. Apply float finish to surfaces indicated and/or to receive trowel finish and to be covered with fluid-applied or sheet waterproofing, built-up or membrane roofing, or sand-bed terrazzo.
- D. Trowel Finish (CF-3): After applying float finish, apply first troweling and consolidate concrete by hand or power-driven trowel. Continue troweling passes and restraighten until surface is free of trowel marks and uniform in texture and appearance. Grind smooth any surface defects that would telegraph through applied coatings or floor coverings.
  1. Apply a trowel finish to surfaces indicated and/or exposed to view or to be covered with resilient flooring, carpet, ceramic or quarry tile set over a cleavage membrane, paint, or another thin-film-finish coating system.
  2. Finish and measure surface so gap at any point between concrete surface and an unlevelled, freestanding, 10-foot- (3.05-m-) long straightedge resting on 2 high spots and placed anywhere on the surface does not exceed 1/4 inch (6 mm).
- E. Trowel and Fine-Broom Finish (CF-4): Apply a first trowel finish to surfaces indicated or where ceramic or quarry tile is to be installed by either thickset or thin-set method. While concrete is still plastic, slightly scarify surface with a fine broom.
  1. Comply with flatness and levelness tolerances for trowel-finished floor surfaces.
- F. Broom Finish (CF-5): Apply a broom finish to exterior concrete platforms, steps, ramps, and elsewhere as indicated.
  1. Immediately after float finishing, slightly roughen trafficked surface by brooming with fiber-bristle broom perpendicular to main traffic route. Coordinate required final finish with Architect before application.
- G. Slip-Resistive Finish (CF-6): Before final floating, apply slip-resistive finish where indicated and to concrete stair treads, platforms, and ramps. Apply according to manufacturer's written instructions and as follows:
  1. Uniformly spread 25 lb/100 sq. ft. of dampened slip-resistive granules over surface in one or two applications. Tamp aggregate flush with surface, but do not force below surface.
  2. After broadcasting and tamping, apply float finish.

3. After curing, lightly work surface with a steel wire brush or an abrasive stone and water to expose slip-resistive granules.
- H. Interior slab: Provide a troweled smooth flat matte finish, except at the cooler and freezer. Moisture mitigation is required due to over troweling slab to the point that moisture is trapped with the concrete. Slab shall be at the contractor's sole risk, responsibility and shall be no cost to the owner.

### **3.11 CONCRETE FLOOR FINISH TOLERANCES**

- A. Floor Elevation Tolerance Envelope:
  1. The acceptable tolerance envelope for absolute elevation of any point on the slab surface, with respect to the elevation shown on the Drawings, is as follows:
    - a. Slab-on-Grade, or Slab-on-Void Construction:  $\pm 3/4"$
    - b. Top surfaces of formed slabs measured prior to removal of supporting shores:  $\pm 3/4"$
    - c. Top surfaces of all other slabs:  $\pm 3/4"$
    - d. Slabs specified to slope shall have a tolerance from the specified slope of  $3/8"$  in  $10'-0"$  at any point, up to  $3/4"$  from theoretical elevation at any point.

### **3.12 MISCELLANEOUS CONCRETE ITEMS**

- A. Filling In: Fill in holes and openings left in concrete structures after work of other trades is in place unless otherwise indicated. Mix, place, and cure concrete, as specified, to blend with in-place construction. Provide other miscellaneous concrete filling indicated or required to complete the Work.
- B. Curbs: Provide monolithic finish to interior curbs by stripping forms while concrete is still green and by steel-troweling surfaces to a hard, dense finish with corners, intersections, and terminations slightly rounded.
- C. Equipment Bases and Foundations: Provide machine and equipment bases and foundations as shown on Drawings. Set anchor bolts for machines and equipment at correct elevations, complying with diagrams or templates from manufacturer furnishing machines and equipment.
- D. Steel Pan Stairs: Provide concrete fill for steel pan stair treads, landings, and associated items. Cast-in inserts and accessories as shown on Drawings. Screed, tamp, and trowel finish concrete surfaces.

### **3.13 CONCRETE PROTECTING AND CURING**

- A. General: Protect freshly placed concrete from premature drying and excessive cold or hot temperatures. Comply with ACI 306.1 for cold-weather protection and ACI 301 for hot-weather protection during curing.
- B. Evaporation Retarder: Apply evaporation retarder to unformed concrete surfaces if hot, dry, or windy conditions cause moisture loss approaching  $0.2 \text{ lb/sq. ft.} \times h$  before and during finishing operations. Apply according to manufacturer's written instructions after placing, screeding, and bull floating or darbying concrete, but before float finishing.
- C. Formed Surfaces: Cure formed concrete surfaces, including underside of beams, supported slabs, and other similar surfaces. If forms remain during curing period, moist cure after loosening forms. If removing forms before end of curing period, continue curing for the remainder of the curing period.
- D. Unformed Surfaces: Begin curing immediately after finishing concrete. Cure unformed surfaces, including floors and slabs, concrete floor toppings, and other surfaces.
- E. Cure concrete according to ACI 308.1, by one of the following methods:
  1. Moisture Curing: Keep surfaces continuously moist for not less than seven days with the following materials:

- a. Water, maximum 2" depth.
- b. Continuous water-fog spray.
2. Curing compound to be provided as specified by Architect and shall not interfere with other finishes.

### **3.14 LIQUID FLOOR TREATMENTS**

- A. Penetrating Liquid Floor Treatment: Prepare, apply, and finish penetrating liquid floor treatment according to manufacturers written instructions.
  1. Remove curing compounds, sealers, oil, dirt, laitance, and other contaminants and complete surface repairs.
  2. Do not apply to concrete that is less than 28 days' old.
  3. Apply liquid until surface is saturated, scrubbing into surface until a gel forms; rewet; and repeat brooming or scrubbing. Rinse with water; remove excess material until surface is dry. Apply a second coat in a similar manner if surface is rough or porous.
- B. Polished Concrete Floor Treatment: Apply polished concrete finish system to cured and prepared slabs to match accepted mockup.
  1. Machine grind floor surfaces to receive polished finishes level and smooth and to depth required to reveal aggregate to match approved mockup.
  2. Apply penetrating liquid floor treatment for polished concrete in polishing sequence and according to manufacturer's written instructions, allowing recommended drying time between successive coats.
  3. Continue polishing with progressively finer grit diamond polishing pads to gloss level to match approved mockup.
  4. Control and dispose of waste products produced by grinding and polishing operations.
  5. Neutralize and clean polished floor surfaces.
- C. Sealing Coat: Uniformly apply a continuous sealing coat of curing and sealing compound to hardened concrete by power spray or roller according to manufacturer's written instructions.

### **3.15 JOINT FILLING**

- A. Prepare, clean, and install joint filler according to manufacturer's written instructions.
  1. Defer joint filling until concrete has aged at least six month(s). Do not fill joints until construction traffic has permanently ceased.
- B. Remove dirt, debris, saw cuttings, curing compounds, and sealers from joints; leave contact faces of joint clean and dry.
- C. Install semi-rigid joint filler full depth in saw-cut joints and at least 2 inches deep in formed joints. Overfill joint and trim joint filler flush with top of joint after hardening.

### **3.16 CONCRETE SURFACE REPAIRS**

- A. Defective Concrete: Repair and patch defective areas when approved by Architect. Remove and replace concrete that cannot be repaired and patched to Architect's approval.
- B. Patching Mortar: Mix dry-pack patching mortar, consisting of one part Portland cement to two and one-half parts fine aggregate passing a No. 16 sieve, using only enough water for handling and placing.
- C. Repairing Formed Surfaces: Surface defects include color and texture irregularities, cracks, spalls, air bubbles, honeycombs, rock pockets, fins and other projections on the surface, and stains and other discolorations that cannot be removed by cleaning.
  1. Immediately after form removal, cut out honeycombs, rock pockets, and voids more than 1/2 inch in any dimension to solid concrete. Limit cut depth to 3/4 inch. Make edges of cuts perpendicular to concrete surface. Clean, dampen with water, and brush-coat holes

- and voids with bonding agent. Fill and compact with patching mortar before bonding agent has dried. Fill form-tie voids with patching mortar or cone plugs secured in place with bonding agent.
2. Repair defects on surfaces exposed to view by blending white Portland cement and standard Portland cement so that, when dry, patching mortar will match surrounding color. Patch a test area at inconspicuous locations to verify mixture and color match before proceeding with patching. Compact mortar in place and strike off slightly higher than surrounding surface.
  3. Repair defects on concealed formed surfaces that affect concrete's durability and structural performance as determined by Architect.
- D. Repairing Unformed Surfaces: Test unformed surfaces, such as floors and slabs, for finish and verify surface tolerances specified for each surface. Correct low and high areas. Test surfaces sloped to drain for trueness of slope and smoothness; use a sloped template.
1. Repair finished surfaces containing defects. Surface defects include spalls, popouts, honeycombs, rock pockets, crazing and cracks in excess of 0.01 inch wide or that penetrate to reinforcement or completely through unreinforced sections regardless of width, and other objectionable conditions.
  2. After concrete has cured at least 14 days, correct high areas by grinding.
  3. Correct localized low areas during or immediately after completing surface finishing operations by cutting out low areas and replacing with patching mortar. Finish repaired areas to blend into adjacent concrete.
  4. Correct other low areas scheduled to receive floor coverings with a repair underlayment. Prepare, mix, and apply repair underlayment and primer according to manufacturer's written instructions to produce a smooth, uniform, plane, and level surface. Feather edges to match adjacent floor elevations.
  5. Correct other low areas scheduled to remain exposed with a repair topping. Cut out low areas to ensure a minimum repair topping depth of 1/4 inch to match adjacent floor elevations. Prepare, mix, and apply repair topping and primer according to manufacturer's written instructions to produce a smooth, uniform, plane, and level surface.
  6. Repair defective areas, except random cracks and single holes 1 inch or less in diameter, by cutting out and replacing with fresh concrete. Remove defective areas with clean, square cuts and expose steel reinforcement with at least a 3/4-inch clearance all around. Dampen concrete surfaces in contact with patching concrete and apply bonding agent. Mix patching concrete of same materials and mixture as original concrete except without coarse aggregate. Place, compact, and finish to blend with adjacent finished concrete. Cure in same manner as adjacent concrete.
  7. Repair random cracks and single holes 1 inch or less in diameter with patching mortar. Groove top of cracks and cut out holes to sound concrete and clean off dust, dirt, and loose particles. Dampen cleaned concrete surfaces and apply bonding agent. Place patching mortar before bonding agent has dried. Compact patching mortar and finish to match adjacent concrete. Keep patched area continuously moist for at least 72 hours.
- E. Perform structural repairs of concrete, subject to Architect's approval, using epoxy adhesive and patching mortar.
- F. Repair materials and installation not specified above may be used, subject to Architect's approval.

### **3.17 FIELD QUALITY CONTROL**

- A. Testing and Inspecting: See Section 01 45 23.
1. Additional testing and inspecting, at Contractor's expense, will be performed to determine compliance of replaced or additional work with specified requirements.



2. Correct deficiencies in the Work that test reports and inspections indicate do not comply with the Contract Documents.

### **3.18 PROTECTION OF LIQUID FLOOR TREATMENTS**

- A. Protect liquid floor treatment from damage and wear during the remainder of construction period. Use protective methods and materials, including temporary covering, recommended in writing by liquid floor treatments installer.

END OF SECTION 03 30 00

## **SECTION 03 52 16.19 - LIGHTWEIGHT INSULATING CONCRETE**

### **PART 1 - GENERAL**

#### **1.01 DESCRIPTION**

- A. Drawings and general provisions of the Contract, including Division 01 General Requirements and NCISD Procurement and Contracting Requirements, apply to this Section.
- B. Refer to Section AB – Instructions to Proposers, Section AS – Subcontractor / Manufacturer Prequalification, and Section 01 25 00 – Request for Substitution Procedures.
- C. Scope of Work:
  - 1. Provide lightweight insulating concrete deck at roof as indicated on the Drawings.
  - 2. Includes lightweight insulating concrete decks installed on structural steel metal deck and cementitious wood fiber decks.
  - 3. Provide all materials and accessories required for a complete installation.
- D. Related Work:
  - 1. Section 01 45 23 – Testing and Inspection Services
  - 2. Section 05 31 00 – Steel Decking
  - 3. Section 06 10 00 – Rough Carpentry
  - 4. Section 07 52 19 – Modified Bituminous “Cool Roof” Membrane Roofing
  - 5. Section 07 72 00 – Roof Accessories
  - 6. Section 07 72 23 – Roof Hatches and Vents

#### **1.02 SUBMITTALS**

- A. Review and comply with all provisions of section 01 33 00 – Submittal Procedures.
- B. Product Data: Submit manufacturer’s literature, product data, certifications and supporting information for all products proposed to be furnished, as necessary to demonstrate compliance with the specified requirements.
  - 1. Mix Design: Indicate materials and proportions of proposed mix.
  - 2. Manufacturer’s letter of certification of the approved installer.
- C. Shop Drawings: Submit complete shop drawings consisting of design, fabrication and erection / installation of proposed assemblies.
  - 1. Show profiles, sizes, spacing and locations of assembled components.
  - 2. Show details of shop fabrications, connections and details.
  - 3. Show details of field fabrications, connections and details.
  - 4. Provide calculations demonstrating compliance with wind load and other requirements.
  - 5. Shop drawings shall be sealed and signed by a Texas registered engineer.
- D. Installation Instructions: Submit manufacturer’s complete installation instructions, including fastening, for all products and / or assemblies proposed to be furnished.
  - 1. Installation details submitted for review shall be specific to the work of this contract and accurately depict interface within the assembly(s) indicated on the Drawings.
  - 2. Generic details that do not depict actual conditions shall not be acceptable.
- E. Maintenance Instructions: Submit manufacturer’s complete maintenance instructions and recommendations for all products and / or assemblies proposed to be furnished.
  - 1. Include recommended cleaning products and instructions for use.
  - 2. Where applicable, provide recommended maintenance schedules and procedures.
- F. Manufacturer's specifications and other data for all products proposed to be furnished as needed to prove compliance with specified requirements.

G. Manufacturer's letter of certification of the approved installer.

### **1.03 REFERENCES**

A. American Society for Testing and Material:

1. ASTM C150 – Standard Specifications for Portland Cement
2. ASTM C172 – Standard Practice for Sampling Freshly Mixed Concrete
3. ASTM C332 – Standard Specification for Lightweight Aggregates for Insulating Concrete, Group 1
4. ASTM C495 – Standard Test Method for Compressive Strength of Lightweight Insulating Concrete
5. ASTM C513 – Standard Test Method for obtaining Specimens of Hardened Lightweight Insulating Concrete for Compressive Strength
6. ASTM C578 – Standard Specifications for Rigid Cellular Polystyrene Thermal Insulation
7. ASTM C796 – Standard Test Method for Foaming Agents for Use in Producing Cellular Concrete Using Preformed Foam
8. ASTM C869, Standard Specifications for Foaming Agents Used in Making Preformed Foam for Cellular Concrete
9. ASTM C1077 – Standard Practice for Agencies Testing Concrete and Concrete Aggregates for Use in Construction and Criteria for Testing Agency Evaluation
10. ASTM E119 – Standard Test Method for Fire Tests of Building Construction and Materials
11. ASTM E329 – Standard Specifications for Agencies Engaged in Construction Inspection, Testing and Special Inspection

B. Comply with all applicable recommendations of American National Standard Institute (ANSI) A122.1, and any others referred to herein. In any conflict between referenced standards, the more stringent requirements shall govern.

1. ANSI / SPRI FX-1-2006 – Standard Field Test Procedures for Determining the Withdrawal Resistance of Roofing Fasteners.

### **1.04 QUALITY ASSURANCE AND TESTING PROCEDURES**

A. Acceptable Applicators:

1. Applicator must be approved / licensed by the system manufacturer. Approval shall be confirmed in writing to the Architect. Written approval by the manufacturer for the applicator shall include the project by name.
2. Applicator must have at least five (5) years of satisfactory experience installing the specified system.
3. Upon request by the Architect, provide a list of at three (3) projects where the applicator has installed the specified / proposed lightweight insulating concrete deck. The list shall include the name and contact information of the project architect and general contractor.

B. Testing Laboratory Services:

1. The Owner will select the Testing Laboratory and pay for the cost of tests to determine the dry density and compressive strength of the lightweight insulating concrete deck. Testing shall be determined in accordance with ASTM C495.

C. Quality Assurance:

1. The system shall conform to the requirements of FM Global and shall be currently listed as an approved component in the FM RoofNav Database.
2. Roof Deck assembly shall conform to F.M. wind uplift Class 90.
3. The system manufacturer's product shall be UL classified and listed in the current Underwriters Laboratories "Fire Resistance Design Directory".

D. Building / Construction Components:

1. 01 Meet or exceed established standards.

2. Meet 30 R-value.

## **1.05 ROOF SYSTEM COORDINATION**

- A. Coordinate with roofing manufacturer / contractor as required to assure compatibility of the lightweight insulating roof deck with the performance and installation criteria of the specified basis of design roofing system.
- B. If a roofing system other than the basis of design system is used on the project, coordinate as required to assure compatibility of the lightweight insulating roof deck with the performance and installation criteria of the roofing system.
- C. Modify the design performance of the lightweight insulating roof deck as required to meet requirements of the roofing system to be installed.

## **PART 2 - PRODUCTS**

### **2.01 MANUFACTURERS**

- A. The following manufacturers are acceptable to provide the work of this section, provided their proposed systems / products meet or exceed all specified requirements:
  1. Elastizell
  2. Siplast
  3. Vermiculite Products Inc.
  4. Celcore
  5. Merlecrete

### **2.02 LIGHTWEIGHT CONCRETE**

- A. Aggregate:
  1. Vermiculite: Comply with ASTM C332, Group 1.
  2. Mix shall be 1:6 with 125 to 225 psi at 28 days compressive strength; 44 to 60 PCF cast density, and 22 to 28 PCF dry density.
  3. Vermiculite aggregate proposed for use shall be certified as being asbestos free.
- B. Cellular:
  1. Foaming agent shall comply with ASTM C869 when tested in accordance with ASTM C796.
  2. Cast density of 36 to 44 PCF.
  3. Minimum dry density of 26 PCF.
  4. Minimum 28-day compressive strength of 200 PSI.
- C. Cement: Portland, conforming to ASTM C150, Type I, I/II or III.
- D. Admixture: As recommended by system manufacturer.
- E. Reinforcing Fibers: shall be monofilament type and shall not exceed 1.5 PCY
- F. Water: Free from any materials harmful to concrete or structural steel deck.
- G. Expansion Joint Material: 1" thick fiberglass approved by the manufacturer for use in conjunction with and insulating concrete deck.
- H. Metal Deck: Refer to structural drawings and specifications for size, type and section modulus of metal deck.
  1. Steel deck perforations for aggregate insulating concrete shall not exceed 1.5% open area.
  2. Steel deck vent perforations for cellular insulating concrete shall not exceed 0.75% open area.
- I. Curing Compound: As required by the insulating concrete manufacturer and applied in accordance with the manufacturer's instructions.

## **2.03 INSULATION BOARD**

- A. Rigid, closed cell, un-faced Expanded Polystyrene (EPS) board stock complying with ASTM C578.
- B. Thickness: six (6) inches minimum.
- C. Nominal Density: 1.0 PCF, Type I.
- D. Fire Resistance: Flame spread – ASTM E84. Smoke Density – ASTM E84.
- E. Provide a minimum of six (6) 3" diameter bond holes for each 8 SF of board.

## **2.04 DESIGN OF ROOF DAMAGE**

- A. The design to drain roof areas, whether to roof drains or gutters, is generally accomplished by sloping the underlying steel structure sloping to the drainage vehicle.
- B. In areas of the roof that are shown to be cricketed or similar, provide tapered rigid insulation or build up surface of lightweight concrete above the EPS insulation in the patterns shown or required to facilitate full drainage of the roof surface.
  - 1. Area to slope at 1/4" per foot unless noted otherwise.

# **PART 3 - EXECUTION**

## **3.01 INSPECTION AND PREPARATION**

- A. Prior to erection of forms, inspect structural deck to ensure all work is complete and suitable for this installation to progress.
- B. Prior to placing insulating concrete, inspect corrugated metal forms to ensure that they are secured to the structure and free of debris or foreign materials.
- C. Verify that all deficiencies have been corrected prior to commencing installation.
- D. Weather:
  - 1. Insulating concrete roof decks may be placed when temperatures are 40°F and rising.
  - 2. If colder temperatures are anticipated, the Applicator shall take suitable precautions for the installation of an acceptable deck.
  - 3. Do not place insulating concrete deck during precipitation or when there is a likely expectation that precipitation will occur during installation.
  - 4. Adverse weather precautions, actions and remedies shall be in strict accordance with the system manufacturer's standards and recommendations.
- E. The roofing membrane system application must be coordinated with the insulating concrete installation to avoid prolonged exposure of the roof deck.

## **3.02 INSTALLATION**

- A. Lightweight concrete shall be mixed in accordance with manufacturer's standards and recommendations.
- B. Fill valleys / voids of structural metal deck with a leveling thickness of lightweight concrete fill.
- C. Install EPS rigid insulation board in the fresh bond coat of lightweight concrete fill.
  - 1. Install insulation board in fresh bond coat layer in such a manner that results in the underside of insulation boards making full coverage contact with bond coat layer.
  - 2. EPS board shall be held back 3(+) inches from the perimeter / edges of the roof deck. Voids to be filled with lightweight concrete fill.
- D. The EPS layer shall be placed and allowed to set overnight, undisturbed, prior to installation of the lightweight concrete roof deck topping layer.

- E. Where required, place reinforcing mesh with longitudinal wires at right angles to structural supports.
  - 1. Lap 6 inches and tie at intersections, both sides and ends.
  - 2. Ensure that mesh is in approximate center of the topping fill depth.
- F. Install a minimum of 2" thickness of lightweight concrete fill over EPS board, filling all bond holes, perimeter voids and other locations to produce a smooth surface suitable for the installation of the specified roofing system.
  - 1. The surface to receive lightweight concrete fill shall be dry, free of water, dew, frost, ice and snow at the time of placement.
- G. Where indicated on the drawings increase depth of lightweight concrete fill as required to form crickets, etc. required for positive drainage
- H. Insulating concrete shall be screeded to the proper thickness and slope with a surface free of ridges and sharp projections prior to installation of the roofing membrane.
- I. Cure roof deck topping in accordance with the system manufacturer's standards and recommendations.

### **3.03 FIELD QUALITY CONTROL AND TESTING**

- A. Check the cast density at point of placement and adjust the mix to obtain required cast density.
  - 1. End of hose cast density checks shall be taken, at minimum, every thirty (30) minutes at the point of placement.
  - 2. Do not rod specimens.
  - 3. A set of test specimens shall be considered to be six (6) 3x6 cylinders made from the same sampling.
  - 4. Four (4) specimens from each set shall be tested for compressive strength and two (2) for dry density.
- B. Protect samples from damage and temperature extremes and test accordingly at 28 days to ASTM C495.
- C. Applicator shall have test equipment available on job site at all times during pouring of insulating concrete for testing slump and cast density.
  - 1. Slump shall not exceed 5 inches.
- D. Pull Test: Conduct pull tests to document / substantiate the lightweight concrete deck meets or exceeds the minimum pull-out requirements of the specified roofing system.
  - 1. Testing shall be done and recorded in accordance with ANSI / SPRI FX-1-2006.

### **3.04 COORDINATION WITH ROOFING WORK**

- A. Confirm prior to placement of the lightweight concrete that the specified roof system is compatible with the type of insulating concrete to be installed.
- B. Begin roofing when the insulating concrete roof deck has open air cured sufficiently to a point where subsequent work can progress without damage to the lightweight insulating concrete deck.
  - 1. This is usually 3 to 5 days after the deck has been placed.
  - 2. Confirm the Contractor has coordinated with roofing installer as required.
- C. The roof deck should not be left exposed for longer than 5 to 7 days following open-air cure period.
- D. Consult the roofing manufacturers for their recommended attachment of the roofing system to the insulating concrete roof deck system.

### **3.05 REPAIRS**

- A. Where required to provide surface conditions suitable to receive the specified roof system, repairs to smooth the deck surface, correct depressions or fill divots shall be performed in accordance with written guidance provided by the systems manufacturer.
- B. Remove and replace any area of the roof deck that fails to comply with the requirements of the systems manufacturer, this specification or applicable product approval.

END OF SECTION 03 52 16.19

## **SECTION 05 12 00 - STRUCTURAL STEEL FRAMING**

---

### **PART 1 - GENERAL**

#### **1.01 RELATED DOCUMENTS**

- A. Drawings and general provisions of the Contract, including Division 01 General Requirements and NCISD Procurement and Contracting Requirements, apply to this Section.

#### **1.02 SUMMARY**

- A. Section Includes:
  - 1. Structural steel.
  - 2. Prefabricated building columns.
- B. Related Sections:
  - 1. Section 01 45 23 "Testing and Inspection Services".
  - 2. Section 05 31 13 "Steel Floor Decking".
  - 3. Section 05 31 23 "Steel Roof Decking".
  - 4. Section 05 50 00 "Metal Fabrications".
  - 5. Section 05 51 00 "Metal Stairs."

#### **1.03 DEFINITIONS**

- A. Structural Steel: Elements of structural-steel frame, as classified by AISC 303, "Code of Standard Practice for Steel Buildings and Bridges."
- B. Seismic-Load-Resisting System: Elements of structural-steel frame designated as "SLRS" or along grid lines designated as "SLRS" on Drawings, including columns, beams, and braces and their connections.
- C. Heavy Sections: Rolled and built-up sections as follows:
  - 1. Shapes included in ASTM A 6 with flanges thicker than 1 1/2 inches.
  - 2. Welded built-up members with plates thicker than 2 inches.
  - 3. Column base plates thicker than 2 inches.
- D. Protected Zone: Structural members or portions of structural members indicated as "Protected Zone" on Drawings. Connections of structural and nonstructural elements to protected zones are limited.
- E. Demand Critical Welds: Those welds, the failure of which would result in significant degradation of the strength and stiffness of the Seismic-Load-Resisting System and which are indicated as "Demand Critical" or "Seismic Critical" on Drawings.

#### **1.04 REFERENCES**

- A. Comply with applicable provisions of the following specifications and documents: The latest adopted edition of all standards referenced in this section shall apply, unless noted otherwise
  - 1. AISC "Code of Standard Practice for Steel Buildings and Bridges".
  - 2. AISC "Specification for Structural Steel Buildings," including the "Commentary" and the Supplements thereto, as issued.
  - 3. AISC "Specification for Architecturally Exposed Structural Steel".
  - 4. AISC's "Seismic Provisions for Structural Steel Buildings".
  - 5. ASTM A 6 "Specification for General Requirements for Rolled Steel Plates, Shapes, Sheet Piling, and Bars for Structural Use".
  - 6. AWS D1.1 Structural Welding Code.
  - 7. Research Council on Structural Connections' (RCSC) "Specification for Structural Joints Using ASTM A 325 or A 490 Bolts".



8. Research Council on Structural Connections' (RCSC) "Load and Resistance Factor Design Specification for Structural Joints Using ASTM A 325 or A 490 Bolts".
  9. SSPC (Steel Structures Painting Council), Painting Manuals, Volumes 1 and 2.
  10. UL Fire Resistance Directory.
- B. In the case of conflict between the Contract Documents and a reference standard, the Contract Documents shall govern. In the case of a conflict between the Contract Documents and the Building Code, the more stringent shall govern.

## **1.05 PERFORMANCE REQUIREMENTS**

- A. Delegated Design: Prepare submittal documents including connection design calculations and drawings signed and sealed by registered design professional, licensed in state where project is located, employed by the steel fabricator.
- B. Design all structural steel framing connections complying with specified performance:
1. Load Capacity: Resist loads indicated on drawings or resist full capacity of supported framing member if reaction not indicated. Account for connection and member loads and eccentricities.
    - a. Request additional design criteria when necessary to complete connection design.
  2. Configuration: Design and detail all connections for each member size, steel grade and connection type to resist the loads and reactions indicated on the drawings or specified herein. Use details consistent with details shown on drawings, supplementing where necessary. The details shown on drawings are conceptual and do not indicate the required weld sizes or number of bolts unless specifically noted. Use rational engineering design and standard practice in detailing, accounting for all loads and eccentricities in both the connection and the members. Promptly notify the design professional in charge of any location where the connection design criteria is not clearly indicated. The design of all connections is subject to the review and acceptance of the design professional in charge. Submit structural calculations prepared and sealed by a qualified engineer registered in the state where the project is located. Submit calculations for review before preparation of detail drawing.

## **1.06 ACTION SUBMITTALS**

- A. Product Data: For each type of product indicated.
- B. Shop Drawings: Show fabrication of structural-steel components.
1. Include details of cuts, connections, splices, camber, holes, and other pertinent data.
  2. Include embedment drawings.
  3. Indicate welds by standard AWS symbols, distinguishing between shop and field welds, and show size, length, and type of each weld. Show backing bars that are to be removed and supplemental fillet welds where backing bars are to remain.
  4. Indicate type, size, and length of bolts, distinguishing between shop and field bolts. Identify pretensioned and slip-critical high-strength bolted connections.
  5. Identify members and connections of the seismic-load-resisting system.
  6. Indicate locations and dimensions of protected zones.
  7. Identify demand critical welds.
  8. For structural-steel connections indicated to comply with design loads, include structural analysis data signed and sealed by the qualified professional engineer responsible for their preparation.
- C. At full penetration welds, Welding Procedure Specifications (WPSs) and Procedure Qualification Records (PQRs): Provide according to AWS D1.1, "Structural Welding Code - Steel," for each welded joint whether prequalified or qualified by testing, including the following:

1. Power source (constant current or constant voltage).
2. Electrode manufacturer and trade name, for demand critical welds.

## **1.07 INFORMATIONAL SUBMITTALS**

- A. Submit the following informational submittals:
  1. Qualification Data: For qualified installer, fabricator, and testing agency.
  2. Welding certificates.
  3. Mill test reports for structural steel, including chemical and physical properties.
  4. Product Test Reports: For the following:
    - a. Bolts, nuts, and washers including mechanical properties and chemical analysis.
    - b. Direct-tension indicators.
    - c. Tension-control, high-strength bolt-nut-washer assemblies.
    - d. Shear stud connectors.
    - e. Shop primers.
  5. Source quality-control reports.
  6. **Delegated Design Drawings and Calculations: Signed and sealed by responsible Engineer.**
    - a. **Connection calculations.**

## **1.08 QUALITY ASSURANCE**

- A. Fabricator Qualifications: A qualified fabricator that participates in the AISC Quality Certification Program and is designated an AISC-Certified Plant, Category STD.
- B. Installer Qualifications: A qualified installer who participates in the AISC Quality Certification Program and is designated an AISC-Certified Erector, Category CSE.
- C. Shop-Painting Applicators: Qualified according to AISC's Sophisticated Paint Endorsement P1, P2, or P3 as applicable for exposure or SSPC-QP 3, "Standard Procedure for Evaluating Qualifications of Shop Painting Applicators."
- D. Welding Qualifications: Qualify procedures and personnel according to AWS D1.1/D1.1M, "Structural Welding Code - Steel."
  1. Welders and welding operators performing work on bottom-flange, demand-critical welds shall pass the supplemental welder qualification testing, as required by AWS D1.8. FCAW-S and FCAW-G shall be considered separate processes for welding personnel qualification.
- E. Comply with applicable provisions of the following specifications and documents:
  1. AISC 303.
  2. AISC 341 and AISC 341s1.
  3. AISC 360.
  4. RCSC's "Specification for Structural Joints Using ASTM A 325 or A 490 Bolts."
- F. Preinstallation Conference: Conduct conference at Project site.

## **1.09 DELIVERY, STORAGE, AND HANDLING**

- A. Store materials to permit easy access for inspection and identification. Keep steel members off ground and spaced by using pallets, dunnage, or other supports and spacers. Protect steel members and packaged materials from corrosion and deterioration.
  1. Do not store materials on structure in a manner that might cause distortion, damage, or overload to members or supporting structures. Repair or replace damaged materials or structures as directed.
- B. Store fasteners in a protected place in sealed containers with manufacturer's labels intact.
  1. Fasteners may be repackaged provided Owner's testing and inspecting agency observes repackaging and seals containers.

2. Clean and re-lubricate bolts and nuts that become dry or rusty before use.
3. Comply with manufacturers' written recommendations for cleaning and lubricating ASTM F 1852 fasteners and for retesting fasteners after lubrication.

## **1.10 COORDINATION**

- A. Coordinate selection of shop primers with topcoats to be applied over them. Comply with paint and coating manufacturers' recommendations to ensure that shop primers and topcoats are compatible with one another.
- B. Coordinate installation of anchorage items to be embedded in or attached to other construction without delaying the Work. Provide setting diagrams, sheet metal templates, instructions, and directions for installation.

## **PART 2 - PRODUCTS**

### **2.01 STRUCTURAL-STEEL MATERIALS**

- A. Recycled Content of Steel Products: Provide products with an average recycled content of steel products so postconsumer recycled content plus one-half of pre-consumer recycled content is not less than the following:
  1. W-Shapes: 60 percent.
  2. Channels, Angles, M, S-Shapes: 60 percent.
  3. Plate and Bar: 25 percent.
  4. Cold-Formed Hollow Structural Sections: 25 percent.
  5. Steel Pipe: 25 percent.
  6. All Other Steel Materials: 25 percent.
- B. W-Shapes: Refer Structural General Notes.
- C. Channels, Angles, M, S-Shapes: Refer Structural General Notes.
- D. Plate and Bar: Refer Structural General Notes.
- E. Corrosion-Resisting Structural-Steel Shapes, Plates, and Bars: ASTM A 588, Grade 50.
- F. Cold-Formed Hollow Structural Sections: Refer Structural General Notes.
- G. Steel Pipe: Refer Structural General Notes.
  1. Weight Class: See Plans.
  2. Finish: Black except where indicated to be galvanized.
- H. Welding Electrodes: Comply with AWS requirements.

### **2.02 BOLTS, CONNECTORS, AND ANCHORS**

- A. High-Strength Bolts, Nuts, and Washers: ASTM A 325, Type 1, heavy-hex steel structural bolts.
  1. Direct-Tension Indicators: ASTM F 959, Type 325, compressible-washer type with plain finish.
- B. Zinc-Coated High-Strength Bolts, Nuts, and Washers (All bolts located in Crawl Space): ASTM A 325, Type 1, heavy-hex steel structural bolts.
  1. Finish: Hot-dip or mechanically deposited zinc coating.
  2. Direct-Tension Indicators: ASTM F 959, Type 325, compressible-washer type with mechanically deposited zinc coating finish.
- C. Tension-Control, High-Strength Bolt-Nut-Washer Assemblies: ASTM F 1852, Type 1, heavy hex or round head assemblies consisting of steel structural bolts with splined ends, heavy-hex carbon-steel nuts, and hardened carbon-steel washers.
  1. Finish: Plain or Mechanically deposited zinc coating, where required.

- D. Shear Connectors: ASTM A 108, Grades 1015 through 1020, headed-stud type, cold-finished carbon steel; AWS D1.1, Type B.
- E. Unheaded Anchor Rods: ASTM F 1554, See Anchor Bolt Schedule on Drawings for Grade.
  - 1. Configuration: Straight.
  - 2. Nuts: ASTM A 563 heavy-hex carbon steel.
  - 3. Plate Washers: ASTM A 36 carbon steel.
  - 4. Washers: ASTM F 436, Type 1, hardened carbon steel.
  - 5. Finish:
    - a. General Condition – Plain
    - b. Crawl Space - Hot-dip zinc coating, ASTM A 153, Class C.
- F. Clevises and Turnbuckles: Made from cold-finished carbon steel bars, ASTM A 108, Grade 1035.
- G. Eye Bolts and Nuts: Made from cold-finished carbon steel bars, ASTM A 108, Grade 1030.
- H. Sleeve Nuts: Made from cold-finished carbon steel bars, ASTM A 108, Grade 1018.
- I. Structural Slide Bearings: Low-friction assemblies, of configuration indicated, that provide vertical transfer of loads and allow horizontal movement perpendicular to plane of expansion joint while resisting movement within plane of expansion joint.
  - 1. Basis-of-Design Product: Subject to compliance with requirements, provide product indicated on Drawings or comparable product by one of the following:
    - a. Amscot Structural Products Corp.
    - b. Fluorocarbon Company Limited.
    - c. R.J. Watson Bridge & Structural Engineered Systems.
    - d. Seismic Energy Products, L.P.
  - 2. Mating Surfaces: PTFE and PTFE or mirror-finished stainless steel.
  - 3. Coefficient of Friction: Not more than 0.05.
  - 4. Design Load: Not less than 5,000 psi .
  - 5. Total Movement Capability: 2 inches.

## **2.03 PRIMER**

- A. Low-Emitting Materials: Paints and coatings shall comply with the testing and product requirements of the Standard Practice for the Testing of Volatile Organic Emissions from Various Sources Using Small-Scale Environmental Chambers."
- B. Primer (General): Fabricator's standard lead- and chromate-free, non-asphaltic, rust-inhibiting primer complying with MPI#79 and compatible with topcoat.
- C. Galvanizing Repair Paint: SSPC-Paint 20.
- D. Exposed miscellaneous steel such as brick angles to be hot dipped galvanized.
- E. Exposed steel beams and columns to weather to receive High performance paint, coordinate shop primer and surface rep.

## **2.04 GROUT**

- A. Refer Section 03 30 00.

## **2.05 FABRICATION**

- A. Structural Steel: Fabricate and assemble in shop to greatest extent possible. Fabricate according to AISC's "Code of Standard Practice for Steel Buildings and Bridges" and AISC 360.
  - 1. Camber structural-steel members where indicated.
  - 2. Fabricate beams with rolling camber up.

3. Identify high-strength structural steel according to ASTM A 6 and maintain markings until structural steel has been erected.
  4. Mark and match-mark materials for field assembly.
  5. Complete structural-steel assemblies, including welding of units, before starting shop priming operations.
- B. Fabricate and assemble structural steel in shop to greatest extent possible. Fabricate structural steel according to AISC specifications referenced in this Section and in final approved Shop Drawings.
1. Properly mark and match-mark materials for field assembly. Fabricate for delivery sequence that will expedite erection and minimize field handling of materials.
  2. Where finishing is required, complete assembly, including welding of units, before start of finishing operations. Provide finish surfaces of members exposed in final structure free of markings, burrs, and other effects.
  3. Camber structural steel members where indicated. The camber specified is the camber that is measured in the field with the beam on its side so that the beam weight has no effect. During shipment and handling, cambered members shall be supported in a way that will not result in loss of camber.
  4. Camber tolerance
    - a. Beams 50 feet and less; plus or minus 1/2 inch.
    - b. Beams greater than 50 feet; plus or minus 1/2 inch, except tolerance can be increased 1/8 inch for each 10 feet or fraction thereof in excess of 50 feet.
    - c. Contact engineer for members outside specified camber tolerance. Provide engineer with a list of beam locations and actual measured camber amounts. Submit an engineered shoring plan, if requested, that will allow the beam to deflect to the horizontal position after concrete placement without overloading the framing below.
  5. Complete structural steel assemblies, including welding of units, before starting shop priming operations.
  6. Comply with fabrication tolerance limits of AISC's "Code of Standard Practice for Steel Buildings and Bridges" for structural steel.
- C. Thermal Cutting: Perform thermal cutting by machine to greatest extent possible.
1. Plane thermally cut edges to be welded to comply with requirements in AWS D1.1.
- D. Bolt Holes: Cut, drill, or punch standard bolt holes perpendicular to metal surfaces.
- E. Finishing: Accurately finish ends of columns and other members transmitting bearing loads.
- F. Cleaning: Clean and prepare steel surfaces that are to remain unpainted according to SSPCSP3, "Power Tool Cleaning."
- G. Shear Connectors: Prepare steel surfaces as recommended by manufacturer of shear connectors. Use automatic end welding of headed-stud shear connectors according to AWS D1.1 and manufacturer's written instructions.
- H. Holes for Other Work: Provide holes required for securing other work to structural steel framing, and for passage of other work through steel framing members, as shown on approved shop drawings.
1. Provide threaded nuts welded to framing, and other specialty items as indicated to receive other work.
  2. Cut, drill, or punch holes perpendicular to metal surfaces. Do not flame cut holes by burning.
- I. Base-Plate Holes: Cut, drill, mechanically thermal cut, or punch holes perpendicular to steel surfaces. Base plates hole sizes for anchor bolts may be oversized to facilitate erection:
1. Bolts 3/4 inch to 7/8 inch diameter: 1/2 inch oversize.
  2. Bolts 1 inch to 1 1/2 inch diameter: 3/4 inch oversize.

3. Bolts over 1 3/4 inch diameter: 1 inch oversize.
- J. Base Plate Washers: Sizes shall be as follows:
1. 3/4 inch diameter Bolts: 2 inch diameter x 1/4 inch thick
  2. 7/8 inch diameter Bolts: 2 1/2 inch diameter x 5/16 inch thick
  3. 1 inch diameter Bolts: 3 inch diameter x 3/8 inch thick
  4. 1 1/4 inch diameter Bolts: 3 inch diameter x 1/2 inch thick
  5. 1 1/2 inch diameter Bolts: 3 1/2 inch diameter x 1/2 inch thick
  6. 1 3/4 inch diameter Bolts: 4 inch diameter x 5/8 inch thick
  7. 2 inch diameter Bolts: 5 inch diameter x 3/4 inch thick
- K. Architecturally Exposed Structural Steel (AESS): Fabricate with exposed surfaces smooth, square, and free of surface blemishes, including pitting, rust and scale seam marks, roller marks, rolled trade names, and roughness.
1. Remove blemishes by filling, grinding, or by welding and grinding, prior to cleaning, treating, and shop priming.
  2. Comply with fabrication requirements, including tolerance limits, of AISC's "Specification for Architecturally Exposed Structural Steel" for architecturally exposed structural steel.

## **2.06 SHOP CONNECTIONS**

- A. High-Strength Bolts: Shop install high-strength bolts according to RCSC's "Specification for Structural Joints Using ASTM A 325 or A 490 Bolts" for type of bolt and type of joint specified.
1. Joint Type: Snug tightened, Pretensioned, or Slip critical as required or indicated on Drawings.
- B. Weld Connections: Comply with AWS D1.1 and AWS D1.8, where required, for tolerances, appearances, welding procedure specifications, weld quality, and methods used in correcting welding work.
1. Assemble and weld built-up sections by methods that will maintain true alignment of axes without exceeding tolerances in AISC 303 for mill material.

## **2.07 SHOP PRIMING**

- A. Shop prime steel surfaces except the following:
1. Surfaces embedded in concrete or mortar. Extend priming of partially embedded members to a depth of 2 inches.
  2. Surfaces to be field welded.
  3. Surfaces to be high-strength bolted with slip-critical connections.
  4. Surfaces to receive sprayed fire-resistive materials (applied fireproofing) excluding crawl space steel. Crawl space steel shall be primed regardless of whether it is to receive fireproofing.
  5. Galvanized surfaces.
- B. Surface Preparation: Clean surfaces to be painted. Remove loose rust and mill scale and spatter, slag, or flux deposits. Prepare surfaces according to the following specifications and standards:
1. SSPC-SP 2, "Hand Tool Cleaning."
- C. Priming: Immediately after surface preparation, apply primer according to manufacturer's written instructions and at rate recommended by SSPC to provide a minimum dry film thickness of 1.5 mils. Use priming methods that result in full coverage of joints, corners, edges, and exposed surfaces.
- D. Apply two coats of shop paint to surfaces that are inaccessible after assembly or erection. Change color of second coat to distinguish it from first.
- E. Crawl space steel to be primed to a DFT between 2.5 and 3.5 mils.

- F. Painting: Prepare steel and apply a one-coat, non-asphaltic primer complying with SSPCPS Guide 7.00, "Painting System Guide 7.00: Guide for Selecting One-Coat Shop Painting Systems," to provide a dry film thickness of not less than 1.5 mils.

## **2.08 GALVANIZING**

- A. Hot-Dip Galvanized Finish: Apply zinc coating by the hot-dip process to structural steel according to ASTM A 123.
  - 1. Fill vent and drain holes that will be exposed in the finished Work unless they will function as weep holes, by plugging with zinc solder and filing off smooth.
  - 2. Galvanize lintels and shelf angles attached to structural steel frame and located in exterior walls.

## **2.09 SOURCE QUALITY**

- A. Testing Agency: Refer Section 01 45 23.
  - 1. Provide testing agency with access to places where structural-steel work is being fabricated or produced to perform tests and inspections.
- B. Correct deficiencies in Work that test reports and inspections indicate does not comply with the Contract Documents.

# **PART 3 - EXECUTION**

## **3.01 EXAMINATION**

- A. Verify, with steel Erector present, elevations of concrete and masonry bearing surfaces and locations of anchor rods, bearing plates, and other embedments for compliance with requirements.
  - 1. Prepare a certified survey of bearing surfaces, anchor rods, bearing plates, and other embedments showing dimensions, locations, angles, and elevations.
- B. Proceed with installation only after unsatisfactory conditions have been corrected.

## **3.02 PREPARATION**

- A. Provide temporary shores, guys, braces, and other supports during erection to keep structural steel secure, plumb, and in alignment against temporary construction loads and loads equal in intensity to design loads. Remove temporary supports when permanent structural steel, connections, and bracing are in place unless otherwise indicated.
  - 1. Do not remove temporary shoring supporting composite deck construction until cast-inplace concrete has attained its design compressive strength.

## **3.03 ERECTION**

- A. Set structural steel accurately in locations, to elevations indicated, and according to AISC 303 and AISC 360.
- B. Base Bearing and Leveling Plates: Clean concrete- and masonry-bearing surfaces of bond-reducing materials, and roughen surfaces prior to setting plates. Clean bottom surface of plates.
  - 1. Set plates for structural members on wedges, shims, or setting nuts as required.
  - 2. Weld plate washers to top of baseplate.
  - 3. Snug-tighten anchor rods after supported members have been positioned and plumbed. Do not remove wedges or shims but, if protruding, cut off flush with edge of plate before packing with grout.
  - 4. Promptly pack grout solidly between bearing surfaces and plates so no voids remain. Neatly finish exposed surfaces; protect grout and allow it to cure. Comply with manufacturer's written installation instructions for shrinkage-resistant grouts.

- C. Maintain erection tolerances of structural steel within AISC's "Code of Standard Practice for Steel Buildings and Bridges."
- D. Align and adjust various members that form part of complete frame or structure before permanently fastening. Before assembly, clean bearing surfaces and other surfaces that will be in permanent contact with members. Perform necessary adjustments to compensate for discrepancies in elevations and alignment.
  - 1. Level and plumb individual members of structure.
  - 2. Make allowances for difference between temperature at time of erection and mean temperature when structure is completed and in service.
- E. Splice members only where indicated.
- F. Do not use thermal cutting during erection unless approved by Engineer. Finish thermally cut sections within smoothness limits in AWS D1.1.
- G. Do not enlarge unfair holes in members by burning or using drift pins. Ream holes that must be enlarged to admit bolts.
- H. Shear Connectors: Prepare steel surfaces as recommended by manufacturer of shear connectors. Use automatic end welding of headed-stud shear connectors according to AWS D1.1 and manufacturer's written instructions.

### **3.04 FIELD CONNECTIONS**

- A. High-Strength Bolts: Install high-strength bolts according to RCSC's "Specification for Structural Joints Using ASTM A 325 Bolts" for type of bolt and type of joint specified.
  - 1. Joint Type: Snug tightened, Pretensioned, or Slip critical as indicated on Drawings.
- B. Weld Connections: Comply with AWS D1.1 and AWS D1.8 for tolerances, appearances, welding procedure specifications, weld quality, and methods used in correcting welding work.
  - 1. Comply with AISC 303 and AISC 360 for bearing, alignment, adequacy of temporary connections, and removal of paint on surfaces adjacent to field welds.
  - 2. Remove backing bars or runoff tabs where indicated, back gouge, and grind steel smooth.
  - 3. Assemble and weld built-up sections by methods that will maintain true alignment of axes without exceeding tolerances in AISC's "Code of Standard Practice for Steel Buildings and Bridges" for mill material.

### **3.05 FIELD QUALITY CONTROL**

- A. Testing Agency: See Section 01 45 23.
- B. Correct deficiencies in Work that test reports and inspections indicate does not comply with the Contract Documents.

### **3.06 REPAIRS AND PROTECTION**

- A. Galvanized Surfaces: Clean areas where galvanizing is damaged or missing and repair galvanizing to comply with ASTM A 780.
- B. Touchup Painting: Immediately after erection, clean exposed areas where primer is damaged or missing and paint with the same material as used for shop painting to comply with SSPCPA1 for touching up shop-painted surfaces.
  - 1. Clean and prepare surfaces by SSPC-SP 2 hand-tool cleaning or SSPC-SP 3 power-tool cleaning.

END OF SECTION 05 12 00



## **SECTION 05 31 23 - STEEL ROOF DECKING**

---

### **PART 1 - GENERAL**

#### **1.01 RELATED DOCUMENTS**

- A. Drawings and general provisions of the Contract, including Division 01 General Requirements and NCISD Procurement and Contracting Requirements, apply to this Section.

#### **1.02 SUMMARY**

- A. Section Includes:
  - 1. Roof deck.
  - 2. Acoustical roof deck.
  - 3. Non-composite vented roof deck.
- B. Related Requirements:
  - 1. Section 01 45 23 "Structural Testing and Inspection Services"
  - 2. Section 05 12 00 "Structural Steel Framing".
  - 3. Section 05 50 00 "Metal Fabrications".

#### **1.03 REFERENCES**

- A. Comply with applicable provisions of the following specifications and documents. The latest adopted edition of all standard referenced in this section shall apply, unless noted otherwise.
  - 1. AWS D1.1 – Structural Welding Code
  - 2. AWS D1.3 – Structural Welding Code – Sheet Steel
  - 3. SDI – Design Manual
  - 4. SSPC – Painting Manual
  - 5. UL – Fire Resistance Directory
  - 6. ICBO – Product Evaluation Reports
  - 7. FM – Roof Assembly Classifications
- B. In the case of conflict between the Contract Documents and a referenced standard, the Contract Documents shall govern. In the case of a conflict between the Contract Documents and the Building Code, the more stringent shall govern.

#### **1.04 ACTION SUBMITTALS**

- A. Product Data: For each type of deck, accessory, and product indicated.
- B. Shop Drawings:
  - 1. Include layout and types of deck panels, anchorage details, reinforcing channels, pans, cut deck openings, special jointing, accessories, and attachments to other construction.

#### **1.05 INFORMATIONAL SUBMITTALS**

- A. Welding certificates.
- B. Product Certificates: For each type of steel deck.
- C. Product Test Reports: Based on evaluation of comprehensive tests performed by a qualified testing agency, indicating that each of the following complies with requirements:
  - 1. Power-actuated mechanical fasteners.
  - 2. Acoustical roof deck.
- D. Evaluation Reports: For steel deck.
- E. Field quality-control reports.

## **1.06 QUALITY ASSURANCE**

- A. Testing Agency Qualifications: Refer Section 01 45 23.
- B. Welding Qualifications: Qualify procedures and personnel according to AWS D1.3, "Structural Welding Code - Sheet Steel."
- C. FM Global Listing: Provide steel roof deck evaluated by FM Global and listed in its "Approval Guide, Building Materials" for Class 1 fire rating and Class 1-90 windstorm ratings.

## **1.07 DELIVERY, STORAGE, AND HANDLING**

- A. Protect steel deck from corrosion, deformation, and other damage during delivery, storage, and handling.
- B. Stack steel deck on platforms or pallets and slope to provide drainage. Protect with a waterproof covering and ventilate to avoid condensation.
  - 1. Protect and ventilate acoustical cellular roof deck with factory-installed insulation to maintain insulation free of moisture.

## **PART 2 - PRODUCTS**

### **2.01 PERFORMANCE REQUIREMENTS**

- A. AISI Specifications: Comply with calculated structural characteristics of steel deck according to AISI's "North American Specification for the Design of Cold-Formed Steel Structural Members."
- B. Fire-Resistance Ratings: Comply with ASTM E 119; testing by a qualified testing agency. Identify products with appropriate markings of applicable testing agency.
  - 1. Indicate design designations from UL's "Fire Resistance Directory" or from the listings of another qualified testing agency.
- C. Recycled Content of Steel Products: Postconsumer recycled content plus one-half of pre-consumer recycled content not less than 25 percent.
- D. Low-Emitting Materials: Paints and coatings shall comply with the testing and product requirements of the California Department of Health Services' "Standard Practice for the Testing of Volatile Organic Emissions from Various Sources Using Small-Scale Environmental Chambers."

### **2.02 ROOF DECK**

- A. Manufacturers: Subject to compliance with requirements, provide products by one of the following:
  - 1. ASC Profiles, Inc.; a Blue Scope Steel company.
  - 2. Canam United States; Canam Group Inc.
  - 3. CMC Joist & Deck.
  - 4. Consolidated Systems, Inc.; Metal Dek Group.
  - 5. Cordeck.
  - 6. DACS, Inc.
  - 7. Epic Metals Corporation.
  - 8. Marlyn Steel Decks, Inc.
  - 9. New Millennium Building Systems, LLC.
  - 10. Nucor Corp.; Vulcraft Group.
  - 11. Roof Deck, Inc.
  - 12. Valley Joist; Subsidiary of EBSCO Industries, Inc.
  - 13. Verco Manufacturing Co.
  - 14. Wheeling Corrugating Company; Div. of Wheeling-Pittsburgh Steel Corporation.

- B. Roof Deck: Fabricate panels, without top-flange stiffening grooves, to comply with "SDI Specifications and Commentary for Steel Roof Deck," in SDI Publication No. 31, and with the following:
1. Prime-Painted Steel Sheet: ASTM A 1008, Structural Steel (SS), Grade 40 minimum, shop primed with manufacturer's standard baked-on, rust-inhibitive primer.
    - a. Color: Manufacturer's standard.
  2. Galvanized-Steel Sheet: ASTM A 653, Structural Steel (SS), Grade 40, G60 zinc coating.
  3. Galvanized and Shop-Primed Steel Sheet: ASTM A 653, Structural Steel (SS), Grade 40, G60 zinc coating; cleaned, pretreated, and primed with manufacturer's standard baked-on, rust-inhibitive primer.
    - a. Color: Manufacturer's standard.
  4. Deck Profile: As indicated on plan.
  5. Profile Depth: As indicated on plan.
  6. Design Uncoated-Steel Thickness: As indicated in Structural General Notes.
  7. Span Condition: Triple span or more.
  8. Side Laps: Overlapped or interlocking seam at Contractor's option.

## **2.03 ACOUSTICAL ROOF DECK**

- A. Manufacturers: Subject to compliance with requirements, provide products by one of the following:
1. ASC Profiles, Inc.; a Blue Scope Steel company.
  2. Canam United States; Canam Group Inc.
  3. CMC Joist & Deck.
  4. Consolidated Systems, Inc.; Metal Dek Group.
  5. Cordeck.
  6. DACS, Inc.
  7. Epic Metals Corporation.
  8. Marlyn Steel Decks, Inc.
  9. New Millennium Building Systems, LLC.
  10. Nucor Corp.; Vulcraft Group.
  11. Roof Deck, Inc.
  12. Wheeling Corrugating Company; Div. of Wheeling-Pittsburgh Steel Corporation.

## **2.04 NON-COMPOSITE VENTED ROOF DECK**

- A. Manufacturers: Subject to compliance with requirements, provide products by one of the following:
1. ASC Profiles, Inc.; a Blue Scope Steel company.
  2. Canam United States; Canam Group Inc.
  3. CMC Joist & Deck.
  4. Consolidated Systems, Inc.; Metal Dek Group.
  5. Marlyn Steel Decks, Inc.
  6. New Millennium Building Systems, LLC.
  7. Nucor Corp.; Vulcraft Group.
  8. Roof Deck, Inc.
  9. Verco Manufacturing Co.
  10. Wheeling Corrugating Company; Div. of Wheeling-Pittsburgh Steel Corporation.
- B. Non-composite Vented Roof Deck: Fabricate ribbed- and vented-steel sheet non-composite form-deck panels to comply with "SDI Specifications and Commentary for Non-composite Steel Form Deck," in SDI Publication No. 31, and with the following:
1. Galvanized-Steel Sheet: ASTM A 653, Structural Steel (SS), Grade 40, G60 zinc coating.
  2. Profile Depth: As indicated in Structural General Notes.

3. Design Uncoated-Steel Thickness: As indicated in Structural General Notes.
4. Span Condition: Triple span or more.
5. Side Laps: Overlapped or interlocking seam at Contractor's option.
6. Vent Slot Area: Manufacturer's standard vent slots providing 1-1/2.

## **2.05 ACCESSORIES**

- A. General: Provide manufacturer's standard accessory materials for deck that comply with requirements indicated.
- B. Mechanical Fasteners: Corrosion-resistant, low-velocity, power-actuated or pneumatically driven carbon-steel fasteners; or self-drilling, self-threading screws.
- C. Side-Lap Fasteners: Corrosion-resistant, hexagonal washer head; self-drilling, carbon-steel screws, No. 10 minimum diameter.
- D. Flexible Closure Strips: Vulcanized, closed-cell, synthetic rubber.
- E. Miscellaneous Sheet Metal Deck Accessories: Steel sheet, minimum yield strength of 33,000 psi, not less than 0.0359-inch design uncoated thickness, of same material and finish as deck; of profile indicated or required for application.
- F. Pour Stops and Girder Fillers: Steel sheet, minimum yield strength of 33,000 psi, of same material and finish as deck, and of thickness and profile recommended by SDI Publication No. 31 for overhang and slab depth unless otherwise indicated.
- G. Column Closures, End Closures, Z-Closures, and Cover Plates: Steel sheet, of same material, finish, and thickness as deck unless otherwise indicated.
- H. Weld Washers: Uncoated steel sheet, shaped to fit deck rib, 0.0598 inch thick, with factory punched hole of 3/8-inch minimum diameter.
- I. Flat Sump Plates: Single-piece steel sheet, 0.0747 inch thick, of same material and finish as deck. For drains, cut holes in the field.
- J. Recessed Sump Pans: Single-piece steel sheet, 0.0747 inch thick, of same material and finish as deck, with 3-inch- wide flanges and sloped recessed pans of 1-1/2-inch minimum depth. For drains, cut holes in the field.
- K. Galvanizing Repair Paint: ASTM A 780.
- L. Repair Paint: Manufacturer's standard rust-inhibitive primer of same color as primer.

## **PART 3 - EXECUTION**

### **3.01 EXAMINATION**

- A. Examine supporting frame and field conditions for compliance with requirements for installation tolerances and other conditions affecting performance.
- B. Proceed with installation only after unsatisfactory conditions have been corrected.

### **3.02 INSTALLATION, GENERAL**

- A. Install deck panels and accessories according to applicable specifications and commentary in SDI Publication No. 31, manufacturer's written instructions, and requirements in this Section.
- B. Install temporary shoring before placing deck panels if required to meet deflection limitations.
- C. Locate deck bundles to prevent overloading of supporting members.
- D. Place deck panels on supporting frame and adjust to final position with ends accurately aligned and bearing on supporting frame before being permanently fastened. Do not stretch or contract side-lap interlocks.

- E. Place deck panels flat and square and fasten to supporting frame without warp or deflection.
- F. Cut and neatly fit deck panels and accessories around openings and other work projecting through or adjacent to deck.
- G. Provide additional reinforcement and closure pieces at openings as required for strength, continuity of deck, and support of other work.
- H. Comply with AWS requirements and procedures for manual shielded metal arc welding, appearance and quality of welds, and methods used for correcting welding work.
- I. Mechanical fasteners may be used in lieu of welding to fasten deck. Locate mechanical fasteners and install according to deck manufacturer's written instructions.
  - 1. Fasteners shall provide diaphragm shear and uplift resistance equal to or greater than welding indicated herein and on Drawings.

### **3.03 ROOF-DECK INSTALLATION**

- A. Fasten roof-deck panels to steel supporting members by arc spot (puddle) welds of the surface diameter indicated or arc seam welds with an equal perimeter that is not less than 1-1/2 inches long, and as follows:
  - 1. Weld Diameter: As indicated on Structural Plans.
  - 2. Weld Spacing: As indicated on Structural Plans.
  - 3. Weld Washers: Install weld washers at each weld location if deck gauge is lighter than 22 gauge.
- B. Side-Lap and Perimeter Edge Fastening: Fasten side laps and perimeter edges of panels between supports, at intervals shown on Structural Plans:
  - 1. Mechanically fasten with self-drilling, No. 10 diameter or larger, carbon-steel screws.
  - 2. Fasten with a minimum of 1-1/2-inch- long welds.
- C. End Bearing: Install deck ends over supporting frame with a minimum end bearing of 1-1/2 inches, with end joints as follows:
  - 1. End Joints: Lapped 2 inches minimum or butted at Contractor's option.
- D. Roof Sump Pans and Sump Plates: Install over openings provided in roof deck and weld or mechanically fasten flanges to top of deck. Space welds or mechanical fasteners not more than 12 inches apart with at least one weld or fastener at each corner.
  - 1. Install reinforcing channels or zees in ribs to span between supports and weld or mechanically fasten.
- E. Miscellaneous Roof-Deck Accessories: Install ridge and valley plates, finish strips, end closures, and reinforcing channels according to deck manufacturer's written instructions. Weld or mechanically fasten to substrate to provide a complete deck installation.
  - 1. Weld cover plates at changes in direction of roof-deck panels unless otherwise indicated.

### **3.04 FIELD QUALITY CONTROL**

- A. Testing Agency: See Section 01 45 23.
- B. Field welds will be subject to inspection.
- C. Testing agency will report inspection results promptly and in writing to Contractor and Architect.
- D. Remove and replace work that does not comply with specified requirements.
- E. Additional inspecting, at Contractor's expense, will be performed to determine compliance of corrected work with specified requirements.

### **3.05 PROTECTION**

- A. Galvanizing Repairs: Prepare and repair damaged galvanized coatings on both surfaces of deck with galvanized repair paint according to ASTM A 780 and manufacturer's written instructions.
- B. Repair Painting: Wire brush and clean rust spots, welds, and abraded areas on both surfaces of prime-painted deck immediately after installation, and apply repair paint.
  - 1. Apply repair paint, of same color as adjacent shop-primed deck, to bottom surfaces of deck exposed to view.
- C. Provide final protection and maintain conditions to ensure that steel deck is without damage or deterioration at time of Substantial Completion.

END OF SECTION 05 31 23

## **SECTION 27 15 00 - COMMUNICATIONS HORIZONTAL CABLING**

### **PART 1 - GENERAL**

#### **1.01 SUMMARY**

- A This section of the horizontal cabling portion of a structured cabling system includes:
  - 1. UTP Copper cabling
  - 2. Termination and patch cables
- B Provide all horizontal cabling, terminating hardware, adapters, and cross-connecting hardware necessary to interconnect all system equipment including equipment located in communications rooms.
- C Related Sections
  - 1. Section 27 02 00 - Basic Materials and Methods for Communications Systems
  - 2. Section 27 05 26 - Grounding and Bonding for Communications Systems
  - 3. Section 27 05 28 - Pathways for Communications Systems
  - 4. Section 27 11 00 - Communications Room Fittings

#### **1.02 REFERENCES**

- A The publications listed below form a part of this specification. The publications are referred to in the text by basic designation only.
- B Specific reference in specifications to codes, rules, regulations, standards, manufacturer's instructions, or requirements of regulatory agencies shall mean the latest printed edition of each in effect at the date of contract unless the document is shown dated.
- C Conflicts
  - 1. Refer to section 27 02 00.
- D Codes and Standards
  - 1. Refer to section 27 02 00.

#### **1.03 SUBMITTALS**

- A Refer to sections 27 02 00 and 27 13 00.

#### **1.04 QUALITY ASSURANCE**

- A Refer to section 27 02 00.

## **1.05 DELIVERY, STORAGE, AND HANDLING**

- A Refer to sections 27 02 00 and 27 13 00.
- B Storage temperature range: -40°F to 149°F (-40°C to 65°C)

## **1.06 PROJECT/SITE CONDITIONS**

- A Refer to section 27 02 00.

## **1.07 WARRANTY**

- A Refer to section 27 02 00.

## **1.08 MAINTENANCE AND SUPPORT**

- A Refer to section 27 13 00

## **PART 2 - PRODUCTS**

### **2.01 ACCEPTABLE MANUFACTURERS**

- A Labeling
  - 1. Refer to section 27 02 00.
- B Firestopping
  - 1. Refer to section 27 02 00.

### **2.02 ACCEPTABLE COPPER MANUFACTURERS**

- A UTP Plenum Rated Cable Cat6 /Cat 6A
  - 1. Commscope CS34P - 6 U/UTP Cable, plenum - Color Coded by System
    - a. Data / IP Phone - Blue - CS34P BLU C6 4/23 U/UTP CPK 1KFT
    - b. **Wireless (AP) - Blue- CS44P BLU C6A 4/23 U/UTP CPK 1KFT**
    - c. Access Control/Intrusion - Yellow - CS34P YEL C6 4/23 U/UTP CPK 1KFT
    - d. **Video Surveillance(Cameras)- Purple/Violet - CS44P VLT C6A 4/23 U/UTP CPK 1KFT**
    - e. Intercom - White - CS34P WHT C6 4/23 U/UTP CPK 1KFT
    - f. Fire Alarm - Red - CS34P RED C6 4/23 U/UTP CPK 1KFT
    - g. Building Controls/HVAC - Grey - CS34P GRY C6 4/23 U/UTP CPK 1KFT
    - h. Audio-Video Systems(Projectors/TV/Sound System) - Green - CS34P GRN C6 4/23 U/UTP CPK 1KFT



2. Owner approved alternate
- B Data/Voice Outlet Components Cat6**
1. **Commscope -UKJ600(Cat6) UKJ10G(Cat6A) - Color Coded by Ssystem**
    - a. Data/IP Phones - Orange -**760257280 | UKJ600-OR**
    - b. **Wireless(AP) CAT 6A - Blue - 760257290 | UKJ10G-BL**
    - c. Access Control/Intrusion - Yellow - **760257283 | UKJ600-YL**
    - d. **Video Surveillance(Cameras) CAT6A - Purple/Violet - 760241168-UKJ10G-VL**
    - e. Intercom - White - **760237652 | UKJ600-P.WH**
    - f. Fire Alarm- Red - **760257282 | UKJ600-RD**
    - g. Building Controls/HVAC - Grey -**760237658 | UKJ600-GY**
    - h. Audio Video Systems (Projectors/TV/Sound System) - Green -**760257284 | UKJ600-GN**
    - 1) **ALL CAT6/CAT6A JACKS ARE TO BE TERMINATED USING COMMSCOPE MODULAR JACK LACING TERMINATION TOOL KIT.**
    - i. Or owner approved alternates
  2. Owner approved alternate
- C Patch Panels (24 or 48 port)**
1. Comm
    - a. ~~24-Port CPP-UDDM-KJ-1U-24~~
    - b. 48-Port CPP-UDDM-KJ-2U-48
      - 1) **General Data , Access Point , Video Surveillance Category cabling is to be terminated on seperate 48 port patch panels. Each systems Category cabling is to receive dedicated patch panels**
      - 2) **Fire Alarm, BAS, Instrusion detection, Access Control and intercom sytems Category cabling may be combined to a single patch panel.**
    - c. Or owner approved alternates
  2. Owner approved alternate
- D Copper Patch Cords Cat6 Pre-assembled**

1. Commscope - Color Coded by Ssystem
  - a. Data/IP Phones -
    - 1) MDF/IDF - Black - 1' - UC1BBB2-01F001
    - 2) Workstations/Field - Blue - 15' - UC1BBB2-0ZF015
  - b. Wireless(AP) (**Cat 6A**)
    - 1) MDF/IDF- Blue- 1' - ~~UC1BBB2-0ZF001~~ **UC1AAA2 | UC1AAA2-0ZF001**
    - 2) Workstations/Field- Blue - 15' - ~~UC1BBB2-0ZF015~~ **UC1AAA2 | UC1AAA2-0ZF015**
  - c. Access Control/Intrusion
    - 1) MDF/IDF - Yellow - 1' - UC1BBB2-09F001
    - 2) Workstations/Field -Yellow - 15' - UC1BBB2-09F015
  - d. Video Surveillance(Cameras)(**CAT 6A**)
    - 1) MDF/IDF - Purple/Violet - 1' - ~~UC1BBB2-0LF001~~ **UC1AAA2 | UC1AAA2-0LF001**
    - 2) Workstations/Field -Purple/Violet - 15' - ~~UC1BBB2-0LF015~~ **UC1AAA2 | UC1AAA2-0LF015**(Coordinate length with Div 28 prior to ordering)
  - e. Intercom
    - 1) MDF/IDF - White- 1' - UC1BBB2-08F001
    - 2) Workstations/Field- White - 15' - UC1BBB2-08F015
  - f. Fire Alarm
    - 1) MDF/IDF - Red - 1' - UC1BBB2-07F001
    - 2) Workstations/Field- Red - 15' -UC1BBB2-07F015
  - g. Building Controls/HVAC
    - 1) MDF/IDF - Grey - 1' - UC1BBB2-0CF001
    - 2) Workstations/Field- Grey - 15' -UC1BBB2-0CF015
  - h. Audio Video Systems (Projectors/TV/Sound System)
    - 1) MDF/IDF - Green - 1' - UC1BBB2-0MF001
    - 2) Workstations/Field- Black - 15' -UC1BBB2-01F015
  - i. **Outdoor Cameras / Access Points (Cat 6A OSP)**

- 1) **CommScope CAT 6, F/UTP, Outdoor Rated Patch Cord - CO11152 | CO11152-01F015 (Coordinate length with Div 28 prior to ordering)**
- 2) Or owner approved equivalent.

**E Biscuit Boxes**

1. Commscope
  - a. 1-Port - SMB-1P-266
  - b. 2-Port - SMB-2P-266
  - c. Or owner approved alternate

**F Ceiling Connector Assemblies**

1. **CommScope CCA-Cat6A-Plenum-White**
2. **Or owner approved equivalent**

**G Wall and/or Rack Mount 110 Termination Blocks**

1. Commscope
2. Leviton
3. Owner approved alternate

**H Faceplate for wall-mount telephones**

1. Commscope 760100891 | M10LW4SP
2. Owner approved alternate

**2.03 ACCESSORIES**

- A Mount one laminated full-size hard copy in color of an as-built floor plan designating workstation locations, pathways, and communications room locations. Confirm hard copy size with Owner.
- B Provide clear plastic lamination serving each communication room.
- C Install the laminated drawings within a protective Plexiglas encasement on the wall of the servicing communications rooms. To ease accessibility the Plexiglas encasement shall be in either flip-down format or file folder format.

**2.04 HORIZONTAL COPPER CABLING**

- A Recognized cabling for providing the signal medium from the work area to the communications room shall include the following:
  1. Category 6 UTP cable

## B Category 6 UTP Cable Requirements

1. 23/24 AWG solid bare copper.
2. Cable jacket shall comply with NEC Article 800 for use as a plenum cable and shall be UL and c (UL) Listed Type CMP (communications multipurpose plenum).
3. Cable shall terminate on an eight-pin modular jack at each outlet. All horizontal cabling shall meet or exceed the ANSI/TIA-568-C.2 Commercial Building Telecommunications Cabling Standard, Part 2: Balanced Twisted Pair Cabling Components.
4. Cables shall be marked as UL verified with a minimum of Category 6 rating.
5. The cable shall support Voice, Analog Base band Video/Audio, Fax, Modem, Switched-56, T-1, ISDN, RS-232, RS-422, RS-485, 10BASE-T Ethernet, Token Ring, 100Mbps TP-PMD, 100BASE-T Ethernet, 155 Mbps ATM, AES/EBU Digital Audio, 270 Mbps Digital Video, 622 Mbps 64-CAP ATM and emerging high-bandwidth applications, including 1 Gbps Ethernet, gigabit ATM, as well as all 77 channels (550 Mhz) of analog broadband video.
6. The maximum horizontal cable tested length for Category 6 copper cable from the termination of the cable in the communications room to the outlet is 295'-0". It's contractor's responsibility to reroute as necessary to bring all cable runs within distance limit without additional cost to the project. Plan ahead and get approval or exception from Owner before pulling the cables that would ne over the distance limit.
7. Cable shall meet or exceed the following electrical characteristics:
  - a. Cable shall be specified to 250 MHz. Cable shall meet the manufacturer's guaranteed electrical performance and physical specifications.

## 2.05 TERMINATION HARDWARE

### A Patch panels

1. Patch panels shall be rated to match installed cable plant
2. The wiring block shall accommodate #23 AWG cable conductors.
3. All modular cross connect panels shall be UL-listed.

### B Work Area Outlet Faceplates:

1. ~~CommScope~~ **Leviton** - 4-Port - 43080-1L4 - QP SS wallplate w/id single gang 4 port
2. ~~CommScope~~ **Leviton** - 6-Port - 43080-1L6 - QP SS wallplate w/id single gang 6 port

## 2.06 PATCH CABLES

### A Verify exact quantities and lengths with Owner prior to purchase

- B Patch Cable requirements:
1. Category 6, stranded UTP cable
  2. **Category 6A , stranded UTP cable (Access Points,Cameras)**
  3. **Color coded by system. Reference Colors and part numbers in Section 2.02**
  4. Standard modular non-keyed, 8-position 8-conductor plug
  5. 94V-0 rated
  6. UL listed
  7. Meets FCC Part 68
- C Provide 3'-0", 5'-0", 7'-0", and 10'-0" Patch Cords at the communications room for each installed port.
1. Coordinate with Owner on the active equipment layout prior to purchase to ensure correct sizing of patch cords from patch panels to switching equipment.
  2. When connecting voice ports to a copper riser, provide a one-pair stranded 8P8C connector on one end and 110GS on the other end and shall be of appropriate length for application.
- D Provide a 10'-0" Station Cord for each work area outlet port.
- E Place each size/length patch cord in a separate container, and mark the containers that hold the patch cords with the length of patch cords contained within.
- F All cords shall conform to the requirements of ANSI/TIA-568-C.2 Commercial Building Telecommunications Cabling Standard, Horizontal Cabling Section, and be part of the UL LAN Certification and Follow-up Program.
- G Cords shall be equipped with an eight-pin modular connector on each end, wired straight through and shall be of appropriate length for application.
- H All rated patch cords shall be round, and consist of #23 AWG copper, stranded conductors, tightly twisted into individual pairs.
- I Patch cords shall be made and warranted by the manufacturer of the cabling system installed in this project and shall meet or exceed patch cord specifications as outlined in TIA standards.

## **2.07 IDENTIFICATION (LABELING) SYSTEM**

- A Refer to sections 27 02 00 and 27 13 00.

## **PART 3 - EXECUTION**

### **3.01 EXAMINATION**

### **3.02 PREPARATION**

- A Refer to section 27 02 00.
- B The Contractor shall check pathways, raceways, and other elements for compliance with space allocations, installation tolerances, debris, hazards to cable installation, and other conditions affecting installation prior to installation.

### **3.03 INSTALLATION REQUIREMENTS**

- A Refer to section 27 02 00.
- B All installation shall be done in conformance with ANSI/TIA-568-C standards, BICSI methods, industry standards and manufacturer's installation guidelines.
  - 1. The Contractor shall ensure that the maximum pulling tensions of the specified distribution cables are not exceeded and cable bends maintain the proper radius during the placement of the facilities.
  - 2. Failure to follow the appropriate guidelines shall require the Contractor to provide in a timely fashion the additional material and labor necessary to properly rectify the situation.
  - 3. This shall also apply to any and all damages sustained to the cables by the Contractor during the implementation.
- C Install cable using techniques, practices, and methods that are consistent with specified data cabling and the installed components and that ensure specified performance levels of completed and linked signal paths, end to end.
  - 1. Pull cables in smooth and regular motions using methods that prevent cable kinking.
  - 2. Pull cables simultaneously if more than one is being installed in the same raceway/pathway.
  - 3. If necessary, use approved cable pulling lubricant
  - 4. Use fish tape, cable, rope, basket weave wire/cable grips, and other tools that will ensure no damage to the media or raceway.
  - 5. Install open cabling parallel and perpendicular to surfaces or structural members following surface contours where possible.
  - 6. Do not bend cable greater than a bend radius of 0'-1".
- D Provide a 10'-0" service loop at the communications room and shall provide a 3'-0" service loop above the access ceiling or cable trays unless specified otherwise.

1. All service loops shall be a minimum of 1'-6" (18") in diameter and be accessible for maintenance.
- E Coordinate loop placement and orientation with the technology consultant.
  1. This allows for future changes or expansion without installing new cables.
- F Install cables in continuous "home run" lengths from work station outlet to specified patch panel.
  1. No intermediate punch down blocks or splices may be installed or utilized between the communications rooms and the workstation outlet without written Owner permission.
- G All cable must be handled with care during installation so as not to change performance specifications.
  1. Factory twists of each individual pair must be maintained up to the connection points at both ends of the cable.
  2. There shall never be more than 0'-1/2" of unsheathed cable at either the wiring closet or the workstation termination locations.
- H All cabling and associated hardware shall be placed so as to make efficient use of available space.
  1. All cabling and associated hardware shall be placed so as not to impair equipment's efficient use of their full capacity.

### **3.04 CABLING METHODS**

- A The Contractor shall provide cabling in accessible spaces, cable tray, (surface and/or enclosed raceway), conduits, and/or J-Hook cable support system.
  1. Within consoles, racks, cabinets, desks, and counters, in accessible ceilings spaces and in gypsum board partitions where open cable method may be used.
  2. Use UL or ETL listed plenum rated cable in all spaces.
  3. Provide all necessary installation materials, hardware, tools and equipment to perform insulation displacement type terminations at all data outlets, patch panels, and voice termination materials.
- B Conceal raceway and cabling except in unfinished spaces as is practical.
- C Exposed Cable
  1. All station cabling shall be installed inside walls or ceiling spaces whenever possible.
  2. Exposed station cable will only be run where indicated on the drawings and will only be allowed when no other options exist.

- a. Owner must approve all exceptions.
- D The Contractor shall utilize conduits/cable tray as indicated on the drawings.
- E All cabling placed above drop ceilings must be supported by cable tray, J-hooks, caddy bags or conduit.
  - 1. The Contractor shall permanently affix cable supports to the building structure or substrates and provide attachment hardware and anchors designed for the structure to which attached and are suitably sized to sustain the weight of the cables to be supported.
    - a. Attaching cable to pipes or other mechanical items is not permitted.
    - b. Cabling shall not be attached to ceiling grid wires.
  - 2. Multiple cables are to be dressed every 5'-0" to 7'-0".
    - a. Maximum cable sag between cable hooks is 3"-6".
- F The Contractor shall route data and voice cables separately in a neat and orderly fashion.
  - 1. No cable ties or wraps shall be used to secure the cables in the runway outside of the communications rooms. Cable ties shall be rated for the environment.
- G Keep all items protected before and after installation with dust and moisture proof barrier materials/envelopes.
- H If wiring is terminated on patch panels, data, voice jacks prior to painting, carpet installation, and general finish clean up, these jacks shall be placed in a protective envelope to ensure dust, debris, moisture, and other foreign material do not settle onto jacks' contacts.
  - 1. Envelope will be removed on final trim out after other trades have completed their finish work.
  - 2. It shall be the Contractor's responsibility to ensure the integrity of these protective measures throughout the life/installation of the project.
    - a. Cable bundles brought into the communications rooms shall be routed and dressed in such a manner that prior to termination the cables are not subject to damage and misuse such as installers walking on the bundles that are on the floor.
    - b. Cable pulling force shall not exceed 25 lbs of pulling tension or cable manufacturer's recommended pulling tensions.
    - c. Do not leave cables on the floor unprotected or cable bundles hanging from the ceilings. Coil them up in a temporary manner and protect them from damage.



- I Communications room cables shall be combed and dressed in a manner as to prevent twists, “braiding” and crossed cables in the cable bundle from the communication room entrance to the termination point at the rear of the patch panel.
  - 1. Behind the patch panel, the cable bundle shall be attached to the rear cable support bar, and shall drop out each cable in a neat, cascading manner to prevent crossed and/or interwoven cables to each patch panel port termination point.
    - a. Use Velcro wraps instead of cables ties for all bundling in the communications rooms.
    - b. Plastic/nylon tie-wraps are not allowed to permanently secure cables inside the communications room.

### **3.05 CABLING SEPARATION**

- A Comply with TIA rules for separating unshielded copper communication and data-processing equipment cables from potential EMI sources, including electrical power lines and equipment.
- B Maintain a minimum spacing of 1’-6” (18”) from electrical feeders and/or branch circuit wiring including, but not limited to, light fixtures, sources of heat and EMI sources.
- C Maintain a minimum spacing of 1’-0” from auxiliary systems cabling.
- D Maintain a 1’-0” separation where cables must pass perpendicularly to electrical, plumbing, or other wiring, conduit, or piping systems.
  - 1. Use non-conduit bushings, if necessary to maintain separation, which allow for the addition of a reasonable number of cables in the future.
- E Maintain communications pathways away from electrical apparatus such as motor driven equipment and transformers, minimum separation distance of 10’-0” is recommended.

### **3.06 CABLING TERMINATION**

- A All terminations shall be done with lacing tool.
- B Terminate cables in consistent consecutive order.
- C Terminate cables onto 8P8C modular patch panels without damaging twisted pairs or jacket.
- D Arrange cables on patch panels and voice termination hardware in ascending order of room numbers and outlet numbers within rooms.
- E Provide a 10’-0” service loop for horizontal cables at each rack in communications rooms.
  - 1. Locate loop at ceiling deck or on bottom of cable runway in minimum 1’-6” (18”) diameter.

- F Provide a 3' service loop for horizontal cables at work area outlets. Locate service loop above or below data/voice outlet where vertical cable run transitions to horizontal run.
- G **At locations where Plenum rated cabling is converted to OSP rated. Contractor shall provide 3' service loop on each side of the conversion. 3' service loop of plenum rated cable. 3' service loop of OSP rated cable.**
- H Maintain twists in cable pairs to within 0'-1/2" of termination.
- I Building Systems Cabling (BAS, FA, elevator line, etc)
  - 1. Coordinate exact placement and connectivity requirements with applicable trade prior to installation.
  - 2. Group all building systems cables in one group.
  - 3. Clearly label cable number and function, in the last positions on the horizontal cabling blocks in each communications room.
- J Limit cable-bending radius to 20X the cable diameter during installation, and 15X the cable diameter after installation.
- K Start numbering at the left of the main door to the room and continue in a clockwise direction around the room.
  - 1. The cables within the room will be terminated starting with the cables located to the left of the main door to the room and continue around the room in a clockwise direction.

### **3.07 TERMINATION HARDWARE**

#### **A Station Hardware**

- 1. Flush mount jacks shall be mounted in a faceplate with back box.
- 2. Outlets shall not be mounted on temporary, movable, or removable surfaces, doors, or access hatches without prior Owner approval.
- 3. 8P8C Jack Pin Assignments for work area outlets shall match the T-568B wiring scheme.

#### **B Patch panels**

- 1. Copper cables shall be terminated in eight position/eight conductor (8P8C) modular patch panels.
- 2. All Modular jack panels shall match the T-568B wiring scheme.

#### **C Work Area Outlet**

- 1. 8P8C non-keyed modular outlets for applications up to one Gbps and ANSI/TIA-568-C compliant for the specified transmission requirements

D Work Area Outlet Faceplates:

1. Furnish and install blank plates in all unused ports.

### 3.08 SPECIAL CIRCUITS

A The Contractor shall coordinate with the Owner on the cable termination plan for special circuits, including cables to wireless access point locations, security, elevators, fire alarms, etc.

B Wireless Access Points

1. Install ~~two (2)~~**One (1) Cat6A cable** from dedicated wireless patch panel(s) in communications room to outlets having 8P8C connectors within a BISCUIT box.
2. Enclosures shall be NEMA rated for the environment to which they are exposed.
3. 30'-0" of cable slack shall be coiled and hung on a "J"-hook at the enclosure location.

### 3.09 IDENTIFICATION AND LABELING

A Labeling system shall consist of a hand-held portable printer and labels appropriate to the application. Handwritten labels are not acceptable.

B Labelling scheme shall meet Owner's IT cabling standard and industry standards and best practices. Submit labelling scheme for approval before work to start.

C Fiber termination hardware (designation strip) shall have a 0'-3/4" x 0'-1/4" thermal transfer printable label with a permanent acrylic adhesive

D All labels shall be permanent and shall not fade, peel, or deteriorate due to environment or time.

E The Contractor shall provide a copy of the finalized plan in writing to the Owner representative and DBR for review and authorization to proceed.

1. Coordinate with Owner for specifications on labeling of all hardware, cabling, and related equipment prior to any testing.

F Labeling requirements:

1. Label cable terminations on designation strips
2. Label all cable at each terminating point.
3. Label each port of the work area outlet.
4. Cable identification numbers shall not be duplicated.
5. Label patch panels in the communications rooms to match those on the corresponding voice and data outlets.

- a. The font shall be at least 0'-1/8" in height.
6. Where ~~a wireless access point~~ is **any cable** is installed above an acoustical ceiling, label the ceiling grid frame below the access point, displaying the data port number and, if applicable, the access point identification number. Coordinate labeling of grid with Owner and Architect prior to application of labels.
7. Label each distribution rack, block and other terminating equipment unit and field within that unit within 0'-4" from the block or patch panel termination. Keep labels in a neat and orderly lineup.
8. Label each connector and each discrete unit of cable-terminating and connecting hardware within connector fields, in wiring closets and equipment rooms.
  - a. Where similar jacks and plugs are used for both communication and data-processing equipment, use a different color for jacks and plugs of each service.
9. Post the cable schedule in a prominent location in each wiring closet and equipment room. List incoming and outgoing cables and their designations, origins, and destinations.

G Location and termination field description

1. Room location
2. Rack-mount or Wall mount
3. Termination field type
  - a. Specific patch panel ports versus a separate dedicated patch panel

H Unique identifiers

1. Segregation and position on equipment rack
2. Port color-coding
3. Unique labeling

I Documentation

1. Provide electronic copy of final comprehensive schedules for project in software and format selected by Owner.
  - a. All labels shall correspond to as-built drawings and to final test reports.
2. All cable inventory data documentation shall be submitted in format coordinated with and approved by Owner so that data can be incorporated into existing databases.
3. Documentation shall include cable identification number, source and destination, type of cable, length of cable and number of pairs or fibers.

4. Complete cross connect documentation is required.

### **3.10 FIELD QUALITY CONTROL**

- A Refer to section 27 02 00.

### **3.11 POST-INSTALLATION TESTING**

- A Contractor shall test each pair or strand of every cable prior to acceptance. (100% PASS)
- B Contractor shall submit acceptance documentation as defined below. No cabling installation is considered complete until test results have been completed, submitted and approved.
- C Standards Compliance and Test Requirements:
  1. Cabling shall meet ANSI/TIA-568-C.2 Category 6 Horizontal cabling requirements.
- D Attenuation, NEXT, PSNEXT, Return Loss, ELFEXT, and PSELFEXT data that indicate the worst case result, the frequency at which it occurs, the limit at that point, and the margin.
  1. These tests shall be performed in a swept frequency manner from 1 MHz to highest relevant frequency, using a swept frequency interval that is consistent with TIA and ISO requirements.
  2. Information shall be provided for all pairs or pair combinations and in both directions when required by the appropriate standards.
  3. Length, propagation delay, and delay skew relative to the relevant limit.
    - a. Length, propagation delay, and delay skew shall be tested relative to the relevant limit.
    - b. Test shall also include mutual capacitance and characteristic impedance.
      - 1) Any individual test that fails the relevant performance specification shall be marked as a 'FAIL'.
- E Cable Test Documentation:
  1. Cable test documentation shall be submitted in hard copy and electronic formats.
    - a. If proprietary software is used, disk or CD shall contain any necessary software application required to view test results.
    - b. Electronic reports shall be accompanied by a Certificate signed by an authorized representative of the Contractor warranting the truth and accuracy of the electronic report.
    - c. Certificate shall reference traceable circuit numbers that match the electronic record.

2. Each test record shall contain the cable ID as follows:
  - a. “MEDIA TYPE – SOURCE ROOM – DESTINATION ROOM – STRAND/PAIR #”, e.g. MM-MC-HC23-001.
3. Test results saved within the field-test instrument shall be transferred into an accessible database utility that allows for the maintenance, inspection and archiving of the test records.
  - a. These test records shall be uploaded to the PC unaltered, i.e., “as saved in the field-test instrument”.
  - b. The file format, CSV (comma separated value), does not provide adequate protection of these records and shall not be used.
4. Test reports shall include the following information for each cabling element:
  - a. Wire map results that indicate that 100% of the cabling has been tested for shorts, opens, miss-wires, splits, polarity reversals, transpositions, presence of AC voltage and end-to-end connectivity.
  - b. Length, propagation delay, and delay skew relative to the relevant limit. Any individual test that fails the relevant performance specification shall be marked as a FAIL.
  - c. Cable manufacturer, cable model number/type, and NVP
  - d. Tester make & model, serial number, hardware version, and software version.
  - e. Cable ID and project name
  - f. Auto-test specification used
  - g. Overall pass/fail indication
  - h. Date of test

F Cable Test Equipment

1. Contractor shall supply all of the required test equipment used to conduct acceptance tests.
2. Test equipment used under this contract shall be from manufacturers that have a minimum of 5 years experience in producing field test equipment. Manufacturers shall be ISO 9001 certified.
3. Testing equipment shall be UL-verified to meet Level III accuracy.
  - a. The cable installers shall have a copy of this reference in their possession and be familiar with the contents.

4. Testing equipment shall be within the calibration period recommended by the manufacturer.
5. Testing equipment shall have the latest software and firmware installed.
6. Testing equipment of a given type shall be from the same manufacturer, and have compatible electronic results output.
7. Test adapter cables shall be approved by the manufacturer of the test equipment.
  - a. Adapter cables from other sources are not acceptable.
  - b. Adapter cables must be replaced after 1000 tests to ensure accuracy.
8. Test equipment must have a dynamic range of at least 100 dB to minimize measurement uncertainty.
9. Test equipment must be capable of storing full frequency sweep data for all tests and printing color graphical reports for all swept measurements.
10. Test equipment must include S-Band time domain diagnostics for NEXT and return loss (TDNXT and TDRL) for accurate and efficient troubleshooting.
11. Test equipment must be capable of running individual NEXT, return loss, etc measurements in addition to auto tests. Individual tests increase productivity when diagnosing faults.
12. Test equipment must include a library of cable types, sorted by major manufacturer.
13. Test equipment must be able to internally group auto tests and cables in project folders for good records management.
  - a. Test equipment must store at least 1000 auto tests in internal memory.
14. Test equipment must include DSP technology for support of advanced measurements.
15. Test equipment must make swept frequency measurements in compliance with TIA standards.
16. The measurement reference plane of the test equipment shall start immediately at the output of the test equipment interface connector.
17. There shall not be a time domain dead zone of any distance that excludes any part of the link from the measurement.
18. Acceptable testers:
  - a. Fluke DTX CableAnalyzer
  - b. Owner approved equivalent

### **3.12 CLEANING**

- A Refer to section 27 02 00.

### **3.13 ACCEPTANCE**

- A Once all work has been completed, test documentation has been submitted and approved, and the Owner is satisfied that all work has been completed in accordance with contract documents, the Owner will notify Contractor in writing of formal acceptance of the system.
- B Contractor's RCDD shall warrant in writing that 100% of the installation meets the requirements specified herein.
- C Acceptance shall be subject to completion of all work, successful post-installation testing which yields 100% PASS rating, and submittal and approval of full documentation as described above. Tests with the "\* PASS" (asterisk) will not be acceptable.
  - 1. These circuits must be repaired to meet "PASS".

**END OF SECTION 27 15 00**



# **SECTION 27 41 16 - INTEGRATED AUDIO-VIDEO SYSTEM AND EQUIPMENT**

## **PART 1 - GENERAL**

### **1.01 SUMMARY**

- A This document covers the general requirements for the installation of audio-video (AV) systems.

### **1.02 RELATED DOCUMENTS**

- A Drawings and general provisions of the Contract, including General and Supplementary Conditions and Division 1 Specification Sections, apply to this Section.
- B Related Sections
  - 1. Section 27 02 00 - Basic Materials and Methods for Communications Systems
  - 2. Section 27 05 28 - Pathways for Communications Systems
  - 3. Section 27 05 26 - Grounding and Bonding for Communications Systems
  - 4. Section 27 15 00 - Communications Horizontal Cabling

### **1.03 CODES**

- A Perform all work in strict accordance with the requirements and recommendations stated in the codes and standards except when requirements are exceeded by the contract documents.
- B The equipment, materials, and installation shall confirm to the latest version of all applicable codes, standards and regulations of authorities having jurisdiction including the following:
  - 1. NFPA 70, National Electrical Code.
  - 2. NFPA 101, Code for Safety to Life from Fire in Buildings and Structures.
  - 3. FCC Rules, Part 76.
  - 4. UL 50, Enclosures for Electrical Equipment.
  - 5. All applicable parts will be FCC Class B approved.
  - 6. All equipment, cable, devices, and accessories provided shall be listed and labeled by Underwriters Laboratories, Inc. for the intended use under the latest appropriate testing standard.
  - 7. Americans with Disabilities Act.
  - 8. Texas Accessibility Standards.

9. International Building Codes (IBC).
10. State and Local Building Codes with Amendments.
11. All requirements of the local Authority Having Jurisdiction (AHJ).

#### **1.04 REGULATIONS**

- A Comply with terms and conditions of Americans with Disabilities Act, especially regarding provisions for hearing impaired and wheelchair access in control areas.

#### **1.05 SUBMITTALS**

##### **A General**

1. Refer to Division 1 and section 27 02 00.
2. Submit in quantities, format and timetable as required by General Conditions.

##### **B Product Data Binders**

1. Minimum number of Sets: four (4) or one (1) electronic copy on CD.
2. Timetable
  - a. Submit within thirty (30) days after award of contract.
  - b. Submit simultaneously with Shop Drawings.
  - c. Allow minimum of ten (10) business days for review. All sets minus one (1) will be returned with review comments. If a resubmit is required, resubmit total quantity of complete sets. If second resubmit is required, Contractor shall reimburse Owner for expenses incurred during additional review process.
  - d. Review and approval of Product Data is required before equipment purchase and installation.
  - e. Bind product data sheets together either in GBC or 3-ring type binders.

##### **C Shop Drawings**

1. Minimum Number of Sets: four (4) or one (1) electronic copy on CD.
2. Timetable
  - a. Submit within thirty (30) days after award of contract.
  - b. Submit simultaneously with Product Data Binders.

- c. Allow minimum of ten (10) business days for review. All sets minus one (1) will be returned with review comments. If a resubmit is required, resubmit total quantity of complete sets. If second resubmit is required, Contract shall reimburse Owner for expenses incurred during additional review process.

3. Description:

- a. Shop Drawings shall be used for coordination between trades and updated as final record drawings.
- b. Bind all Shop Drawings together to form set. Loose drawings will not be accepted.
- c. Each drawing shall include: Project, Building, Location, Contractor Name, Architect, AV Consultant, Date and Revision Number.
- d. Number and title each drawing in logical manner as a set.
- e. Include cover sheet with listing of all drawings included in bound set.
- f. Ensure that labeling on Shop Drawings match labeling on equipment.
- g. Minimum Scale:
  - 1) Floor Plans: 1/8 inch = 1 foot.
  - 2) Rack Elevations: 1-½ inch = 1 foot.
  - 3) Plate/Panel Details: 6 inches = 1 foot.
  - 4) Loudspeaker Details: 1 inch = 1 foot.
- h. Include as a minimum:
  - 1) Floor plans indicating locations of all AV devices, vertical risers, pull boxes, and exposed wiring. Include Device ID (PRJ, SCREEN, FRK, FB, AVP, etc., as referenced in design contract documents), as appropriate for projectors, screens, racks, floor boxes, AV plates in walls, etc.
  - 2) Schematic diagram showing all primary and secondary devices, interconnectivity and signal flow.
  - 3) Plate details showing size, material, finish, connectors, engraving, etc.
  - 4) Mounting detail drawings of loudspeakers, racks, and overhead equipment. Hire services of professional structural engineer, licensed by the appropriate governing authority, to review shop drawings, building structural drawings, and any existing structures from which equipment is to be suspended. Include Structural Engineer's stamped report with shop drawing submittal. Report shall include:
    - (a) Itemization of items reviewed by the Structural Engineer.

- (b) Confirmation that proposed methods of suspending equipment as shown on the shop drawings conform to required safety factors.
  - (c) Confirmation that building structure from which equipment is to be suspended will support equipment including required safety factors.
- 5) Rack elevations.
  - 6) Complete schematic diagram. One-line diagram with detailed descriptions of product inputs and outputs is acceptable. Include terminal strip details and cable label information. If wiring diagram spans more than three (3) sheets, additionally provide simplified block diagram of entire system on one (1) sheet.
  - 7) Electrical power wiring diagram. Include circuit, switching, and control details.
  - 8) Wiring diagram of grounding and shielding scheme.
  - 9) Drawings for custom-fabricated items (i.e., plates, panels, cables, and assemblies).
  - 10) General construction drawings necessary for completion of work.

#### D Operation and Maintenance Manuals

- 1. Minimum number of Sets: four (4).
- 2. Bind Operation and Maintenance Manuals using either GBC or 3-ring binders.
- 3. Format and Minimum Information below:
  - a. Section 1 - System Operation.
    - 1) Introduction/overview to system components and their functions and locations. Include a brief listing of basic system functions.
    - 2) Complete but simple system operating instructions to accomplish basic system functions, written for non-technical personnel.
    - 3) Certificate indicating names of Owner personnel trained by AV Contactor, date of training, name of AV Contractor representative that provided training, and name of project.
  - b. Section 2 - System Documentation.
    - 1) Simplified system one-line schematic diagram showing changes made during construction.

- 2) Complete inventory of system components including serial numbers. Identify location (equipment rack, over stage, stored in control room, etc.) of each component.
  - 3) Cable and terminal strip documentation including cable numbers, functions, originating locations, terminating locations, and signal levels.
  - 4) All Shop Drawings corrected to reflect as-built conditions.
  - 5) Other data and drawings required during construction.
  - 6) Initial Tests and Adjustments data.
  - 7) Final Tests and Adjustments data.
  - 8) CD-ROM discs including all utilized manufacturer's software and saved copies of software configurations (configurations as established during Final Tests and Adjustments).
- c. Section 3 - Manufacturer's Documentation.
- 1) For each equipment model at no additional costs to Owner, even if manufacturer does not include costs of such documentation with purchase of equipment item.
  - 2) Manufacturer's Product Data.
  - 3) Operating instructions.
  - 4) Installation instructions.
  - 5) Service information.
  - 6) Schematic diagrams.
  - 7) Replacement parts list.
- d. Section 4 - Maintenance Information.
- 1) Preventive maintenance schedule letter clearly stating target dates of six month and end-of-warranty preventative maintenance inspections, and list of maintenance tasks performed.
  - 2) Maintenance instructions including manufacturer's recommended maintenance, recommended maintenance schedule and information concerning proper inspection, testing, and replacement of components.
  - 3) Troubleshooting information complete with instructions for procedures during equipment failure.
- e. Section 5 - Warranty Information

- 1) System warranty letter.
4. Provide three (3) sets on CD-R disc that include all material in Operation and Maintenance Manuals in PDF format except for copyrighted material.
5. Submit one (1) set of Operation and Maintenance Manuals at least ten (10) days before Final Tests and Adjustments procedures (minus data from Final Tests and Adjustments). This set will be reviewed by Owner and returned to Contractor. Re-submit after Final Tests and Adjustments and include data. NOTE: Do not schedule Final Tests and Adjustments or perform training of Owner personnel before submitting Operation and Maintenance Manual.
6. Submit remaining number of complete manuals as required by General Conditions within ten (10) days after return of reviewed set(s). Include Final Tests and Adjustment data, warranty period letter, and any other data not included in first submission.

E Samples.

1. Request for Samples - Upon request, furnish samples (at no additional cost) to Owner and/or General Contractor of submitted items proposed as substitutes for specified items. Products will be reviewed to determine if proposed substitute items meet required function and quality.
2. Product Tests
  - a. Products submitted as samples may require testing by independent laboratory. Testing at expense of Contractor.
  - b. Obtain written approval of tested products before incorporating into system.

## **1.06 QUALITY ASSURANCE**

A AV Contractor Qualifications.

1. Be established AV System Contractor, regularly engaged in furnishing and installing AV systems. NOTE: Electrical or general contracting firms responsible for completion of this work, but not meeting above requirement, shall employ services of approved AV Contractor as subcontractor to perform work described herein.
2. Be experienced in installations of similar size and scope within last five (5) years. Submit list of four (4) (minimum) installed jobs of similar magnitude, completed within last five years. For verification, submit complete information, including project name, project address, contact person, daytime telephone number plus month and year of project completion. At Owner's request, accompany Owner or Owner's representative on visit to any or all example completed projects submitted.

3. Be Authorized Dealer for all major lines of equipment listed in Part 2 (Biamp, Chief, Crestron, JBL, Middle Atlantic, Shure, etc.) Must have at least one permanent staff member who is factory trained in the installation and maintenance of each major product line offered.
4. Employ personnel (at all levels of work) experienced in projects of similar size and scope. Provide list of key personnel to be responsible for each of the following aspects of work: Project Management, Technical Documentation, Control System programming, DSP programming and Leadership of Field Work (one who is present for all field work). For each identified employee, indicate number of years employed by contractor, number of years experience in assigned responsibilities, and list of previously completed projects where similar responsibilities were required.
5. Project manager assigned to this project must have a minimum of five (5) years experience in installing and integrating AV systems of similar scale. Project Manager shall also have either an AVIXA CTS-I or CTS-D certification.

## **PART 2 - PRODUCTS**

### **2.01 GUIDELINES**

- A Infrastructure Products - All conduits, basket tray/cable tray, pull boxes and associated parts required for infrastructure shall be installed by the electrical contractor unless specifically excluded in these specifications or drawings.
- B Performance - Regardless of completeness of descriptive paragraphs herein, each device shall meet its manufacturer's published specifications. Verify performance.
- C Contract Documents - Drawings and specifications are to be used in conjunction with one another and to supplement one another. In general the specifications determine the nature and quality of the materials, and the drawings establish the quantities, details, and give characteristics of performance that should be adhered to in the installation of the AV system components. If there is an apparent conflict between the drawings and specifications, the items with the greater quantity or quality shall be provided and installed. Clarification with the owner about these items shall be made prior to the ordering and installation.
- D Quantities - All quantities are indicated on AV drawings or in Part 2 AV Products list. Confirm quantities on final Contract Documents. If Contract Documents do not include quantities necessary to deliver complete working system, provide notification of disparity, and install required quantity of devices for complete working system.
- E Small Parts - Systems are described in terms of major products. Even if not specifically mentioned, provide and install patch cables, connectors, hardware, converters, power supplies, labels, terminals, mounting accessories etc. necessary for complete and working system meeting design intent of specifications.
- F Keys - Provide five (5) sets of keys for any AV system product requiring keys.

- G Condition - Provide and install products listed in this section in factory new condition, conforming to applicable provisions of American National Standards Institute.
- H Designations - Each major product item is given unique designation (such as MIX1 for mixer number 1). The product designations are unique in this section only and may be repeated in other specification sections.
- I Security Screws - Use Bryce Security Penta-Plus button-head screws and bits to secure rack components, LCD mounts, Projector mounts and any other location deemed necessary by Owner. Use nylon washers (not provided by Bryce) to protect equipment surfaces. Account for appropriate tip wear when ordering quantity and do not use a bit beyond the manufacturer's recommendations. Provide ten (10) additional unused driver bits and deliver to the customer after completion.
- J AV Electrical Power - Coordinate with Electrical Contractor regarding proper placement of isolated-ground duplex outlets for any AV equipment. Electrical circuits should be connected (and outlets wired) by the Electrical Contractor to the AV system circuit breaker panel (N.I.C.). Ensure that "Star" ground configuration is properly implemented by the Electrical Contractor. Ensure that ground wires from each outlet are isolated from conduit, neutrals, and each other.
- K AV Screens - For any screen specified, size as indicated in drawings. Unless otherwise indicated in drawings or specifications, set limits so projected images are 48" above finished floor, and include additional black drop as appropriate considering screen size and mounting height.
- L AV Racks:
1. Provide blank faceplate in any area marked BLANK in drawings.
  2. Provide shelf for mounting of any device for which rack mount kit is not available.
  3. Panelcrafters Provide one (1) Panelcrafters DBR-XXXXXX-RHIM-01 designer/integrator information plate or approved alternate per rack. Install information plate at the top of each rack unless 1RU space is not available. Contact Panelcrafters sales department to add AV Contractor graphic to the "integrator" section (approximately 8.5" x 1.75" of the right-hand side). All alternates must include AV Consultant graphic. Submit to AV designer for approval of final plate design prior to purchasing and installation.
- M AV Floor Boxes:
1. Clean floor boxes of all dust and debris prior to installation of any active or connectorized plate.
  2. Any floor box with active or connectorized AV plates found to have any dust, debris or water in bottom of box are subject to replacement of all plates and components. A re-test of all associated components must be completed.



- N Wireless Microphones - Coordinate frequency selection with other radio-frequency sources in the area and with manufacturer's recommendations.
- O Control System Programming:
1. Program each panel to provide simple, intuitive control of all basic AV functions including:
    - a. program and speech volume levels
    - b. video source and destination routing
    - c. screen control
    - d. video projector lift control (where applicable)
    - e. AV system power
    - f. media player transport functions
    - g. video conferencing CODEC controls including call initiation (where applicable)
    - h. video conferencing PTZ camera control (where applicable)
    - i. combine/uncombine settings for all combinations of controlled rooms
    - j. local lighting and blackout shade controls (where applicable)
  2. Utilize AVIXA's "Dashboard for Controls" concept and Crestron's SMART GRAPHICS for touch panel layout unless directed otherwise by Owner.
  3. Provide layout of each and every touch panel and hard-button panel pages in the product data submittal for approval by Owner.
  4. Provide web-control for each touch panel in AV system. Include page tracking, and track current button feedback between touch panel and web-control panel.
  5. Staff member certified by control system manufacturer shall program control system.
  6. After programming is approved, all control system code and programming, including touch panel code and graphics, will become property of Owner. AV Contractor shall provide Owner both raw and compiled code on CD-R disc.
  7. Provide follow up meeting with Owner after 6 months of operation to make updates as requested to control programming.
- P Audio System Programming - Owner shall coordinate layout and logical branching of DSP audio system. Include screen layout and menu branching drawings in AV submittal. After AV system is approved, all audio control system code and programming will become property of Owner. AV Contractor shall provide Owner both raw and compiled code on CD-R disc.

Q AV Design Bid & Substitutions:

1. System design is around products listed in Part 2. Intent of product specification is to provide standard of quality and function for installed materials. Certain performance specifications are given to clarify job requirements.
2. Bid AV system with products specified in Base Bid section below unless noted otherwise from Owner.
3. No substitutions will be allowed without prior approval from Owner specific to proposed manufacturer and model numbers.
4. Equipment listed in Part 2 is based on performance criteria to meet Owner design requirements.
5. All requested substitutions need to meet or exceed performance of devices listed in Part 2. For each request provide manufacturer's published specifications to verify performance and explain functional and cost impact.
6. Evaluation and approval of substitution requests will be performed by Owner.

**2.02 ROOM DESCRIPTIONS**

**2.03 AV PRODUCTS - ACTIVE EQUIPMENT**

A The following are major active products for this project.

1. **Interactive Displays (IVD) :**
  - a. **Clartouch 6000a+ 65"**
    - 1) **Provide (1) CTI-PCMOD-PC65-ST PC Module for each interactive display in the project.**
    - 2) **Provide (1) CTI-STAND-ADJM-V4 Adjustable mobile stand for each interactive display in the project.**
    - 3) **Provide (1) CM100 Collar Mic Kit for each interactive display in the project.**
  - b. **Or owner approved Equivalents.**
2. **Flat Panel Display (FSD-1) (FSD-2) (FSD-3)**
  - a. **FSD-1 Locations provide LG 65" UR340C Series Display with Chief MTM1U adjustable tilt mount. Or owner approved equivalents**
  - b. **FSD-2 Locations provide LG 65" UR340C Series Display with Chief MTM1U adjustable tilt mount. Or owner approved equivalents**

- 1) **AV inputs associated to FSD-2 displays provide (1) Liberty DigitaLinx HDMI HDBaseT Wall Plate Extension Set AV DL-1H1A-WPKT-W.Or owner approved equivalents**
    - (a) **Shall use 24 AWG 4-Pair Dual Shielded HDBaseT Cable LLINX-HD for Transmitter /Receiver interconnections. Or approved equivalent.**
  - c. **FSD-3 Locations(Menu Boards)Provide LG 55” UR340C with Chief MTM1U adjustable tilt mount. Or owner approved equivalents**
- 3. Cafeteria/Stage AV system Equipment**
- a. **Provide (2) Epson EB-PU1008W Large Venue laser projectors . Chief Universal projector mount and Chief CMS492CP2 suspended storage box for each projector. Provide Standard Lense ELPLM08. Contractor is to confirm final lense part number required prior to placing order.**
  - b. **Provide (2) Draper Ultimate Access XL 100"H X160"W Motorized projection screens. With Draper ALR-MS1000X screen surface. Contractor is to verify required black drop prior to placing orders.**
  - c. **Video Input plates (AV-1)**
    - 1) **Provide (2) Liberty DigitaLinx HDMI HDBaseT Wall Plate Extension Set AV DL-1H1A-WPKT-W .Or approved equivalents.**
    - 2) **Provide (1) Liberty DigitaLinx 2x4 HDMI Distribution Amp / Splitter. Projectors are to mirror the same content.**
    - 3) **Provide (2) DigitaLinx HDMI 2.0 HDBaseT Extension Sets. (1) Receiver per projector installed in projector ceiling storage box. (1) Transmitters per projector to be instlled in AV equipment rack.**
    - 4) **Shall use 24 AWG 4-Pair Dual Shielded HDBaseT Cable LLINX-HD for all HDBASET Transmitter /Receiver interconnections. Or approved equivalent.**
    - 5) **Provide (1) BSS BLU 100 Digital Signal Processor (DSP)**
    - 6) **Provide (1) BSS BLU BIB input expander**
    - 7) **Povide (2) BSS BLU-10 AV System controllers**
    - 8) **Provide (2) Crown DCI 4|1250 Power Amplifiers .**
    - 9) **Provide (1) CD/Media Player with Bluetooth: Denon DN-500CB**
    - 10) **Local Sound Speakers ElectroVoice EVID-PC8.2. Quantity per the drawings.**

- 11) **Provide (3) Passive Stage monitor speakers EV MFX-12MC installed at stage left, right and center. Provide RCI NL4 Speakon custom wall plates for each**
  - 12) **Provide Assistive Listening System: Williams Sound PPA 457 NET Pro System or Listen Tech equivalent**
  - 13) **XLR Wall Plate (MIC): Atlas SG-XLR-F1 (Qty: per drawings)**
  - 14) **Provide Wireless Microphone System : Shure QLXD 124/85 (Qty: 2).**
    - (a) **Provide SHURE UA844+/SWB antenna splitter and antennas to achieve full coverage of the space.**
  - 15) **Provide Wired Microphone: Shure SM58 (Qty: 2)**
    - (a) **Provide one (1) 25-ft-long microphone cable (Qty: 2)**
    - (b) **Provide one (1) Atlas Mic Stand and Boom kit TB1930 (Qty: 2)**
  - 16) **Provide Hanging Microphones: Shure MX202B/C (Qty: per drawings).**
  - 17) **Provide (1) Atlas WMA24-23 wall mounted AV equipment Rack**
    - (a) **Provide one (1) Storage Drawer 3RU: Atlas SD3-14.**
    - (b) **Provide one (1) PDU: Furman M-8S**
    - (c) **Provide black panels to cover to all un-used rack spaces.**
  - 18) **Intercom/Bell Relay: Radio Design Labs TX-70A.**
    - (a) **Provide all wiring and accessories required for connecting local sound system to building PA to mute local sound during all call.**
4. **GYM Sound System**
- a. **Audio DSP: BSS Blu-100 (Qty: 1)**
  - b. **Amplifier: Provide (2) Crown DCI 4|1250 Power Amplifiers**
  - c. **Audio Controller (AVC): BSS EC-8BV Install inside AV enclosure**
  - d. **XLR (mic) Wall Plate (MIC): Atlas SG-XLR-F1 (Qty: per drawings)**
  - e. **Provide Whirlwind MIP3 Audio input plate**
  - f. **Provide Wireless Microphone System : Shure QLXD 124/85 (Qty: 2).**
    - 1) **Provide SHURE UA844+/SWB antenna splitter and antennas to achieve full coverage of the space.**
  - g. **Wired Microphone: Shure SM58 (Qty: 2)**

- 1) **Provide one (1) 25-ft-long microphone cable (Qty: 2)**
  - 2) **Provide one (1) Atlas Mic Stand and Boom kit TB1930 (Qty: 2)**
  - h. **Provide Assistive Listening System: Williams Sound PPA 457 NET Pro System or Listen Tech equivalent**
  - i. **CD/Media Player with Bluetooth: Denon DN-500CB(Qty:1).**
    - 1) **Provide antenna to extend Bluetooth signal coverage to the entire space.**
  - j. **Provide (1) Liberty DigitaLinx HDMI HDBaseT Wall Plate Extension Set AV DL-1H1A-WPKT-W .Or approved equivalents.**
  - k. **Intercom/Bell Relay: Radio Design Labs TX-70A.**
    - 1) **Provide all wiring and accessories required for connecting local sound system to building PA to mute local sound during all call.**
  - l. **Local sound speakers Electro-Voice ZLX-15 Quantity per the drawings.**
  - m. **Equipment Rack: Atlas, #WMA24-23**
    - 1) **Provide black panels to cover to all un-used rack spaces.**
    - 2) **Provide one (1) Storage Drawer 3RU: Atlas SD3-14.**
    - 3) **Provide one (1) PDU: Furman M-8S**
- 5. MUSIC Room Sound System**
- a. **Provide (1) 12-channel Mixer Allen & Heath 12CH mixer CQ-12T**
  - b. **Provide Wireless Microphone System : Shure QLXD 124/85 (Qty: 2).**
  - c. **CD/Media Player with Bluetooth: Denon DN500CB (Qty:1).**
  - d. **Provide one (1) PDU: Furman CN1800S**
  - e. **Equipment Rack: Gator Case #GRC-10X12RU**
  - f. **Provide two (2) QSC #K8.2 Powered Speakers with wall mount Yoke**
  - g. **Provide Custom dual gang wall plate with XLR mixer feed Right and Left connectors to Wall mounted speakers.**

## **2.04 CABLES**

- A Interconnect Wiring – Provide and install following cable as required for connections in all areas. Meet provisions of N.E.C. Provide plenum rated cable where required.
  - 1. Analog Audio/Microphone cable - West Penn D25291.

2. Digital Audio Plenum Rated Cable: West Penn DA252401/ DA252402/ DA252406, or AES/EBU compliant equivalent.
3. Analog Composite Video Plenum Rated Cable: West Penn 25806.
4. RGBHV Plenum Rated Cable: West Penn 258195.
5. Control Plenum Rated Cable: West Penn D25350.
6. Low Impedance Loudspeaker Cable
  - a. For cable distance <50': 14-guage 2-conductor West Penn #25226B
  - b. For cable distance from 50' to 100': 12-guage 2-conductor West Penn #25227B
  - c. For cable distance > 100', consult with manufacturer and engineer before ordering/installation.
  - d. Terminate with Neutrik "Speakon" type connectors when available.
7. High Impedance Loudspeaker Cable (25v/70v)
  - a. For cable distance <300': 18-guage 2-conductor West Penn #25224B
  - b. For cable distance from 300' to 500': 16-guage 2-conductor West Penn #25225B
  - c. For cable distance > 500', consult with manufacturer and engineer before ordering/installation.
  - d. Terminate with Neutrik "Speakon" type connectors when available.
8. HDMI cables: Belden HD-800 series. All HDMI cables used shall be certified to meet the performance of the display devices over the actual cable length. Provide HDMI transmitters and receivers as needed.
9. HDBaseT Cable: Belden 2183P (or as manufacturer recommended).

## **PART 3 - EXECUTION**

### **3.01 INSTALLATION**

#### **A General Guidelines**

1. Quality of Work - Perform labor to accepted industry standards and state and local codes to accomplish complete and working system.
2. Material and Labor - Provide specified products and other incidental materials, appliances, tools, and transportation required for complete and functioning systems. Provide personnel to perform labor who are skilled in techniques and can demonstrate technical knowledge AV infrastructure system installations.

3. [if !vml][endif]Provide a complete functioning sound system that's been fully tested and properly balanced, configured, and equalized. Be of maximum assistance to the Owner during the warranty period of the system, to the degree that maximum Owner satisfaction is assured.
4. Observe proper circuit polarity and loudspeaker wiring polarity. No cables shall be wired with a polarity reversal between connectors with respect to either end. Special care shall be taken when wiring microphone cables, to ensure that constant polarity is maintained. Balanced audio connectors shall be wired as follows.

Wire	Connector	Signal
Black	Pin #3 or Ring	Low or Negative
Red or White	Pin #2 or Tip	High or Positive
Bare	Pin #1 or Shield	Ground

5. Provide all audio circuits balanced and floating, except as noted in the Specifications or directed by the Consultant at the time of final equalization and testing. Shields of audio cables shall be grounded at one end only, at the outputs of the various equipment items in the system
6. Route cables and wiring within equipment racks and cabinetry according to function, separating wires of different signal levels (video, microphone level, line level, amplifier output, 120VAC, intercom, control, etc.) by as much physical distance as possible. Neatly arrange and bundle all cables loosely with plastic cable ties. Cables and wires shall be continuous lengths without splices.[if !vml][endif]
7. All system wire, except spare wire, after being cut and stripped, shall have the wire strands twisted back to their original lay and be terminated by approved soldered or mechanical means. No unterminated wire ends will be accepted. Heat-shrink type tubing shall be used to insulate and dress the ends of all wire and cables. Include a separate tube for the ground or drain wire.
8. All cables in conduits shall be insulated from each other and from the conduit the entire length and shall not be spliced. All cables and wires are to be continuous lengths without splices.
9. All solder joints and terminations shall be made with resin-core silver solder. Temperature regulated soldering irons rated at least 60 watts shall be used for all soldering work. No soldering guns or temperature unregulated irons shall be used on the job site.
10. Each mechanical connector shall be attached using the proper size controlled- duty-cycle ratcheting crimp tool which has been approved by the manufacturer of the connectors. Conventional non-ratcheting type crimping tools are unacceptable, and shall not be used on the job site.

11. Label all wires in racks and console as to destination and purpose with permanent labels. Clearly and permanently label all controls and connections at the front and back of the rack, with permanent labels. Wall plates and custom panels shall be engraved and filled with contrasting paint, unless otherwise noted. All labeling shall be completed prior to final system inspection.
12. Documents at Job Site - Keep following documents at job site during entire construction period:
  - a. Complete Specifications and Drawings.
  - b. Approved Shop Drawings.
  - c. Approved Product Data.
  - d. Progress Set of Project Record Documents.
13. Mounting - Mount equipment and enclosures plumb and square. Ensure that permanently installed equipment is firmly and safely held in place. Design equipment supports to support loads imposed with project safety factor of five (5) or greater. For devices hung overhead, obtain review by Structural Engineer licensed by the appropriate governing authority prior to installation.
14. Locate wireless microphone system and hearing assist system antennas at or above ceiling or at bar joist height in areas without ceilings. Coordinate exact location with Owner to provide adequate coverage in the area served by the system. Adjust antenna location for best possible reception/transmission in area of coverage.
15. Provide adequate protective vandal guards for all devices located in areas subject to damage from activities or vandalization, such as school gym, sports field, school cafeteria.
16. Provide hearing assist transmitter(s) and receivers for each sound reinforcement system. The quantity of hearing assist receivers for each system shall be equal to a minimum of four (4) percent of the total seating capacity, but in no case less than ten (10) receivers for the area of coverage of each local sound reinforcement system.
17. Dimension Verification - Verify dimensions and space requirements to assure that proper mounting, clearance, and maintenance access space is available for system components.
18. Clean-Up - Leave project clean each day. Place debris where designated by General Contractor. Debris includes but not limited to: solder splatter, cable ends, stripped insulation, spent crimp connectors, gypsum board and ceiling tile dust, and product wrappings and cartons. After completion of installation, thoroughly clean areas worked, including non-visible areas such as equipment rack interiors, rack top panels, and inside lockable floor and wall boxes.



19. Coordinate installation of AV infrastructure and equipment with other trades in order to follow project schedule.
20. Maintain any licensing required by the appropriate governing authority to install and terminate low voltage systems.

#### B Labeling

1. Equipment Labels - AV Contractor shall provide engraved lamicoid labels on front and rear of rack-mounted equipment. Mount labels plumb and square. Include schematic reference design, item name, and system or area controlled by labeled component. On program preamps and mixers, provide label for each input indicating which source is controlled by labeled channel. Unless otherwise indicated, provide permanently-mounted black labels engraved with 1/8-inch white block characters. Handwritten, self-laminating, or embossed plastic (Dymo) labels are not acceptable. Provide labels for major equipment with two (2) lines (minimum) of engraving, coded as follows:
  - a. Line 1: Generic name of device, such as MIXER AMPLIFIER.
  - b. Line 2: Schematic designation of device, such as AV-MSW-1.
2. Control Labels - AV Contractor shall provide engraved label over each user-operated control that describes the function or purpose of control. Provide label of proper size to fit available space.
3. Terminal Strip Labels - AV Contractor shall label each terminal strip with unique identification code in addition to numerical label (Cinch MS series) for each terminal. Show terminal strip codes on system schematic drawings included with Project Record Documents.
4. Rear Equipment Labels - AV Contractor shall provide adhesive label on rear of equipment where cables attach, to indicate designation of cable connected at each point.
5. Cable and Wire Labels - Label cables and wiring logically, legibly and permanently for easy identification. Labels on cables shall be adhesive strip type, covered with clear heat shrink tubing. Factory stamped heat shrink tubing may be used. Hand-written or self-laminating type labels are not acceptable.
6. Cable Label Codes and Locations - Label each cable with unique alpha-numeric code. Locate cable designation at start and end of each cable run, within three (3) inches of termination point. For cable runs that have intermediate splice points, label cable with same designation throughout, with additional suffix to indicate each segment of run. Provide cable designation codes to schematic drawings included with Project Record Documents and Operation and Maintenance Manuals.

#### C Power and Grounding

1. Power Coordination - Coordinate final connection of power and ground wiring to rack. Electrical contractor will provide power to AV systems. Before installation, verify load requirements for systems as accepted.
2. Bus Bars - Install 1-inch by 1/4-inch copper ground bus bar, top to bottom in floor mounted AV racks. Ground and bond equipment chassis of each rack-mounted component without three-pin grounding plug to bus bars with #12 AWG insulated green wire using 6-32 or larger nuts, bolts, lock-washers, and appropriate NEMA connectors. Electrical Contractor (Division 26) shall provide and connect #4 AWG green insulated wire from Bus Bars to ground point in AV technical electrical panel.

#### D Equipment Racks

1. Ventilation - Provide ventilation adequate to keep temperature in rack below 85 degrees Fahrenheit. Use “whisper” type ventilation fans in racks, adjusted to come on when temperature in rack rises above 85 degrees Fahrenheit, only if adequate cooling cannot be provided by Owner.

#### E Wiring

1. Wiring Standards - Execute wiring in strict adherence to best AV engineering practices.
2. Field Connection Devices - Connect cable to active components through screw terminal connections and spade lugs when appropriate. For BNC connections use three-piece, dual crimp BNC properly sized for cable with insulating bushings. Wire nut or “Skotchlock” connectors are not acceptable. Do not wrap audio cable splices or connections with adhesive backed tape. Punch connectors or telephone-style punch blocks are not acceptable anywhere in the installation unless specifically authorized by Owner.
3. Run cable in ceiling plenums neatly parallel to building walls, supported every three feet to structure with plenum rated ties.
4. Raceways - Run vertical wiring inside rack in Panduit (or equivalent) plastic raceways with snap-on covers, sized to allow at least 50% future wiring. Mount raceways on full length 3/4-inch flat black plywood backboards, attached to rack sides. If between-rack wiring chases are provided, Panduit raceways are not required. Horizontal wiring in rack shall be neatly tied in manageable bundles with cable lengths cut to minimize excess cable slack, but still allow for service and testing. Provide horizontal support bars if cable bundles sag. Individually bundle excess AC power cable away from rack mounted equipment with plastic cable ties. Electrical tape and adhesive backed cable tie anchors are not acceptable.
5. Accessibility - Ensure that wiring and connections are completely visible and labeled in rack. Mount termination resistors, if required, on terminal strips, fully visible and not concealed within equipment or connectors.

6. Loudspeaker Polarity - Connect loudspeakers electrically in phase, using same wire color for loudspeaker wiring throughout project.
7. Physical Damage Prevention - Take necessary precautions to prevent physical damage to cables and equipment. Damaged cables or equipment will not be accepted. Separate, organize, and route cables to restrict channel crosstalk and feedback oscillation.
8. Racks - Looking into the rack from the rear, locate AC power, control, data and speaker wiring on the left; line level audio, control, video, and RF wiring on the right. Keep several inches of space between power cables and other signals.
9. Other Connections - Make connections using rosin core solder or approved mechanical connectors. Where spade lugs are used, crimp properly with ratchet type crimping tool. Solder spade lugs mounted on #22 AWG or smaller cable after crimping.

### **3.02 FIRESTOPPING**

- A Refer to section 27 02 00.

### **3.03 STORAGE AND HANDLING**

- A Power up any electronic equipment to ensure its proper functioning before its arrival onsite.
- B Ensure that materials (especially electronic and electro-acoustic devices) are protected against physical, environmental, and electronic damage until final acceptance by Owner.
- C Schedule delivery to minimize delays in the project.
- D Provide storage protection against temperature and humidity extremes, theft, vandalism, physical damage, and environmental damage.

### **3.04 WARRANTY**

- A Refer to Division 1.
- B Warranty - Submit letter providing warranty covering labor and materials supplied under this contract. Bind in Operation and Maintenance Manuals. Terms as described in General Conditions. Minimum terms as follows:
  1. System - Systems shall be free of manufacturing or installation defects for a minimum period of one (1) year from the date of final acceptance. Clearly designate begin and end dates of system warranty period.
  2. Parts and Labor - Provide parts and labor to repair defects in materials and workmanship during system warranty period.

3. Response Time - Within system warranty period, provide initial on-site service response within one (1) business day of service call. Provide resolution to any system defects within 72 hours or within 48 hours of receipt of repaired or replaced product from manufacturer.
  4. Replacement Products - If any item must be removed for repair during system warranty period, provide replacement item of similar quality at no charge.
  5. Repair Limit - Do not repair any piece of equipment found defective during installation or system warranty period more than two (2) times. After second repair, replace defective item with similar approved item at no additional cost to Owner.
  6. Extended Manufacturer's Warranties - Identify products with manufacturer's warranties extending beyond one (1) year. Provide terms and conditions of such warranties.
  7. Service Personnel Information - Provide name(s) and telephone number(s) of service personnel to be contacted regarding repair and maintenance.
- C Extended Warranty - Provide cost to extend complete AV system warranty from one (1) year to three (3) years. Included a list of all provided services including maintenance schedules.

### **3.05 INITIAL TESTS**

- A Purpose - These tests are to ensure that the AV system is installed and functioning as specified, and to ensure the system is ready for Final Tests and Adjustments (described later).
- B Testing Standards - Perform testing in accordance with ANSI standards.
- C Inspection - Verify prior to beginning actual tests and adjustments on systems:
1. Proper grounding of all electronic components (through third prong of power connector or separate connection between component chassis and ground bus bar).
  2. Cables dressed, routed, and labeled, connected with proper polarity.
  3. Insulation and shrink tubing in place.
  4. Dust, debris, solder splatter, etc. removed.
  5. Proper frequency settings (or modules) at crossovers and controllers.
  6. All equalizer bands and tone controls set for flat frequency response.
  7. Survey temperatures of each piece of equipment after four (4) hours use (minimum). Note and report any hot equipment.

- D Electrical Power Quality - While all sound and AV system components are unplugged from electrical power outlets, AV Contractor shall turn on power to outlets, and confirm proper voltages at each outlet across the following pairs of terminals: hot and neutral, hot and ground, and neutral and ground (zero volts across neutral and ground). AV Contractor to document measurements.
- E General Function Tests - Test each piece of equipment to ensure that it performs its intended function. Include all portable equipment in tests. Intent of initial tests is to verify complete, functioning system before Final Tests and Adjustments. Correct problems found during initial testing before beginning Final Tests and Adjustments. Document whether all pieces performed intended functions; note any unresolved malfunctions.
- F Initial Tests and Adjustments Data - Submit written report of Initial Tests and Adjustments data upon completion to Owner. Include printed name(s) of technician(s) performing tests, date(s) and time(s) of tests, model and serial numbers of test equipment, results of each initial test, descriptions of problems encountered and their solutions, and statement that system is ready for Final Tests and Adjustments. Initial Tests and Adjustments Data to include signatures of technician(s) performing tests.

### **3.06 FINAL TESTS AND ADJUSTMENTS**

- A Purpose - These tests are to be witnessed by AV Consultant to determine if system is complete and functioning as designed and specified. Also, AV Consultant will perform listening and viewing tests and witness adjustments of all images for optimum clarity.
- B Timetable - Coordinate with Owner, General Contractor, and AV Consultant to schedule Final Tests and Adjustments after submittal of Initial Tests and Adjustments data.
- C System and Site Conditions - AV Consultant will witness Final Tests and Adjustments. Have systems fully functional and ready for observation and testing upon AV Consultant's arrival. Coordinate with all trades for quiet conditions throughout the listening areas and for the duration of the test schedule. If upon AV Consultant's arrival, systems do not meet criteria, site is not sufficiently quiet, or if Owner or AV Consultant is required to make additional trips to job site to witness additional testing or perform additional reviews of installed equipment, Contractor shall reimburse Owner for labor and expenses incurred by having incurred costs deducted from payments to contractor.
- D Test Labor - Provide technician familiar with this project's AV systems and operation of test equipment to perform testing. Provide additional technician to assist in the tests and to perform troubleshooting, repairs, and adjustments. Include labor for these technicians to be present for one (1), eight (8)-hour day during Final Tests and Adjustments.
- E Tools - Provide standard hand tools including screwdrivers, pliers, wire strippers, nut drivers, soldering iron, and other tools appropriate for troubleshooting system problems.
- F Ladders and Scaffolds - Provide ladders and scaffolds to inspect/adjust loudspeakers and rigging points.

- G Verification of Initial Tests and Adjustments - Verify that Initial Tests and Adjustments have been performed and meet criteria. During Final Tests and Adjustments, AV Consultant may require portions of the Initial Tests and Adjustments to be repeated. Repeat measurements as requested without claim for additional payment.
- H Installer shall perform thorough preliminary testing of the AV Systems prior to the final inspection by the Consultant. All systems and subsystems shall be tested to ensure that they are in proper working order and meet the performance specifications. Perform preliminary programming and setup of digital signal processors as necessary to conduct these tests.
- I The testing and equalization work shall be performed after the installation work has been completed, but prior to any use of the system. During the testing and equalization work, the Installer shall have on the job site one (1) competent technician who is familiar with the project, and who will be prepared to stay as long as his services are needed. It is estimated that approximately eight (8) hours will be required for this work
- J The process of equalizing and testing the system may necessitate moving and adjusting certain loudspeakers. Adjustments shall be performed without claim for additional payment.
- K Coordinate as necessary to ensure a totally quiet room during the sound reinforcement systems testing and balancing period.
- L Prior to requesting systems testing, verify the following:
1. All systems are in first-class working condition and free of short circuits, ground loops, parasitic oscillations, excessive system noise beyond published.
  2. All specified equipment, including loose equipment, is on the job site for proper accounting.
  3. All loudspeaker circuits have been tested, are connected to the proper crossover frequency, and are in perfect working order. Furnish impedance measurements of each circuit in PDF format prior to final tests.
  4. All video systems and associated control systems have been tested and are in perfect working order.
  5. All equipment controls shall be labeled, even if unused. If permanent labels cannot be furnished prior to system inspection, temporarily label every control on the front and in the rear of the racks as to its function with write-on tape. Supply printer labels or markers suitable for permanently indicating knob settings after equalization is performed.
  6. Operation manuals for every equipment item furnished are on hand at the job site.
  7. Installer shall provide all signal processing software loaded on a portable PC and ready for use at time of testing. Installer shall provide a calibrated RTA and microphone, and pink noise generator at time of testing.

- M Should the performance testing show that the Installer has not properly completed the systems, the Installer shall make all necessary corrections or adjustments and a second demonstration shall be arranged at the Installer's expense.
- N The final acceptance of the system by the Owner will be based upon the report of the Consultant following inspection, testing, and demonstration. A list of items in need of completion or correction shall be generated by the Consultant, which must be corrected by the Installer before final acceptance will be granted.

### **3.07 SOUND SYSTEM PERFORMANCE**

- A After equalization and testing, the sound system shall meet or exceed the following specifications:
  - 1. System shall be free of short circuits, ground loops, parasitic oscillation, excessive system noise, hum, RF interference, and instability of any form.
  - 2. Minimum SPL with band-limited pink noise input to the system in the targeted space shall be 95 dB before audible distortion occurs.
  - 3. Seat-to-seat variation in SPL at 4kHz octave band pink noise shall be within a tolerance of plus or minus 3dB SPL.
  - 4. Acoustic response of the system shall be plus or minus 1.5dB along a line which is flat from 50 Hz to 4000 Hz and which rolls off at 1dB per octave to 16kHz.
- B The following tests and adjustments shall be performed by the Contractor. All equipment required supplied by the Contractor Follow EIA standard RS-160 and RS-219 in performing the tests. Make all necessary corrections to bring systems into specification compliance. Record the results of these tests in project record drawings. Submit written results of tests to Architect and Engineer prior to scheduled equalization and final inspection date.
  - 1. Measure and record impedance of each speaker line at frequency of 1,000 Hz, with loudspeakers connected to their respective lines.
  - 2. Measure and record overall system hum and noise level of each input channel with controls set so that -50 dBm microphone input or +4 dBm input would drive the system to full amplifier output. Terminate inputs with resistor (150 to 600 ohms) and disconnect power to noise generator for this test.
  - 3. Adjust the gain of each active device to provide both optimum signal - to noise ratio, and at least 10 dB headroom at each active device. Observe the output of each active device with an oscilloscope of 5 MHZ band width, and verify visually that the signal required for full amplifier output is free of overload, clipping, parasitics, and radio frequency components. Adjust gain structure of all active components and record the input and output signal levels of all active components and record the input and output signal levels of all active components in both dBm and volts, during normal program levels.

4. Measure and record system electrical frequency response for each input channel through power amplifier. Required is flat response with permissible deviation of +/-1 dB within the range of 30 Hz to 16 kHz.
5. Check system to assure freedom from oscillations or stray RF pickup. Check inputs with no signal and with typical program material driving system to full output. Detect unwanted signals on Oscilloscope at termination.
6. Check phasing of loudspeakers by applying constant power per octave (pink) noise to system and walking through the transition areas of coverage from one loudspeaker to the next. Transition should be smooth with no apparent shift in source from one speaker to the next. Apply sine wave sweep signal to each loudspeaker system sweeping from 50 Hz to 5,000 Hz and at a level of 10 Db below full amplifier output, and listen for rattle or objectionable noises. Correct if apparent.
7. Achieve uniform distribution of sound from each loudspeaker (with bleachers in their extended position in gymnasium where applicable). Drive system with broadband, constant power per octave (pink) noise, and measure the SPL using a sound level meter incorporating an octave-band filter centered at 4 kHz. Adjust noise level until the meter readings are between 75 and 80 dB. Use a sound level meter filter that meets ANSI S1 4-1971 Type 2 and ANSI S1 11-1971 standards set for slow meter damping. Take all readings at seated ear height. Adjust speaker as necessary to achieve +/-3 dB over entire area covered by this system.

### **3.08 FINAL ACCEPTANCE BY OWNER**

- A Certificate - Submit Certificate of Final Acceptance form signed by Owner verifying complete installation and proper operation of systems upon fulfillment of all requirements and upon recommendation by Owner.
- B General Adjustments - Adjust, balance, and align equipment for optimum quality, meeting manufacturers published specifications.
- C Input/Output Jack Demonstration - Demonstrate proper performance and phase of each system input and output jack (all audio input and output jacks) as received at AV and network systems.
- D Inventory - Inventory all installed and portable equipment for correct quantities.
- E Functional Demonstration - Demonstrate operation of each function of each major piece of equipment.
- F Other Tests - Perform any other tests on any part of the AV system as requested by Owner.



- G Final Equipment Settings - Record final settings of all equalizer bands, tone controls, filters, delays, limiters, etc., including those established through computer software settings. Include descriptions of settings (including software settings) in Operation and Maintenance Manual. Include software copy of configuration file(s) in Operation and Maintenance Manual.
- H Security Inspection - Inspect equipment for security from tampering (covers, shaft-locks, etc.).
- I Review of Labels - Review installed labels on cables, equipment, controls, and terminal strips.

### **3.09 OWNER TRAINING**

- A Provide Owner training as described in General Conditions. As a minimum, provide eight (8) hours instruction (within two (2) trips to site) regarding AV Systems operation to Owner-designated personnel. Schedule instruction time(s) with Owner to occur after completion of Final Tests and Adjustments. Coordinate with Owner in advance to schedule instruction time. Document date, time, and attendees of the training session and include documentation in Operation and Maintenance Manuals to serve as record of trained personnel.

### **3.10 SUPPORT DURING OWNER'S FIRST USE OF COMPLETED SYSTEM**

- A Provide personnel familiar with design, installation, and operation of each system to be present at Owner's first use of each completed system (up to eight (8) hours total in a single session). During first use of each system, respond to Owner requests for troubleshooting, adjustments, and additional training. If no one contractor employee or representative can provide expertise in all aspects of the system, provide multiple personnel for the eight (8) hours per session as required. Schedule presence of personnel in advance with Owner. Should significant elements of the new system be operational prior to final completion, Owner may elect to schedule contractor presence for Owner function prior to final completion of system. Should Owner exercise this option, contractor presence will not be required at first use following final completion.

**END OF SECTION 27 41 16**

## **SECTION 28 20 00 - VIDEO SURVEILLANCE SYSTEM**

### **PART 1 - GENERAL**

#### **1.01 SUMMARY/OVERVIEW**

- A This section provides specifications for the installation of an IP based Video Surveillance System (VS) and related components.
- B Related Sections
  - 1. Section 26 02 00 - Basic Materials and Methods for Electrical (including related sub-sections)
  - 2. Section 27 02 00 - Basic Materials and Methods for Communications Systems (including related sub-sections)
  - 3. Section 28 02 00 - Basic Materials and Methods for Safety and Security Systems
  - 4. Section 28 10 00 - Access Control System
  - 5. Section 28 31 00 - Intrusion Detection System

#### **1.02 REFERENCES**

- A See Section 28 02 00

#### **1.03 SYSTEM DESCRIPTION**

- A **The project will be equipped with a new Video Management System (VMS) as a Stand-Alone System.** an addition to the owners existing Digital watchdog VMS. Contractor shall provide license for each new Camera ,and required intergration license for access control and intrusion systems.
  - 1. ~~Provide Network Video Recorder (NVR) and Network Attached Storage (NAS) located in relay rack in the MDF of the project site.~~**NVR for the project is exisitng centralized district NVR.**
    - a. The new system shall provide for recording, local monitoring, and remote monitoring of IP cameras.
- B The security integrator shall furnish and install the surveillance system, consisting of camera assemblies, ~~NVR~~, wiring & cabling, and low voltage camera power supplies.
  - 1. All active surveillance equipment and communication devices shall be on emergency/UPS power.
- C Camera assemblies include camera, lens, housing, and mount. Provide and install wiring and low voltage power from the security wall field/rack to the camera locations.

1. Scope of work shall be complete from point of origin (camera) to point of termination (security rack).
- D Coordinate all work that must be performed in security head end spaces with the General Contractor, the Electrical Contractor, and the Telecommunications contractor. (if applicable)
- E Camera images shall support H.264 compression formats.
- F Camera lenses for fixed cameras shall be varifocal and sized to provide the owner approved field of view. The lens shall be IR corrected and have megapixel resolution.
- G Surveillance camera audio functions shall not be installed and/or disabled unless specifically requested by Owner.

#### **1.04 SUBMITTALS**

- A Follow provisions of Section 28 02 00 for additional requirements.
- B Project Data
  1. Provide a description of system operation indicating the purpose and capability of each device/component of the system with a functional diagram indicating all interfaces to other systems.
- C IP: Video Quality test reports shall be provided for all cameras to confirm an optimum high definition video signal.
- D Shop drawings shall reflect all requirements associated with Owner provided or existing equipment and materials that will be used as part of this system.
- E Video Storage calculations to show the system capacity can accommodate the specified video retention.
- F Battery calculations to show the expected loads and backup duration for camera power supplies and UPS devices for all active surveillance equipment.
- G System programming, camera titles, descriptions, camera images and database
  1. Camera titles and descriptions prior to system programming
  2. Programming/database prior to performance testing
  3. Provide a cross reference between specified camera numbers and programmed camera numbers
  4. Final programming, camera images and system documentation on electronic media to Owner
- H Product Data
  1. Manufacturer's technical data sheets and specifications

## **1.05 QUALITY ASSURANCE**

A Follow provisions of Section 28 02 00

B Spare Parts:

1. Provide two (2) spare components for every model and configuration of electronic components and devices used on the project as spare parts inventory.
  - a. The security integrator will turn over the new and unused components and devices to the owner at project closeout.

## **1.06 DELIVERY, STORAGE AND HANDLING**

A See Section 28 02 00

## **1.07 PROJECT/SITE CONDITIONS**

A See Section 28 02 00

## **1.08 WARRANTY**

A See Section 28 02 00

# **PART 2 - PRODUCTS**

## **2.01 CAMERA SPECIFICATIONS**

A All cameras shall be a Dome Camera unless otherwise specified

1. Compatible with the VMS
2. Vandal resistant with polycarbonate dome
3. Wide Dynamic Range Feature: All exterior cameras and interior cameras that have exterior lighting or headlights in their field of view shall have a Wide Dynamic Range feature to improve picture quality in situations with strong backlighting.
4. Multi-stream so that recording and viewing can be at different frame rate and compression.
5. Day-night Color/B&W camera with cut filter
6. Exterior cameras:
  - a. Shall be outdoor rated
  - b. Include a heater to permit fog-free viewing in low temperatures
  - c. Fan to prevent overheating in high temperatures (as required)

## 2.02 NETWORK VIDEO RECORDER (EXISTING)

- A Coordinate with owner on the number of user licenses required

## 2.03 ACCEPTABLE MANUFACTURERS

- A Video Management System (VMS) Platform Software

1. **Digital Watch Dog, VMS.**
2. Owner Approved Equivalent

- B NVR Server: Compatible with VMS Requirements

1. i-Pro- Panasonic
2. Compatible with VMS Requirements

- C Type A Camera:

1. ~~Advidia - Model M-45-FW , with built in Microphone~~**Digital Watchdog - DWC-VSDG04Bi - 4MP**
2. Owner Approved Equivalent

- D Type B Camera:

1. ~~Advidia - Model M-87-V~~**Hanwha QNV-C9011R - 8MP**
2. Owner Approved Equivalent

- E Type C Camera:

1. **I PRO - WV-U85402-V2L - Dual Sensor - 2 X 4MP**
2. Owner Approved Equivalent

- F Type D Camera:

1. Advidia - WV-S8574L - Multi-directional Camera - 4X 4K (33MP)
2. Owner Approved Equivalent

- G Type E Camera:

1. **I PRO - WV-S85702-F3L - Dual sensor 2 X 4K**
2. Owner Approved Equivalent

- H **Type -F Camera:**

1. **I PRO WV-S8573L 3X4K(25MP)**
2. Owner approved Equivalent

I Equipment Racks and Racks Components: (By Division 27)

1. Ortronics

J Surge Protection Devices

1. Ditek DTK-MRJPOES (at Device)
2. Ditek DTK-RM12POE (MDF/IDF)
3. Owner Approved Equivalent

K Video Wire & Cable

1. CommScope
2. Owner Approved Equivalent

## PART 3 - EXECUTION

### 3.01 CONFIGURATION

A Video Cameras

1. Provide day/night cameras in exterior locations
2. Lenses shall be field tested with Owner present to verify clear, crisp images and desired field of view
  - a. Substitute camera lenses as necessary to obtain required field of view at no additional cost
  - b. Provide spot filters for exterior lenses as required to reduce picture washout caused by sunlight

B IP PoE Cameras

1. The security integrator shall coordinate network and IP address requirements with Owner to identify the Media Access Control (MAC) address (Layer 2) of each provided camera, the location to be installed, and the port configuration needed for communication.
2. Make all necessary adjustments to camera lenses to obtain clear, crisp images and desired field of view to the Owners satisfaction.
  - a. Substitute camera lenses as necessary to obtain required field of view at no additional cost.
    - 1) Adjust all cameras to produce high-definition images with no blooming, streaking or noticeable lag.

- 2) Provide and install in-line PoE injectors as required when non PoE network switches are used or when manufacturer specified power is not available to the camera.
- 3) All camera power shall comply with the specified power requirements.

### **3.02 POWER REQUIREMENTS**

- A Provide uninterruptible power supplies for all active surveillance equipment
  1. Rack mounted components, including all active network communication hardware, shall be on an Uninterruptible Power Supply (UPS) system.
  2. Refer to Section 28 02 00 for UPS and power requirements
  3. Camera power supplies shall be on an Auxiliary Power Supply (APS), system as required, with a battery backup.
    - a. The Auxiliary power supply shall be furnished with a power distribution panel with each camera individually fused or protected with an over-current protector.
- B Power supplies shall provide:
  1. 120 VAC input and output voltage as required
  2. UL Listed
  3. Power fail contacts to monitor the status of the input power
    - a. Connect each power supply power fail alarm as a separate alarm input into AC/ID system
  4. Key lockable wall mount metal enclosure with tamper switch
  5. Independently fused outputs

### **3.03 INSTALLATION**

- A Refer to provisions of Section 28 02 00
- B All surveillance system devices and components shall be compatible.
- C Camera Housings and Mounts
  1. Cameras shall include housings and mounts as indicated in the Drawings.
    - a. Provide the smallest available housing for each camera application.
      - 1) Integrated miniature dome cameras are preferred
  2. Wiring to cameras shall pass from the back-box through the mount and into the housing. Exposed wiring or conduit shall not be acceptable.

3. Provide sun shields for camera housings in outdoor locations exposed directly to sunlight.
  4. Provide surge protection for power and copper video cables for exterior cameras at the camera and at the point of termination (security rack).
  5. Field verify the exact camera location, position, and mounting prior to installation.
  6. Roof mounted cameras shall use roof deck brackets.
- D Video Management Control System
1. System platform software shall be 'open architecture' allowing for compatibility and integration with other building automated systems.
  2. The system shall allow for secure remote viewing of live and recorded video as required.
- E Provide labeling suitable to Owner for all major equipment components. Coordinate with Owner on numbering scheme to match existing. Major equipment components:
1. IP Video monitors, IP camera Patch Panels, PoE Switches (or mid-span units), Network Video Recorders (NVR), and fiber mux units (if required).
- F Coordinate with Telecommunication subcontractor for network and patch panel provisions for security connections in the IT room. (If applicable)
- G Coordinate with Owner for all system programming and database requirements.
1. Provide all programming, setup, camera and device titling and data entry
  2. Camera and device title and descriptions shall be consistent for all components
- H Install all Point-to-Point wiring with appropriate terminal connections for every wire and component termination so that all connections are mechanically and electrically secure.
- I Install field wiring in continuous lengths, without splices.
- J Verify upon job completion that all wiring and terminations are clearly labeled to identify the wire and terminal.
- K Testing of the surveillance system includes checkout of installed cameras back to the Security head end equipment to confirm proper operation of camera assemblies. Security integrator shall provide all necessary test equipment to fully demonstrate proper performance of field devices. Copies of test results shall be included in the project completion submittals given to the Owner.

**END OF SECTION 28 20 00**



## **SECTION 28 31 00 - INTRUSION DETECTION SYSTEM**

### **PART 1 - GENERAL**

#### **1.01 SUMMARY/OVERVIEW**

- A This section provides specifications for the installation of Electronic Intrusion Detection (ID), and related components.

#### **1.02 RELATED SECTIONS**

- A Drawings and general provisions of the Contract, including General and Supplementary Conditions and Division 1 Specification Sections, apply to this Section.
- B Related Spec Sections
  - 1. Section 08 71 00 - Door Hardware
  - 2. Section 26 00 00 - Electrical (including related sub-sections)
  - 3. Section 27 02 00 - Basic Materials and Methods for Communications Systems (including related sub-sections)
  - 4. Section 28 02 00 - Basic Materials and Methods for Safety and Security Systems
  - 5. Section 28 10 00 - Access Control System
  - 6. Section 28 20 00 - Video Surveillance System
  - 7. Section 284600 - Fire Alarm and Smoke Detection

#### **1.03 REFERENCES**

- A See Section 28 02 00

#### **1.04 SYSTEM COORDINATION**

- A The Security Integrator shall completely coordinate all relevant work of other trades/systems including, but not limited to:
  - 1. Door Hardware
  - 2. Fire Alarm System
  - 3. Electrical Systems(s)
  - 4. Telecommunications System(s)

#### **1.05 GENERAL SYSTEM DESCRIPTION**

- A General Requirements

1. Furnish all labor, materials, tools, equipment, and services for a complete security system as indicated and in accordance with provisions of the contract documents.
  2. Although such work is not specifically indicated, furnish and install all supplementary or miscellaneous items, and devices incidental to or necessary for a sound, secure and complete installation.
  3. Comply with the provisions of Division 1 for General Requirements.
    - a. In the event of a conflict between the provisions of this Section and Division 1, the more stringent provisions shall apply.
  4. All system devices and components included shall be compatible.
- B The project shall be equipped with new system that is maintained by the police department.
1. All work required within the project for new ID system head end shall be furnished and installed by the project security contractor.
- C The ID system will support the needs of the project in accordance with these specifications.
1. The ID system shall have the capability for future expansion to support the security needs of the completed complex.
- D The ID system shall be interfaced with the Fire Alarm system (by others) as required to comply with all building code requirements.
- E Emergency/UPS power will be utilized to power the ID system's computer workstation (client) at the Security head end equipment location.
- F Emergency/APS power will be utilized to power the ID system's Data Gathering Panels and control components as required throughout the facility.

## **1.06 INTRUSION DETECTION SYSTEM**

- A A series of field installed alarm initiating devices shall be connected to the ID system so that status changes of the devices are transmitted to the security management system.
1. Provide Data Gathering Panels (DGP), alarm devices, and keypads to be connected to the security management system via Local Area Network (LAN).
  2. The security integrator shall coordinate network and IP address requirements with Owner to identify the Media Access Control (MAC) address (Layer 2) of each provided device, the location to be installed, and the port configuration needed for communication.
- B Tamper Switches

1. Typically closed tamper switches to monitor the secure status of all DGP's, power supplies, terminal cabinets, power distribution units, and other Security System cabinets and enclosures.
  2. Fasten tamper switches within the cabinet to provide no access to the switch and fasteners when the cabinet is closed.
  3. Provide independent monitoring of tamper conditions for each cabinet.
    - a. Include the number of tamper switches in the total alarm input figures.
- C Provide ID keypads conveniently located near areas being protected so as to allow devices to arm and disarm.

#### **1.07 SUBMITTALS**

- A Follow provisions of Section 28 02 00 additional requirements.
- B Field Test Reports
1. Upon completion and testing of the installed system, test reports shall be submitted in booklet form and electronic media showing all field tests performed on, and adjustments made to each/any component and all field tests performed to prove compliance with the specified performance criteria.
  2. Indicate and interpret test results in written form and verbally to owner/DBR for compliance with performance requirements at a pre-scheduled meeting.
- C Battery calculations to show the expected loads and backup duration for power supplies and UPS devices for all active ID equipment.
- D Security Contractor is responsible to prepare and submit as required to the Authority Having Jurisdiction (AHJ) any and all information to obtain an Electronic Locking Mechanisms permit.

#### **1.08 QUALITY ASSURANCE**

- A Follow provisions of Section 28 02 00
- B Spare Parts:
1. Provide two (2) spare components for every model and configuration of electronic components and devices used on the project as spare parts inventory.
    - a. The security integrator will turn over the new and unused components and devices to the owner at project closeout.

#### **1.09 DELIVERY, STORAGE AND HANDLING**

- A Follow provisions of Section 28 02 00

## **1.10 PROJECT/SITE CONDITIONS**

- A Follow provisions of Section 28 02 00

## **1.11 WARRANTY**

- A Follow provisions of Section
- B All devices and components shall comply with applicable U.L. standards.

## **PART 2 - PRODUCTS**

### **2.01 ACCEPTABLE INTRUSION DETECTION MANUFACTURERS**

- A ID System Platform Software
  - 1. Bosch RPS (Remote Programming Software) D5500CU
- B Intrusion Detection Data Gathering Panels (DGP)
  - 1. Bosch B9512G
  - 2. Owner Approved Equivalent
- C Keypads
  - 1. Bosch Bosch B915
  - 2. Owner Approved Equivalent
- D Tamper Switches
  - 1. Sentrol 3010
  - 2. Owner Approved Equivalent
- E Dual Technology Motion Detectors
  - 1. 360 degree: Bosch DS9370
  - 2. Owner Approved Equivalent
- F **Wall Mounted Motion Detectors**
  - 1. **Wide Angle: Bosch ISC-PDL1-W18G**
  - 2. **Narrow Angle,Long Range : Bosch ISC-PDL1-WC30G**
  - 3. **Or owner approved Equivalent**
- G **Speaker Strobe with Colored Lenses**
  - 1. **Bosch E70 Speaker Strobe Blue**

2. **Or owner approved Equivalent**

**H POPIT Expansion Module**

1. **Bosch B299**
2. **Or approved Equivalent**

**I POPIT Input Module**

1. **Bosch D9127T**
2. **Or approved Equivalent**

**J Ethernet Expansion Module**

1. **Bosch B426**
2. **Or approved equivalent**

**K Powe Supply Expansion Module**

1. **Bosch B520**
2. **Or approved Equivalent**

## **PART 3 - EXECUTION**

### **3.01 GENERAL REQUIREMENTS**

**A Power Supplies**

1. Power supply requirements
  - a. A switch and on/off indicator within the power supply cabinet.
  - b. Four hours of sealed gel battery backup to provide continuous operation during power failure.
    - 1) Provide batteries as required to provide specified battery backup time for a fully loaded power supply, regardless of the connected load.
  - c. A battery charger to maintain the battery.
  - d. Low battery and power fail contacts to monitor the status of the input power and the battery.
    - 1) Connect each power supply low battery and power fail alarm as a separate alarm input into DGP.
  - e. Key lockable wall mount metal enclosure with tamper switch.
2. Additional DGP Power Supply Requirements

- a. The DGP power supply provides power only to DGP's and shall not provide power for locks or any other low voltage device.
3. Additional Device Power Supply Requirements
  - a. Provide device power supplies for other security system devices requiring power (e.g. card readers, local alarms, motion sensors, etc.)
  - b. Provide power distribution boards with independently fused outputs.

#### B Video Surveillance System Integration

1. Automatic Video Call-up
  - a. All alarms shall call up all cameras in the area of alarm to the screen of the ACID alarm operator workstation to allow for operator assessment of the alarm.
2. Pre and Post Alarm Video
  - a. The operator shall be able to view up to 10 seconds of video before the alarm and 30 seconds after the alarm for all cameras associated with the alarm.
  - b. This feature is to be integrated with the operator alarm notification to assist in alarm assessment.
  - c. This feature shall be displayed as an option on the alarm notification screen and will not require operator to make a manual video search.
3. Recording
  - a. All cameras whose field of view that include images of the area affected by the alarm, shall be recorded when an alarm is detected for use in forensic analysis, including the pre and post alarm video.
4. Duress and Emergency Intercommunications Integration
  - a. Calls from emergency intercoms/phones with cameras shall provide the above video call-up and the pre and post alarm video capabilities.

#### C Access Control Intergration

1. **Intrusion system is to be intergrated with owners RS2 access control system. Contractor shall coordinate arm and disarm fuction required for all exterior door card readers and dedicated arming card readers .**

#### D Tamper Resistant Screws

1. Provide appropriate screw heads for each application (e.g. countersunk heads for recessed cover plate screws, flat head screws for standard junction box covers, etc.).
2. The security integrator shall provide Torx® tamper resistant screws for:

- a. Junction boxes located above doors
- b. Junction boxes located below ceiling height and/or within reach of hatch ladders
- c. Security device cover plates
- d. Surface mounted door position switches and armored cable

### **3.02 ENCLOSURE INSTALLATION**

- A Enclosures shall be lockable with a tamper switch and installed in a manner to be accessible with clearance to fully open enclosure door.
- B All security panels shall be wired through a dedicated power supply with battery backup.
  - 1. Power to the data gathering panels is to be hardwired utilizing EMT or rigid conduit in accordance with the Electrical specifications.
  - 2. A circuit from the Fire Alarm panel must be installed to each lock power distribution panel.
- C Enclosures shall be installed on designated wall fields in a neat and compact manner to allow for future growth.
- D Enclosures shall be sized to allow for 20% growth in each panel.
- E All panels and boards shall be installed in enclosure(s) suitable to their environment and have sufficient size and orientation to include all system components.
- F Each panel shall be labeled accordance with Owner standards.
  - 1. The label for each panel shall be posted on the exterior of the panel door.
    - a. Each panel shall have a list of devices connected to it located on the inside cover.
    - b. A detailed device layout drawing will be located on the inside of the panel door in an appropriate sleeve and keeper.

### **3.03 FURTHER REQUIREMENTS**

- A Refer to provisions of Section 28 02 00
- B Furnish and coordinate installation of all special device back boxes and ACID field devices as shown on the security drawings and as specified in this section.
- C The exact installation locations of all equipment shall be coordinated and verified with the Contractor prior to installation.
  - 1. Subcontractor shall notify the Contractor if any location appears to be unsuitable.
- D Provide low voltage power supplies for electric locking devices and ACID devices and components as shown on the security drawings and specified in this Section.

- E Coordinate with the Telecommunications Subcontractor for data network connections, IP address requirements, and telephone circuits as required.
- F Prepare all systems for user operation.
  - 1. The security system must be complete and ready to operate prior to Owner final acceptance of the system.
- G Coordinate with the Owner for all system programming requirements.
- H **Kitchen area is to be programmed as an independent Zone. Coordinate the exact programming with the owner**
- I Perform database programming as required to support the card reader, alarm point, surveillance system integration, and control panel configuration as required.

**END OF SECTION 28 31 00**



## **SECTION 31 32 13.26 - LIME-FLY ASH OR FLY ASH STABILIZATION**

---

### **PART 1 - GENERAL**

#### **1.01 SCOPE OF WORK**

- A. This Section specifies the requirements for treating and stabilizing existing subgrade material or select fill material under pavements or site structures as shown on the drawings, by pulverizing, adding lime and or fly ash, and finishing to the lines and grades shown on the drawings and constructed as specified herein.
- B. This section excludes work necessary for building pad preparations. Work within the building footprint and surrounding 5 feet shall be accomplished under technical specification 31 23 00 Excavation and Fill prepared by structural engineer.

#### **1.02 RELATED WORK SPECIFIED ELSEWHERE**

- A. Drawings and general provisions of the Contract, including A-procurement and Contracting Requirements, Division 00 and Division 01 apply to this section.
- B. Clearing and Grubbing: Section 31 11 00
- C. Site Grading: Section 31 22 13
- D. Asphalt Concrete Paving: Section 32 12 16
- E. Concrete Pavement: Section 32 13 13

#### **1.03 PROJECT/SITE CONDITIONS**

- A. It is the primary requirement of this specification to secure a completed course of treated material containing a uniform lime fly ash or fly ash mixture free from loose or segregated areas, or uniform density and moisture content, well bound for its full depth and with a smooth surface suitable for placing subsequent courses. It is to be the responsibility of the Contractor to regulate the sequence of his work, to process a sufficient quantity of material to provide full depth as shown on PLANS, to use the proper amounts of lime and fly ash, maintain the work, and rework the courses as necessary to meet the above requirements.

#### **1.04 SUBMITTALS (Not Used)**

#### **1.05 APPLICABLE PUBLICATIONS**

- A. American Society for Testing and Materials (ASTM) C977-03 Standard Specification for Quicklime and Hydrated Lime for Soil Stabilization.
- B. ASTM Specification C618-08 Standard Specification for Coal Fly Ash and Raw or Calcined Natural Pozzolan for Use in Concrete.

- C. Texas Department of Transportation Test Method Tex-114-E, Laboratory Compaction Characteristics and Moisture-Density Relationship of Subgrade, Embankment Soils, and Backfill Material
- D. Texas Department of Transportation 2004 Standard Specifications for Construction of Highways, Streets and Bridges (TxDOT) Item 420 Weighing and Measuring Equipment.

## **1.06 DEFINITIONS**

- A. Subgrade: The uppermost surface of an excavation, including excavation for trenches, or the top surface of a fill or backfill immediately below the base course, pavement, granular leveling fill, or topsoil materials.
- B. Geotechnical Engineer: The Geotechnical Engineer responsible for geotechnical design and materials testing.
- C. Base Course: The granular material forming the pavement base supported by the subgrade in asphalt pavement or unit paver pavement sections.
- D. Embankment: soil material used to fill an excavation

## **1.07 QUALITY ASSURANCE**

- A. Codes and Standards: Perform earthwork complying with requirements of authorities having jurisdiction.
- B. Testing and Inspection Service: Owner will employ a qualified independent geotechnical engineering testing agency to classify proposed on-site and borrow soil materials to verify that soils comply with specified requirements and to perform required field and laboratory testing. Contractor responsible to coordinate with the testing agency prior to start of work requiring testing so as to minimize unnecessary cost or delays to the project.
- C. Testing:
  - 1. Owner will retain and pay a qualified Geotechnical engineer to take all field samples and do all laboratory testing necessary to verify compliance of the work to these Specifications or as required by City or other regulatory agencies. The Geotechnical Engineer shall submit results of all testing done during the course of the work to the Owner, Architect, and Contractor.
  - 2. Notify testing lab a minimum of 48 hours in advance of the time testing is required to satisfy requirements of this section.
  - 3. Should testing specified above show work which does not satisfy these Specifications, the Contractor shall pay, through the Owner, for all additional tests required to determine the extent of work that is not satisfactory and for all additional tests necessary to demonstrate compliance with these specifications.
  - 4. All tests shall be performed by the Geotechnical Engineer in accordance with Test Method Tex-114-E or other approved methods selected by Geotechnical Engineer.

- D. Certification: (none needed)

## **PART 2 - PRODUCTS**

### **2.01 LIME**

- A. Lime to meet the requirements of ASTM C977-03 for hydrated lime or quicklime. When Quicklime is specified, the Contractor is to select, prior to construction, the grade to be used and notify the Engineer in writing before changing from one grade to another.

### **2.02 FLY ASH**

- A. Fly ash to meet ASTM Specification C618-05, Class C. Fly ash to also have a minimum CaO content of 20 percent.

### **2.03 WATER**

- A. Water used for mixing or curing shall be reasonably clean and free of oil, salt, acid, alkali, sugar, vegetable matter or other substances injurious to the finished product.
- B. Water sources other than the local municipal domestic water supply must be approved by the Owner.
1. If onsite reclaimed water sources are used, tanks and apprentices must be clearly marked with the words "non-potable" water.

### **2.04 SOIL**

- A. Soil should be a clayey type soil, free of organic material, large rocks and other unsuitable materials with a plasticity index greater than 10 and a liquid limit in excess of 30. The soil should not contain more than twenty percent sands or silts.

## **PART 3 - EXECUTION**

### **3.01 EQUIPMENT**

- A. All machinery, tools, and equipment used are to be maintained in a satisfactory and workmanlike manner.
- B. Lime and fly ash is to be stored and handled in closed weather-proof containers until immediately before distribution on the road. If storage bins are used, they are to be completely enclosed. Material in bags to be stored in weatherproof buildings with adequate protection from ground dampness.
- C. If lime and/or fly ash is furnished in trucks, each truck is to have the weight of lime and fly ash verified on public scales. Scales are to conform to the requirements of the TxDOT Item 420 "Weighing and Measuring Equipment."
- D. If lime and/or fly ash is furnished in bags, each bag is to bear the manufacturer's certified weight. Bags varying more than 5 percent from that weight may be rejected. The average weight of

bags in any shipment, as shown by weighing 50 bags taken at random, is to be not less than the manufacturer's certified weight.

### 3.02 CONSTRUCTION

- A. Preparation of Roadbed: Before other operations are begun, the roadbed is to be graded and shaped as required to construct in conformance with the lines, grades, thickness, and typical cross-section on the PLANS. Unsuitable soil or material to be removed and replaced with acceptable material. The subgrade to be firm and able to support, without displacement, the construction equipment and the compaction hereinafter made stable by scarifying, and aeration or adding lime and/or fly ash, and compacting until it is of uniform stability. If the Contractor elects to use a cutting and pulverizing machine to remove the subgrade material accurately to the secondary grade and pulverizing the material at the same time, there is no requirement to neither expose the secondary grade nor windrow the material. However, the Contractor will be required to roll the subgrade, as directed by the geotechnical engineer, before using the pulverizing machine and correct any soft areas that this riling may reveal. This method to be permitted only where a machine is provided, which ensures that the material is cut uniformly to the proper depth and which has cutters to plane the secondary grade to a smooth surface over the entire width of the cut. The machine to be of such design that a visible indication is given at all times that the machine is cutting to the proper depth.
- B. Application: Lime to be spread only on that area where the first mixing operation can be completed during the same working day. The sequence for application of lime and fly ash to be as specified below. The application and mixing of lime or fly ash with the material to be accomplished by the methods hereinafter described as "Slurry Placing."
  - 1. Slurry Placing: The lime or fly ash to be mixed with water in vehicles with approved distributors and applied as a thin water suspension or slurry. Quicklime to be applied with a lime percentage not less than that applicable for the grade used. The distribution of lime or fly ash as directed by the Owner to be attained by successive passes over a measured section of roadway until the proper moisture and lime or fly ash content has been secured. The distributor vehicle to be equipped with an agitator to keep the lime or fly ash and water in a uniform mixture.
- C. Mixing
  - 1. Mixing: The materials to be uniformly mixed by approved methods.
    - a. If the soil binder lime mixture contains clods, they are to be reduced in size by raking, blading, sinking, barrowing, scarifying, or the use of other approved pulverization methods. This shall be done in a way such that when all nonslaking aggregates retained on the No. 4 sieve are removed, the remainder of the material is to meet the following requirements when tested at the field moisture condition or dry by laboratory sieves.
      - 1) Minimum Passing 1-3/4-inch Sieve: 100 percent.
      - 2) Minimum Passing No 4 Sieve: 60 percent.
    - b. It is the intent of this specification that lime and fly ash may be spread sequentially prior to commencement of mixing operations.

- c. During the interval of time between application and mixing, hydrated lime or fly ash that has been exposed to excessive loss due to washing or blowing not to be accepted for payment. Spreading, mixing, compaction, and finishing for lime-fly ash stabilized subgrade to be completed during daylight hours of the same day.
- 2. Mixing Procedures for Fly Ash Only: If fly ash only is to be used without lime, the following mixing procedures to apply.
  - a. The raw material to be thoroughly mixed by approved road mixers or other approved equipment, and the mixing continued until a homogeneous, friable mixture is obtained, free from all clods or lumps.
  - b. The fly ash to be distributed at a uniform rate and in such manner as to reduce the scattering of fly ash by wind. Fly ash not to be applied when wind conditions are such that blowing fly ash becomes objectionable to traffic or adjacent property owners. A motor grade shall not be used to spread fly ash.
  - c. The material and fly ash to be thoroughly mixed by approved road mixers or other approved equipment, and the mixing continued until a homogeneous, friable mixture of material is obtained, free from all clods or lumps. If the soil bind-fly ash mixture contained clods, they are to be reduced in size by raking, blading, discing, hallowing scarifying, or the use of other approved pulverization methods. This shall be done in a way such that when all nonslaking aggregates retained on the No. 4 sieve are removed, the remainder of the material meets the following requirements when tested at the field moisture condition or dry by laboratory sieves:
    - 1) Minimum Passing 1-3/4-inch Sieve: 100 percent.
    - 2) Minimum Passing No. 4 Sieve: 60 percent.
  - d. Fly ash to be applied only to such an area that all the operations can be continuous and completed in daylight.
  - e. During the interval of time between application and mixing, fly ash that has been exposed to the open air for a period of 6 hours or more or to excessive loss due to washing or blowing not to be accepted for payment. It is recommended that mixing and compaction of fly ash stabilized subgrade be completed within 2 hours in order to take advantage of rapid initial set characteristics.
  - f. Mixing after the addition of fly ash to be accomplished dry or with a minimum amount of water to prevent fly ash balls.
- D. Compaction: Compaction of the mixture to begin immediately after adding and mixing of the last stabilizing agent and be completed within 6 hours. The material to be aerated or sprinkled as necessary to provide the optimum moisture. Compaction to begin at the bottom and continue until the entire depth of mixture is uniformly compacted by the "Density Control" method.

Description	Density
For Lime-Fly Ash or Fly Ash Treated Subgrade	Not less than 95 percent

The testing to be as outlined in Test Method Tex-114-E or other approved methods. In addition to the requirements specified for density, the full depth of the material shown on the PLANS to be compacted to the extent necessary to remain firm and stable under construction equipment. Throughout this entire operation, the shape of the base course to be maintained by blading, and the surface upon completion to be smooth and in conformity with the typical section shown on the PLANS and to the established lines and grades.

- E. Finishing, Curing, and Preparation for Surfacing: After the final layer or course of the lime-fly ash or fly ash treated subgrade, subbase, or base has been compacted, it is to be brought to the required lines and grades in accordance with the typical sections.
1. The resulting base surface to be thoroughly rolled with a pneumatic tire roller and "clipped," "skinned," or "tight bladed" by a power grader to a depth of approximately 1/4-inch, removing all loosened stabilized material from the section. The surface then to be thoroughly compacted with the pneumatic roller, adding small increments of moisture as needed during rolling. If plus No. 4 aggregate is present in the mixture, one complete coverage of the section with the flat wheel roller to be made immediately after the "clipping" operation. Surface finishing methods to be varied from this procedure provided a dense, uniform surface free of surface compaction planes is produced. The moisture content of the surface material must be maintained at optimum during all finishing operations. Surface compaction and finishing to proceed in such a manner as to produce, in not more than 2 hours, a smooth, closely knit surface, free of cracks, ridges, or loose material conforming to the crown, grade, and line shown on the plans.
  2. After the lime-fly ash or fly ash treated course has been finished as specified herein, the surface is to be protected against rapid drying by either of the following curing methods for a period of not less than 3 days or until the surface or subsequent courses are placed.
    - a. Maintain a thorough and continuously moist condition by sprinkling.
    - b. Apply a 2-inch layer of earth on the completed course and maintain in a moist condition.
  3. Completed sections of lime-fly ash or fly ash treated material in place may be opened immediately to local traffic and to construction equipment and to all traffic after the curing period, provided the lime-fly ash or fly ash treated course has hardened sufficiently to prevent marring or distorting the surface by equipment or traffic.

### 3.03 MEASUREMENT

- A. Lime-fly ash or fly ash treatment of the subgrade, existing subbase, and existing base to be measured by the square yard to neat lines as shown on the typical sections. When dry lime or quick lime is used, the quantity of lime to be measured by the ton of 2,000 pounds dry weight. When Quicklime is used, the quantity of lime to be calculated from the required minimum percent solids based upon the use of Grade 1, Grade 2, or Grade 3 as follows.
1. Grade 1: The "Dry Solids Content" to be at least 31 percent by weight of the slurry and the quantity of lime to be calculated by the ton of 2,000 pounds based on the 31 percent, as delivered on the road.

2. Grade 2: The "Dry Solids Content" to be at least 35 percent by weight of the slurry and the quantity of lime to be calculated by the ton of 2,000 pounds based on the 35 percent, as delivered on the road.
  3. Grade 3: The "Dry Solids Content" to be at least 46 percent by weight of the slurry and the quantity of lime to be calculated by the ton of 2,000 pounds based on the 46 percent, as delivered on the road.
- B. Fly ash to be measured by the ton of 2,000 pounds dry weight. Fly ash may be applied in dry or in Slurry form. Moisture content in the final mix not to exceed moisture by more than 2 percent.

### **3.04 PAYMENT**

Work performed and materials furnished as prescribed by this Item and measured as provided under paragraph 3.3A are to be paid at the lump sum price bid in the proposal.

- A. Fly ash to be paid for at the unit bid per ton of 2,000 pounds for "Fly Ash," which price to be full compensation for furnishing all fly ash.
- B. "Lime-Fly Ash Treated Subgrade (Density Control)" and "Fly Ash Treated Subgrade (Density Control)" to be paid for at the unit price bid per square yard of compacted subgrade.
1. Manipulation of "Lime-Fly Ash Treated Subgrade" and "Fly Ash Treated Subgrade" to be paid for at the unit price bid per square yard per Item "Manipulation of Lime, Fly Ash, and or Cement for Stabilization of Compacted Subgrade."
  2. "Density Control" is required on this project. Sprinkling and rolling not to be paid for directly, but the cost of all sprinkling and rolling to be subsidiary to other bid items.
  3. The unit price bid to be full compensation for all correction of secondary subgrade; for loosening, mixing, pulverizing, spreading, drying, application of lime and/or application of fly ash, water content of the slurry, shaping, and maintaining; for all manipulations required; for all hauling and freight involved; for all tools equipment, labor, and for all incidentals necessary to complete the work.

END OF SECTION





# NEW CANEY I.S.D.

## NEW CANEY ELEMENTARY SCHOOL


19300 VIA CORSICA DRIVE  
NEW CANEY, TX 77357

BRW PROJECT NO.: 223117.00  
CLIENT PROJECT NO. 102-2023  
SEPTEMBER 9, 2024

### BOARD OF TRUSTEES

- |                   |   |                     |
|-------------------|---|---------------------|
| CREG MIXON        | - | PRESIDENT           |
| ELIZABETH HARRELL | - | VICE PRESIDENT      |
| WENDY SHARP       | - | SECRETARY           |
| ANGELA TOMPKINS   | - | ASSISTANT SECRETARY |
| CHAD TURNER       | - | BOARD MEMBER        |
| TY TROUT          | - | BOARD MEMBER        |
| BETH PRYKRYL      | - | BOARD MEMBER        |

### VICINITY MAP

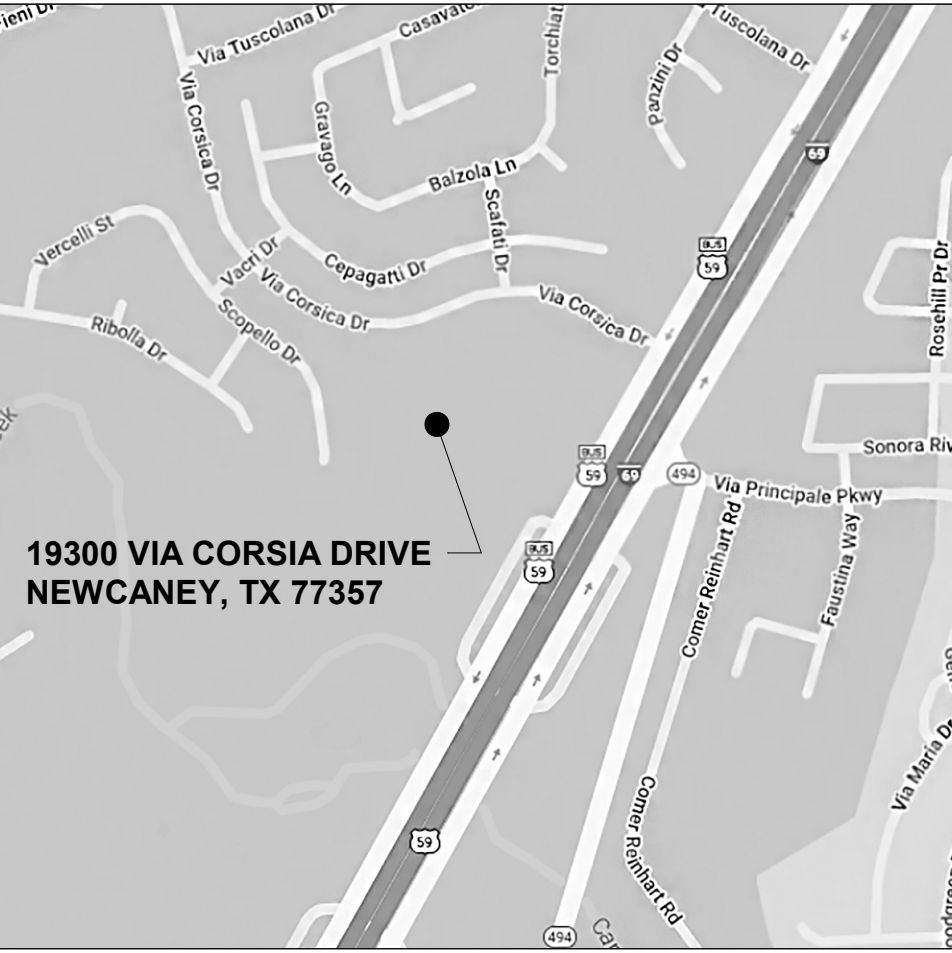

### OWNER

### NEW CANEY INDEPENDENT SCHOOL DISTRICT

22784 US HIGHWAY 59, BUILDING E  
PORTER, TX 77365  
281.577.8600

### ARCHITECT

### BROWN REYNOLDS WATFORD ARCHITECTS

4501 MAGNOLIA COVE DRIVE, SUITE 250  
HOUSTON, TX 77345  
281.361.3800

### CIVIL ENGINEER/ STRUCTURAL ENGINEER

### DALLY + ASSOCIATES, INC.

9800 RICHMOND AVE, SUITE 460  
HOUSTON, TEXAS 77042  
713.337.8881

### LANDSCAPE ARCHITECT

### WESTWOOD PROFESSIONAL SERVICES

20349 STATE HIGHWAY 249, SUITE 350  
HOUSTON, TEXAS 77070  
281.883.0103

### MECHANICAL / ELECTRICAL / PLUMBING/ TECHNOLOGY ENGINEER

### DBR ENGINEERING CONSULTANTS, INC.

9990 RICHMOND AVE, SOUTH BUILDING, SUITE 300  
HOUSTON, TEXAS 77042  
713.914.0888

### FOODSERVICE

### FOODSERVICE DESIGN PROFESSIONALS

253171 I-45,  
THE WOODLANDS, TEXAS 77380  
281.350.2323

### SYMBOL LEGEND

NORTH ARROWS

ARTIFICIAL PROPERTY LINE / LIMITS OF CONSTRUCTION

BUILDING SETBACK LINE/EASEMENT

EXISTING CONTOURS

REVISED CONTOURS

EXISTING SPOT GRADE

REVISED SPOT GRADE

WORKING POINT, CONTROL OR DATUM POINT

COLUMN DESIGNATION

DETAIL BUBBLE

BUILDING SECTION

WALL SECTION

FACE OF FINISH DIMENSIONING

MATCH LINE

VIEW TITLE

SHEET NUMBERING:

SHEET TYPE DESIGNATOR

DISCIPLINE DESIGNATOR

A1.2

1

EXTERIOR ELEVATION

A1.2

1

INTERIOR ELEVATION

KEYNOTE

WALL TYPE

DOOR NUMBER

WINDOW TYPE

REVISIONS

ROOM NAME

101A

ROOM NAME DESIGNATION & NUMBER

CP1 | RB1 | P1 | AC1

CEILING FINISH

WALL FINISH

BASE FINISH

FLOOR FINISH

ROOM NAME

101A

ROOM NAME DESIGNATION & NUMBER

AC1

P1

RB1

CP1

CEILING FINISH

WALL FINISH

BASE FINISH

FLOOR FINISH

FINISH SYMBOL

SIGNAGE SYMBOL

NEW CONSTRUCTION

NEW FIRE RATED CONSTRUCTION

EXISTING WALL TO REMAIN

ALIGN

TEMPERED GLASS

REFERENCES:

SHEET NUMBER

DETAIL NUMBER

### INDEX OF DRAWINGS

G1.1	TITLE SHEET	S5.3	TYPICAL ROOF FRAMING DETAILS (JOIST)	FS1.7	FS ELECTRICAL PLAN	E5.3	ELECTRICAL PANEL SCHEDULES
G1.2	MASTER KEYNOTE LIST	S5.4	TYPICAL ROOF FRAMING DETAILS (BEAMS)	FS2.1	FS EXHAUST HOODS	E5.4	ELECTRICAL PANEL SCHEDULES
G1.3	TYPICAL ACCESSIBILITY DETAILS	S5.5	TYPICAL MISC. STEEL DETAILS	FS2.2	FS CONDENSING UNITS	E6.1	ELECTRICAL DETAILS
G1.4	LIFE SAFETY PLAN	S5.6	TYPICAL CMU DETAILS	FS2.3	FS WALK-INS	E6.2	ELECTRICAL DETAILS
		S7.1	STEEL ROOF (OVERFLOW)	FS2.4	FS SERVING COUNTERS	E6.3	ELECTRICAL DETAILS
AS1.1	SITE PLAN	S7.2	LOW ROOF FRAMING DETAILS	FS2.5	FS SERVING COUNTERS	E7.1	ELECTRICAL DETAILS
AS1.2	SITE DETAILS	S8.1	BRACE ELEVATIONS & DETAILS	FS3.1	FS ELEVATIONS		
AS1.3	SITE DETAILS	S8.2	BRACE ELEVATIONS	FS3.2	FS SECTIONS & DETAILS	EL1.1	COMPOSITE ELECTRICAL LIGHTING PLAN
AS1.4	CANOPY PLANS AND DETAILS			FS3.3	FS DETAILS	EL2.1A	ELECTRICAL LIGHTING AND SPECIAL SYSTEMS PLAN AREA A
		A1.0	PARTITION TYPES	FS3.4	FS DETAILS	EL2.1B	ELECTRICAL LIGHTING AND SPECIAL SYSTEMS PLAN AREA B
C0.0	TOPOGRAPHIC SURVEY	A1.1	COMPOSITE PLAN	MEPT1.1	MEPT SITE PLAN	EL2.1C	ELECTRICAL LIGHTING AND SPECIAL SYSTEMS PLAN AREA C
C1.0	GENERAL NOTES	A1.1A	FLOOR PLAN AREA A			EL2.1D	ELECTRICAL LIGHTING AND SPECIAL SYSTEMS PLAN AREA D
C2.0	DEMOLITION PLAN	A1.1B	FLOOR PLAN AREA B			EL2.1E	ELECTRICAL LIGHTING AND SPECIAL SYSTEMS PLAN AREA E
C3.0	LAYOUT PLAN	A1.1C	FLOOR PLAN AREA C	M0.1	MECHANICAL SYMBOL LEGEND	EP1.1	COMPOSITE ELECTRICAL POWER PLAN
C4.0	PAVING PLAN	A1.1D	FLOOR PLAN AREA D	M2.1A	MECHANICAL PLAN AREA A	EP2.1A	ELECTRICAL POWER PLAN AREA A
C5.0	FIRE ACCESS PLAN	A1.1E	FLOOR PLAN AREA E	M2.1B	MECHANICAL PLAN AREA B	EP2.1B	ELECTRICAL POWER PLAN AREA B
C6.0	UTILITY PLAN	A1.4	ROOF PLAN	M2.1C	MECHANICAL PLAN AREA C	EP2.1C	ELECTRICAL POWER PLAN AREA C
C7.0	GRADING PLAN	A1.5	ROOF DETAILS	M2.1D	MECHANICAL PLAN AREA D	EP2.1D	ELECTRICAL POWER PLAN AREA D
C8.0	DRAINAGE PLAN	A1.6	PLAN DETAILS	M2.1E	MECHANICAL PLAN AREA E	EP2.1E	ELECTRICAL POWER PLAN AREA E
C9.0	DRAINAGE CALCS	A2.1	EXTERIOR ELEVATIONS	M2.2	MECHANICAL ROOF PLAN	EP2.2A	MECHANICAL POWER PLAN AREA A
C10.0	MITIGATION PLAN	A2.2	EXTERIOR ELEVATIONS	M3.1	ENLARGED CENTRAL PLANT	EP2.2B	MECHANICAL POWER PLAN AREA B
C11.0	MITIGATION CROSS SECTIONS	A3.1	WALL SECTIONS	M3.2	ENLARGED MECHANICAL ROOMS	EP2.2C	MECHANICAL POWER PLAN AREA C
C12.0	SWPP	A3.2	WALL SECTIONS	M4.1	MECHANICAL FLOW DIAGRAMS	EP2.2D	MECHANICAL POWER PLAN AREA D
C13.0	STORM SEWER AND SWPP DETAILS	A3.3	WALL SECTIONS	M5.1	MECHANICAL SCHEDULES	EP2.2E	MECHANICAL POWER PLAN AREA E
C14.0	WATER DETAILS	A3.4	WALL SECTIONS	M5.2	MECHANICAL SCHEDULES		
C15.0	SANITARY DETAILS	A3.5	SECTION DETAILS	M5.3	MECHANICAL SCHEDULES		
		A4.1	DOOR SCHEDULE	M6.1	MECHANICAL DETAILS		
L1.0	PLANTING PLAN AND NOTES	A4.2	DOOR AND WINDOW DETAILS	M6.2	MECHANICAL DETAILS		
L1.1	PLANTING DETAILS AND NOTES	A4.3	DOOR AND WINDOW DETAILS	M7.1	MECHANICAL CONTROL DIAGRAMS		
L2.0	IRRIGATION PLAN AND NOTES	A4.4	DOOR AND WINDOW DETAILS	M7.2	MECHANICAL CONTROL DIAGRAMS		
L2.1	IRRIGATION DETAILS AND NOTES	A4.5	DOOR AND WINDOW DETAILS	M7.3	MECHANICAL CONTROL DIAGRAMS		
		A5.1	ENLARGED PLANS			T0.1	TECHNOLOGY SYMBOL LEGEND
S0.1	3D VIEW AND SHEET LIST	A5.2	ENLARGED PLANS & DETAILS	P0.1	PLUMBING SYMBOL LEGEND	T1.1	TECHNOLOGY SITE PLAN
S0.2	GENERAL STRUCTURAL CRITERIA	A5.3	INTERIOR ELEVATIONS	P1.1	PLUMBING SITE PLAN	T1.2	COMPOSITE TECHNOLOGY PLAN
S0.3	GENERAL STRUCTURAL CRITERIA	A5.4	INTERIOR ELEVATIONS	P1.2	COMPOSITE PLUMBING PLAN	T2.1A	TECHNOLOGY PLAN AREA A
S1.0	FOUNDATION PLAN OVERALL	A5.5	INTERIOR ELEVATIONS	P1.3	PLUMBING ROOF PLAN	T2.1B	TECHNOLOGY PLAN AREA B
S1.1A	FOUNDATION PLAN AREA A	A5.6	INTERIOR ELEVATIONS	P2.1A	PLUMBING PLAN AREA A	T2.1C	TECHNOLOGY PLAN AREA C
S1.1B	FOUNDATION PLAN AREA B	A5.7	INTERIOR ELEVATIONS	P2.1B	PLUMBING PLAN AREA B	T2.1D	TECHNOLOGY PLAN AREA D
S1.1C	FOUNDATION PLAN AREA C	A5.8	INTERIOR ELEVATIONS	P2.1C	PLUMBING PLAN AREA C	T2.1E	TECHNOLOGY PLAN AREA E
S1.1D	FOUNDATION PLAN AREA D	A5.9	CASEWORK SECTIONS	P2.1D	PLUMBING PLAN AREA D	T3.1	TECHNOLOGY ENLARGED
S1.1E	FOUNDATION PLAN AREA E	A6.1A	CASEWORK SECTIONS	P2.1E	PLUMBING PLAN AREA E	T6.1	TECHNOLOGY DETAILS
S2.0	COMPOSITE ROOF PLAN	A6.1B	REFLECTED CEILING PLAN AREA A	P3.1	ENLARGED FOOD SERVICE PLUMBING PLAN	T6.2	TECHNOLOGY DETAILS
S2.0A	ROOF FRAMING PLAN AREA A	A6.1C	REFLECTED CEILING PLAN AREA B	P4.1	PLUMBING RISERS	T6.3	SECURITY DETAILS
S2.0B	ROOF FRAMING PLAN AREA B	A6.1D	REFLECTED CEILING PLAN AREA C	P5.1	PLUMBING SCHEDULES	T6.4	SECURITY DOOR DETAILS
S2.0C	ROOF FRAMING PLAN AREA C	A6.1E	REFLECTED CEILING PLAN AREA D	P5.2	PLUMBING SCHEDULES	T6.5	SECURITY DOOR DETAILS
S2.0D	ROOF FRAMING PLAN AREA D	A7.1	REFLECTED CEILING PLAN AREA E	P6.1	PLUMBING DETAILS		
S2.0E	ROOF FRAMING PLAN AREA E	A7.1A	COMPOSITE FINISH PLAN	P6.2	PLUMBING DETAILS		
S3.0	COMPOSITE HIGH ROOF PLAN	A7.1B	FINISH PLAN AREA A				
S3.0A	HIGH ROOF FRAMING PLAN AREA A	A7.1C	FINISH PLAN AREA B	E0.1	ELECTRICAL SYMBOL LEGEND		
S3.0B	HIGH ROOF FRAMING PLAN AREA B	A7.1D	FINISH PLAN AREA C	E0.2	ELECTRICAL GENERAL NOTES		
S4.1	DRILLED PIER & PLINTH SCHEDULE & DETAILS	A7.1E	FINISH PLAN AREA D	E1.1	ELECTRICAL SITE PLAN		
S4.2	GRADE BEAM SCHEDULE AND DETAILS	A7.2	FINISH PLAN AREA E	E1.2	ELECTRICAL ROOF PLAN		
S4.3	COLUMN SCHEDULE & DETAILS			E3.1	ENLARGED ELECTRICAL PLANS		
S4.4	TYPICAL FOUNDATION DETAILS	FS1.1	FS GENERAL COORDINATION NOTES	E3.2	ENLARGED ELECTRICAL PLANS		
S4.5	TYPICAL SITE FOUNDATION DETAILS	FS1.2	FS EQUIPMENT PLAN	E3.3	ENLARGED ELECTRICAL PLAN - FOOD SERVICE		
S4.6	FOUNDATION DETAILS (PIER)	FS1.3	FS FACILITY MODEL	E4.1	ELECTRICAL ONE-LINE DIAGRAM		
S4.7	FOUNDATION DETAILS (PIER)	FS1.4	FS EQUIPMENT MODEL	E4.2	ELECTRICAL ONE-LINE SCHEDULES		
S5.1	TYPICAL FRAMING DETAILS	FS1.5	FS SPECIAL CONDITIONS AND MECHANICAL PLAN	E5.1	ELECTRICAL SCHEDULES		
S5.2	TYPICAL FRAMING DETAILS	FS1.6	FS PLUMBING PLAN	E5.2	ELECTRICAL PANEL SCHEDULES		

### ARCHITECTURAL ABBREVIATIONS

A.F.F.	ABOVE FINISH FLOOR	MNTD.	MOUNTED
B.O.	BOTTOM OF	NOM.	NOMINAL
C.J.	CONTROL JOINT	N.I.C.	NOT IN CONTRACT
CL.R.	CLEAR	O.C.(E.W.)	ON CENTER (EACH WAY)
DIA.	DIAMETER	O.H.	OPPOSITE HAND
DN	DOWN	RE:	REFERENCE
E.J.	EXPANSION JOINT	REQ./REQD	REQUIRED
EQ.	EQUAL	R.O.	ROUGH OPENING
F.F.	FINISH FLOOR	SIM.	SIMILAR
F.V.	FIELD VERIFY	T.O.	TOP OF
H.M.	HOLLOW METAL	TYP.	TYPICAL
GA.	GAUGE	U.N.O.	UNLESS NOTED OTHERWISE
M.O.	MASONRY OPENING	W/	WITH
MAX.	MAXIMUM	W.B.	WIND BRACE
MIN.	MINIMUM	W.P.	WORKING POINT

BROWN REYNOLDS WATFORD  
ARCHITECTS  
4501 MAGNOLIA COVE DRIVE  
HOUSTON, TEXAS 77345  
281-361-3800  
WWW.BRWARCH.COM

COPYRIGHT © 2024  
BROWN REYNOLDS WATFORD ARCHITECTS, INC.  
SEPTEMBER 9, 2024  
DATE  
HN, AH, QN, LB  
JSC  
DRAWN BY  
CHECKED BY  
BRW PROJECT NUMBER  
223117.00

NEW CANEY I.S.D.  
NEW CANEY  
ELEMENTARY SCHOOL  
19300 VIA CORSICA DRIVE  
NEW CANEY, TX 77357

NO.	REVISION	DATE
1 <td>ADDENDUM NO.1</td> <td>09/23/24</td>	ADDENDUM NO.1	09/23/24
2 <td>ADDENDUM NO.2</td> <td>10/2/2024</td>	ADDENDUM NO.2	10/2/2024


TITLE SHEET




MASTER KEYNOTE LIST

0100	DIVISION 01 - GENERAL REQUIREMENTS	0760.52	6" PREFINISHED METAL BACKER & COVER PLATES @ ALL JOINTS	1020.16	STAINLESS STEEL 1 1/2" DIAMETER GRAB BAR (36" LONG)	1290.01	BICYCLE RACK
0150.02	TEMPORARY CONSTRUCTION SIGN	0770.04	PREFINISHED METAL REGLET WITH SEALANT AND COUNTERFLASHING	1020.17	STAINLESS STEEL 1 1/2" DIAMETER GRAB BAR (42" LONG)	1290.05	CAN WASH
0200	DIVISION 02 - EXISTING CONDITIONS (TO REMAIN, U.N.O.) & DEMOLITION	0770.06	PREFABRICATED PIPE PEDESTAL	1020.19	STAINLESS STEEL 1 1/2" DIAMETER GRAB BAR (L-SHAPED)	1290.07	REMOVABLE BOLLARD
0300	DIVISION 03 - CONCRETE	0770.07	PREFABRICATED EQUIPMENT SUPPORT	1020.20	SOAP DISPENSER (SURFACE-MOUNTED) (OFCI)	1290.07	FIXED BOLLARD
0310.01	TAMPED, SCREEDED DRY SAND	0770.08	EQUIPMENT CURB WITH GALVANIZED COUNTERFLASHING	1020.21	SOAP DISPENSER (COUNTER-MOUNTED)	1290.08	9 LOOP BICYCLE RACK "KAY PARK" MODEL HW238-11-G
0310.02	3/4" CHAMFER	0770.09	ROOF HATCH WITH INTEGRAL CURB AND COUNTERFLASHING	1020.22	PAPER TOWEL DISPENSER (SURFACE-MOUNTED) (OFCI)	1300	DIVISION 13 - SPECIAL CONSTRUCTION
0310.06	WATER STOP	0770.10	LADDER-UP SAFETY POST	1020.26	JUMBO ROLL TOILET PAPER DISPENSER (OFCI)	1400	DIVISION 14 - CONVEYING EQUIPMENT
0310.10	CONCRETE EXPANSION JOINT, FILL WITH SEALANT TO WITHIN 1/4" OF SURFACE	0770.13	24 GAUGE GALVANIZED CAP, MITER, RIVET AND SOLDER ENDS WATERTIGHT, ANCHOR 12" O.C. (ONE MIN. PER SIDE)	1020.27	STAINLESS STEEL SANITARY NAPKIN DISPOSAL (OFCI)	2100	DIVISION 21 - FIRE SUPPRESSION (RE: PLUMBING)
0310.11	EXPANSION JOINT PREMOLDED EXPANSION FILLER	0770.14	PRESSURE BAR WITH MECHANICAL FASTENERS	1020.33	MOP & BROOM HOLDER	2200	DIVISION 22 - PLUMBING (RE: PLUMBING)
0320.01	DOWEL INTO CONCRETE SLAB	0770.15	REMOVABLE STAINLESS STEEL COUNTERFLASHING	1020.37	WALL-MOUNTED FOLDING SHOWER SEAT	2210.01	PLUMBING VENT
0320.02	STEEL REINFORCING	0770.16	4 LB. LEAD FLASHING, SET IN PLASTIC CEMENT AND EXTEND 2'-0" FROM DRAIN	1020.42	STAINLESS STEEL SHOWER CURTAIN ROD WITH VINYL CURTAIN AND HOOKS	2210.06	FLOOR DRAIN
0330.01	CONCRETE	0770.31	CONTINUOUS PREFINISHED VENTED SCREED CLAMPING RING	1020.47	SURFACE MOUNTED BABY CHANGING STATION	2210.13	GREASE INTERCEPTOR
0330.02	CONCRETE SLAB	0770.32	REMOVABLE 16 GA. STAINLESS STEEL HOOD, CROSS-BREAK OR SLOPE FOR DRAINAGE	1020.48	STAINLESS STEEL SANITARY NAPKIN DISPOSAL (WALL MOUNTED)	2210.14	ROOF DRAIN
0330.05	CONCRETE GRADE BEAM	0770.33	SHEET METAL OT FLEX TUBE COLLAR	1020.52	STAINLESS STEEL 1 1/2" DIAMETER GRAB BAR (24" LONG)	2210.15	ROOF DRAIN PIPING
0330.07	CONCRETE FOOTING	0790.01	SEALANT WITH BACKER ROD AS REQUIRED	1020.53	CEILING MOUNTED SWING (OFCI)	2210.16	OVERFLOW ROOF DRAIN
0330.11	CONCRETE RAMP	0790.02	CAULKING	1040.03	FIRE EXTINGUISHER AND WALL BRACKET	2210.21	CONDENSATE PIPING
0330.19	REMOVABLE BOLLARD (STEEL HOLLOW)	0790.03	SEAL WALL TO DECK	1040.06	SEMI-RECESSED CABINET (OFCI)	2230.03	BOILER
0330.20	BOLLARD PADLOCK TO BE INSTALLED PER MANUFACTURER'S RECOMMENDATIONS	0790.04	HOLLOW METAL STOP	1040.08	NOX PADLOCK	2240.01	WATER CLOSET, ORIENT FLUSH VALVE TOWARDS ACCESSIBLE SPACE AT ACCESSIBLE STALLS / RESTROOMS
0350.03	LIGHTWEIGHT INSULATING CONCRETE ROOF WITH 9" EXPANDED POLYSTYRENE INSULATION BOARD (EPS)	0790.05	WATER CUT-OFF MASTIC	1040.12	BLEEDING CONTROL KIT SEMI-RECESSED CABINET (OFCI)	2240.02	URINAL
0350.04	COMPRESSIBLE FILLER	0790.06	SEALANT	1050.02	TWO-TIER METAL LOCKERS	2240.03	WALL-HUNG LAVATORY WITH CARRIER
0350.05	TAPERED (STAIR-STEPPED) INSULATION BOARD AS REQUIRED TO PROVIDE SLOPE	0790.15	STAINLESS STEEL EXP. JT. COVER, TAPER END DOWN	1050.14	MANUFACTURED ADA ACCESSIBLE LOCKER ROOM BENCH	2240.04	PORCELAIN LAVATORY
0360.01	LEAD CAULKING OVER WATERPROOF CEMENT GROUT	0790.16	STAINLESS STEEL SCREWS WITH NEOPRENE WASHERS @ 12" O.C.	1050.20	LOCKERS ON WD. 2X4 BASE RE: A5 SERIES	2240.06	STAINLESS STEEL SINK
0360.02	CEMENT GROUT	0800	DIVISION 08 - OPENINGS	1050.22	METAL STORAGE SHELVING 36" X 24"	2240.08	PRE-MANUFACTURED SHOWER BASE
0360.03	FILL WITH GROUT	0810.01	ALUMINUM DOOR FRAME	1050.23	METAL STORAGE SHELVING 48" X 18"	2240.11	MOP SINK
0400	DIVISION 04 - MASONRY	0810.02	HOLLOW METAL FRAME	1050.24	METAL STORAGE SHELVING 48" X 24"	2240.19	BI-LEVEL DRINKING FOUNTAINS WITH BOTTLE FILLING STATION
0405.01	FLASHING END DAM	0810.03	HOLLOW METAL STOP	1050.25	THREE-TIER METAL LOCKERS	2240.25	LAVATORY STATION
0405.05	MASONRY VENEER WEEP / VENT	0810.04	HOLLOW METAL DOOR AND FRAME	1070.01	PRE-MANUFACTURED EXTERIOR ALUMINUM CANOPY SYSTEM	2300	DIVISION 23 - HEATING, VENTILATING, & AIR-CONDITIONING (HVAC) (RE: MECHANICAL)
0420.01	ADJUSTABLE MASONRY WALL TIES AT 16" O.C.E.W.	0810.05	JAMB ANCHOR (3 PER JAMB)	1070.05	FLAGPOLE COLLAR	2310.01	GAS PIPING (PAINT WHERE EXPOSED)
0420.02	CONCRETE MASONRY UNIT HORIZONTAL REINFORCING	0810.06	HOLLOW METAL DOOR	1070.07	ALUMINUM CANOPY DECK	2320.03	REFRIGERANT PIPING
0420.03	FACE BRICK	0810.18	ALUMINUM FRAME WITH STIFFENER AS REQUIRED	1070.10	ALUMINUM FLASHING CAP	2330.04	EXHAUST FAN
0420.07	STONE VENEER	0810.19	SLIDING GLASS WINDOW HARDWARE	1070.11	ALUMINUM FASCIA	2330.06	OUTSIDE AIR INTAKE HOOD
0420.08	STONE BAND	0830.07	COLLINS COUNTER DOOR	1070.12	ALUMINUM GUTTER BEAM	2330.29	EXHAUST AIR HOOD
0470.05	CAST STONE SILL WITH DRIP	0830.15	OVERHEAD COLING DOOR-HOUSING	1070.13	ALUMINUM T PLATE ANCHOR TO STRUCTURE	2330.30	SUPPLY FAN
0500	DIVISION 05 - METALS	0830.18	DOOR TRACK	1070.14	UNDERGROUND CANOPY DRAINAGE	2330.31	DRYER EXHAUST VENT
0510.01	STEEL STRUCTURE (RE: STRUCTURAL)	0840.01	ALUMINUM STOREFRONT	1100	DIVISION 11 - EQUIPMENT	2350.07	HOT FLUE VENT WITH BASE AND COLLAR
0510.02	STEEL COLUMN (RE: STRUCTURAL)	0840.02	ALUMINUM STOREFRONT DOOR	1120.03	VENDING MACHINES (N.I.C.)	2360.02	HVAC CONDENSING UNIT
0510.03	STEEL TUBE COLUMN (RE: STRUCTURAL)	0840.04	ALUMINUM TRIM TO MATCH ADJACENT ALUMINUM FINISH U.N.O.	1120.05	COPPER (N.I.C.)	2360.03	CHILLER
0510.04	STEEL ANGLE (RE: STRUCTURAL)	0840.05	CONTINUOUS ALUMINUM SILL PAN FLASHING WITH BACK AND END DAMS	1130.02	REFRIGERATOR	2370.01	AIR HANDLING UNIT
0510.05	STEEL CHANNEL (RE: STRUCTURAL)	0840.12	ALUMINUM STOREFRONT SUBSILL	1130.03	REFRIGERATOR WITH ICE MAKER	2600	DIVISION 26 - ELECTRICAL (RE: ELECTRICAL)
0510.06	STEEL LINTEL (RE: STRUCTURAL)	0840.14	ALUMINUM STOREFRONT SUBSILL	1130.05	DISHWASHER	2620.01	CONDUIT
0510.08	STEEL BENT PLATE (RE: STRUCTURAL)	0850.08	SLIDING TRANSACTION WINDOW	1130.06	WASHING MACHINE	2620.06	ELECTRICAL FLOOR BOX, MOUNT FLUSH WITH ADJACENT FLOOR FINISH
0510.10	STEEL BEAM (RE: STRUCTURAL)	0870.01	METAL THRESHOLD, SET IN BED OF SEALANT	1130.07	CLOTHES DRYER	2620.08	ELECTRICAL METER
0520.01	STEEL JOIST (RE: STRUCTURAL)	0870.10	DOOR BOTTOM WITH DRIP SKIRT	1130.17	FLAT SCREEN TV W/ MOUNTING BRACKET	2620.10	ELECTRICAL MAIN DISCONNECT
0530.02	METAL ROOF DECK (RE: STRUCTURAL)	0880.58	MIRROR GLASS	1130.18	STACKABLE WASHER/ DRYER (RE: SPECS)	2620.12	ELECTRICAL PANEL
0540.01	COLD-FORMED METAL FRAMING	0880.64	GLASS TYPE G-2 FULLY TEMPERED CLEAR GLASS	1140.03	KITCHEN EQUIPMENT (RE: FOOD SERVICE)	2620.20	WALL OUTLET
0540.02	6" METAL STUDS (C.F.M.F.) AT 16" O.C. MAXIMUM	0880.65	GLASS TYPE G-4 (INSULATED GLASS)	1140.09	ICE MACHINE	2620.21	CARD ACCESS CONDUIT & J-BOX TO BE INSTALLED ON SECURE SIDE @ GATES W/ CARD ACCESS
0540.08	SILL GASKET	0880.67	GLASS TYPE G-8 (TRANSPARENT MIRROR GLASS)	1150.26	CEILING MOUNTED PROJECTOR	2630.01	EMERGENCY GENERATOR
0540.12	COLD-FORMED METAL HEADER	0880.68	GLASS TYPE G-10 (MONOLITHIC INTERIOR SECURITY GLAZING)	1150.27	CEILING MOUNTED PROJECTION SCREEN	2630.10	WALL-MOUNTED EXIT SIGN
0540.13	COLD-FORMED BUILT-UP METAL JAMB	0880.69	GLASS TYPE G-12 (EXTERIOR SECURITY GLAZING)	1160.02	THEATRICAL PROSCENIUM CURTAIN AND SUPPORT SYSTEM	2630.11	CEILING-MOUNTED EXIT SIGN
0550.02	3" X 3" X 1/4" STEEL ANGLE	0890.01	PREFINISHED FIXED ALUMINUM LOUVER (WITH BIRD SCREEN)	1160.03	THEATRICAL SIDE CURTAIN AND SUPPORT SYSTEM	2630.15	HOUSELIGHT TRACK
0550.05	2" X 2" X 5/16" STEEL ANGLE	0890.08	METAL CLIP ANGLE FOR LOUVER FRAME MOUNTING AS REQUIRED	1160.04	THEATRICAL BORDER CURTAIN AND SUPPORT SYSTEM	2630.17	LIGHT POLE AND FIXTURE ON CONCRETE BASE
0550.06	3/4" DIAMETER STEEL ROD	0900	DIVISION 09 - FINISHES	1160.05	THEATRICAL REAR STAGE CURTAIN AND SUPPORT SYSTEM	2630.22	WALL PACK
0550.13	4" X 4" X 1/2" STEEL "T" PLATE	0950.38	PIPE SLEEVE	1165.04	TEMPERED GLASS BASKETBALL BACKBOARD WITH RIM, NET, AND SAFETY PADS, PROVIDE STEEL SUPPORTS AND MOUNTING BRACKETS	2630.23	CANOPY LIGHT FIXTURE
0550.14	BOTH SIDE WITH (4) 3/8" S.S. BOLTS	0950.39	1 1/2" DIAMETER STANDARD STEEL PIPE HANDRAIL, RETURN TO WALL @ ENDS WITH 3" MIN. RADIUS	1165.05	STUD BRACE AT 4'-0" O.C. MAX.	2630.24	DISPLAY CASE LIGHT FIXTURE
0550.43	HANDRAIL BRACKET @ 48" O.C. MAX.	0950.43	CORRUGATED PIPE SLEEVE, 16GA GALVANIZED	1165.06	7/8" FURRING CHANNELS AT 16" O.C.	2700	DIVISION 27 - COMMUNICATIONS
0600	DIVISION 06 - WOOD, PLASTICS, & COMPOSITES	0950.71	WALL COVERING	1200	DIVISION 12 - FURNISHINGS	3120.01	GRADE
0610.01	SHIM AS REQUIRED	0950.71	WALL COVERING	1220.01	MINI-BLINDS	3120.02	COMPACTED SELECT FILL
0610.02	1X WOOD BLOCKING	0950.72	CEMENT PLASTER SOFFIT SYSTEM	1220.04	CUBICLE CURTAIN / TRACK	3120.03	COMPACTED SUBGRADE
0610.03	2X WOOD BLOCKING	0950.73	CEMENT PLASTER SOFFIT SYSTEM	1220.05	MOTORIZED WINDOW SHADE	3120.05	TOP OF PAV/G/ GRADE
0610.04	2X PRESSURE TREATED WOOD BLOCKING	0950.74	CEMENT PLASTER SOFFIT SYSTEM	1220.06	EMPLOYEE MAILBOXES	3200	DIVISION 32 - EXTERIOR IMPROVEMENTS
0610.08	2 LAYERS 3/4" EXTERIOR GRADE PLYWOOD BLOCKING	0950.75	CEMENT PLASTER SOFFIT SYSTEM	1220.09	SOLID SURFACE COUNTERTOP WITH 4" SPLASH AS SHOWN	3210	Bases, Ballasts & Paving
0610.19	WOOD WEDGE	0950.76	CEMENT PLASTER SOFFIT SYSTEM	1230.26	PLASTIC LAMINATE CLAD COUNTERTOP WITH 4" SPLASH AS SHOWN	3210.06	PERMEABLE GRAVEL PAVING SYSTEM
0620.03	1X HARDWOOD BASE	0950.77	CEMENT PLASTER SOFFIT SYSTEM	1230.41	HARDWOOD VENEER BASE CABINET CASEWORK WITH ADJUSTABLE SHELVES	3210.08	CONCRETE SIDEWALK (RE: CIVIL)
0640.07	3/4" PLYWOOD	0950.78	CEMENT PLASTER SOFFIT SYSTEM	1230.43	HARDWOOD VENEER WALL CABINET CASEWORK WITH ADJUSTABLE SHELVES	3210.10	CONCRETE CURB RAMP
0640.53	3/4" PLASTIC LAMINATE CLAD MEDIUM DENSITY PARTICLEBOARD	0950.79	CEMENT PLASTER SOFFIT SYSTEM	1230.44	PLASTIC LAMINATE CLAD BASE CABINETS WITH ADJUSTABLE SHELVES	3210.11	ACCESSIBLE CONCRETE CURB RAMP WITH INTEGRAL COLOR CONCRETE AND TACTILE WARNING SURFACE
0640.56	3/4" PLASTIC LAMINATE CLAD PARTICLEBOARD ADJUSTABLE SHELF	0950.80	CEMENT PLASTER SOFFIT SYSTEM	1230.45	PLASTIC LAMINATE CLAD WALL CABINETS WITH ADJUSTABLE SHELVES	3210.14	CONCRETE PAVING (RE: CIVIL)
0640.75	1 1/2" PLASTIC LAMINATE ON BACKER	0950.81	CEMENT PLASTER SOFFIT SYSTEM	1230.46	PLASTIC LAMINATE CLAD TALL CABINET	3210.15	CONCRETE APPROACH
0660.01	PLASTIC PANELING	0950.82	CEMENT PLASTER SOFFIT SYSTEM	1230.47	ADJUSTABLE SHELF REST AND PRE-DRILLED HOLES AT 1" O.C. TYP.	3210.22	PAVING EXPANSION JOINT - FILL WITH JOINT SEALER 1/4" BELOW SURFACE
0700	DIVISION 07 - THERMAL & MOISTURE PROTECTION	0950.83	CLEAR AND PREP SURFACE AND PAINT (TO MATCH EXISTING)	1230.48	WIRE GROMMET	3210.30	6" CONCRETE CURB (WITH GUTTER AS REQUIRED) (RE: CIVIL)
0710.02	SELF ADHERING SHEET WATERPROOFING MEMBRANE	0950.84	CLEAR AND PREP SURFACE AND PAINT (TO MATCH EXISTING)	1230.49	CABINET PULLS	3210.32	CONCRETE MOW STRIP
0720.01	3 1/2" BATT INSULATION	0950.85	CLEAR AND PREP SURFACE AND PAINT (TO MATCH EXISTING)	1230.50	1/4" CLEAR TEMPERED GLASS SHELVES	3210.33	4" PAVEMENT MARKING (DIAGONAL STRIPING AT 2'-0" O.C. TYPICAL)
0720.02	6 1/4" BATT INSULATION	0950.86	CLEAR AND PREP SURFACE AND PAINT (TO MATCH EXISTING)	1230.51	SHELF BRACKET	3210.34	H.C. PAVEMENT MARKING
0720.04	1 1/2" CONTINUOUS RIGID INSULATION	0950.87	CLEAR AND PREP SURFACE AND PAINT (TO MATCH EXISTING)	1230.52	1/2" PLASTIC LAMINATE CLAD PLYWOOD	3210.35	FIRE LANE STRIPING
0720.05	2" CONTINUOUS INSULATION	0950.88	CLEAR AND PREP SURFACE AND PAINT (TO MATCH EXISTING)	1230.53	3/4" PLASTIC LAMINATE CLAD PARTICLEBOARD DRAWER WITH 1/2" HIGH DENSITY PARTICLEBOARD BOTTOM	3210.36	DIRECTIONAL PAVEMENT MARKING
0720.16	SEMI-RIGID MINERAL WOOL INSULATION FILLER / BACKER MATERIAL	0950.89	CLEAR AND PREP SURFACE AND PAINT (TO MATCH EXISTING)	1230.54	3/4" PLASTIC LAMINATE CLAD PARTICLEBOARD CABINET DOOR	3210.37	WHEEL STOP (6'-0" LONG), DRILL AND DOWEL INTO PAVING
0725.01	UNDERSLAB VAPOR BARRIER	0950.90	CLEAR AND PREP SURFACE AND PAINT (TO MATCH EXISTING)	1230.55	COAT OR BACKPACK HOOK	3210.38	4" LANE DIVIDER STRIPE- WHITE
0725.04	FLUID-APPLIED MEMBRANE AIR BARRIER SYSTEM	0950.91	CLEAR AND PREP SURFACE AND PAINT (TO MATCH EXISTING)	1230.56	3/4" PLASTIC LAMINATE CLAD PLYWOOD	3210.40	4" LANE DIVIDER STRIPE- YELLOW
0725.05	SELF-ADHERING DETAIL TRANSITION MEMBRANE	0950.92	CLEAR AND PREP SURFACE AND PAINT (TO MATCH EXISTING)	1230.57	3/4" PLASTIC LAMINATE CLAD MEDIUM DENSITY PARTICLEBOARD	3210.41	12" WHITE LIMIT LINE
0725.07	FLUID-APPLIED MEMBRANE AIR BARRIER DETAIL TRANSITION SYSTEM	0950.93	CLEAR AND PREP SURFACE AND PAINT (TO MATCH EXISTING)	1230.58	1/4" PLASTIC LAMINATE CLAD CABINET BACK	3210.42	8'-0" HIGH NOM. CHAIN-LINK FENCE
0750.01	ROOFING BASE FLASHING SYSTEM	0950.94	CLEAR AND PREP SURFACE AND PAINT (TO MATCH EXISTING)	1230.59	3/4" PLASTIC LAMINATE CLAD PARTICLEBOARD ADJUSTABLE SHELF	3230.05	CHAIN-LINK GATE
0750.03	4" CANT STRIP	0950.95	CLEAR AND PREP SURFACE AND PAINT (TO MATCH EXISTING)	1230.60	FIXED 3/4" PLASTIC LAMINATE CLAD PLYWOOD SHELF	3310.01	CHAIN-LINK FABRIC (GALVANIZED)
0750.06	WRAP HIGH TEMPERATURE SELF-SEALING UNDERLAYMENT MEMBRANE TO OUTSIDE FACE OF BLOCKING	0950.96	CLEAR AND PREP SURFACE AND PAINT (TO MATCH EXISTING)	1230.61	SHELF STANDARDS: REEVE T-STANDARD #7408 FULL HT	3330.05	2" MIN. DIAMETER SCHEDULE 40 STEEL PIPE (GALVANIZED)
0750.07	MODIFIED BITUMEN MEMBRANE ROOFING SYSTEM	0950.97	CLEAR AND PREP SURFACE AND PAINT (TO MATCH EXISTING)	1230.62	FRAMLESS HINGED 1/2" TEMP. GLASS DOOR W/ LOCK & HD PUSH LATCHES TOP & BOTTOM	3340.04	AREA DRAIN INLET (RE: CIVIL)
0750.12	WALKWAY PAD	0950.98	CLEAR AND PREP SURFACE AND PAINT (TO MATCH EXISTING)	1230.63	PLASTIC LAMINATE ON 3/4" CORE ON ALL EXPOSED SURFACES	3370.04	TRANSFORMER (BY POWER COMPANY) WITH CONCRETE PAD PER POWER COMPANY REQUIREMENTS
0750.14	1/2" ROOF COVER BOARD	0950.99	CLEAR AND PREP SURFACE AND PAINT (TO MATCH EXISTING)	1230.64	LIGHT W/ PLASTIC LAMINATE ON 3/4" PLYWOOD SHEILD	3370.08	BARE COPPER GROUND
0750.21	HOT AIR-WELD	0950.100	CLEAR AND PREP SURFACE AND PAINT (TO MATCH EXISTING)	1230.65	FINISHED WOOD BOLTED THRU WALL TO 2 X 6	3370.11	ELECTRICAL BOX
0760.01	THROUGH-WALL FLASHING WITH WEEPS AT 2'-0" O.C. AND MORTAR NET	0950.101	CLEAR AND PREP SURFACE AND PAINT (TO MATCH EXISTING)	1230.67	METAL NAME PLATE	3400	DIVISION 34 - TRANSPORTATION
0760.10	GALVANIZED STRAP	0950.102	CLEAR AND PREP SURFACE AND PAINT (TO MATCH EXISTING)	1230.68	3/16" FACE FLUSH W/ VERTICAL SUPPORTS	Division 02	Existing Conditions (To Remain, U.N.O.) & Demolition
0760.13	PREFINISHED METAL FASCIA	0950.103	CLEAR AND PREP SURFACE AND PAINT (TO MATCH EXISTING)	1230.69	CLOTHES ROD		
0760.14	METAL CLEAT	0950.104	CLEAR AND PREP SURFACE AND PAINT (TO MATCH EXISTING)	1230.71	3/4" AWP GLUED TO 3/4" PLYWOOD BACKER		
0760.30	PREFINISHED EDGE TRIM	0950.105	CLEAR AND PREP SURFACE AND PAINT (TO MATCH EXISTING)	1230.72	1 1/2" X 3/4" END TO MATCH WD. VENEER, TYP. TOP, BOT., & SIDES		
0760.31	PREFINISHED METAL COPING SYSTEM	0950.106	CLEAR AND PREP SURFACE AND PAINT (TO MATCH EXISTING)	1230.73	ADA BAR		
0760.32	CONTINUOUS CLEAT	0950.107	CLEAR AND PREP SURFACE AND PAINT (TO MATCH EXISTING)	1230.74	KEYBOARD TRAY		
0760.37	CONTINUOUS STEEL STRAP ATTACHED TO EACH STUD	0950.108	CLEAR AND PREP SURFACE AND PAINT (TO MATCH EXISTING)	1230.75	1/4" CLEAR TEMPERED GLASS BYPASS SLIDING DOORS AND ALUMINUM TRACK		
0760.40	TERMINATION BAR AND PREFINISHED FLASHING CAP	0950.109	CLEAR AND PREP SURFACE AND PAINT (TO MATCH EXISTING)	1230.76	PLASTIC LAMINATE CLAD BASE AND WALL CABINETS WITH ADJUSTABLE SHELVES RE: INTERIOR ELEVATION		
0760.44	COATED METAL GRAVEL STOP FASCIA SYSTEM	0950.110	CLEAR AND PREP SURFACE AND PAINT (TO MATCH EXISTING)	1230.77	CLINIC BED (N.I.C.)		
0760.49	THERMOPLASTIC SPLIT PIPE SEAL	0950.111	CLEAR AND PREP SURFACE AND PAINT (TO MATCH EXISTING)				
0760.50	HOOK SEAM	0950.112	CLEAR AND PREP SURFACE AND PAINT (TO MATCH EXISTING)				
0760.51	2 PC. PREFINISHED METAL END PLATE, SOLDER ALL JOINTS WATERTIGHT	0950					




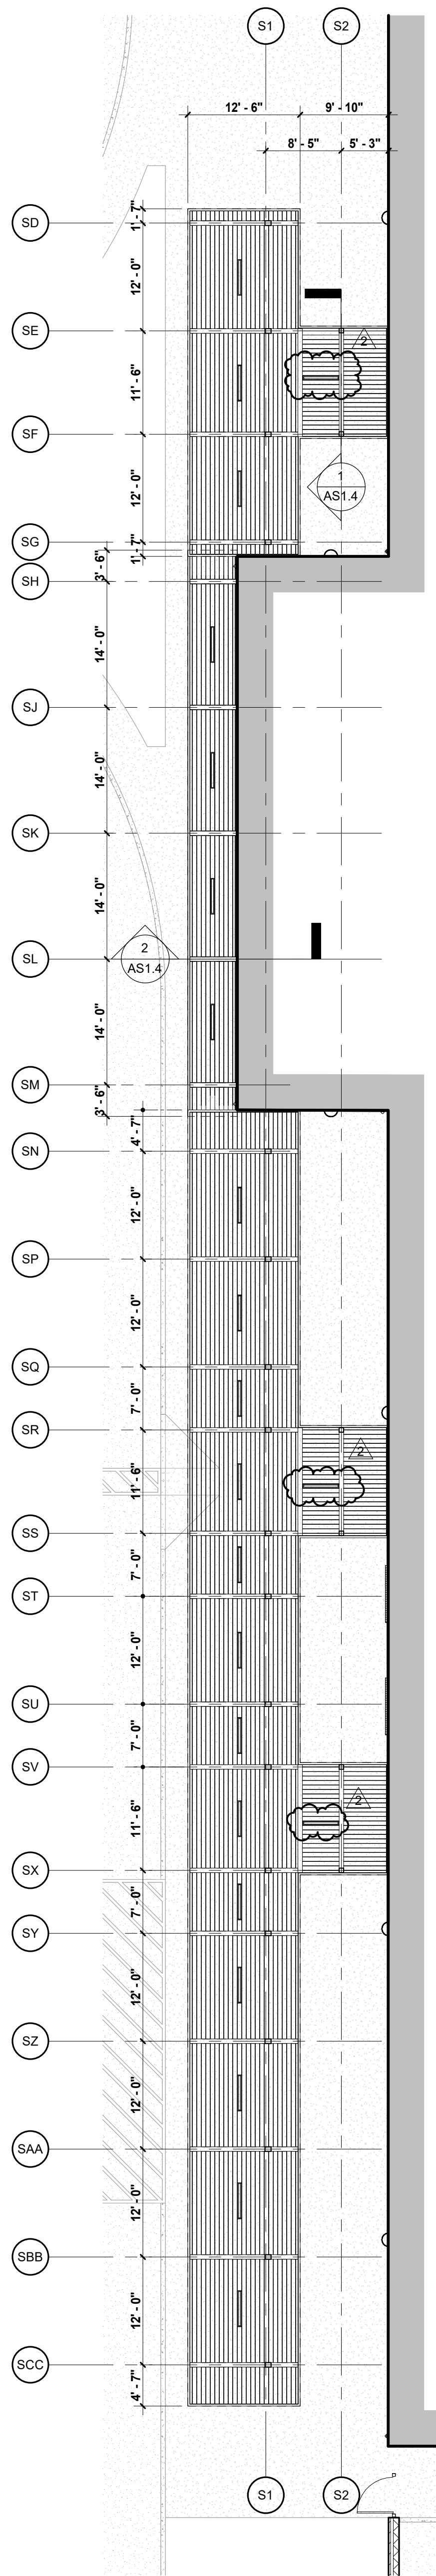


**5 CANOPY PLAN**  
3/32" = 1'-0"

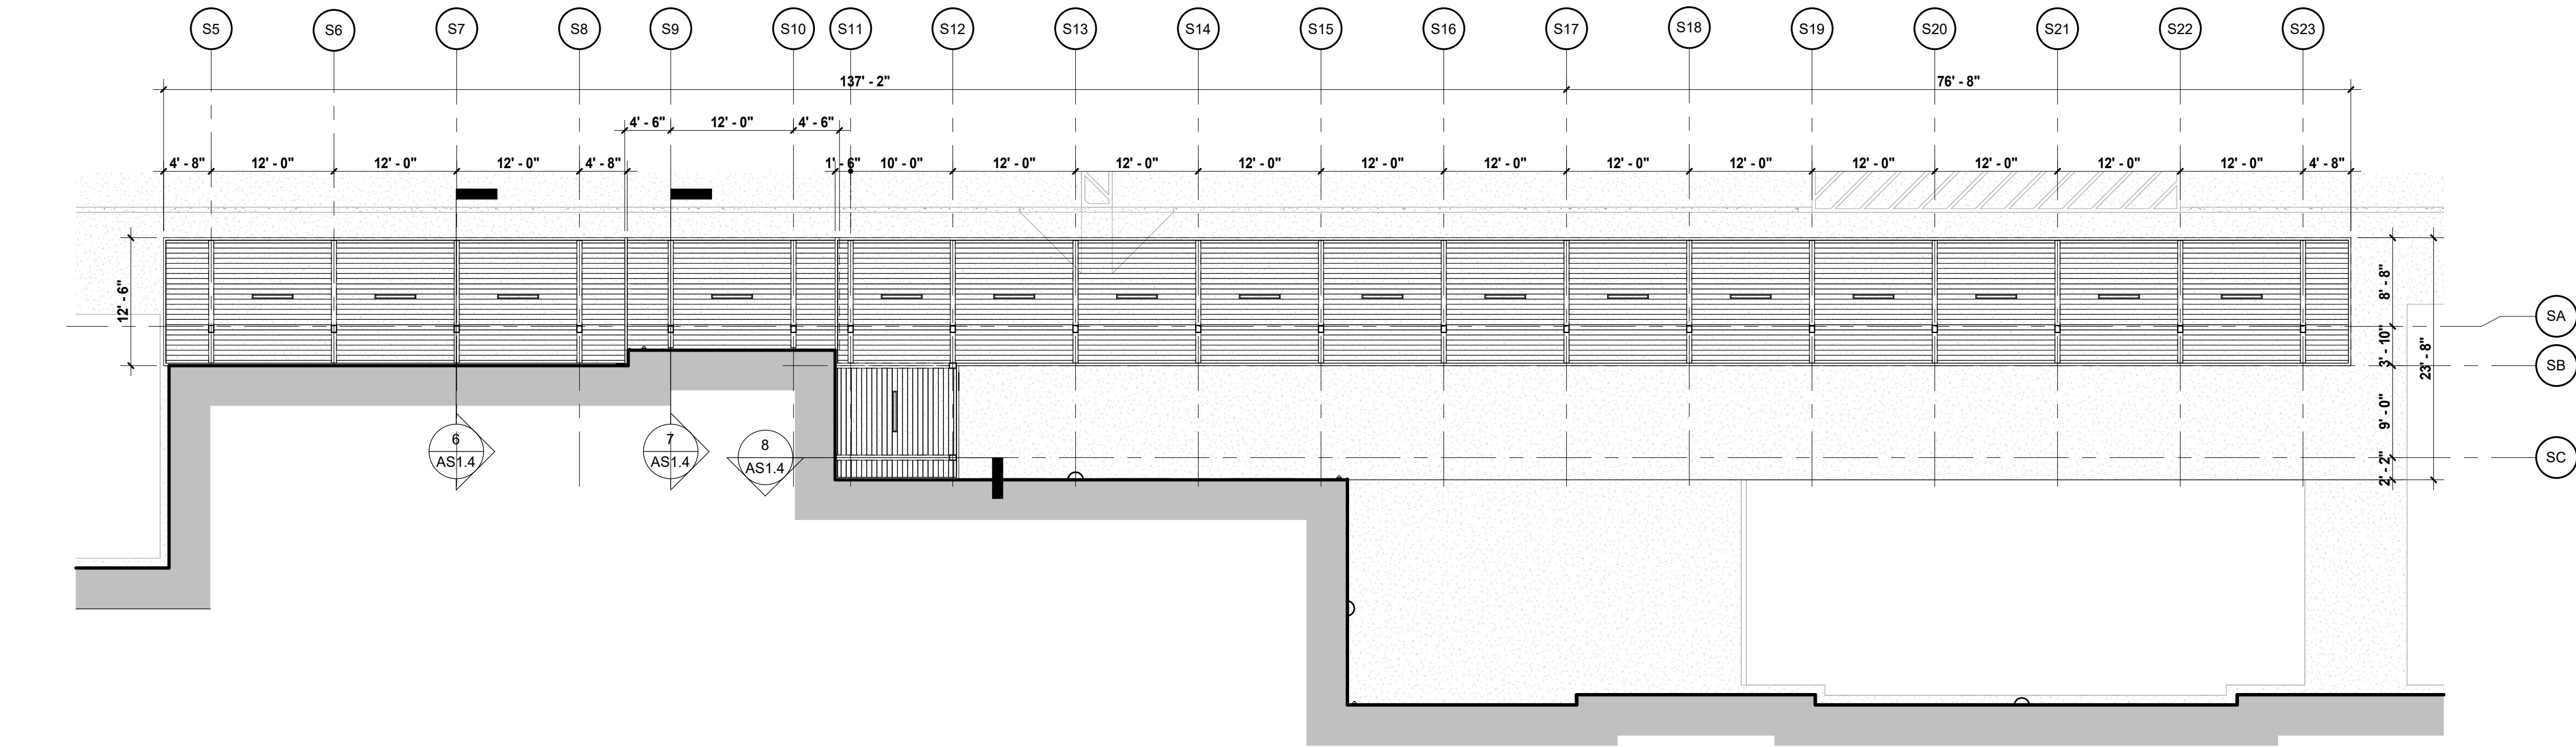


**9 CANOPY PLAN**  
3/32" = 1'-0"

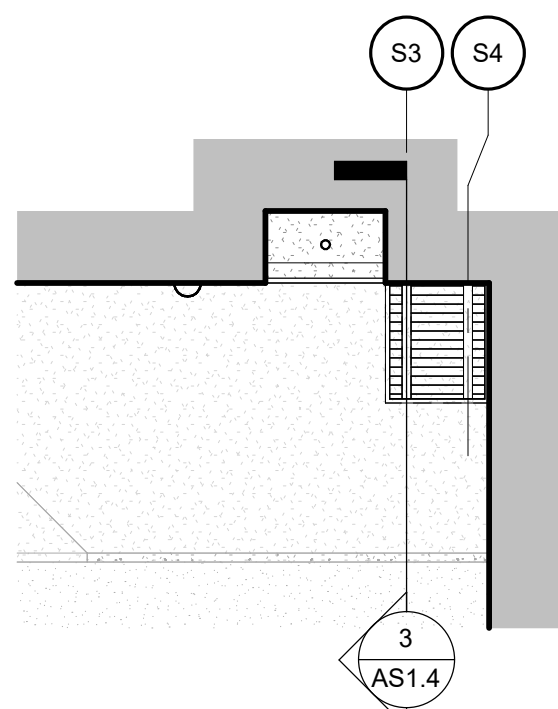


**4 CANOPY PLAN**  
3/32" = 1'-0"

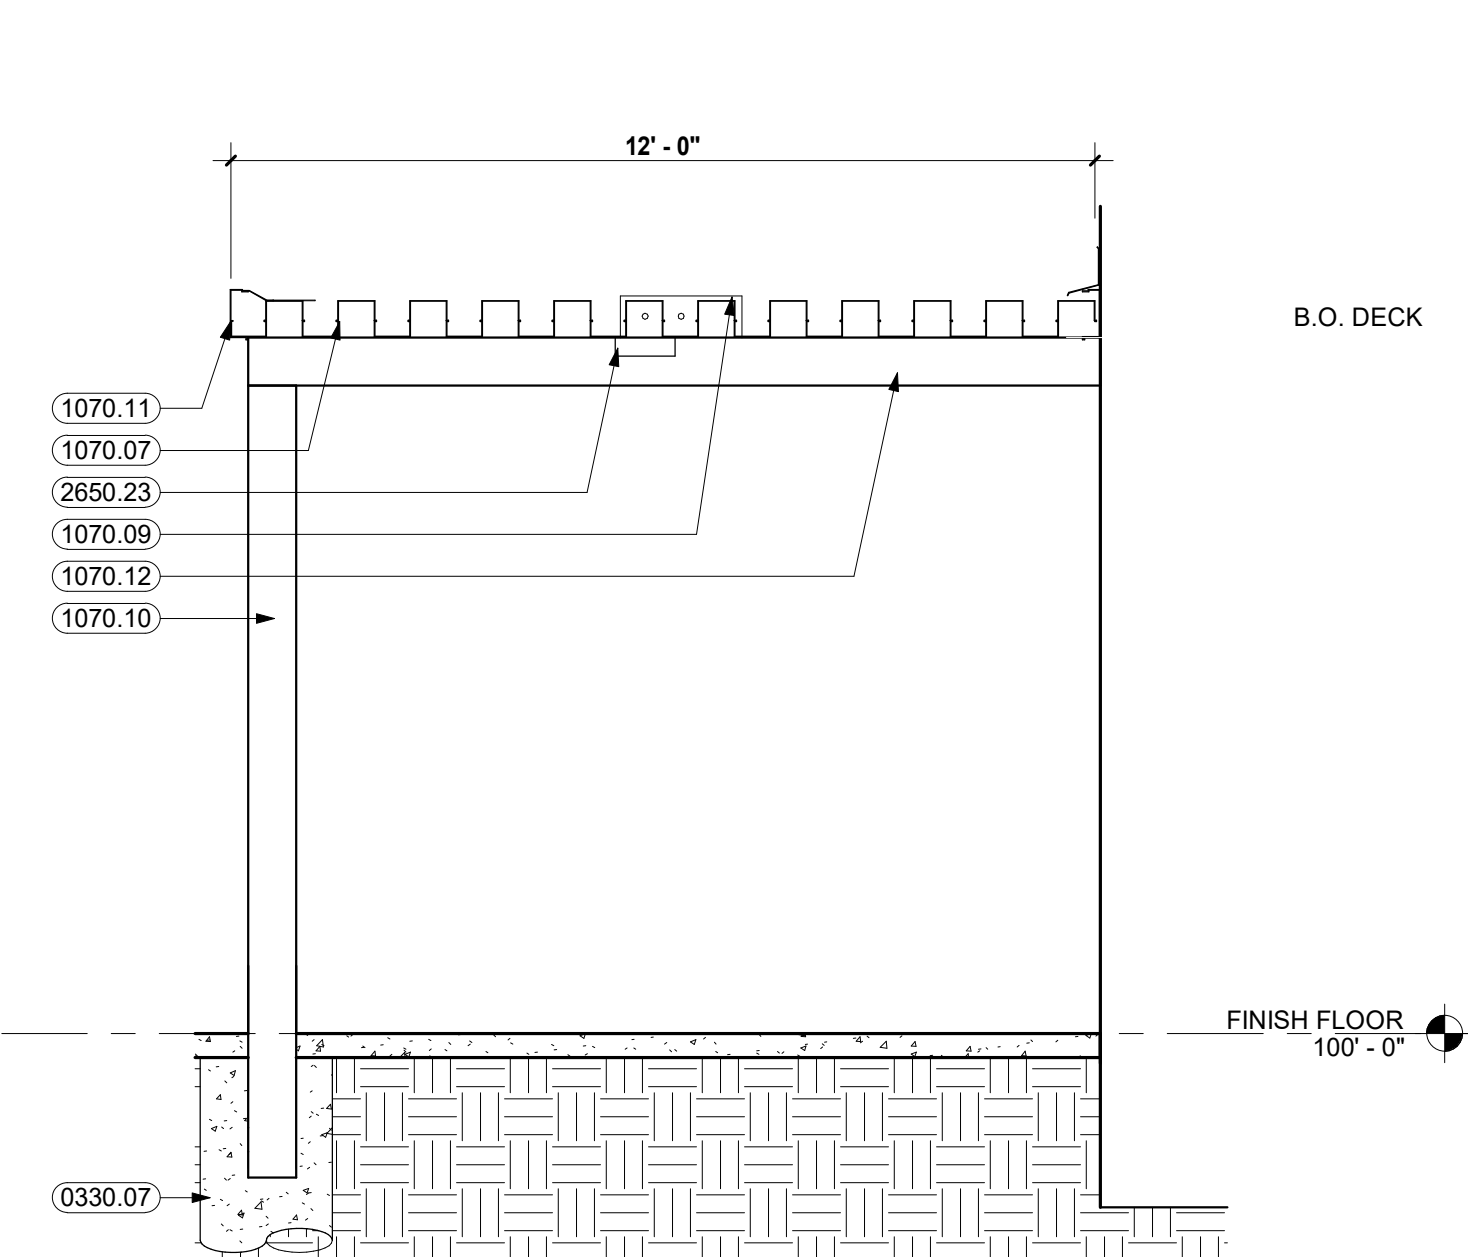


**8 CANOPY SECTION 06**  
3/8" = 1'-0"

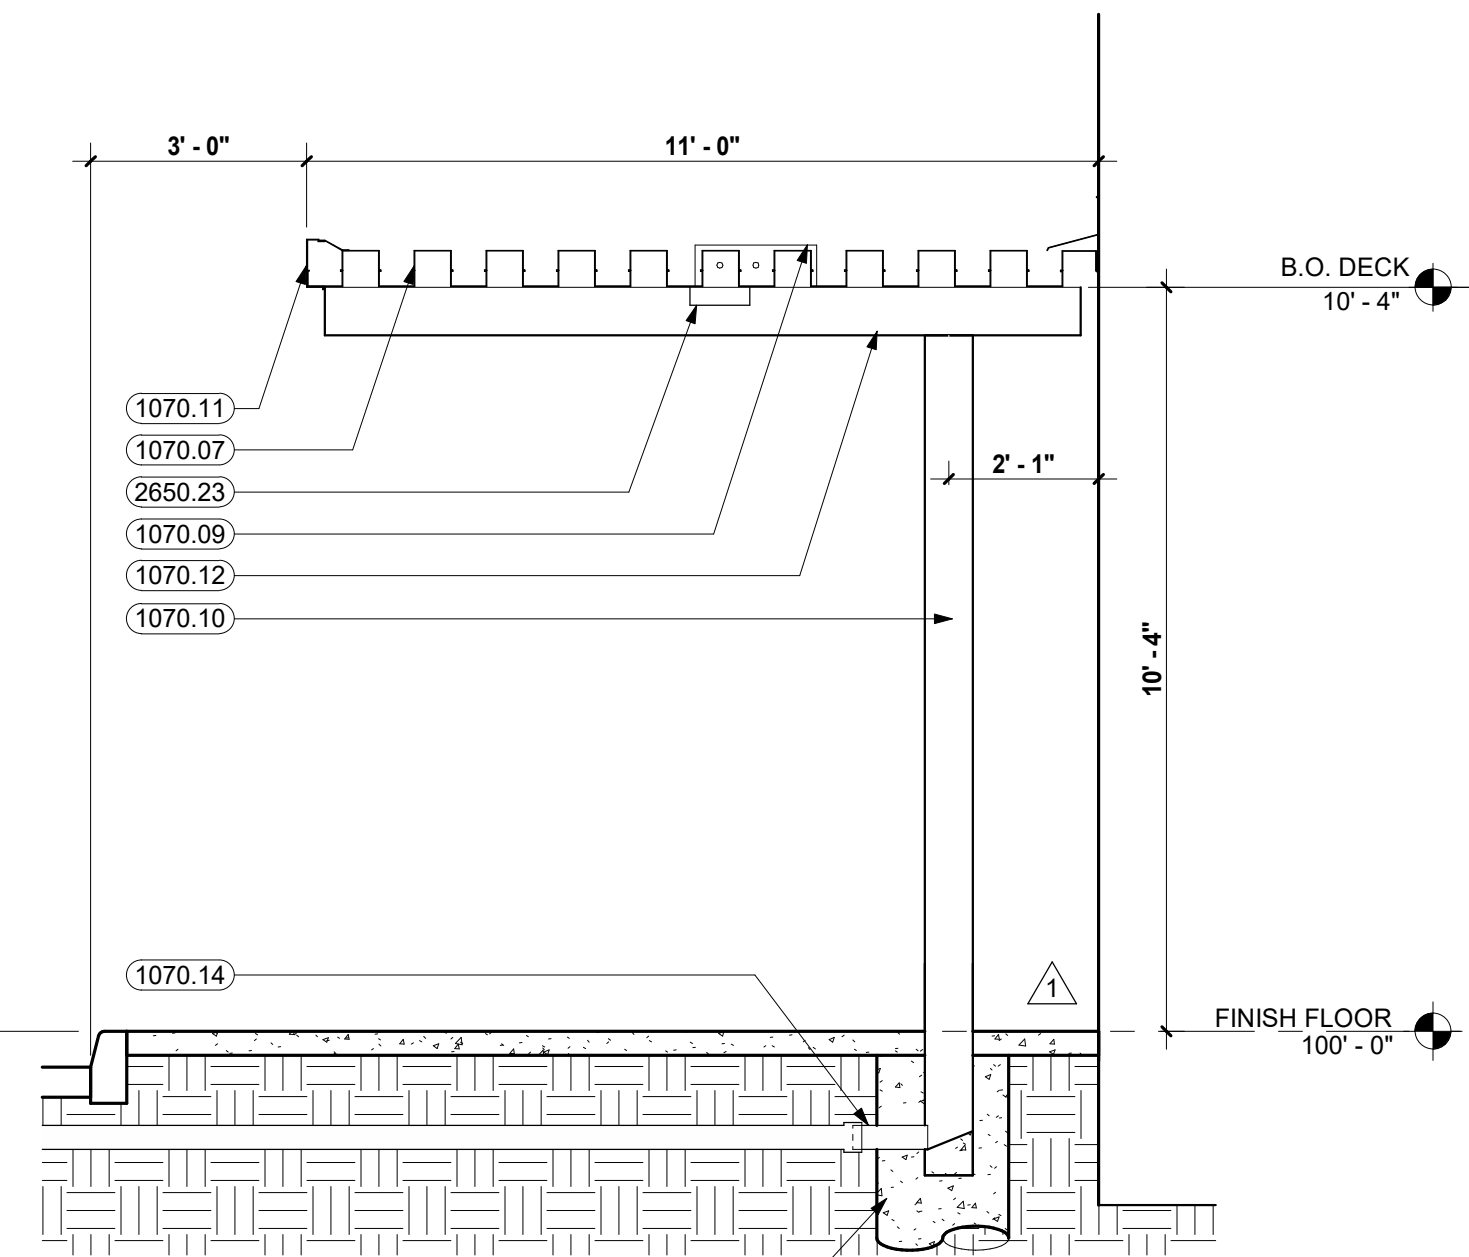


**7 CANOPY SECTION 05**  
3/8" = 1'-0"

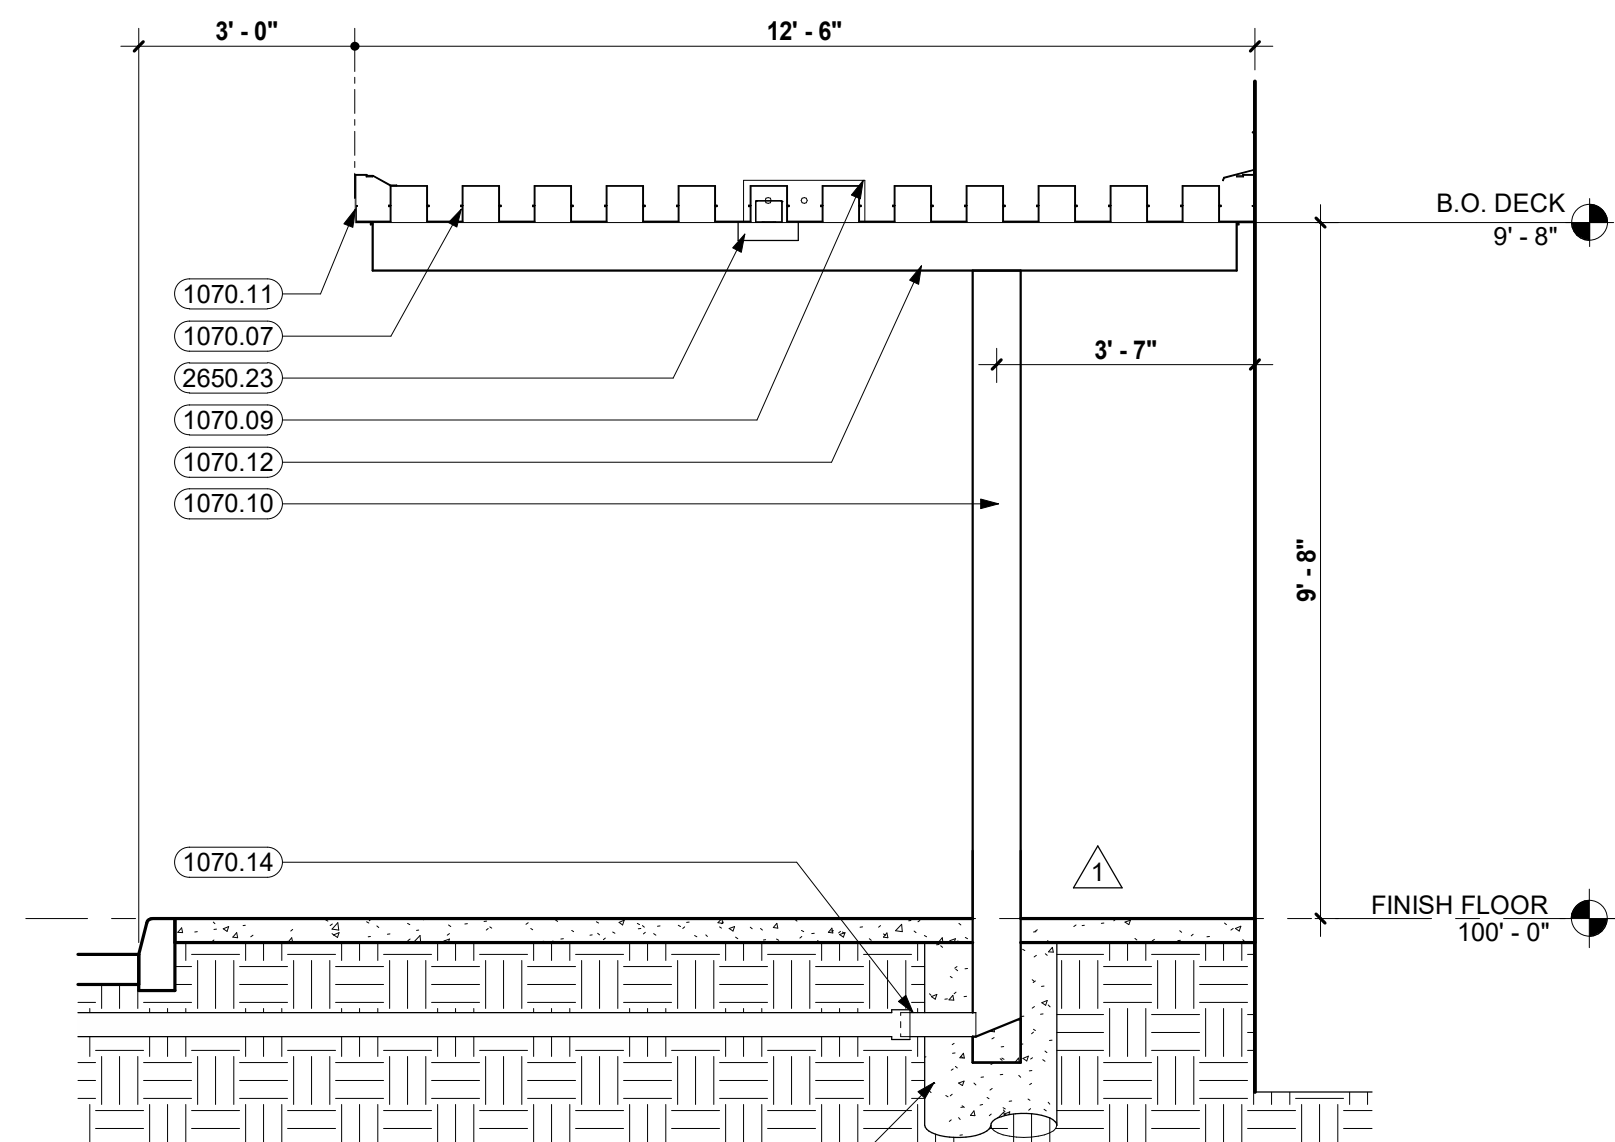


**6 CANOPY SECTION 04**  
3/8" = 1'-0"

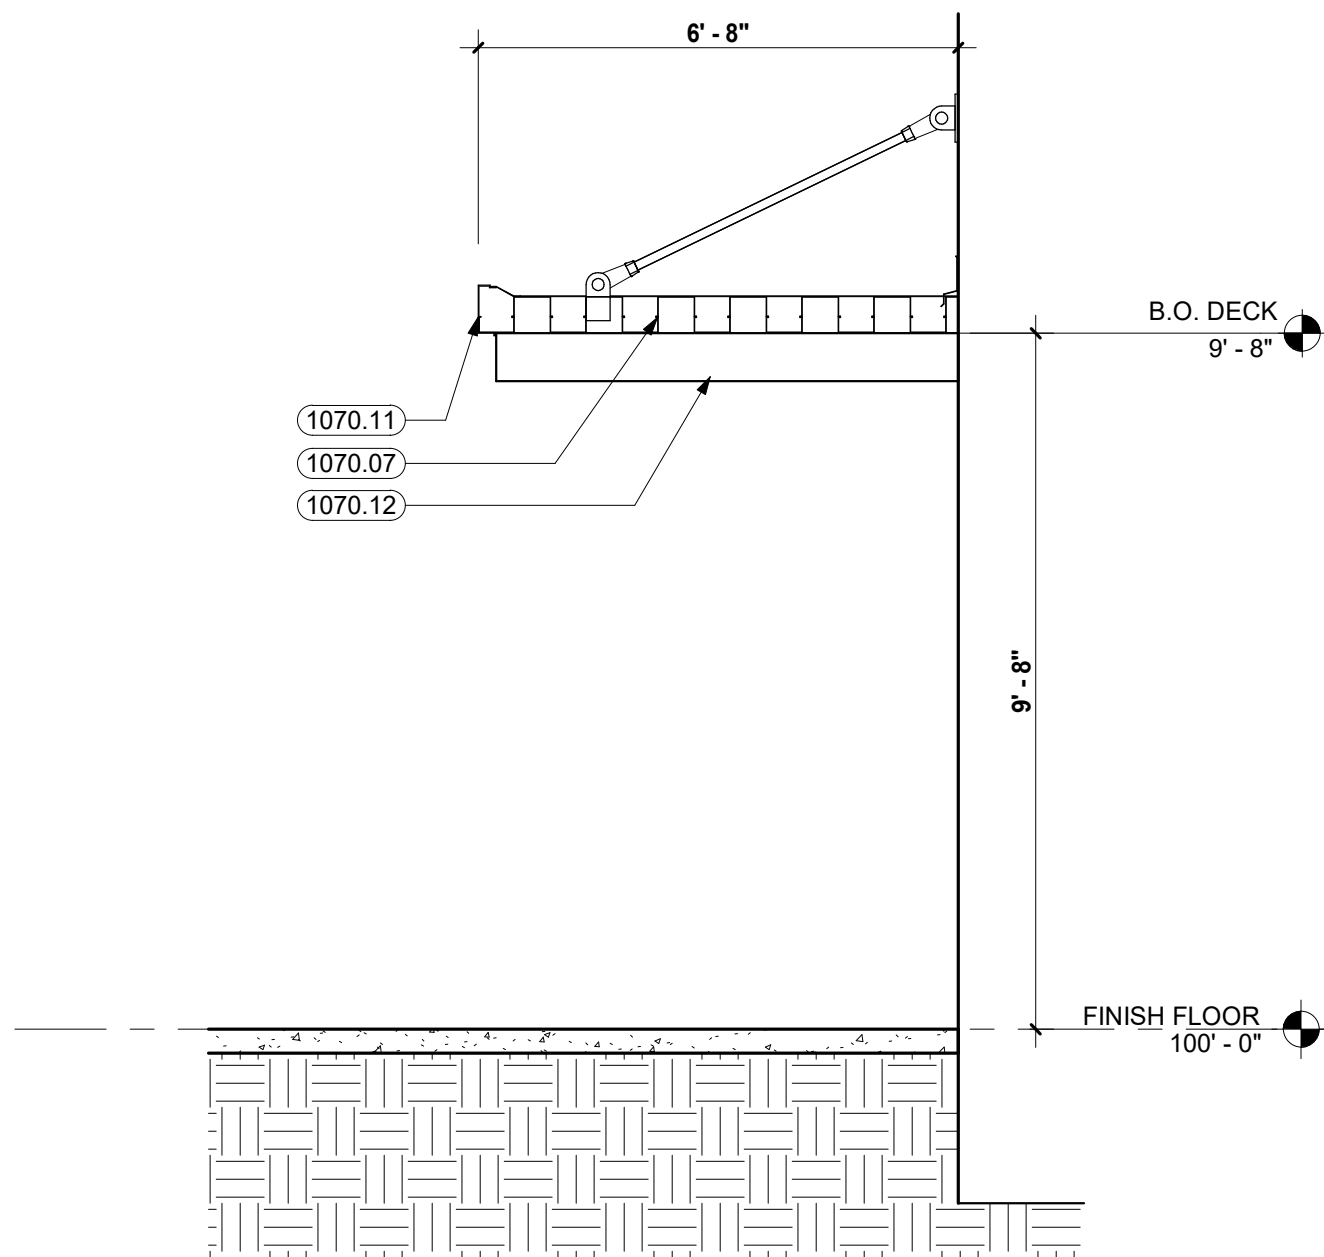

**3 CANOPY SECTION 03**  
3/8" = 1'-0"

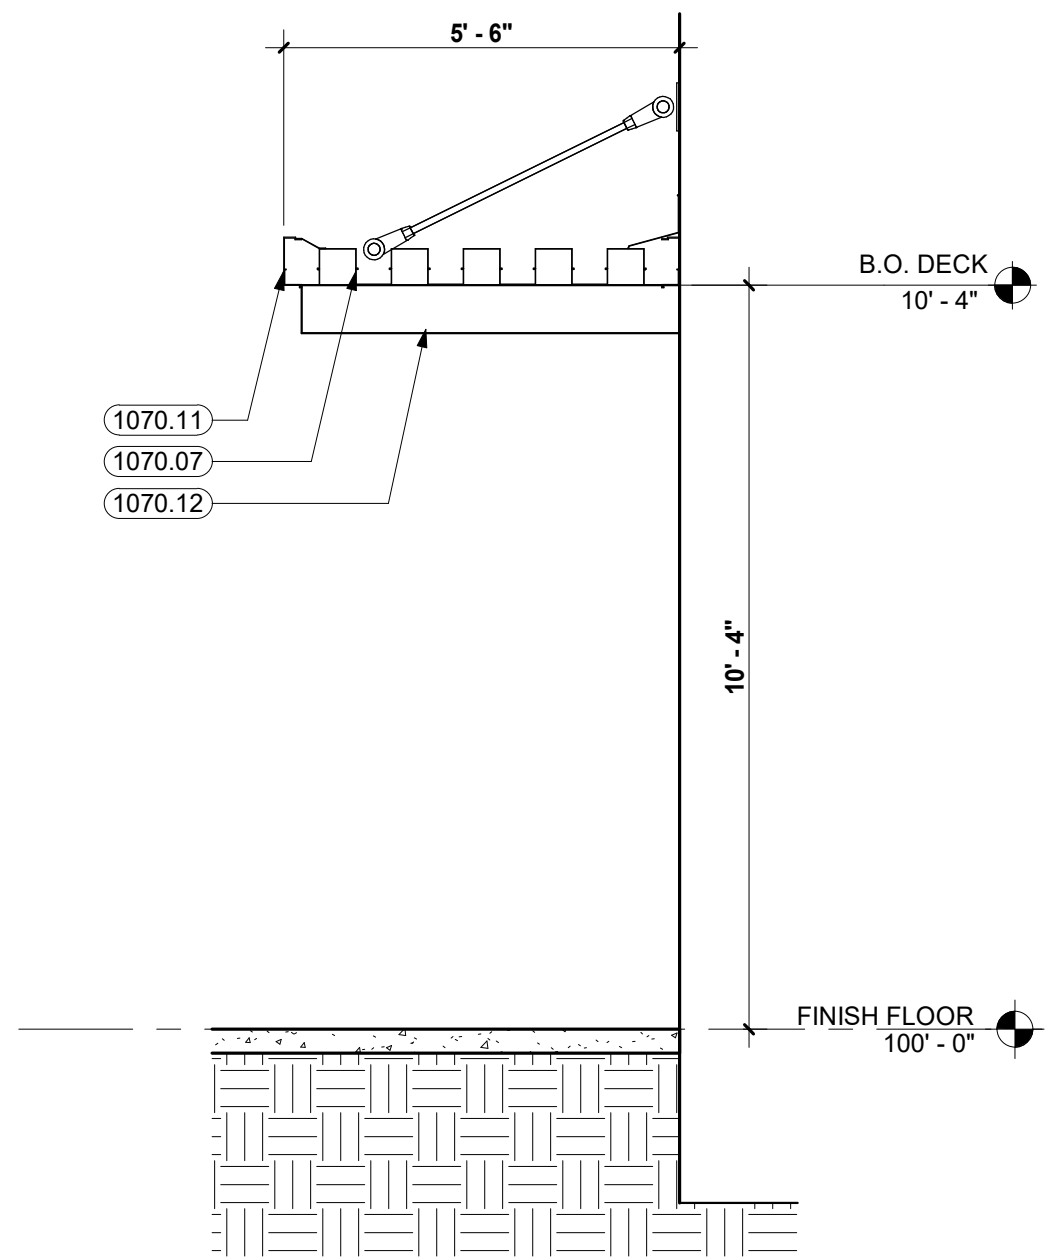

**2 CANOPY SECTION 02**  
3/8" = 1'-0"

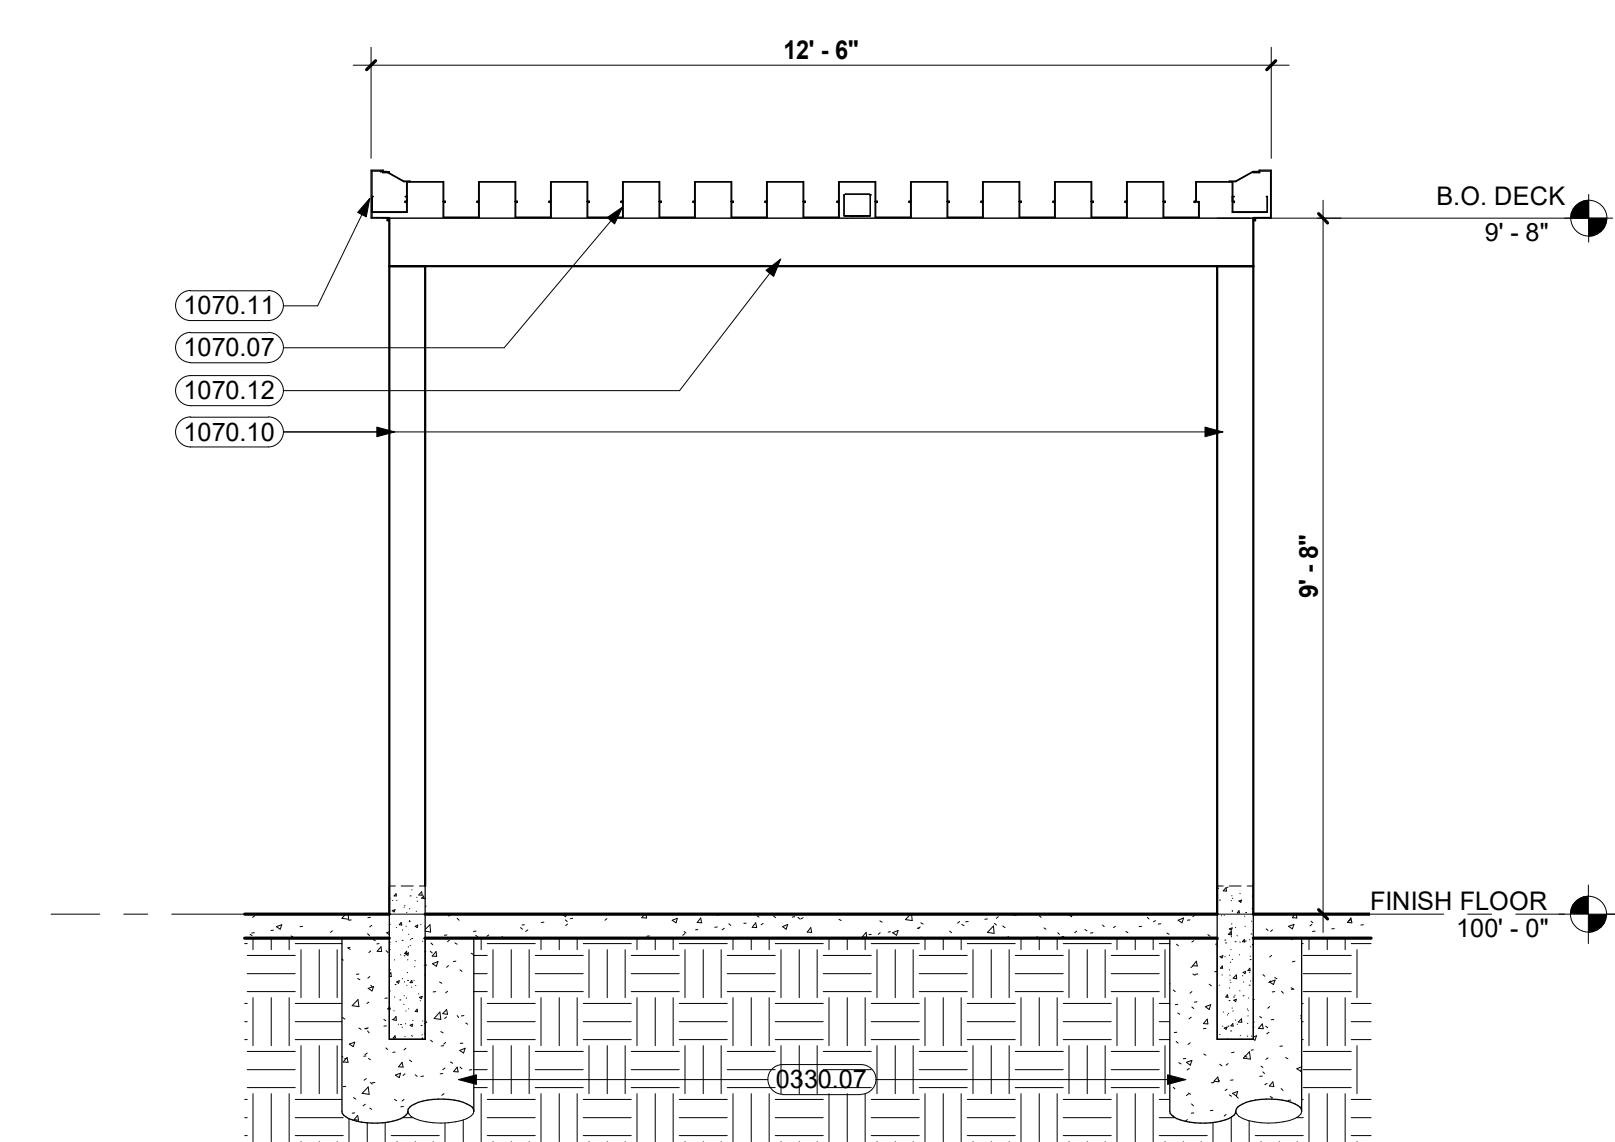

**1 CANOPY SECTION 01**  
3/8" = 1'-0"

- KEYNOTES**
- 0330.07 CONCRETE FOOTING
  - 1070.07 ALUMINUM CANOPY DECK
  - 1070.09 ALUMINUM FLASHING CAP
  - 1070.10 ALUMINUM CANOPY COLUMN
  - 1070.11 ALUMINUM FASCIA
  - 1070.12 ALUMINUM GUTTER BEAM
  - 1070.14 UNDERGROUND CANOPY DRAINAGE
  - 2650.23 CANOPY LIGHT FIXTURE

**BROWN REYNOLDS WATFORD ARCHITECTS**  
4501 MAGNOLIA COVE DRIVE  
SUITE 200  
DALLAS, TEXAS 77345  
281-361-3800  
WWW.BRWARCH.COM


COPYRIGHT © 2024  
BROWN REYNOLDS WATFORD ARCHITECTS, INC.  
DATE: SEPTEMBER 9, 2024  
DRAWN BY: QN, AH, LB  
CHECKED BY: JSC  
BRW PROJECT NUMBER: 223117.00

**NEW CANEY I.S.D.**  
**NEW CANEY ELEMENTARY SCHOOL**  
19300 VIA CORSICA DRIVE  
NEW CANEY, TX 77337


NO.	REVISION	DATE
1	ADDENDUM NO. 1	09/23/24
2	ADDENDUM NO. 2	10/22/2024

**AS1.4**  
CANOPY PLANS AND DETAILS



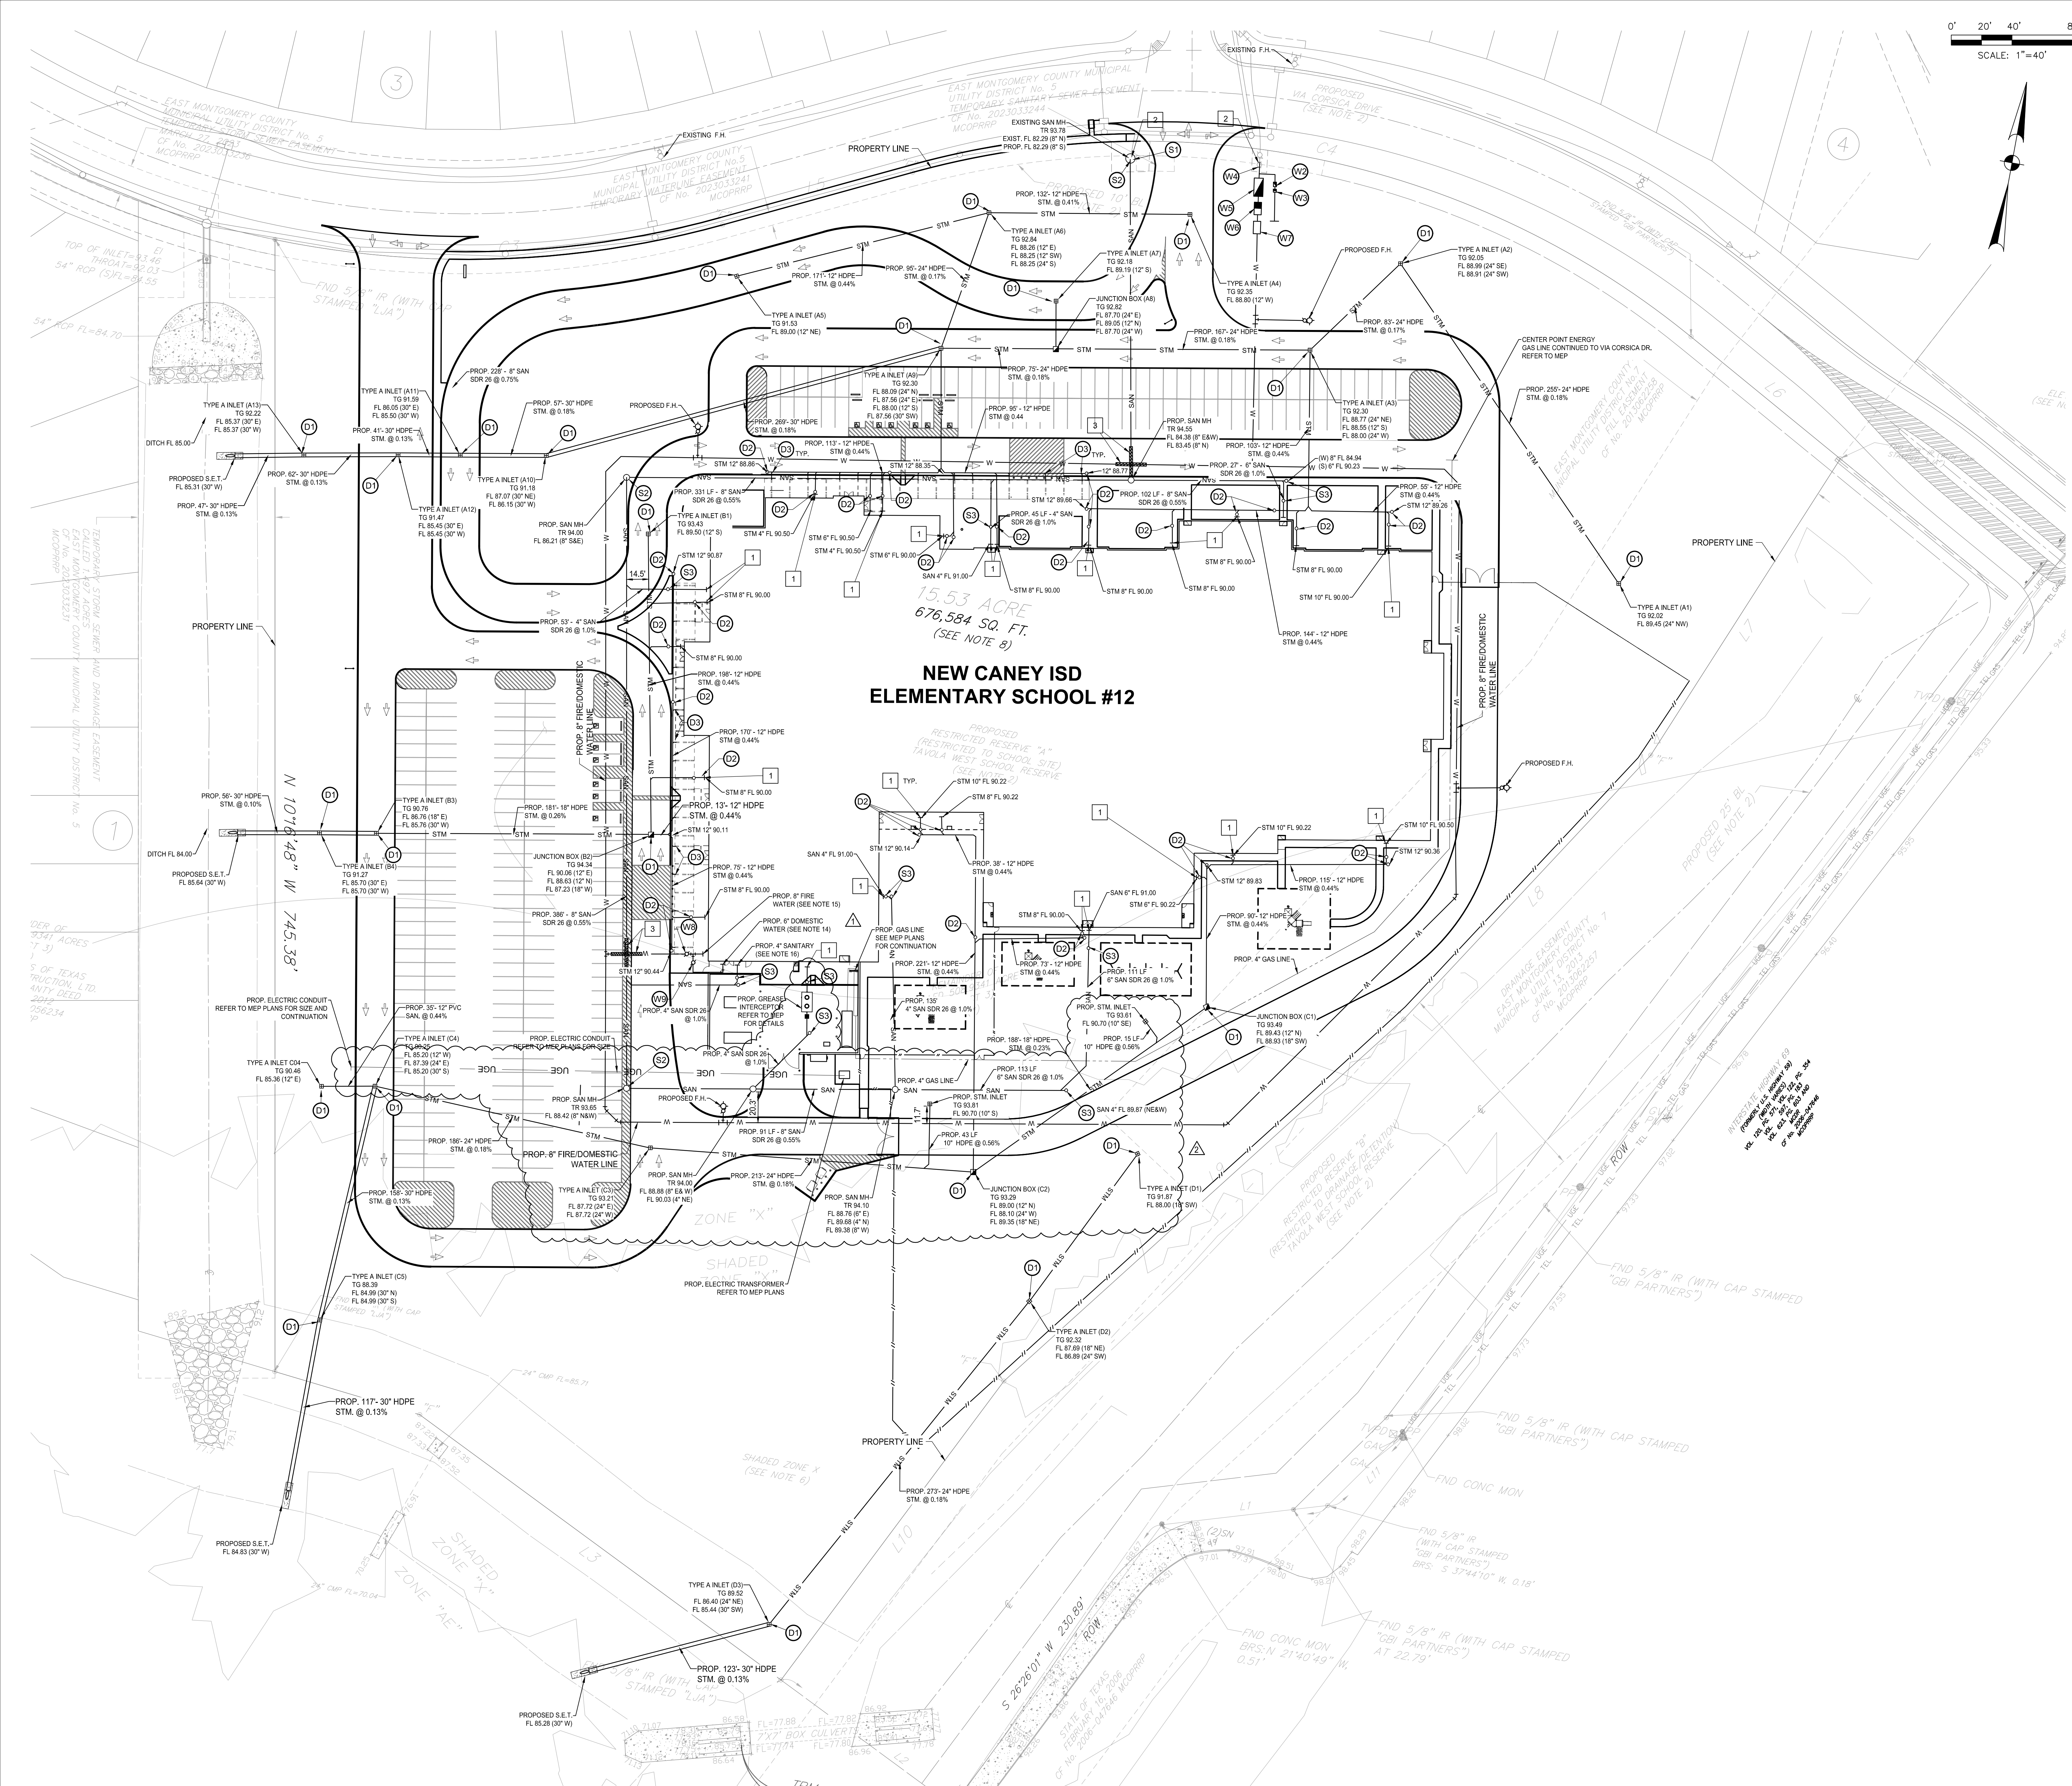

0' 20' 40' 80'  
SCALE: 1"=40'

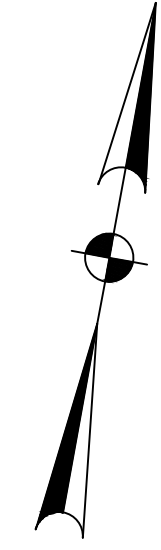

GENERAL CONSTRUCTION NOTES:

- ALL UNDERGROUND UTILITIES SHOWN ARE NOT GUARANTEED TO BE COMPLETE OR DEFINITE, BUT WERE OBTAINED FROM THE BEST INFORMATION AVAILABLE.
- CONTRACTOR TO VERIFY ALL UNDERGROUND UTILITIES IN THE FIELD PRIOR TO CONSTRUCTION AND NOTIFY ENGINEER IF DISCREPANCIES OCCUR.
- THE LOCATION OF ALL UTILITIES PRESENTED ON THESE DRAWINGS IS SHOWN IN AN APPROXIMATE WAY ONLY. THE CONTRACTOR SHALL DETERMINE THE EXACT LOCATION BEFORE COMMENCING WORK. HE AGREES TO BE FULLY RESPONSIBLE FOR ANY AND ALL DAMAGES WHICH MIGHT BE OCCASIONED BY HIS FAILURE TO EXACTLY LOCATE AND PRESERVE THESE UNDERGROUND UTILITIES.
- CAUTION!!! THERE ARE OVERHEAD POWER LINES IN THE WORK AREA. CONTRACTOR SHALL FOLLOW CITY, STATE AND FEDERAL GUIDELINES WHEN WORKING AROUND EXISTING POWER LINES.
- CONTRACTOR TO OBTAIN ALL PERMITS AND APPROVALS REQUIRED PRIOR TO STARTING CONSTRUCTION.
- SIDEWALKS SHALL HAVE A RUN SLOPE NO GREATER THAN 5% AND A CROSS SLOPE NO GREATER THAN 2%, UNLESS OTHERWISE NOTED.
- ALL DIMENSIONS ARE TO FACE OF CURB OR EDGE OF PAVEMENT UNLESS OTHERWISE NOTED.
- ALL DIMENSIONS ARE PERPENDICULAR OR PARALLEL TO THEIR RESPECTIVE PROPERTY LINES UNLESS OTHERWISE NOTED.
- REFER TO ARCHITECTURAL AND STRUCTURAL DRAWINGS FOR BUILDING DIMENSIONS.
- PRIOR TO CONSTRUCTION, THE CONTRACTOR SHALL COORDINATE STAGING AND TRAFFIC CONTROL PLANS WITH OWNER.
- ALL DISTURBED AREAS NOT TO BE PAVED OR LANDSCAPED SHALL BE SODDED UPON COMPLETION.
- WATER AND SEWER MAINS SHALL BE CONSTRUCTED AND TESTED IN ACCORDANCE WITH TCEQ RULES AND REGULATIONS.
- CONTRACTOR PERFORMING THE WORK SHALL BE RESPONSIBLE FOR SECURING ALL UTILITY PERMITS, PRIOR TO INSTALLATION OF ANY UTILITIES INCLUDING WATER, SEWER, ELECTRIC, CABLE TELEVISION AND GAS.
- DOMESTIC WATER LINES LESS THAN 4" IN DIAMETER SHALL BE SCH 40 PVC AND HAVE A MINIMUM COVER OF 2 FEET. DOMESTIC WATER LINES 4" DIAMETER AND LARGER SHALL BE AWWA C-900 DR 14 PVC AND HAVE A MINIMUM COVER OF 4 FEET.
- FIRE WATER SERVICE SHALL BE C-900 SELF-EXTINGUISHING PVC PIPE THAT BEARS UNDERWRITERS' LABORATORIES MARK OF APPROVAL AND IS ACCEPTABLE WITHOUT PENALTY TO TEXAS STATE FIRE INSURANCE COMMITTEE AND HAVE A MINIMUM COVER OF 4 FEET.
- SANITARY SEWER PIPE SIZES 8 INCHES AND SMALLER SHALL BE PVC SCHEDULE 40, AND PIPE SIZES 8 INCHES OR LARGER MAY BE SDR 35.
- ALL STORM AND SANITARY SEWER CLEANOUTS SHALL HAVE TRAFFIC-RATED LIDS. CLEANOUTS LOCATED OUTSIDE OF PAVED AREAS SHALL HAVE 18" DIAMETER X 6" THICK REINFORCED CONCRETE PAD WITH TOP OF PAD MATCHING FINISHED GRADE.
- PROVIDE BENTONITE PLUG AT ALL POINTS WHERE UTILITIES EXIST UNDER BUILDING FOUNDATION. REFER TO STRUCTURAL FOR DETAIL.

GENERAL UTILITY KEY NOTES:

- REFER TO MEP PLANS FOR SIZE AND CONTINUATION.
- FIELD VERIFY EXISTING UTILITY LOCATION, SIZE AND DEPTH BEFORE CONSTRUCTION.
- 1 FULL LENGTH OF PIPE WITH RESTRAINT JOINTS CENTER ABOVE/BELOW SANITARY/WATER PIPE

DRAINAGE KEY NOTES:

- PROPOSED STORM SEWER STRUCTURE
- PROPOSED STORM SEWER CLEANOUT
- PROPOSED 6" HOPE DOWNSPOUT

SANITARY SEWER KEY NOTES:

- FIELD LOCATE EXISTING SANITARY SEWER AND CONNECTED PROPOSED SANITARY SEWER TO EXISTING SANITARY SEWER.
- PROPOSED SANITARY MANHOLE.
- PROPOSED SANITARY CLEANOUT.

WATER KEY NOTES:

- NOT USED.
- PROPOSED DOMESTIC 2" IRRIGATION METER.
- PROPOSED IRRIGATION 2" BACKFLOW PREVENTOR
- FIELD LOCATED EXISTING WATER LINE AND CONNECT PROPOSED FIRE WATER LINE.
- PROPOSED 8" FIRE/DOMESTIC COMPOUND WATER METER.
- PROPOSED 8" FIRE WATER BACKFLOW PREVENTOR.
- PROPOSED CHECK VALVE ASSEMBLY WITH 4" FDC & PIV VAULT.
- 8" GATE VALVE W/BOX
- 6" GATE VALVE W/BOX

WATER AND SANITARY SERVICE CONNECTIONS TO BE COORDINATED WITH EAST MONTGOMERY COUNTY M.U.D. No. 5.

**BROWN REYNOLDS WATFORD ARCHITECTS**  
4301 MAGNOLIA CIRCLE DRIVE  
SUITE 100  
HOUSTON, TEXAS 77057  
281-361-3800  
WWW.BRWARCHITECTS.COM

**FRED DALLY**  
90904  
10/02/2024

**Daily**  
ASSOCIATES  
8900 Harwin Avenue, Suite 400  
Houston, Texas 77036  
281-337-8881  
TECHNICAL ENGINEERING  
P.E. PROJECT NO. 23-085-00


COPYRIGHT © 2024  
BROWN REYNOLDS WATFORD ARCHITECTS, INC.  
DATE: SEPTEMBER 9, 2024  
DRAWN BY: AG  
CHECKED BY: JC  
BRW PROJECT NUMBER: 223117.00

**NEW CANEY I.S.D.**  
**NEW CANEY**  
**ELEMENTARY SCHOOL**  
19300 VIA CORSICA DRIVE  
NEW CANEY, TX 77537

NO.	REVISION	DATE
1	ADDENDUM No. 1	9/23/2024
2	ADDENDUM No. 2	10/02/2024

**C6.0**  
UTILITY PLAN



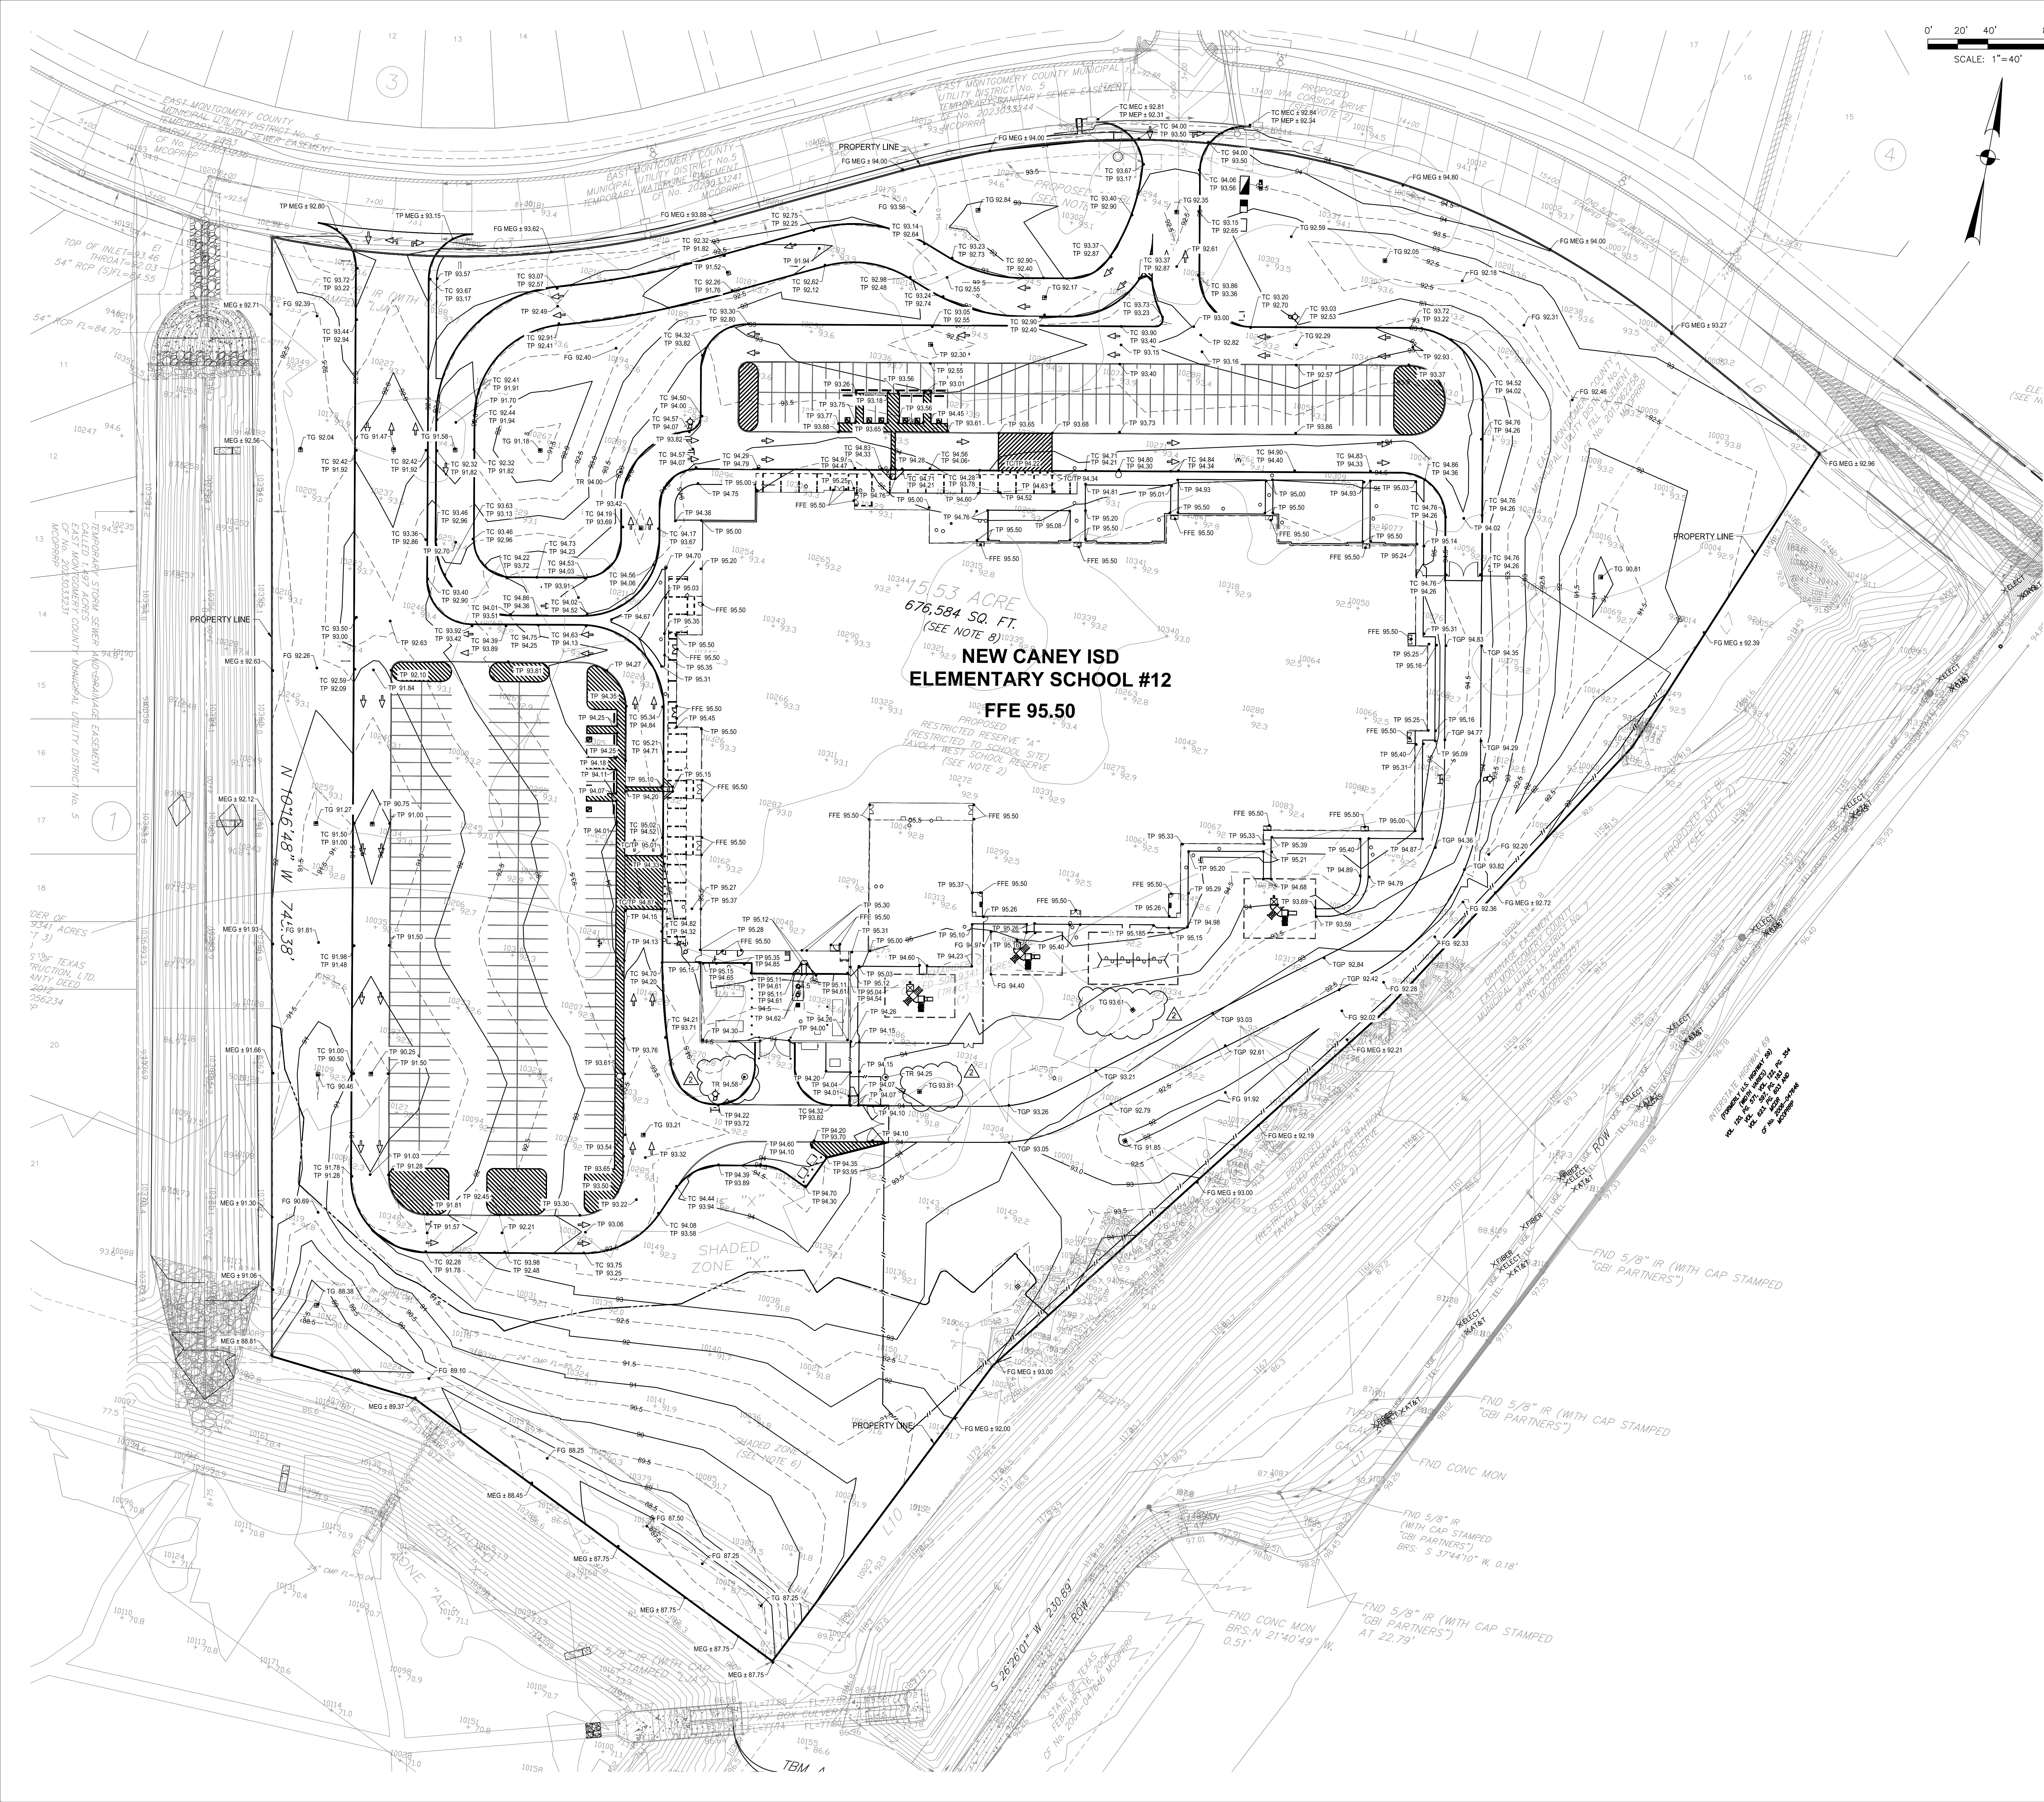


**LEGEND**

PROPOSED BUILDING LIMITS	
FFE	FINISHED FLOOR ELEVATION
FL	FLOW LINE
FG	FINISHED GRADE
MEG	MATCH EXISTING CURB
MEP	MATCH EXISTING GRADE
TC	TOP OF CURB
TG	TOP OF GRATE
TP	TOP OF PAVEMENT
NG	NATURAL GROUND
---	DRAINAGE PATTERN
---	EXISTING CONTOURS
---	PROPOSED CONTOURS
---	500 YR BASE FLOOD ELEVATION
---	TOP OF GRAVEL PAVEMENT

- GENERAL CONSTRUCTION NOTES:**
- ALL UNDERGROUND UTILITIES SHOWN ARE NOT GUARANTEED TO BE COMPLETE OR DEFINITE, BUT WERE OBTAINED FROM THE BEST INFORMATION AVAILABLE.
  - CONTRACTOR TO VERIFY ALL UNDERGROUND UTILITIES IN THE FIELD PRIOR TO CONSTRUCTION AND NOTIFY ENGINEER IF DISCREPANCIES OCCUR.
  - THE LOCATION OF ALL UTILITIES PRESENTED ON THESE DRAWINGS IS SHOWN IN AN APPROXIMATE WAY ONLY. THE CONTRACTOR SHALL DETERMINE THE EXACT LOCATION BEFORE COMMENCING WORK. HE AGREES TO BE FULLY RESPONSIBLE FOR ANY AND ALL DAMAGES WHICH MIGHT BE OCCASIONED BY HIS FAILURE TO EXACTLY LOCATE AND PRESERVE THESE UNDERGROUND UTILITIES.
  - CAUTION! THERE ARE OVERHEAD POWER LINES IN THE WORK AREA. CONTRACTOR SHALL FOLLOW CITY, STATE AND FEDERAL GUIDELINES WHEN WORKING AROUND EXISTING POWER LINES.
  - ALL DIMENSIONS ARE TO FACE OF CURB OR EDGE OF PAVEMENT UNLESS OTHERWISE NOTED.
  - ALL DIMENSIONS ARE PERPENDICULAR OR PARALLEL TO THEIR RESPECTIVE PROPERTY LINES UNLESS OTHERWISE NOTED.
  - REFER TO ARCHITECTURAL AND STRUCTURAL DRAWINGS FOR BUILDING DIMENSIONS.
  - PRIOR TO CONSTRUCTION, THE CONTRACTOR SHALL COORDINATE STAGING AND TRAFFIC CONTROL PLANS WITH OWNER.
  - ALL DISTURBED AREAS NOT TO BE PAVED OR LANDSCAPED SHALL BE SODED OR HYDROMULCHED UPON COMPLETION. RE: LANDSCAPE

**BROWN REYNOLDS WATFORD ARCHITECTS**  
4301 MAGNOLIA CIRCLE DRIVE  
HOUSTON, TEXAS 77056  
281-361-3800  
WWW.BRWARCHITECT.COM

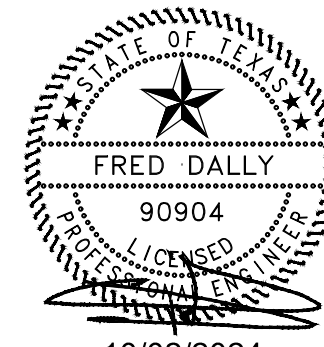

**Daily**  
+ ASSOCIATES  
8600 Harland Avenue, Suite 400  
Houston, Texas 77036  
TELEPHONE: 281-527-5200  
FAX: 281-527-5201  
D - A PROJECT NO. 023-085-00

COPYRIGHT © 2024  
BROWN REYNOLDS WATFORD ARCHITECTS, INC.  
DATE: SEPTEMBER 9, 2024  
DRAWN BY: AG  
CHECKED BY: JC  
BRW PROJECT NUMBER: 223117.00

**NEW CANEY I.S.D.**  
**NEW CANEY**  
**ELEMENTARY SCHOOL**  
19300 VIA CORSICA DRIVE  
NEW CANEY, TX 77357

NO.	REVISION	DATE
1	ADDENDUM No. 1	9/23/2024
2	ADDENDUM No. 2	10/02/2024

ACCORDING TO THE FEDERAL MANAGEMENT AGENCY FLOOD INSURANCE RATE MAP NO. 48339C000, MAP REVISED AUGUST 18, 2014, THE SUBJECT PROPERTY LIES WITHIN ZONES "X" AND SHADED ZONE "X" IS DEFINED AS A SPECIAL FLOOD HAZARD AREA SUBJECT TO INUNDATION BY THE 1% ANNUAL CHANCE FLOOD WITH BASE FLOOD ELEVATION DETERMINED. AREAS OF 1% ANNUAL CHANCE FLOOD WITH AVERAGE DEPTHS OF LESS THAN 1 FOOT OR WITH DRAINAGE AREAS OF LESS THAN 1 SQUARE MILE; AND AREAS PROTECTED BY LEVEES FROM 1% ANNUAL CHANCE FLOOD AS SHOWN ON THE FEMA MAP REFERENCED ABOVE.



500 YR BFE = 92.00'

**C7.0**  
GRADING PLAN








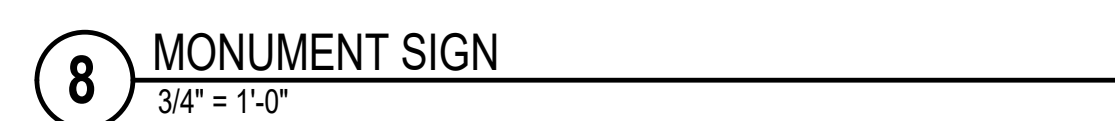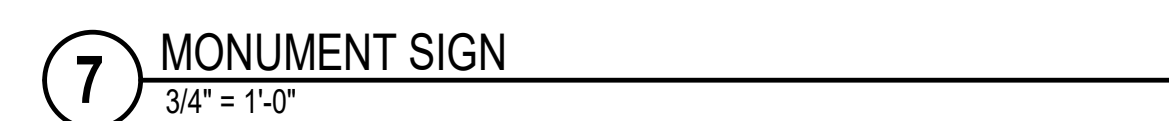



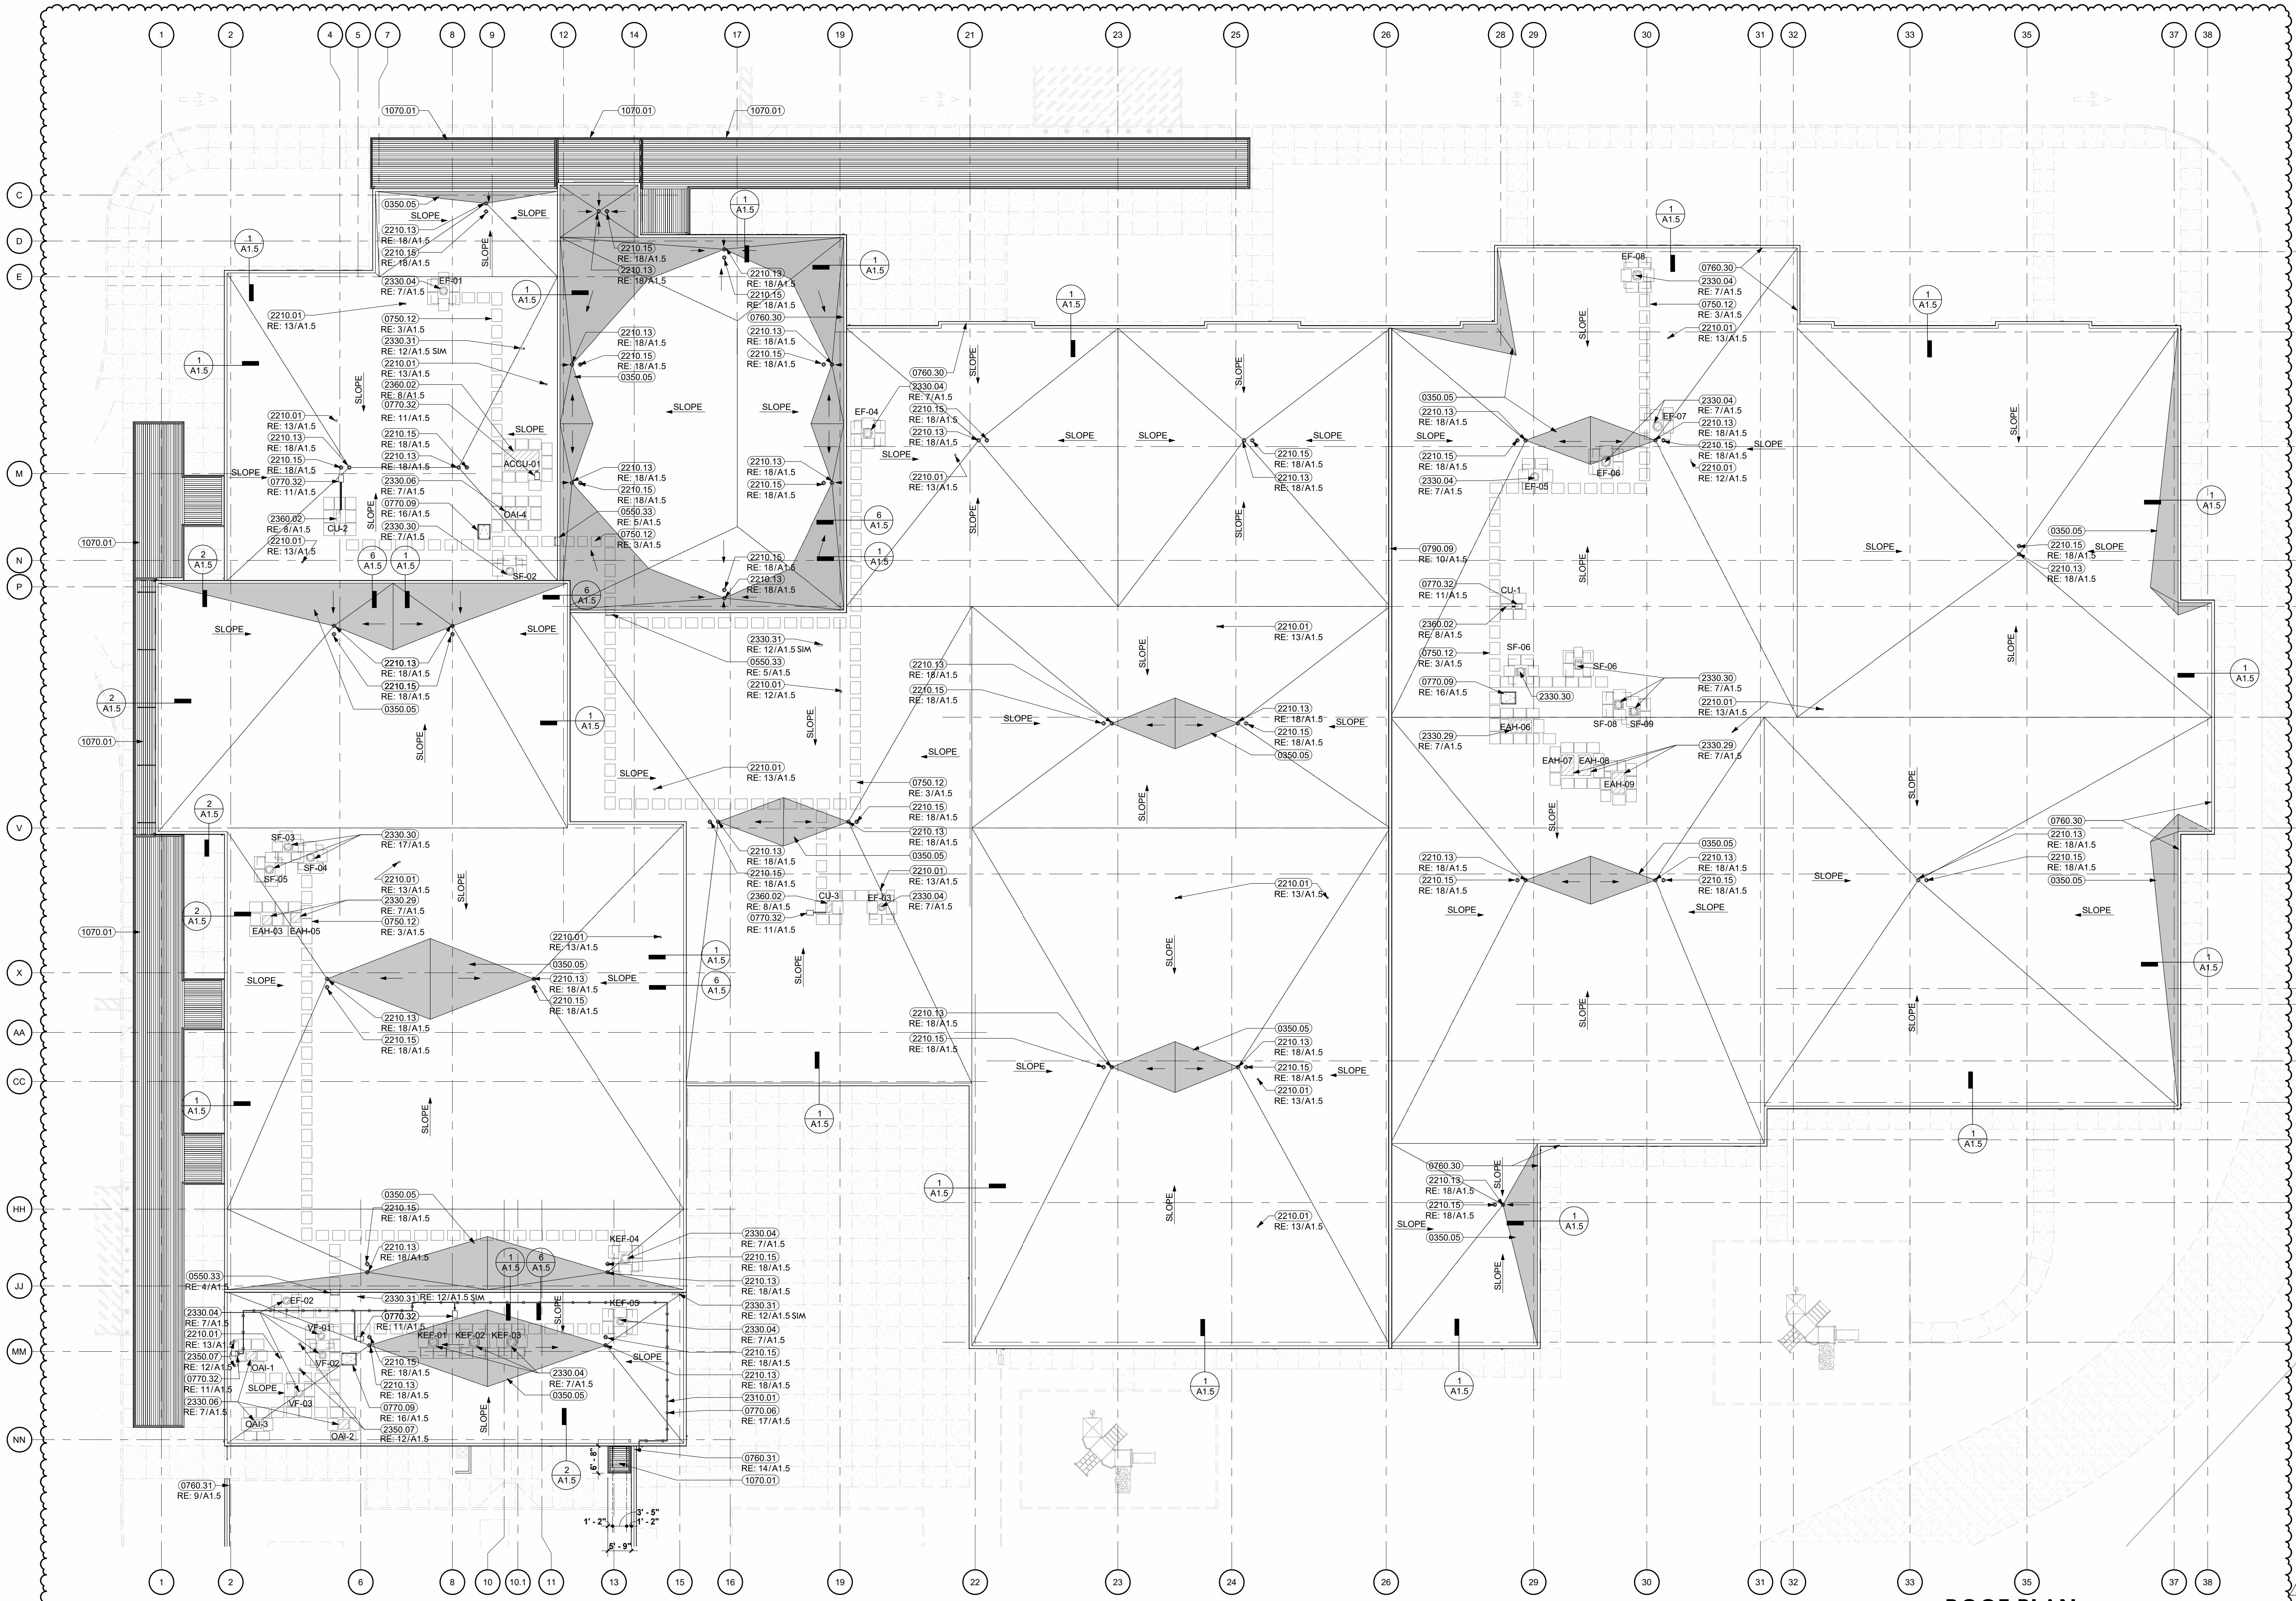

- KEYNOTES**
- 0350.05 TAPERED (STAIR-STEPPED) INSULATION
  - 0550.33 WALKWAY PAD
  - 0750.12 METAL LADDER
  - 0760.30 PREFINISHED METAL COPING SYSTEM
  - 0770.06 PREFABRICATED PIPE PEDESTAL
  - 0770.09 ROOF HATCH WITH INTEGRAL CURB AND COUNTERFLASHING
  - 0770.32 REMOVABLE 16 GA. STAINLESS STEEL HOOD, CROSS-BREAK OR SLOPE FOR DRAINAGE
  - 0790.09 ROOF EXPANSION JOINT SYSTEM
  - 1070.01 PRE-MANUFACTURED EXTERIOR ALUMINUM CANOPY SYSTEM
  - 2210.01 PLUMBING VENT
  - 2210.13 ROOF DRAIN
  - 2210.15 OVERFLOW ROOF DRAIN
  - 2310.01 GAS PIPING (PAINT WHERE EXPOSED)
  - 2330.04 EXHAUST FAN
  - 2330.06 OUTSIDE AIR INTAKE HOOD
  - 2330.29 EXHAUST AIR HOOD
  - 2330.30 SUPPLY FAN
  - 2330.31 DRYER EXHAUST VENT
  - 2350.07 HOT FLUE VENT WITH BASE AND COLLAR
  - 2360.02 HVAC CONDENSING UNIT

**1 ROOF PLAN**  
1/16" = 1'-0"

**BROWN REYNOLDS WATFORD**  
ARCHITECTS  
4501 MAGNOLIA COVE DRIVE  
SUITE 200  
HOUSTON, TEXAS 77045  
281-361-3800  
WWW.BRWARCH.COM

COPYRIGHT © 2024  
BROWN REYNOLDS WATFORD ARCHITECTS, INC.  
DATE: SEPTEMBER 9, 2024  
DRAWN BY: HN, AH, LB  
CHECKED BY: JSC  
PROJECT NUMBER: 22317.00

**NEW CANEY I.S.D.**  
**NEW CANEY**  
**ELEMENTARY SCHOOL**  
19300 VIA CORSICA DRIVE  
NEW CANEY, TX 77337







NO.	REVISION	DATE
2	ADDENDUM NO.2	10/22/2024

**A1.4**

ROOF PLAN




0350.03	LIGHTWEIGHT INSULATING CONCRETE ROOF WITH 4" EXPANDED POLYSTYRENE INSULATION BOARD (EIFS)
0350.04	COMPRESSIBLE FILLER
0350.05	TAPERED (STAIR-STEP) INSULATION BOARD AS REQUIRED TO PROVIDE SLOPE
0405.01	FLASHING END DAM
0420.03	FACE BRICK
0420.10	4" CONCRETE MASONRY UNITS
0420.14	8" CONCRETE MASONRY UNITS
0420.23	CONCRETE MASONRY BOND BEAM
0440.07	STONE VENEER
0510.01	STEEL STRUCTURE (RE: STRUCTURAL)
0510.02	STEEL JOIST (RE: STRUCTURAL)
0510.05	STEEL CHANNEL (RE: STRUCTURAL)
0510.08	STEEL BENT PLATE (RE: STRUCTURAL)
0520.01	STEEL JOIST (RE: STRUCTURAL)
0530.02	METAL ROOF DECK (RE: STRUCTURAL)
0540.02	6" METAL STUDS (C.F.M.F.) AT 16" O.C.



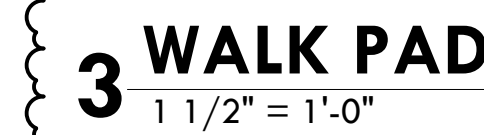
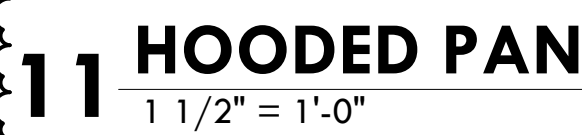
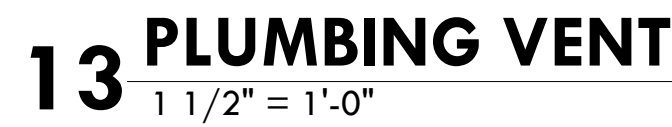
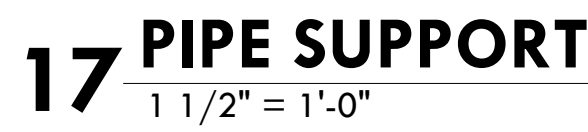
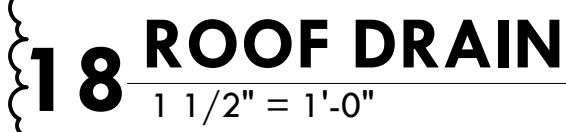
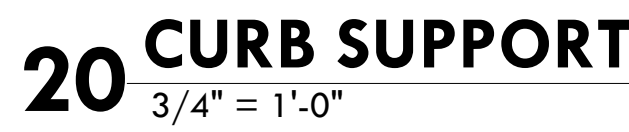




0830.07	CEILING COUNTER DOOR
0930.01	CERAMIC TILE
0930.02	COVERED CERAMIC TILE BASE
0930.10	WALL TILE
0980.13	4" RESILIENT BASE
0980.25	SEAMLESS EPOXY BASE
0980.03	1" THICK FABRIC-WRAPPED ACOUSTICAL WALL PANELS
1010.50	12" MARKERBOARD
1010.52	4" TACKBOARD
1020.16	STAINLESS STEEL 1 1/2" DIAMETER GRAB BAR (36" LONG)
1020.20	1/2" DIAPHRAGM DISPENSER (SURFACE-MOUNTED) (OFCI)
1020.22	PAPER TOWEL DISPENSER (SURFACE-MOUNTED) (OFCI)
1020.50	STAINLESS-STEEL FRAMED MIRROR (24" x 36")
1040.03	FIRE EXTINGUISHER AND SEMI-RECESSED CABINET
1130.19	3" CELING MOUNTED FLAT SCREEN
1140.03	KITCHEN EQUIPMENT (REF. FOOD SERVICE)
1150.27	RECESSED PROJECTOR SCREEN
1160.02	THEATRICAL PROSCENIUM VALANCE
1224.01	WATER CLOSURE - ORIENT PLUSH VALVE TOWARDS ACCESSIBLE SPACE AT
1224.03	STALLS / RESTROOMS
1224.04	WALL-HUNG LAVATORY WITH CARRIER PORCELAIN LAVATORY
1224.19	BI-LEVEL DRINKING FOUNTAINS WITH BOTTLE FILLING STATION
2650.10	1/2" MOUNTED EXIT SIGN
2650.15	HOUSELIGHT SIGN

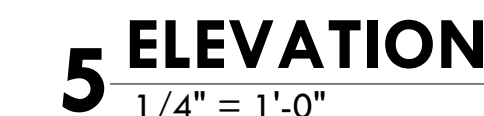



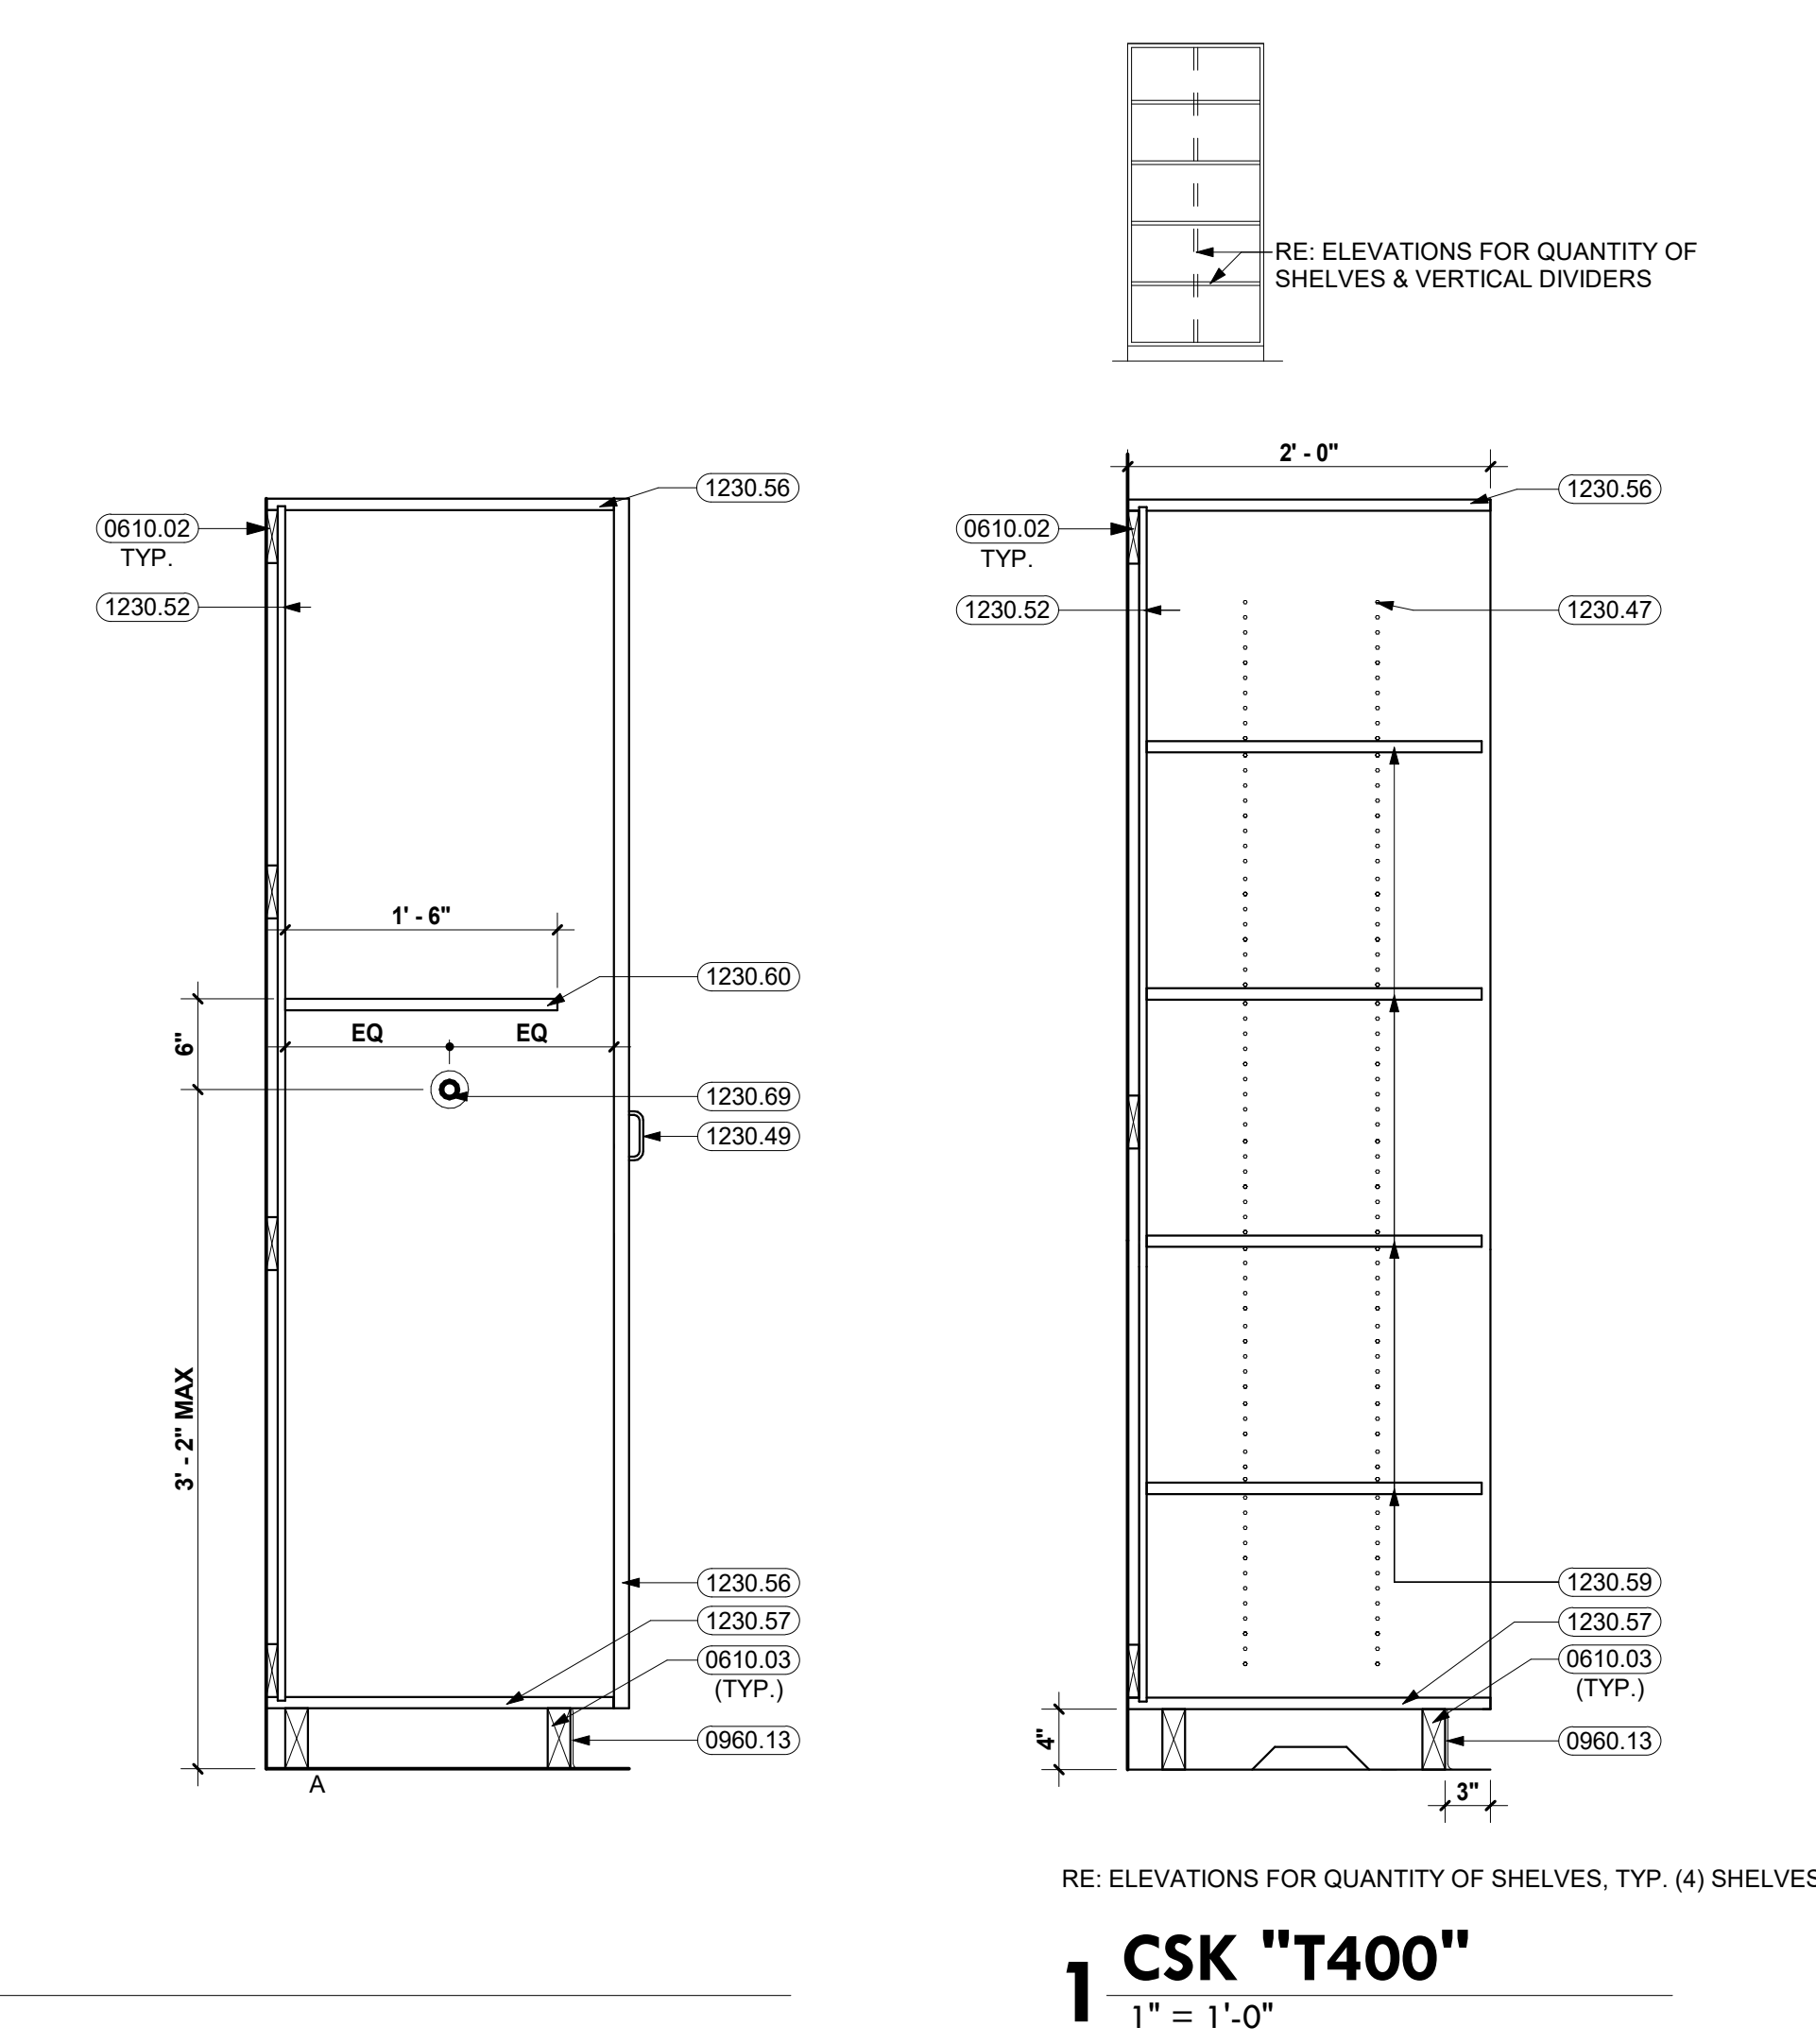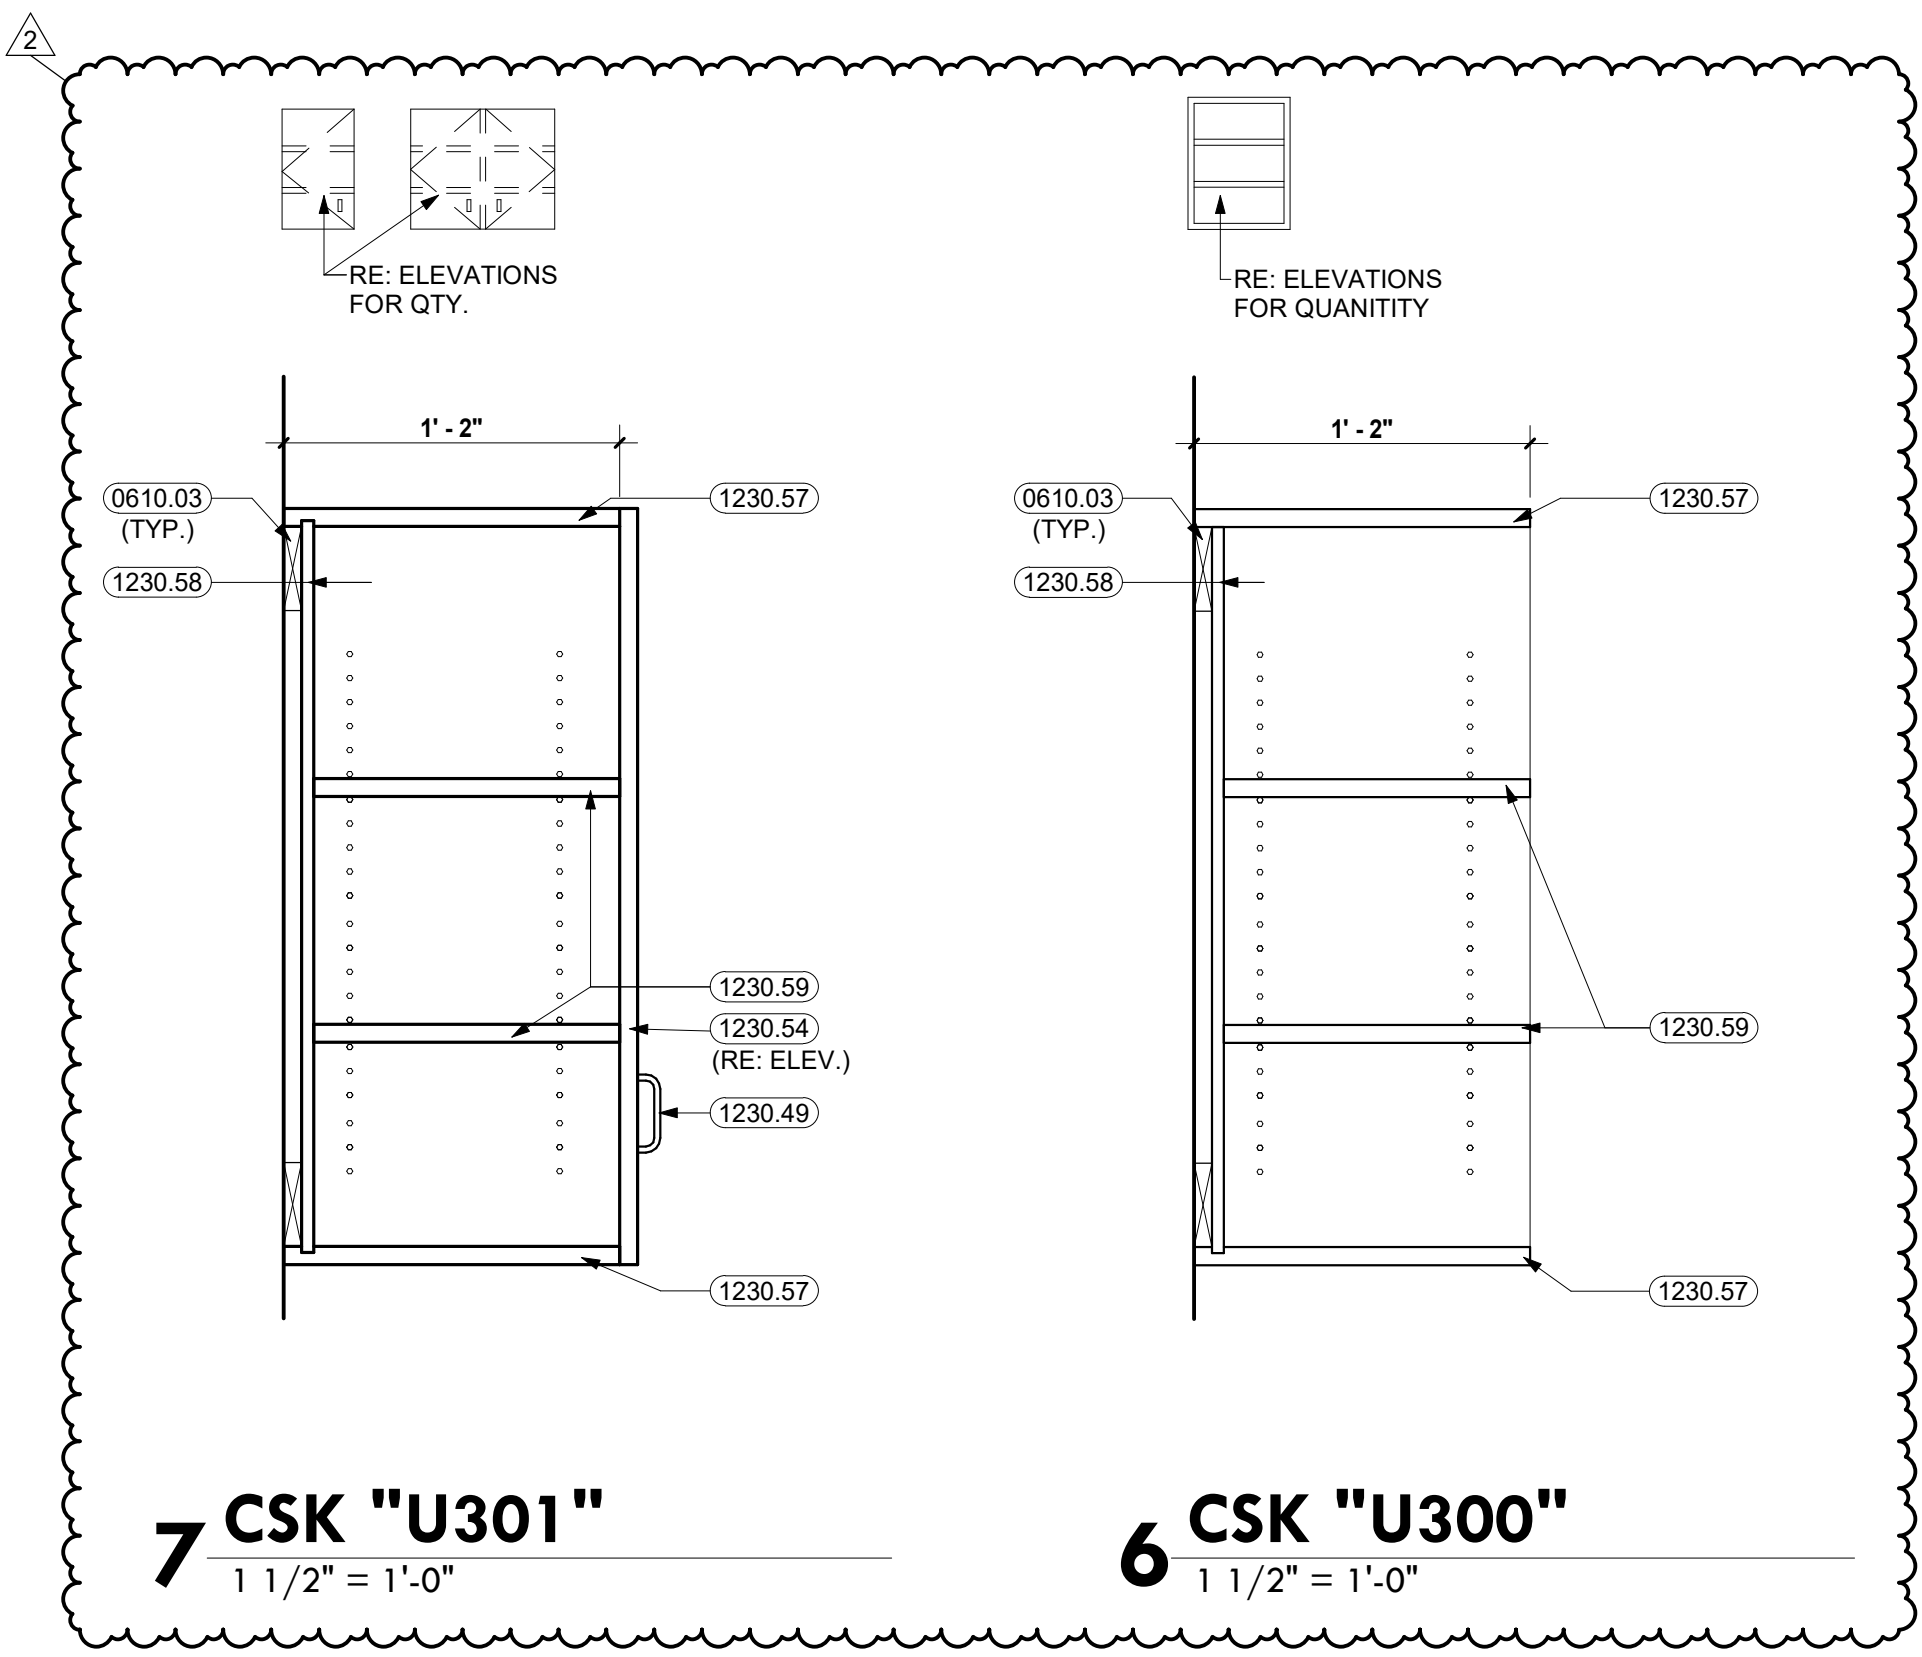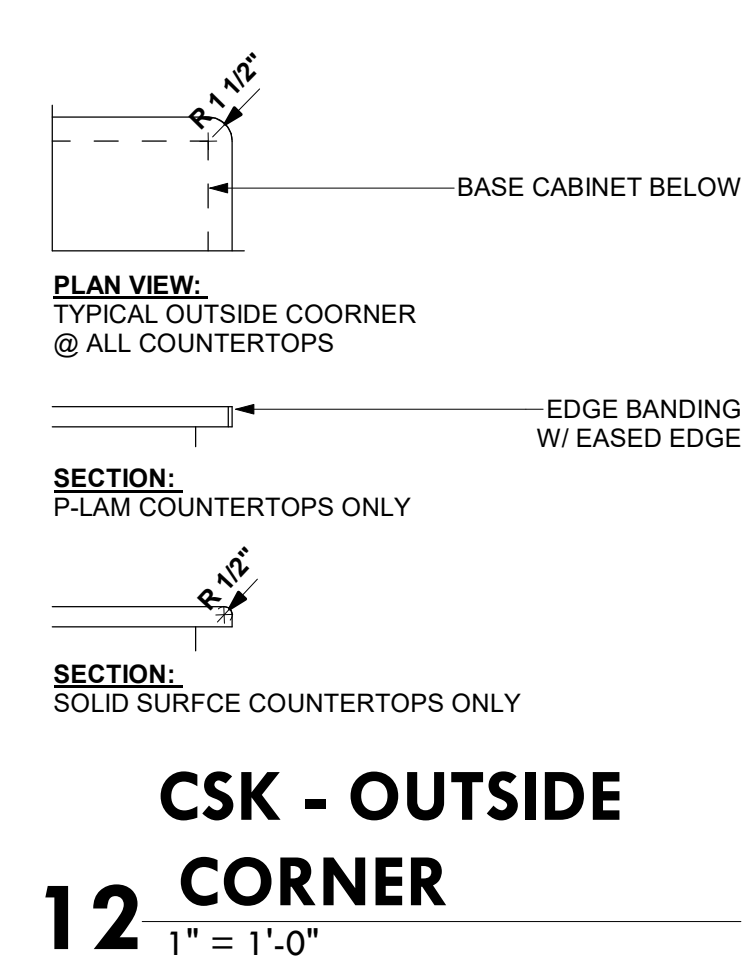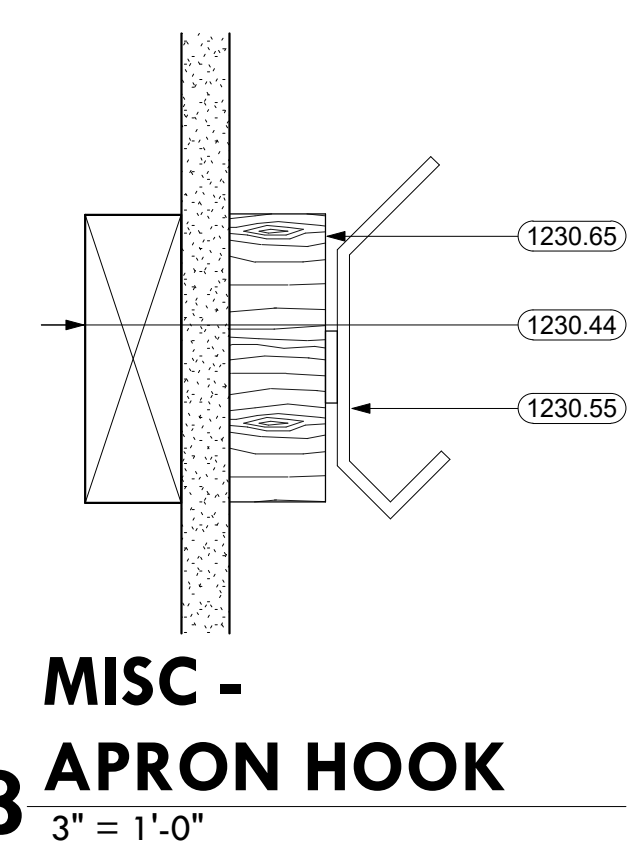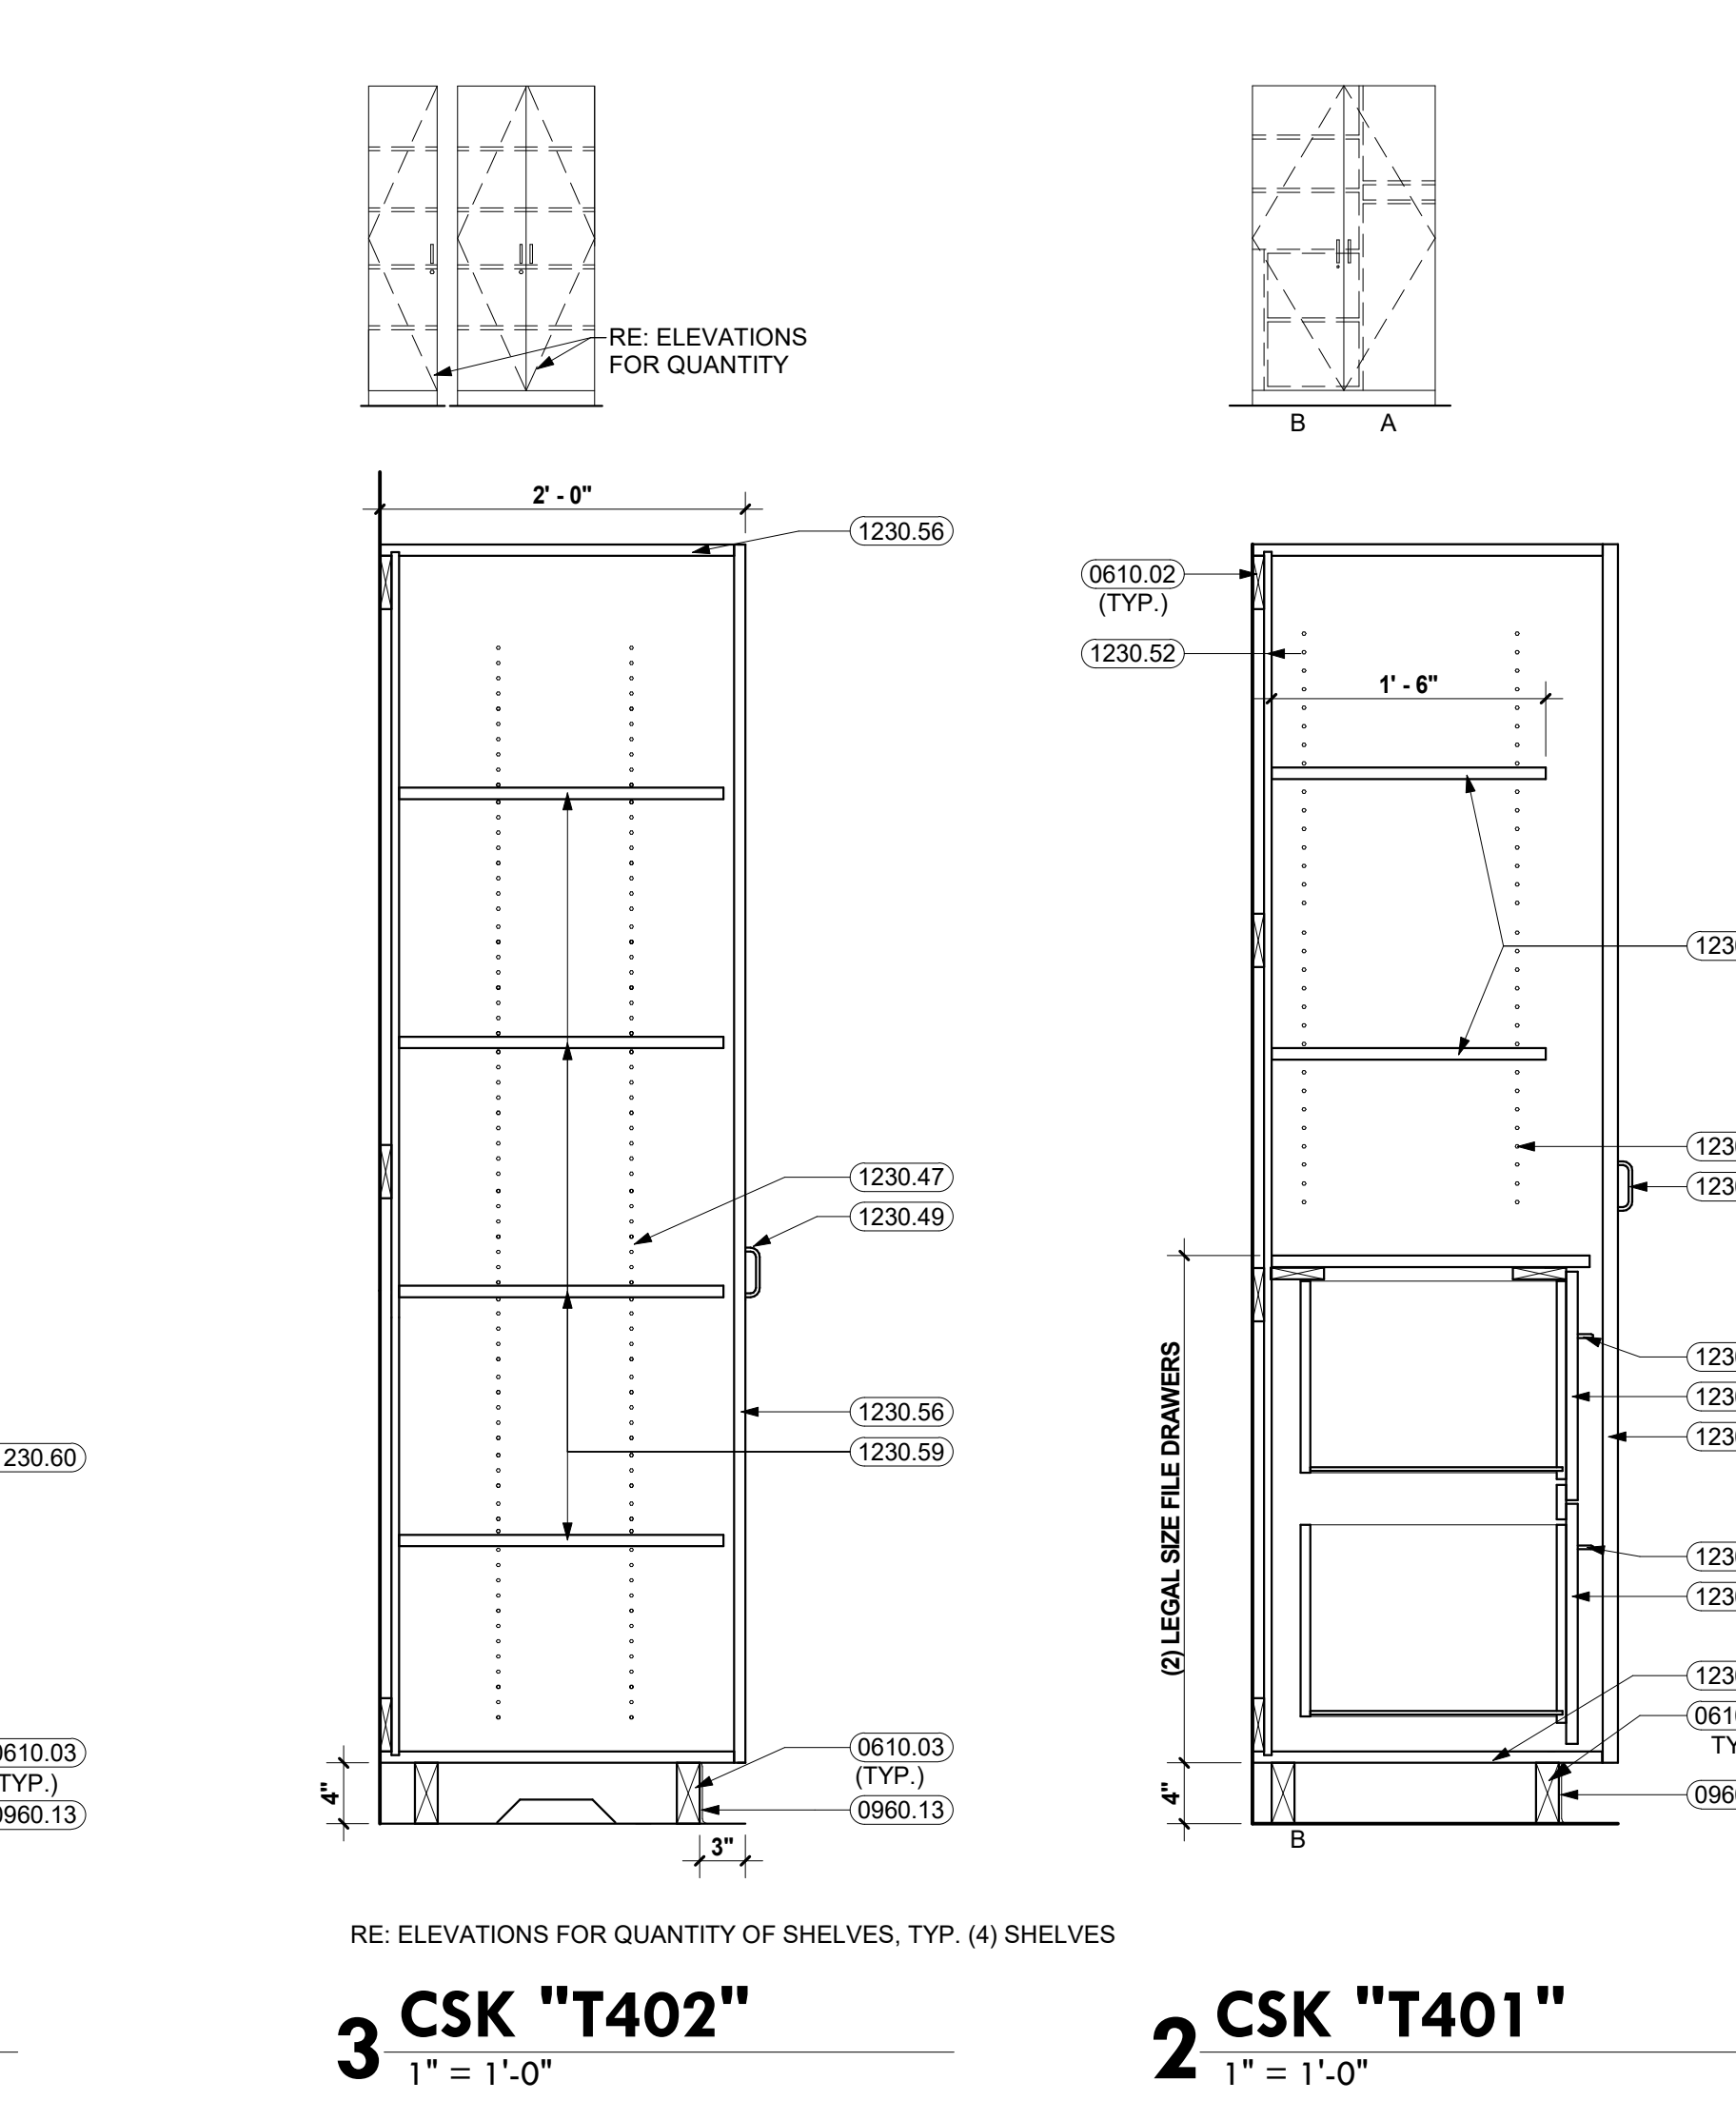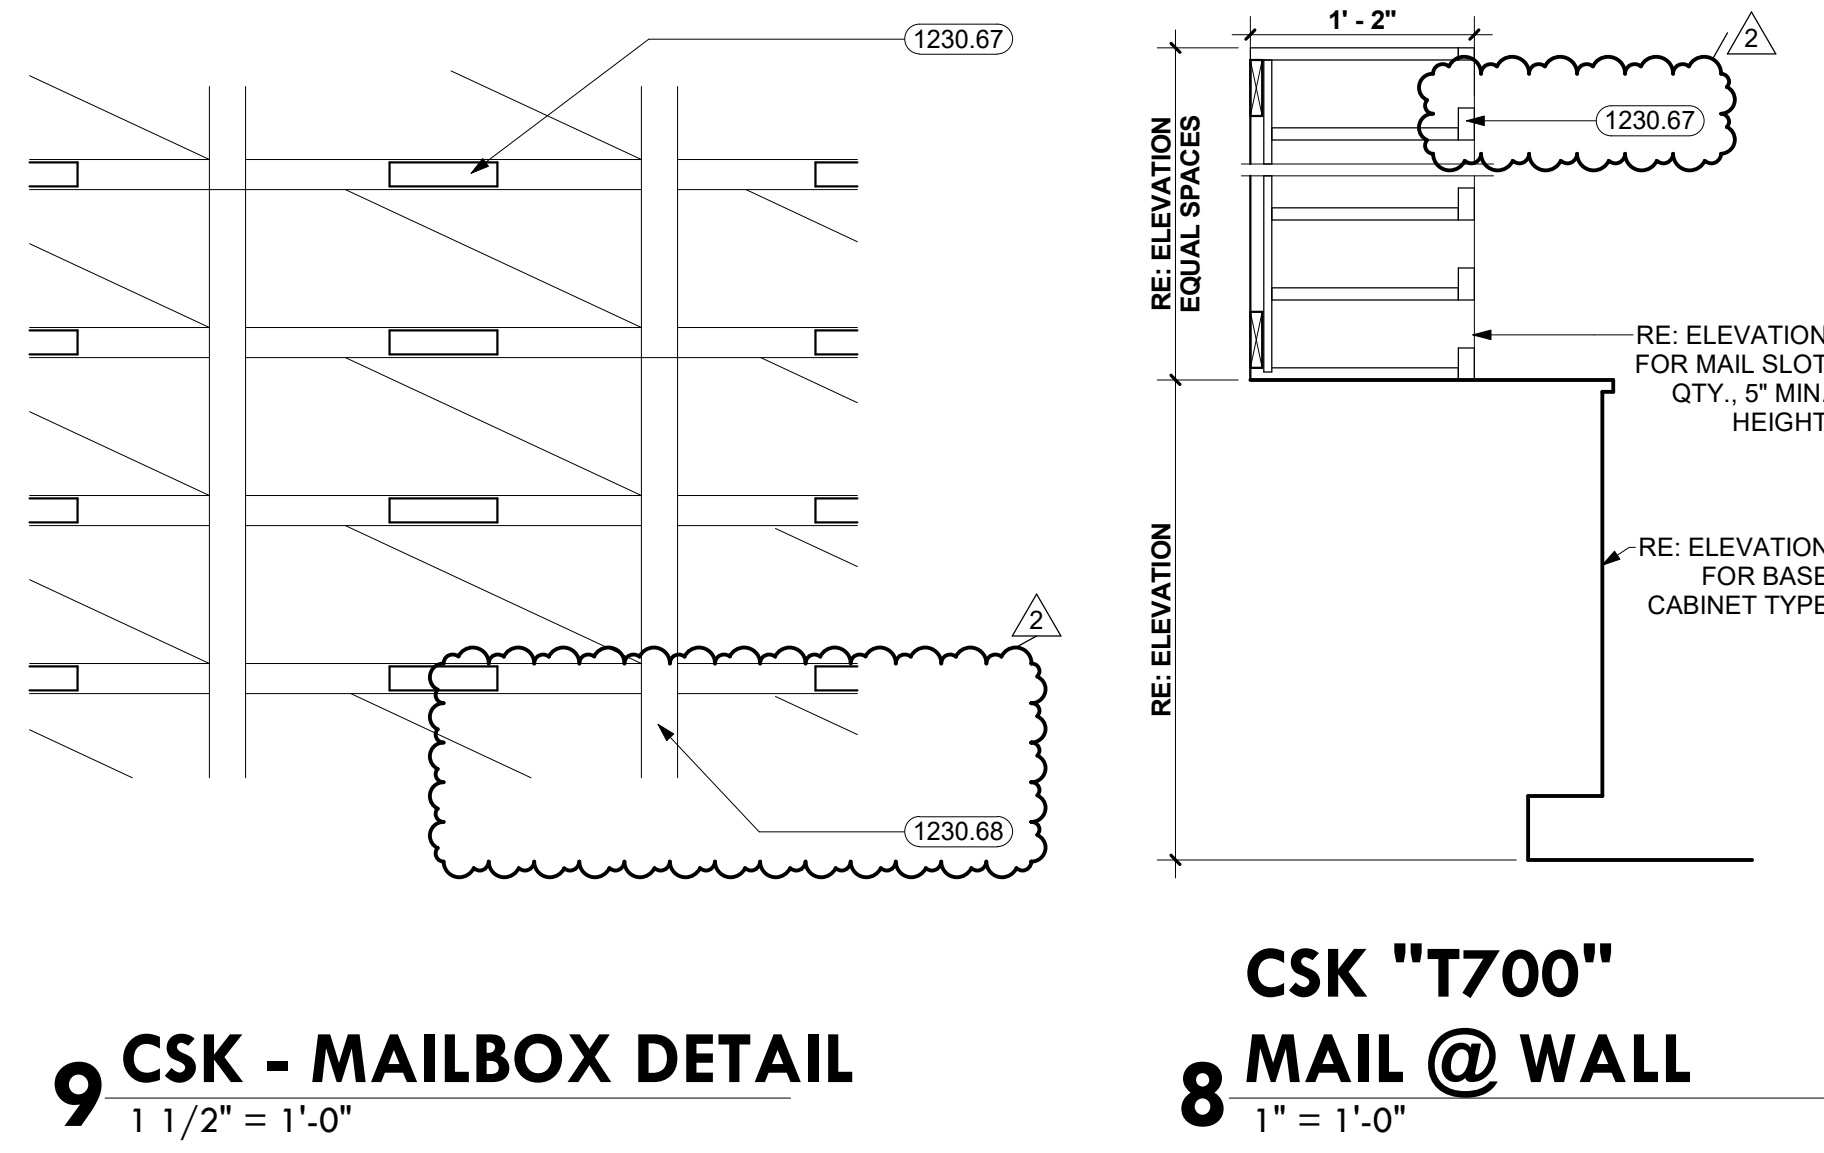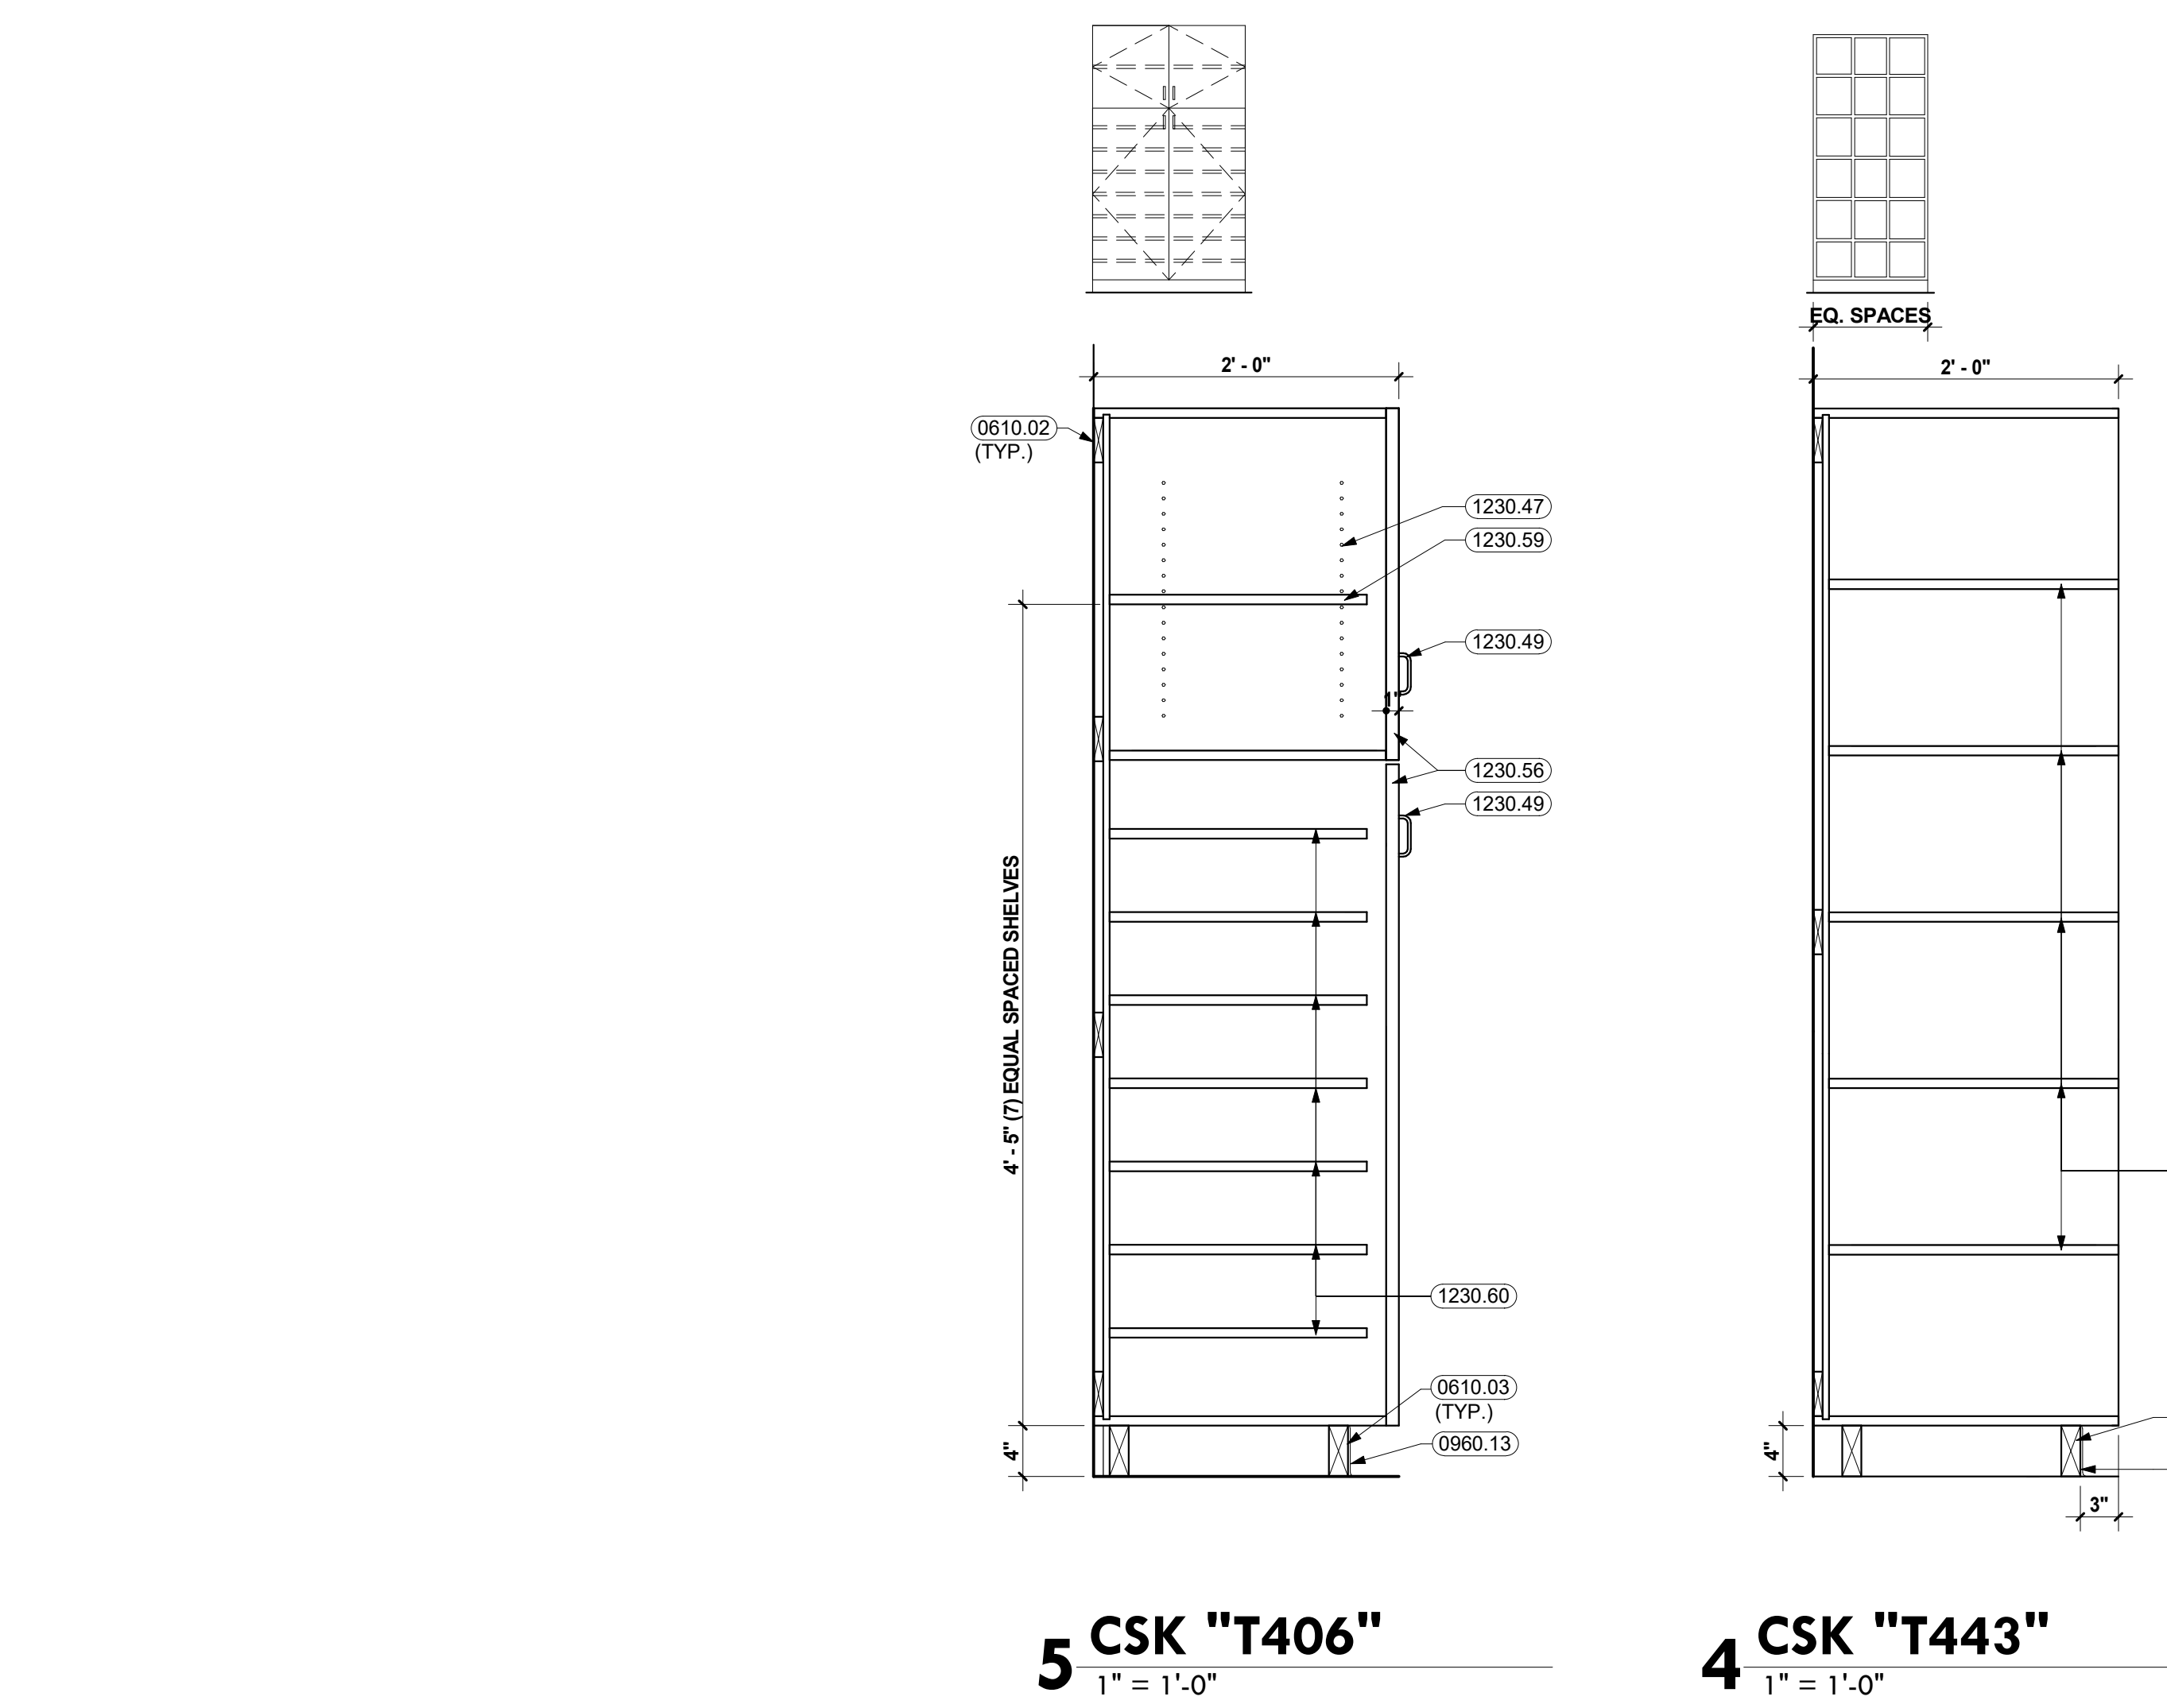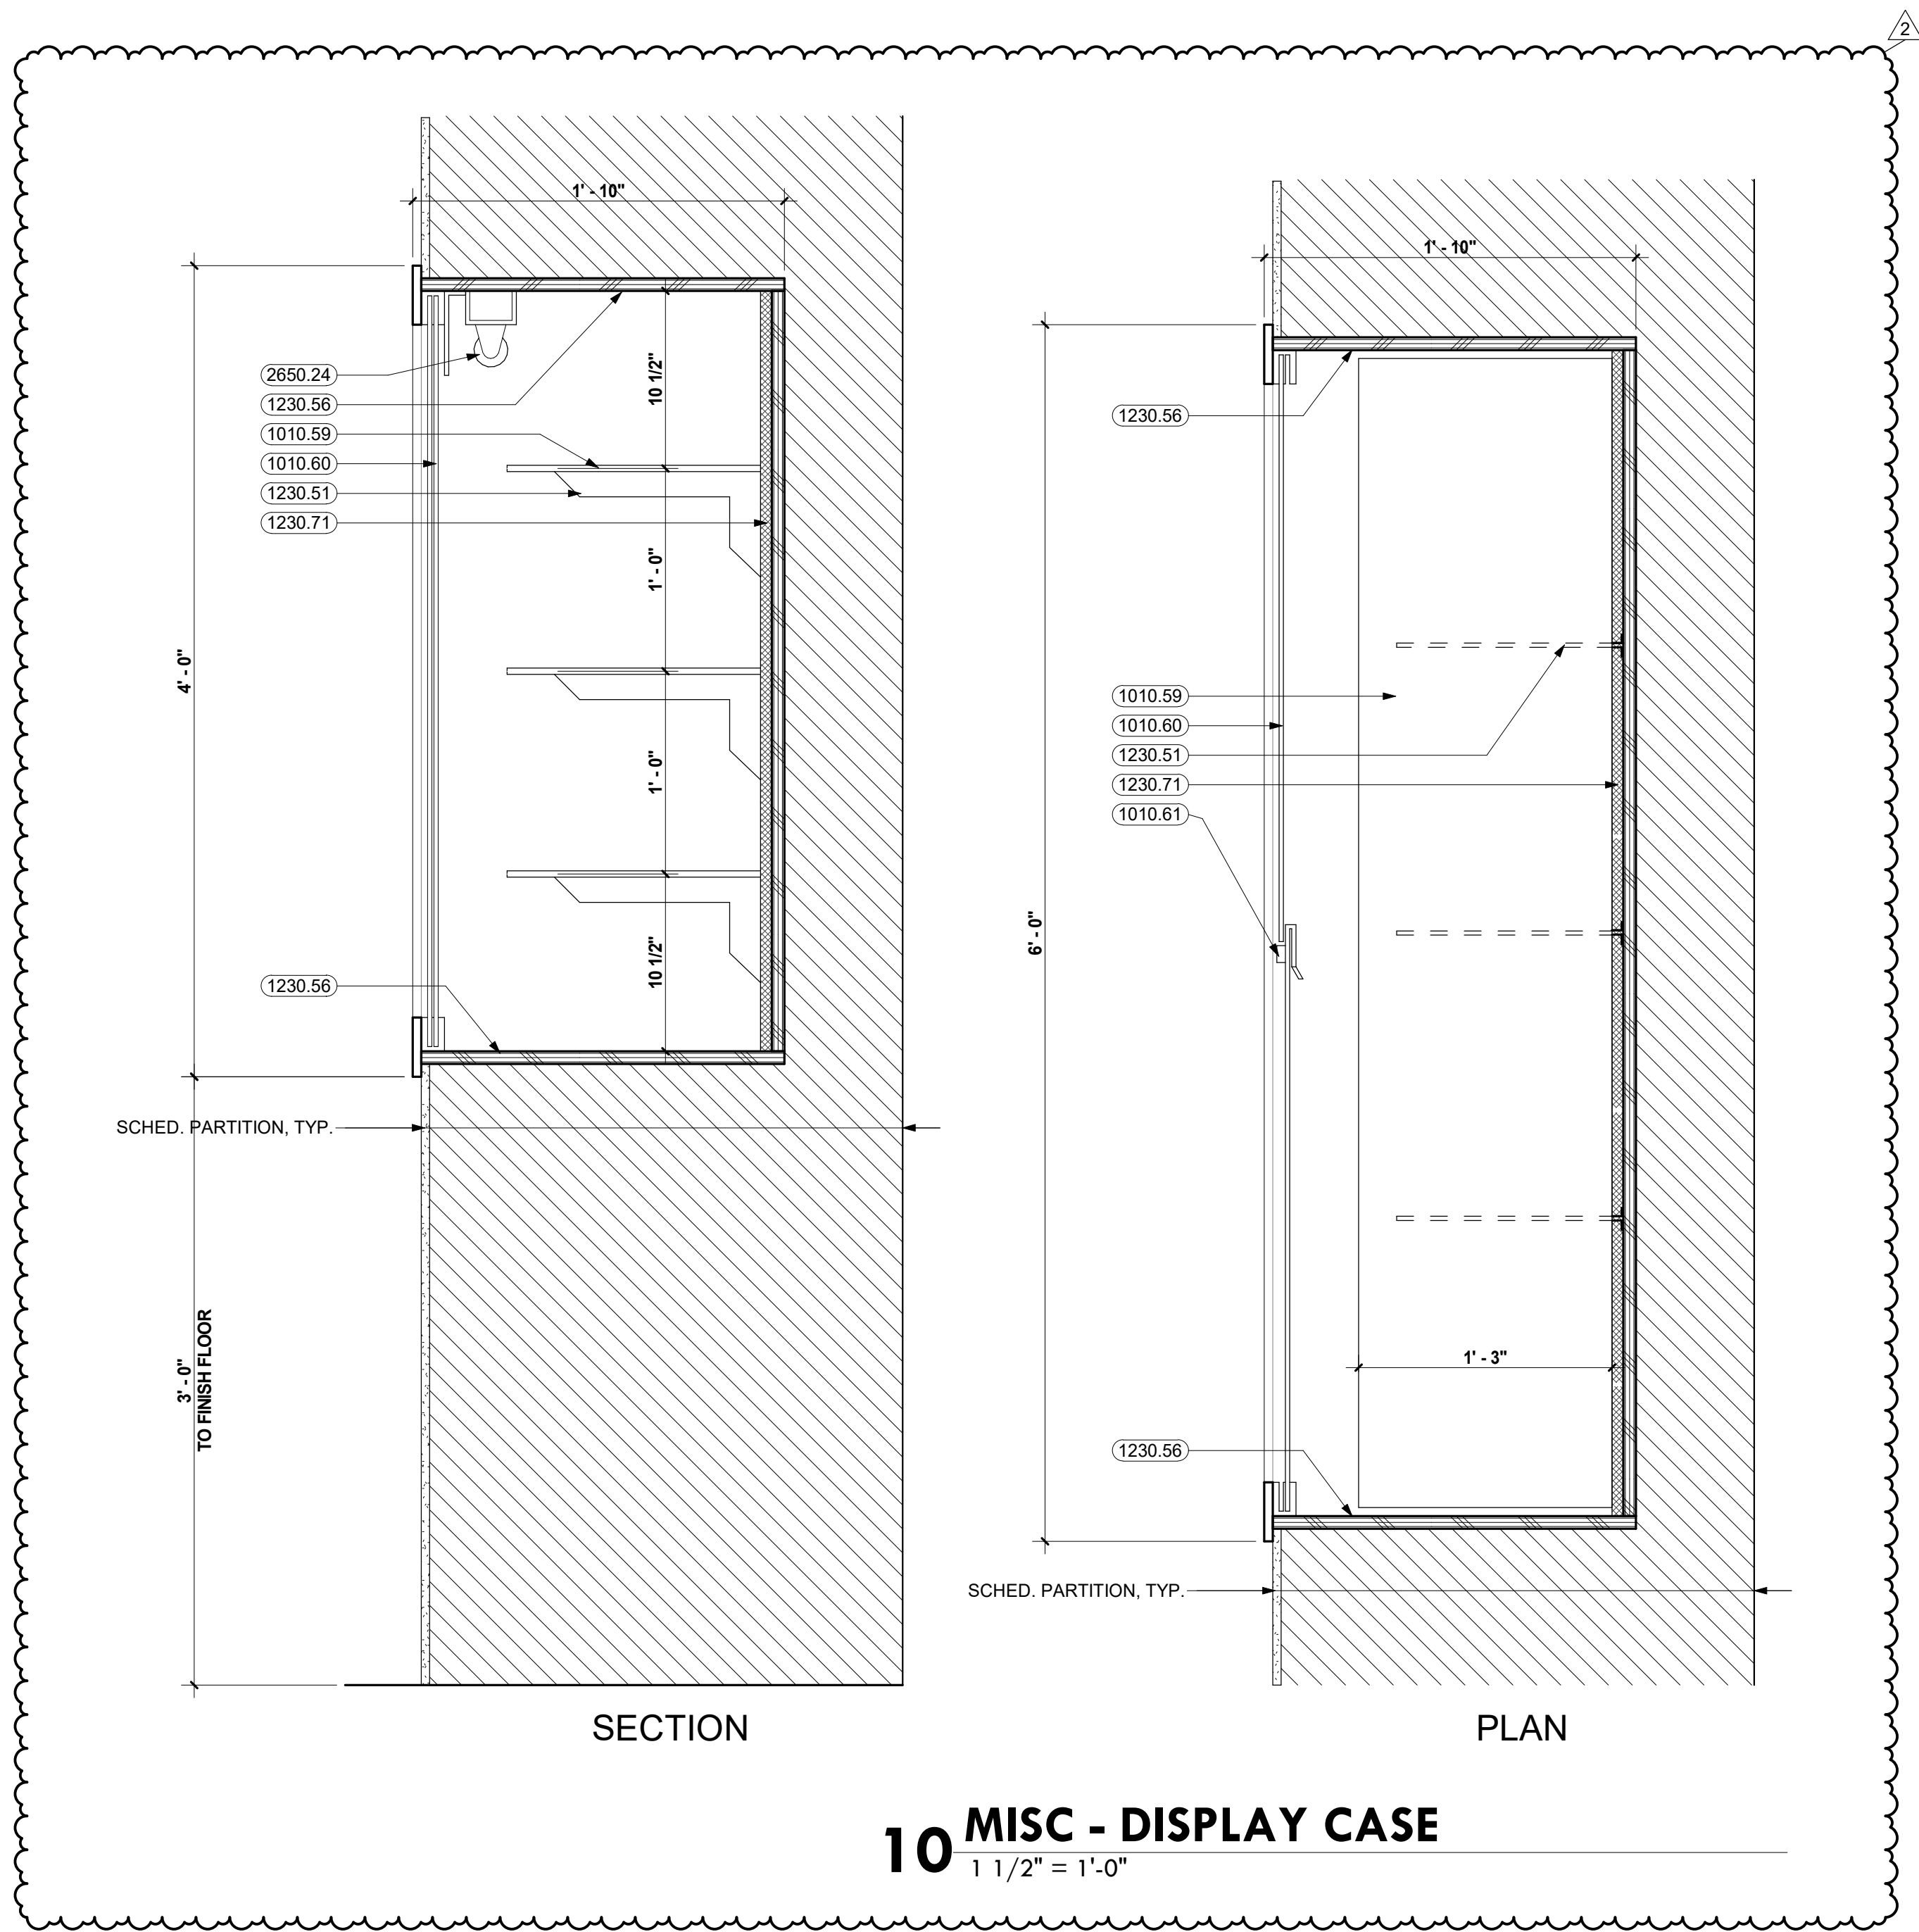

- KEYNOTES**
- 0610.02 1X WOOD BLOCKING
  - 0610.03 2X WOOD BLOCKING
  - 0960.13 4" RESILIENT BASE
  - 1010.59 3/8" CLEAR TEMPERED GLASS SHELVES
  - 1010.60 1/4" CLEAR TEMPERED GLASS BYPASS SLIDING DOORS AND ALUMINUM TRACK RATCHET LOCK
  - 1230.44 PLASTIC LAMINATE CLAD BASE CABINETS WITH ADJUSTABLE SHELVES
  - 1230.47 ADJUSTABLE SHELF REST AND PRE-DRILLED HOLES AT 1" O.C. TYP.
  - 1230.49 CABINET PULLS
  - 1230.51 SHELF BRACKET
  - 1230.52 1/2" PLASTIC LAMINATE CLAD PLYWOOD
  - 1230.53 3/4" PLASTIC LAMINATE CLAD PARTICLEBOARD DRAWER WITH 1/2" HIGH DENSITY PARTICLEBOARD BOTTOM
  - 1230.54 3/4" PLASTIC LAMINATE CLAD PARTICLEBOARD CABINET DOOR
  - 1230.55 COAT OR BACKPACK HOOK
  - 1230.56 3/4" PLASTIC LAMINATE CLAD PLYWOOD
  - 1230.57 3/4" PLASTIC LAMINATE CLAD MEDIUM DENSITY PARTICLEBOARD
  - 1230.58 1/4" PLASTIC LAMINATE CLAD CABINET BACK
  - 1230.59 3/4" PLASTIC LAMINATE CLAD PARTICLEBOARD ADJUSTABLE SHELF
  - 1230.60 FIXED 3/4" PLASTIC LAMINATE CLAD PLYWOOD SHELF
  - 1230.65 FINISHED WOOD BOLTED THRU WALL TO 2 X 4
  - 1230.67 METAL NAME PLATE
  - 1230.68 3/16" FACE FLUSH W/ VERTICAL SUPPORTS
  - 1230.69 CLOTHES ROD
  - 1230.71 3/4" AWAY CLUED TO 3/4" PLYWOOD BACKER
  - 2650.24 DISPLAY CASE LIGHT FIXTURE

**BROWN REYNOLDS WATFORD ARCHITECTS**  
4501 MAGNOLIA COVE DRIVE  
SUITE 200  
HOUSTON, TEXAS 77345  
281-361-3800  
WWW.BRWARCH.COM

**NEW CANEY I.S.D.**  
**NEW CANEY ELEMENTARY SCHOOL**  
19300 VIA CORSICA DRIVE  
NEW CANEY, TX 77337






NO.	REVISION	DATE
2	ADDENDUM NO. 2	10/2/2024

COPYRIGHT © 2024  
BROWN REYNOLDS WATFORD ARCHITECTS, INC.  
DATE: SEPTEMBER 9, 2024  
DRAWN BY: AH, QN  
CHECKED BY: JSC  
BRW PROJECT NUMBER: 223117.00

**A5.9**

CASEWORK SECTIONS





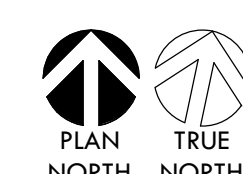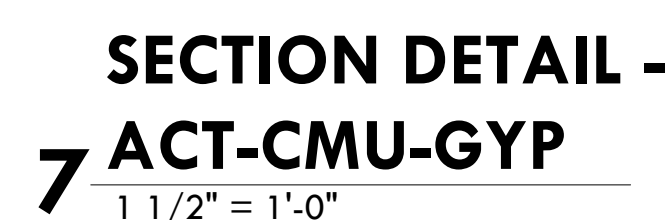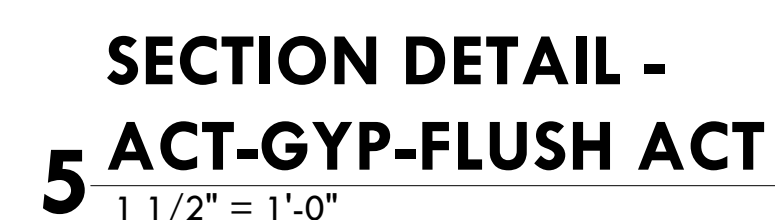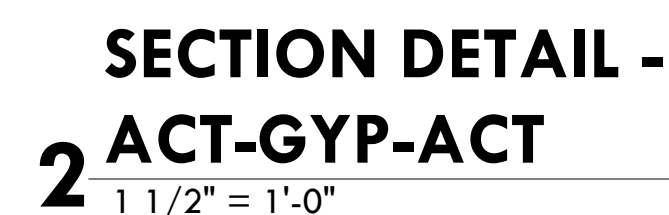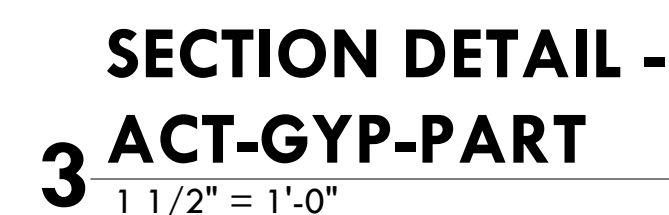

### 1 REFLECTED CEILING PLAN AREA A


- ### REFLECTED CEILING PLAN LEGEND

- ## KEY PLAN

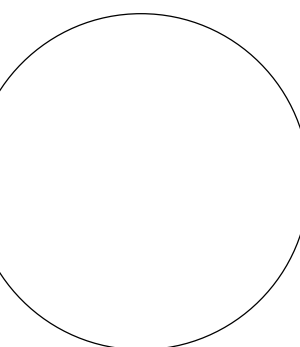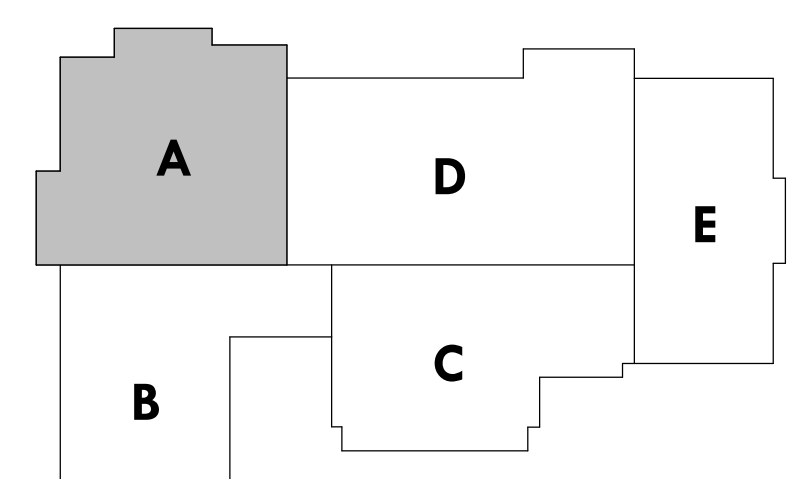

COPYRIGHT © 2024  
BROWN REYNOLDS WATFORD ARCHITECTS, INC.

DATE	SEPTEMBER 9, 2024
DRAWN BY	HN, AH, LB
CHECKED BY	JSC
PERM PROJECT NUMBER	223117.00

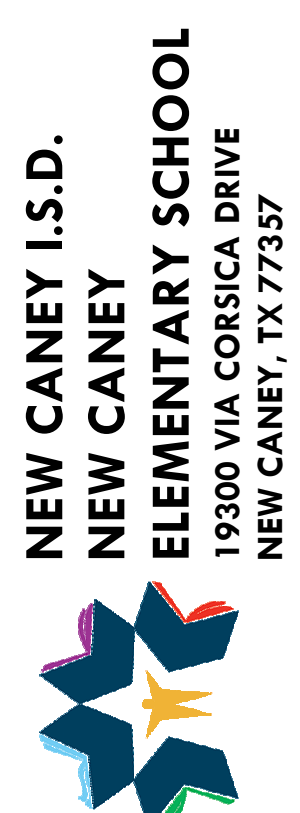


NO.	REVISION	DATE
2	ADDENDUM NO.2	10/2/2024
3	TBD	Date 3

### A6.1 A

REFLECTED CEILING  
PLAN AREA A



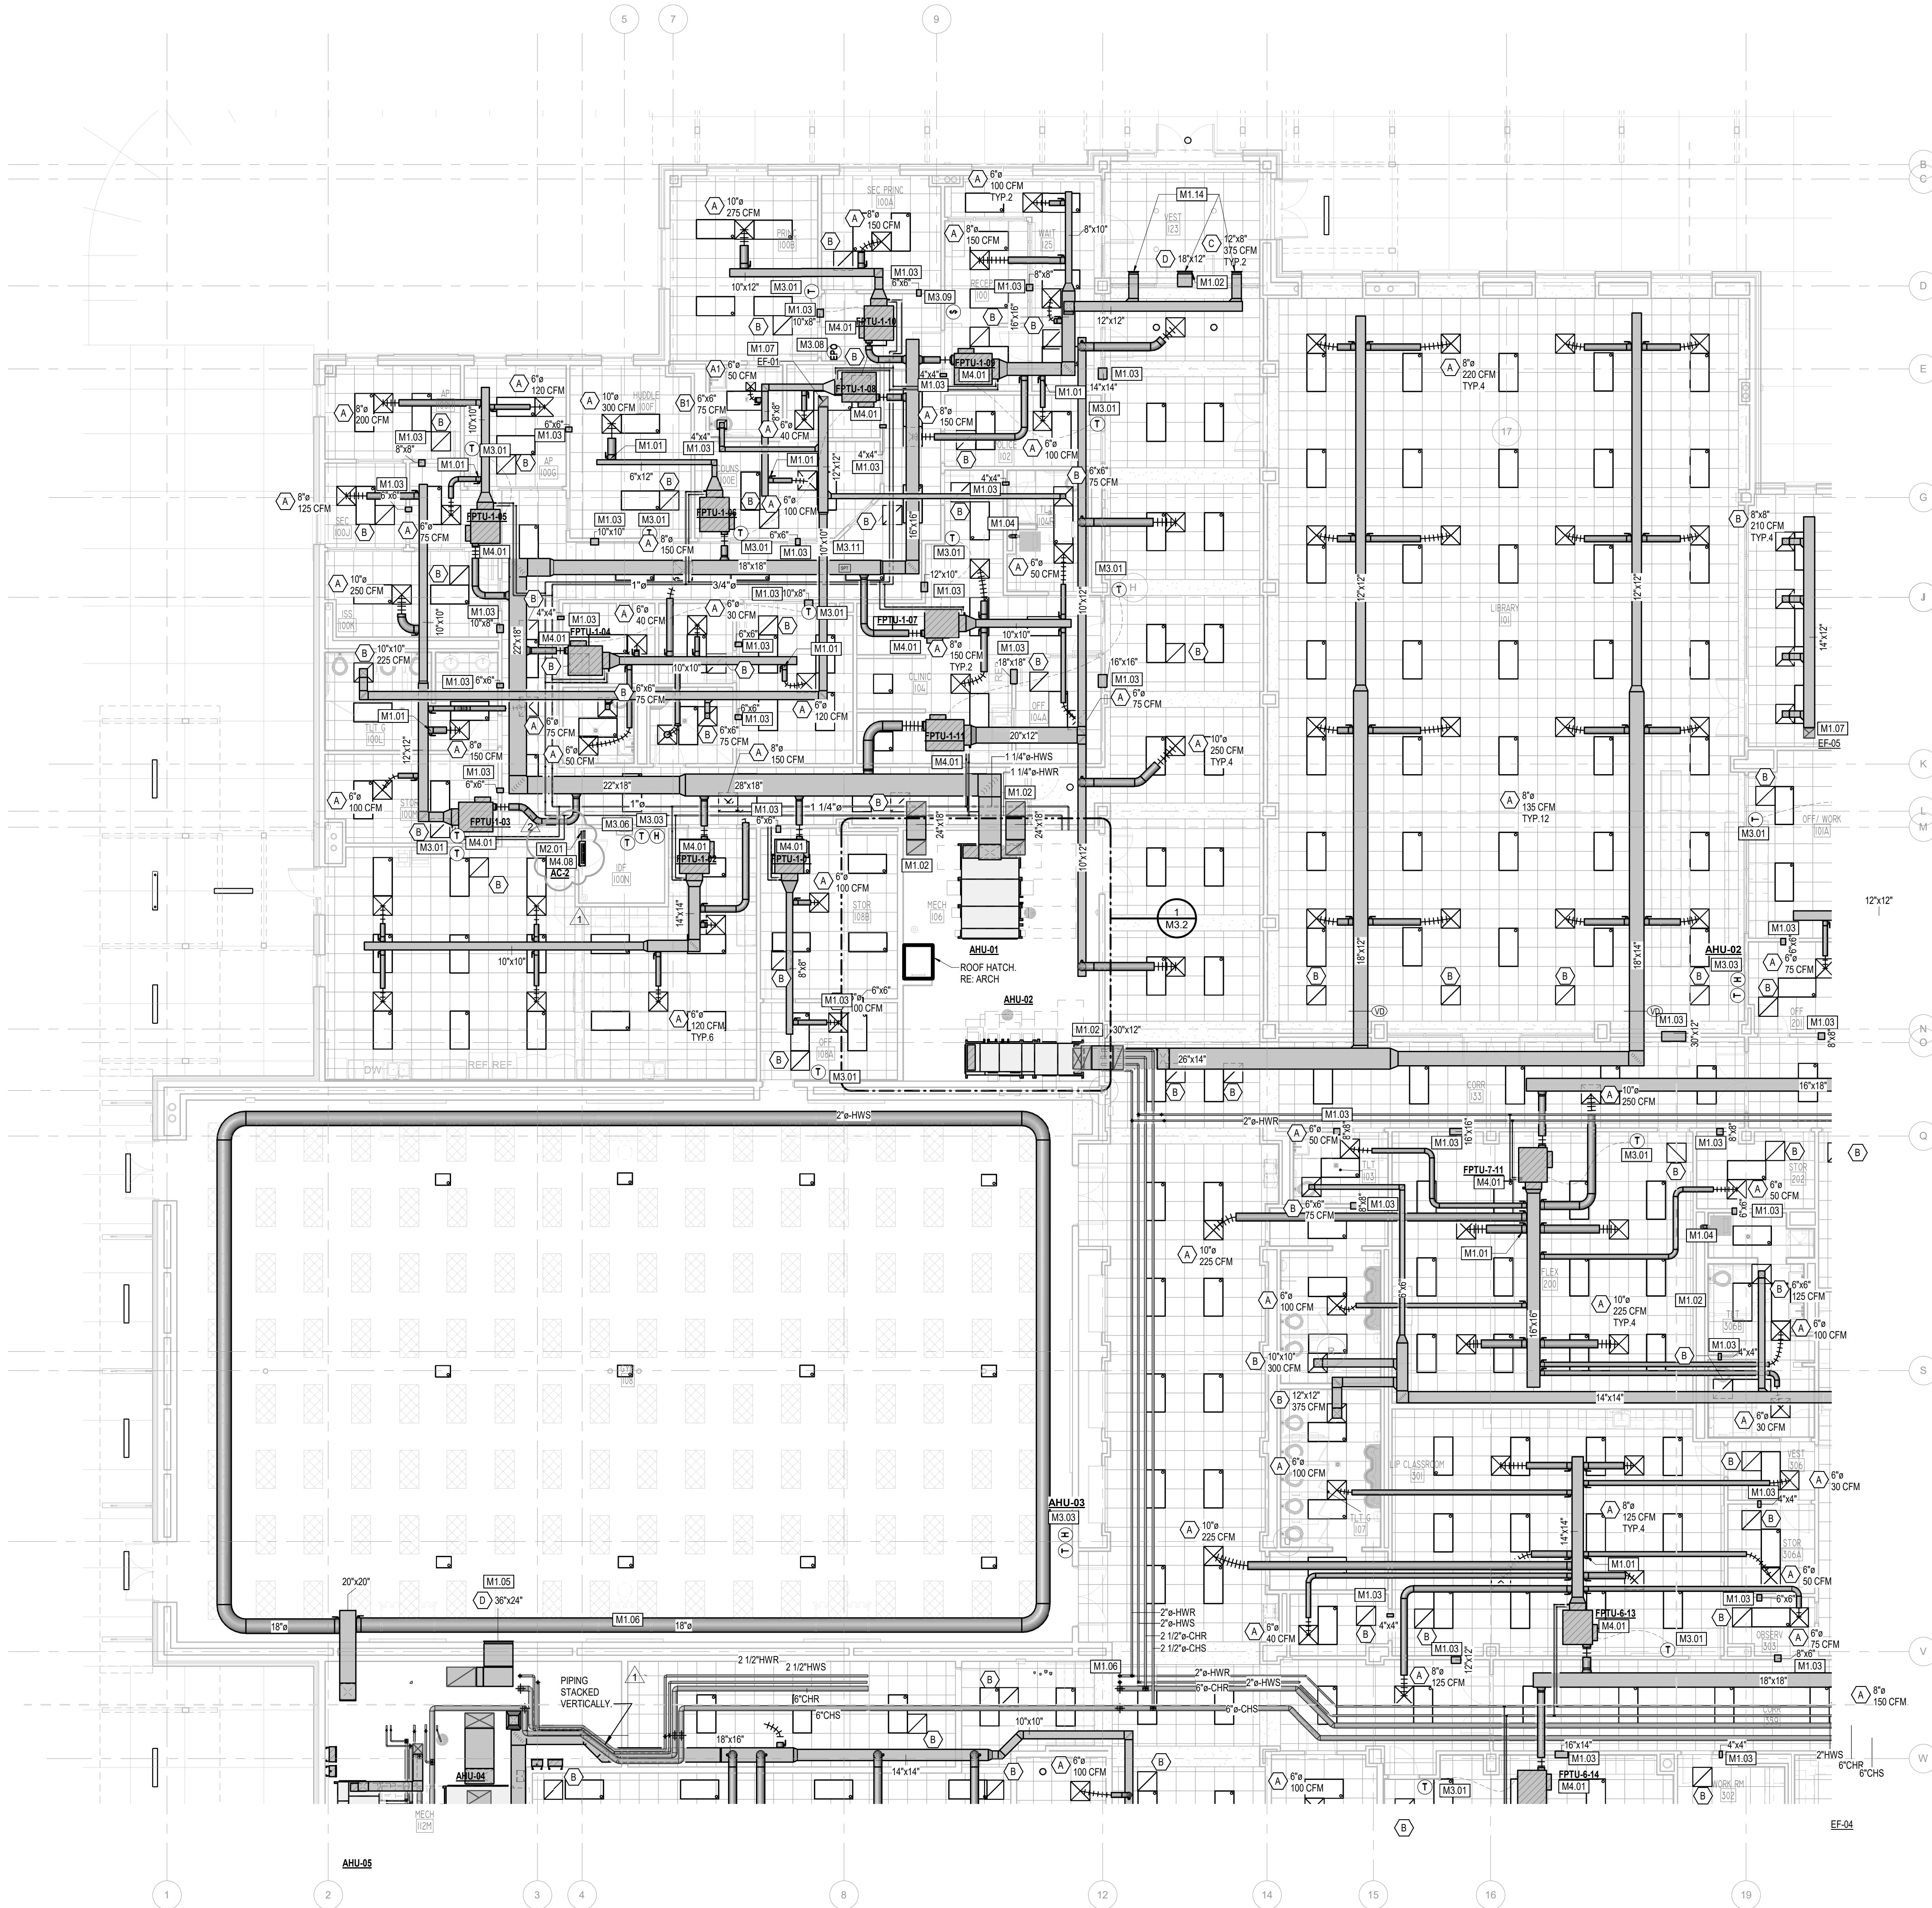


MECHANICAL PLAN AREA A  
1/8" = 1'-0"

MECHANICAL KEYED  
NOTES

- M1.01 PROVIDE SPIN-IN FITTING WITH LOCKING QUADRANT BUTTERFLY DAMPER FOR ALL ROUND DUCT CONNECTIONS TO RECTANGULAR DUCT. TYPICAL. RE: SM6.1.
- M1.02 PROVIDE RETURN AIR TRANSFER BOOT. SIZE AS INDICATED. RE: DETAIL 7.8M6.1.
- M1.03 PROVIDE WALL OPENING WITH MINIMUM FREE AREA AS INDICATED. OPENINGS LARGER THAN THE STUD SPACING SHALL BE FRAMED OUT. COORDINATE WITH ARCHITECT FOR LOCATIONS.
- M1.04 ROUTE DRYER EXHAUST DUCT UP THROUGH ROOF AND TERMINATE WITH GOOSENECK. SIZE DUCT ACCORDING TO DRYER MANUFACTURER INSTALLATION INSTRUCTIONS. REFER TO M2.2 FOR DRYER VENT CONTINUATION. RE: 15M6.1.
- M1.05 PROVIDE RETURN AIR GRILLE WITH BOOT AT APPROXIMATE LOCATION SHOWN. SIZE AS INDICATED. MOUNT GRILLE HIGH ON WALL TIGHT TO STRUCTURE. COORDINATE EXACT ELEVATION WITH ARCHITECT PRIOR TO INSTALLATION. RE: DETAIL 5M6.1.
- M1.06 PROVIDE DUCTSOX SEDONA XM FABRIC DUCT AS SHOWN. PROVIDE SLOTS IN DUCT PER MANUFACTURER'S RECOMMENDATIONS. MOUNT DUCT HIGH TIGHT TO STRUCTURE. ENSURE BOTTOM OF DUCT MAINTAINS 2' CLEAR HEIGHT WITHIN GYMNASIUM. COORDINATE EXACT ELEVATION WITH ARCHITECT PRIOR TO INSTALLATION.
- M1.07 ROUTE DUCT UP TO EXHAUST FAN ON ROOF. SIZE AS INDICATED. PROVIDE TRANSITION AS REQUIRED FOR DUCT CONNECTION. PROVIDE MOTORIZED DAMPER WITHIN DUCTWORK INTERLOCKED WITH ASSOCIATED FAN.
- M1.14 PROVIDE SIDE WALL GRILLES TO BE AT APPROXIMATE LOCATION SHOWN. GRILLES TO BE AT AN ELEVATION OF 16'-3" A.F.F. COORDINATE LOCATION WITH ARCHITECT AND OTHER TRADES PRIOR TO INSTALL. COORDINATE AIR DEVICE LOCATIONS WITH ACOUSTIC PANELS PRIOR TO INSTALL.
- M2.01 ROUTE 3/4" CONDENSATE DRAIN LINE FROM FAN COIL UNIT TO FLOOR DRAIN AS SHOWN. COORDINATE EXACT DRAIN LOCATION WITH PLUMBING. RE: DETAIL 3.M6.2.
- M3.01 PROVIDE THERMOSTAT AT APPROXIMATE LOCATION SHOWN. THERMOSTAT SHALL BE INSTALLED AT SAME ELEVATION AS LIGHT SWITCHES. COORDINATE FINAL LOCATION WITH ARCHITECT AND OTHER TRADES TO AVOID CONFLICTS.
- M3.03 PROVIDE COMBINATION TEMPERATURE/HUMIDITY SENSOR AT APPROXIMATE LOCATION SHOWN. SENSOR SHALL BE INSTALLED AT SAME ELEVATION AS LIGHT SWITCHES. COORDINATE FINAL LOCATION WITH ARCHITECT AND OTHER TRADES TO AVOID CONFLICTS.
- M3.06 PROVIDE WIRED WALL MOUNTED CONTROLLER FOR DUCTLESS AIR CONDITIONING UNIT. CONTROLLER SHALL BE PROVIDED BY DUCTLESS AIR CONDITIONING UNIT MANUFACTURER. INSTALL AT SAME ELEVATION AS LIGHT SWITCHES. COORDINATE FINAL LOCATION WITH ARCHITECT AND OTHER TRADES TO AVOID CONFLICTS.
- M3.08 LOCATE HVAC VENTILATION EMERGENCY SHUTDOWN SWITCH AT APPROXIMATE LOCATION SHOWN. INSTALL AT SAME ELEVATION AS LIGHT SENSORS.
- M3.09 LOCATE ADMIN UNIT AFTER HOUR TIMER AT APPROXIMATE LOCATION SHOWN. INSTALL AT SAME ELEVATION AS LIGHT SWITCHES.
- M3.11 APPROXIMATE LOCATION OF VAV AIR HANDLING UNIT STATIC PRESSURE SENSOR. LOCATE APPROXIMATELY 2/3 THE LONGEST RUN OF THE ASSOCIATED AHU.
- M4.01 PROVIDE FAN POWERED TERMINAL UNIT AT APPROXIMATE LOCATION SHOWN. SUPPORT UNIT FROM STRUCTURE. PROVIDE ALL CLEARANCES AS REQUIRED BY EQUIPMENT MANUFACTURER. COORDINATE WITH ADJACENT PIPING, WALLS, CONDUIT, STRUCTURAL MEMBERS, ETC. RE: DETAIL 4M6.1.
- M4.08 PROVIDE WALL MOUNTED DUCTLESS FAN COIL UNIT AT APPROXIMATE LOCATION SHOWN. INSTALL UNIT AS HIGH AS POSSIBLE ON WALL.

KEY PLAN

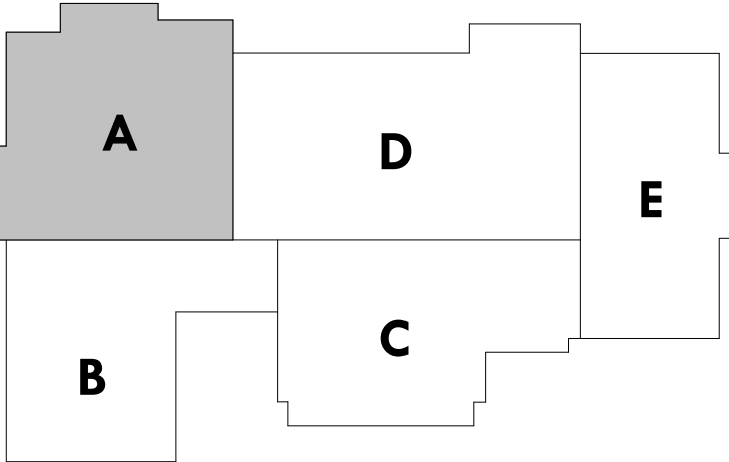

**BROWN REYNOLDS WATFORD**  
ARCHITECTS  
4501 MAGNOLIA COVE DRIVE  
SUITE 250  
281.361.3800  
WWW.BRWARCH.COM




**DBR**  
713.314.8888  
https://www.dbrinc.com  
TYPE: MECHANICAL  
DBR Project # 220393.000  

COPYRIGHT © 2024  
BROWN REYNOLDS WATFORD ARCHITECTS, INC.  
DATE: SEPTEMBER 9, 2024  
DRAWN BY: DBR  
CHECKED BY: DBR  
BRW PROJECT NUMBER: 223117.00


**NEW CANEY I.S.D.**  
**NEW CANEY**  
**ELEMENTARY SCHOOL**  
19300 VIA CORSICA DRIVE  
NEW CANEY, TX 77337

NO.	REVISION	DATE
1	Addendum 1	09.23.2024
2	Addendum 2	10.02.2024

**M2.1A**  
MECHANICAL PLAN  
AREA A

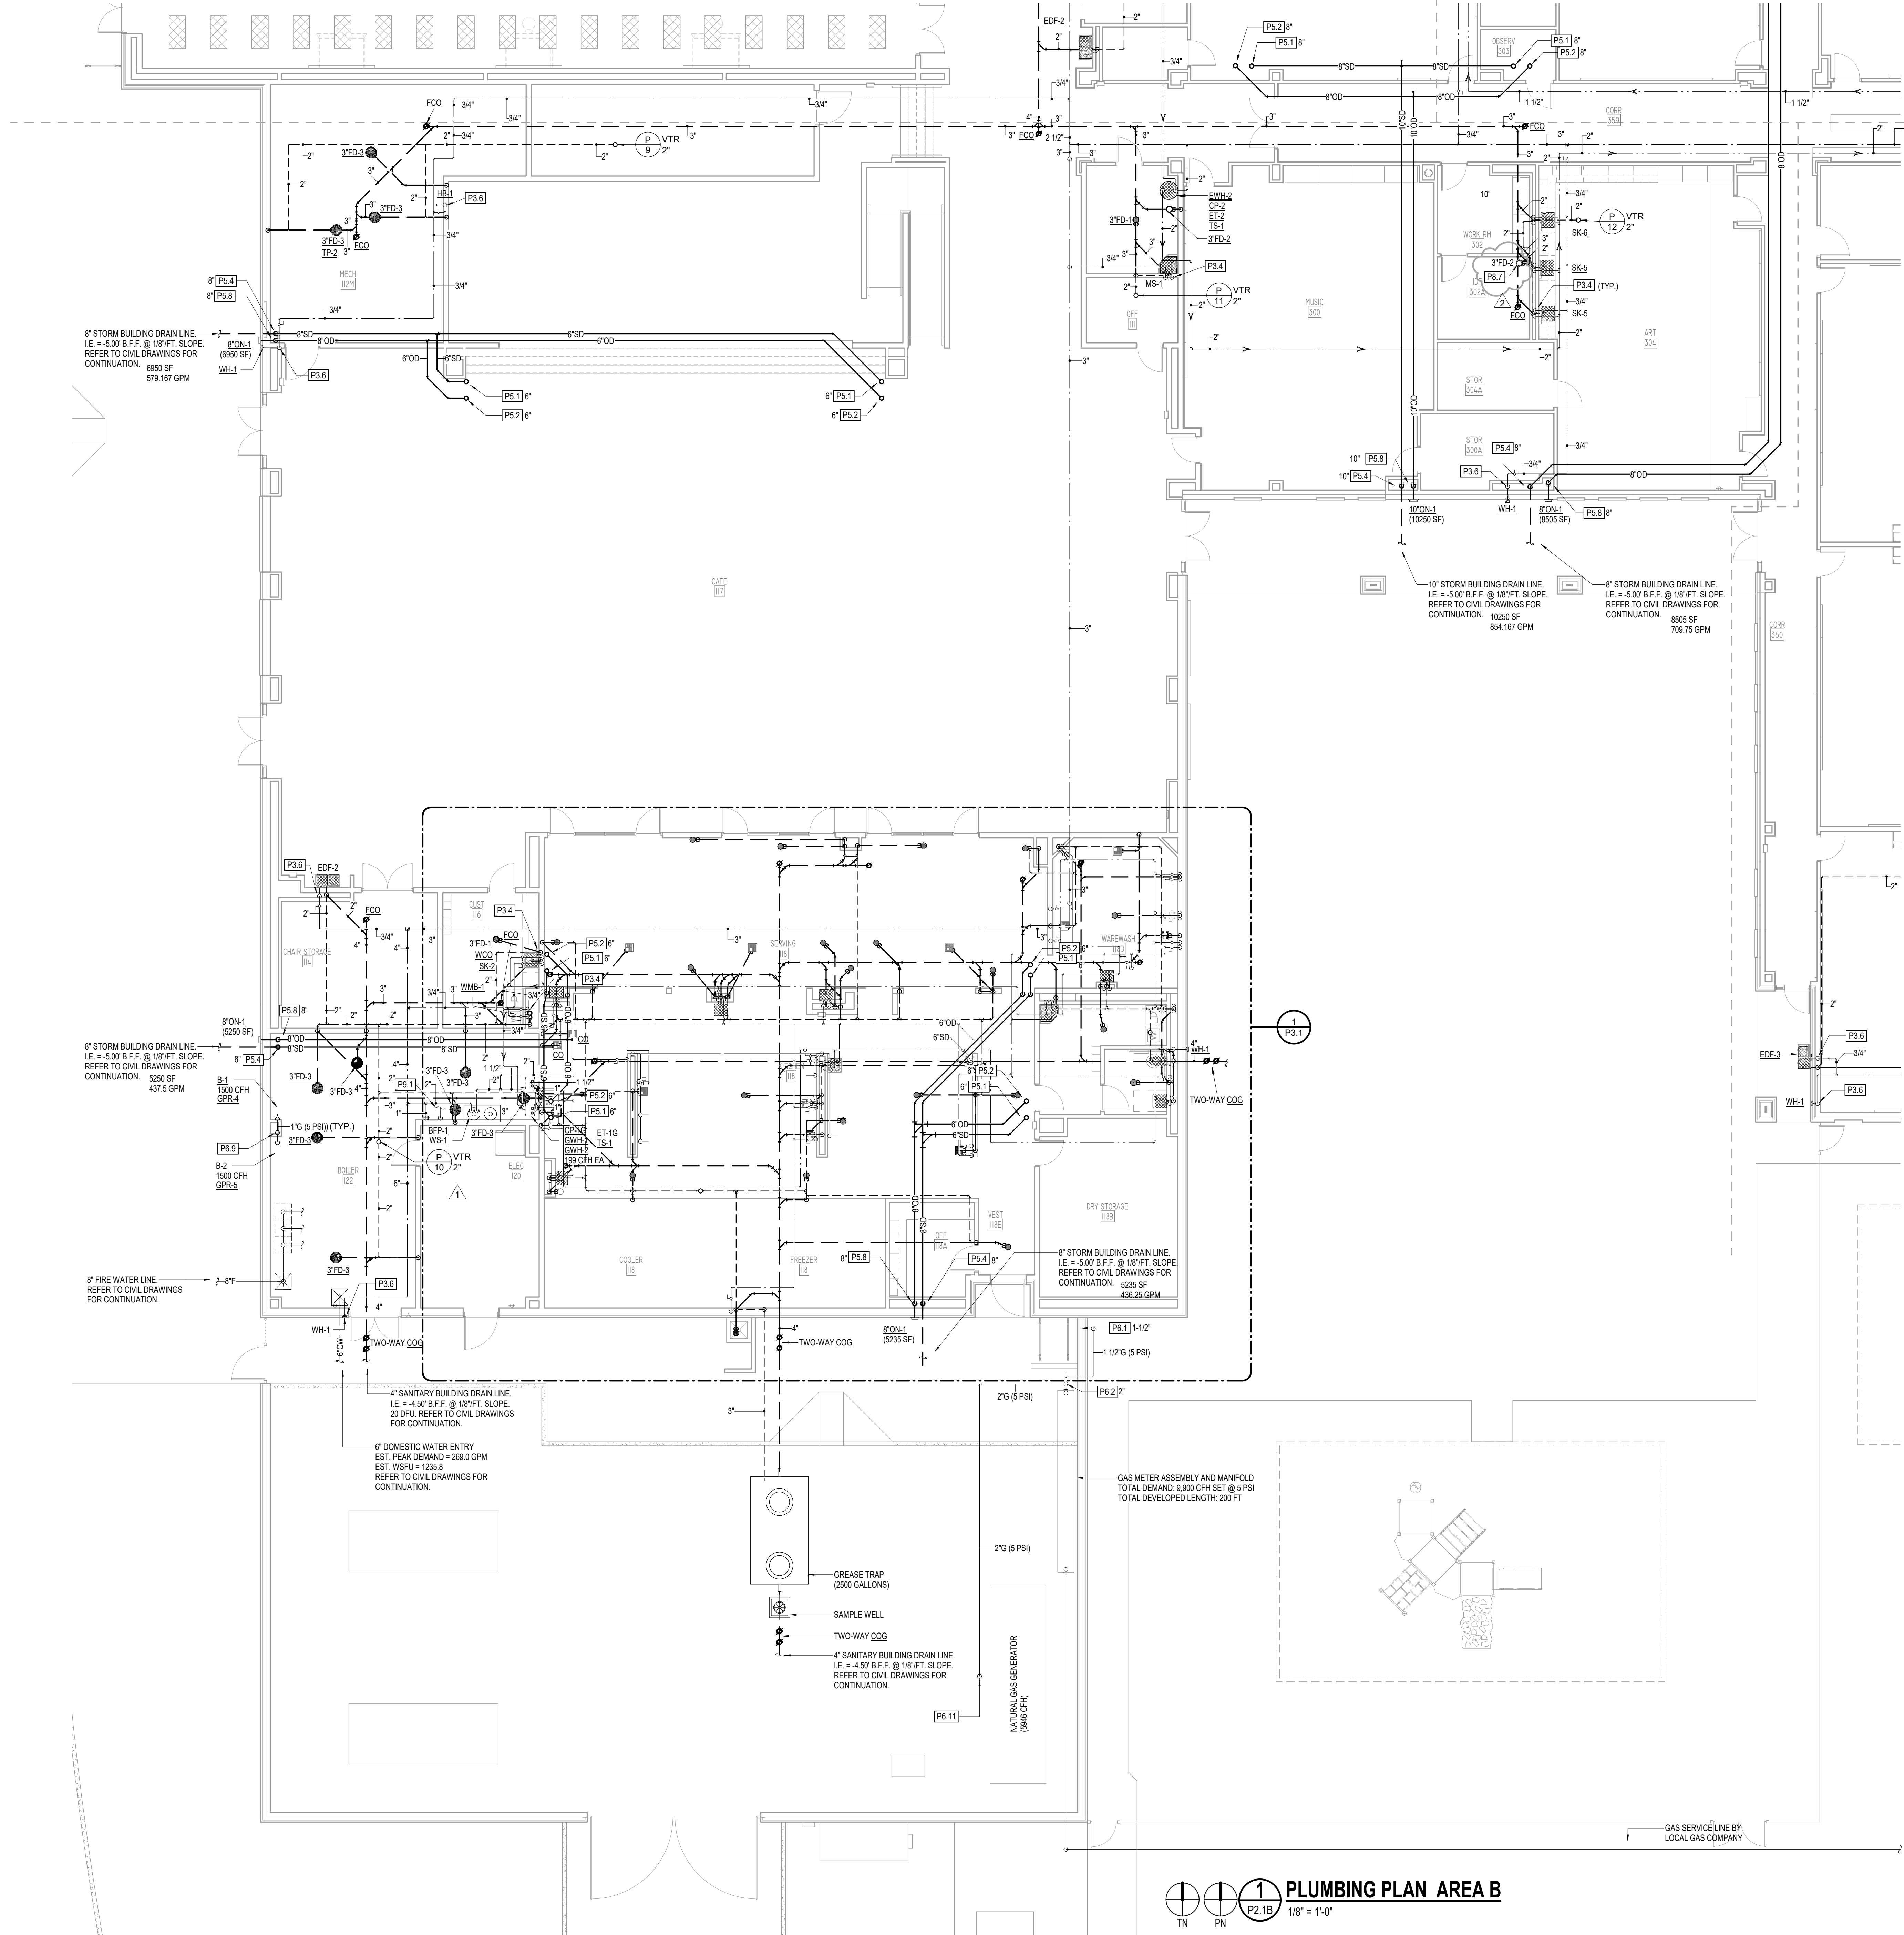

- PLUMBING KEYED NOTES**
- P3.4 DROP AND EXTEND 3/4" HOT AND COLD WATER TO SERVE FIXTURE(S).
  - P3.6 DROP AND EXTEND 3/4" COLD WATER TO SERVE FIXTURE(S).
  - P5.1 STORM DOWN FROM ROOF DRAIN ABOVE. SIZE AS NOTED.
  - P5.2 STORM DOWN FROM OVERFLOW DRAIN ABOVE. SIZE AS NOTED.
  - P5.4 STORM DOWN TO BELOW GRADE. SIZE AS NOTED.
  - P5.8 DROP TO DOWNSPOUT OVERFLOW NOZZLE. SIZE AS NOTED.
  - P6.1 GAS (5PSI) UP FROM METER MANIFOLD TO ROOF TOP. SIZE AS NOTED.
  - P6.2 GAS (5PSI) DOWN FROM METER MANIFOLD TO BELOW GRADE TO GENERATOR. SIZE AS NOTED.
  - P6.9 1-1/4" GAS (5 PSI) DOWN FROM HOODED ROOF PENETRATION TO GAS BOILERS.
  - P6.11 2" GAS (5PSI) UP FROM BELOW BOILER TO GENERATOR.
  - P8.7 PROVIDE FUNNEL FLOOR DRAIN TIGHT TO WALL FOR INDIRECT DRAIN LINE.
  - P8.7 MAKE-UP WATER LINE COMPLETES WITH SHUT-OFF AND BACKFLOW DEVICE. RE. MECHANICAL DRAWINGS FOR CONTINUATION.

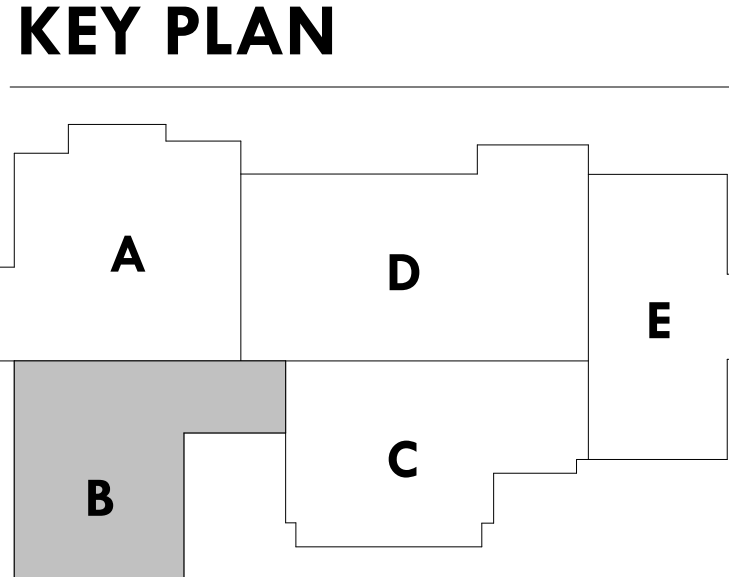

**PLUMBING PLAN AREA B**  
1/8" = 1'-0"

**BROWN REYNOLDS WATFORD ARCHITECTS**  
4501 MAGNOLIA COVE DRIVE  
SUITE 200  
DALLAS, TEXAS 77345  
281-341-3800  
WWW.BRWARCH.COM



**DBR**  
713.314.8888  
https://www.dbrinc.com  
TYPED: DBR Project # 220393.000  
BY: BARRWISLEJL/TJN / AD

COPYRIGHT © 2024  
BROWN REYNOLDS WATFORD ARCHITECTS, INC.  
DATE: SEPTEMBER 9, 2024  
DRAWN BY: DBR  
CHECKED BY: DBR  
BRW PROJECT NUMBER: 223117.00

**NEW CANEY I.S.D.**  
**NEW CANEY ELEMENTARY SCHOOL**  
19300 VIA CORSICA DRIVE  
NEW CANEY, TX 77337

NO.	REVISION	DATE
1	Addendum 1	09.23.2024
2	Addendum 2	10.02.2024



FIRE ALARM:

- A. ALL CEILING MOUNTED DEVICES SHALL BE CENTERED IN THE CEILING TILE.
- B. ALL FIRE ALARM VISUAL AND AUDIO/VISUAL DEVICES SHALL BE CONFIGURED TO PROVIDE CANDELA RATINGS IN ACCORDANCE WITH ADA & NFPA COVERAGES.
- C. ALL VISUAL FIRE ALARM DEVICES SHALL BE 75 CD UNLESS NOTED OTHERWISE.
- D. SPEAKERS SHALL BE AUDIBLE AND INTELLIGIBLE. LOCATIONS OF SPEAKER SHOWN ARE FOR REFERENCE ONLY. EXACT QUANTITY AND LOCATIONS OF SPEAKERS/SPEAKER STROBES SHALL BE AS REQUIRED BY FIRE ALARM SHOP DRAWINGS AND FULLY DESIGNED AND SEALED BY A LICENSED FIRE ALARM CONTRACTOR. CONTRACTOR SHALL DESIGN PER PROJECT SPECIFICATIONS AND MEET LOCAL AUTHORITY HAVING JURISDICTION REQUIREMENTS.
- E. ELECTRICAL CONTRACTOR SHALL INCLUDE IN THEIR BID SCOPE FOR 120V DEDICATED 15A CIRCUIT WITH (3) #12 CONDUCTOR IN 3/4" CONDUIT TO EACH SPEAKER AMPLIFIER REQUIRED BY FIRE ALARM SHOP DRAWINGS. EXACT QUANTITY AND LOCATION MAY NOT BE SHOWN ON ELECTRICAL PLANS.
- F. ELECTRICAL CONTRACTOR SHALL PROVIDE CONDUIT PATHWAYS FOR FIRE ALARM PLENUM CONDUCTORS WHERE REQUIRED TO TRANSIT HARD CEILING AREAS. CONDUIT RACEWAYS SHALL ALLOW ACCESS TO CONDUIT AT EACH END IN ACCESSIBLE LOCATIONS ABOVE CEILINGS.
- G. CONTRACTOR SHALL PROVIDE ADDITIONAL DEVICES AS REQUIRED BY FIRE ALARM SHOP DRAWINGS TO MEET CODE-MINIMUM DEVICE COVERAGE.
- H. CONTRACTOR SHALL PERFORM AUDIBILITY TESTS AS REQUIRED BY LOCAL AHJ AND SUBMIT AUDIBILITY TESTS TO BUILDING OWNER AND ENGINEER OF RECORD FOR REVIEW.
- I. ALL MECHANICAL AIR HANDLERS/FOCUS/PTTUS WITH 2000CFM OR MORE SHALL HAVE A DUCT SMOKE DETECTOR IN THE SUPPLY DUCT AND A FIRE ALARM SHUT DOWN RELAY TIED TO THE MAIN FIRE ALARM PANEL. REFER TO THE MECHANICAL PLANS/ SCHEDULES FOR CFM VALUES AND FOR EXACT LOCATIONS.
- J. CONTRACTOR SHALL ADD TEST SWITCH AT SWITCH HEIGHT ON WALL FOR EACH DUCT SMOKE DETECTOR. TYPICAL OF ALL DUCT SMOKE DETECTORS IN MECHANICAL ROOMS.

FOOD SERVICE:

- A. ELECTRICAL PLANS ARE SCHEMATIC AND INDICATE GENERAL LOCATION OF ALL DEVICES. ALL ROUGH-INS AND SPECIAL INSTALLATION REQUIREMENTS FOR ANY DEVICE, FIXTURE, OR APPLIANCE IN THE KITCHEN SHALL BE BASED ON FOOD SERVICE PLANS.
  - B. ALL CONNECTIONS SHOWN ON THESE MAY INCLUDE SPECIAL MOUNTING INSTRUCTIONS THAT ARE INDICATED ON FOOD SERVICE PLANS. REFERENCE FOOD SERVICE FOR ALL DETAILS.
  - C. ANY DISCONNECT INDICATED WITHIN THE LIMITS OF THE KITCHEN WALLS SHALL BE STAINLESS STEEL.
  - D. ALL RECEPTACLES SHALL BE GFCI PER 2020 NATIONAL ELECTRIC CODE. PROVIDE WITH WEATHERPROOF COVERS AS DESCRIBED ON FOOD SERVICE PLANS. GFCI PROTECTION SHALL BE DONE BY MEANS OF GFCI BREAKERS.
  - E. EXACT ELECTRICAL CONNECTION REQUIREMENTS FOR COOLER/FREEZER SYSTEM AND ACCESSORIES ARE INDICATED ON FOOD SERVICE PLANS. ELECTRICAL PLANS SHOW SCHEMATIC CIRCUIT ONLY.
  - F. VERIFY QUANTITY OF CONDUCTORS REQUIRED BETWEEN COOLER/FREEZER AND REFRIGERATION RACK WITH FOOD SERVICE EQUIPMENT SUBMITTAL.
  - G. ELECTRICAL CONTRACTOR SHALL PROVIDE CIRCUIT TO KITCHEN HOOD LIGHTS, AND SHALL INCLUDE CONNECTION TO THE LIGHT SWITCH AS PART OF THEIR SCOPE.
  - H. INTERCONNECT FIRE PROTECTION SYSTEM TO PANEL BOX SHUNT TRIP(S) AND BUILDING ALARM - BY DIVISION 26. ALL EQUIPMENT/DEVICES LOCATED BELOW THE KITCHEN EXHAUST HOOD SHALL BE PROVIDED WITH SHUNT TRIP BREAKERS.
  - I. EMPTY CONDUIT RUN FROM CASHIER STATION TO MANAGERS OFFICE FOR POS SYSTEM BY DIVISION 26. LOCATION OF MANAGERS OFFICE SHALL BE VERIFIED IN FIELD WITH FOOD SERVICE INSTALLERS PRIOR TO INSTALLATION OF CONDUIT AND ASSOCIATED ROUGH-INS.
- SITE PLAN:
- A. ALL EQUIPMENT LOCATIONS ARE APPROXIMATE. COORDINATE WITH ARCHITECT/CIVIL PRIOR TO INSTALLATION FOR EXACT EQUIPMENT LOCATION.
  - B. THE CONTRACTOR SHALL EXERCISE CAUTION WHEN EXCAVATING TO AVOID DAMAGE TO EXISTING POWER, COMMUNICATIONS, SEWER/SANITARY, WATER AND/OR GAS LINES, THAT MAY BE BURIED IN AREA OF NEW CONSTRUCTION OR WHEN DIGGING NEW TRENCH FOR NEW FEEDERS.
  - C. COORDINATE ALL WORK WITH ARCHITECTURAL AND CIVIL PLANS BEFORE INSTALLATION OF ALL ELECTRICAL EQUIPMENT GEAR.
  - D. THE ELECTRICAL CONTRACTOR SHALL PROVIDE AND INSTALL PULL STRINGS TO ALL UNDERGROUND EMPTY CONDUITS.
  - E. THE ELECTRICAL CONTRACTOR SHALL COORDINATE WITH DATA/COMM TECHNOLOGY INSTALLER FOR EXACT NUMBER OF EMPTY CONDUITS AND SIZES OF ALL THE UNDERGROUND DATA/COMM CONDUITS.
  - F. REFERENCE SPECIFICATIONS FOR MATERIALS AND METHODS.
  - G. WHERE CONDUIT PATH CROSSES UNDER EXISTING PAVEMENT, CONTRACTOR SHALL BORE UNDER PAVEMENT.
  - H. CONTRACTOR SHALL PROVIDE FLUSH WITH GRADE PULL-BOXES AS REQUIRED EVERY 200' MAXIMUM FOR DIVISION 26 AND 150' FOR DIVISION 27/28. SERVICE LATERAL PULL-BOXES SHALL BE COORDINATED WITH THE POWER COMPANY AND THEIR SPECIFICATIONS.

NOTE TO ELECTRICAL CONTRACTOR:  
ELECTRICAL CONTRACTOR SHALL PROVIDE CONDUIT, OUTLET BOXES, JUNCTION BOXES FOR ALL TECHNOLOGY, LOW VOLTAGE, ACCESS CONTROL SECURITY, SURVEILLANCE, AND OTHER DIVISION 27/28 SCOPE. REFER TO DIVISION 27/28 DRAWINGS AND SPECIFICATIONS FOR ALL WORK REQUIRED. OMISSION OF THIS SCOPE FOR DIV 26 SCOPE OF WORK IS PROHIBITED.

LIGHTING:

- A. CONTROL DEVICES SHALL BE PROVIDED IN ACCORDANCE WITH PERFORMANCE DESCRIPTION INDICATED IN THE LIGHTING CONTROL DEVICE SCHEDULE FOUND ON SCHEDULE SHEETS.
- B. MULTIPLE SWITCHES SHOWN TOGETHER SHALL BE GANGED UNDER A COMMON COVER PLATE.
- C. PROVIDE LABELING OF ALL CONTROL DEVICES, SWITCH PACKS, LIGHT FIXTURES, JUNCTION BOXES, ETC IN ACCORDANCE WITH ELECTRICAL SPECIFICATIONS.
- D. LIGHTING FIXTURE LOCATIONS SHOWN TAKE PRECEDENT IN CEILING LOCATION TO ALL OTHER TRADES. THE ELECTRICAL CONTRACTOR IS RESPONSIBLE FOR ENSURING OTHER TRADES DO NOT IMPACT SPACING AND/OR OVERLAYMENT OF OTHER DEVICES WHERE LIGHT FIXTURES MUST BE INSTALLED.
- E. REFERENCE SYMBOLS LEGEND FOR LIGHT SWITCH DEVICE NOMENCLATURE AND SWITCH-LEG ASSOCIATIONS.
- F. ALL 2X2, 2X4 FIXTURES INSTALLED IN SUSPENDED GRID CEILING SHALL BE PROVIDED WITH (4) SECONDARY SUPPORT WIRES ANCHORED DIRECTLY TO STRUCTURE.
- G. ALL LIGHT FIXTURES LABELED AS "NL" SHALL BE "ALWAYS ON" FOR NIGHT LIGHT BYPASS LOCAL LIGHT SWITCH TYPICAL.
- H. "BB" DENOTES BATTERY BACKUP LIGHT FIXTURE.

CORRIDOR LIGHTING SEQUENCE OF OPERATIONS NOTES

- A. SCHEDULE CONTROLS FOR CORRIDOR/COLLABORATION SPACE LIGHTING. LIGHTS WILL BE SCHEDULED TO BE ON DURING REGULAR OPERATING HOURS(OWNER TO PROVIDE SCHEDULE).
- B. CEILING AND WALL MOUNTED OCCUPANCY SENSORS ARE PROVIDED THROUGHOUT FOR AFTER HOURS PURPOSES. THE OCCUPANCY SENSORS WILL TURN ON THE CORRIDOR LIGHTS ON WHEN THE TIMING IS OUTSIDE OF THE SCHEDULED HOURS. THE LIGHTS IN THESE SPACES WILL THEN STAY ON FOR UP TO 30 MINUTES(DURATION OF TIME CAN BE PROGRAMMED TO 30 MINUTES OR LESS). OCCUPANCY SENSORS WILL NOT CONTROL LIGHTS DURING REGULAR OPERATING HOURS.
- C. MASTER OVERRIDE SWITCH, "ON" CONTROL, LOCATED IN THE TEACHER'S LOUNGE, SHALL OVERRIDE ALL THE CORRIDOR LIGHTING ON ONLY, TO PREVENT TIMING OUT BY THE OCCUPANCY SENSORS FOR AFTER HOURS EVENTS/HOLIDAY EVENTS,ETC. (SEE PLANS FOR LOCATION)

EMER. LIGHTING:

- A. ROUTE AN UNSWITCHED HOT LEG TO ALL LIGHT FIXTURES DESIGNATED AS EMERGENCY FIXTURES. HOT LEG SHALL ORIGINATE FROM CIRCUIT SERVING NORMAL LIGHTING FIXTURES IN THAT SPACE. UNSWITCHED HOT LEG SHALL CONNECT TO THE NORMAL POWER SENSING LUG ON THE UL524 GENERATOR TRANSFER DEVICE (GTD). REFER TO GTD WIRING DIAGRAM ON SHEET E601 FOR ADDITIONAL INFORMATION.
- B. ALL EXTERIOR EMERGENCY LIGHTING SHALL BE PROVIDED WITH AN EMERGENCY LIGHTING CIRCUIT AND NORMAL LIGHTING CIRCUIT AND ROUTED THROUGH GTD 20A GENERATOR TRANSFER DEVICE -UL 1008 AND CONTROLS LIGHTING RELAY. LOCATE GTD ADJACENT TO EMERGENCY PANEL SERVING CIRCUIT. REFER TO GTD WIRING DIAGRAM ON SHEET E601 FOR ADDITIONAL INFORMATION.
- C. ROUTE AN UNSWICHED HOT LEG TO ALL LIGHT FIXTURES DESIGNATED AS EMERGENCY FIXTURES. HOT LEG SHALL ORIGINATE FROM CIRCUIT SERVING NORMAL LIGHTING FIXTURES IN THAT SPACE. UNSWITCHED HOT LEG SHALL CONNECT TO THE NORMAL POWER SENSING LUG ON THE EMERGENCY BATTERY PACK.
- D. ALL EMERGENCY LIGHT FIXTURE GENERATOR TRANSFER DEVICES SHALL BE CONNECTED TO THE EMERGENCY EGRESS LIGHTING CIRCUIT INDICATED ON DRAWINGS. ALL EMERGENCY WIRING SHALL BE ROUTED IN A SEPARATE CONDUIT.
- E. PROVIDE UNSWITCHED CIRCUIT TO ALL EXIT SIGNS ORIGINATING FROM CIRCUIT NEAREST EMERGENCY CIRCUIT.
- F. ALL SINGLE FACED EXIT SIGNS SHALL BE "X1" AND ALL DOUBLE FACED EXIT SIGNS SHALL BE "X2" UNLESS NOTED OTHERWISE. REFERENCE PLANS FOR CHEVRON CONFIGURATION COORDINATE INSTALLATION REQUIREMENT WITH ARCHITECTURAL PLANS.
- G. EMERGENCY LIGHTING SHALL BE CONTROLLED WITH THE NORMAL LIGHTING WITHIN THE SPACE UNLESS NOTED OTHERWISE.

LIGHTING CONTROLS COMMISSIONING:

- THE CONTRACTOR SHALL INCLUDE, AS PART OF THEIR SCOPE, THE REQUIREMENTS TO COMMISSION THE LIGHTING CONTROL SYSTEM, AS REQUIRED BELOW. THE LIGHTING CONTROL SYSTEM MAY BE STAND-ALONE, RELAY, CONTACTOR OPERATED, TIMER, PHOTOCELL, OR ANY COMBINATION OF THESE LISTED. FOR EACH OF THE FOLLOWING TASKS, RECORD THE DATE PERFORMED, PERSON(S) COMPLETING THE VERIFICATION, INITIAL SETTING/CONDITION, ACTIONS PERFORMED, AND FINAL SETTING CONDITION. SUBMIT DOCUMENTATION TO THE CITY HAVING JURISDICTION AT OR BEFORE SUBSTANTION COMPLETION. SUBMITTING AFTER SUBSTANTION COMPLETION WILL DELAY THE ISSUANCE OF A CERTIFICATE OF OCCUPANCY. REFER TO COMMISSIONING SPECIFICATIONS FOR ADDITIONAL INFORMATION AND COORDINATE ALL COMMISSIONING REQUIREMENTS WITH THE COMMISSIONING AGENT.
- A. ENSURE ALL LIGHTING FIXTURES HAVE LAMPS THAT ARE FUNCTIONAL.
  - B. TEST ALL EXIT SIGNS, EMERGENCY LIGHTING FIXTURES, AND EMERGENCY TRANSFER DEVICES OR CENTRAL BATTERY SYSTEM.
  - C. VERIFY THAT ALL OCCUPANCY SENSORS HAVE BEEN INSTALLED AND ARE OPERATIONS.
  - D. TEST ALL WALL-SWITCH OCCUPANCY SENSORS.
  - E. TEST ALL DIGITALLOW VOLTAGE SWITCHES AND THEIR PERIPHERALS, WHERE INSTALLED, SUCH AS:
    - 1. CEILING MOUNTED OCCUPANCY SENSORS
    - 2. POWER PACKS
    - 3. DAYLIGHT SENSING/HARVESTING SENSORS
  - F. VERIFY THE FOLLOWING FUNTIONALITY AND/OR INSTALLATION OF ALL CONTROL DEVICES
    - 1. SENSORS HAVE BEEN LOCATED AND AIMED TO RELEVANT LOCATIONS OF OCCUPANCY, PER MANUFACTURERS RECOMMENDATION
    - 2. VERIFY STATUS INDICATORS ON DEVICES ARE OPERATIONAL AND CORRECT
    - 3. DEVICES CONTROL LIGHTING FIXTURES AS SPECIFIED ON THE DRAWINGS
    - 4. ALL OCCUPANCY/VACANCY MODE TIME-OUTS ARE SET TO NO GREATER THAN 30 MINUTES.
    - 5. ALL CONTROL DEVICES ARE SET VACANCY MODE, OR NO MORE THAN 50% OF FIXTURES TURN ON AUTOMATICALLY UPON ENTERING A SPACE/ROOM.
    - 6. MOVEMENT IN ADJACENT SPACES OR CYCLING OF HVAC SYSTEMS DOES NOT FALSELY TRIGGER SENSORS. (VACANCY MODE PREFERRED TO PREVENT THIS) SHOULD ADDITIONAL INFORMATION REGARDING THE TESTING REQUIREMENTS BE NEEDED, REFERENCE IECC 2015 SECTION 408.3

POWER:

- A. ELECTRICAL DEVICES SHOWN ARE NOT EXACT. ALL DEVICE LOCATIONS SHALL BE VERIFIED WITH ARCHITECTURAL MILLWORK, CASEWORK, AND GENERAL ELEVATION VIEWS.
- B. HVAC AND PLUMBING EQUIPMENT LOCATIONS ARE NOT EXACT, AND THE EXACT POINT OF CONNECTION TO EQUIPMENT MAY VARY. COORDINATE EXACT ROUGH-IN REQUIREMENTS IN FIELD AND WITH FINAL SUBMITTALS FOR ALL DIV. 21/22/23 EQUIPMENT.
- C. PROVIDE LABELING OF ALL DEVICES, CONDUIT, PANELS, AND JUNCTION BOXES IN ACCORDANCE WITH ELECTRICAL SPECIFICATIONS.
- D. MINIMIZE ROOF PENETRATIONS. WHERE ABLE, ROUTE ALL CONDUIT FOR ROOF MOUNTED EQUIPMENT THROUGH ROOF CURB. CONTRACTOR WILL BE RESPONSIBLE FOR COORDINATING NECESSARY WATER PROOFING AROUND ROOF PENETRATIONS WITH ROOFING INSTALLER.
- E. ALL RECEPTACLES LOCATED IN RESTROOMS, JANITOR CLOSETS, MECHANICAL ROOMS, ELEVATOR PIT(S) OR SHAFT(S), ELEVATOR EQUIPMENT ROOMS, SERVING ELECTRIC DRINKING FOUNTAINS OR VENDING MACHINES, LOCATED WITHIN 6" OF A SINK, LOCATED ABOVE A WET COUNTERTOP OR IN A KITCHEN OR COFFEE BAR SHALL BE GFCI. FEED-THRU GFCI/GFI IS PROHIBITED. ALL GFCI/GFI DEVICES SHALL BE PROVIDED WITH INDIVIDUAL TEST/RESET FEATURES. GFCI RESET SHALL BE READILY ACCESSIBLE AND REMOTE RESET SWITCHES PROVIDED AS REQUIRED TO PREVENT MOVING LARGE EQUIPMENT TO RESET THE DEVICE.
- F. MULTI-WIRE HOME RUNS SHALL NOT BE ALLOWED EXCEPT IN CLASSROOMS. REFER TO POWER GENERAL NOTE G FOR FURTHER DETAILS. PROVIDE DEDICATED NEUTRALS FOR ALL CIRCUITS. SHARING CONDUIT IS PERMISSIBLE WHERE TOTAL CONDUCTOR AMPACITY DERATING HAS BEEN PERFORMED BY ELECTRICAL CONTRACTOR. THE NEUTRAL IS CONSIDERED CURRENT-CARRYING.
- G. MULTI-WIRE HOME RUNS SHALL BE ALLOWED ONLY IN CLASSROOMS. MULTI-WIRE HOMERUNS SHALL HAVE HANDLE TIES TO COMPLY WITH NEC.
- H. ALL RECEPTACLES SHALL BE TAMPER RESISTANT TYPE. ALL RECEPTACLES SHALL BE HEAVY DUTY WITH GROOVE/INDENT FINDER.
- I. LABEL ALL CIRCUITS AT ALL JUNCTION BOXES AND OUTLETS WITH TYPE-WRITTEN LABEL IDENTIFYING CIRCUIT ON THE FRONT OF THE DEVICE COVER PLATES AND ON COVER OF JUNCTION BOX. IF A BOX HAS MULTIPLE CIRCUITS WITHIN LABEL, ALL CIRCUITS CIRCUIT LABEL SHALL IDENTIFY THE PANEL NAME AND BREAKER NUMBER.  
  
EXAMPLE: L-1  
  
PANEL "L-1"  
CIRCUIT NUMBER: 1
- J. CONTRACTOR SHALL INDICATE CIRCUIT SERVING EACH WIRING DEVICE BY PROVIDING TYPE WRITTEN LABELING LOCATED ON THE INSIDE FACE OF EACH WIRING DEVICE COVERPLATE.
- K. ALL VFDs, MOTOR STARTERS, OR DISCONNECT SWITCHES SHALL BE SUPPLIED BY DIVISION 23 AND INSTALLED BY DIVISION 26 UNLESS NOTED OTHERWISE. ELECTRICAL CONNECTIONS SHALL BE PROVIDED BY DIVISION 26. DIVISION 26 SHALL COORDINATE WITH DIVISION 23 PRIOR TO ROUGH-IN.

BROWN REYNOLDS WATFORD ARCHITECTS

4501 MAGNOLIA COVE DRIVE  
SUITE 200  
DALLAS, TEXAS 77345  
281-301-13800  
WWW.BRWARCH.COM

+

BRW



DBR

713.314.8888 F  
https://www.dbrinc.com  
DBR Page#: #20039.000

BRW PARTWISERLIT/INTL AD

COPYRIGHT © 2024  
BROWN REYNOLDS WATFORD ARCHITECTS, INC.

DATE  
SEPTEMBER 9, 2024

DRAWN BY  
Author

CHECKED BY  
Checker

BRW PROJECT NUMBER  
223117.00

NEW CANEY I.S.D.  
NEW CANEY  
ELEMENTARY SCHOOL

19300 VIA CORSICA DRIVE  
NEW CANEY, TX 77337

NO.	REVISION	DATE
1	Addendum 1	09/23/2024
2	Addendum 2	10/02/2024

E0.2

ELECTRICAL GENERAL NOTES




GENERAL NOTE

- A REFER TO SHEET E0.2 FOR GENERAL NOTES.  
B REFER TO SHEET E0.2 FOR CORRIDOR LIGHTING SEQUENCE OF OPERATIONS NOTES.


ELECTRICAL KEYED NOTES

- E3.5 PROVIDE SINGLE POINT OF POWER AT CHILLER FOR FREEZE PROTECTION. COORDINATE EXACT POWER REQUIREMENTS WITH DIVISION 26.
- E4.16 PROVIDE 120V POWER RECEPTACLE ON COLUMN NEAR ROOF STRUCTURES FOR FANS. FANS SHALL BE GFCI. FIELD COORDINATE EXACT LOCATION, ELEVATION, AND INSTALLATION DETAILS WITH ARCHITECT AND OWNER PRIOR TO STARTING ANY WORK.
- E5.14 APPROXIMATE LOCATION OF TAMPER SWITCH. PROVIDE 120V POWER FOR TAMPER SWITCH. CONTRACTOR SHALL COORDINATE INSTALLATION REQUIREMENTS WITH CIVIL ARCHITECT/OWNER PRIOR TO ROUGH-IN. FIELD COORDINATE WITH ALL DIVISIONS.
- E5.15 PROVIDE 120V JUNCTION BOX FOR CONNECTION TO IRRIGATION CONTROLLER BOX. FIELD COORDINATE WITH LANDSCAPE CONTRACTOR, ARCHITECT AND OWNER PRIOR TO STARTING ANY WORK.
- E5.16 PROVIDE 120V JUNCTION BOX FOR CONNECTION TO MOTORIZED VALVES. FIELD COORDINATE WITH MECHANICAL CONTRACTOR, ARCHITECT AND OWNER PRIOR TO STARTING ANY WORK.
- E7.1 APPROXIMATE LOCATION OF EXISTING 3-PHASE OVERHEAD POWER LINES.
- E7.2 APPROXIMATE PROPOSED LOCATION OF NEW UTILITY COMPANY TERMINAL POWER POLE. PROVIDE A MINIMUM OF 18' DISTANCE FROM PROPERTY LINE. EXACT POLE LOCATION AND ROUTING SHALL BE DETERMINED BY ENTERGY. COORDINATE PLACEMENTS OF POLE ALONG PROPERTY'S EASEMENTS REQUIREMENTS WITH ENTERGY AND ALL SITE UTILITIES PRIOR TO ROUGH-IN.
- E7.3 PROPOSED ROUTING OF POWER COMPANY UNDERGROUND PRIMARY DUCTBANK. PROVIDE (2) 1" CONDUITS. PROVIDE CAUTION TAPE AT 12" DEPTH AND TOP OF CONDUIT AT 36" DEPTH. COORDINATE ROUTING WITH ENTERGY AND ALL SITE UTILITIES PRIOR TO ROUGH-IN. INSTALL PER ENTERGY SERVICE GUIDELINES, SPECIFICATIONS AND STANDARDS. REFER TO ONE-LINE DIAGRAM FOR ADDITIONAL INFORMATION.
- E7.4 NEW UNDERGROUND FIRE SPRINKLER VAULT. REFERENCE CIVIL PLANS FOR EXACT LOCATION. PROVIDE RELAY FOR FIRE ALARM POST INDICATOR VALVE (FV). PROVIDE FLOW SWITCH AND SUPERVISOR/TAMPER SWITCH IN VAULT. ROUTE 1" CONDUIT FROM FIRE SPRINKLER RISER ROOM TO VAULT FOR ALL ASSOCIATED FIRE ALARM WIRING. FIRE ALARM ALARMS SHALL COORDINATE ALL MONITORING POINTS OF SPRINKLER SYSTEM WITH FIRE PROTECTION CONTRACTOR. ALL POINTS SHALL BE MONITORED BY THE FIRE ALARM CONTROL PANEL. COORDINATE PLACEMENT OF ALL DEVICES WITH CIVIL DRAWINGS.
- E7.6 PROVIDE A MINIMUM OF 12 FEET CLEARANCE IN FRONT OF TRANSFORMER. COORDINATE WITH ENTERGY AND ALL SITE UTILITIES PRIOR TO ROUGH-IN.
- E7.8 PROPOSED LOCATION OF NEW ENTERGY PAD MOUNTED TRANSFORMER. PROVIDE CONCRETE PAD PER ENTERGY SERVICE STANDARDS AND SPECIFICATIONS. COORDINATE WITH UTILITY POWER COMPANY AND ALL SITE UTILITIES PRIOR TO ROUGH-IN.
- E7.9 PROVIDE 20' X 20' EASEMENT FROM THE CENTER OF THE TRANSFORMER CONCRETE PAD. REFER TO ENTERGY CONCRETE PAD STANDARDS AND SPECIFICATIONS FOR FINAL PAD SIZE AND DIMENSIONS. COORDINATE WITH ENTERGY AND ALL SITE UTILITIES PRIOR TO ROUGH-IN.
- E7.10 PROVIDE BOLLARDS PER ENTERGY SERVICE STANDARDS AND SPECIFICATIONS. COORDINATE WITH UTILITY POWER COMPANY AND ALL SITE UTILITIES PRIOR TO ROUGH-IN.
- E7.11 PROPOSED ROUTING OF NEW UNDERGROUND SECONDARY DUCTBANK FOR NEW SERVICE ENTRANCE. PER ENTERGY SERVICE STANDARDS AND SPECIFICATIONS. COORDINATE WITH ENTERGY AND ALL SITE UTILITIES PRIOR TO ROUGH-IN. REFER TO ONE-LINE DIAGRAM FOR FURTHER DETAILS.
- E7.16 PROPOSED LOCATION OF NEW GENERATOR LOAD BANK. ALL WORKING CLEARANCES PER NEC AND LOAD BANK MANUFACTURER SHALL BE MET. REFER TO PROJECT SPECIFICATIONS FOR ADDITIONAL INFORMATION.
- E7.17 PROVIDE EXTERIOR FLOOD LIGHTING FIXTURE. CONTRACTOR SHALL FIELD COORDINATE EXACT LOCATION WITH ARCHITECT/OWNER PRIOR TO INSTALLATION.
- E7.19 PROVIDE (1) 1" CONDUIT WITH PULL STRING CONDUIT STUB-OUT FOR FUTURE ELECTRONIC MARQUEE SIGN BACK TO "MECH A132" ROOM. CONDUIT SHALL BE LABELED, AND CAPPED. PROVIDE AND INSTALL ALL PULL BOXES AS REQUIRED.
- E7.22 PROPOSED ROUTING OF UNDERGROUND SECONDARY DUCTBANK FROM MAIN SERVICE EQUIPMENT MCB TO MAIN SWITCHBOARD MSB IN ELEC ROOM B131. FIELD COORDINATE WITH ALL SITE UTILITIES PRIOR TO ROUGH-IN. REFER TO ONE-LINE DIAGRAM FOR FURTHER DETAILS.
- E7.23 PROPOSED ROUTING OF UNDERGROUND DUCTBANK FROM NATURAL GAS ENGINE EMERGENCY GENERATOR GN1 TO DISTRIBUTION PANELBOARD EDP IN ELEC ROOM B131. FIELD COORDINATE WITH ALL SITE UTILITIES PRIOR TO ROUGH-IN. REFER TO ONE-LINE DIAGRAM FOR FURTHER DETAILS.
- E7.24 APPROXIMATE LOCATION OF MARQUEE SIGN. PROVIDE (2) CIRCUITS TO MONUMENT SIGN. PROVIDE (2) DEDICATED 20 AMP CIRCUITS FOR DIGITAL MARQUEE SIGN. PROVIDE 30AMP/2P/1NC DISCONNECT FOR MARQUEE SIGN. PROVIDE 2" CONDUIT FOR POWER. PROVIDE MINIMUM 1" CONDUIT FOR TECHNOLOGY WIRING. REFER TO TECHNOLOGY PLANS FOR ADDITIONAL MARQUEE SIGN REQUIREMENTS.
- E7.26 APPROXIMATE LOCATION OF EXISTING POWER COMPANY POWER POLE.
- E7.27 APPROXIMATE PROPOSED LOCATION OF NEW UTILITY COMPANY POWER POLE. EXACT POLE LOCATION AND ROUTING SHALL BE DETERMINED BY ENTERGY. COORDINATE PLACEMENTS OF POLE ALONG PROPERTY'S EASEMENTS REQUIREMENTS WITH ENTERGY AND ALL SITE UTILITIES PRIOR TO ROUGH-IN.
- E7.28 APPROXIMATE PROPOSED ROUTING OF POWER COMPANY OVERHEAD PRIMARY LINE. PROVIDE A MINIMUM OF 18' FROM PROPERTY LINE. COORDINATE ROUTING AND PLACEMENTS OF POLE ALONG PROPERTY'S EASEMENTS REQUIREMENTS WITH ENTERGY AND ALL SITE UTILITIES PRIOR TO ROUGH-IN. INSTALL PER ENTERGY SERVICE GUIDELINES, SPECIFICATIONS AND STANDARDS.
- E7.29 CONTRACTOR SHALL COORDINATE PLACEMENT OF POLE LIGHTS WITH POWER COMPANY OVERHEAD LINE AND UNDERGROUND EASEMENTS PRIOR TO STARTING ANY WORK.
- E10.2 EXTERIOR LIGHTING SHALL BE CONTROLLED BY RELAY PANEL WITH SCHEDULE AND PHOTOCELL OVERRIDE PER 2019 IEC CODE REQUIREMENTS. PHOTOCELL SHALL BE INTEGRATED WITH LIGHTING RELAY PANEL. COORDINATE SCHEDULE WITH OWNER. PARKING LOT POLE LIGHTS SHALL BE CONTROLLED SEPARATELY. PROVIDE CONTACT RELAY TO ALLOW BAS SYSTEM INTEGRATION COORDINATE WITH MECHANICAL CONTROLS CONTRACTOR FOR SYSTEM INTEGRATION.

NOTE TO ELECTRICAL CONTRACTOR:  
ELECTRICAL CONTRACTOR SHALL PROVIDE CONDUIT, OUTLET BOXES, JUNCTION BOXES FOR ALL TECHNOLOGY, LOW VOLTAGE, ACCESS CONTROL SECURITY, SURVEILLANCE, AND OTHER DIVISION 27/28 SCOPE. REFER TO DIVISION 27/28 DRAWINGS AND SPECIFICATIONS FOR ALL WORK REQUIRED. OMISSION OF THIS SCOPE FROM DIV 26 SCOPE OF WORK IS PROHIBITED.

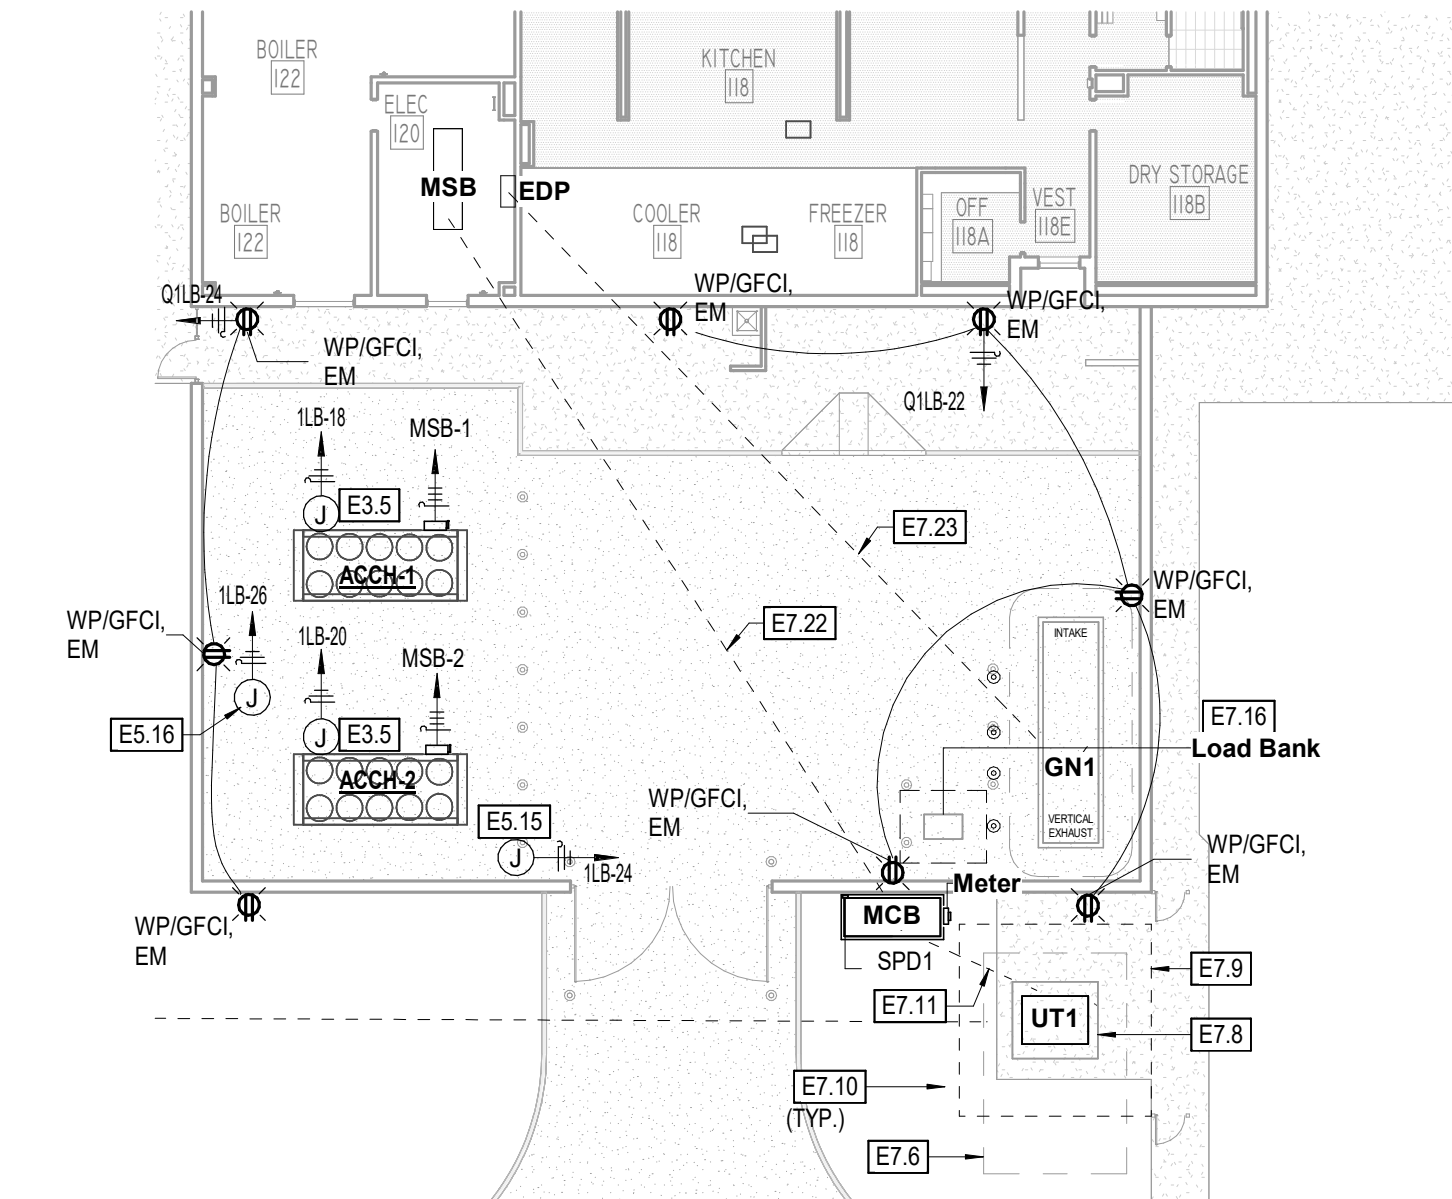

2 ENLARGED ELECTRICAL CENTRAL PLANT  
E1.1 1" = 20'-0"

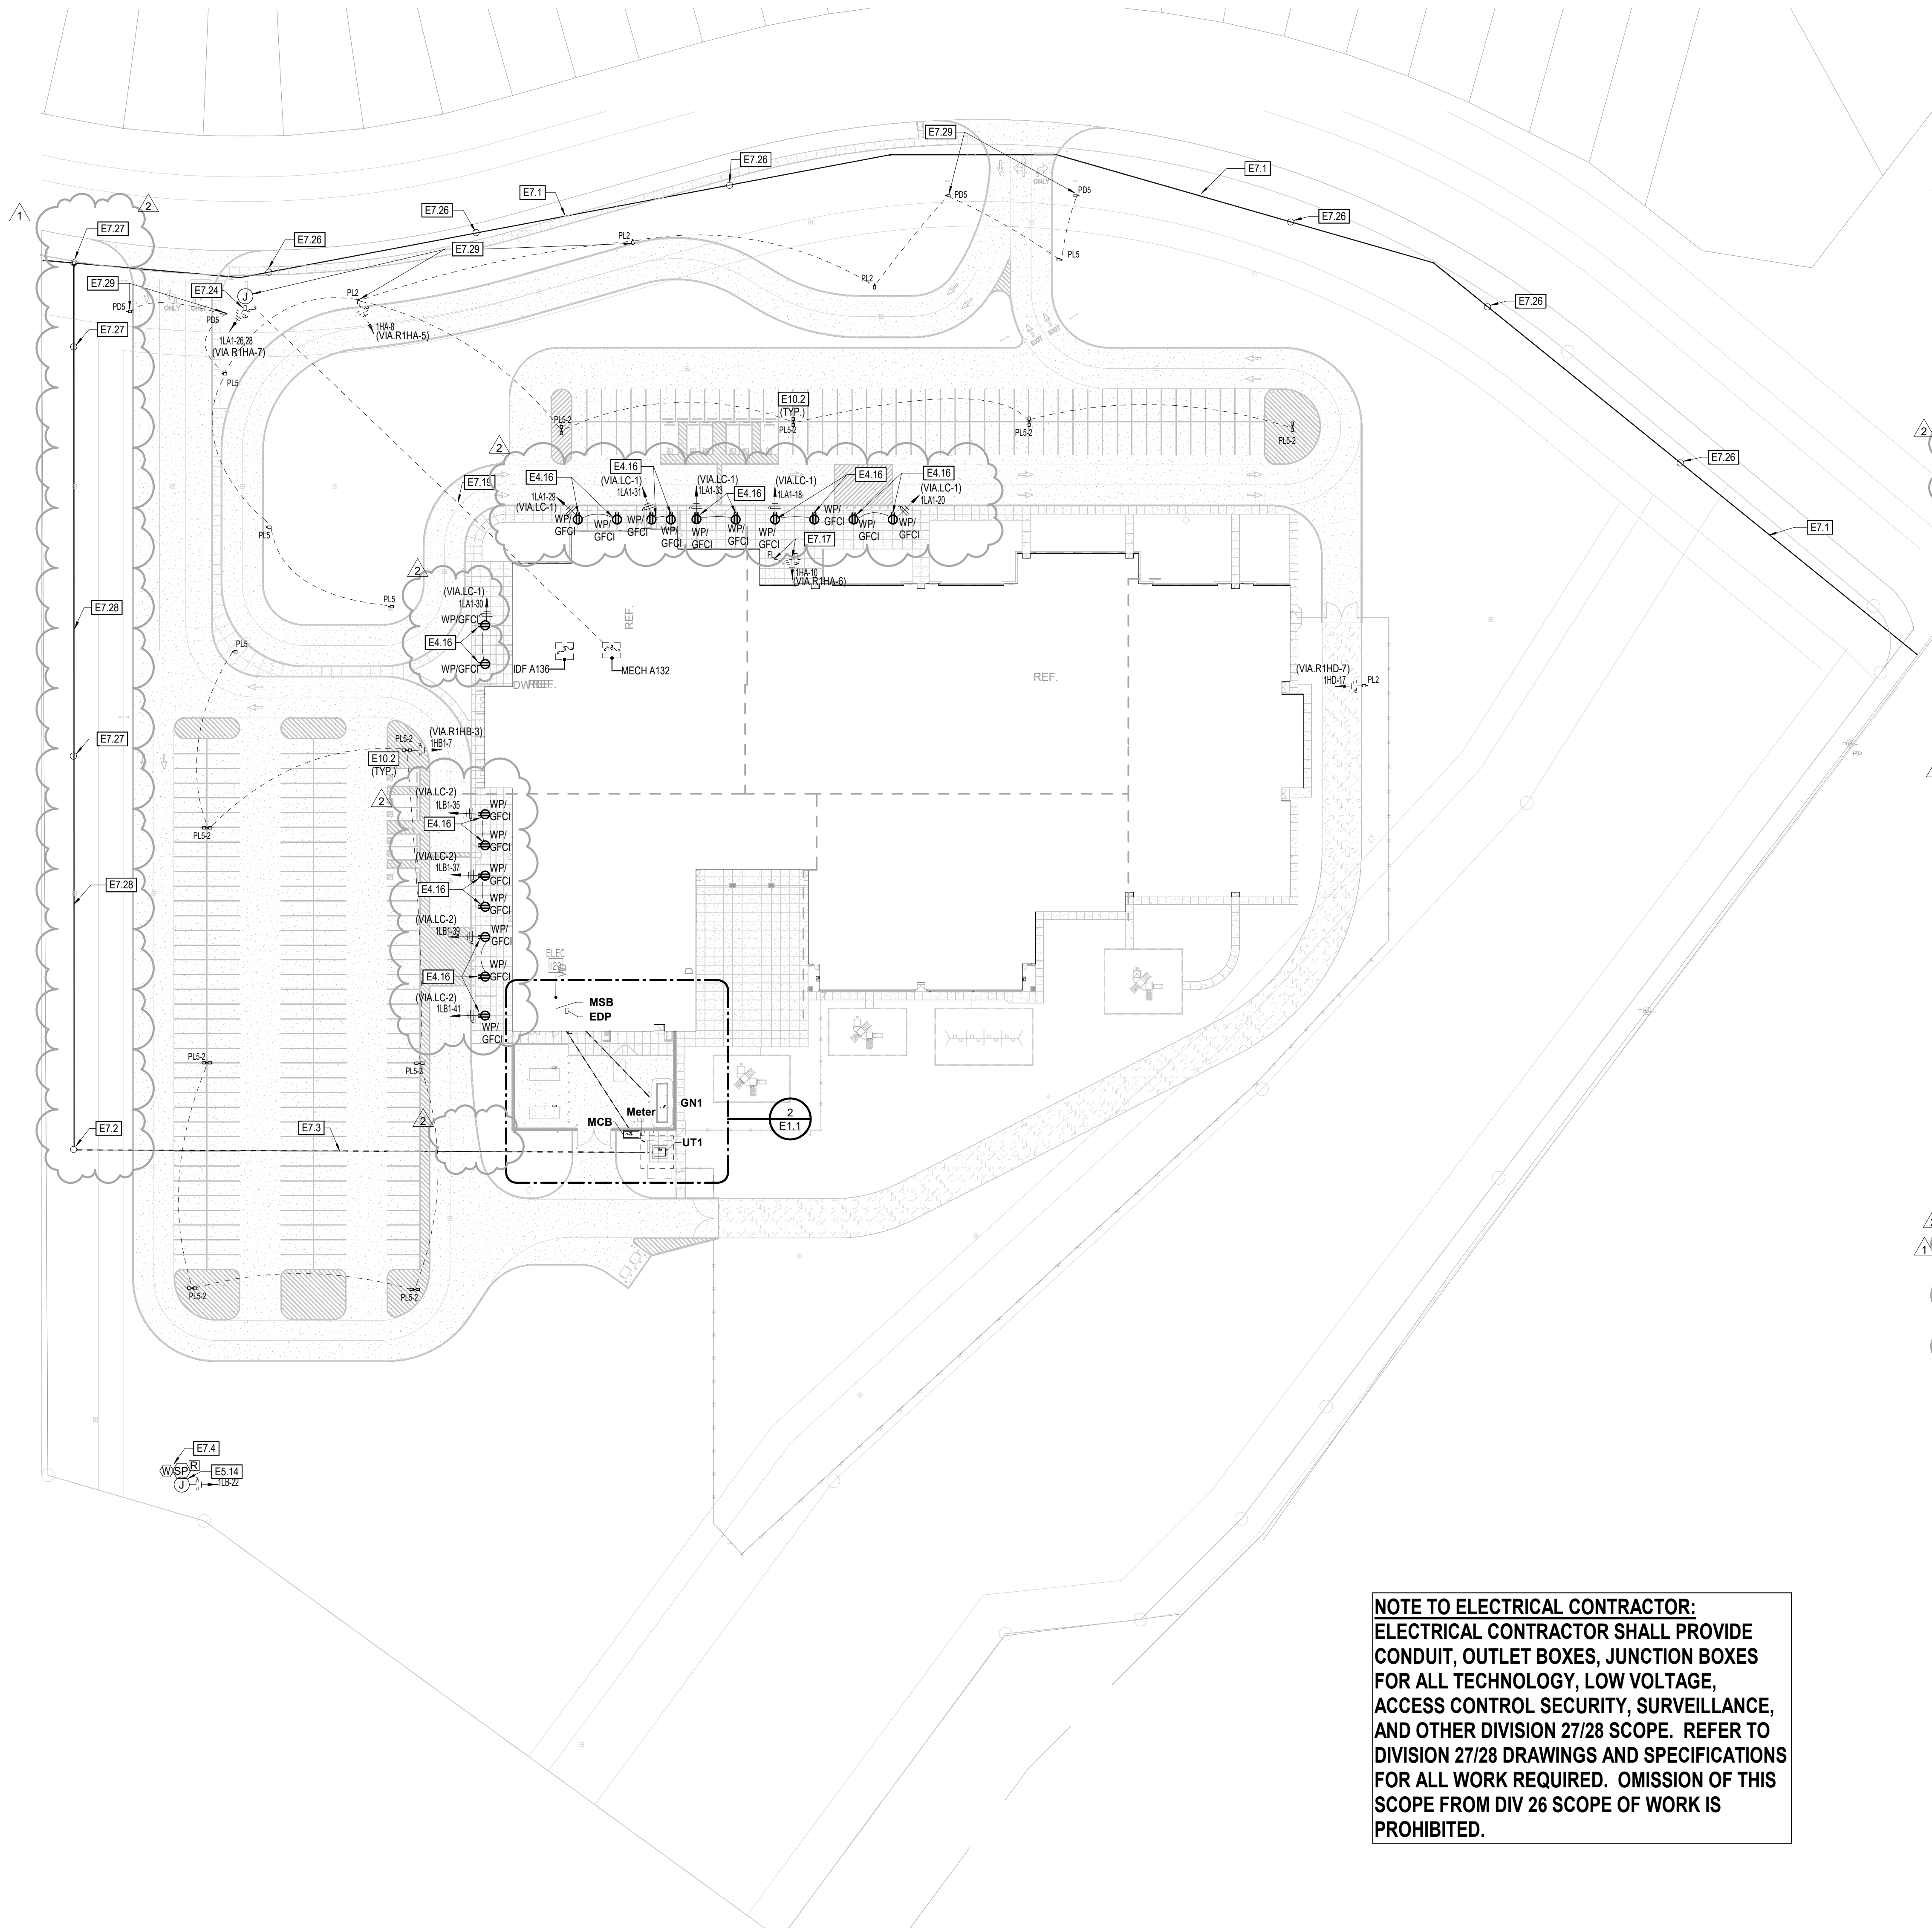

1 ELECTRICAL SITE PLAN  
E1.1 1" = 50'-0"



2018 IECC STANDARD SEQUENCE OF OPERATIONS	AUTO ON		MANUAL ON (VACANCY)		AUTO OFF (20MIN MAX)		PARTIAL OFF AT NORMAL HOURS		AUTO OFF AFTER HOURS (30MIN MAX)		TIME ON		TIME OFF		ASTRONOMIC OR PHOTOCCELL ON/OFF		AUTO STEP CONTROL WITH OFF		AUTO CONTINUOUS DIM WITH OFF		MANUAL BILEVEL REDUCTION CONTROL		MANUAL CONTINUOUS DIM CONTROL		MANUAL ON/OFF SWITCH		MANUAL DIMMER SWITCH		DISPLAY, ACCENT, TASK CONTROL			
	ROOM TYPE		OCCUPANCY SENSOR				TIME SWITCH				DAYLIGHT CTL		LT REDUCT		MANUAL CONTROL		SEQUENCE OF OPERATION															
	Spaces (≤ 300 sq ft)		•	20 MIN																		•	D								Manual On 100%; Occupancy sensor Auto Off; Manual control and ≥50% light reduction with two on/off controls; Where ≥150W in daylight area, use continuous dimming daylighting control and dimmer switch.	
	*Enclosed Offices		•	20 MIN																		•	D								Manual On 100%; Occupancy sensor Auto Off; Manual control and ≥50% light reduction with two on/off controls; Where ≥150W in daylight area, use continuous dimming daylighting control and dimmer switch.	
	**Open Plan Office Areas ≤600SqFt zones*		•	20 MIN																		•	D								Manual On 100%; Occupancy sensor Auto Off; Manual control and ≥50% light reduction with two on/off controls; Where ≥150W in daylight area, use continuous dimming daylighting control and dimmer switch.	
	Class/Lecture/Training Room		•	20 MIN																		•	D								Manual On 100%; Occupancy sensor Auto Off; Manual control and ≥50% light reduction with two on/off controls; Where ≥150W in daylight area, use continuous dimming daylighting control and dimmer switch.	
	Conference/Meeting Room		•	20 MIN																		•	D								Manual On 100%; Occupancy sensor Auto Off; Manual control and ≥50% light reduction with two on/off controls; Where ≥150W in daylight area, use continuous dimming daylighting control and dimmer switch.	
	Copy/Print Room			•	20 MIN																		•	D								Manual On 100%; Occupancy sensor Auto Off; Manual control and ≥50% light reduction with two on/off controls; Where ≥150W in daylight area, use continuous dimming daylighting control and dimmer switch.
	Restroom		100%		20 MIN																		•									Auto On 100%. Occupancy sensor Auto Off; Manual control.
	Lunch/Break Rooms/Lounges		50%		20 MIN																		•	D								Auto On 50%; Occupancy sensor Auto Off; Manual control and ≥50% light reduction with two on/off controls; Where ≥150W in daylight area, use continuous dimming daylighting control and dimmer switch.
Corridor		100%		20 MIN																		•	D								Auto On 100%; Occupancy sensor Auto Off; Manual control device; Where ≥150W in daylight area, use continuous dimming daylighting control and dimmer switch.	
Stairwell		100%		20 MIN																		•	D								Auto On 100%; Occupancy sensor Auto Off; Manual control; Where ≥150W in daylight area, use continuous dimming daylighting control and dimmer switch.	
Storage Room			•	20 MIN																		•	D								Manual On 100%; Occupancy sensor Auto Off; Manual control and ≥50% light reduction with two on/off controls; Where ≥150W in daylight area, use continuous dimming daylighting control and dimmer switch.	
Cafeteria / Gym / Library		100%										11PM										•	D								Auto On 100%; Occupancy sensor Auto Off; Manual control and ≥50% light reduction with two on/off controls; Where ≥150W in daylight area, use continuous dimming daylighting control and dimmer switch.	
Multipurpose Rooms			•	20 MIN																		•	D								Manual On 100%; Occupancy sensor Auto Off; Manual control and ≥50% light reduction with two on/off controls; Where ≥150W in daylight area, use continuous dimming daylighting control and dimmer switch.	
Locker Room		100%		20 MIN																		•	D								Auto On 100%; Occupancy sensor Auto Off; Manual control and ≥50% light reduction with two on/off controls; Where ≥150W in daylight area, use continuous dimming daylighting control and dimmer switch.	
Lab			•	20 MIN																		•	D								Manual On 100%; Occupancy sensor Auto Off; Manual control and ≥50% light reduction with two on/off controls; Where ≥150W in daylight area, use continuous dimming daylighting control and dimmer switch.	
Building Façade / Landscape (Decorative)											CLOSE	OPEN	•																		Dusk Auto On with astro time switch or photocell; Evening Time Auto Off no later than one hour after business close. Morning Time Auto On no earlier than one hour before business open. Dawn Auto Off.	
**Exterior / Parking Lots / Site Lighting (Setback)											6AM	12AM	•																		Dusk Auto On with astro time switch or photocell; Reduce at least 30% from midnight or up to one hour after business close. Auto On to full at 6:00AM or up to one hour before business open. Dawn Auto Off.	

●= Designation for code compliant default control design for spaces without daylighting controls

D= Where daylighting control is required, "D" designation indicates controls required in the space for code compliance design.

CK= Captive Key Switch system for use in Hotel/Motel and Guest Suite

RELAY PANEL - R1HA			
RELAY NO.	AREA SERVED	CIRCUIT NO.	NOTES
R1HA-1	CORRIDOR LIGHTS	SEE PLANS	2
R1HA-2	EM LIGHTS	SEE PLANS	2
R1HA-3	EXTERIOR WALL PACKS	SEE PLANS	1
R1HA-4	EXTERIOR DOWNLIGHTS	SEE PLANS	1
R1HA-5	SITE POLE LIGHTS	SEE PLANS	1
R1HA-6	FLAG POLE LIGHTS	SEE PLANS	1
R1HA-7	MARQUEE SIGN	SEE PLANS	1
R1HA-8	EXTERIOR SIGNAGE	SEE PLANS	1
R1HA-9	SPARE	SEE PLANS	
R1HA-10	SPARE	SEE PLANS	
R1HA-11	SPARE	SEE PLANS	
R1HA-12	SPARE	SEE PLANS	
R1HA-13	SPARE	SEE PLANS	
R1HA-14	SPARE	SEE PLANS	
R1HA-15	SPARE	SEE PLANS	
R1HA-16	SPARE	SEE PLANS	
R1HA-17	SPARE	SEE PLANS	
R1HA-18	SPARE	SEE PLANS	
R1HA-19	SPARE	SEE PLANS	
R1HA-20	SPARE	SEE PLANS	

- NOTES:
1. EXTERIOR LIGHTING SHALL BE PHOTOCELL CONTROLLED WITH ON/OFF SCHEDULING AS REQUIRED BY THE 2018 IECOD.
  2. CORRIDOR LIGHTING SHALL BE CONTROLLED BY ON/OFF SCHEDULING PROVIDE OVERRIDE SWITCHES AND OCCUPANCY SENSORS PROVIDED AT CORRIDORS. REFERENCE PLANS FOR SWITCHING ZONES. CONFIRM SCHEDULING AND OVERRIDE LOCATIONS WITH OWNER. REFER TO CORRIDOR LIGHTING SEQUENCE OF OPERATIONS NOTES ON PLANS.

RELAY PANEL - R1HB			
RELAY NO.	AREA SERVED	CIRCUIT NO.	NOTES
R1HB-1	EXTERIOR WALL PACKS	SEE PLANS	1
R1HB-2	EXTERIOR DOWNLIGHTS	SEE PLANS	1
R1HB-3	SITE POLE LIGHTS	SEE PLANS	1
R1HB-4	MECH. YARD LTG.	SEE PLANS	1
R1HB-5	SPARE	SEE PLANS	
R1HB-6	SPARE	SEE PLANS	
R1HB-7	SPARE	SEE PLANS	
R1-HB-8	SPARE	SEE PLANS	
R1-HB-9	SPARE	SEE PLANS	
R1-HB-10	SPARE	SEE PLANS	
R1-HB-11	SPARE	SEE PLANS	
R1-HB-12	SPARE	SEE PLANS	
R1-HB-13	SPARE	SEE PLANS	
R1-HB-14	SPARE	SEE PLANS	
R1-HB-15	SPARE	SEE PLANS	
R1-HB-16	SPARE	SEE PLANS	
R1-HB-17	SPARE	SEE PLANS	
R1-HB-18	SPARE	SEE PLANS	
R1-HB-19	SPARE	SEE PLANS	
R1-HB-20	SPARE	SEE PLANS	

- NOTES:
1. EXTERIOR LIGHTING SHALL BE PHOTOCELL CONTROLLED WITH ON/OFF SCHEDULING AS REQUIRED BY THE 2019 IECC.
  2. CORRIDOR LIGHTING SHALL BE CONTROLLED BY ON/OFF SCHEDULING. PROVIDE OVERRIDE SWITCHES AND OCCUPANCY SENSORS PROVIDED AT CORRIDORS. REFERENCE PLANS FOR SWITCHING ZONES. CONFIRM SCHEDULING AND OVERRIDE LOCATIONS WITH OWNER. REFER TO CORRIDOR LIGHTING SEQUENCE OF OPERATIONS NOTES ON PLANS.


RELAY PANEL - R1HD			
RELAY NO.	AREA SERVED	CIRCUIT NO.	NOTES
R1HD-1	CORRIDOR LIGHTS	SEE PLANS	2
R1HD-2	CORRIDOR LIGHTS	SEE PLANS	2
R1HD-3	EM.LIGHTS	SEE PLANS	2
R1HD-4	EM.LIGHTS	SEE PLANS	2
R1HD-5	EXTERIOR WALL PACKS	SEE PLANS	1
R1HD-6	EXTERIOR WALL DOWNLIGHTS	SEE PLANS	1
R1HD-7	SITE POLE LIGHTS	SEE PLANS	1
R1HD-8	SPARE	SEE PLANS	
R1HD-9	SPARE	SEE PLANS	
R1HD-10	SPARE	SEE PLANS	
R1HD-11	SPARE	SEE PLANS	
R1HD-12	SPARE	SEE PLANS	
R1HD-13	SPARE	SEE PLANS	
R1HD-14	SPARE	SEE PLANS	
R1HD-15	SPARE	SEE PLANS	
R1HD-16	SPARE	SEE PLANS	
R1HD-17	SPARE	SEE PLANS	
R1HD-18	SPARE	SEE PLANS	
R1HD-19	SPARE	SEE PLANS	
R1HD-20	SPARE	SEE PLANS	

- NOTES:
1. EXTERIOR LIGHTING SHALL BE PHOTOCCELL CONTROLLED WITH ON/OFF SCHEDULING AS REQUIRED BY THE 2019 IECC.
  2. CORRIDOR LIGHTING SHALL BE CONTROLLED BY ON/OFF SCHEDULING PROVIDE OVERRIDE SWITCHES AND OCCUPANCY SENSORS PROVIDED AT CORRIDORS. REFERENCE PLANS FOR SWITCHING ZONES. CONFIRM SCHEDULING AND OVERRIDE LOCATIONS WITH OWNER. REFER TO CORRIDOR LIGHTING SEQUENCE OF OPERATIONS NOTES ON PLANS.

LIGHTING CONTACTOR SCHEDULE					
MARK	POLES	AMPS/ POLES	COIL VOLTAGE	CONTROL METHOD	MARK
LC-1	8	20	120	SCHEDULE VIA BAS, LOCAL OVERRIDE SWITCHES PER PLANS, H-O-A	NORTH EXTERIOR FANS
LC-2	8	20	120	SCHEDULE VIA BAS, LOCAL OVERRIDE SWITCHES PER PLANS, H-O-A	WEST EXTERIOR FANS

**LIGHTING CONTACTOR NOTES**

1. EXTERIOR FAN RECEPTACLES SHALL BE CONTROLLED BY MOMENTARY CONTACT SWITCH.
2. EACH CONTACTOR SHALL HAVE HAND-OFF-AUTO (HOA) SWITCH ADJACENT TO CONTACTOR.
3. POLE QUANTITIES INDICATED HAVE SPARE POLES BUILT IN. REFERENCE PLANS FOR ACTUAL QUANTITY OF CIRCUITS GOING TO EACH LIGHTING CONTACTOR.
4. LOCATE NEW CONTACTOR ADJACENT TO PANEL SERVING CIRCUIT. CONNECT NEW CONTACTOR TO NEAREST 120V CONVENIENCE CIRCUIT.

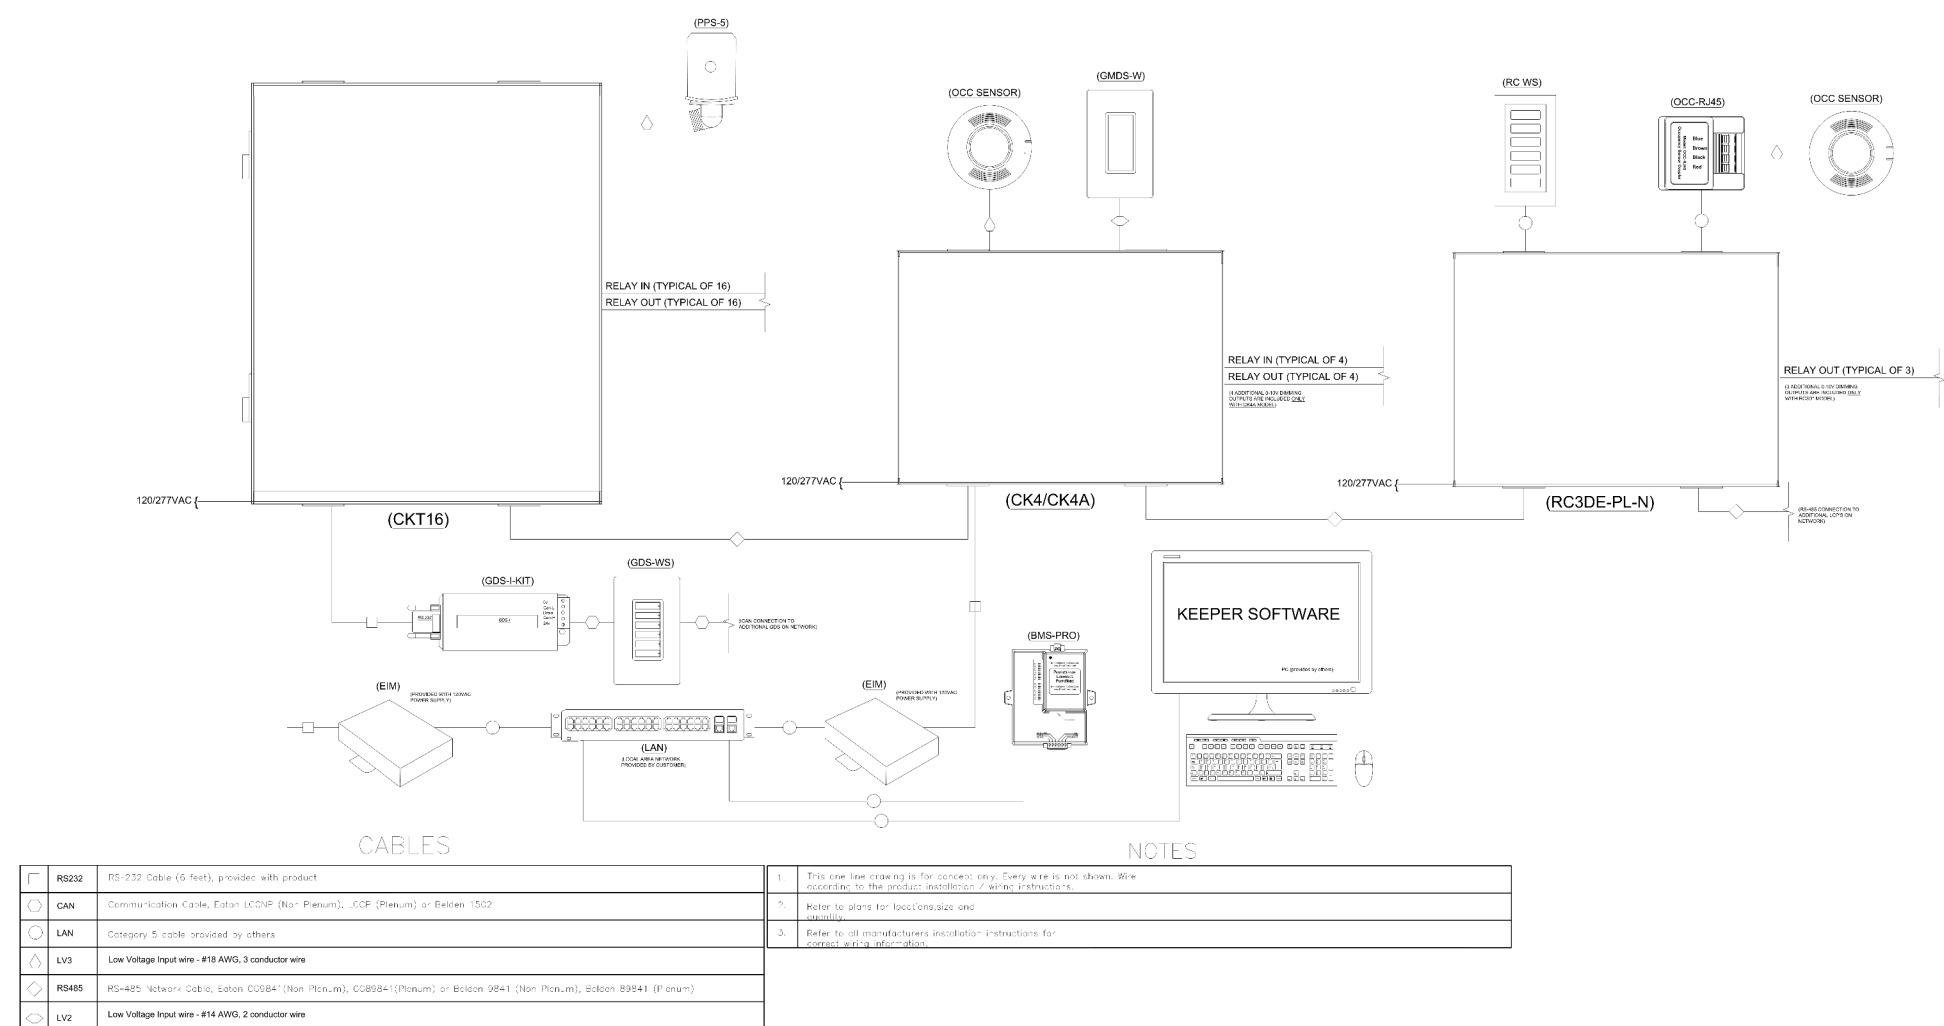[illegible]

LIGHTING FIXTURE SCHEDULE							
TYPE	MANUFACTURE	MODEL	MOUNTING	LAMPS	VOLTAGE	WATTAGE	DESCRIPTION
A1	METALUX	24C22-50-UNV-L840-CD1-U	RECESSED	LED 4000K	277 V	40 VA	2'X4 LED CENTER BASKET TROFFER WITH SMOOTH LENS, 5000 LUMENS
A1E	METALUX	24C22-50-UNV-L840-CD1-U	RECESSED	LED 4000K	277 V	40 VA	2'X4 LED TYPE "A1" EXCEPT WITH UL 924 "GTD" TRANSFER DEVICE BY LIGHTING CONTROL'S MANUFACTURER.
A2	METALUX	24C22-40-SUNV-L840-CD1-U	RECESSED	LED 4000K	277 V	30 VA	2'X4 LED CENTER BASKET TROFFER WITH SMOOTH LENS, 4100 LUMENS
A2E	METALUX	24C22-40-SUNV-L840-CD1-U	RECESSED	LED 4000K	277 V	30 VA	SAME AS TYPE "A2" EXCEPT WITH UL 924 "GTD" TRANSFER DEVICE BY LIGHTING CONTROL'S MANUFACTURER.
A3	METALUX	24C22-65HE-S-UNV-L840-CD1-U	RECESSED	LED 4000K	277 V	50 VA	2'X4 LED CENTER BASKET TROFFER WITH SMOOTH LENS, 8000 LUMENS
A3E	METALUX	24C22-65HE-S-UNV-L840-CD1-U	RECESSED	LED 4000K	277 V	50 VA	SAME AS TYPE "A3" EXCEPT WITH UL 924 "GTD" TRANSFER DEVICE BY LIGHTING CONTROL'S MANUFACTURER.
A4	METALUX	24GRF-A1D5-64-F1-UNV-L840-CD1-G3U	RECESSED	LED 4000K	277 V	48 VA	2'X4 TROFFER WITH FROSTED ACRYLIC, 125 LENS, 6400 LUMENS, G3 GASKETING
A4E	METALUX	24GRF-A1D5-64-F1-UNV-L840-CD1-G3U	RECESSED	LED 4000K	277 V	48 VA	SAME AS TYPE "A4" EXCEPT WITH UL 924 "GTD" TRANSFER DEVICE BY LIGHTING CONTROL'S MANUFACTURER.
A5E	METALUX	24C22-65HE-S-UNV-EL14W-L840-CD1-U	RECESSED	LED 4000K	277 V	50 VA	SAME AS TYPE "A5" EXCEPT WITH EMERGENCY REMOTE BATTERY PACK, PROVIDE WITH PART NUMBER LCP50-20F.
A6E	METALUX	24C240-UNV-EL14W-L840-CD1-U	RECESSED	LED 4000K	277 V	30 VA	SAME AS TYPE "A2" EXCEPT WITH EMERGENCY BATTERY PACK.
B1	METALUX	24C22-32-S-UNV-L840-CD1-U	RECESSED	LED 4000K	277 V	24 VA	2'X2 LED CENTER BASKET TROFFER WITH SMOOTH LENS, 3200 LUMENS
D1	HALO COMMERCIAL	H0615D010-HM00525840-61WDH	RECESSED	LED 4000K	277 V	16 VA	6" RECESSED ROUND DOWNLIGHT, SEMI SPEC FINISH AND FLANGE, 1500 LUMENS
D1E	HALO COMMERCIAL	H0615D010-REM14-HM00525840-61WDH	RECESSED	LED 4000K	277 V	16 VA	SAME AS TYPE "D1" EXCEPT WITH EMERGENCY BATTERY PACK.
D2	HALO COMMERCIAL	H0620D010-HM00525840-61WDH	RECESSED	LED 4000K	277 V	21 VA	6" RECESSED ROUND DOWNLIGHT, SEMI SPEC FINISH AND FLANGE, 2000 LUMENS
D2E	HALO COMMERCIAL	H0620D010-HM00525840-61WDH	RECESSED	LED 4000K	277 V	21 VA	SAME AS TYPE "D2" EXCEPT WITH UL 1008 "GTD" TRANSFER DEVICE BY LIGHTING CONTROL'S MANUFACTURER.
FL	INVue	VFS-X-B40-S-LED-E1-MST-xx-SMT-xx-SF-xx-VFS-TV-xx	GROUND	LED 4000K	277 V	67 VA	LED FLAG POLE LUMINAIRE, SURFACE MOUNT TENON, TOP AND SIDE VISOR
H01	METALUX	VHB-24-UNV-UNV-L840-CD-U+VHB-WHG+VH-B-SPMH-LOOP-10	SURFACE	LED 4000K	277 V	165 VA	LED HIGH BAY LUMINAIRE, IMC2 REMOTE WIRING, WIDE DISTRIBUTION, SINGLE POINT MOUNT KIT, #2 CABLE 10FT WITH LOOP
H01E	METALUX	VHB-24-UNV-UNV-L840-CD-U+VHB-WHG+VH-B-SPMH-LOOP-10	SURFACE	LED 4000K	277 V	165 VA	SAME AS TYPE "H01" EXCEPT WITH UL 924 "GTD" TRANSFER DEVICE BY LIGHTING CONTROL'S MANUFACTURER.
H02	METALUX	VHB-24-UNV-UNV-L840-EL20W-REM-CD-U+VHB-WHG+VHB-SPMH-LOOP-10	SURFACE	LED 4000K	277 V	165 VA	SAME AS TYPE "H01" EXCEPT WITH EMERGENCY BATTERY PACK.
KE	STARTEK	HYDRO-D-1000-SD-40-K-60-FINISH-SM(X)+J-C	SURFACE	LED 4000K	277 V	58 VA	4FT SURFACE MOUNT LINEAR, 600 IMPACT PROTECTION, PROVIDE WITH UL 1008 "GTD" TRANSFER DEVICE BY LIGHTING CONTROL'S MANUFACTURER.
LE	METALUX	45NLED-LD5-41SL-UNV-UNV-EL14W-L840-CD1-U + WGSNF-4FT-B	CHAIN HUNG	LED 4000K	277 V	35 VA	4' STAND STRIP/LIGHT, FULL FROSTED LENS, 4100 LUMENS, PROVIDE WITH UL 924 "GTD" TRANSFER DEVICE BY LIGHTING CONTROL'S MANUFACTURER.
M	HALO	L80303FL94(X)	TRACK	LED 4000K	120 V	37 VA	LED TRACK HEAD, FLOOD OPTIC, TO BE PROVIDED WITH HALO SINGLE CIRCUIT TRACK PER PLAN.
P05	MCORAW EDISON	GAT-C46-L5ED-50-740-U-55-5-6-X-82 + RTAP15-5-1-1BRZ3-8C	POLE	LED 4000K	277 V	54 VA	LED POST TOP LUMINAIRE, BRONZE FINISH, TYPE V, WITH A 15FT ROUND TAPERED ALUMINUM POLE, BRONZE FINISH, LIGHTS SHALL DIM TO 50% WHEN NO OCCUPANCY IS DETECTED DURING SCHEDULED ON TIME.
PL2	LUMARK	PRV-XL-P43A-740-VOLT-I-T3-BZ-82-ZNWO FF-X + RTAP25-6-1BRZ2-DIM-B-C-VDP	POLE	LED 4000K	277 V	172 VA	AREA SITE LUMINAIRE, TYPE IV, WITH 25FT ROUND, TAPERED ALUMINUM POLE, BRONZE FINISH, PROGRAMMABLE DIMMING SENSOR, LIGHTS SHALL DIM TO 50% WHEN NO OCCUPANCY IS DETECTED DURING SCHEDULED ON TIME, PROVIDE WITH INTERNAL HOUSE SIDE SHELW.
PL5	LUMARK	PRV-XL-P43A-740-VOLT-I-T3-BZ-ZW-WOF FF-X + RTAP25-6-1BRZ2-DIM-B-C-VDP	POLE	LED 4000K	277 V	172 VA	AREA SITE LUMINAIRE, TYPE V, WITH 25FT ROUND, TAPERED ALUMINUM POLE, BRONZE FINISH, PROGRAMMABLE DIMMING SENSOR.
PL5-L	LUMARK	PRV-XL-P43A-740-VOLT-I-5WG-BZ-ZQ-WO FF-X + RTAP25-6-1BRZ2-DIM2180-BC-VDP	POLE	LED 4000K	277 V	344 VA	AREA SITE LUMINAIRES @ 180", TYPE V, WITH 25FT ROUND, TAPERED ALUMINUM POLE, BRONZE FINISH, PROGRAMMABLE DIMMING SENSOR, LIGHTS SHALL DIM TO 50% WHEN NO OCCUPANCY IS DETECTED DURING SCHEDULED ON TIME.
WP	MCORAW EDISON	ISS-SA1C-740-I-74W-82	SURFACE	LED 4000K	277 V	34 VA	LED SPECIFICATION GRADE WALL PACE, TYPE IV DISTRIBUTION, BRONZE FINISH
WPE	MCORAW EDISON	ISS-SA1C-740-I-74W-82	SURFACE	LED 4000K	277 V	34 VA	SAME AS TYPE "D2" EXCEPT WITH UL 1008 "GTD" TRANSFER DEVICE BY LIGHTING CONTROL'S MANUFACTURER.
X1	SURE-LITES	CX17BK	SURFACE	LED	277 V	3 VA	SINGLE FACE DIE CAST ALUMINUM EXT. BATTERY BACK UP, BLACK FINISH, RED OR GREEN LETTERS, PROVIDE MOUNTING KIT AS SHOWN ON PLANS.
X1WB	SURE-LITES	LPW17H8K	SURFACE	LED	277 V	3 VA	WET LOCATION SINGLE FACE EXT SIGN, BATTERY BACK UP, RED LETTERS, BLACK FINISH
X2	SURE-LITES	CX17BK	SURFACE	LED	277 V	3 VA	DOUBLE FACE DIE CAST ALUMINUM EXT. BATTERY BACK UP, BLACK FINISH, RED OR GREEN LETTERS
XIG	SURE-LITES	CX17BK-WG10	SURFACE	LED	277 V	3 VA	SINGLE FACE DIE CAST ALUMINUM EXT. BATTERY BACK UP, BLACK FINISH, RED OR GREEN LETTERS, WALL MOUNT WIRE GUARD

- NOTES:  
1. LIGHTING FIXE CATALOG NUMBERS AND DESCRIPTIONS ARE REQUIRED FOR ESTABLISHING QUALITY, APPEARANCE AND PERFORMANCE OF THE DESIGN. EXACT CATALOG NUMBERS DESCRIBING MOUNTING METHODS, FINISHES AND REQUIREMENTS RELATIONS TO WIRING AND LEADS FOR ALL FIXTURES SHALL BE CONFIRMED (BY THE CONTRACTOR) WITH THE ROOM FINISH SCHEDULE AND REFLECTED IN ALL CATALOGS, INCLUDING GRID TYPES, ON THE ARCHITECTURAL DRAWINGS PRIOR TO BIDDING. FIXTURES SHALL BE SUBMITTED ACCORDING TO THE CONDITIONS IDENTIFIED ON THE ARCHITECTURAL PLANS. REFER TO THE WRITTEN SPECIFICATIONS FOR ADDITIONAL REQUIREMENTS.  
2. IF THE LIGHT FIXTURES ARE TO BE MANUFACTURED BY A THIRD PARTY, THE BIDDER MUST OBTAIN WRITTEN APPROVAL FROM THE DESIGN TEAM. QUALIFIED MANUFACTURERS, ALL BIDDERS SHALL SUBMIT THEIR PROPOSED LIGHT FIXTURES IN SUBMITTAL FORM A MINIMUM OF BUSINESS DAYS PRIOR TO BID DATE FOR REVIEW. APPROVED LIGHT FIXTURES WILL BE ISSUED IN AN ADDENDUM.

LIGHTING CONTROLS DEVICE SCHEDULE		
TYPE	DESCRIPTION	COMMENTS
S <sup>3</sup> S <sup>3</sup> S <sup>4</sup> S <sup>K</sup>	LINE VOLTAGE SWITCH.	'3' INDICATES THREE WAY SWITCHING. '4' INDICATES FOUR WAY SWITCHING. 'K' INDICATES SWITCH SHALL BE KEYED SWITCH.
S <sup>MC</sup>	LINE VOLTAGE MOMENTARY CONTACT SWITCH.	
S <sup>T</sup>	LINE VOLTAGE TIMER SWITCH WITH DIGITAL TIMER.	RATED FOR 120/277VAC. PROVIDE WITH AUDIBLE & VISUAL ALERTS. USER PROGRAMMABLE FOR 5MIN-12HR TIME-OUT SETTINGS.
S <sup>OC1</sup>	LINE VOLTAGE WALL MOUNT DUAL TECHNOLOGY OCCUPANCY SENSOR	SENSOR SHALL BE SET TO VACANCY MODE
S <sup>OC2</sup>	LINE VOLTAGE WALL MOUNT DUAL TECHNOLOGY OCCUPANCY SENSOR	SENSOR SHALL BE SET TO OCCUPANCY MODE
S <sup>LV</sup> S <sup>VK</sup>	LOW VOLTAGE MANUAL CONTROL.	CONNECT TO POWER PACK IF OCCUPANCY SENSORS ARE INDICATED ON PLAN. PROVIDE MULTI-BUTTON SWITCH AS REQUIRED PER SWITCH LEGS SHOWN ON PLANS. 'K' INDICATES SWITCH SHALL BE KEYED SWITCH. HUBBLE KEYED SWITCH MODEL:LVSKEY-3M-SS,KEY #126 OR APPROVED EQUAL BY THE OWNER.
S <sup>LV3</sup>	LOW VOLTAGE DIGITAL 3 BUTTON SWITCH.	PROVIDE 3 BUTTON SWITCH FOR EACH SWITCH LEG AS INDICATED ON THE PLANS. THE SWITCH SHALL HAVE THE FOLLOWING BUTTONS: MASTER ON/OFF, RAISE AND LOWER. THE MASTER ON/OFF SWITCH SHALL BE ENGRAVED WITH THE ZONE IT CONTROLS AND THE RAISE/LOWER SWITCHES SHALL BE ENGRAVED WITH RAISE/LOWER. PROVIDE DIGITAL ROOM CONTROLLER.
S <sup>OR</sup> S <sup>ORK</sup>	LOW VOLTAGE MANUAL CONTROL.	CONNECT TO RELAY PANEL OR TIME CLOCK FOR TIME OF DAY. OVERRIDE AS NOTED ON PLANS. PROVIDE MULTI-BUTTON SWITCH AS NOTED ON PLANS. 'K' INDICATES SWITCH SHALL BE KEYED SWITCH.
S <sup>D</sup>	LOW VOLTAGE SWITCH WITH 0-10V SLIDE DIMMER WITH MASTER OVER RIDE BUTTON (ANALOG)	PROVIDE POWER PACKS AS REQUIRED.
OC1	CEILING MOUNTED DUAL TECH OCCUPANCY SENSOR.	SET TO VACANCY MODE. PROVIDE POWER PACKS AS NEEDED.
OC2	CEILING MOUNTED DUAL TECH OCCUPANCY SENSOR.	SET TO OCCUPANCY MODE. PROVIDE POWER PACKS AS REQUIRED.
OC3	CEILING MOUNTED ULTRASONIC OR MICROPHONIC OCCUPANCY SENSOR.	SET TO OCCUPANCY MODE. PROVIDE POWER PACKS AS REQUIRED.
OC4	CEILING MOUNTED DUAL TECH OCCUPANCY SENSOR FOR HIGH BAY APPLICATION.	SET TO OCCUPANCY MODE. PROVIDE POWER PACKS AS REQUIRED.
DS	DAYLIGHT HARVESTING SENSOR	CONNECT TO ROOM CONTROLLER OR INDIVIDUAL LIGHT FIXTURE FOR DAYLIGHT HARVESTING DIMMING CONTROL.

- NOTES:
1. COOPER GREENGATE IS THE BASIS OF DESIGN. NO SUBSTITUTION ALLOWED.
  2. LIGHTING CONTROLS SHALL BE PRICED AS AN ALTERNATE. LIGHTING CONTRLS BID SHALL NOT BE PACKAGE WITH THE LIGHT FIXTURE PACKAGE
  3. BASIS OF DESIGN SHALL BE A HARD-WIRED TYPE SYSTEM, UNLESS NOTED OTHERWISE.
  4. PROVIDE ADDITIONAL SET OF CONTACTS ON OCCUPANCY SENSOR TO CONTROL HVAC SETBACK.

NO.	REVISION	DATE
1	Addendum 1	09.23.2024
2	Addendum 2	10.02.2024

**NEW CANEY I.S.D.  
NEW CANEY  
ELEMENTARY SCHOOL**  
19300 VIA CORSICA DRIVE  
NEW CANEY, TX 77357

DATE  
DRAWN BY  
CHECKED BY  
NEW PROJECT NUMBER

**BROWN REYNOLDS WATFORD  
ARCHITECTS**  
4501 MAGNOLIA COVE DRIVE  
SUITE 250  
HOUSTON, TEXAS 77345  
281-361-3800  
[WWW.BRWARCH.COM](http://WWW.BRWARCH.COM)

## E5.1

## ELECTRICAL SCHEDULES



Panelboard 1HB												65000 A AIC Rating X New Existing			
480/277 Vye Volt, 3 Phase, 4 Wire												Mains Type: 0 A -- LUGS: DOUBLE -- Mounting Style: SURFACE			
2 Section															
Type 1 - Nema Rating															
LOAD (VA)		TYPE	DESCRIPTION	WIRE	CB	CKT	CB	WIRE	DESCRIPTION	TYPE	LOAD (VA)	note			
1745 VA	F		KEF-01	12	20 A	1 1 2	50 A	8	HWP-1	M	17458 VA				
						3 4									
						5 6									
						7 8									
						9 10									
1745 VA	F		KEF-02	12	20 A	11 12	50 A	8	HWP-2	M	17458 VA				
						13 14									
						15 16									
						17 18									
						19 20									
0 VA	--	Spare		12	20 A	21 22	60 A	6	CHP-1	MT	22447 VA				
0 VA	--	Spare		12	20 A	23 24									
0 VA	--	Spare		12	20 A	25 26									
0 VA	--	Spare		12	20 A	27 28									
0 VA	--	Spare		12	20 A	29 30									
0 VA	--	Spare		12	20 A	31 32	--	12	Spare	--	0 VA				
0 VA	--	Spare		12	20 A	33 34	--	12	Spare	--	0 VA				
0 VA	--	Spare		12	20 A	35 36	--	12	Spare	--	0 VA				
0 VA	--	Spare		12	--	37 38									
0 VA	--	Spare		12	--	39 40	70 A	4	T1LB	Spare: R: WHL	25030 VA				
0 VA	--	Spare		12	--	41 42									
0 VA	--	Spare		12	20 A	43 44	20 A	12	Spare	--	0 VA				
0 VA	--	Spare		12	20 A	45 46	20 A	12	Spare	--	0 VA				
0 VA	--	Spare		12	20 A	47 48	20 A	12	Spare	--	0 VA				
0 VA	--	Spare		12	20 A	49 50	20 A	12	Spare	--	0 VA				
0 VA	--	Spare		12	20 A	51 52	20 A	12	Spare	--	0 VA				
0 VA	--	Spare		12	20 A	53 54	20 A	12	Spare	--	0 VA				
0 VA	--	Spare		12	--	55 56	--	12	Spare	--	0 VA				
0 VA	--	Spare		12	--	57 58	--	12	Spare	--	0 VA				
0 VA	--	Spare		12	--	59 60	--	12	Spare	--	0 VA				
NEC REF:		Load Type	Conn.	Fct.	Diversity	NEC REF:		Load Type	Conn.	Fct.	Diversity				
220.44	(R)Receptacle	1080 VA	100.00%	1080 VA	210.20A	(L)Lighting									
220.56	(K)Kitchen	1000 VA	100.00%	1000 VA		(EL)Ext. Ltg.									
220.60	(C)Cooling	0 VA		0 VA	620.14	(E)Elevators									
220.60	(H)Heating	8362 VA	100.00%	8362 VA	220.5	(WH)Wat. Htr.	1285 VA	100.00%	1285 VA						
220.60	(F)Fans	62209 VA	100.00%	62209 VA	630.11B	(MT)Lrg. Motor	44894 VA	112.50%	50505 VA						
	(M)Misc.					(SP)Sub Pnl.	0 VA		Not Computed	0 VA					
Total Connected Load:		118830 VA	VA =	143 A	Location of Panel: ELEC 120										
Total Load (Diversified):		124442 VA	VA =	150 A											

Panelboard 1LB												10000 A AIC Rating X New Existing			
120/208 Vye Volt, 3 Phase, 4 Wire						Mains Type:		150 A MCB 225 A BUS (Copper)		-- LUGS: --		Mounting Style: SURFACE			
Type 1 - Nema Rating												2 Section			
WIRE	LOAD (VA)	TYPE	DESCRIPTION	WIRE	CB	1 CKT	CB	WIRE	DESCRIPTION	TYPE	LOAD (VA)	NOTE			
	360 VA	R	RC - RM B128	12	20 A	1	2	20 A	12	EF-02	F	528 VA			
	360 VA	R	RC - RM B129	12	20 A	3	4	20 A	12	VF-01	F	696 VA			
	1000 VA	K	MICROWAVE	12	20 A	5	6	20 A	12	VF-02	F	696 VA			
	4333 VA	M	DRYER	10	30 A	7	8	20 A	12	VF-03	F	696 VA			
				10	30 A	9	10	20 A	12	KEF-03	F	696 VA			
	1000 VA	M	WASHER	12	20 A	11	12	20 A	12	KEF-04	F	684 VA			
	85 VA	WH	CP1-G	12	20 A	13	14	20 A	12	KEF-05	F	696 VA			
	480 VA	WH	GWH-1.2	12	20 A	15	16	20 A	12			--	0 VA		
	720 VA	WH...	WS-1	12	20 A	17	18	20 A	12	FREEZE PROTECTION	M	720 VA			
	66 VA	M	CP-1	12	20 A	19	20	20 A	12	FREEZE PROTECTION	M	720 VA			
				12	20 A	21	22	20 A	10	TAMPER SWITCH	M	360 VA			
	66 VA	M	CP-2	12	20 A	23	24	20 A	12	IRRIGATION CONTROLS	M	360 VA			
				12	20 A	25	26	20 A	12	MOTORIZED VALVES	M	720 VA			
	2704 VA	M	B-01	12	20 A	27	28	20 A	12	MOTORIZED DAMPERS	M	540 VA			
				12	20 A	29	30	20 A	12	RC - RM B129	R	180 VA			
	2704 VA	M	B-02	12	20 A	31	32	20 A	12	RC - RM B129	R	180 VA			
				12	20 A	33	34								
	500 VA	M	GEN BATTERY CHRNG	12	20 A	35	36	30 A	10	SPD2	SP	0 VA			
	500 VA	M	GEN ANTI CONDENSATE	12	20 A	37	38					--	0 VA		
	1500 VA	M	GEN JACKET HEATER	12	20 A	39	40					--	0 VA		
				12	20 A	41	42	20 A	12	Spare	--	0 VA			
	0 VA	--	Spare	12	20 A	43	44	20 A	12	Spare	--	0 VA			
	0 VA	--	Spare	12	20 A	45	46	20 A	12	Spare	--	0 VA			
	0 VA	--	Spare	12	20 A	47	48	20 A	12	Spare	--	0 VA			
	0 VA	--	Spare	12	20 A	49	50	20 A	12	Spare	--	0 VA			
	0 VA	--	Spare	12	20 A	51	52	20 A	12	Spare	--	0 VA			
	0 VA	--	Spare	12	20 A	53	54	20 A	12	Spare	--	0 VA			
	0 VA	--	Spare	12	--	55	56	--	12	Spare	--	0 VA			
	0 VA	--	Spare	12	--	57	58	--	12	Spare	--	0 VA			
	0 VA	--	Spare	12	--	59	60	--	12	Spare	--	0 VA			
NEC REF:	Load Type	Conn.	Fct.	Diversity	NEC REF:	Load Type	Conn.	Fct.	Diversity						
220.44	(R)Receptacle	1080 VA	100.00%	1080 VA	210.20A	(L)Lighting						Location of Panel: ELEC 120			
220.56	(K)Kitchen	1000 VA	100.00%	1000 VA		(EL)Ext. Ltg.									
220.60	(C)Cooling	0 VA		620.14		(E)Elevators									
220.60	(H)Heating	4872 VA	100.00%	4872 VA	220.5	(WH)Wat. Htr.	1285 VA	100.00%	1285 VA						
220.60	(F)Fans	16793 VA	100.00%	16793 VA	630.11B	(MT)Lrg. Motor	0 VA		Not Computed	0 VA					
	(M)Misc.					(SP)Sub Pnl.									
						(W)Welders									
Total Connected Load:				25030 VA	VA =	69 A									
Total Load (Diversified):				25030 VA	VA =	69 A									

Panelboard 1HA											65000 A AIC Rating X New Existing		
480/277 Vye Volt, 3 Phase, 4 Wire				Mains Type:		225 A MCB		--		LUGS: --		Mounting Style: SURFACE	
1 Section				MCB		225 A BUS (Copper)							
Type 1 - Nema Rating													
WIRE	LOAD (VA)	TYPE	DESCRIPTION	WIRE	CB	1 CKT	CB	WIRE	DESCRIPTION	TYPE	LOAD (VA)	note	
0 VA	--	--	Spare	12	20 A	1	2	20 A	12	LIGHTING	L	1350 VA	
1840 VA	L	--	LIGHTING	12	20 A	3	4	20 A	12	LIGHTING	L	720 VA	
2122 VA	L	--	LIGHTING	12	20 A	5	6	20 A	12	LIGHTING	L	1815 VA	
238 VA	EL	--	EXTERIOR LTG AREA A	12	20 A	7	8	20 A	12	SITE POLE LIGHTS	EL	2706 VA	
1397 VA	EL	--	EXTERIOR LTG AREA A	12	20 A	9	10	20 A	12	FLAG POLE LIGHTS	EL	134 VA	
0 VA	--	--	Spare	12	20 A	11	12	20 A	12	CORRIDOR LIGHTING	L	992 VA	
0 VA	--	--	Spare	12	20 A	13	14	15 A	12	FFTU1-1-06	F	720 VA	
1838 VA	F, M	--	SP-02	12	20 A	15	16	15 A	12	FFTU1-1-07	F	720 VA	
0 VA	--	--	Spare	12	20 A	17	18	15 A	12	FFTU1-1-08	F	720 VA	
0 VA	--	--	Spare	12	20 A	19	20	15 A	12	FFTU1-1-09	F	1136 VA	
11639 VA	F	--	AHU-01	8	35 A	21	22	15 A	12	FFTU1-1-10	F	720 VA	
0 VA	--	--	Spare	12	20 A	23	24	15 A	12	FFTU1-1-11	F	1136 VA	
0 VA	--	--	Spare	12	20 A	25	26	15 A	12	FFTU1-1-13	F	1136 VA	
0 VA	--	--	Spare	12	20 A	27	28	15 A	12	FFTU1-1-09	F	720 VA	
0 VA	--	--	Spare	12	20 A	29	30	15 A	12	FFTU1-1-10	F	720 VA	
720 VA	F	--	FFTU1-1-01	12	15 A	33	34	15 A	12	FFTU1-1-12	F	1136 VA	
1136 VA	F	--	FFTU1-1-02	12	15 A	35	36						
720 VA	F	--	FFTU1-1-03	12	15 A	37	38						
720 VA	F	--	FFTU1-1-04	12	15 A	39	40						
0 VA	--	--	Spare	12	15 A	41	42						
0 VA	--	--	Spare	12	20 A	43	44	40 A	8	ACCU-01	C	21482 VA	
0 VA	--	--	Spare	12	20 A	45	46						
0 VA	--	--	Spare	12	20 A	47	48	20 A	12	Spare	--	0 VA	
0 VA	--	--	Spare	12	20 A	49	50	20 A	12	Spare	--	0 VA	
0 VA	--	--	Spare	12	20 A	51	52	20 A	12	Spare	--	0 VA	
0 VA	--	--	Spare	12	20 A	53	54	20 A	12	Spare	--	0 VA	
0 VA	--	--	Spare	12	20 A	55	56						
0 VA	--	--	Spare	12	20 A	57	58	125 A	1 A	T1LA	Spare: R: 86547 VA		
0 VA	--	--	Spare	12	20 A	59	60						
NEC REF:	Load Type	Conduct.	Fct.	Diversity	NEC REF:	Load Type	Conn.	Fct.	Diversity				
220.44	(R)Receptacle	39690 VA	62.00%	24840 VA	210.20A	(L)Lighting	8797 VA	125.00%	10996 VA				
220.56	(K)Kitchen	5400 VA	65.00%	3510 VA	(EL)Ext. Lgt.	8327 VA	125.00%	10409 VA					
220.60	(C)Cooling	21482 VA	100.00%	21482 VA	(E)Elevators								
220.60	(H)Heating			0 VA	(W)HWH: Htr.	6085 VA	100.00%	6085 VA					
220.60	(F)Fans	32420 VA	100.00%	32420 VA	(MT)Log. Motor								
	(M)Misc.	30439 VA	100.00%	30439 VA	(SP)Spa Pmt. (W) Welders	0 VA	Not Computed	0 VA					
Total Connected Load:				152629 VA	VA =	184 A	Location of Panel: MECH 106						
Total Load (Diversified):				104180 VA	VA =	169 A							



Panelboard 1HD													65004 A/C Rating X New Existing	
480/277 Vye Volt, 3 Phase, 4 Wire				Mains Type:	225 A MCB				--	LUGS: --		Mourning Style:		
2 Section				MCB	225 A BUS (Copper)				--	FEED THRU		SURFACE		
NOTE	Type 1 -Nema Rating				WIRE	CB	CKT	CB	WIRE	DESCRIPTION	TYPE	LOAD (VA)	NOTE	
	0 VA	--			12	20	A 1	2	20 A	--	Spare	--	0 VA	
	1640 VA	L			12	20	A 3	4	20 A	12	LIGHTING	--	1085 VA	
	1920 VA	L			12	20	A 5	6	20 A	12	LIGHTING	--	1920 VA	
	1920 VA	L			12	20	A 7	8	20 A	12	LIGHTING	--	1760 VA	
	2600 VA	L			12	20	A 9	10	20 A	12	LIGHTING	--	2400 VA	
	2660 VA	L			12	20	A 11	12	20 A	12	LIGHTING	--	2660 VA	
	1760 VA	L			12	20	A 13	14	20 A	12	LIGHTING	--	1600 VA	
	238 VA	EL			12	20	A 15	16	20 A	12	EXTERIOR LTS. AREA C.D.E	EL	147 VA	
	172 VA	EL			12	20	A 17	18	15 A	12	FPTU-9-07	F	720 VA	
	1136 VA	F			12	15 A	19	20	15 A	12	FPTU-9-08	F	720 VA	
	720 VA	F			12	15 A	21	22	15 A	12	FPTU-9-09	F	720 VA	
	720 VA	F			12	15 A	23	24	15 A	12	FPTU-9-10	F	720 VA	
	720 VA	F			12	15 A	25	26	15 A	12	FPTU-9-11	F	720 VA	
	720 VA	F			12	15 A	27	28	15 A	12	FPTU-9-12	F	720 VA	
	720 VA	F			12	15 A	29	30	15 A	12	FPTU-9-13	F	720 VA	
	720 VA	F			12	15 A	31	32	15 A	12	FPTU-9-14	F	720 VA	
	720 VA	F			12	15 A	33	34	15 A	12	FPTU-9-15	F	720 VA	
	720 VA	F			12	15 A	35	36	15 A	12	FPTU-9-16	F	720 VA	
	720 VA	F			12	15 A	37	38	15 A	12	FPTU-9-01	F	720 VA	
	720 VA	F			12	15 A	39	40	15 A	12	FPTU-9-02	F	1524 VA	
	720 VA	F			12	15 A	41	42	15 A	12	FPTU-9-03	F	720 VA	
	3990 VA	F, M				43	44				SF-08	F, M	3990 VA	
					12	20	A 45	46	20 A	12				
						47	48							
						49	50							
	3990 VA	F, M			12	20	A 51	52	20 A	12	SF-09	F, M	3990 VA	
						53	54							
	720 VA	F			12	15 A	55	56	15 A	12	FPTU-6-05	F	720 VA	
	720 VA	F			12	15 A	57	58	15 A	12	FPTU-6-06	F	720 VA	
	720 VA	F			12	15 A	59	60	15 A	12	FPTU-6-07	F	720 VA	
	720 VA	F			12	15 A	61	62	15 A	12	FPTU-6-08	F	720 VA	
	720 VA	F			12	15 A	63	64	15 A	12	FPTU-6-09	F	720 VA	
	720 VA	F			12	15 A	65	66	15 A	12	FPTU-6-10	F	720 VA	
	720 VA	F			12	15 A	67	68	15 A	12	FPTU-6-11	F	1136 VA	
	720 VA	F			12	15 A	69	70	15 A	12	FPTU-6-12	F	720 VA	
	720 VA	F			12	15 A	71	72	15 A	12	FPTU-6-12	F	720 VA	
	1136 VA	F			12	15 A	73	74	15 A	12	FPTU-6-13	F	720 VA	
	1136 VA	F			12	15 A	75	76	15 A	12	FPTU-9-04	F	720 VA	
	720 VA	F			12	15 A	77	78	15 A	12	FPTU-6-01	F	720 VA	
	720 VA	F			12	15 A	79	80	--	12	Space	--	0 VA	
	720 VA	F			12	15 A	81	82	--	12	Space	--	0 VA	
	720 VA	F			12	15 A	83	84	--	12	Space	--	0 VA	
NEC REF:	Load Type	Conn.			Fct.	Diversity	NEC REF:	Load Type	Conn.		Fct.	Diversity		
220.44	(R)Receptacle						210.20(A)	(L)Lighting			25375 VA	125.00%	6966 VA	
220.56	(K)Kitchen						(E)Elect. Ltg.			557 VA	125.00%	2968 VA		
220.60	(C)Cooling					0 VA	620.14	(E)Elevators						
220.60	(H)Heating					0 VA		(W)Htng. Htr.						
220.60	(F)Fans	114393 VA	100.00%			114393 VA	220.5	(A)T.Ltg. Motor (Sp.Su. Pnt.)						
	(M)Misc.						630.11(B)	(W)Welders						
Total Connected Load:				138685 VA	VA	=	167 A	Location of Panel: ELEC 331E						
Total Load (Diversified):				144758 VA	VA	=	174 A							

Panelboard 1HD1										6500 A I/C Rating X New Existing			
480/277 Vwye Volt, 3 Phase, 4 Wire Mains Type:					0 A --		LUGS: SINGLE		Mounting Style: SURFACE				
2 Section					225 A BUS (Copper)		FEED THRU						
Type 1 -Nema Rating					MLO								
NOTE	LOAD (VA)	TYPE	DESCRIPTION		WIRE	CB	OCT	CB	WIRE	DESCRIPTION	TYPE	LOAD (VA)	NOTE
	22447 VA	F	AHU-06		6	60 A	3 4 5 6 7 8	50 A	8	AHU-08	F	17458 VA	
	3325 VA	F	AHU-06-EF		12	15 A	9 10 11 12	15 A	12	AHU-08-EF	F	3325 VA	
	1330 VA	F	AHU-06-ERV		12	15 A	13 14 15 16 17 18	15 A	12	AHU-08-ERV	F	1330 VA	
	3325 VA	F	AHU-07-EF		12	15 A	19 20 21 22 23 24	15 A	12	AHU-09-EF	F	3325 VA	
	1330 VA	F	AHU-07-ERV		12	15 A	25 26 27 28 29 30	15 A	12	AHU-09-ERV	F	1330 VA	
	0 VA	--	Spare		12	20 A	31 32	20 A	12	Spare	--	0 VA	
	0 VA	--	Spare		12	20 A	33 34	20 A	12	Spare	--	0 VA	
	0 VA	--	Spare		12	20 A	35 36	20 A	12	Spare	--	0 VA	
	0 VA	--	Spare		12	20 A	37 38	20 A	12	Spare	--	0 VA	
	0 VA	--	Spare		12	20 A	39 40	20 A	12	Spare	--	0 VA	
	0 VA	--	Spare		12	20 A	41 42	20 A	12	Spare	--	0 VA	
	0 VA	--	Spare		12	20 A	43 44	20 A	12	Spare	--	0 VA	
	0 VA	--	Spare		12	20 A	45 46	20 A	12	Spare	--	0 VA	
	0 VA	--	Spare		12	20 A	47 48	20 A	12	Spare	--	0 VA	
	0 VA	--	Spare		12	--	49 50	--	12	Space	--	0 VA	
	0 VA	--	Spare		12	--	51 52	--	12	Space	--	0 VA	
	0 VA	--	Spare		12	--	53 54	--	12	Space	--	0 VA	
	0 VA	--	Spare		12	--	55 56	--	12	Space	--	0 VA	
	0 VA	--	Spare		12	--	57 58	--	12	Space	--	0 VA	
	0 VA	--	Spare		12	--	59 60	--	12	Space	--	0 VA	
NEC REF:	Load Type	Conn.	Fct.	Diversity	NEC REF:	Load Type	Conn.	Fct.	Diversity				
220.42	(R)Receptacle				210.20A	(L)Lighting							
220.56	(K)Kitchen					(E)Ext. Ltg.							
220.60	(C)Cooling			0 VA	620.14	(E)Elevators							
220.60	(H)Heating			0 VA		(WH)Wat. Htr.							
220.60	(F)Fans	58525 VA	100.00%	58525 VA	220.5	(MT)Lrg. Motor							
	(M)Misc.				630.11B	(SP)Sub Pnl. (WP)Warders							
Total Connected Load:		58525 VA	VA =	70 A	Location of Panel: ELEC 331E								
Total Load (Diversified):		58525 VA	VA =	70 A									

Panelboard 1LC													1000 A AIC Rating		
													X New		
120/208 Vylt Vltl 3 Phase, 4 Wire													Existing		
2 Section													Mounting Style:		
Maina Type:													SURFACE		
MCB															
400 A MCB													LUGS: --		
250 A VCB (Copper)													FEED THRU		
Type 1 -Nema Rating															
NOTE	LOAD (VA)	TYPE	DESCRIPTION	WIRE	CB	CKT	1	2	3	4	WIRE	DESCRIPTION	TYPE	LOAD (VA)	NOTE
	720 VA	R	RC -RM D112	10	20 A	1	12	20 A	12		12	RC -RM C107	R	360 VA	
	720 VA	R	RC -RM D112	10	20 A	3	4	20 A	12		12	RC -RM C107	R	720 VA	
	720 VA	R	RC -RM d112	10	20 A	5	6	20 A	12		12	RC -RM C107	R	1080 VA	
	720 VA	R	RC -RM D111	10	20 A	7	8	20 A	12		12	RC -RM C118	R	360 VA	
	720 VA	R	RC -RM D111	10	20 A	9	10	20 A	12		12	RC -RM C118	R	720 VA	
	720 VA	R	RC -RM D111	10	20 A	11	12	20 A	12		12	RC -RM C118	R	1080 VA	
	720 VA	R	RC -RM D108	10	20 A	13	14	20 A	10		10	RC -RM C110	R	360 VA	
	720 VA	R	RC -RM D108	10	20 A	15	16	20 A	10		10	RC -RM C110	R	720 VA	
	720 VA	R	RC -RM D108	10	20 A	17	18	20 A	10		10	RC -RM C110	R	1080 VA	
	720 VA	R	RC -RM D105	10	20 A	19	20	20 A	12		12	RC -RM C115	R	360 VA	
	720 VA	R	RC -RM D105	10	20 A	21	22	20 A	12		12	RC -RM C115	R	720 VA	
	720 VA	R	RC -RM D105	10	20 A	23	24	20 A	12		12	RC -RM C115	R	1080 VA	
	720 VA	R	RC -RM D106	10	20 A	25	26	20 A	10		10	RC -RM C112	R	360 VA	
	720 VA	R	RC -RM D106	10	20 A	27	28	20 A	10		10	RC -RM C112	R	720 VA	
	720 VA	R	RC -RM D106	10	20 A	29	30	20 A	10		10	RC -RM C112	R	1080 VA	
	720 VA	R	RC -RM D107	10	20 A	31	32	20 A	10		10	RC -RM C113	R	360 VA	
	720 VA	R	RC -RM D107	10	20 A	33	34	20 A	10		10	RC -RM C113	R	720 VA	
	720 VA	R	RC -RM D107	10	20 A	35	36	20 A	10		10	RC -RM C113	R	1080 VA	
	720 VA	R	RC -RM D110	12	20 A	37	38								
	720 VA	R	RC -RM D110	12	20 A	39	40	30 A	10		10	SPD2	SP	0 VA	
	720 VA	R	RC -RM D110	12	20 A	41	42								
	720 VA	R	RC -RM D113	12	20 A	43	44	20 A	10		10	RC -RM C128	R	360 VA	
	720 VA	R	RC -RM D113	12	20 A	45	46	20 A	10		10	RC -RM C128	R	720 VA	
	720 VA	R	RC -RM D113	12	20 A	47	48	20 A	10		10	RC -RM C128	R	1080 VA	
	720 VA	R	RC -RM D142	12	20 A	49	50	20 A	10		10	RC -RM C129	R	360 VA	
	720 VA	R	RC -RM D142	12	20 A	51	52	20 A	10		10	RC -RM C129	R	720 VA	
	720 VA	R	RC -RM D142	12	20 A	53	54	20 A	10		10	RC -RM C129	R	1080 VA	
	720 VA	R	RC -RM D140	12	20 A	55	56	20 A	12		12	RC -RM C126	R	360 VA	
	720 VA	R	RC -RM D140	12	20 A	57	58	20 A	12		12	RC -RM C126	R	720 VA	
	720 VA	R	RC -RM D140	12	20 A	59	60	20 A	12		12	RC -RM C126	R	1080 VA	
	720 VA	R	RC -RM D143	12	20 A	61	62	20 A	12		12	RC -RM C131	R	360 VA	
	720 VA	R	RC -RM D143	12	20 A	63	64	20 A	12		12	RC -RM C131	R	720 VA	
	720 VA	R	RC -RM D143	12	20 A	65	66	20 A	12		12	RC -RM C131	R	1080 VA	
	720 VA	R	RC -RM D139	12	20 A	67	68	20 A	10		10	RC -RM C123	R	360 VA	
	720 VA	R	RC -RM D139	12	20 A	69	70	20 A	10		10	RC -RM C123	R	720 VA	
	720 VA	R	RC -RM D139	12	20 A	71	72	20 A	12		12	RC -RM C123	R	1080 VA	
	720 VA	R	RC -RM D138	12	20 A	73	74	20 A	10		10	RC -RM C134	R	360 VA	
	720 VA	R	RC -RM D138	12	20 A	75	76	20 A	10		10	RC -RM C134	R	720 VA	
	720 VA	R	RC -RM D138	12	20 A	77	78	20 A	12		12	RC -RM C134	R	1080 VA	
	0 VA	--	Spare	12	20 A	79	80	--	--		--	Space	--	0 VA	
	0 VA	--	Spare	12	20 A	81	82	--	--		--	Space	--	0 VA	
	0 VA	--	Spare	12	20 A	83	84	--	--		--	Space	--	0 VA	
NEC REF:	Load Type	Code	Fct.	Overlyt	NEC REF:	Load Type	Code	Fct.	Overlyt	NEC REF:	Load Type	Code	Fct.	Overlyt	NEC REF:
220.44	(R)Receptacle	86120 VA	55.81%	48060 VA	210.20A	(L)Lighting				(L)Ext. Ltg.					
220.60	(K)Kitchen			0 VA	620.14	(E)Elevators				(W)Wat. Htr.					
220.60	(C)Cooling			0 VA		(MT)Jnt. Motor				(SP)Sub Pnl.	0 VA	Not Computed		0 VA	
220.60	(F)Fans	7913 VA	100.00%	7913 VA	220.5	(W)Welders									
	(M)Misc.				630.11B										
Total Connected Load:				94033 VA	VA =	261 A	Location of Panel: ELEC 307A								
Total Load (Diversified):				55973 VA	VA =	165 A									

Panelboard 1LC1											10000 A/c Rating		
											X New		
120/208 Vwlt. Vol. 3 Phase, 4 Wire				Mainns Type:		0 0 A / B (Copper)		--		LUGS: SINGLE		Existing	
2 Section				MLO						Mourning Style:		SURFACE	
Type 1 - Nema Rating													
NOTE	LOAD (VA)	TYPE	DESCRIPTION	WIRE	CB	CKT	CB	WIRE	DESCRIPTION	TYPE	LOAD (VA)	NOTE	
	900 VA	R	RC- RM D135	12	20 A	1	2	20 A	12	RC- RM C120 122.	R	360 VA	
	900 VA	R	RC- RM D135	12	20 A	1	3	20 A	12	RC- RM C106	R	900 VA	
	720 VA	R	RC- RM D133	12	20 A	5	6	20 A	12	RC- RM C135	R	900 VA	
	900 VA	R, M	RC- RM D133	12	20 A	7	8	20 A	12	RC- RM B101	R	540 VA	
	360 VA	R	RC- RM D134	12	20 A	9	10	20 A	12	RC- RM B101	R	360 VA	
	360 VA	R	RC- RM D136	12	20 A	11	12	20 A	12	RC- RM B101	R	360 VA	
	720 VA	R	RC- RM D132	12	20 A	13	14	20 A	12	Spare		0 VA	
	720 VA	R	RC- RM D132	12	20 A	15	16	20 A	12	RC- RM B101	R, M	1860 VA	
	720 VA	R	RC- RM D132	12	20 A	17	18	20 A	12	RC- RM B101	R	540 VA	
	1080 VA	R	RC- RM D123	12	20 A	19	20	20 A	12	RC- RM B105	R	1080 VA	
	1080 VA	R	RC- RM D124	12	20 A	21	22	20 A	12	RC- RM B102 103	R	720 VA	
	540 VA	R	RC- RM D122, 125, 126	12	20 A	23	24	20 A	12	Spare		0 VA	
	360 VA	R	RC- RM D130	12	20 A	25	26	20 A	12	RC- RM B107	R	540 VA	
	900 VA	R	RC- RM D130	12	20 A	27	28	20 A	12	Spare		0 VA	
	540 VA	R, M	RC- RM D127, 128, 129	12	20 A	29	30	20 A	12	RC- RM B107	R	720 VA	
	900 VA	R	RC- RM D128	12	20 A	31	32	20 A	12	RC- RM B107	R	720 VA	
	540 VA	R, M	RC- RM A142	12	20 A	33	34	15 A	12	EDF	R	400 VA	
	360 VA	R	RC- RM A142	12	20 A	35	36	15 A	12	EDF	R	400 VA	
	540 VA	R	RC- RM A142	12	20 A	37	38	15 A	12	EDF	R	400 VA	
	400 VA	R	EDF	12	15 A	39	40	15 A	12	EDF	R	400 VA	
	400 VA	R	EDF	12	15 A	41	42	15 A	12	EDF	R	400 VA	
	400 VA	R	EDF	12	15 A	43	44	15 A	10	EDF	R	400 VA	
	720 VA	R	CORRIDOR	12	20 A	45	46	15 A	10	EDF	R	400 VA	
	540 VA	R	CORRIDOR	12	20 A	47	48	15 A	10	EDF	R	400 VA	
	540 VA	R	WP/GFCI	12	20 A	49	50	20 A	12	CORRIDOR	R	360 VA	
	4333 VA	M	DRYER	10	30 A	51	52	20 A	12	CORRIDOR	R	1080 VA	
	1000 VA	M	WASHER	10	30 A	53	54	20 A	12	CORRIDOR	R	540 VA	
	720 VA	R	EXTERIOR PARKING	10	20 A	55	56	20 A	12	CORRIDOR	R	720 VA	
	360 VA	R	RC- RM B107	12	20 A	59	60	20 A	12	LOCAL SOUND SPEAKER	M	720 VA	
	360 VA	R	RC- RM B107	12	20 A	61	62	20 A	12	Spare		0 VA	
	0 VA	--	Spare	12	20 A	63	64	20 A	12	Spare		0 VA	
	0 VA	--	Spare	12	20 A	65	66	20 A	12	Spare		0 VA	
	0 VA	--	Spare	12	20 A	67	68	20 A	12	Spare		0 VA	
	0 VA	--	Spare	12	20 A	69	70	20 A	12	Spare		0 VA	
	0 VA	--	Spare	12	20 A	71	72	20 A	12	Spare		0 VA	
	0 VA	--	Spare	12	--	73	74	--	12	Spare		0 VA	
	0 VA	--	Spare	12	--	75	76	--	12	Spare		0 VA	
	0 VA	--	Spare	12	--	77	78	--	12	Spare		0 VA	
	0 VA	--	Spare	12	--	79	80	--	12	Spare		0 VA	
	0 VA	--	Spare	12	--	81	82	--	12	Spare		0 VA	
	0 VA	--	Spare	12	--	83	84	--	12	Spare		0 VA	
NEC REF:	Load Type	Conn.	Fct.	Diversity	NEC REF:	Load Type	Conn.	Fct.	Diversity				
220.44	(R)Receptacle	32120 VA	65.57%	21060 VA	210.20A	(L)Ext. Ltg.							
220.56	(K)Kitchen					(E)Elevators							
220.60	(C)Cooling			0 VA	620.14	(WH)Wat. Htr.							
220.62	(H)Heating			0 VA		(L)Eng. Motors							
220.60	(F)Fans				220.5	(SP)Sub-Pnl.							
220.60	(M)Misc.	7913 VA	100.00%	7913 VA	620.11B	(W)Welders							
Total Connected Load:				40033 VA	VA =	111 A	Location of Panel: ELEC 307A						
Total Load (Diversified):				28973 VA	VA =	80 A							

Panelboard 1LD											1000 A A/C Rating		
											X New Existing		
120/208 Vye Wkt, 3 Phase, 4 Wire			Mains Type:		250 A MCB			Shunt Trip Main		LUGS: --		Mounting Style: SURFACE	
2 Section					250 A BUS (Copper)			FEED THRU					
Type 1 - Nema Rating					Isolated Ground Bus								
WIRE	LOAD (VA)	TYPE	DESCRIPTION		WIRE	CB	CKT	CB	WIRE	DESCRIPTION	TYPE	LOAD (VA)	NOTE
720 V/A	R	RC - RM E118	12	20 A	1	12	20 A	10	RC - RM E114	R	720 V/A		
720 V/A	R	RC - RM E118	12	20 A	3	4	20 A	10	RC - RM E114	R	720 V/A		
720 V/A	R	RC - RM E118	12	20 A	5	6	20 A	10	RC - RM E114	R	720 V/A		
720 V/A	R	RC - RM E122	12	20 A	7	8	20 A	12	RC - RM E105	R	720 V/A		
720 V/A	R	RC - RM E122	12	20 A	9	10	20 A	12	RC - RM E105	R	720 V/A		
720 V/A	R	RC - RM E122	12	20 A	11	12	20 A	12	RC - RM E105	R	720 V/A		
720 V/A	R	RC - RM E125	10	20 A	13	14	20 A	10	RC - RM E104	R	720 V/A		
720 V/A	R	RC - RM E125	10	20 A	15	16	20 A	10	RC - RM E104	R	720 V/A		
720 V/A	R	RC - RM E125	10	20 A	17	18	20 A	10	RC - RM E104	R	720 V/A		
720 V/A	R	RC - RM E120	12	20 A	19	20	20 A	10	RC - RM E100	R	720 V/A		
720 V/A	R	RC - RM E120	12	20 A	21	22	20 A	10	RC - RM E100	R	720 V/A		
720 V/A	R	RC - RM E120	12	20 A	23	24	20 A	10	RC - RM E100	R	720 V/A		
720 V/A	R	RC - RM E121	10	20 A	25	26	20 A	12	RC - RM E106	R	720 V/A		
720 V/A	R	RC - RM E121	10	20 A	27	28	20 A	12	RC - RM E106	R	720 V/A		
720 V/A	R	RC - RM E121	10	20 A	29	30	20 A	12	RC - RM E106	R	720 V/A		
720 V/A	R	RC - RM E126	10	20 A	31	32	20 A	12	RC - RM E103	R	720 V/A		
720 V/A	R	RC - RM E126	10	20 A	33	34	20 A	12	RC - RM E103	R	720 V/A		
720 V/A	R	RC - RM E126	10	20 A	35	36	20 A	12	RC - RM E103	R	720 V/A		
720 V/A	R	RC - RM E110	12	20 A	37	38							
720 V/A	R	RC - RM E110	12	20 A	39	40	30 A	10	SPD2	SP	0 V/A		
720 V/A	R	RC - RM E110	12	20 A	41	42							
720 V/A	R	RC - RM E112	12	20 A	43	44	20 A	10	RC - RM E101	R	720 V/A		
720 V/A	R	RC - RM E112	12	20 A	45	46	20 A	10	RC - RM E101	R	720 V/A		
720 V/A	R	RC - RM E112	12	20 A	47	48	20 A	10	RC - RM E101	R	720 V/A		
720 V/A	R	RC - RM E113	10	20 A	49	50	20 A	12	RC - RM C103	R	720 V/A		
720 V/A	R	RC - RM E113	10	20 A	51	52	20 A	12	RC - RM C103	R	720 V/A		
720 V/A	R	RC - RM E113	10	20 A	53	54	20 A	12	RC - RM C103	R	720 V/A		
720 V/A	R	RC - RM E116	12	20 A	55	56	20 A	12	RC - RM C101	R	720 V/A		
720 V/A	R	RC - RM E116	12	20 A	57	58	20 A	12	RC - RM C101	R	720 V/A		
720 V/A	R	RC - RM E116	12	20 A	59	60	20 A	12	RC - RM C101	R	720 V/A		
720 V/A	R	RC - RM E115	12	20 A	61	62	20 A	12	RC - RM C104	R	720 V/A		
720 V/A	R	RC - RM E115	12	20 A	63	64	20 A	12	RC - RM C104	R	720 V/A		
720 V/A	R	RC - RM E115	12	20 A	65	66	20 A	12	RC - RM C104	R	720 V/A		
0 V/A	--	Spare	12	20 A	67	68	20 A	12	Spare	--	0 V/A		
0 V/A	--	Spare	12	20 A	69	70	20 A	12	Spare	--	0 V/A		
0 V/A	--	Spare	12	20 A	71	72	20 A	12	Spare	--	0 V/A		
0 V/A	--	Spare	12	20 A	73	74	20 A	12	Spare	--	0 V/A		
0 V/A	--	Spare	12	20 A	75	76	20 A	12	Spare	--	0 V/A		
0 V/A	--	Spare	12	20 A	77	78	20 A	12	Spare	--	0 V/A		
0 V/A	--	Spare	12	20 A	79	80	20 A	12	Spare	--	0 V/A		
0 V/A	--	Spare	12	20 A	81	82	20 A	12	Spare	--	0 V/A		
0 V/A	--	Spare	12	20 A	83	84	20 A	12	Spare	--	0 V/A		
NEC Ref.	Load Type	Code	Fct.		NEC Ref.	Load Type	Code		Conn.	Fct.	Diversity		
220.44	(R)Receptacle	7340 VA	56.84%	4150 VA	210.20A	(LJ)Lighting							
220.56	(K)Kitchen	1200 VA	100.00%	1200 VA		(EJ)Ext. Ltg.							
220.60	(C)Cooling	0 VA		0 VA	620.14	(E)Elevators							
220.60	(H)Heating	0 VA		0 VA	(WH)Watr.	9085 VA	100.00%	9085 VA					
220.60	(F)Fans	2616 VA	100.00%	2616 VA	220.5	(M)Motor							
	(M)Misc.	1440 VA	100.00%	1440 VA		(SP)Sub Pnl.	0 VA	Not Computed				0 VA	
					630.11B	(W)Warders							
Total Connected Load:			87481 VA	VA =	243 A	Location of Panel: ELEC 331E							
Total Load (Diversified):			55911 VA	VA =	155 A								

Panelboard 1LD1										10000 A/C Rating X New Existing		
120/208 Vyle Vot, 3 Phase, 4 Wire				Mains Type:		0 A - --		LUGS: DOUBLE		Mounting Site: SURFACE		
2 Section				MLO		250 A BUS (Copper)		FEED THRU				
Load Type - Nema Rating												
NOTE	LOAD (VA)	TYPE	DESCRIPTION	WIRE	CB	OKT	CB	WIRE	DESCRIPTION	TYPE	LOAD (VA)	NOTE
	720 VA	R	RC - RM C100	12	20 A	3	4	20 A	12	RC - RM E108,109,117	R	540 VA
	720 VA	R	RC - RM C100	12	20 A	3	4	20 A	12	RC - RM D151,152,153	R	540 VA
	720 VA	R	RC - RM C100	12	20 A	5	6	20 A	12	RC - RM D144,147	R	360 VA
	540 VA	R	RC - RM D100	12	20 A	7	8	20 A	12	CORRIDOR	R	360 VA
	360 VA	R	RC - RM D100	12	20 A	9	10	20 A	12	CORRIDOR	R	720 VA
	1080 VA	R	RC - RM D100	12	20 A	11	12	20 A	12	CORRIDOR	R	720 VA
	540 VA	R	RC - RM D100	12	20 A	13	14	20 A	12	CORRIDOR	R	720 VA
	360 VA	R	RC - RM D100	12	20 A	15	16	20 A	12	CORRIDOR	R	360 VA
	1080 VA	R	RC - RM D103	12	20 A	17	18	20 A	12	CORRIDOR	R	540 VA
	540 VA	R	RC - RM D103	12	20 A	19	20	20 A	12	CORRIDOR	R	720 VA
	360 VA	R	RC - RM D103	12	20 A	21	22	20 A	12	CORRIDOR	R	360 VA
	1080 VA	R	RC - RM D103	12	20 A	23	24	15 A	12	EDF	R	400 VA
	540 VA	R	RC - RM D103	12	20 A	25	26	15 A	12	EDF	R	400 VA
	360 VA	R	RC - RM D103	12	20 A	27	28	15 A	12	EDF	R	400 VA
	1080 VA	R	RC - RM D103	12	20 A	29	30	15 A	12	EDF	R	400 VA
	720 VA	R	RC - RM D101	12	20 A	31	32	15 A	12	EDF	R	400 VA
	540 VA	R	RC - RM D101	12	20 A	33	34	15 A	12	EDF	R	400 VA
	720 VA	R	RC - RM D101	12	20 A	35	36	20 A	12	EXTERIOR RECEPTACLE	R	1080 VA
	720 VA	R	RC - RM D101	12	20 A	37	38	--	12	Space	--	0 VA
	360 VA	R	RC - RM D101	12	20 A	39	40	--	12	Space	--	0 VA
	540 VA	R	RC - RM D101	12	20 A	41	42	--	12	Space	--	0 VA
	720 VA	R	RC - RM D102	12	20 A	43	44	--	12	Space	--	0 VA
	360 VA	R	RC - RM D102	12	20 A	45	46	40 A	8	EWH-3	WH	9000 VA
	720 VA	R	RC - RM D102	12	20 A	47	48	--	12	Space	--	0 VA
	1200 VA	K	REFRIGERATOR	12	20 A	49	50	20 A	12	CP-3	WH	85 VA
	720 VA	R	RC - RM D150	12	20 A	51	52	20 A	12	MOTORIZED DAMPERS	M	720 VA
	1200 VA	K	REFRIGERATOR	12	20 A	53	54	20 A	12	MOTORIZED DAMPERS	M	720 VA
	540 VA	R	RC - RM D148	12	20 A	55	56	20 A	12	EF-05	F	528 VA
	900 VA	R	RC - RM D148	12	20 A	57	58	20 A	12	EF-06	F	696 VA
	0 VA	--	Space	12	20 A	59	60	20 A	12	EF-07	F	696 VA
	0 VA	--	Space	12	20 A	61	62	20 A	12	EF-08	F	696 VA
	0 VA	--	Space	12	20 A	63	64	20 A	12	Spare	--	0 VA
	0 VA	--	Space	12	20 A	65	66	20 A	12	Spare	--	0 VA
	0 VA	--	Space	12	20 A	67	68	20 A	12	Spare	--	0 VA
	0 VA	--	Space	12	20 A	69	70	20 A	12	Spare	--	0 VA
	0 VA	--	Space	12	20 A	71	72	20 A	12	Spare	--	0 VA
	0 VA	--	Space	12	20 A	73	74	20 A	12	Spare	--	0 VA
	0 VA	--	Space	12	20 A	75	76	20 A	12	Spare	--	0 VA
	0 VA	--	Space	12	20 A	77	78	20 A	12	Spare	--	0 VA
	0 VA	--	Space	12	--	79	80	--	12	Spare	--	0 VA
	0 VA	--	Space	12	--	81	82	--	12	Spare	--	0 VA
	0 VA	--	Space	12	--	83	84	--	12	Spare	--	0 VA
NEC REF:	Load Type	Code	Fct.	Diversity	NEC REF	Load Type	Code	Fct.	Diversity			
220.44	(R)Receptacle	2780 VA	68.00%	18890 VA	210.20A	(L)Lighting						
220.56	(K)Kitchen	12700 VA	100.00%	12000 VA		(EL)Ext. Ltg.						
220.60	(C)Cooling	0 VA		0 VA	620.14	(E)Equipment						
220.60	(H)Heating					(WH)Wat. Htr.	9085 VA	100.00%	9085 VA			
220.60	(F)Fans	2616 VA	100.00%	2616 VA	220.5	(MT)Ltg. Motor						
	(M)Misc.	1440 VA	100.00%	1440 VA		(SP)Sub Pnl.						
					630.11B	(W)Widers						
Total Connected Load:				42121 VA	VA =	117 A						
Total Load (Diversified):				33231 VA	VA =	92 A	Location of Panel: ELEC 331E					

65000 A/C Rating  
X New  
Existing

Panelboard Q1HB

480/277 Voly Wye, 3 Phase, 4 Wire

Mains Type:

0 A --

--

LUGS: SINGLE

Mounting Style:

1 Section

MLO

400 A Bus (Copper)

--

SURFACE

NOTE	LOAD VA	TYPE	DESCRIPTION	WIRE	CB	CKT	CB	WIRE	DESCRIPTION	TYPE	LOAD VA	NOTE
	0 VA	--	Space	12	--	1 12				Space		
	0 VA	--	Space	12	--	3 4	125 A	1	TQ1LB	Space	47927 VA	
	0 VA	--	Space	12	--	5 6				C. H.:		
	0 VA	--	Space	12	20 A	7 8				Space		
	0 VA	--	Space	12	20 A	9 10		70 A	TQ1LB1	Space	32331 VA	
	0 VA	--	Space	12	20 A	11 12				R. SP		
	0 VA	--	Space	12	20 A	13 14				C. K.:		
	0 VA	--	Space	12	20 A	15 16		45 A	8	Space	13960 VA	
	0 VA	--	Space	12	20 A	17 18				R. SP		
	0 VA	--	Space	12	20 A	19 20	20 A	12	Space	--	0 VA	
	0 VA	--	Space	12	20 A	21 22	20 A	12	Space	--	0 VA	
	0 VA	--	Space	12	20 A	23 24	20 A	12	Space	--	0 VA	
	0 VA	--	Space	12	20 A	25 26	20 A	12	Space	--	0 VA	
	0 VA	--	Space	12	20 A	27 28	20 A	12	Space	--	0 VA	
	0 VA	--	Space	12	20 A	29 30	20 A	12	Space	--	0 VA	
	0 VA	--	Space	12	--	31 32	--	12	Space	--	0 VA	
	0 VA	--	Space	12	--	33 34	--	12	Space	--	0 VA	
	0 VA	--	Space	12	--	35 36	--	12	Space	--	0 VA	
	0 VA	--	Space	12	--	37 38	--					
	0 VA	--	Space	12	--	39 40	30 A	10	SPD3	SP	0 VA	
	0 VA	--	Space	12	--	41 42						
NEC REF:	Load Type	Conn.	Fct.	Diversity	NEC REF:	Load Type	Conn.	Fct.	Diversity			
220.44	(R)Receptacle	22040 VA	72.69%	16020 VA	210.20A	(L)Lighting						
220.56	(K)Kitchen	26478 VA	70.00%	18535 VA		(E)Ext. Ltg.						
220.60	(C)Cooling	24015 VA	100.00%	24015 VA	620.14	(E)Elevators						
220.60	(H)Heating	3360 VA	100.00%	0 VA		(W)W/ht. Htr.						
220.60	(F)Fans				220.5	(MT)Lrg. Motor						
	(M)Misc.	21685 VA	100.00%	21685 VA	630.11B	(SP)Sp. Phil.	0 VA	Not Computed		0 VA		
						(W)Welders						
Total Connected Load:				97578 VA	VA =	117 A	Location of Panel: ELEC 120					
Total Load (Diversified):				80255 VA	VA =	97 A						

# Panelboard Q1LB

1000 A/C Rating  
X New  
Existing

120/208 Vols Vlt, 3 Phase, 4 Wire    Mains Type:				150 A MCB		--	LUGS: --		Mounting Style: SURFACE						
1 Section				225 A MCB (Copper)		--	--		--						
Type 1 - Normal Rating				MCB											
NOTE	LOAD TYPE	TYPE	DESCRIPTION	WIRE	CB	CKT	CB	WIRE	DESCRIPTION	TYPE	LOAD (VA)	NOTE			
12356 VA	C		REFRIGERATION SYSTEM (E103)	8	50 A	1	12	20 A	R KITCHEN B126 (E109)	R	1200 VA				
						3	4	20 A	H COOLER B125 (E102A)	H	M 1200 VA				
						5	6	20 A	M COOLER B125 (E102B & C)	M	240 VA				
2849 VA	C		C FREEZER CKT (E103C)	12	20 A	7	8	20 A	M FREEZER B124 (E102B & C)	M	240 VA				
						10	10	20 A	H FREEZER B124 (E102A)	H	M 1300 VA				
324 VA	C		COOLER CKT	12	20	11	12	20 A	RC - RM B130	R	1080 VA				
8648 VA	K		LOAD CENTER (201A)	8	40 A	13	14	20 A	RC - RM B132	R	360 VA				
						15	16	20 A	RC - RM B131	R	540 VA				
						17	18	20 A	RC - RM B123	R	900 VA				
15130 VA	K		LOAD CENTER (201B)	4	70 A	19	20	20 A	RC - RM B123	R	720 VA				
						21	22	20 A	EXTERIOR RECEPTACLE	R	900 VA				
						23	24	20 A	EXTERIOR RECEPTACLE	R	540 VA				
540 VA	R	M	EXTERIOR RECEPTACLE	12	20	25	26	20 A	FCB SYSTEM	R	360 VA				
360 VA	M		DOC PANEL	12	20	27	28	20 A	COD PANEL	M	360 VA				
180 VA	R		R FREEZER B 124	12	20	29	30	20 A	DRAIN LINE HEATER (E103F)	H	960 VA				
0 VA	--		Spare	12	20	31	32	20 A	Spare	--	0 VA				
0 VA	--		Spare	12	20	33	34	20 A	Spare	--	0 VA				
0 VA	--		Spare	12	20	35	36	20 A	Spare	--	0 VA				
0 VA	--		Spare	12	20	37	38		Spare	--	0 VA				
0 VA	--		Spare	12	20	39	40		SPD2	SP	0 VA				
0 VA	--		Spare	12	20	41	42								
NEG REF:				Fct.		Diversity		NEG REF:		Fct.		Diversity			
220.44	(R)Receptacle	7320 VA	100.00%	7320 VA		210.20A		(L)Lighting		Conn.		Fct.			
220.56	(K)Kitchen	23778 VA	100.00%	23778 VA				(E)Ext. Ltg.							
220.60	(C)Cooling	15529 VA	100.00%	15529 VA		620.14		(E)Elevators							
220.60	(H)Heating	3360 VA	100.00%	0 VA				(W)W/ht. Htr.							
220.60	(F)Fans					220.5		(MT)Jug. Motor							
	(M)Misc.	1300 VA	100.00%	1300 VA		630.11B		(SP)Sub Pnl.		0 VA	Not Computed	0 VA			
								(W)Welders							
Total Connected Load:				51287 VA	VA	= 142 A		Location of Panel: ELEC 120							
Total Load (Diversified):				47927 VA	VA	= 133 A									

120/208 Vye Wvt, 3 Phase, 4 Wire

1 Section

Type I -Nema Rating

Mains Type:

MCB

15 A MCB

225 A BUS (Copper)

--

LUGS: --

--

FEED THRU

X New

Exiting

Mounting Site:

SURFACE

Panelboard Q1LB1													
NOTH	LOAD (VA)	TYPE	DESCRIPTION		WIRE	CB	CKT	CB	WIRE	DESCRIPTION	TYPE	LOAD (VA)	NOTE
	900 VA	R	RC - RM-B104		10	20 A	1	20 A	12	IDP	M	500 VA	
	1920 VA	M	RC - RM-B104		12	20 A	1	4	20 A	10	ACP	M	360 VA
	2880 VA	M	RC - RM-B104		10	20 A	5	6	20 A	10	CU-3	C	2163 VA
	360 VA	R	RC - RM-B104		12	20 A	7	8					
	360 VA	R	RC - RM-B104		10	20 A	10	10	20 A	12	LIFT GATE SYSTEM	R	500 VA
	360 VA	R	RC - RM-B104		10	20 A	11	12	20 A	12	R STOR D12R	R	180 VA
	720 VA	R,M	RC - RM-B104		12	20 A	13	14	20 A	12	RC - RM D130	R	1080 VA
	180 VA	R	EXTERIOR RECEPTACLE		12	20 A	15	16	20 A	12	RC - RM A142	R	1080 VA
	180 VA	R	EXTERIOR RECEPTACLE		12	20 A	17	18	20 A	12	DOC	M	360 VA
	0 VA	--	Spare		12	20 A	19	20	20 A	12	Spare	--	0 VA
	0 VA	--	Spare		12	20 A	21	22	20 A	12	Spare	--	0 VA
	0 VA	--	Spare		12	20 A	23	24	20 A	12	Spare	--	0 VA
	0 VA	--	Spare		12	20 A	25	26	20 A	12	Spare	--	0 VA
	0 VA	--	Spare		12	20 A	27	28	20 A	12	Spare	--	0 VA
	0 VA	--	Spare		12	20 A	29	30	20 A	12	Spare	--	0 VA
	0 VA	--	Spare		12	20 A	31	32	20 A	12	Spare	--	0 VA
	0 VA	--	Spare		12	20 A	33	34	20 A	12	Spare	--	0 VA
	0 VA	--	Spare		12	20 A	35	36	20 A	12	Spare	--	0 VA
	0 VA	--	Spare		12	20 A	37	38					
	0 VA	--	Spare		12	20 A	39	40			SPD2	SP	0 VA
	0 VA	--	Spare		12	20 A	41	42					
NEC REF:	Line Type	Overl.	Fct.		Overl.	NEC REF:	Load Type		Corr.	Fct.	Diversity		
220.44	(R)Receptacle	1120 VA	94.96%	10500 VA		210.20A	(L)Lighting		(El.)Ext. Ltg.				
220.56	(K)Kitchen	2700 VA	90.00%	2430 VA			(E)Eleat. Ltg.		(E)Walders				
220.60	(C)Cooling	4326 VA	100.00%	4326 VA	620.14		(M)Jt/Lg. Htr.		(MT)Jt/Lg. Motor				
220.60	(H)Heating			0 VA		220.5	(SP)Sub Pnl.	0 VA	(W)Walders	Not Computed	0 VA		
220.60	(F)Fans												
	(Misc.)	14185 VA	100.00%	14185 VA		630.11B							
Total Connected Load				32331 VA	VA =	90 A	Location of Panel: MECH N12M						
Total Load (Diversified):				31501 VA	VA =	87 A							

Panelboard Q1LA										10000 A AIC Rating		
										X New		
										Existing		
120/208 Vye Volt, 3 Phase, 4 Wire				Mainst Type:						Mounting Style: SURFACE		
1 Section				0 A --								
				225 A VSC (Copper)								
				LUGS: SINGLE								
				--								
Type 1 - Nema Rating												
NOTE	LOAD (VA)	TYPE	DESCRIPTION	WIRE	CB	CKT	CB	WIRE	DESCRIPTION	TYPE	LOAD (VA)	NOTE
	720 VA	R	RC - RM A137	12	20 A	1	2	20 A	REFRIGERATOR	K	900 VA	
	360 VA	R	RC - RM A137	12	20 A	3	4	20 A	ICE MACHINE	M	1125 VA	
	2880 VA	M	RC - RM A137	10	30 A	5	6	12	REFRIGERATOR	K	900 VA	
	1920 VA	M	RC - RM A137	10	20 A	7	8	20 A	REFRIGERATOR	K	900 VA	
	540 VA	R	EXTERIOR RECEPTACLE	10	20 A	9	10	20 A	RC - RM A132	R, M	900 VA	
	2163 VA	C	CU-2	12	20 A	11	12	20 A	RC - RM A129	R	900 VA	
	300 VA	M	ACP	12	20 A	13	14	20 A	RC - RM A104	M	360 VA	
	500 VA	M	IDP	12	20 A	15	16	20 A	RC - RM A104	R	900 VA	
	500 VA	M	IDP	12	20 A	17	18	20 A	RC - RM A105	M	360 VA	
	360 VA	M	DDC	12	20 A	19	20	12	Spare	--	0 VA	
	900 VA	R	RC - RM A104	12	20 A	21	22	12	Spare	--	0 VA	
	360 VA	R	RC - RM A137	12	20 A	23	24	12	Spare	--	0 VA	
	0 VA	--	Spare	12	20 A	25	26	12	Spare	--	0 VA	
	0 VA	--	Spare	12	20 A	27	28	12	SPD2	SP	0 VA	
	0 VA	--	Spare	12	20 A	29	30	10				
NEC REF:	Load Type	Conn.	Fct.	Diversity	NEC REF:	Load Type	Conn.	Fct.	Diversity			
220.44	(R)Receptacle	5400 VA	100.00%	5400 VA	210.20A	(L)Lighting						
220.56	(K)Kitchen	2700 VA	100.00%	2430 VA		(EL)Ext. Ltg.						
220.60	(C)Cooling	2163 VA	100.00%	2163 VA	620.14	(E)Elevators						
220.60	(H)Heating			0 VA		(WH)Wat. Htr.						
220.60	(F)Fans	7985 VA	100.00%	7985 VA	220.5	(MT)Ltr. Motor						
	(M)Misc.				630.11B	(SP)Sub Pnl. (W)Welders	0 VA	Not Computed	0 VA			
Total Connected Load				18248 VA	VA =	51 A	Location of Panel: MECH 106					
Total Load (Diversified):				17978 VA	VA =	50 A						

# Panelboard Q1LD

10000 A A/C Rating  
X New


Existing

120/208 Wye Volt, 3 Phase, 4 Wire    Mains Type:    100 A MCB    --    LUGS:    --    Mounting Style:    SURFACE

1 Section    MCB												
NOTE	Load Type (1) -Nema Rating	Type	DESCRIPTION	WIRE	CB	CKT	CB	WIRE	DESCRIPTION	TYPE	LOAD (VA)	NOTE
	720 VA	R	RC -RM-D146	12	20 A	1	2	20 A	12	EXTERIOR RECEPTACLE	R	360 VA
	1920 VA	M	RC -RM-D145	12	20 A	3	4	30 A	10			
	2880 VA	M	RC -RM-D146	12	20 A	5	6	30 A	10	CU-1	C	4160 VA
	360 VA	R	RC -RM-D146	12	20 A	7	8	20 A	12	DOC	M	360 VA
	360 VA	R	RC -RM-D146	12	20 A	9	10	20 A	12	ACP	M	360 VA
	360 VA	R	RC -RM-D146	12	20 A	11	12	20 A	12	DP	M	500 VA
	900 VA	R M	RC -RM-D145	12	20 A	13	14	20 A	12	BDA/DAS SYSTEM	R	180 VA
	360 VA	R	RC -RM-D146	12	20 A	15	16	20 A	12	BDA/DAS SYSTEM	R	180 VA
	0 VA	--	Spare	12	20 A	17	18	20 A	12	Spare	--	0 VA
	0 VA	--	Spare	12	20 A	19	20	--	12	Space	--	0 VA
	0 VA	--	Spare	12	20 A	21	22	--	12	Space	--	0 VA
	0 VA	--	Spare	12	20 A	23	24	--	12	Space	--	0 VA
	0 VA	--	Space	12	--	25	26	--				
	0 VA	--	Space	12	--	27	28	--	10	SPD2	SP	0 VA
	0 VA	--	Space	12	--	29	30	--				
NEC REF:	Load Type	Code	FcL	Diversity	NEC REF:	Load Type	Conn.	FcL	Diversity			
220.44	(R)Receptacle	3600 VA	100.00%	3600 VA	210.20A	(L)Lighting						
220.56	(K)Kitchen					(EL)Ext. Ltg.						
220.60	(C)Cooking	4160 VA	100.00%	4160 VA	620.14	(E)Elevators						
220.60	(H)Heating			0 VA		(WH)Wat. Htr.						
220.60	(F)Fans				220.5	(MT)Lrg. Motor						
	(M)Misc.	6200 VA	100.00%	6200 VA		(SP)Sub Pnl.	0 VA	Not Computed				
					630.11B	(W)Wireders						
Total Connected Load:				13960 VA	VA	=	39 A	Location of Panel: ELEC 331E				
Total Load (Diversified):				13960 VA	VA	=	39 A					

1HD	1HD1	1LC	1LC1
1LD	1LD1	Q1HB	Q1LB
Q1LB1	Q1LA	Q1LD	



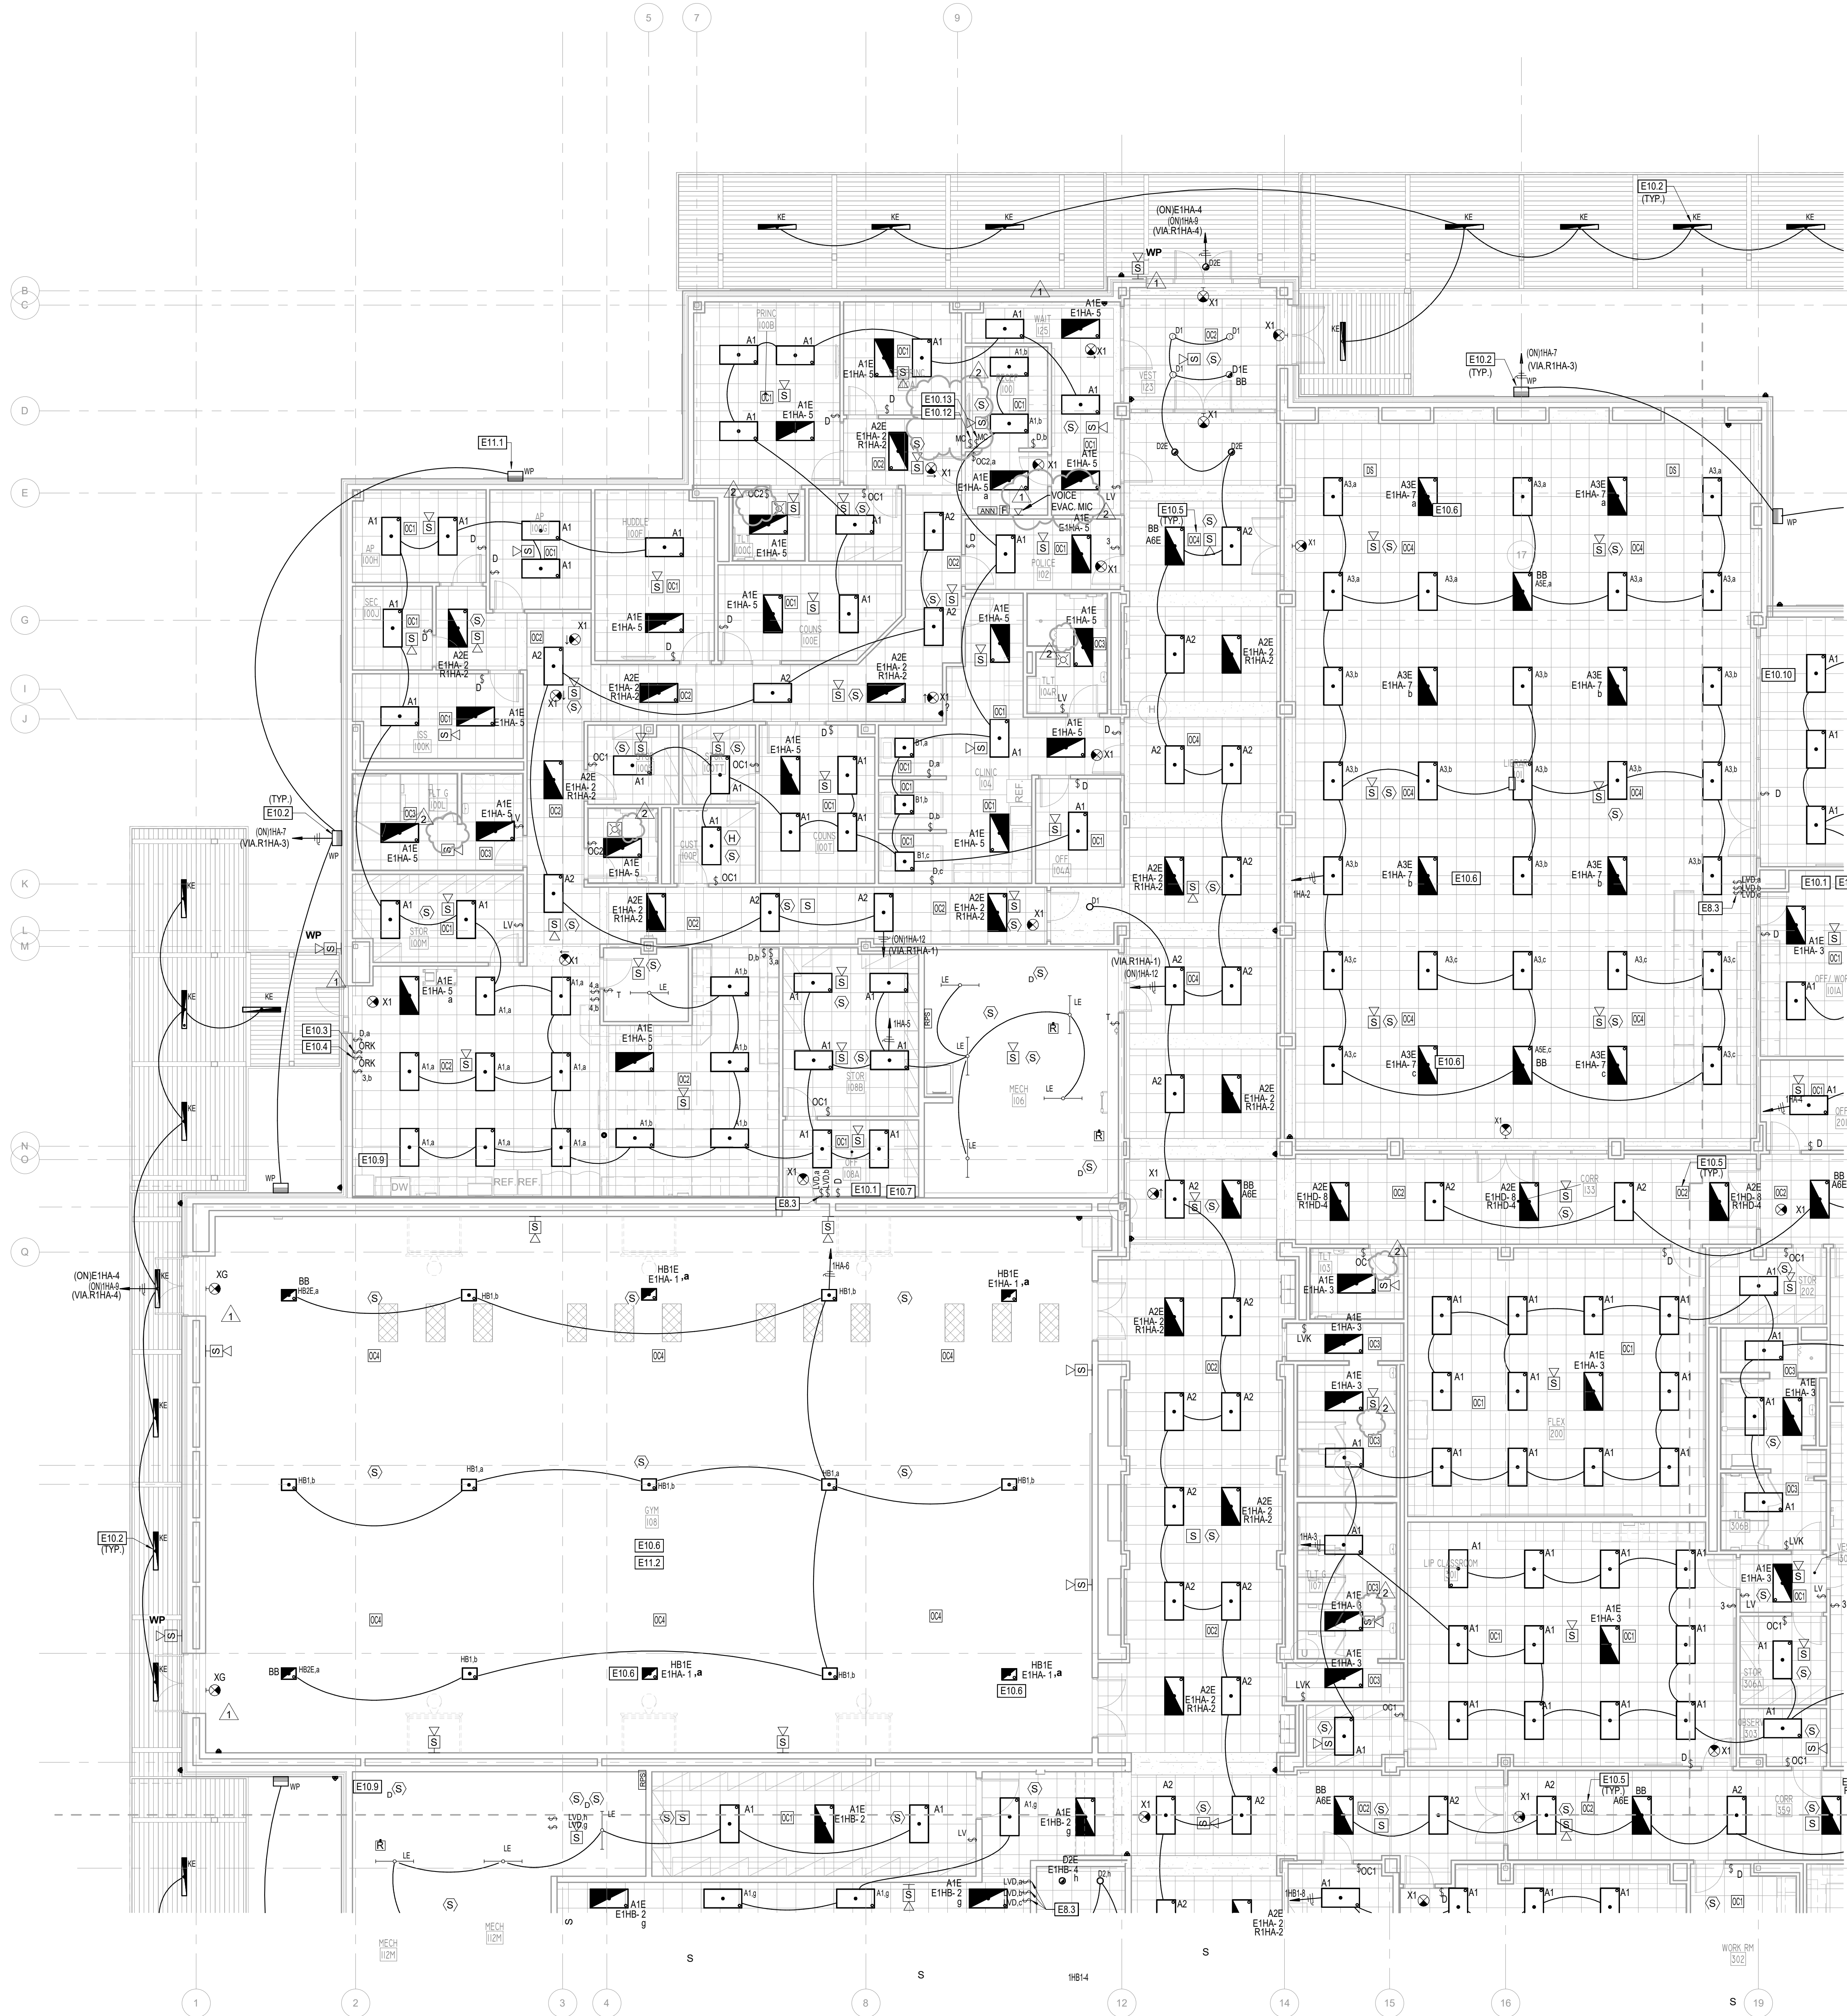


**GENERAL NOTE**

A REFER TO SHEET E02 FOR GENERAL NOTES.  
B REFER TO SHEET E02 FOR CORRIDOR LIGHTING SEQUENCE OF OPERATIONS NOTES.

**ELECTRICAL KEYED NOTES**

- E0.3 PROVIDE 3 BUTTON DIMMING SWITCH. REFERENCE LIGHTING CONTROL DETAILS FOR CONTROL ZONES AND QUANTITIES. PROVIDE LABEL ENGRAVINGS AS SHOWN ON LIGHTING CONTROL DETAILS. REFERENCE LIGHTING CONTROL DEVICE SCHEDULE ON SHEET E5.01 FOR ADDITIONAL INFORMATION.
- E10.1 FOR HIGH CEILING AREAS FOR ROOM CONTROLLERS LABEL THE CEILING GRID PER NCSD STANDARDS. COORDINATE WITH OWNER. BLACK LETTER AND CLEAR BACKGROUND WITH 1/4" HIGH LETTERS ONE 12" TALL LABEL FOR DIGITAL LIGHTING MODULES (LM). PROVIDE PLASTIC TAPE MACHINE TYPED NAME PLATE. GYM/LIBRARY ROOM CONTROLLER SHALL BE LOCATED IN THE LOW CEILING STORAGE ROOM AREA FOR MAINTENANCE ACCESSIBILITY.
- E10.2 EXTERIOR LIGHTING SHALL BE CONTROLLED BY RELAY PANEL WITH SCHEDULE AND PHOTOCELL OVERRIDE PER 2019 IECC CODE REQUIREMENTS. PHOTOCELL SHALL BE INTERFERED WITH LIGHTING RELAY PANEL. COORDINATE SCHEDULE WITH OWNER. PARKING LOT POLE LIGHTS SHALL BE CONTROLLED SEPARATELY. PROVIDE CONTACT RELAY TO ALLOW HAS SYSTEM INTEGRATION COORDINATE WITH MECHANICAL CONTROLS CONTRACTOR FOR SYSTEM INTEGRATION.
- E10.3 PROVIDE HUBBELL KEYED SWITCH AT THE SECURITY KEYPAD LOCATION IN THE STAFF ENTRANCE BREAKROOM (SEQUENCE OF OPERATIONS: EXTERIOR POLE LIGHTING KEYED SWITCH SHALL SWEEP ALL EXTERIOR PARKING POLE LIGHTS ON ONLY FOR A PERIOD OF TIME. CONFIRM LENGTH OF TIME WITH OWNER). ONCE THE OVERRIDE TIMES OUT, THE LIGHTS FOR AFTER HOURS OPERATION WILL BE CONTROLLED ON/OFF BY THE RELAY (SCHEDULE) (SCHEDULING WEEKENDS TO BE CONFIRMED WITH OWNER). (CONFIRM LOCATION WITH LOW VOLTAGE DESIGN CONSULTANT AND SECURITY KEY PAD LOCATION PRIOR TO ROUGH-IN. LABEL THE KEYED SWITCH "PARKING LOT POLE LIGHTS")
- MOMENTARY ON/OFF ROTARY KEYED SWITCH SHALL BE AS FOLLOWS:  
A. MANUFACTURER: HUBBELL CONTROLS LV SERIES HEAVY DUTY KEY SWITCH  
B. MODEL: LVKEY-3M-SS  
C. KEY: #126
- E10.4 PROVIDE HUBBELL KEYED SWITCH AT THE SECURITY KEYPAD LOCATION IN THE STAFF ENTRANCE BREAKROOM (SEQUENCE OF OPERATIONS: CORRIDOR KEYED SWITCH SHALL SWEEP ALL CORRIDOR LIGHTS ON ONLY FOR A PERIOD TIME. CONFIRM LENGTH OF TIME WITH OWNER). ONCE THE OVERRIDE TIMES OUT, THE LIGHTS FOR AFTER HOURS OPERATION WILL BE CONTROLLED ON/OFF BY THE OCCUPANCY SENSORS (SCHEDULING WEEKENDS TO BE CONFIRMED WITH OWNER). (CONFIRM LOCATION WITH LOW VOLTAGE DESIGN CONSULTANT AND SECURITY KEY PAD LOCATION PRIOR TO ROUGH-IN. LABEL THE KEYED SWITCH "ALL CORRIDOR LIGHTING")
- MOMENTARY ON/OFF ROTARY KEYED SWITCH SHALL BE AS FOLLOWS:  
A. MANUFACTURER: HUBBELL CONTROLS LV SERIES HEAVY DUTY KEY SWITCH  
B. MODEL: LVKEY-3M-SS  
C. KEY: #126
- E10.5 CORRIDORS SHALL BE CONTROLLED BY LIGHTING CONTROL RELAY SCHEDULE DURING REGULAR OPERATING SCHOOL HOURS. OCCUPANCY SENSOR SHALL CONTROL THE CORRIDOR LIGHTS FOR ON/OFF OPERATING AFTER REGULAR SCHEDULE HOURS. (TYPICAL)
- E10.6 PROVIDE UL924 20A DEVICE FOR EACH SWITCH ZONE IN SPACE. LOCATE IN LOCATION INDICATED BY KEYED NOTE NUMBER "E10.7".
- E10.7 UL924 20A DEVICES SHALL BE LOCATED IN AN ACCESSIBLE LOCATION WITHIN THIS AREA AND LABELED.
- E10.9 PROVIDE REMOTE BATTERY FOR FIXTURE TYPE "HB2E" LOCATED IN "GYM A139". REMOTE BATTERY SHALL BE LOCATED IN A LOW CEILING ROOM FOR EASY ACCESS AND MAINTENANCE. LABEL THE CEILING GRID PER NCSD STANDARDS. FIELD COORDINATE WITH ARCHITECT/OWNER PRIOR TO ROUGH-IN.
- E10.10 PROVIDE REMOTE BATTERY FOR FIXTURE TYPE "ASE" LOCATED IN "LIBRARY A100". REMOTE BATTERY SHALL BE LOCATED IN A LOW CEILING ROOM FOR EASY ACCESS AND MAINTENANCE. LABEL THE CEILING GRID PER NCSD STANDARDS. FIELD COORDINATE WITH ARCHITECT/OWNER PRIOR TO ROUGH-IN.
- E10.12 PROVIDE HUBBELL KEYED SWITCH AT THE RECEPTION ROOM FOR EXTERIOR FAN RECEPTACLE CONTROL. LABEL THE KEYED SWITCH "NORTH EXTERIOR FANS". CONTRACTOR SHALL FIELD COORDINATE EXACT SWITCH LOCATION WITH ARCHITECT/OWNER PRIOR TO ROUGH-IN.
- E10.13 PROVIDE HUBBELL KEYED SWITCH AT THE RECEPTION ROOM FOR EXTERIOR FAN RECEPTACLE CONTROL. LABEL THE KEYED SWITCH "WEST EXTERIOR FANS". CONTRACTOR SHALL FIELD COORDINATE EXACT SWITCH LOCATION WITH ARCHITECT/OWNER PRIOR TO ROUGH-IN.
- E11.1 REFER TO ARCHITECT PLANS AND ELEVATION FOR EXACT WALL PACK LOCATIONS (TYPICAL FOR ALL WALL PACKS). CONTRACTOR SHALL COORDINATE WITH ARCHITECT/OWNER PRIOR TO ROUGH-IN.
- E11.2 REFER TO POWER PLAN EP2.1A AND 2E6.3 FOR LU SYSTEM REQUIREMENTS. FINAL PLACEMENT OF LIGHT FIXTURES SHALL BE COORDINATED WITH THE LU SYSTEM LAYOUT.

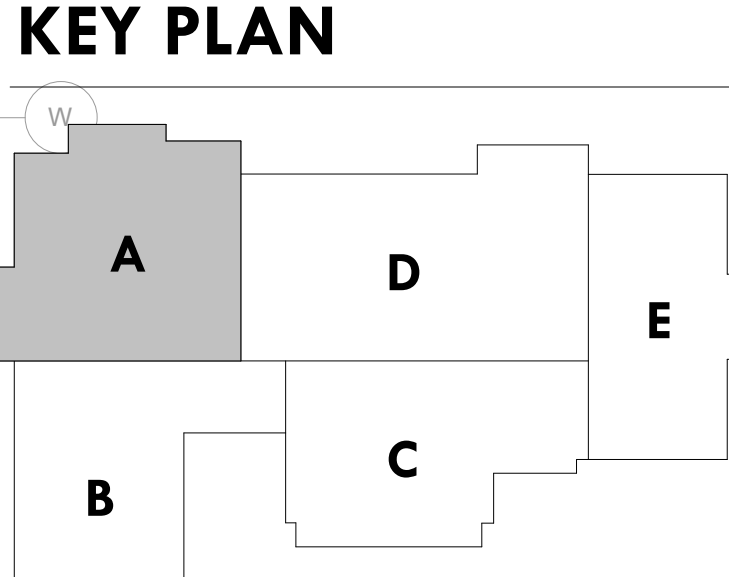

**ELECTRICAL LIGHTING AND SPECIAL SYSTEMS PLAN AREA A**  
1/8" = 1'-0"

**BROWN REYNOLDS WATFORD ARCHITECTS**  
4501 MAGNOLIA COVE DRIVE  
SUITE 200  
DALLAS, TEXAS 77445  
281-361-3800  
WWW.BRWARCH.COM

**BRW**

**BRENT B. MOE**  
117260  
LICENSED PROFESSIONAL ARCHITECT  
10-02-2024

**DBR**  
713.314.8888  
https://www.dbrinc.com  
TYPED: DBR-2024-003  
DBR Project # 20203-003  
BW PARKING LOT (LTN) AD


COPYRIGHT © 2024  
BROWN REYNOLDS WATFORD ARCHITECTS, INC.  
DATE: SEPTEMBER 9, 2024  
DRAWN BY: DBR  
CHECKED BY: DBR  
BRW PROJECT NUMBER: 223117.00

**NEW CANEY I.S.D.**  
**NEW CANEY**  
**ELEMENTARY SCHOOL**  
19300 VIA CORSCA DRIVE  
NEW CANEY, TX 77337

**EL2.1A**

ELECTRICAL LIGHTING  
AND SPECIAL SYSTEMS  
PLAN AREA A

NO.	REVISION	DATE
1	Addendum 1	09.23.2024
2	Addendum 2	10.02.2024

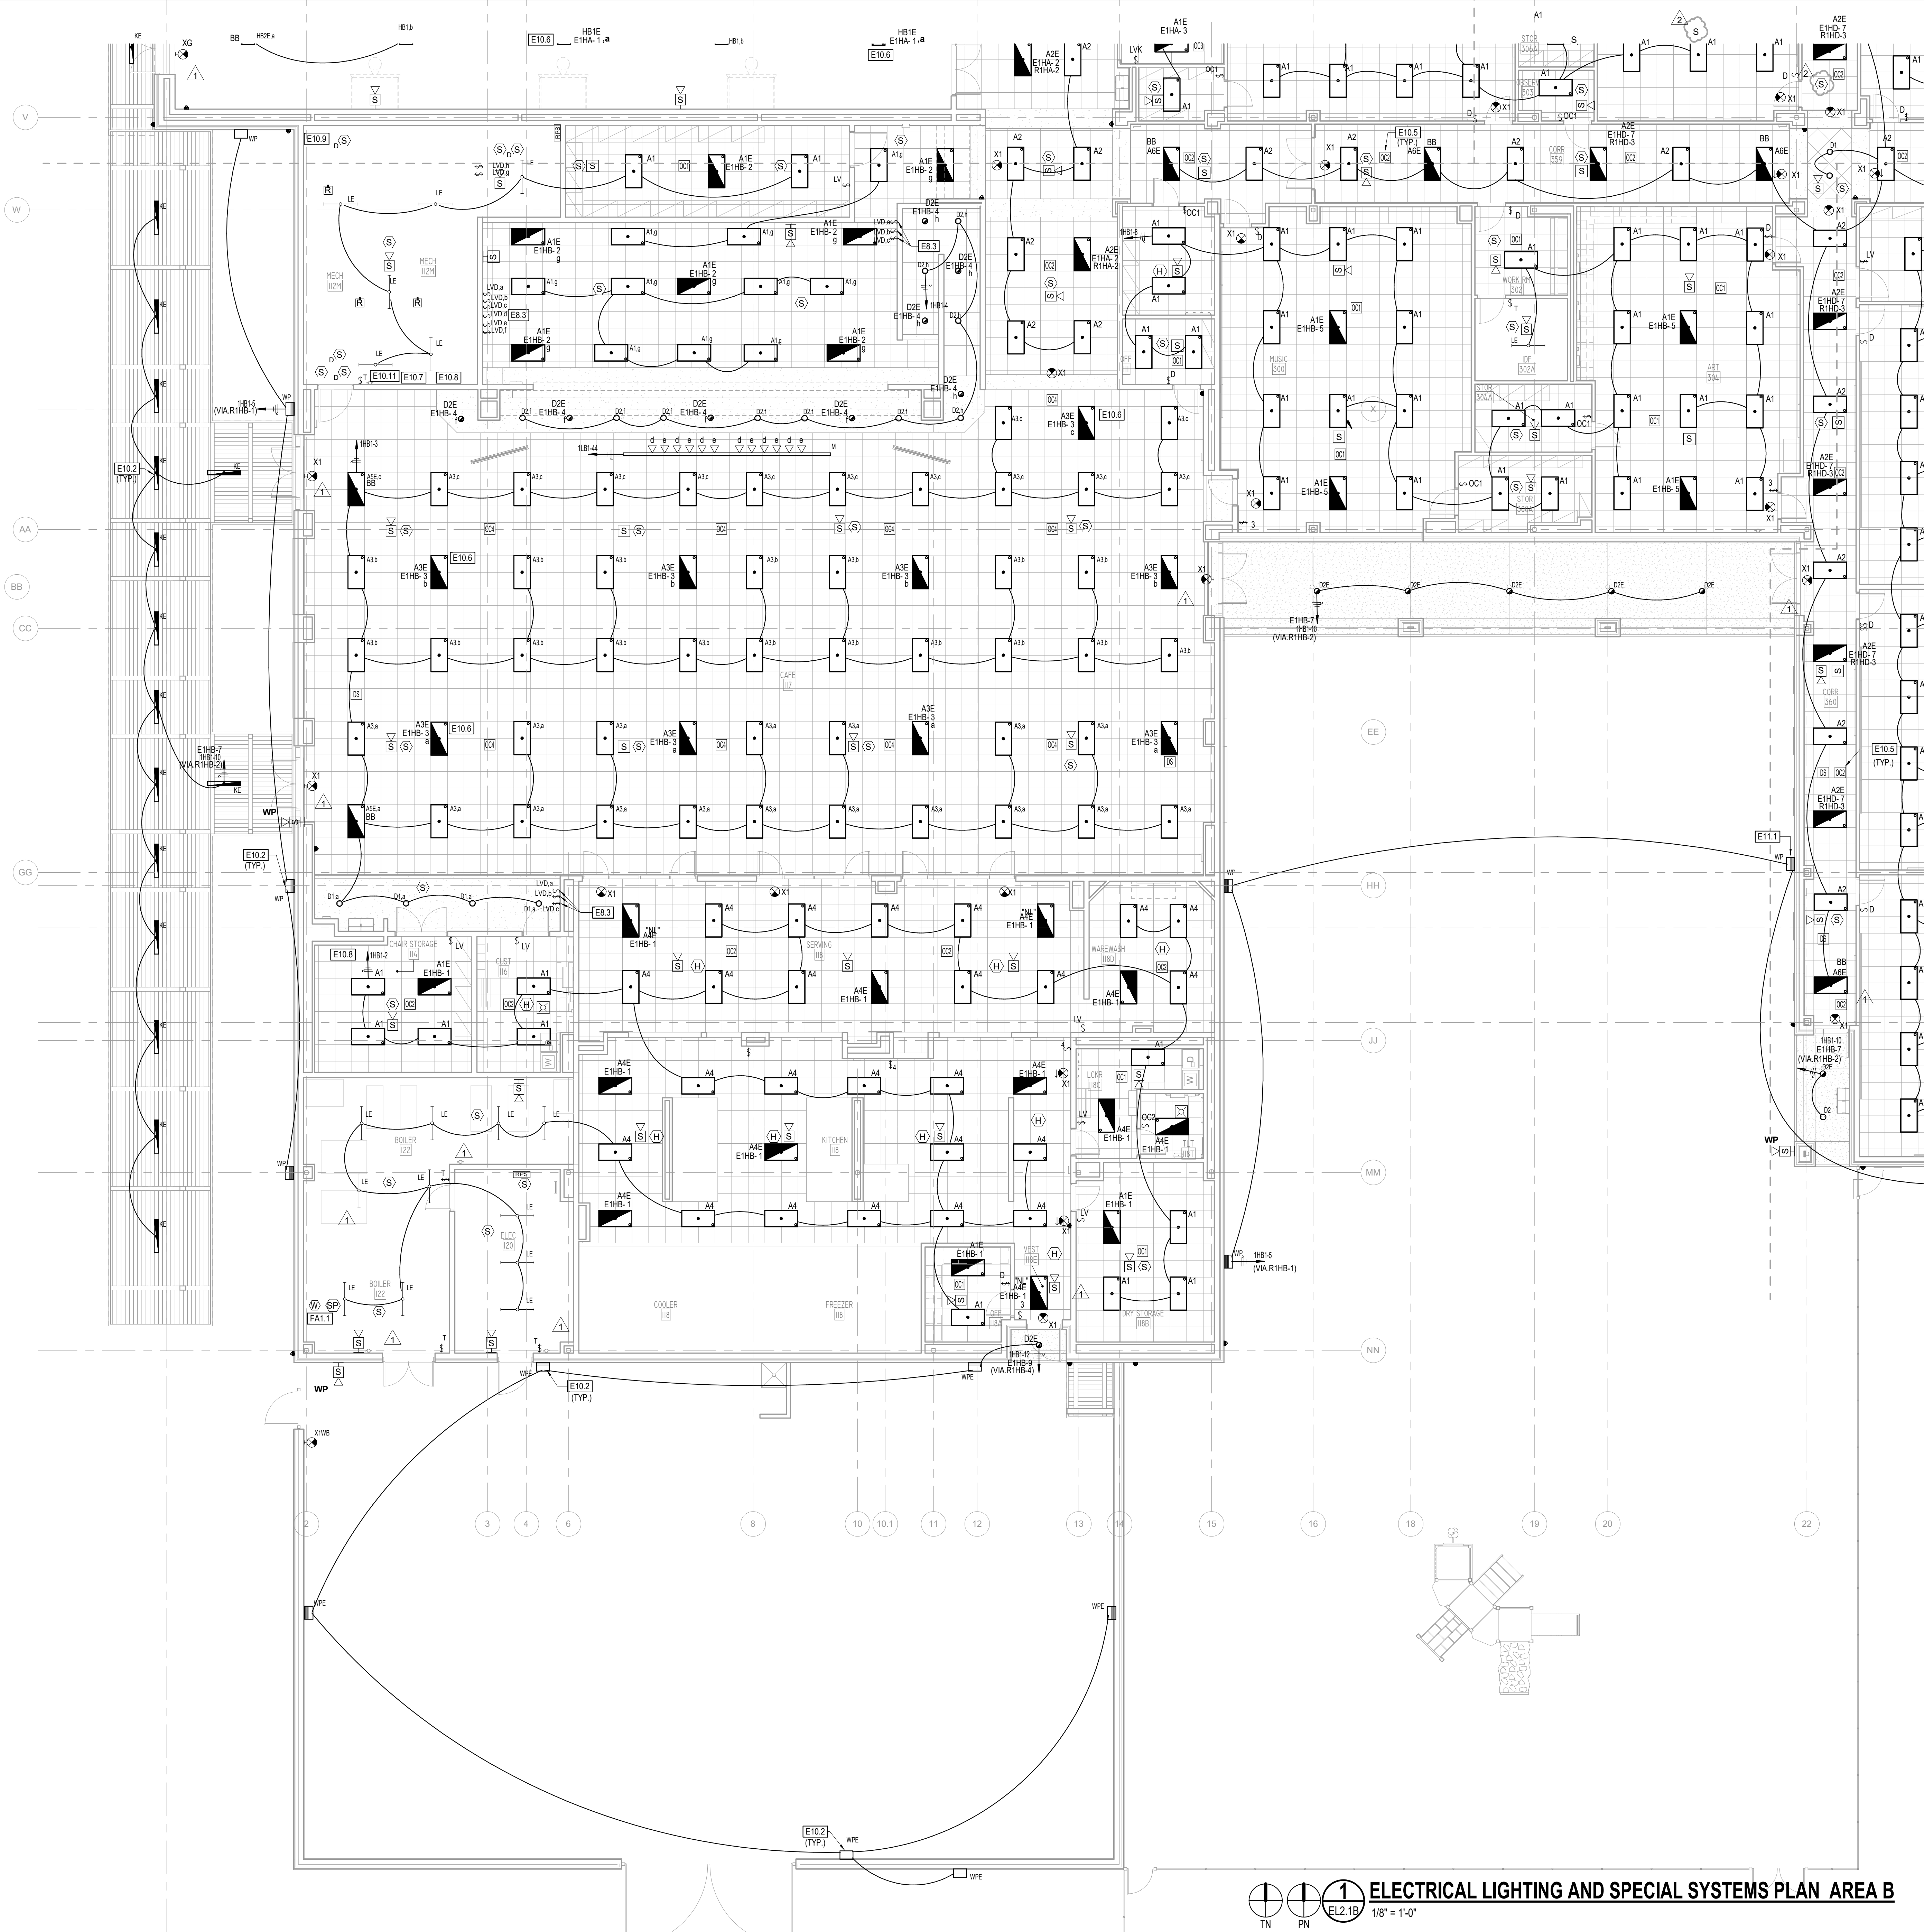

**GENERAL NOTE**

A REFER TO SHEET E0.2 FOR GENERAL NOTES.  
B REFER TO SHEET E0.2 FOR CORRIDOR LIGHTING SEQUENCE OF OPERATIONS NOTES.

**ELECTRICAL KEYED NOTES**


- E8.3 PROVIDE 3 BUTTON DIMMING SWITCH. REFERENCE LIGHTING CONTROL DETAILS FOR CONTROL ZONES AND QUANTITIES. PROVIDE LABEL ENGRAVINGS AS SHOWN ON LIGHTING CONTROL DETAILS. REFERENCE LIGHTING CONTROL DEVICE SCHEDULE ON SHEET E0.1 FOR ADDITIONAL INFORMATION.
- E10.2 SECTORIAL LIGHTING SHALL BE CONTROLLED BY RELAY PANEL WITH SCHEDULE AND PHOTOCELL OVERRIDE PER 2018 IECC CODE REQUIREMENTS. PHOTOCELL SHALL BE INTEGRATED WITH LIGHTING RELAY PANEL. COORDINATE SCHEDULE WITH OWNER. PARKING LOT POLE LIGHTS SHALL BE CONTROLLED SEPARATELY. PROVIDE CONTACT RELAY TO ALLOW BAS SYSTEM INTEGRATION. COORDINATE WITH MECHANICAL CONTROLS CONTRACTOR FOR SYSTEM INTEGRATION.
- E10.5 CORRIDORS SHALL BE CONTROLLED BY LIGHTING CONTROL RELAY SCHEDULE DURING REGULAR OPERATING SCHOOL HOURS. OCCUPANCY SENSOR SHALL CONTROL THE CORRIDOR LIGHTS FOR ON/OFF OPERATING AFTER REGULAR SCHEDULE HOURS. (TYPICAL)
- E10.6 PROVIDE UL924 20A DEVICE FOR EACH SWITCH ZONE IN SPACE. LOCATE IN LOCATION INDICATED BY KEYED NOTE NUMBER "E10.7".
- E10.7 UL924 20A DEVICES SHALL BE LOCATED IN AN ACCESSIBLE LOCATION WITHIN THIS AREA AND LABELED.
- E10.8 PROVIDE REMOTE BATTERY FOR FIXTURE TYPE "A5E" LOCATED IN "CAFETERIA". REMOTE BATTERY SHALL BE LOCATED IN A LOW CEILING ROOM FOR EASY ACCESS AND MAINTENANCE. LABEL THE CEILING GRID PER NCSD STANDARDS. FIELD COORDINATE WITH ARCHITECT/OWNER PRIOR TO ROUGH-IN.
- E10.9 PROVIDE REMOTE BATTERY FOR FIXTURE TYPE "HB2E" LOCATED IN "CAFETERIA". REMOTE BATTERY SHALL BE LOCATED IN A LOW CEILING ROOM FOR EASY ACCESS AND MAINTENANCE. LABEL THE CEILING GRID PER NCSD STANDARDS. FIELD COORDINATE WITH ARCHITECT/OWNER PRIOR TO ROUGH-IN.
- E10.11 FOR HIGH CEILING AREAS FOR ROOM CONTROLLERS LABEL THE CEILING GRID PER NCSD STANDARDS. COORDINATE WITH OWNER. WHITE LETTER AND BLACK BACKGROUND WITH 1/4" HIGH LETTERS ONE 12" TALL LABEL FOR BEST LIGHTING MODULE (LM) PROVIDE PLASTIC TAPE MACHINE TYPED NAME PLATE. CAFETERIA ROOM CONTROLLER SHALL BE LOCATED IN THE MECHANICAL ROOM FOR MAINTENANCE ACCESSIBILITY.
- E10.8 REFER TO ARCHITECT PLANS AND ELEVATION FOR EXACT WALL PACK LOCATIONS (TYPICAL FOR ALL WALL PACKS). CONTRACTOR SHALL COORDINATE WITH ARCHITECT/OWNER PRIOR TO ROUGH-IN.

**FIRE ALARM KEYED NOTES**

- FA1.1 PROVIDE FLOW SWITCH AND SUPERVISORY SWITCH PER SPRINKLER ZONE. COORDINATE WITH FIRE PROTECTION CONTRACTOR PRIOR TO ORDER AND INSTALL.

II S S  
KK S  
LL S

**KEY PLAN**

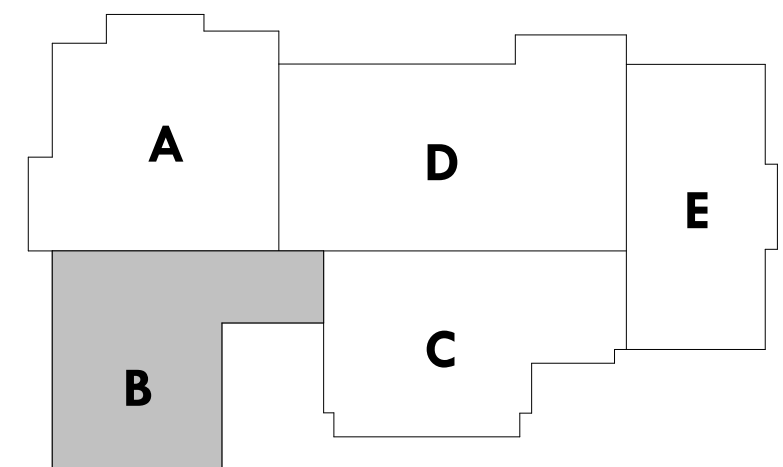

**ELECTRICAL LIGHTING AND SPECIAL SYSTEMS PLAN AREA B**  
1/8" = 1'-0"

**BROWN REYNOLDS WATFORD ARCHITECTS**  
4501 MAGNOLIA COVE DRIVE  
SUITE 200  
DALLAS, TEXAS 77345  
281-301-3800  
WWW.BRWARCH.COM



COPYRIGHT © 2024  
BROWN REYNOLDS WATFORD ARCHITECTS, INC.  
DATE: SEPTEMBER 9, 2024  
DRAWN BY: DBR  
CHECKED BY: DBR  
BRW PROJECT NUMBER: 223117.00

**NEW CANEY I.S.D.**  
**NEW CANEY ELEMENTARY SCHOOL**  
19300 VIA CORSICA DRIVE  
NEW CANEY, TX 77337

NO.	REVISION	DATE
1	Addendum 1	09.23.2024
2	Addendum 2	10.02.2024


**EL2.1B**  
ELECTRICAL LIGHTING AND SPECIAL SYSTEMS PLAN AREA B





**GENERAL NOTE**  
A REFER TO SHEET E02 FOR GENERAL NOTES.  
B REFER TO SHEET E02 FOR CORRIDOR LIGHTING SEQUENCE OF OPERATIONS NOTES.

**ELECTRICAL KEYED NOTES**

- E10.2 EXTERIOR LIGHTING SHALL BE CONTROLLED BY RELAY PANEL WITH SCHEDULE AND PHOTOCELL OVERRIDE PER 2018 IECC CODE REQUIREMENTS. PHOTOCELL SHALL BE INTEGRATED WITH LIGHTING RELAY PANEL. COORDINATE SCHEDULE WITH OWNER. PARKING LOT POLE LIGHTS SHALL BE CONTROLLED SEPARATELY. PROVIDE CONTACT RELAY TO ALLOW BAS SYSTEM INTEGRATION COORDINATE WITH MECHANICAL CONTROLS CONTRACTOR FOR SYSTEM INTEGRATION.
- E10.5 CORRIDORS SHALL BE CONTROLLED BY LIGHTING CONTROL RELAY SCHEDULE DURING REGULAR OPERATING SCHOOL HOURS. OCCUPANCY SENSOR SHALL CONTROL THE CORRIDOR LIGHTS FOR ON/OFF OPERATING AFTER REGULAR SCHEDULE HOURS. (TYPICAL)
- E11.1 REFER TO ARCHITECT PLANS AND ELEVATION FOR EXACT WALL PACK LOCATIONS (TYPICAL FOR ALL WALL PACKS). CONTRACTOR SHALL COORDINATE WITH ARCHITECT/OWNER PRIOR TO ROUGH-IN.

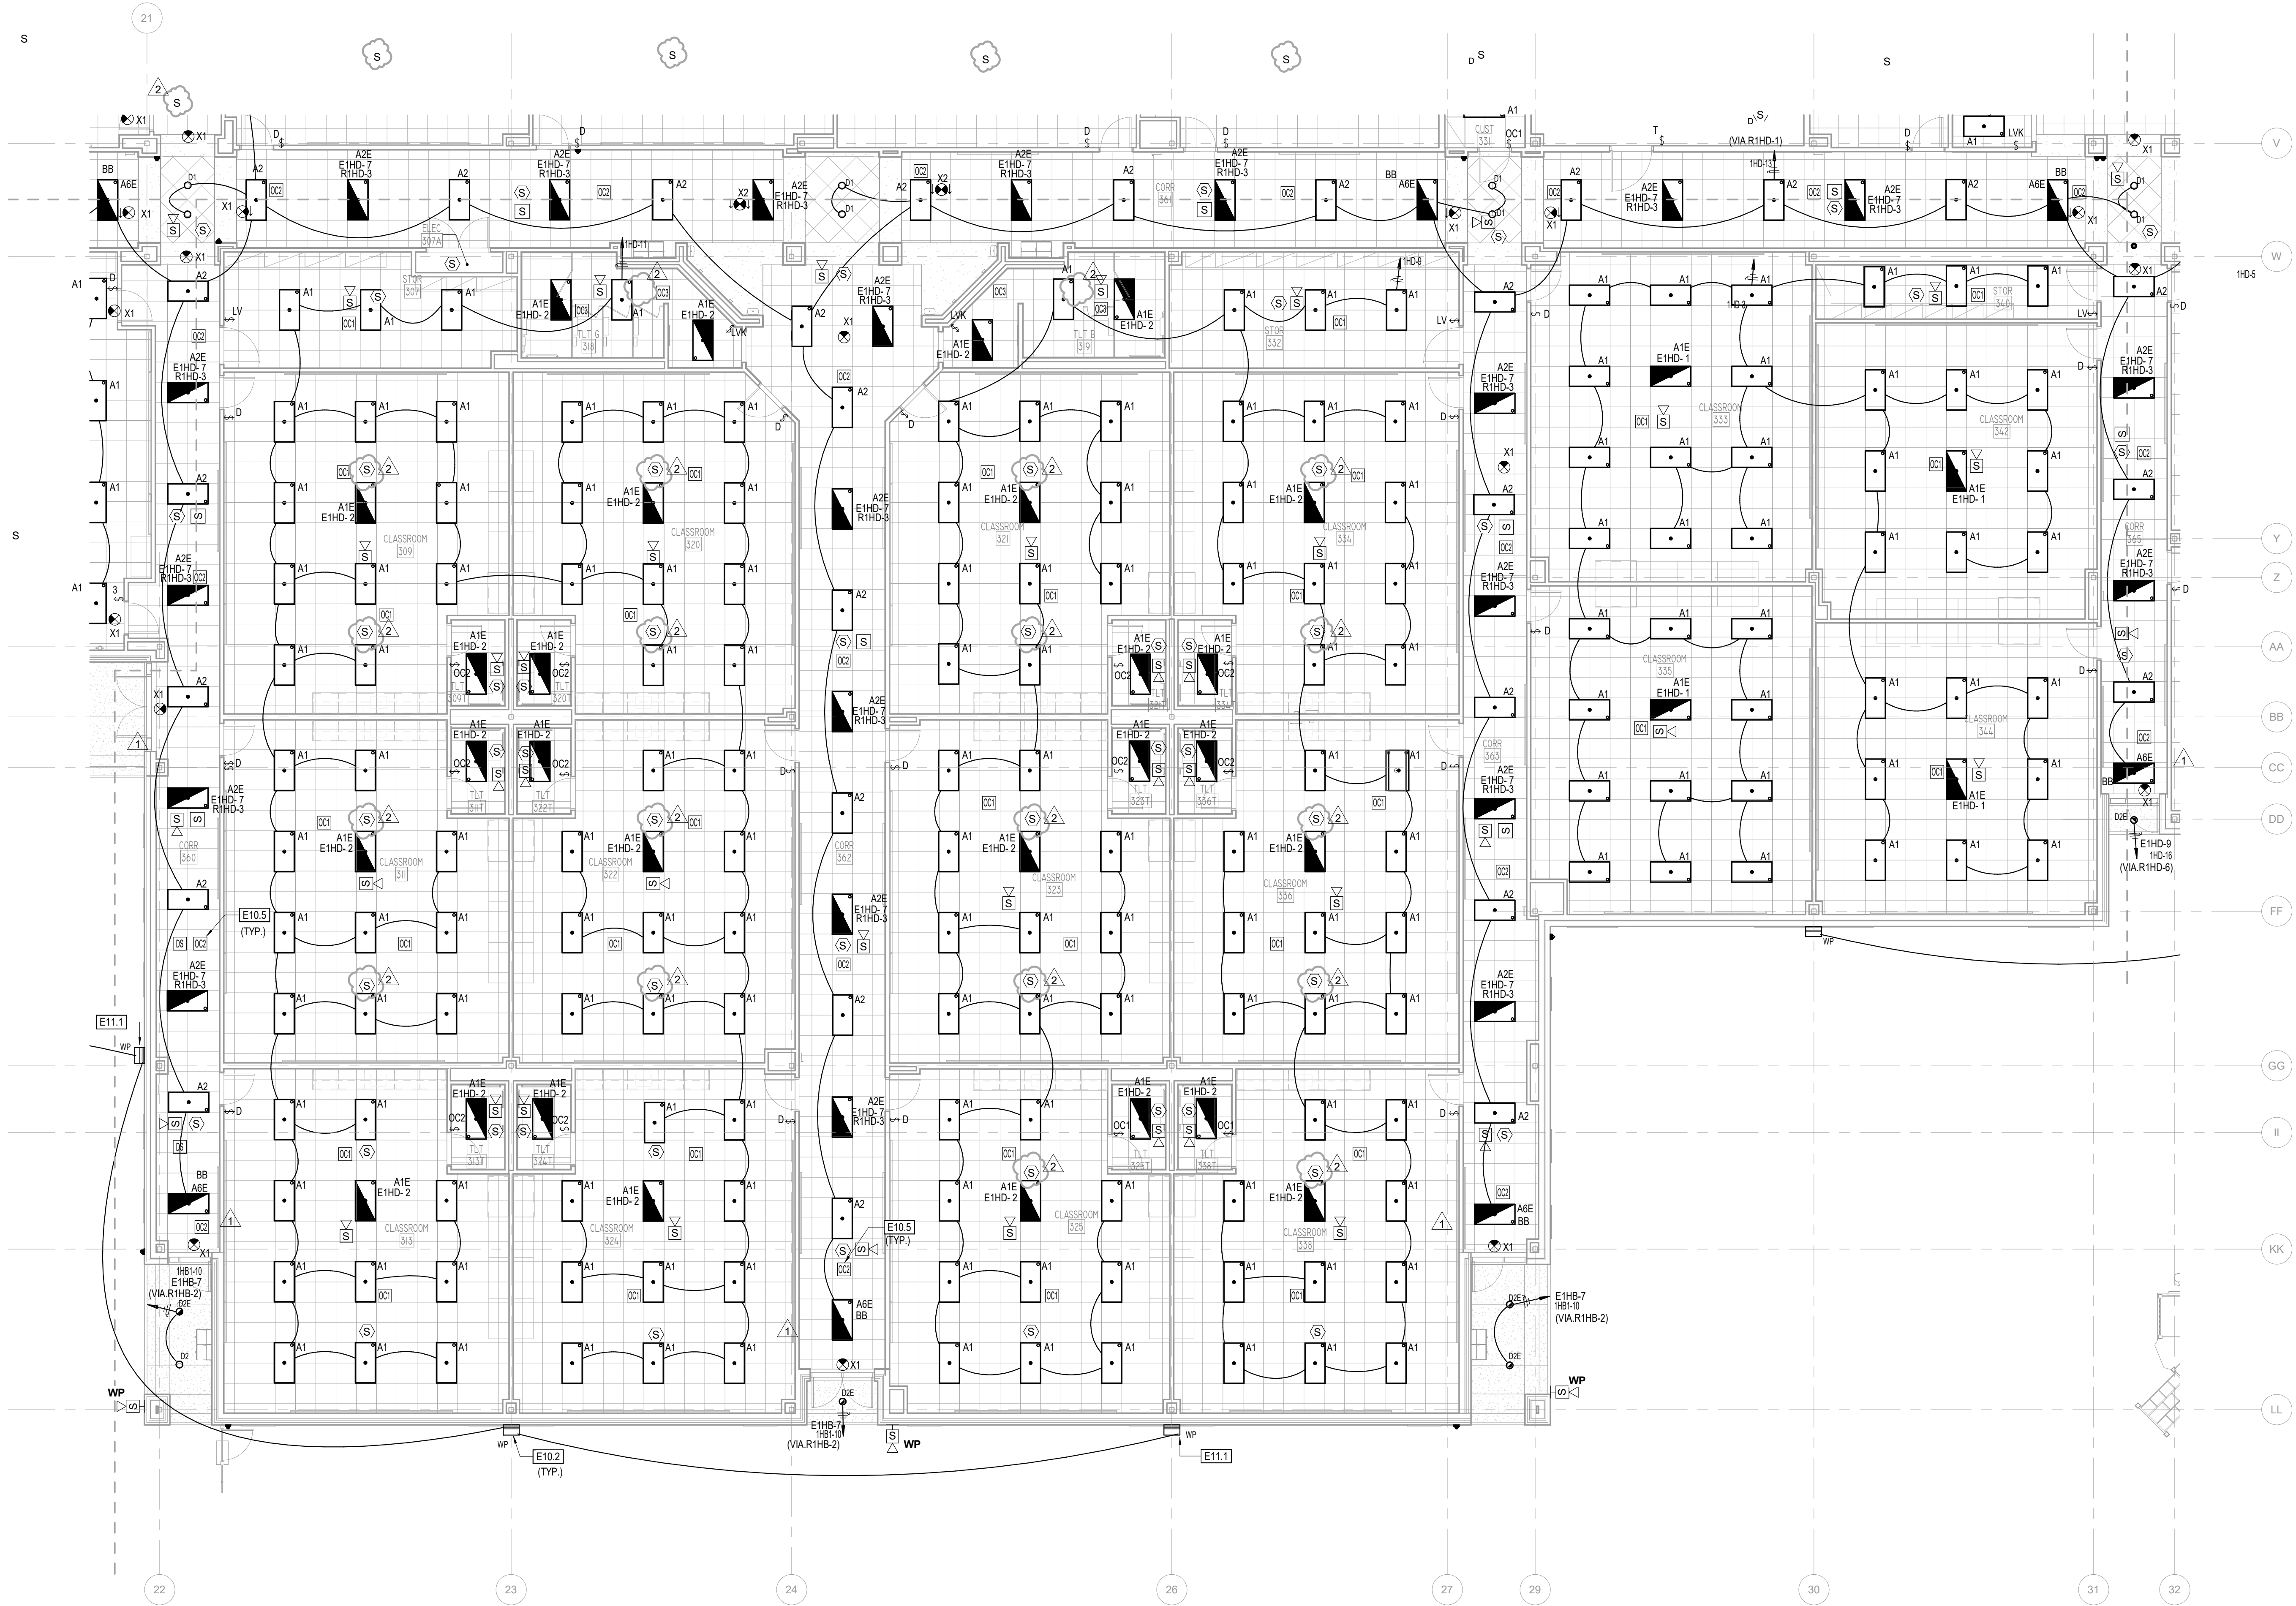


**KEY PLAN**

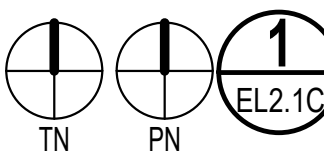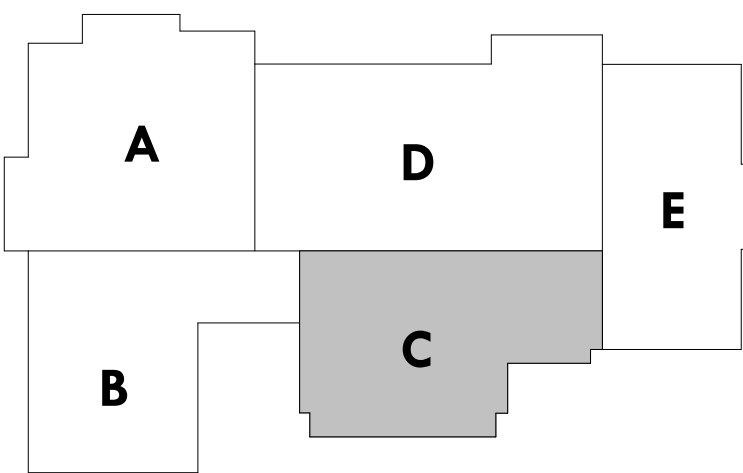

**ELECTRICAL LIGHTING AND SPECIAL SYSTEMS PLAN AREA C**

**BROWN REYNOLDS WATFORD ARCHITECTS**  
4501 MAGNOLIA COVE DRIVE  
SUITE 200  
HOUSTON, TEXAS 77045  
281-361-3800  
WWW.BRWARCH.COM

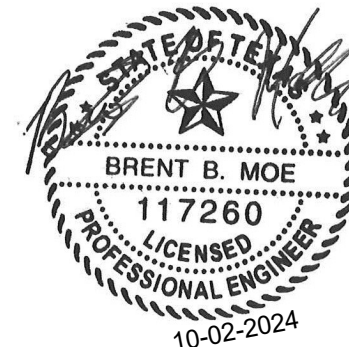


**DBR**  
713.314.8888  
https://www.dbrinc.com  
TYPED: DBR Project # 202039.000  
BW PARKWISLE/UTN AD

COPYRIGHT © 2024  
BROWN REYNOLDS WATFORD ARCHITECTS, INC.  
DATE: SEPTEMBER 9, 2024  
DRAWN BY: DBR  
CHECKED BY: DBR  
BRW PROJECT NUMBER: 223117.00


**NEW CANEY I.S.D.**  
**NEW CANEY ELEMENTARY SCHOOL**  
19300 VIA CORSICA DRIVE  
NEW CANEY, TX 77337

NO.	REVISION	DATE
1	Addendum 1	09.23.2024
2	Addendum 2	10.02.2024

**EL2.1C**  
ELECTRICAL LIGHTING AND SPECIAL SYSTEMS PLAN AREA C

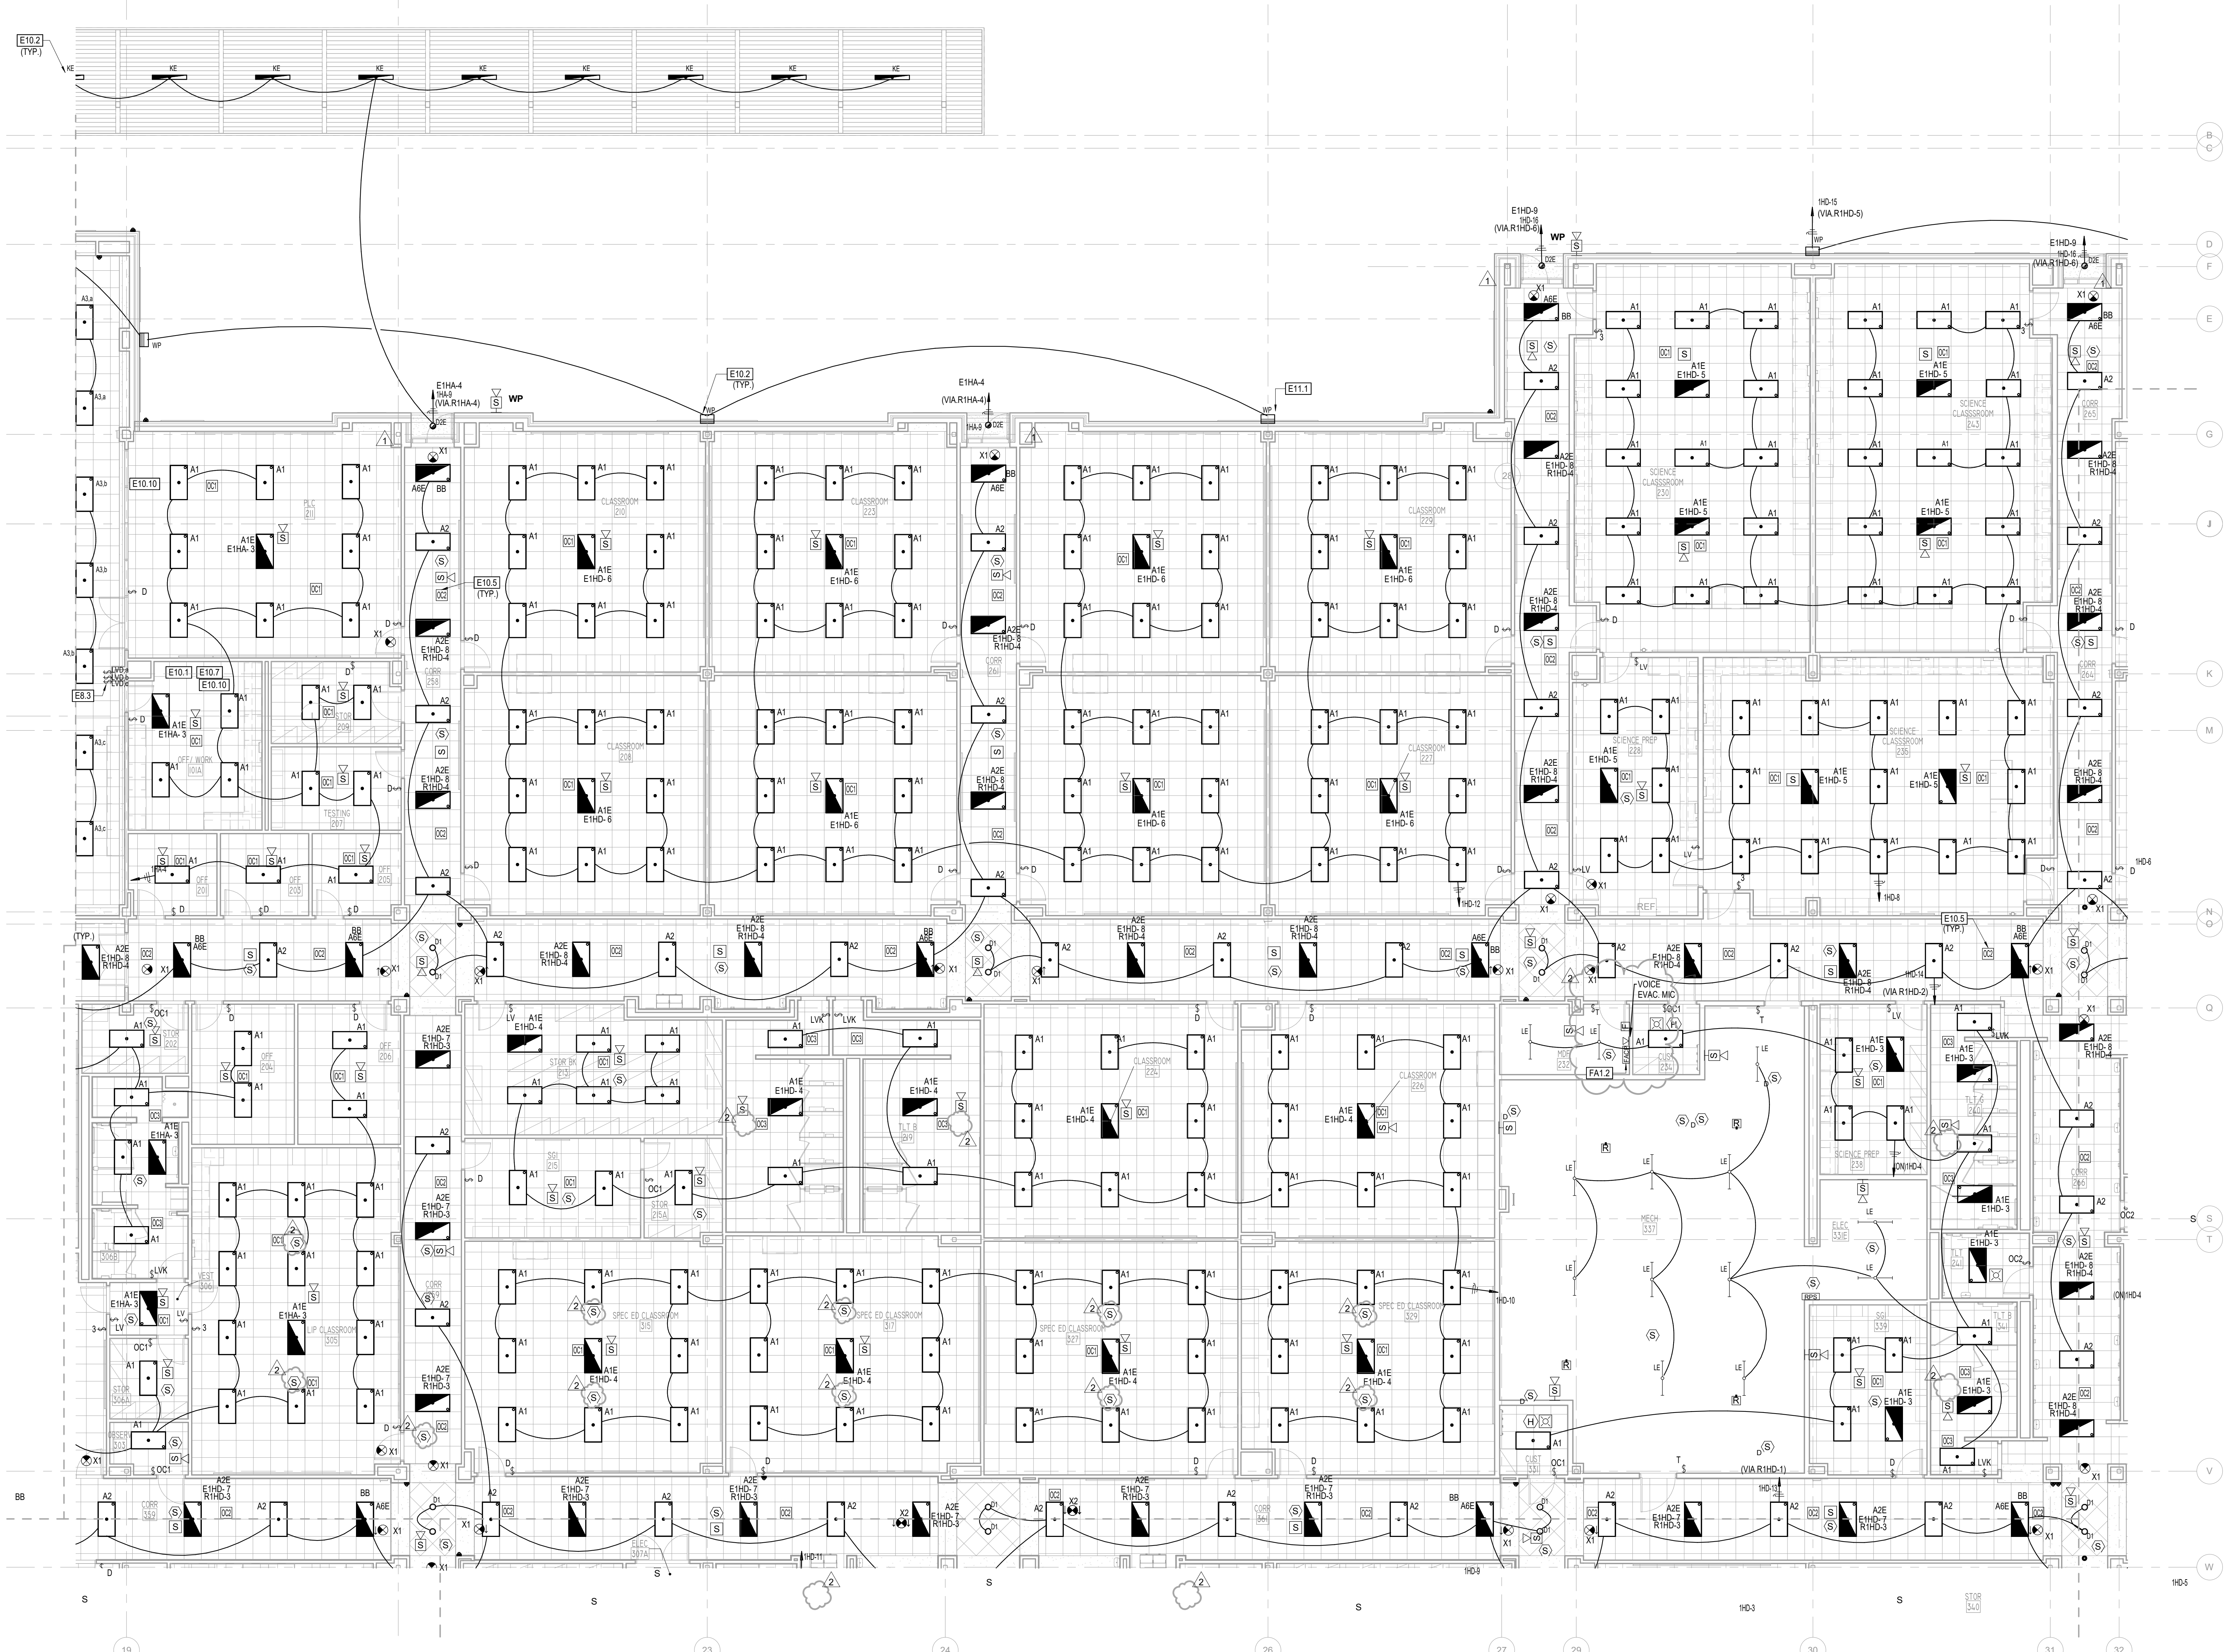

- ### GENERAL NOTE
- A REFER TO SHEET E0.2 FOR GENERAL NOTES.  
B REFER TO SHEET E0.2 FOR CORRIDOR LIGHTING SEQUENCE OF OPERATIONS NOTES.
- ### ELECTRICAL KEYED NOTES
- E8.3 PROVIDE 3 BUTTON DIMMING SWITCH. REFERENCE LIGHTING CONTROL DETAILS FOR CONTROL ZONES AND QUANTITIES. PROVIDE LABEL ENGRAVINGS AS SHOWN ON LIGHTING CONTROL DETAILS. REFERENCE LIGHTING CONTROL DEVICE SCHEDULE ON SHEET E5.01 FOR ADDITIONAL INFORMATION.
- E10.1 FOR HIGH CEILING AREAS FOR ROOM CONTROLLERS LABEL THE CEILING GRID PER NCSD STANDARDS. COORDINATE WITH OWNER, BLACK LETTER AND CLEAR BACKGROUND WITH 1/4" HIGH LETTERS ONE 1/2" TALL LABEL FOR DIGITAL LIGHTING MODULE(S). PROVIDE PLASTIC TAPE MACHINE TYPED NAME PLATE. GYM/LIBRARY ROOM CONTROLLER SHALL BE LOCATED IN THE LOW CEILING STORAGE ROOM AREA FOR MAINTENANCE ACCESSIBILITY.
- E10.2 EXTERIOR LIGHTING SHALL BE CONTROLLED BY RELAY PANEL WITH SCHEDULE AND PHOTOCELL OVERRIDE PER 2018 IECC CODE REQUIREMENTS. PHOTOCELL SHALL BE INTEGRATED WITH LIGHTING RELAY PANEL. COORDINATE SCHEDULE WITH OWNER. PARKING LOT POLE LIGHTS SHALL BE CONTROLLED SEPARATELY. PROVIDE CONTACT RELAY TO ALLOW BAS SYSTEM INTEGRATION COORDINATE WITH MECHANICAL CONTROLS CONTRACTOR FOR SYSTEM INTEGRATION.
- E10.5 CORRIDORS SHALL BE CONTROLLED BY LIGHTING CONTROL RELAY SCHEDULE DURING REGULAR OPERATING SCHOOL HOURS. OCCUPANCY SENSOR SHALL CONTROL THE CORRIDOR LIGHTS FOR ON/OFF OPERATING AFTER REGULAR SCHEDULE HOURS. (TYPICAL)
- E10.7 UL924 20A DEVICES SHALL BE LOCATED IN AN ACCESSIBLE LOCATION WITHIN THIS AREA AND LABELED.
- E10.10 PROVIDE REMOTE BATTERY FOR FIXTURE TYPE "ASE" LOCATED IN "LIBRARY A100". REMOTE BATTERY SHALL BE LOCATED IN A LOW CEILING ROOM FOR EASY ACCESS AND MAINTENANCE. LABEL THE CEILING GRID PER NCSD STANDARDS. FIELD COORDINATE WITH ARCHITECT/OWNER PRIOR TO ROUGH-IN.
- E11.1 REFER TO ARCHITECT PLANS AND ELEVATION FOR EXACT WALL PACK LOCATIONS (TYPICAL FOR ALL WALL PACKS). CONTRACTOR SHALL COORDINATE WITH ARCHITECT/OWNER PRIOR TO ROUGH-IN.
- ### FIRE ALARM KEYED NOTES
- FA1.2 PROVIDE BOSCH IP COMMUNICATION PART #B465. PROGRAMMING BY OWNER.

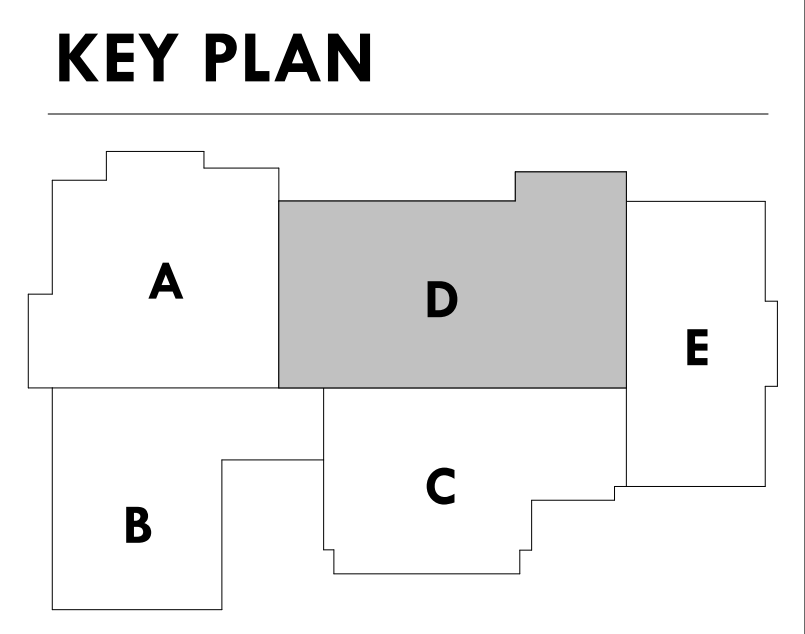

**ELECTRICAL LIGHTING AND SPECIAL SYSTEMS PLAN AREA D**  
1/8" = 1'-0"

**BROWN REYNOLDS WATFORD ARCHITECTS**  
4501 MAGNOLIA COVE DRIVE  
281-361-3800  
WWW.BRWARCH.COM

**BRW**

**BRENT B. MOE**  
117260  
10-02-2024

**DBR**  
713.314.8888  
https://www.dbrinc.com  
TYPE: ELECTRICAL  
DBR Project # 20203.000  
BW: RARWISLEJLTN AD


COPYRIGHT © 2024  
BROWN REYNOLDS WATFORD ARCHITECTS, INC.  
DATE: SEPTEMBER 9, 2024  
DRAWN BY: DBR  
CHECKED BY: DBR  
BRW PROJECT NUMBER: 223117.00

**NEW CANEY I.S.D.**  
**NEW CANEY**  
**ELEMENTARY SCHOOL**  
19300 VIA CORSICA DRIVE  
NEW CANEY, TX 77337

NO.	REVISION	DATE
1	Addendum 1	09.23.2024
2	Addendum 2	10.02.2024

**EL2.1 D**  
ELECTRICAL LIGHTING  
AND SPECIAL SYSTEMS  
PLAN AREA D



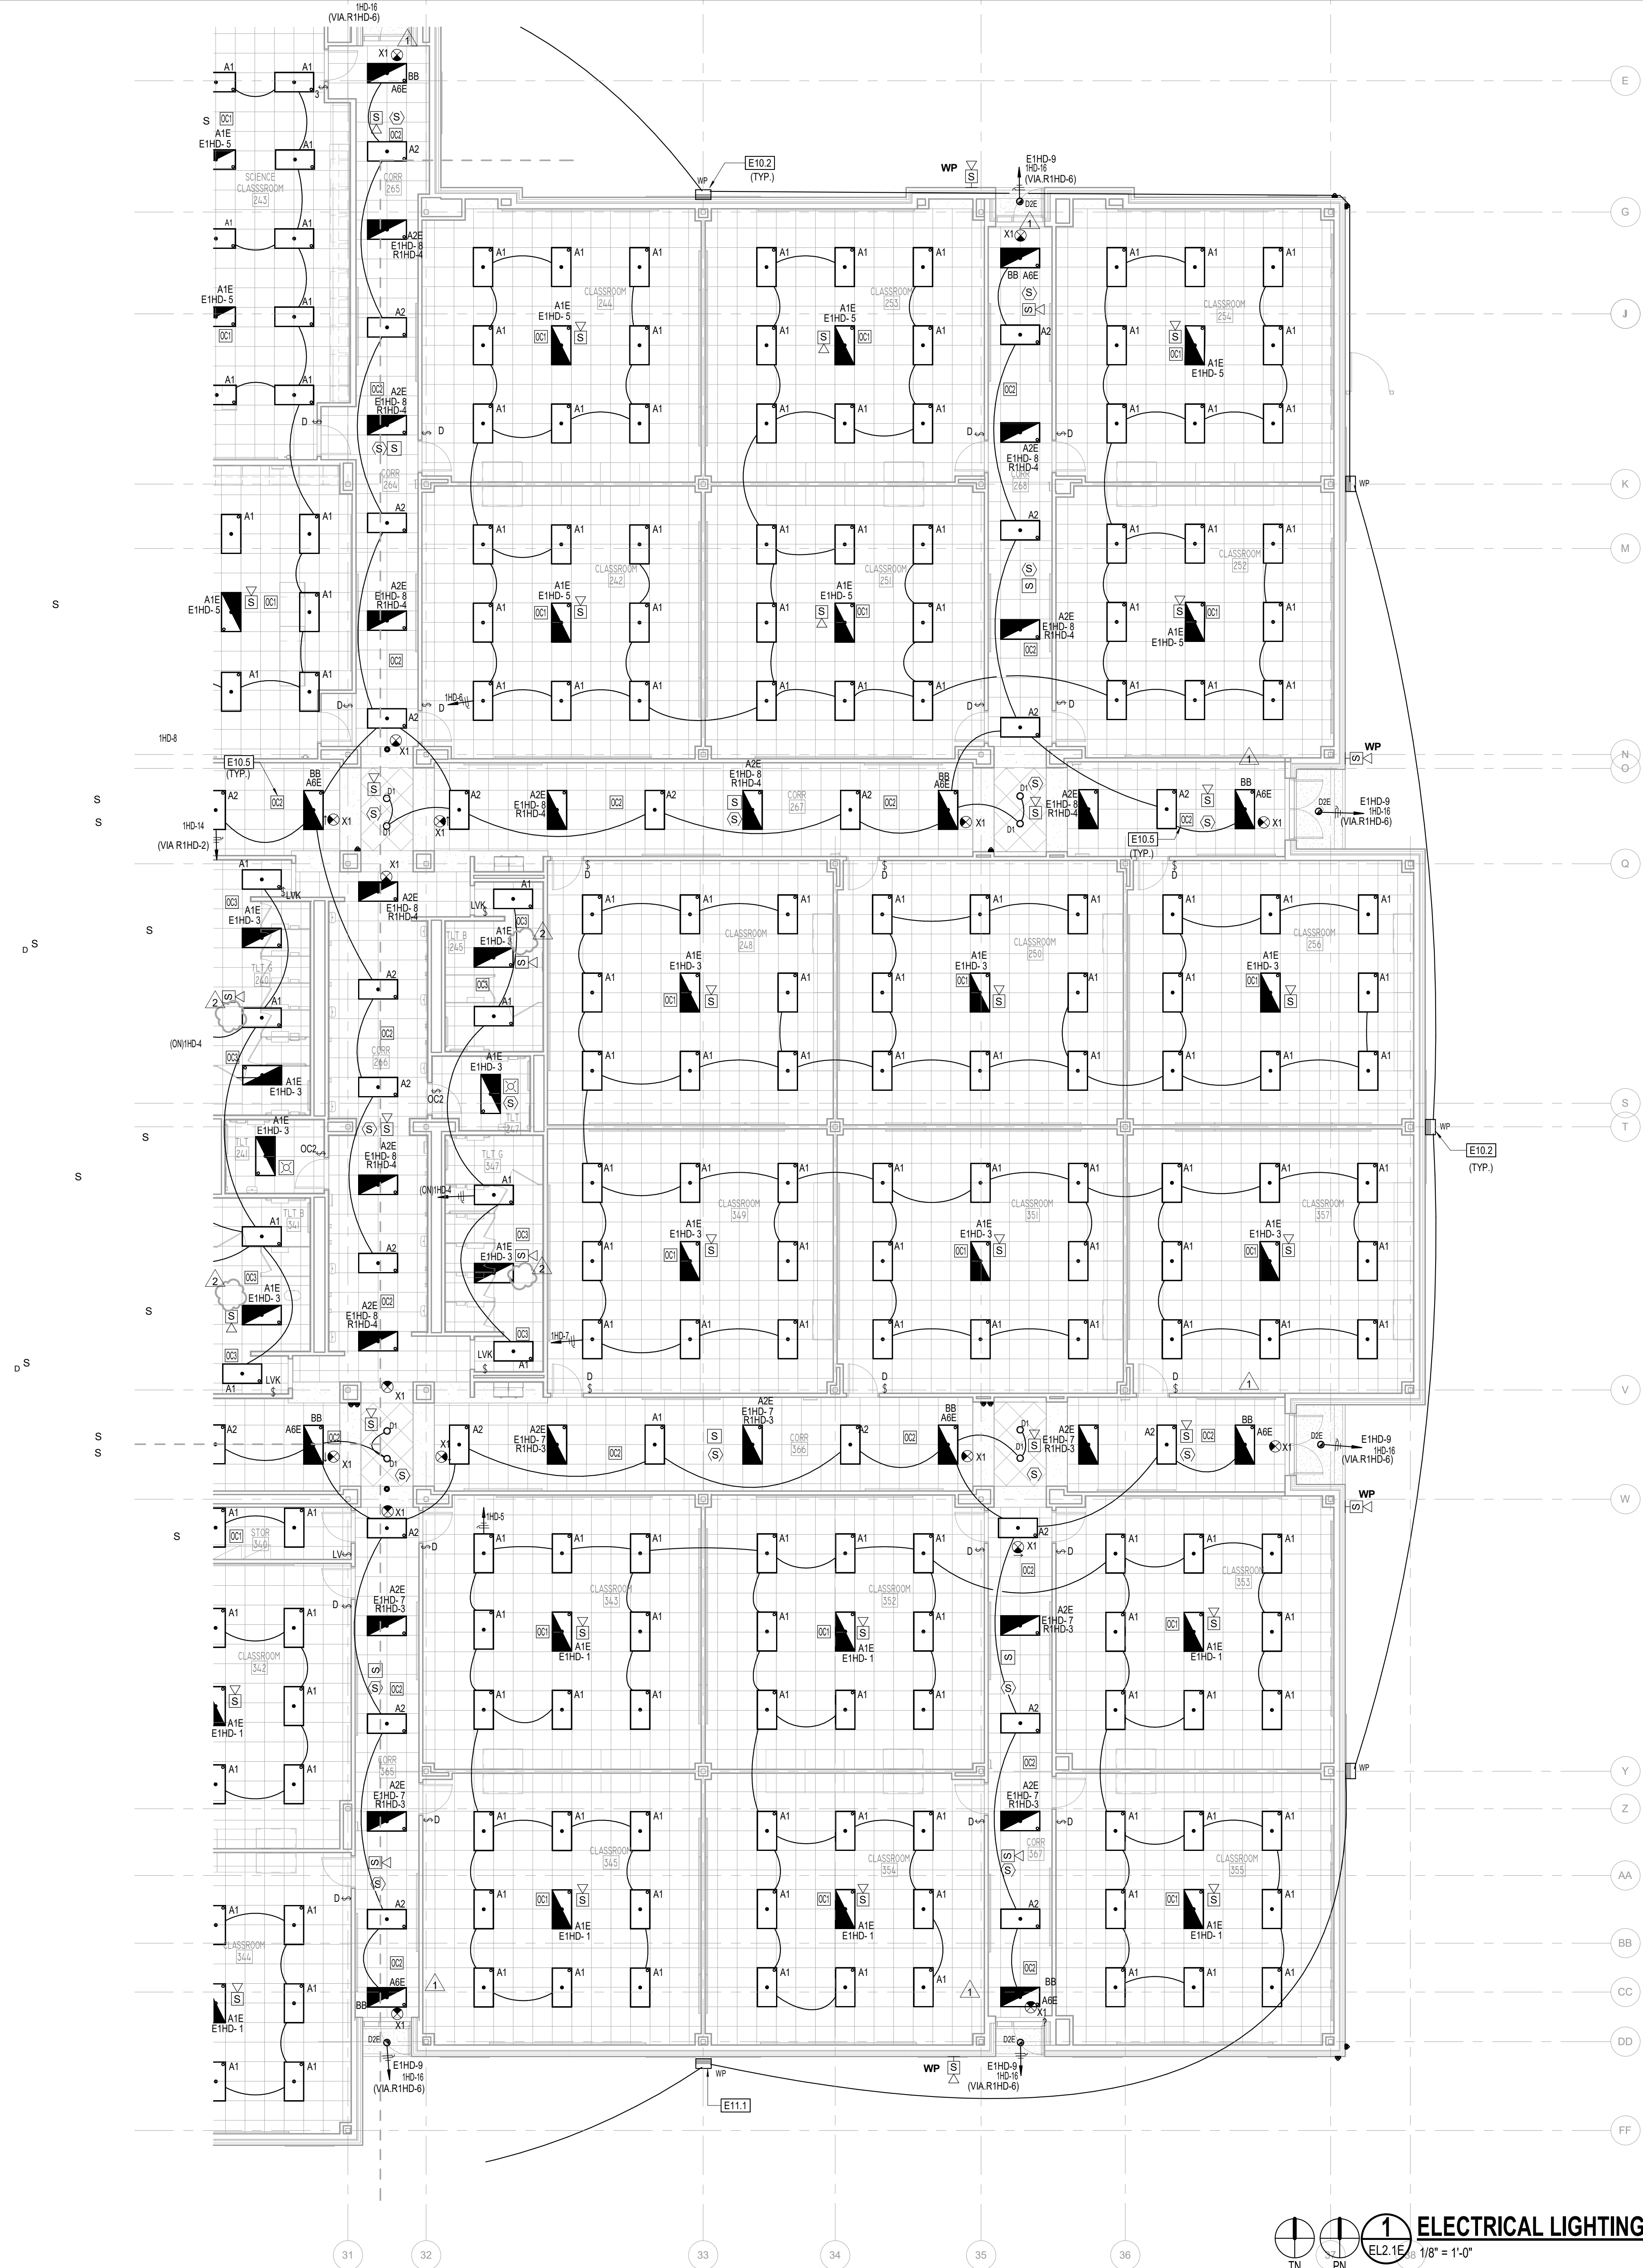



### GENERAL NOTE

- A REFER TO SHEET E0.2 FOR GENERAL NOTES.  
B REFER TO SHEET E0.2 FOR CORRIDOR LIGHTING SEQUENCE OF OPERATIONS NOTES.

### ELECTRICAL KEYED NOTES

- E10.2 EXTERIOR LIGHTING SHALL BE CONTROLLED BY RELAY PANEL WITH SCHEDULE AND PHOTOCELL OVERRIDE PER 2018 IECC CODE REQUIREMENTS. PHOTOCELL SHALL BE INTEGRATED WITH LIGHTING RELAY PANEL. COORDINATE SCHEDULE WITH OWNER PARKING LOT POLE LIGHTS SHALL BE CONTROLLED SEPARATELY. PROVIDE CONTACT RELAY TO ALLOW BAS SYSTEM INTEGRATION COORDINATE WITH MECHANICAL CONTROLS CONTRACTOR FOR SYSTEM INTEGRATION.
- E10.5 CORRIDORS SHALL BE CONTROLLED BY LIGHTING CONTROL RELAY SCHEDULE DURING REGULAR OPERATING SCHOOL HOURS. OCCUPANCY SENSOR SHALL CONTROL THE CORRIDOR LIGHTS FOR ON/OFF OPERATING AFTER REGULAR SCHEDULE HOURS. (TYPICAL)
- E11.1 REFER TO ARCHITECT PLANS AND ELEVATION FOR EXACT WALL PACK LOCATIONS (TYPICAL FOR ALL WALL PACKS). CONTRACTOR SHALL COORDINATE WITH ARCHITECT/OWNER PRIOR TO ROUGH-IN.


### KEY PLAN

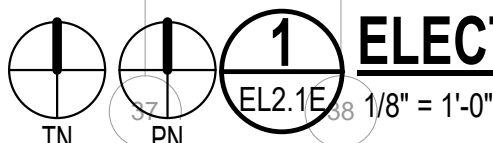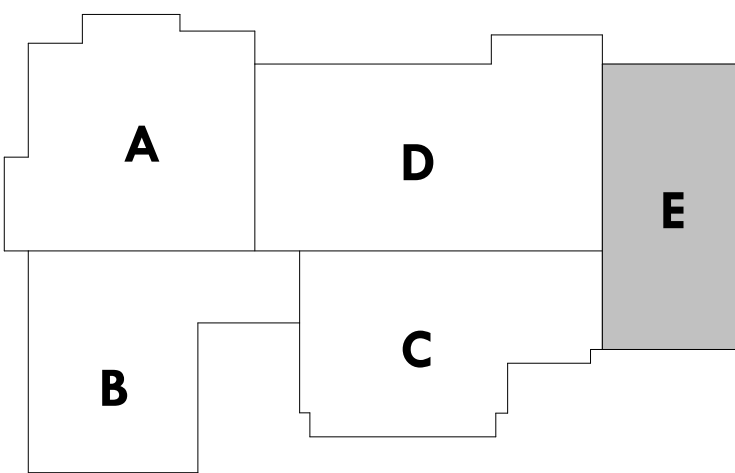

### ELECTRICAL LIGHTING AND SPECIAL SYSTEMS PLAN AREA E

1/8" = 1'-0"

NO.	REVISION	DATE
1	Addendum 1	09.23.2024
2	Addendum 2	10.02.2024

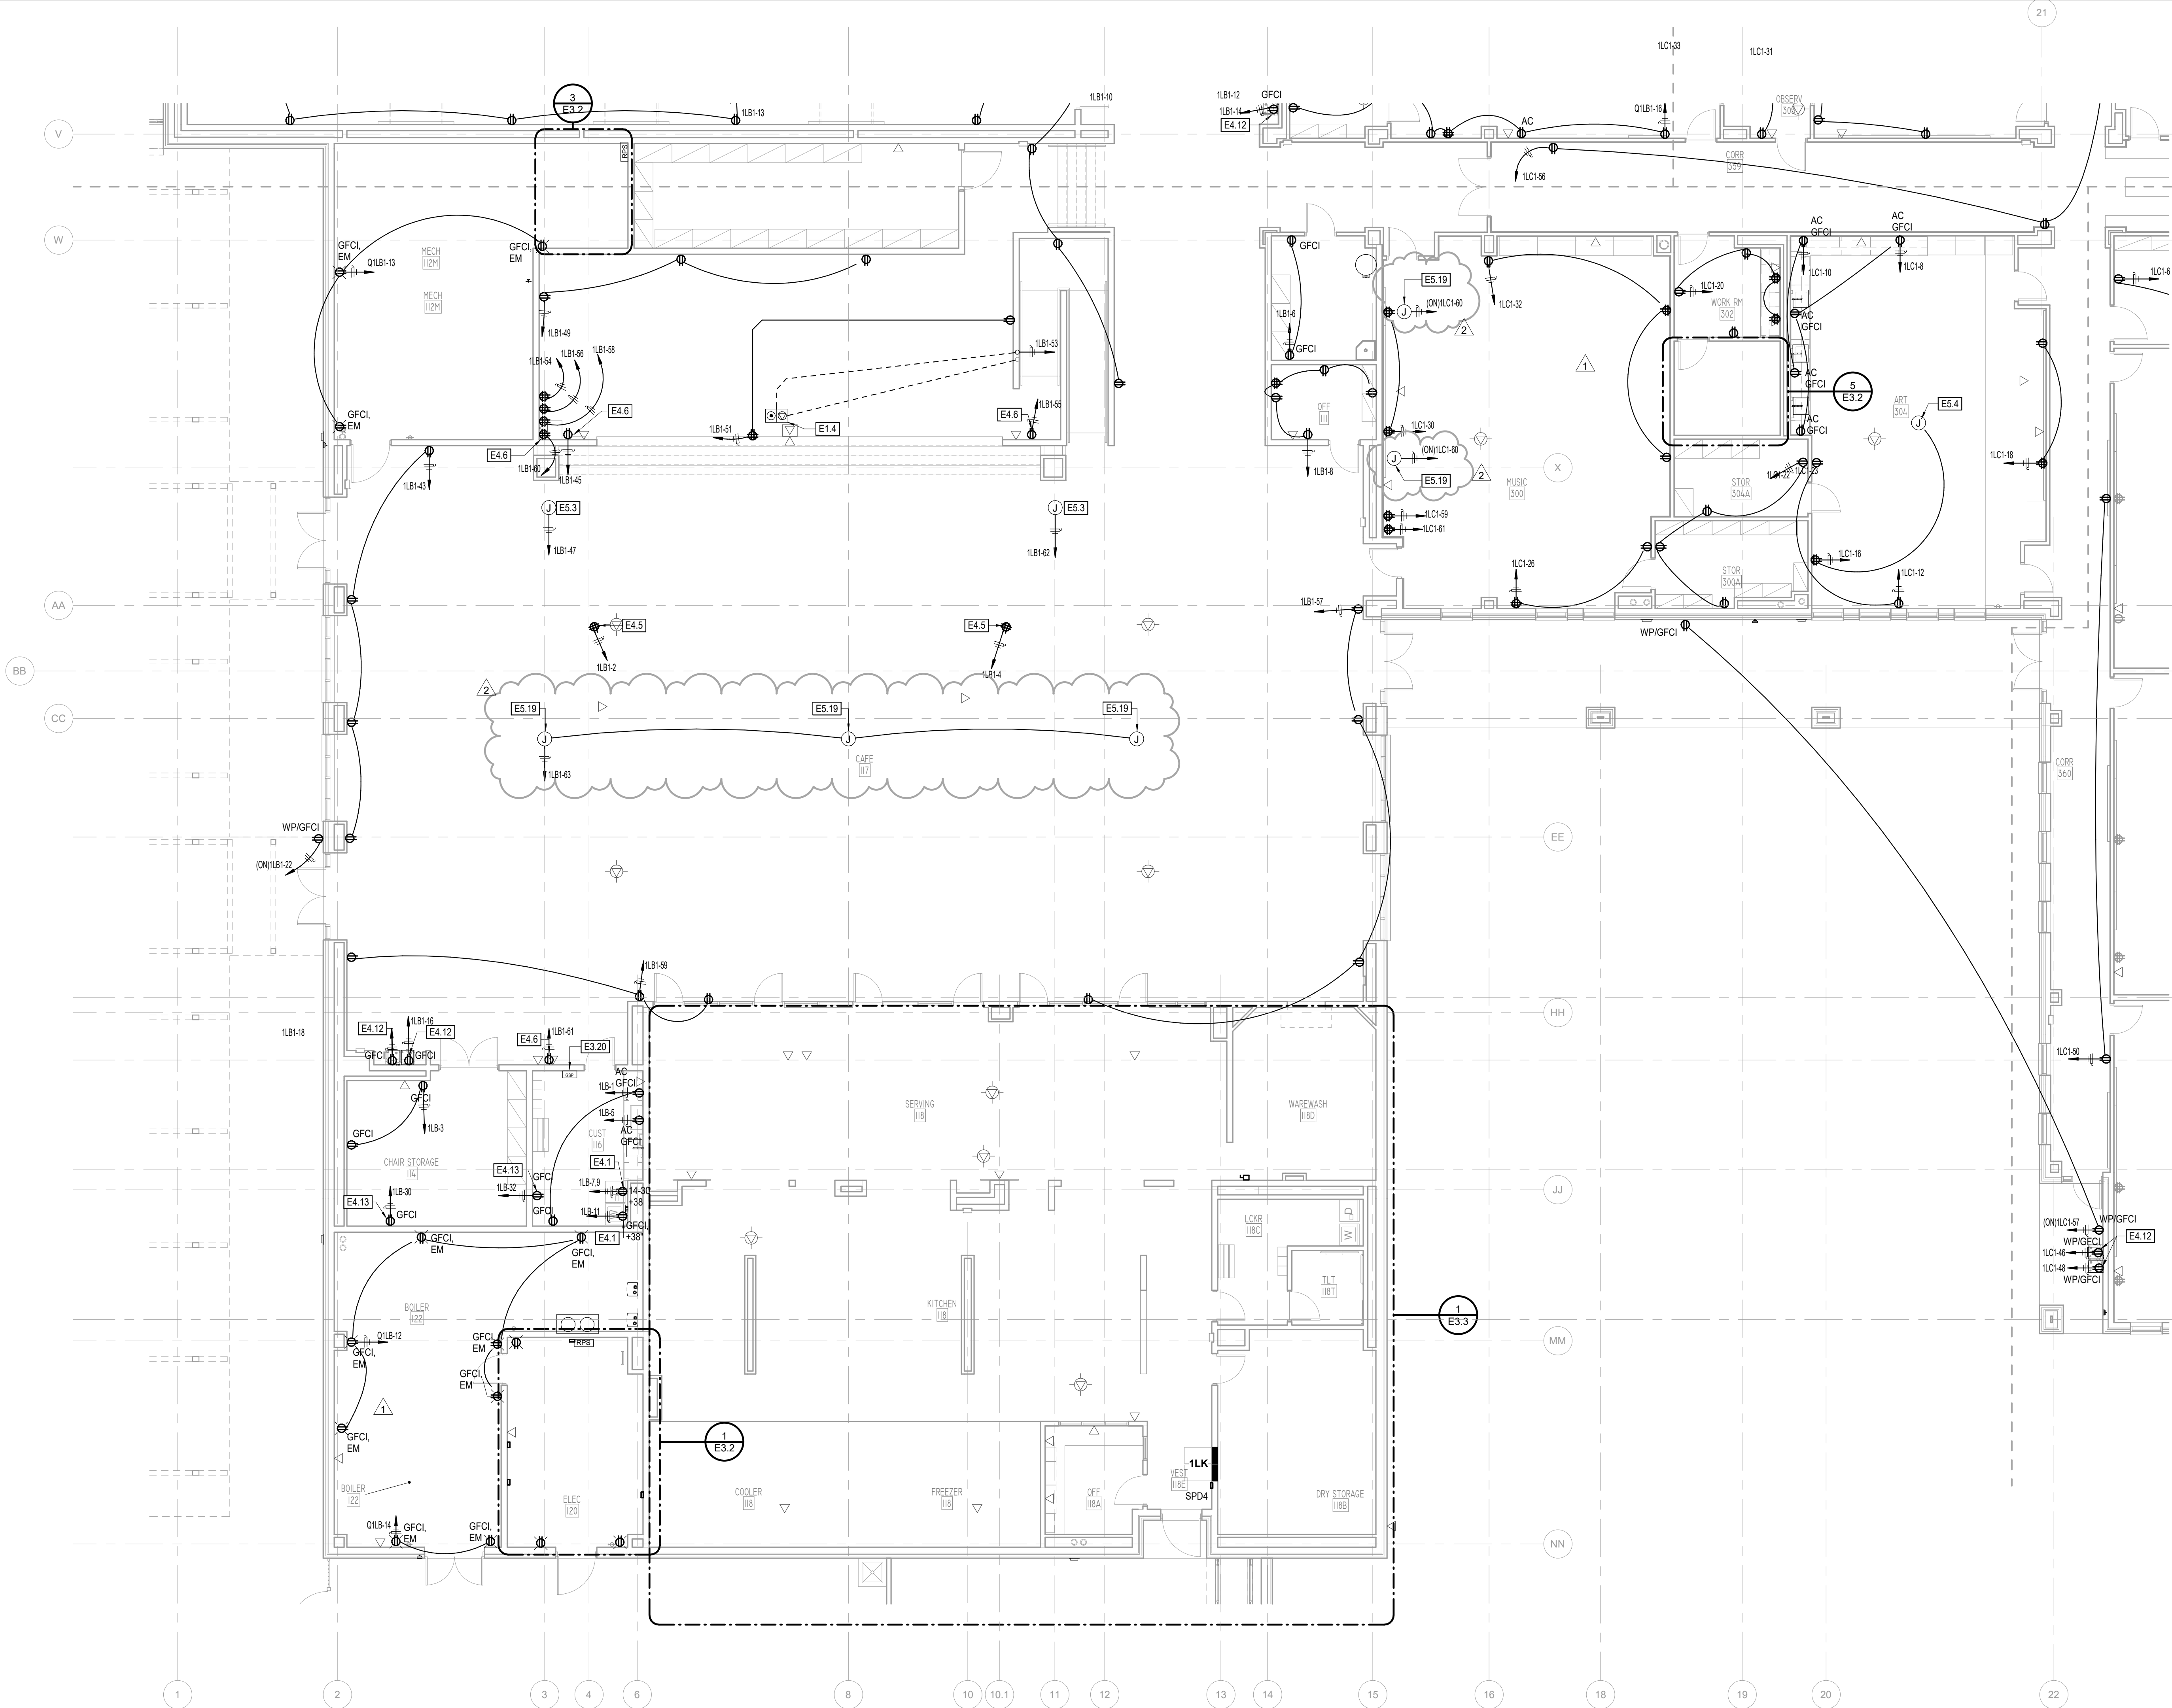


**NOTE TO ELECTRICAL CONTRACTOR:**  
ELECTRICAL CONTRACTOR SHALL PROVIDE CONDUIT, OUTLET BOXES, JUNCTION BOXES FOR ALL TECHNOLOGY, LOW VOLTAGE, ACCESS CONTROL SECURITY, SURVEILLANCE, AND OTHER DIVISION 27/28 SCOPE. REFER TO DIVISION 27/28 DRAWINGS AND SPECIFICATIONS FOR ALL WORK REQUIRED. OMISSION OF THIS SCOPE FROM DIV 26 SCOPE OF WORK IS PROHIBITED.

**GENERAL NOTE**  
A REFER TO SHEET E0.2 FOR GENERAL NOTES.  
B REFER TO SHEET E0.2 FOR CORRIDOR LIGHTING SEQUENCE OF OPERATIONS NOTES.

**ELECTRICAL KEYED NOTES**


- E1.4 PROVIDE A 8-GANG FLOOR BOX, LEGRAND WIREMOLD EVOLUTION EF8885 WITH A EF88101.1X FLUSH STYLE SOLID COVER. XXX DENOTES COLOR AND WILL BE DETERMINED BY THE ARCHITECT. THE EF8885 MUST PROVIDE: 1-HORSE-T, 4-DATA, 2-DUPLEX FOR POWER, 3-MICROPHONE INPUTS, 1-MONITOR OUTPUT. THE EF8885 ACCEPTS STANDARD DEVICE PLATES. ROUTE (1) 1/2" CONDUIT FOR POWER & (1) 1/2" CONDUIT FOR DATA IN THE PLENUM BELOW. TURN UP IN WALL AND ROUTE TO ASSOCIATED LEVEL PLENUM. PROVIDE PULL STRING IN DATA CONDUIT. COORDINATE EXACT LOCATION WITH ARCHITECT, OWNER AND LOW VOLTAGE CONTRACTOR/INSTALLER PRIOR TO ROUGH-IN.
- E3.20 PROPOSED LOCATION OF GENERATOR STATUS PANEL (GSP). FIELD COORDINATE FINAL LOCATION WITHIN ROOM WITH OWNER PRIOR TO ROUGH-IN.
- E4.1 FOR GFCI RECEPTACLES LOCATED BEHIND EQUIPMENT, PROVIDE REMOTE TEST/RESET BUTTON ADJACENT TO EQUIPMENT IN ACCESSIBLE LOCATION.
- E4.5 PROVIDE RECEPTACLE AT CEILING FOR CEILING MOUNTED PROJECTOR. CONFIRM ADDITIONAL REQUIREMENTS WITH FINAL SELECTED EQUIPMENT. FIELD COORDINATE EXACT LOCATION AND REQUIREMENTS WITH AV INSTALLER PRIOR TO ROUGH-IN. COORDINATE CONTROLS WITH OWNER AND AV INSTALLER AND PROVIDE ROUGH-IN CONNECTION AS REQUIRED.
- E4.6 PROVIDE 120V POWER FOR AV RACK(S). FIELD COORDINATE EXACT LOCATION(S). INSTALLATION DETAILS AND ELECTRICAL REQUIREMENTS WITH AV INSTALLER/CONTRACTOR PRIOR TO ROUGH-IN. COORDINATE CONTROLS WITH OWNER AND AV INSTALLER/CONTRACTOR AND PROVIDE ROUGH-IN CONNECTIONS AS REQUIRED.
- E4.12 FOR GFCI RECEPTACLES LOCATED BEHIND EDF, PROVIDE REMOTE TEST/RESET BUTTON 84" A.F.F. IN ACCESSIBLE LOCATION. COORDINATE FINAL LOCATION WITH ARCHITECT/OWNER PRIOR TO ROUGH-IN RE: 19EB.1
- E4.13 PROVIDE 120V DEDICATED POWER FOR FLOOR SWEEPER.
- E5.3 PROVIDE 120V POWER TO JUNCTION BOX FOR PROJECTOR SCREEN. COORDINATE EXACT LOCATION AND EQUIPMENT REQUIREMENTS WITH PROJECTOR SCREEN INSTALLER PRIOR TO ROUGH-IN. COORDINATE CONTROLS WITH OWNER, AV INSTALLER AND PROVIDE ROUGH-IN CONNECTIONS FOR CONTROLS AS REQUIRED.
- E5.4 PROVIDE 120V POWER TO JUNCTION BOX FOR MOTOR SHADES. COORDINATE EXACT LOCATION AND EQUIPMENT REQUIREMENTS WITH MOTOR SHADES INSTALLER PRIOR TO ROUGH-IN. COORDINATE CONTROLS WITH OWNER/ARCHITECT AND PROVIDE ROUGH-IN CONNECTIONS FOR CONTROLS AS REQUIRED. POWER NEEDS TO BE PROVIDED FOR THE LOW WINDOWS AND HIGH WINDOWS. REFER TO ARCHITECTURAL PLANS FOR EXACT LOCATIONS AND ARCHITECTURAL ELEVATIONS.
- E5.19 PROVIDE 120V POWER TO JUNCTION BOX FOR LOCAL SOUND SPEAKER. COORDINATE EXACT LOCATION AND EQUIPMENT REQUIREMENTS WITH SOUND SPEAKER INSTALLER PRIOR TO ROUGH-IN. COORDINATE CONTROLS WITH OWNER, AV INSTALLER AND PROVIDE ROUGH-IN CONNECTIONS FOR CONTROLS AS REQUIRED.

**KEY PLAN**

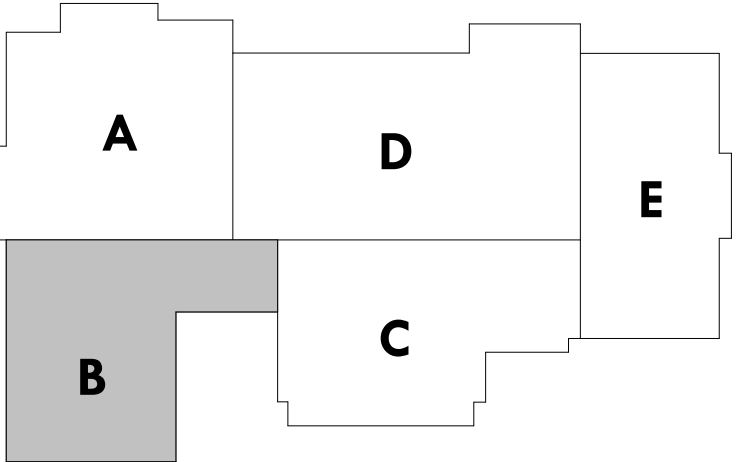

**ELECTRICAL POWER PLAN AREA B**  
1/8" = 1'-0"

**BROWN REYNOLDS WATFORD ARCHITECTS**  
4501 MAGNOLIA COVE DRIVE  
SUITE 250  
HOUSTON, TEXAS 77045  
281-361-3800  
WWW.BRWARCH.COM

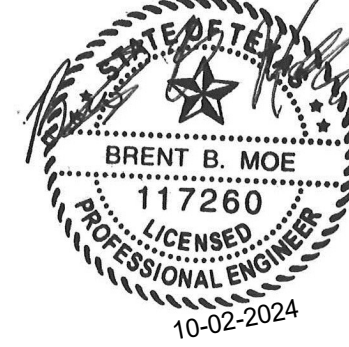

**DBR**  
713.314.8888  
https://www.dbrinc.com  
TYPE: DBR Project # 202039.000  

COPYRIGHT © 2024  
BROWN REYNOLDS WATFORD ARCHITECTS, INC.  
DATE: SEPTEMBER 9, 2024  
DRAWN BY: DBR  
CHECKED BY: DBR  
BRW PROJECT NUMBER: 223117.00

**NEW CANEY I.S.D.**  
**NEW CANEY ELEMENTARY SCHOOL**  
19300 VIA CORSICA DRIVE  
NEW CANEY, TX 77337

NO.	REVISION	DATE
1	Addendum 1	09.23.2024
2	Addendum 2	10.02.2024

**EP2.1B**  
ELECTRICAL POWER  
PLAN AREA B



GROUP	DEVICES	GROUP
-------	---------	-------

DEV

DEVICES

\*# -  
ON THE  
\* SH  
THAT T  
# S  
SPECIF  
B. THE AU  
PRIOR  
C. REFER  
AND IN

'AC'
'AFF'
'AG'
'SM'
'UC'

[illegible]


CC
TEX
'E'
'D'
'R'
'RF'

INTERCOM/PA SPEAKER.  
 7. LOCAL SOUND REINFORCEMENT.

PA SPEAKERS DEVICES:

- (S)<sup>PA</sup> CEILING MOUNTED INTERCOM/PA SPEAKER
- (S) WALL MOUNTED INTERCOM/PA SPEAKER

1. CONTRACTOR SHALL COORDINATING WITH DBR ENGINEER. SHALL BE PERMANENTLY INSTALLED WITHOUT WRITTEN APPROVAL.
2. THE SELECTED, INSTALLING CONTRACTOR MUST BE A CERTIFIED MANUFACTURER TO INSTALL THE CABLE PLANT AND CONNECTIONS. DESCRIPTION.
3. SYSTEM WIRING AND EQUIPMENT INSTALLATION SHALL BE IN ACCORDANCE WITH THE ANSI/IEEE 60.1, IEC 60364 AND THE NEC.

5. PROVIDE AND INSTALL MAGNETIC DOOR CONTACT AT ALL EXITS TO THE BUILDINGS INTRUSION DETECTION SYSTEM.

6. CONTRACTOR TO PROVIDE AND INSTALL A MONITOR RELAY FOR FREEZER/COOLER TEMPERATURE GAUGE AND BACK TO THE CONTROL PANEL. THE MONITOR RELAY SHOULD BE PROGRAMMED TO NOTIFY THE OWNER'S DESIGNATED PERSON.

**NOTES TO**

1. EVERY SYMBOL SHOWN ON LEGEND MAY NOT APPEAR ON THE DEVICE MOUNTING HEIGHTS.
2. REFERENCE SPECIFICATIONS FOR MATERIALS AND METHODS.
3. COMPLETE INSTALLATION OF ALL PRODUCTS SHALL BE IN ACCORDANCE WITH THE MANUFACTURER'S INSTRUCTIONS.
4. ALL EXTERIOR AND WALL MOUNTED CAMERA LOCATIONS ARE TO BE DETERMINED BY THE PROJECT ARCHITECT IN COORDINATION WITH THE GENERAL CONTRACTOR.

EQUIPMENT RACKS/CABINETS		X
WIRELESS ACCESS POINTS	X	
NETWORK SWITCHES	X	
UPS AND PDU	X	
TELEPHONES	X	
WORKSTATION PC	X	


NETWORK CABLING REQUIRED			X
ADMIN PHONE/ MICROPHONES			X
UPS/PDU			X
BACK BOXES, CONDUITS/SLEEVES			X



STAFFORD ARCHITECTS, INC.  
SEPTEMBER 9, 2024  
DBR  
DBR QC  
223117.00

	DATE
	10.02.2024

NO.	REVISION
1	Addendum 2

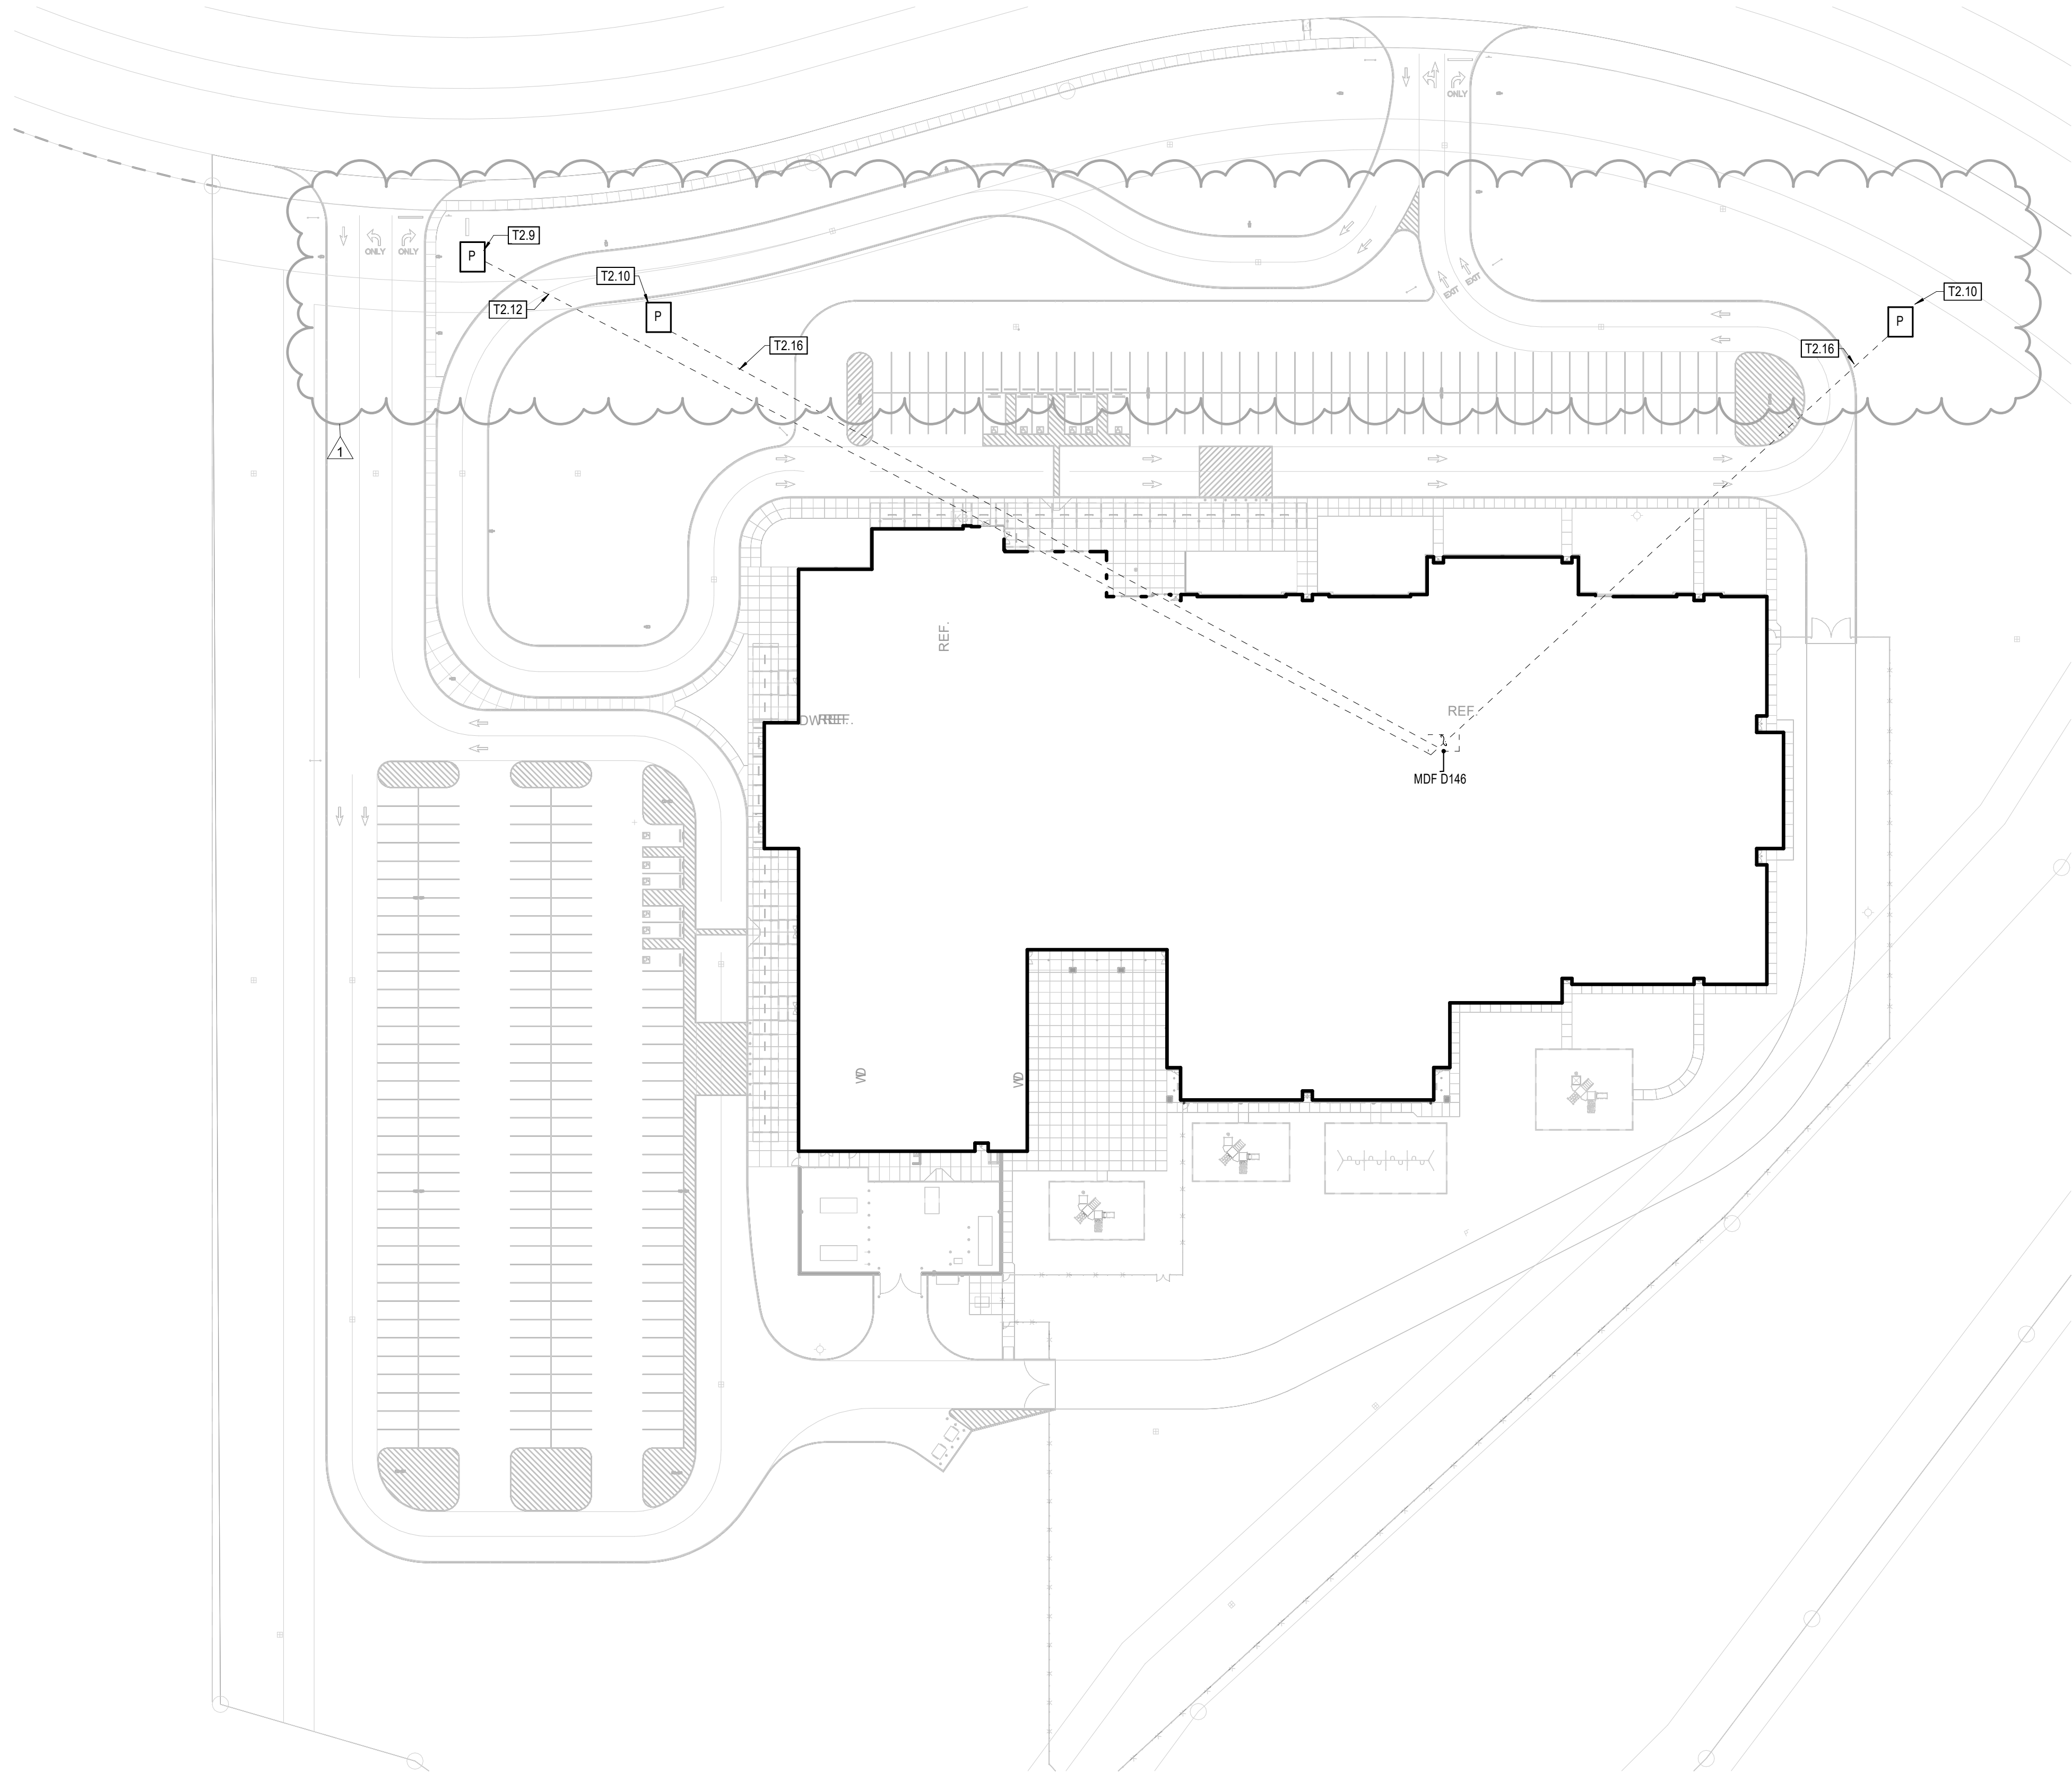

 TN  
 PN  
 T1.1  
**TECHNOLOGY SITE PLAN**  
1" = 50'-0"

**TECHNOLOGY KEYED NOTES**

- T2.9 PROVIDE A 24" W X 36" L X 36" D COMMUNICATIONS HANDHOLE OF HS-20 RATING WITH LOCKABLE COVER. STENCILED WITH "COMMUNICATIONS" MOUNTED FLUSH WITH FINISHED GRADE.
- T2.10 PROVIDE A 48" W X 48" L X 36" D COMMUNICATIONS HANDHOLE OF HS-20 RATING WITH LOCKABLE COVER. STENCILED WITH "COMMUNICATIONS" MOUNTED FLUSH WITH FINISHED GRADE.
- T2.12 PROVIDE ONE (2) 1-INCH CONDUIT TO LOCATION OF MARQUEE SIGN. CONFIRM LOCATION OF SIGN WITH ARCHITECT PRIOR TO INSTALL. LABEL AND CAP CONDUITS FOR FUTURE USE.
- T2.16 PROVIDE ONE (1) 1/4" SCHEDULE 40 PVC AND (1) 1/4" SCHEDULE 40 PVC W/ MANCELL EDGE FABRIC INNERDUCT FOR REDUNDANT FIBER ENTRY.

**GENERAL SITE PLAN NOTES:**

- A. THE CONTRACTOR SHALL REFERENCE ALL OTHER TRADES' CONSTRUCTION DOCUMENTS FOR FULL EXTENT OF THE SITE WORK TO BE PERFORMED. AND FIELD VERIFY THE EXISTING JOB-SITE CONDITIONS BEFORE BIDDING. NO CHANGE ORDER IS ALLOWED FOR INCREASED COST ASSOCIATED WITH CONDITIONS WHICH COULD HAVE BEEN DETERMINED BY EXAMINING THE SITE AND WHOLE PROJECT DOCUMENTS BEFORE SUBMISSION OF PROPOSALS AND/OR BEFORE A CONTRACT IS AWARDED.
- B. ALL CONDUIT AND CABLE RUNS SHOWN ARE DIAGRAMMATIC AND FOR DESIGN INTENT ONLY. CONTRACTOR SHALL COORDINATE WITH INCOMING SERVICE PROVIDERS AND OTHER TRADES (ELECTRICAL, CIVIL, ETC.) FOR THE EXACT ROUTE AND SHARED TRENCHES, IF APPLICABLE. CONTRACTOR SHALL MAKE ANY FIELD ADJUSTMENT TO THE ROUTE AS NECESSARY, AT NO ADDITIONAL COST TO THE PROJECT OR OWNER, TO AVOID COLLISION AND MEET THE PROJECT REQUIREMENTS.
- C. ONLY SWEEP BENDS ARE ALLOWED FOR ALL OSP COMMUNICATIONS CONDUITS. ALL UNDERGROUND CONDUITS SHALL ENTER THE COMMUNICATIONS MANHOLE/HANDHOLE FROM THE SIDE WALLS AND BE PROPERLY SEALED TO PREVENT WATER INFILTRATION.
- D. ALL UNDERGROUND COMMUNICATIONS CONDUITS SHALL BE BURIED AT MINIMUM 3 FEET FROM FINISHED GRADE, AND SLOPE AWAY FROM BUILDING, UNLESS OTHERWISE NOTED.

**BROWN REYNOLDS WATFORD ARCHITECTS**  
4501 MAGNOLIA COVE DRIVE  
SUITE 200  
DALLAS, TEXAS 77345  
281.361.3800  
WWW.BRWARCH.COM




COPYRIGHT © 2024  
BROWN REYNOLDS WATFORD ARCHITECTS, INC.  
DATE: SEPTEMBER 9, 2024  
DRAWN BY: DBR  
CHECKED BY: DBR QC  
BRW PROJECT NUMBER: 223117.00

**NEW CANEY I.S.D.**  
**NEW CANEY ELEMENTARY SCHOOL**  
19300 VIA CORSICA DRIVE  
NEW CANEY, TX 77337


NO.	REVISION	DATE
1	Addendum 2	10.02.2024

**KEY PLAN**

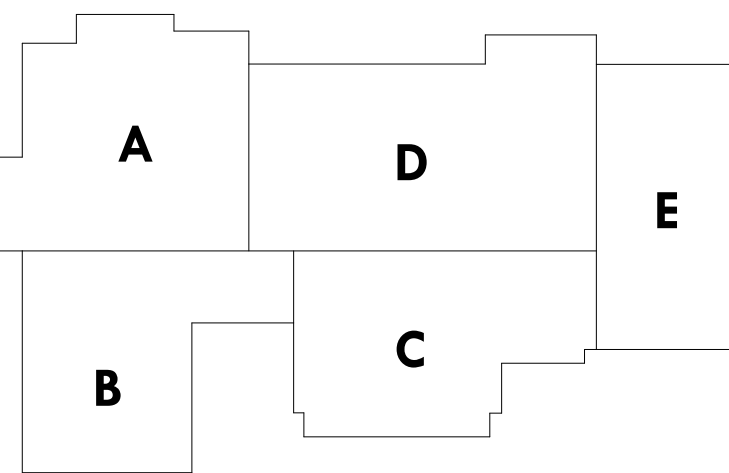

**T1.1**  
TECHNOLOGY SITE PLAN



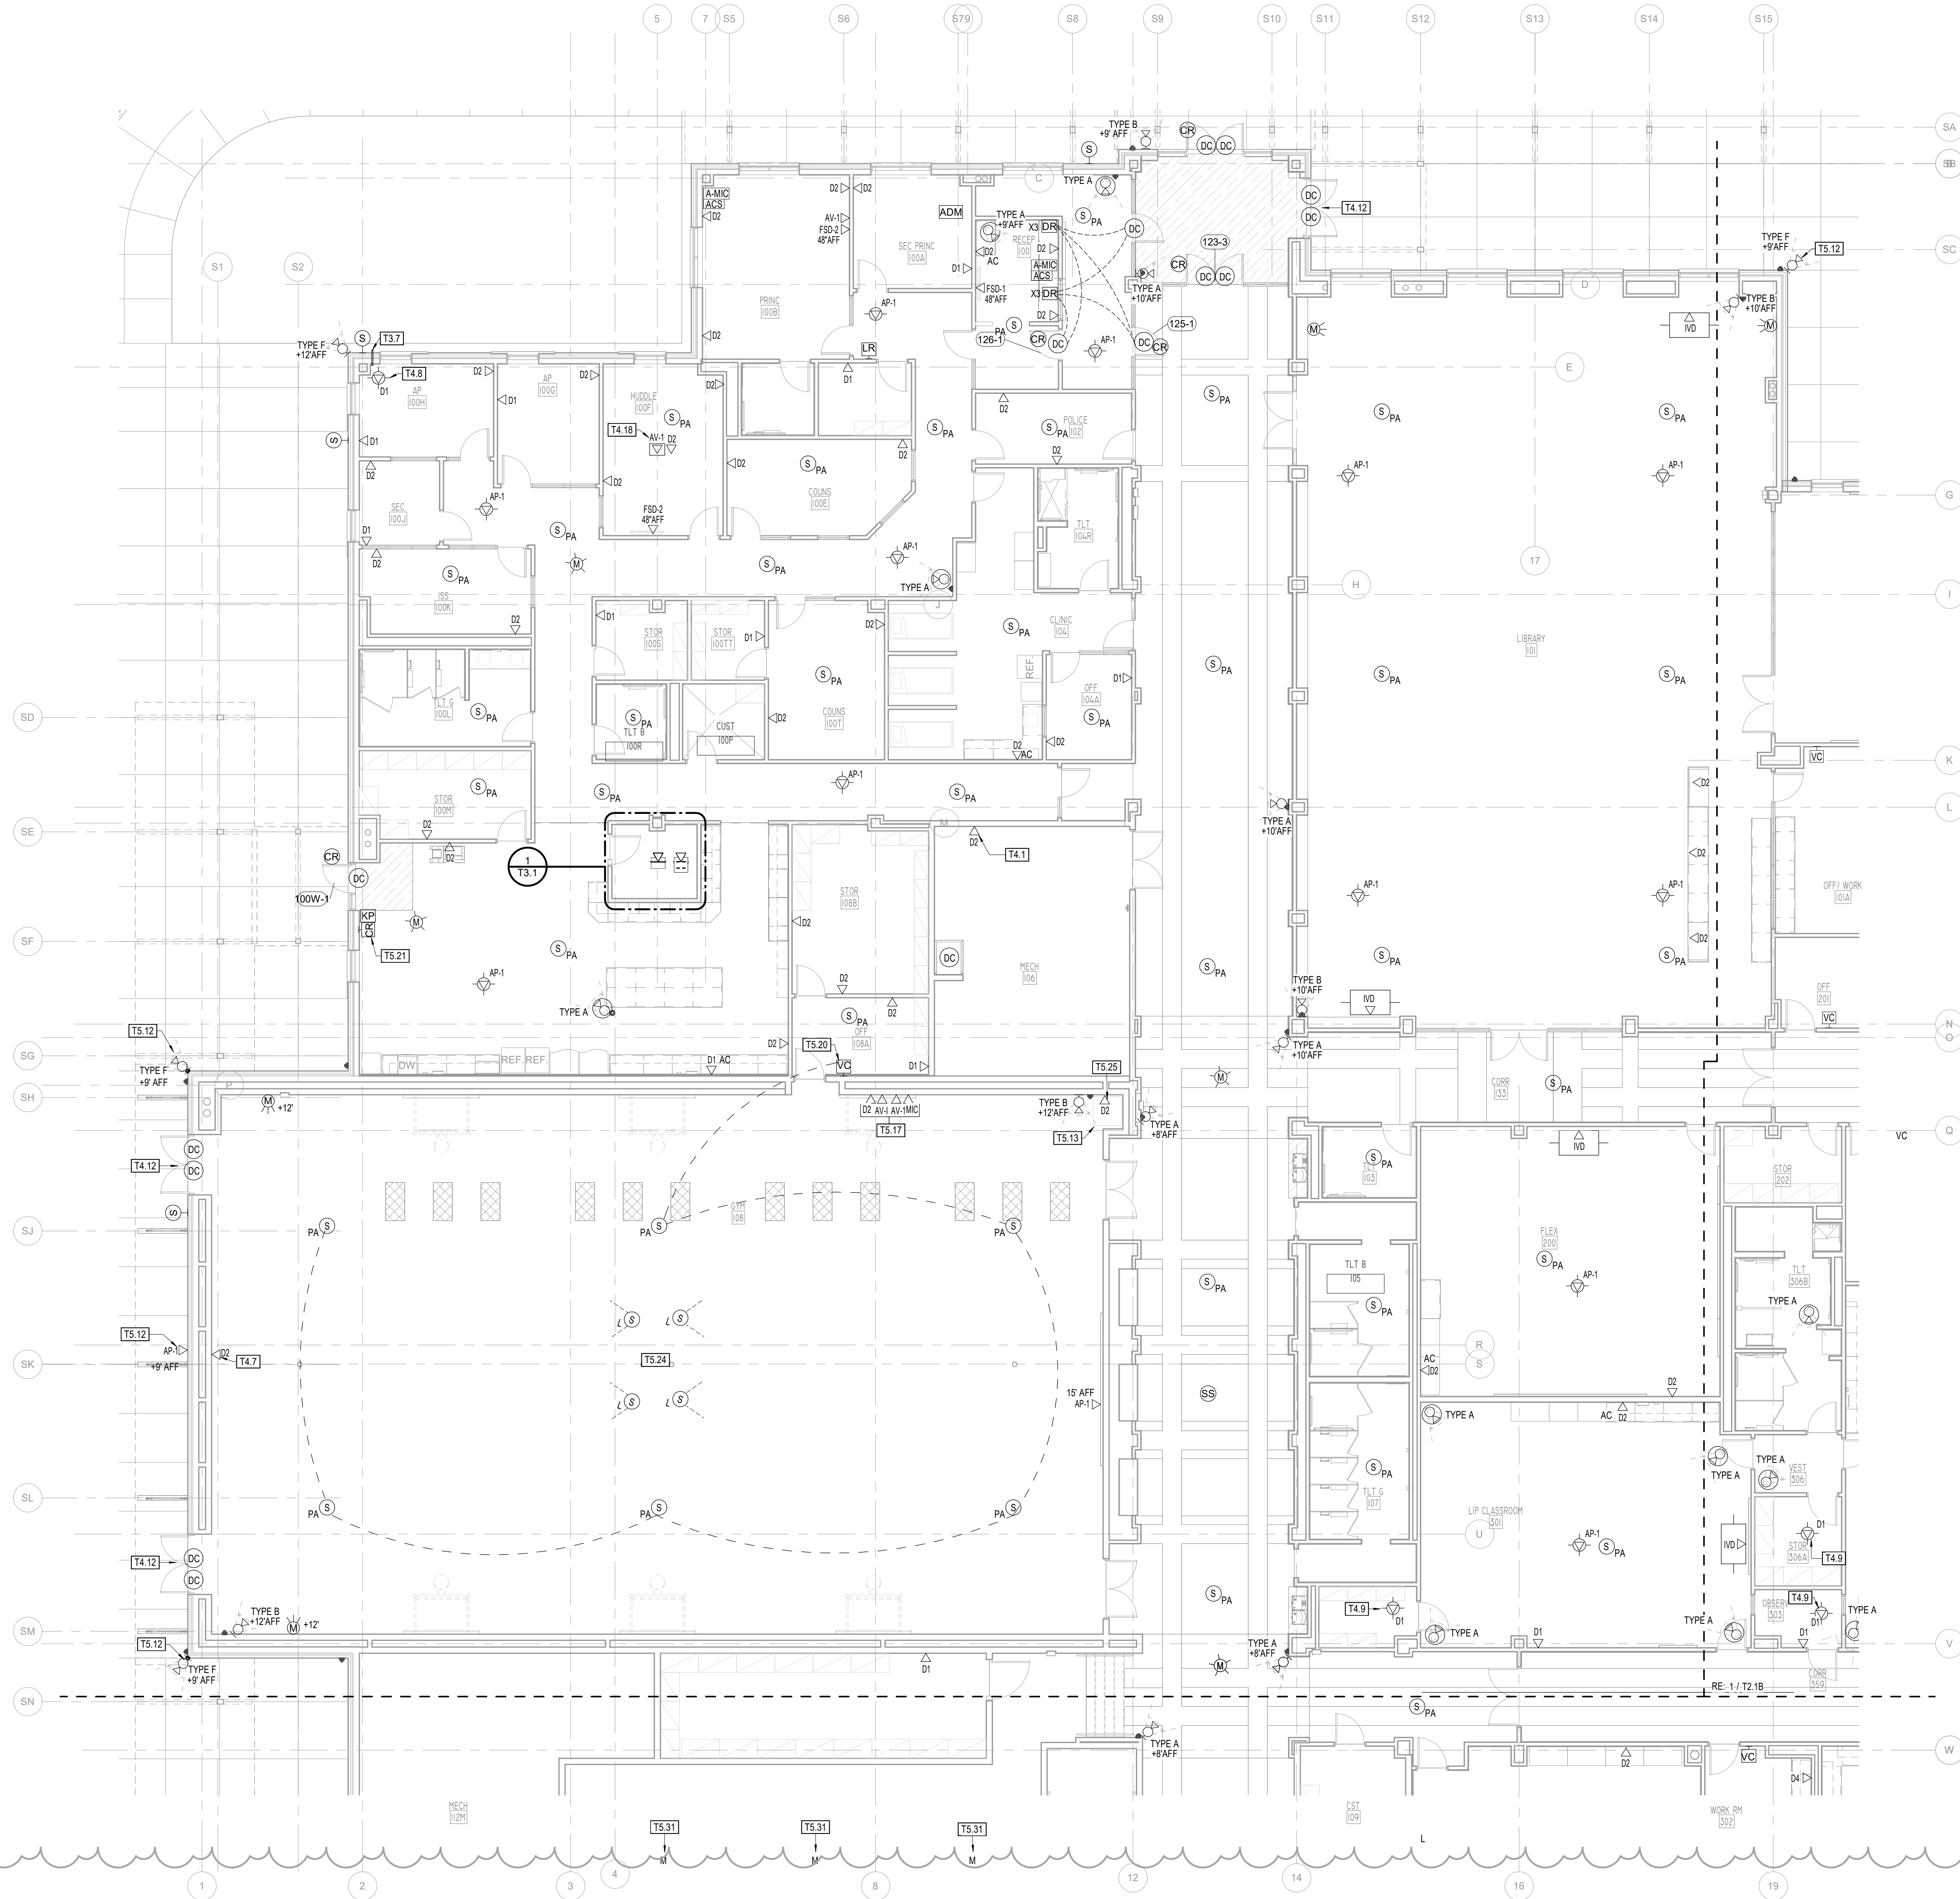

TECHNOLOGY KEYED NOTES


- T3.7 PROVIDE (1) 1-1/2" CONDUIT FOR EXTERIOR WALL MOUNTED ANTENNA CONDUIT STUB OUT.
- T4.1 DATA OUTLET RESERVED FOR BUILDING AUTOMATION SYSTEM EQUIPMENT. TERMINATE CABLE TO A BISCUIT JACK AND COORDINATE WITH BAS INSTALLATION CONTRACTOR FOR EXACT MOUNTING HEIGHT AND LOCATION.
- T4.7 DATA AT 14" AFF FOR LU HEART (HEAD END CONTROLLER)
- T4.8 ABOVE CEILING DATA FOR MARQUEE ANTENNA
- T4.9 PROVIDE (1) DATA CABLE FOR FUTURE CAMERA WITH 25' OF COILED SERVICE LOOP. PROVIDE DATA CABLE AND BISCUIT BOX.
- T4.12 PREPARE DOOR FOR FUTURE DOOR MOUNTED CARD READERS. CONTRACTOR SHALL PROVIDE CONDUIT ROUGH IN REQUIRED. COORDINATE CONDUIT INSTALLATION WITH DIV. 5 CONTRACTOR.
- T4.18 PROVIDE HUB/ASSET TRANSMITTER AND RECEIVER KIT. PROVIDE OSP RATED CAT6 CABLE FOR INTERCONNECTING BETWEEN TRANSMITTER AND RECEIVER.
- T5.12 MOUNT BELOW CANOPY. MUST MAINTAIN VIEW UNDER CANOPIES. FIELD COORDINATE FINAL ELEVATION PRIOR TO ROUGH IN.
- T5.13 INDICATES LOCATION OF AV SYSTEM ENCLOSURE. PROVIDE A IN WALL 14"x14" JUNCTION BOX. ALL CONDUIT IS TO ROUTE IN WALL TO JUNCTION BOX. COORDINATE REQUIRED CONDUITS WITH AV AND CABLEING CONTRACTOR. SURFACE MOUNTED CONDUIT WILL NOT BE ACCEPTED
- T5.17 INSTALL GYMNASIUM AUDIO INPUT PLATE (AV-1) AV HDMI PLATE (AV-1) MICROPHONE INPUT PLATE (MIC) IN RECESSED 4-GANG BACK BOX.
- T5.20 VOLUME CONTROL SHALL CONTROL GYM PUBLIC ADDRESS SPEAKERS.
- T5.21 INTRUSION SYSTEM ARMING CARD READER.
- T5.24 GYMNASIUM LOCAL SOUND SPEAKERS ARE TO BE SECURED FROM STRUCTURE. ANGLED AS TO PROVIDE COMPLETE COVERAGE OF THE GYMNASIUM. FIELD COORDINATE EXACT LOCATION
- T5.25 DATA DROP IS TO BE INSTALLED INSIDE AV ENCLOSURE COORDINATE LOCATION WITH AV INSTALLER.
- T5.31 PROVIDE HANGING MICROPHONES. COORDINATE EXACT LOCATION WITH ARCHITECT PRIOR TO ROUGH IN

GENERAL FLOOR PLAN NOTES:

1. ALL TECHNOLOGY DEVICES, OUTLETS AND CABLE/CONDUIT PATHWAYS SHOWN ARE DIAGRAMMATIC ONLY AND ARE NOT MEANT TO SHOW THE EXACT LOCATION OR ROUTE. CONTRACTOR SHALL VERIFY WITH ARCHITECT AND OWNER FOR EXACT ROUTE, MOUNTING HEIGHT, AND LOCATION BEFORE INSTALLATION, AND SHALL COORDINATE WITH OTHER TRADES TO MAKE ANY FIELD ADJUSTMENTS AS NECESSARY TO AVOID COLLISIONS AND MEET THE PROJECT REQUIREMENTS.
2. CONDUITS AND BACKBOXES, SIZED PER DIV 27/28 SPECIFICATIONS, SHALL BE PROVIDED (BY DIV 26) FOR ALL TECHNOLOGY SYSTEM DEVICES MOUNTED ON WALL, FLOOR, AND OPEN OR SOLID FINISH CEILING. CONDUITS/SLEEVES SHALL BE PROVIDED FOR ALL CABLES ROUTED IN WALLS, OR THROUGH FULL HEIGHT PARTITIONS, OR THROUGH INACCESSIBLE CEILING PLENUM, OR THROUGH SPACES WITH EXPOSED CEILING DECK.
3. CABLES FOR DIFFERENT APPLICATIONS (DATA, AUDIO, VIDEO, SECURITY, ETC.) OR OF DIFFERENT MEDIA TYPE (COAX, UTP, ETC.) SHALL BE ROUTED IN SEPARATE PATHWAYS IN J-HOOKS, CONDUITS, SLEEVES, CORES, ETC. THROUGHOUT THE ENTIRE PATHWAY.
4. BUSHINGS SHALL BE INSTALLED AT EACH END OF THE CONDUITS BEFORE CABLES BEING PULLED THROUGH. PROVIDE PULL STRING IN EACH CONDUIT INSTALLED AND LEAVE ONE FOR FUTURE PULLING AFTER CABLE INSTALLATION IS COMPLETE.
5. NO NETWORK DATA CABLE RUN SHALL EXCEED 295 FEET IN TOTAL LENGTH INCLUDING UP/DOWN AND SERVICE LOOPS WITHOUT PRIOR APPROVAL FROM THE ARCHITECT AND ENGINEER. CONTRACTOR SHALL COORDINATE WITH OTHER TRADES FOR PROPER PATHWAY PLANNING.
6. ANY CATEGORY 6/6A CABLE ROUTING UNDER THE BUILDING SLAB SHALL BE OSP RATED CONTRACTOR IS TO TRANSITION PLENUM RATED CABLEING TO OSP WITHIN 10' OF CONDUIT ROUTING UNDER THE BUILDING SLAB.
7. ALL EXTERIOR DOORS NEED TO BE PREPPED FOR FUTURE CARD READERS.
8. ALL CEILING MOUNTED CAMERAS SHALL BE SECURED TO CEILING TILE USING TOGGLE BOLTS.
9. EXTERIOR CARD READERS SHALL DISARM INTRUSION SYSTEM. COORDINATE EXACT ZONING AND PROGRAMMING REQUIREMENTS WITH OWNER.

CONTRACTOR SHALL WALK EACH CAMERA LOCATION WITH THE OWNER PRIOR TO INSTALLATION. OWNER IS TO PROVIDE FINAL APPROVAL.

KEY PLAN

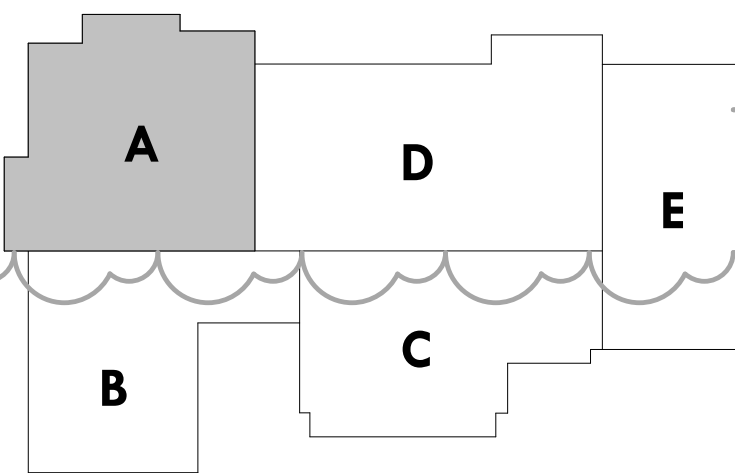

TECHNOLOGY PLAN AREA A  
1/8" = 1'-0"

**BROWN REYNOLDS WATFORD ARCHITECTS**  
4501 MAGNOLIA COVE DRIVE  
SUITE 250  
DALLAS, TEXAS 77345  
281-361-3800  
WWW.BRWARCH.COM

**Bicsi**  
REGISTERED COMMUNICATIONS DISTRIBUTION DESIGNER  
Michael Quitt  
BICS ID # 187703  
EXPIRES 12-31-28  
RCD # 202035.000  
9/27/2024


**DBR**  
713.314.8888 P  
https://www.dbrinc.com  
TYPE: 1000  
DBR Project # 220335.000  
BW PARKWISLE (UTN) AD

COPYRIGHT © 2024  
BROWN REYNOLDS WATFORD ARCHITECTS, INC.  
DATE: SEPTEMBER 9, 2024  
DRAWN BY: DBR  
CHECKED BY: DBR QC  
BRW PROJECT NUMBER: 223117.00

**NEW CANEY I.S.D.**  
**NEW CANEY ELEMENTARY SCHOOL**  
19300 VIA CORSICA DRIVE  
NEW CANEY, TX 77337

NO.	REVISION	DATE
1	Addendum 2	10.02.2024

**T2.1A**  
TECHNOLOGY PLAN  
AREA A

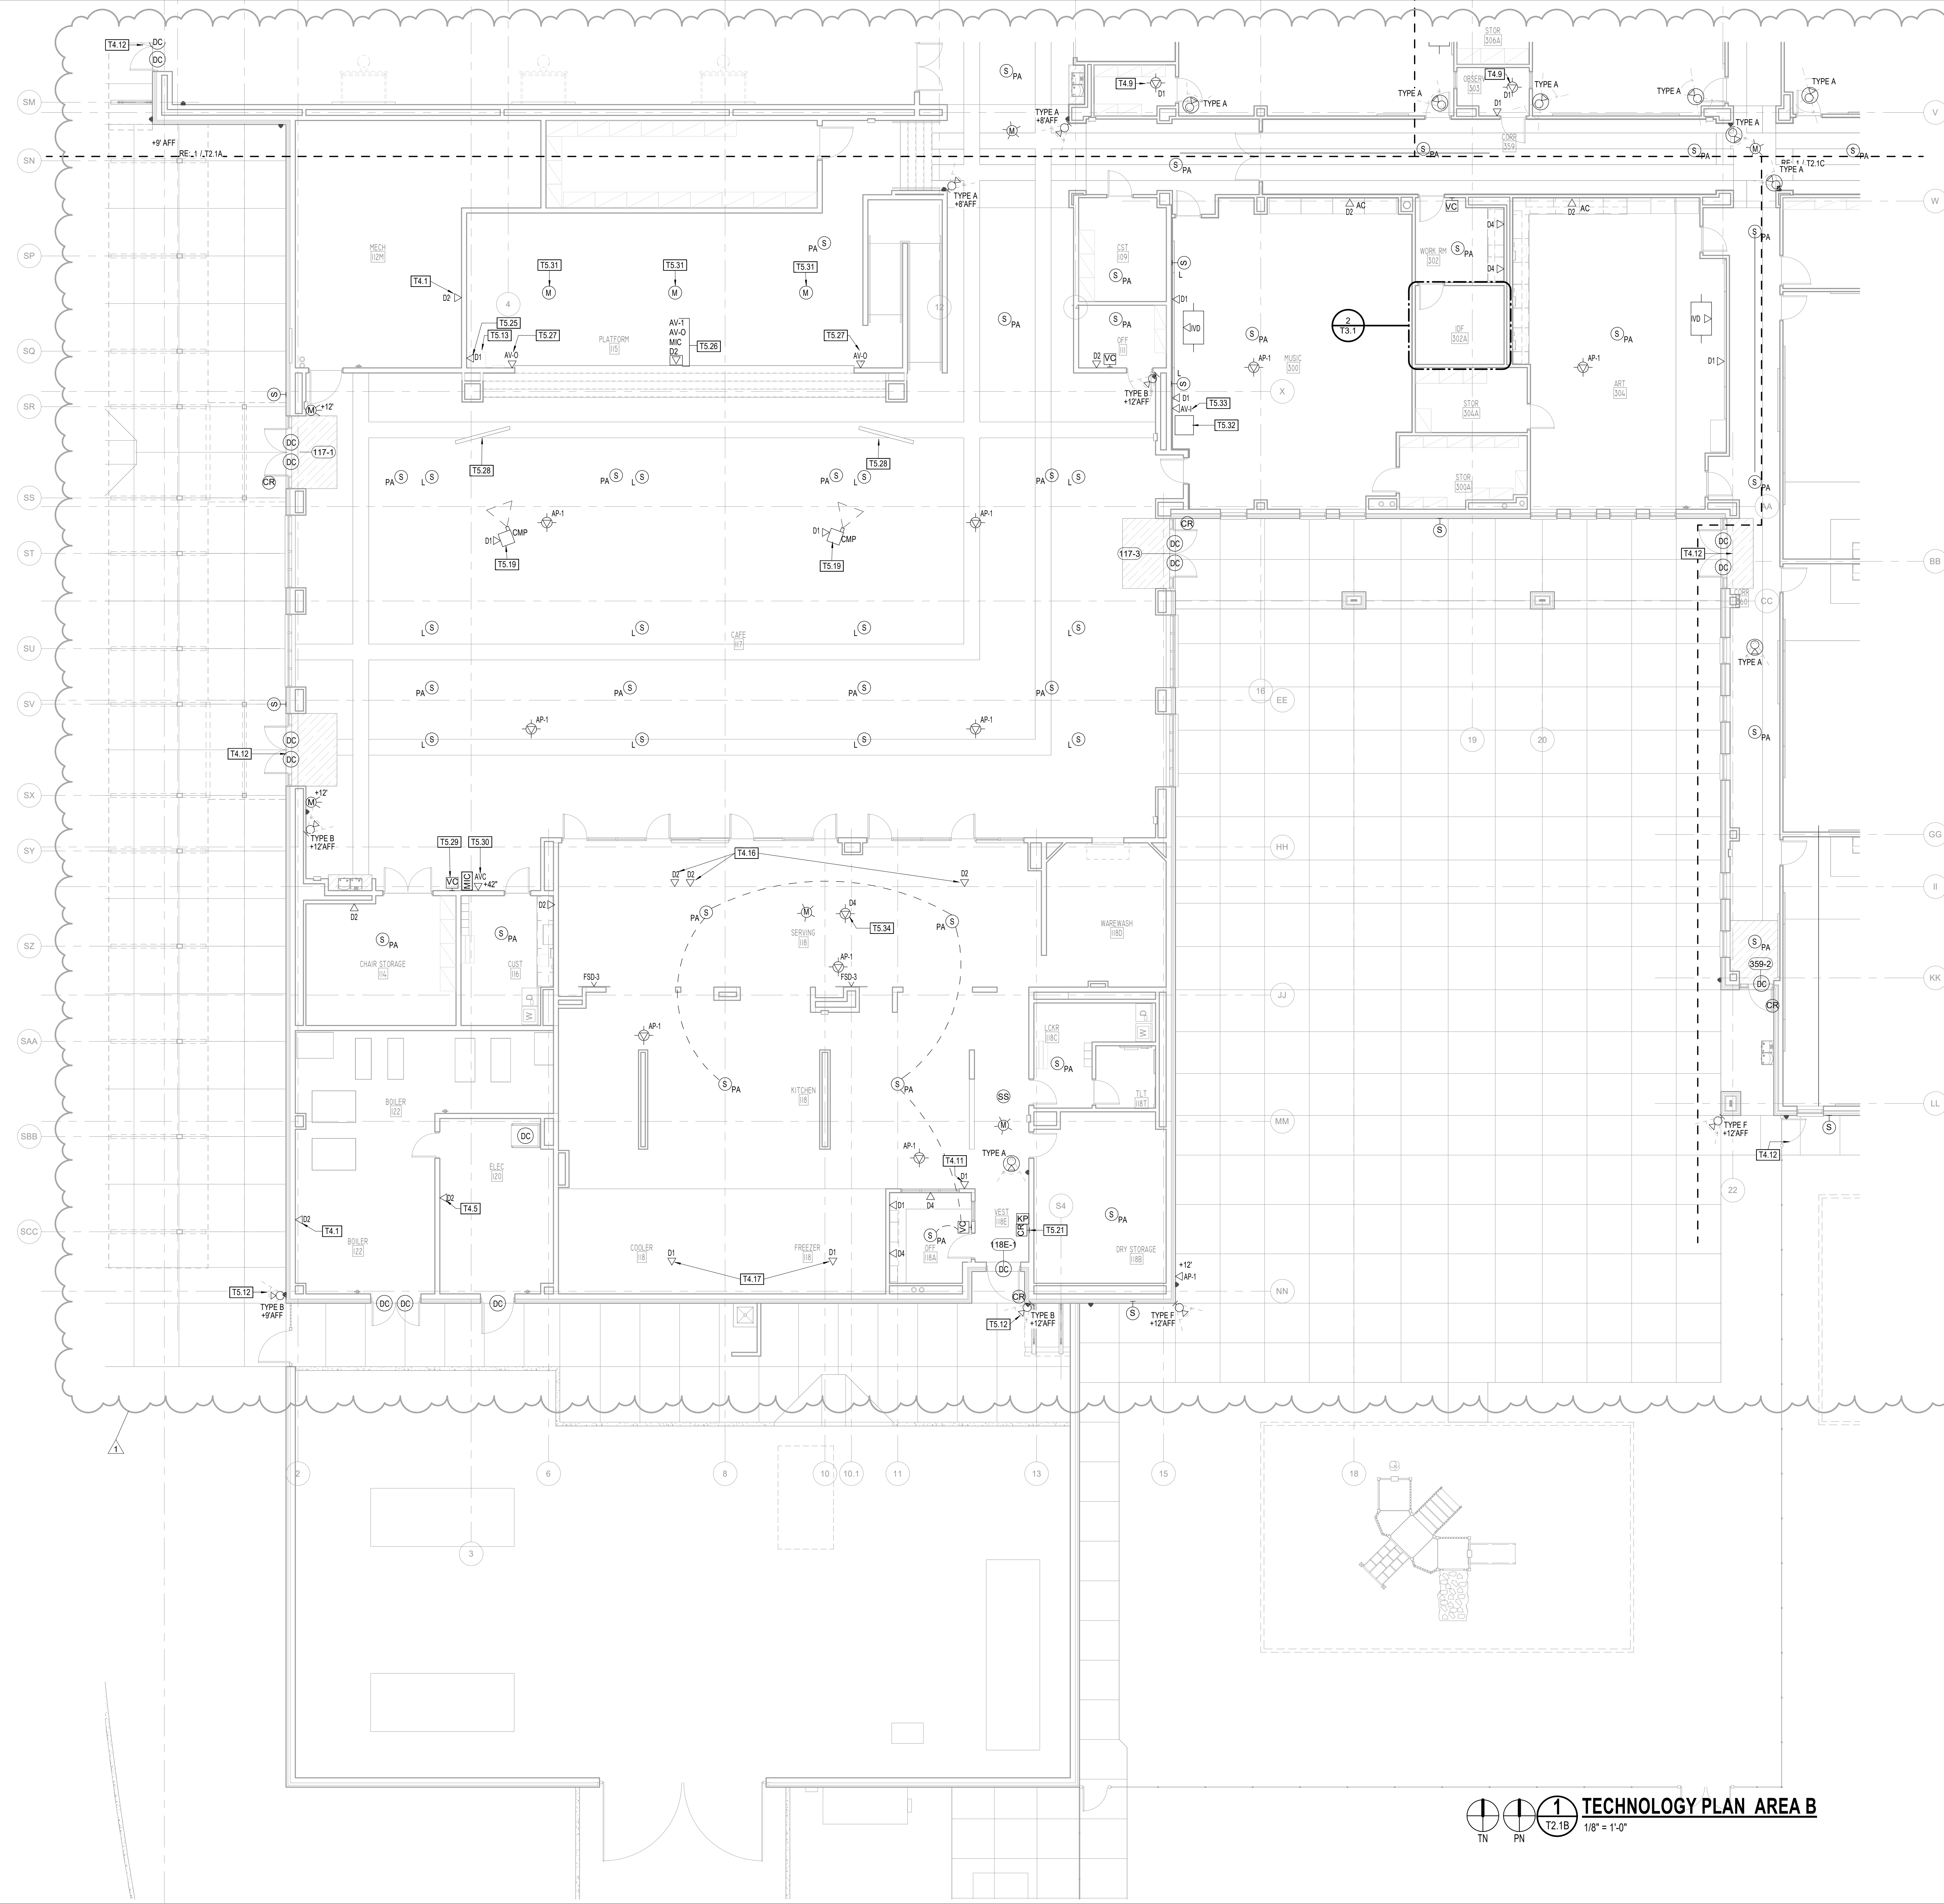

TECHNOLOGY KEYED NOTES


- T4.1 DATA OUTLET RESERVED FOR BUILDING AUTOMATION SYSTEM EQUIPMENT. TERMINATE CABLE TO A BISCUIT JACK AND COORDINATE WITH BAS INSTALLATION CONTRACTOR FOR EXACT MOUNTING HEIGHT AND LOCATION.
- T4.5 DATA OUTLET RESERVED FOR LIGHTING CONTROL SYSTEM. COORDINATE EXACT LOCATION WITH OWNER.
- T4.9 PROVIDE (1) DATA CABLE FOR FUTURE CAMERA WITH 25' OF COILED SERVICE LOOP. PROVIDE DATA CABLE AND BISCUIT BOX.
- T4.11 DATA FOR FREEZER/COOLER MONITORING. SHALL BE INSTALLED 12" BELOW CEILING.
- T4.12 PREPARE DOOR FOR FUTURE DOOR MOUNTED CARD READERS. CONTRACTOR SHALL PROVIDE CONDUIT ROUGH IN REQUIRED. COORDINATE CONDUIT INSTALLATION WITH DIV. 8 CONTRACTOR.
- T4.16 PROVIDE 1" CONDUIT AND CABLEING FROM POINT OF SALE (POS) BACK TO NEAREST IDF ROOM. COORDINATE EXACT LOCATION WITH FOOD SERVICE DRAWINGS.
- T4.17 1 DATA. PROVIDE 25' SERVICE LOOP WITH BISCUIT BOX FOR EACH CABLE (FOR FREEZER AND COOLER).
- T5.12 MOUNT BELOW CANOPY. MUST MAINTAIN VIEW UNDER CANOPIES. FIELD COORDINATE FINAL ELEVATION PRIOR TO ROUGH IN.
- T5.13 INDICATES LOCATION OF AV SYSTEM ENCLOSURE. PROVIDE A IN WALL 16"x4" JUNCTION BOX. ALL CONDUIT IS TO ROUTE IN WALL TO JUNCTION BOX. COORDINATE REQUIRED CONDUITS WITH AV AND CABLEING CONTRACTOR. SURFACE MOUNTED CONDUIT WILL NOT BE ACCEPTED.
- T5.19 CEILING MOUNTED PROJECTOR. REFERENCE SPECIFICATIONS FOR ADDITIONAL INFORMATION.
- T5.21 INTRUSION SYSTEM ARMING CARD READER.
- T5.25 DATA DROP IS TO BE INSTALLED INSIDE AV ENCLOSURE COORDINATE LOCATION WITH AV INSTALLER.
- T5.26 INSTALL STAGE AV HDMI PLATE (AV-1), MICROPHONE INPUT PLATE (MIC), DATA AND STAGE MONITOR SPEAKER XLR PLATE (AV-O) IN STAGE FLOX BOX.
- T5.27 INDICATES LOCATION OF STAGE MONITOR SPEAKER XLR PLATE (AV-O).
- T5.28 PROVIDE 100"H X 160" W MOTORIZED PROJECTION SCREEN. COORDINATE EXACT LOCATION WITH ARCHITECT PRIOR TO INSTALL.
- T5.29 INDICATED VOLUME CONTROL IS TO ADJUST VOLUME OF CAFE PA SPEAKERS.
- T5.30 INDICATES LOCATION OF BLU-10 AV CONTROLLER.
- T5.31 PROVIDE HANGING MICROPHONES. COORDINATE EXACT LOCATION WITH ARCHITECT PRIOR TO ROUGH IN.
- T5.32 PROPOSED LOCATION OF MOBILE AV ENCLOSURE. COORDINATE LOCATION WITH OWNER/ARCHITECT.
- T5.33 LEFT/RIGHT SPEAKER MIXER FEED PLATE.
- T5.34 INDICATED ABOVE CEILING DATA DROP IS RESERVED FOR FUTURE CAMERAS. PROVIDE 40' SERVICE LOOP. CABLING ITS TO BE PURPLE IN COLOR.

GENERAL FLOOR PLAN NOTES:

1. ALL TECHNOLOGY DEVICES, OUTLETS AND CABLE/CONDUIT PATHWAYS SHOWN ARE DIAGRAMMATIC ONLY AND ARE NOT MEANT TO SHOW THE EXACT LOCATION OR ROUTE. CONTRACTOR SHALL VERIFY WITH ARCHITECT AND OWNER FOR EXACT ROUTE, MOUNTING HEIGHT, AND LOCATION BEFORE INSTALLATION, AND SHALL COORDINATE WITH OTHER TRADES TO MAKE ANY FIELD ADJUSTMENTS AS NECESSARY TO AVOID COLLISIONS AND MEET THE PROJECT REQUIREMENTS.
2. CONDUITS AND BACKBOXES, SIZED PER DIV 27/28 SPECIFICATIONS, SHALL BE PROVIDED (BY DIV 28) FOR ALL TECHNOLOGY SYSTEM DEVICES MOUNTED ON WALL, FLOOR, AND OPEN OR SOLID FINISH CEILING. CONDUITS/SLEEVES SHALL BE PROVIDED FOR ALL CABLES ROUTED IN WALLS, OR THROUGH FULL HEIGHT PARTITIONS, OR THROUGH INACCESSIBLE CEILING PLENUM, OR THROUGH SPACES WITH EXPOSED CEILING DECK.
3. CABLES FOR DIFFERENT APPLICATIONS (DATA, AUDIO, VIDEO, SECURITY, ETC.) OR OF DIFFERENT MEDIA TYPE (COAX, UTP, ETC.) SHALL BE ROUTED IN SEPARATE PATHWAYS IN J-HOOKS, CONDUITS, SLEEVES, CORES, ETC. THROUGHOUT THE ENTIRE PATHWAY.
4. BUSINGS SHALL BE INSTALLED AT EACH END OF THE CONDUITS BEFORE CABLES BEING PULLED THROUGH. PROVIDE FULL STRING IN EACH CONDUIT INSTALLED AND LEAVE ONE FOR FUTURE PULLING AFTER CABLE INSTALLATION IS COMPLETE.
5. NO NETWORK DATA CABLE RUN SHALL EXCEED 295 FEET IN TOTAL LENGTH INCLUDING UP/DOWN AND SERVICE LOOPS WITHOUT PRIOR APPROVAL FROM THE ARCHITECT AND ENGINEER. CONTRACTOR SHALL COORDINATE WITH OTHER TRADES FOR PROPER PATHWAY PLANNING.
6. ANY CATEGORY 6/6A CABLEING ROUTING UNDER THE BUILDING SLAB SHALL BE OSP RATED. CONTRACTOR IS TO TRANSITION PLENUM RATED CABLEING TO OSP WITHIN 10' OF CONDUIT ROUTING UNDER THE BUILDING SLAB.
7. ALL EXTERIOR DOORS NEED TO BE PREPPED FOR FUTURE CARD READERS.
8. ALL CEILING MOUNTED CAMERAS SHALL BE SECURED TO CEILING TILE USING TOGGLE BOLTS.
9. EXTERIOR CARD READERS SHALL DISARM INTRUSION SYSTEM. COORDINATE EXACT ZONING AND PROGRAMMING REQUIREMENTS WITH OWNER.

CONTRACTOR SHALL WALK EACH CAMERA LOCATION WITH THE OWNER PRIOR TO INSTALLATION. OWNER IS TO PROVIDE FINAL APPROVAL.

KEY PLAN

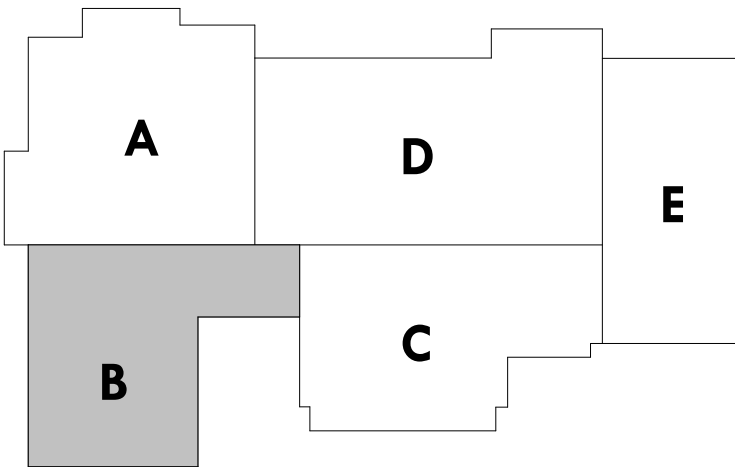

TECHNOLOGY PLAN AREA B  
T2.1B  
1/8" = 1'-0"

**BROWN REYNOLDS WATFORD ARCHITECTS**  
4501 MAGNOLIA COVE DRIVE  
SUITE 250  
DALLAS, TEXAS 77345  
281-361-3800  
WWW.BRWARCH.COM

**Bicsi**  
REGISTERED COMMUNICATIONS DISTRIBUTION DESIGNER  
Michael Quill  
BICS ID # 187703  
EXPIRES 12-31-28  
RCDD # 0000000000  
9/27/2024


**DBR**  
73.314.8888 P  
https://www.dbrinc.com  
TYPE: DBR  
DBR Project # 220393.000  
BW PARKWISLEJLITN AD

COPYRIGHT © 2024  
BROWN REYNOLDS WATFORD ARCHITECTS, INC.  
DATE SEPTEMBER 9, 2024  
DRAWN BY DBR  
CHECKED BY DBR QC  
BRW PROJECT NUMBER 223117.00

**NEW CANEY I.S.D.**  
**NEW CANEY ELEMENTARY SCHOOL**  
19300 VIA CORSICA DRIVE  
NEW CANEY, TX 77337

NO.	REVISION	DATE
1	Addendum 2	10.02.2024

**T2.1B**  
TECHNOLOGY PLAN  
AREA B

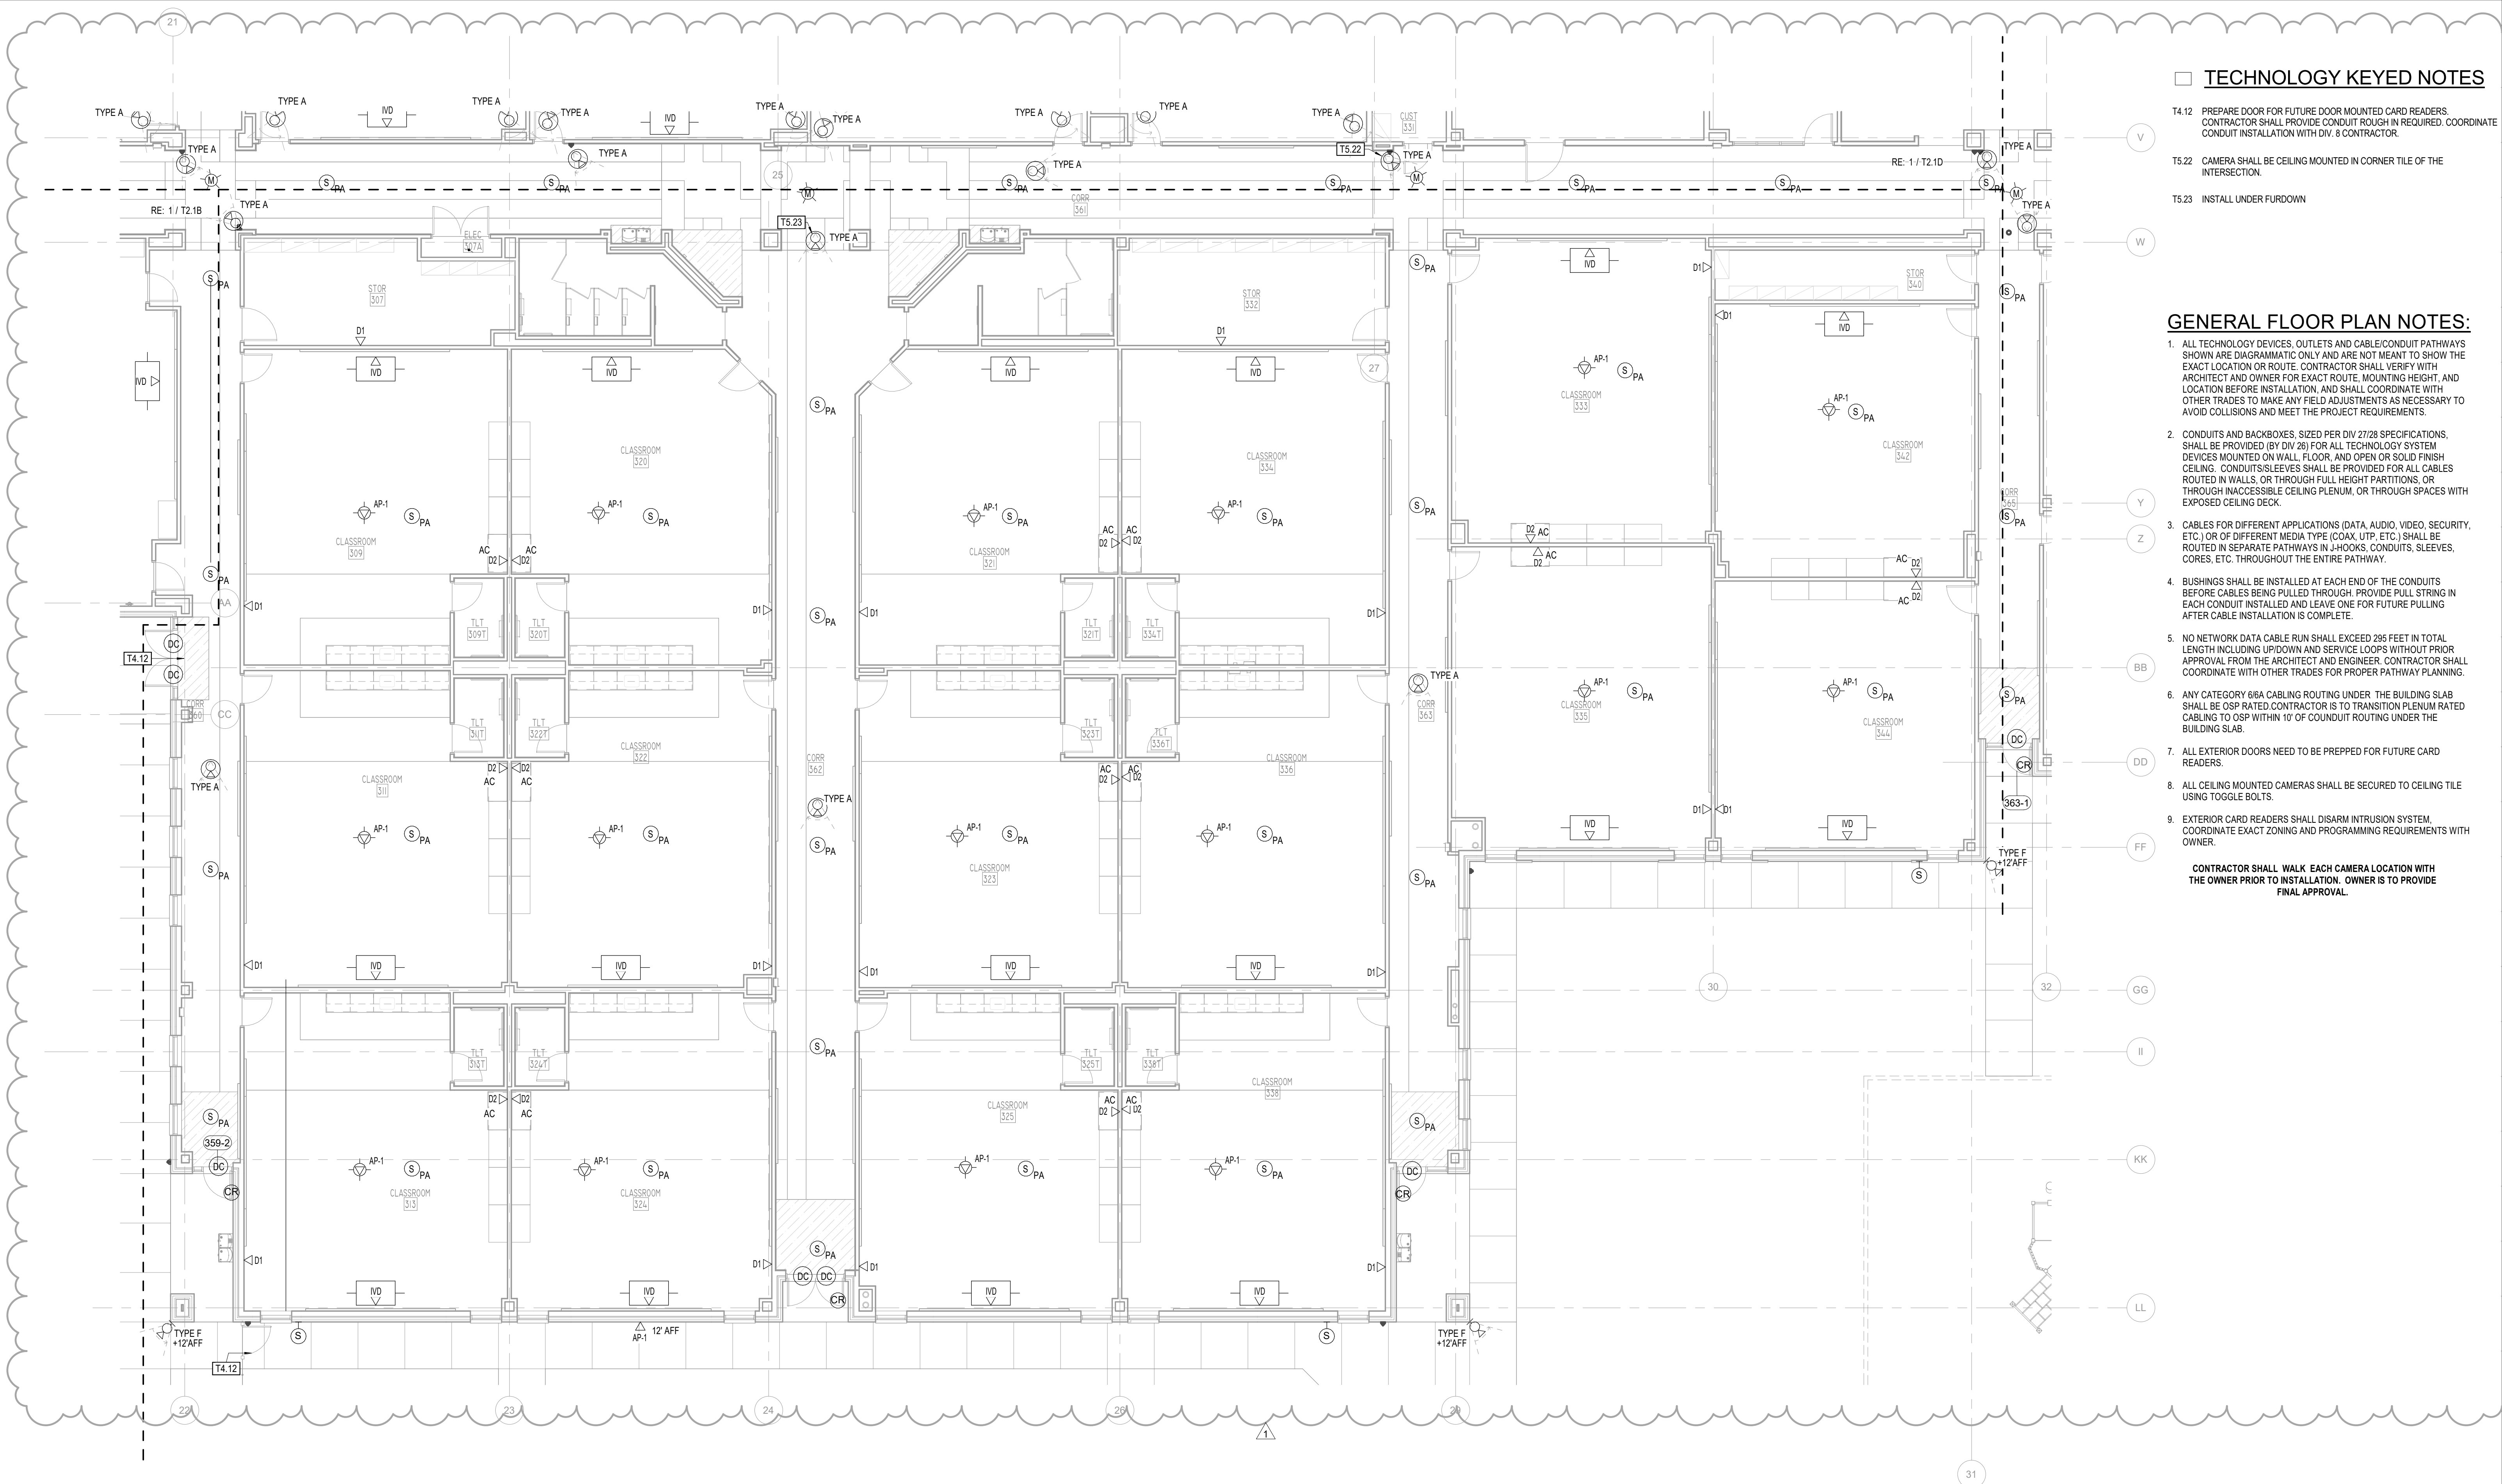

TECHNOLOGY KEYED NOTES

- T4.12 PREPARE DOOR FOR FUTURE DOOR MOUNTED CARD READERS. CONTRACTOR SHALL PROVIDE CONDUIT ROUGH IN REQUIRED. COORDINATE CONDUIT INSTALLATION WITH DIV. 6 CONTRACTOR.
- T5.22 CAMERA SHALL BE CEILING MOUNTED IN CORNER TILE OF THE INTERSECTION.
- T5.23 INSTALL UNDER FURDOWN

GENERAL FLOOR PLAN NOTES:

  - CONDUITS AND BACKBOXES, SIZED PER DIV 27/28 SPECIFICATIONS, SHALL BE PROVIDED BY (DIV 26) FOR ALL TECHNOLOGY SYSTEM DEVICES MOUNTED ON WALL, FLOOR, AND OPEN OR SOLID FINISH CEILING. CONDUITS/SLEEVES SHALL BE PROVIDED FOR ALL CABLES ROUTED IN WALLS, OR THROUGH FULL HEIGHT PARTITIONS, OR THROUGH INACCESSIBLE CEILING PLENUM, OR THROUGH SPACES WITH EXPOSED CEILING DECK.
  - CABLES FOR DIFFERENT APPLICATIONS (DATA, AUDIO, VIDEO, SECURITY, ETC.) OR OF DIFFERENT MEDIA TYPE (COAX, UTP, ETC.) SHALL BE ROUTED IN SEPARATE PATHWAYS IN J-HOOKS, CONDUITS, SLEEVES, CORES, ETC. THROUGHOUT THE ENTIRE PATHWAY.
  - BUSHINGS SHALL BE INSTALLED AT EACH END OF THE CONDUITS BEFORE CABLES BEING PULLED THROUGH. PROVIDE PULL STRING IN EACH CONDUIT INSTALLED AND LEAVE ONE FOR FUTURE PULLING AFTER CABLE INSTALLATION IS COMPLETE.
  - NO NETWORK DATA CABLE RUN SHALL EXCEED 295 FEET IN TOTAL LENGTH INCLUDING UP/DOWN AND SERVICE LOOPS WITHOUT PRIOR APPROVAL FROM THE ARCHITECT AND ENGINEER. CONTRACTOR SHALL COORDINATE WITH OTHER TRADES FOR PROPER PATHWAY PLANNING.
  - ANY CATEGORY 6B/A CABLE ROUTING UNDER THE BUILDING SLAB SHALL BE OSP RATED CONTRACTOR IS TO TRANSITION PLENUM RATED CABLEING TO OSP WITHIN 10' OF CONDUIT ROUTING UNDER THE BUILDING SLAB.
  - ALL EXTERIOR DOORS NEED TO BE PREPPED FOR FUTURE CARD READERS.
  - ALL CEILING MOUNTED CAMERAS SHALL BE SECURED TO CEILING TILE USING TOGGLE BOLTS.
  - EXTERIOR CARD READERS SHALL DISARM INTRUSION SYSTEM. COORDINATE EXACT ZONING AND PROGRAMMING REQUIREMENTS WITH OWNER.
- CONTRACTOR SHALL WALK EACH CAMERA LOCATION WITH THE OWNER PRIOR TO INSTALLATION. OWNER IS TO PROVIDE FINAL APPROVAL.

**BROWN REYNOLDS WATFORD ARCHITECTS**  
4501 MAGNOLIA COVE DRIVE  
SUITE 200  
DALLAS, TEXAS 77345  
281-301-3800  
WWW.BRWARCH.COM

**Bicsi**  
REGISTERED COMMUNICATIONS DISTRIBUTION DESIGNER  
Michael Quill  
BICS ID # 187703  
EXPIRES 12-31-28  
RCD # 12712024

**DBR**  
713.314.8888  
https://www.dbrinc.com  
TYPE: DBR-PC-234  
DBR Project # 220393.000  
BW PARKWISLE/UTN AD


COPYRIGHT © 2024  
BROWN REYNOLDS WATFORD ARCHITECTS, INC.  
DATE SEPTEMBER 9, 2024  
DRAWN BY DBR  
CHECKED BY DBR QC  
BRW PROJECT NUMBER 223117.00

**NEW CANEY I.S.D.**  
**NEW CANEY ELEMENTARY SCHOOL**  
19300 VIA CORSICA DRIVE  
NEW CANEY, TX 77337

NO.	REVISION	DATE
1	Addendum 2	10.02.2024


**T2.1C**  
TECHNOLOGY PLAN  
AREA C

KEY PLAN

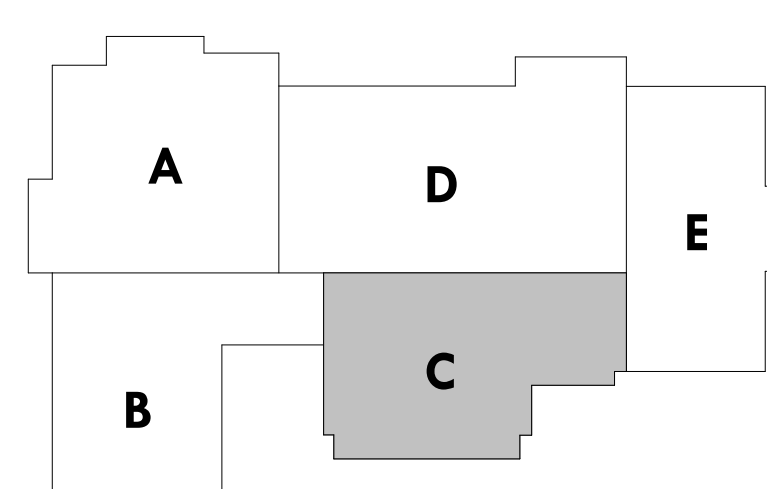

TECHNOLOGY PLAN AREA C  
1/8" = 1'-0"



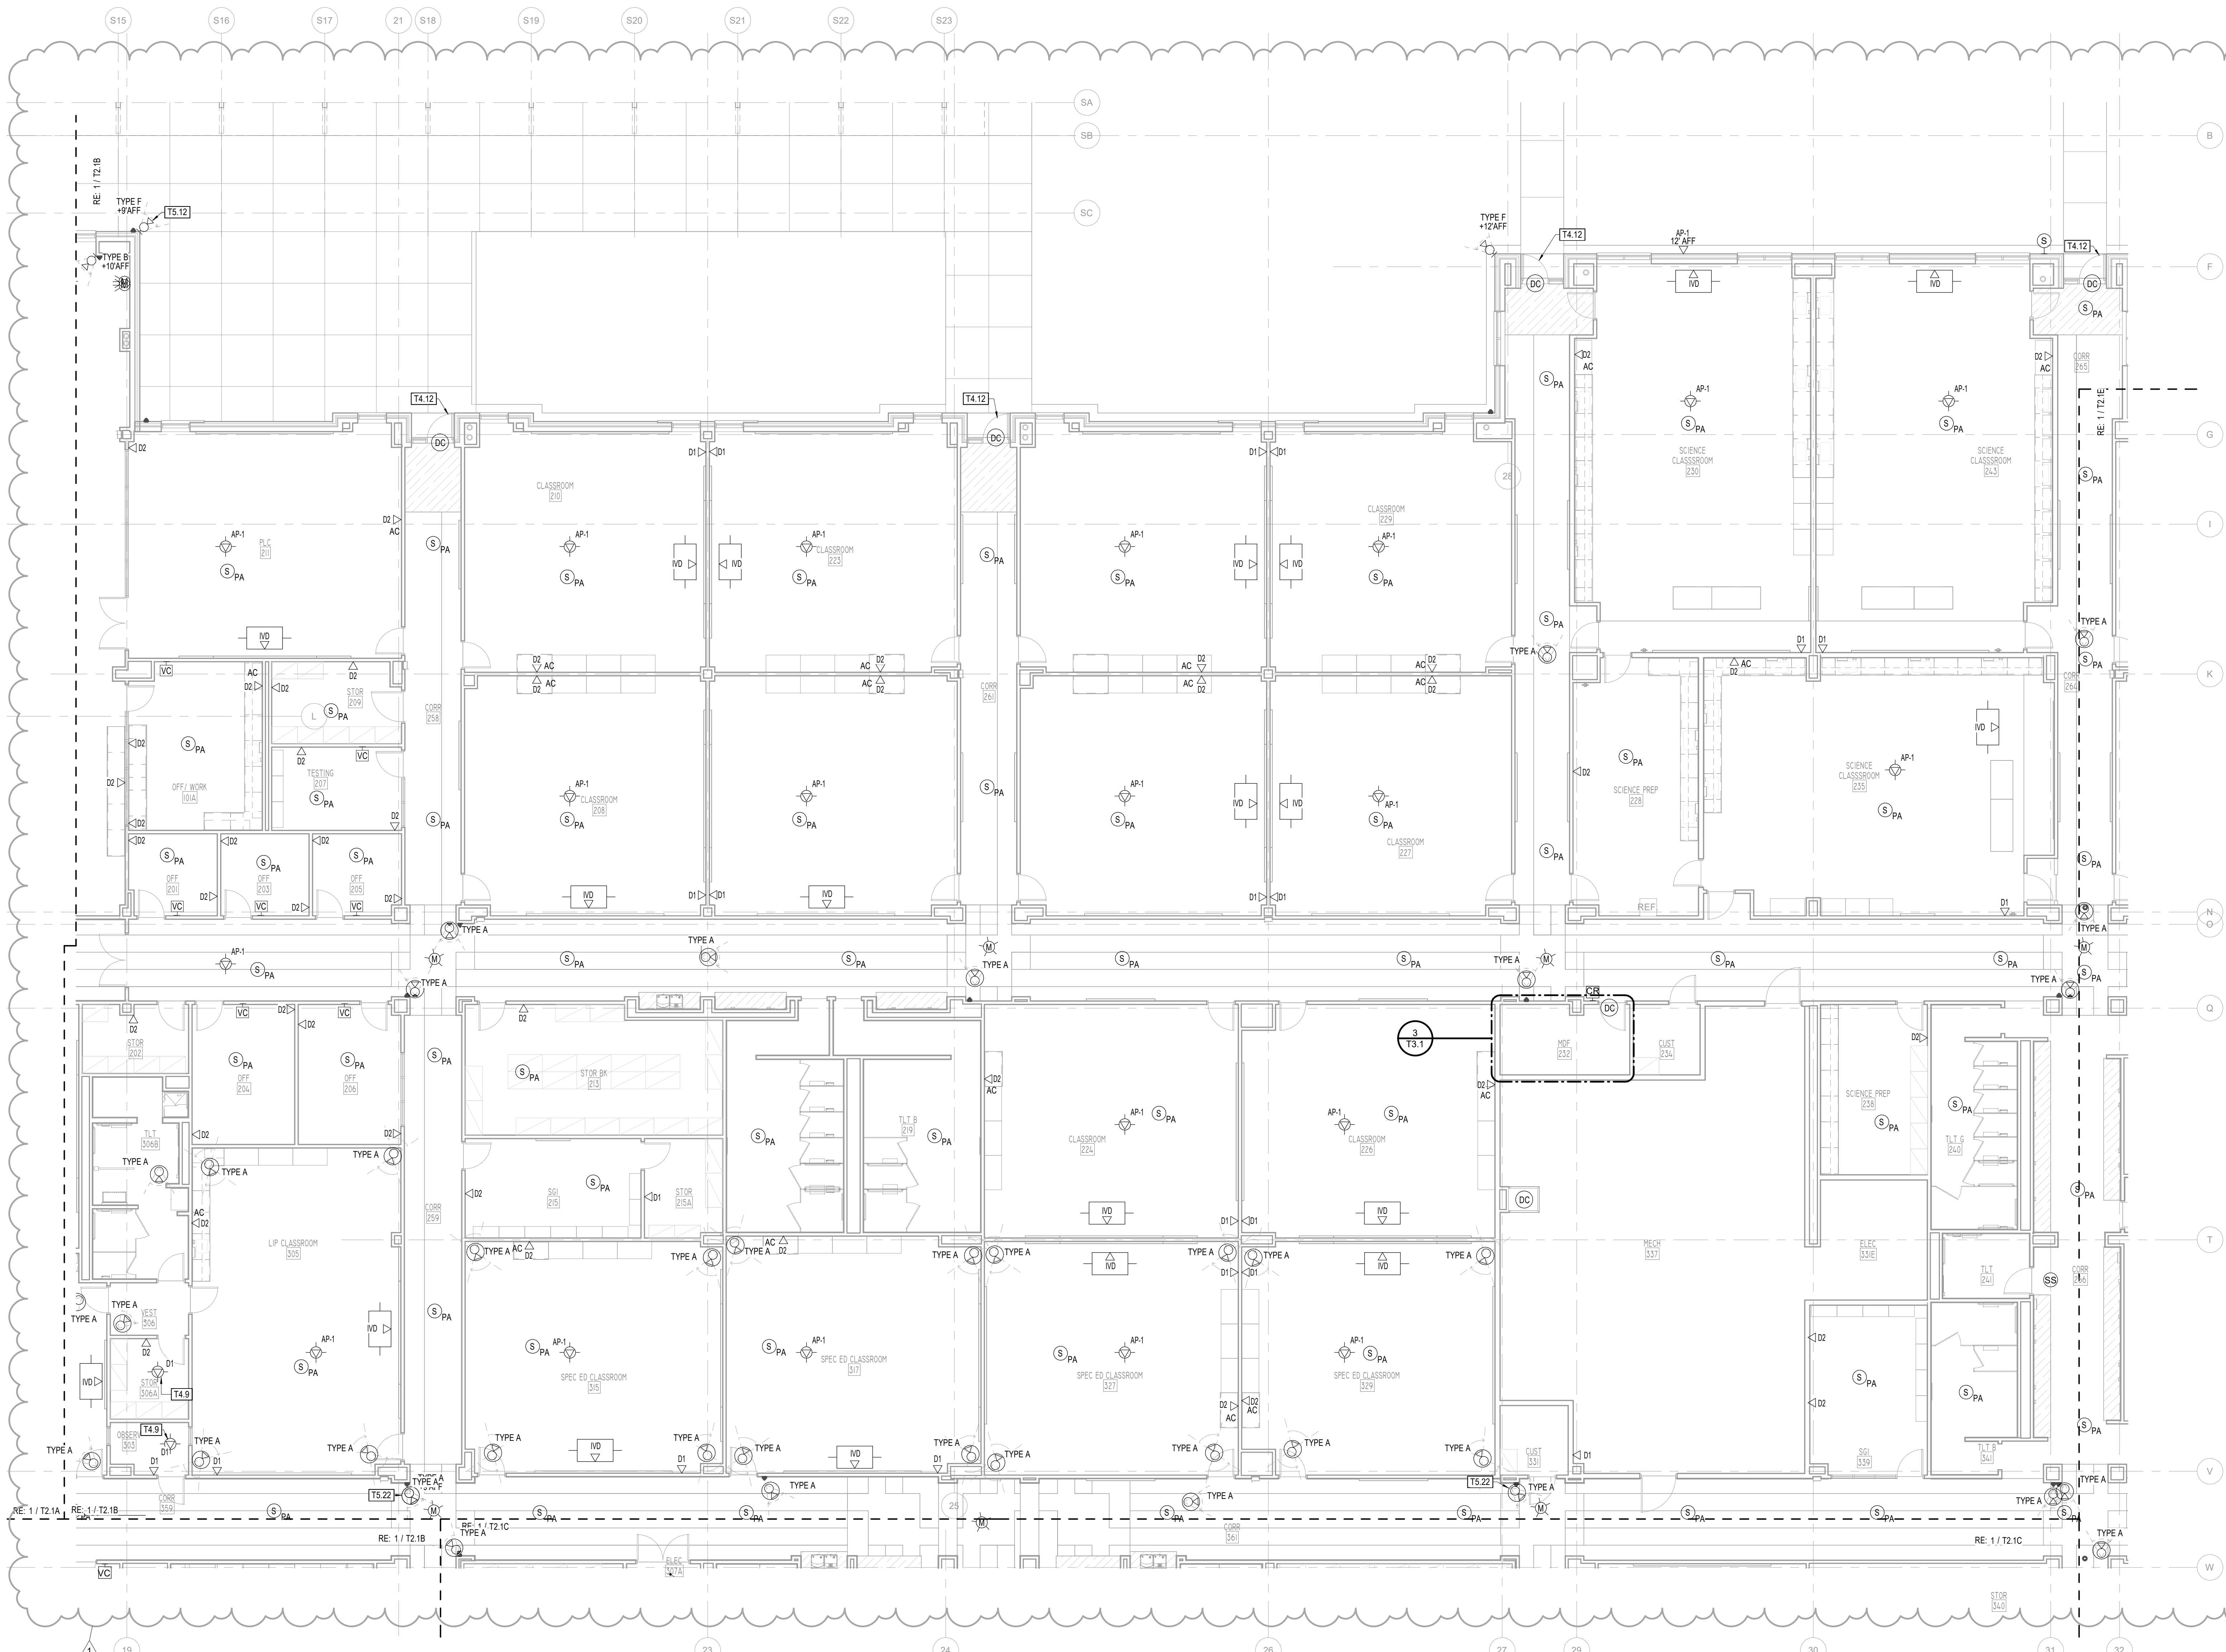

TECHNOLOGY KEYED NOTES


- T4.9 PROVIDE (1) DATA CABLE FOR FUTURE CAMERA WITH 25' OF COILED SERVICE LOOP. PROVIDE DATA CABLE AND BISCUT BOX.
- T4.12 PREPARE DOOR FOR FUTURE DOOR MOUNTED CARD READERS. CONTRACTOR SHALL PROVIDE CONDUIT ROUGH IN REQUIRED. COORDINATE CONDUIT INSTALLATION WITH DIV. 5 CONTRACTOR.
- T5.12 MOUNT BELOW CANOPY. MUST MAINTAIN VIEW UNDER CANOPIES. FIELD COORDINATE FINAL ELEVATION PRIOR TO ROUGH IN.
- T5.22 CAMERA SHALL BE CEILING MOUNTED IN CORNER TILE OF THE INTERSECTION.


GENERAL FLOOR PLAN NOTES:

- ALL TECHNOLOGY DEVICES, OUTLETS AND CABLE/CONDUIT PATHWAYS SHOWN ARE DIAGRAMMATIC ONLY AND ARE NOT MEANT TO SHOW THE EXACT LOCATION OR ROUTE. CONTRACTOR SHALL VERIFY WITH ARCHITECT AND OWNER FOR EXACT ROUTE, MOUNTING HEIGHT, AND LOCATION BEFORE INSTALLATION, AND SHALL COORDINATE WITH OTHER TRADES TO MAKE ANY FIELD ADJUSTMENTS AS NECESSARY TO AVOID COLLISIONS AND MEET THE PROJECT REQUIREMENTS.
- CONDUITS AND BACKBOXES, SIZED PER DIV 2728 SPECIFICATIONS, SHALL BE PROVIDED (BY DIV 28) FOR ALL TECHNOLOGY SYSTEM DEVICES MOUNTED ON WALL, FLOOR, AND OPEN OR SOLID FINISH CEILING. CONDUITS/SLEEVES SHALL BE PROVIDED FOR ALL CABLES ROUTED IN WALLS, OR THROUGH FULL HEIGHT PARTITIONS, OR THROUGH INACCESSIBLE CEILING PLENUM, OR THROUGH SPACES WITH EXPOSED CEILING DECK.
- CABLES FOR DIFFERENT APPLICATIONS (DATA, AUDIO, VIDEO, SECURITY, ETC.) OR OF DIFFERENT MEDIA TYPE (COAX, UTP, ETC.) SHALL BE ROUTED IN SEPARATE PATHWAYS IN J-HOOKS, CONDUITS, SLEEVES, CORES, ETC. THROUGHOUT THE ENTIRE PATHWAY.
- BUSHINGS SHALL BE INSTALLED AT EACH END OF THE CONDUITS BEFORE CABLES BEING PULLED THROUGH. PROVIDE PULL STRING IN EACH CONDUIT INSTALLED AND LEAVE ONE FOR FUTURE PULLING AFTER CABLE INSTALLATION IS COMPLETE.
- NO NETWORK DATA CABLE RUN SHALL EXCEED 295 FEET IN TOTAL LENGTH INCLUDING UP/DOWN AND SERVICE LOOPS WITHOUT PRIOR APPROVAL FROM THE ARCHITECT AND ENGINEER. CONTRACTOR SHALL COORDINATE WITH OTHER TRADES FOR PROPER PATHWAY PLANNING.
- ANY CATEGORY 6A CABLE ROUTING UNDER THE BUILDING SLAB SHALL BE OSP RATED CONTRACTOR IS TO TRANSITION PLENUM RATED CABLE TO OSP WITHIN 10' OF CONDUIT ROUTING UNDER THE BUILDING SLAB.
- ALL EXTERIOR DOORS NEED TO BE PREPPED FOR FUTURE CARD READERS.
- ALL CEILING MOUNTED CAMERAS SHALL BE SECURED TO CEILING TILE USING TOGGLE BOLTS.
- EXTERIOR CARD READERS SHALL DISARM INTRUSION SYSTEM, COORDINATE EXACT ZONING AND PROGRAMMING REQUIREMENTS WITH OWNER.

CONTRACTOR SHALL WALK EACH CAMERA LOCATION WITH THE OWNER PRIOR TO INSTALLATION. OWNER IS TO PROVIDE FINAL APPROVAL.

KEY PLAN

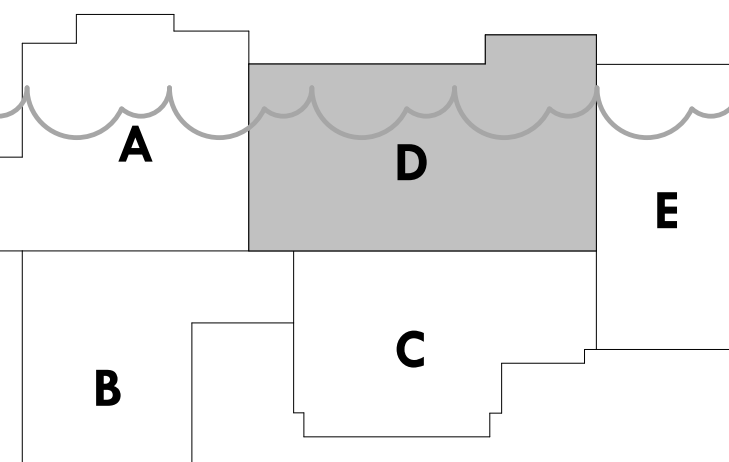

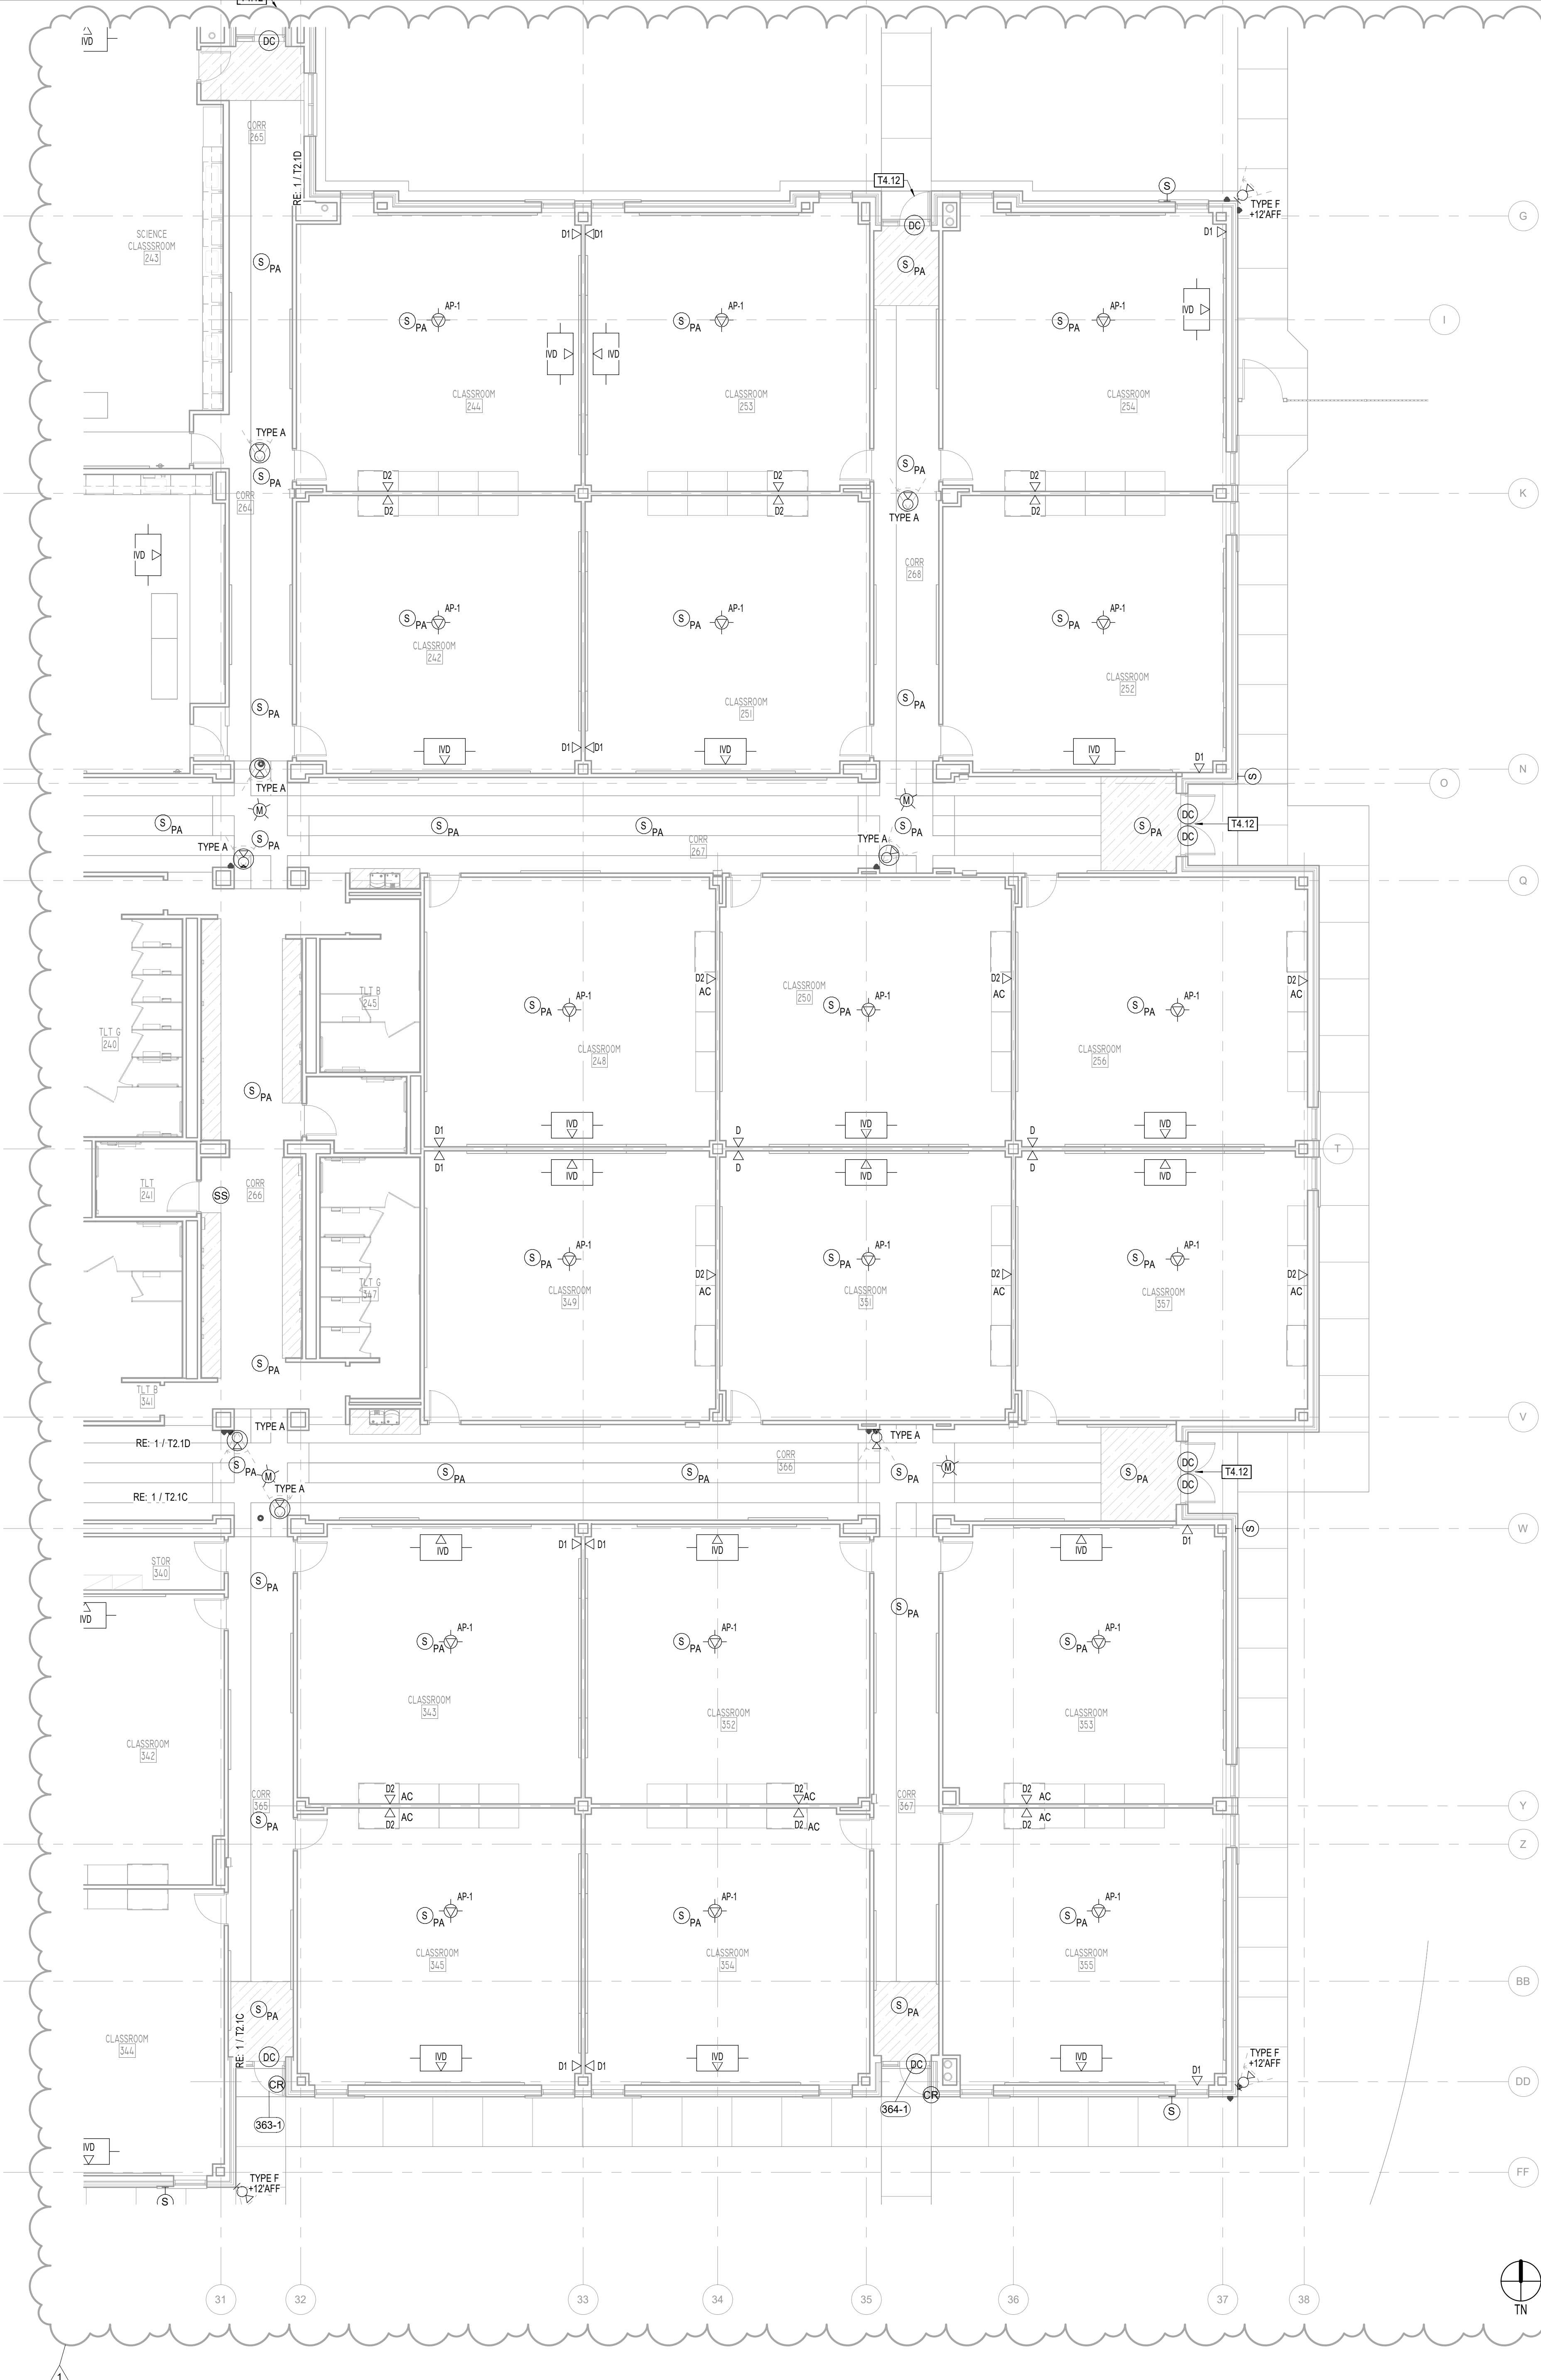

TECHNOLOGY KEYED NOTES


T4.12 PREPARE DOOR FOR FUTURE DOOR MOUNTED CARD READERS.  
CONTRACTOR SHALL PROVIDE CONDUIT ROUGH IN REQUIRED. COORDINATE  
CONDUIT INSTALLATION WITH DIV. 8 CONTRACTOR.

GENERAL FLOOR PLAN NOTES:

- ALL TECHNOLOGY DEVICES, OUTLETS AND CABLE/CONDUIT PATHWAYS SHOWN ARE DIAGRAMMATIC ONLY AND ARE NOT MEANT TO SHOW THE EXACT LOCATION OR ROUTE. CONTRACTOR SHALL VERIFY WITH ARCHITECT AND OWNER FOR EXACT ROUTE, MOUNTING HEIGHT, AND LOCATION BEFORE INSTALLATION, AND SHALL COORDINATE WITH OTHER TRADES TO MAKE ANY FIELD ADJUSTMENTS AS NECESSARY TO AVOID COLLISIONS AND MEET THE PROJECT REQUIREMENTS.
- CONDUITS AND BACKBOXES, SIZED PER DIV 27/28 SPECIFICATIONS, SHALL BE PROVIDED (BY DIV 28) FOR ALL TECHNOLOGY SYSTEM DEVICES MOUNTED ON WALL, FLOOR, AND OPEN OR SOLID FINISH CEILING. CONDUITS/SLEEVES SHALL BE PROVIDED FOR ALL CABLES ROUTED IN WALLS, OR THROUGH FULL HEIGHT PARTITIONS, OR THROUGH INACCESSIBLE CEILING PLENUM, OR THROUGH SPACES WITH EXPOSED CEILING DECK.
- CABLES FOR DIFFERENT APPLICATIONS (DATA, AUDIO, VIDEO, SECURITY, ETC.) OR OF DIFFERENT MEDIA TYPE (COAX, UTP, ETC.) SHALL BE ROUTED IN SEPARATE PATHWAYS IN J-HOOKS, CONDUITS, SLEEVES, CORES, ETC. THROUGHOUT THE ENTIRE PATHWAY.
- BUSHINGS SHALL BE INSTALLED AT EACH END OF THE CONDUITS BEFORE CABLES BEING PULLED THROUGH. PROVIDE PULL STRING IN EACH CONDUIT INSTALLED AND LEAVE ONE FOR FUTURE PULLING AFTER CABLE INSTALLATION IS COMPLETE.
- NO NETWORK DATA CABLE RUN SHALL EXCEED 295 FEET IN TOTAL LENGTH INCLUDING UP/DOWN AND SERVICE LOOPS WITHOUT PRIOR APPROVAL FROM THE ARCHITECT AND ENGINEER. CONTRACTOR SHALL COORDINATE WITH OTHER TRADES FOR PROPER PATHWAY PLANNING.
- ANY CATEGORY 66A CABLE ROUTING UNDER THE BUILDING SLAB SHALL BE OSP RATED CONTRACTOR IS TO TRANSITION PLENUM RATED CABLES TO OSP WITHIN 10' OF CONDUIT ROUTING UNDER THE BUILDING SLAB.
- ALL EXTERIOR DOORS NEED TO BE PREPPED FOR FUTURE CARD READERS.
- ALL CEILING MOUNTED CAMERAS SHALL BE SECURED TO CEILING TILE USING TOGGLE BOLTS.
- EXTERIOR CARD READERS SHALL DISARM INTRUSION SYSTEM. COORDINATE EXACT ZONING AND PROGRAMMING REQUIREMENTS WITH OWNER.

CONTRACTOR SHALL WALK EACH CAMERA LOCATION WITH THE OWNER PRIOR TO INSTALLATION. OWNER IS TO PROVIDE FINAL APPROVAL.

KEY PLAN

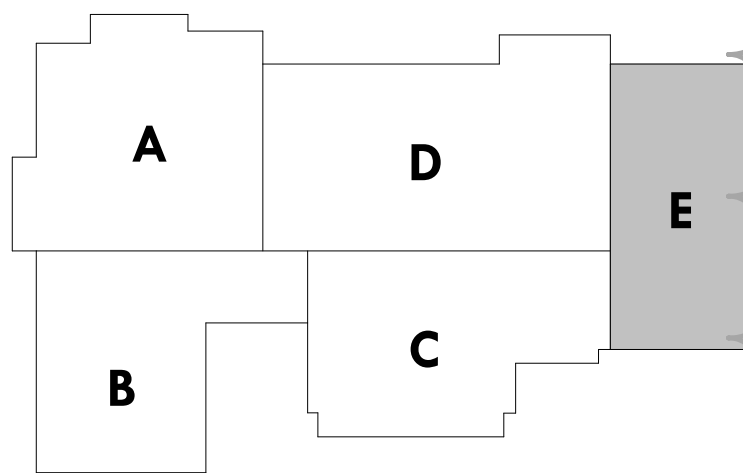

1 TECHNOLOGY PLAN AREA E  
1/8" = 1'-0"

BROWN REYNOLDS WATFORD ARCHITECTS  
4501 MAGNOLIA COVE DRIVE  
SUITE 200  
DALLAS, TEXAS 77345  
281-361-3800  
WWW.BRWARCH.COM

Bicsi  
Michael Quitt  
BICS ID # 187703  
EXPIRES 12-31-28  
RCD 1/2/2024

DBR  
713.314.8888  
https://www.dbrinc.com  
TYPE: DBR  
DBR Project # 220393.000  
BW PARKWISLE/UTN / AD

COPYRIGHT © 2024  
BROWN REYNOLDS WATFORD ARCHITECTS, INC.  
DATE: SEPTEMBER 9, 2024  
DRAWN BY: DBR  
CHECKED BY: DBR-OC  
BRW PROJECT NUMBER: 223117.00




NEW CANEY I.S.D.  
NEW CANEY ELEMENTARY SCHOOL  
19300 VIA CORSICA DRIVE  
NEW CANEY, TX 77337

NO.	REVISION	DATE
1	Addendum 2	10.02.2024


T2.1E  
TECHNOLOGY PLAN  
AREA E

1. CONTRACTOR SHALL VERIFY WITH OWNER IF ON THE EXACT PLACEMENT OF ALL EQUIPMENT RACK AND OVERHEAD CABLE TRAYS BEFORE COMMENCEMENT OF INSTALLATION WORK.
2. CONTRACTOR SHALL COORDINATE WITH OTHER TRADES ON ANY OTHER EQUIPMENT, PIPING, CONDUITS NOT SHOWN ON THIS LAYOUT AND SUBMIT REQUEST FOR LAYOUT CHANGES, IF NECESSARY, TO ARCHITECT AND ENGINEER FOR REVIEW AND APPROVAL.
3. COORDINATE ALL RACK PLACEMENTS WITH GC AND OWNER. NO RACK OR CABLING UNDER AC UNITS OR WATER LINES.
4. NO WATER IS TO BE ROUTED ABOVE MDF/IDF ROOMS.


T4.13	DESIGNATED FOR FIRE ALARM SYSTEM.
T4.14	DESIGNATED FOR FIRE ALARM.
T4.15	DESIGNATED FOR PA SYSTEM.
T6.2	PROVIDE 3/4" GRADE A/C FIRE RESISTANT PLYWOOD ON WALL, WITH GRADE A SIDE FACING OUT. INSTALL PLYWOOD TO PROVIDE COVERAGE BETWEEN 6" AND 102" AFF ON WALL.
T6.14	PROVIDE 19" W X 84" H 2-POST EQUIPMENT RACK. (TYPICAL)
T7.2	PROVIDE 10" WIDE VERTICAL CABLE MANAGER. (TYPICAL)
T7.8	PROVIDE 2U 48 PORT PATCH PANEL. (TYPICAL)
T10	PROVIDE 1U FIBER TERMINATION PANEL. (TYPICAL)
T7.11	PROVIDE 2U FIBER TERMINATION PANEL. (TYPICAL)
T7.14	SPACE RESERVED FOR NETWORK SWITCHES.
T7.17	EQUIPMENT RACK IS RESERVED FOR SCHOOL COMMUNICATION SYSTEM COMPONENTS.

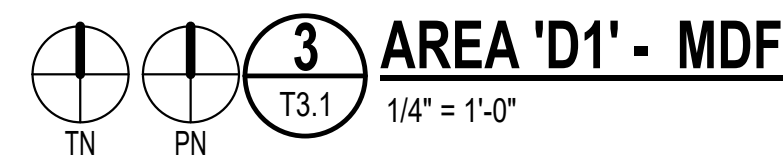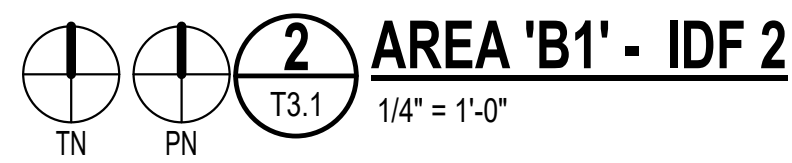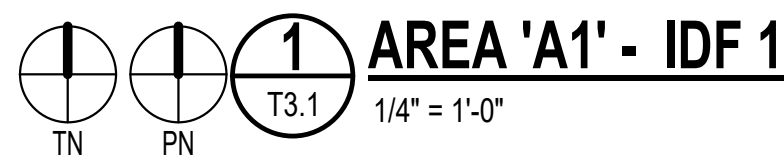




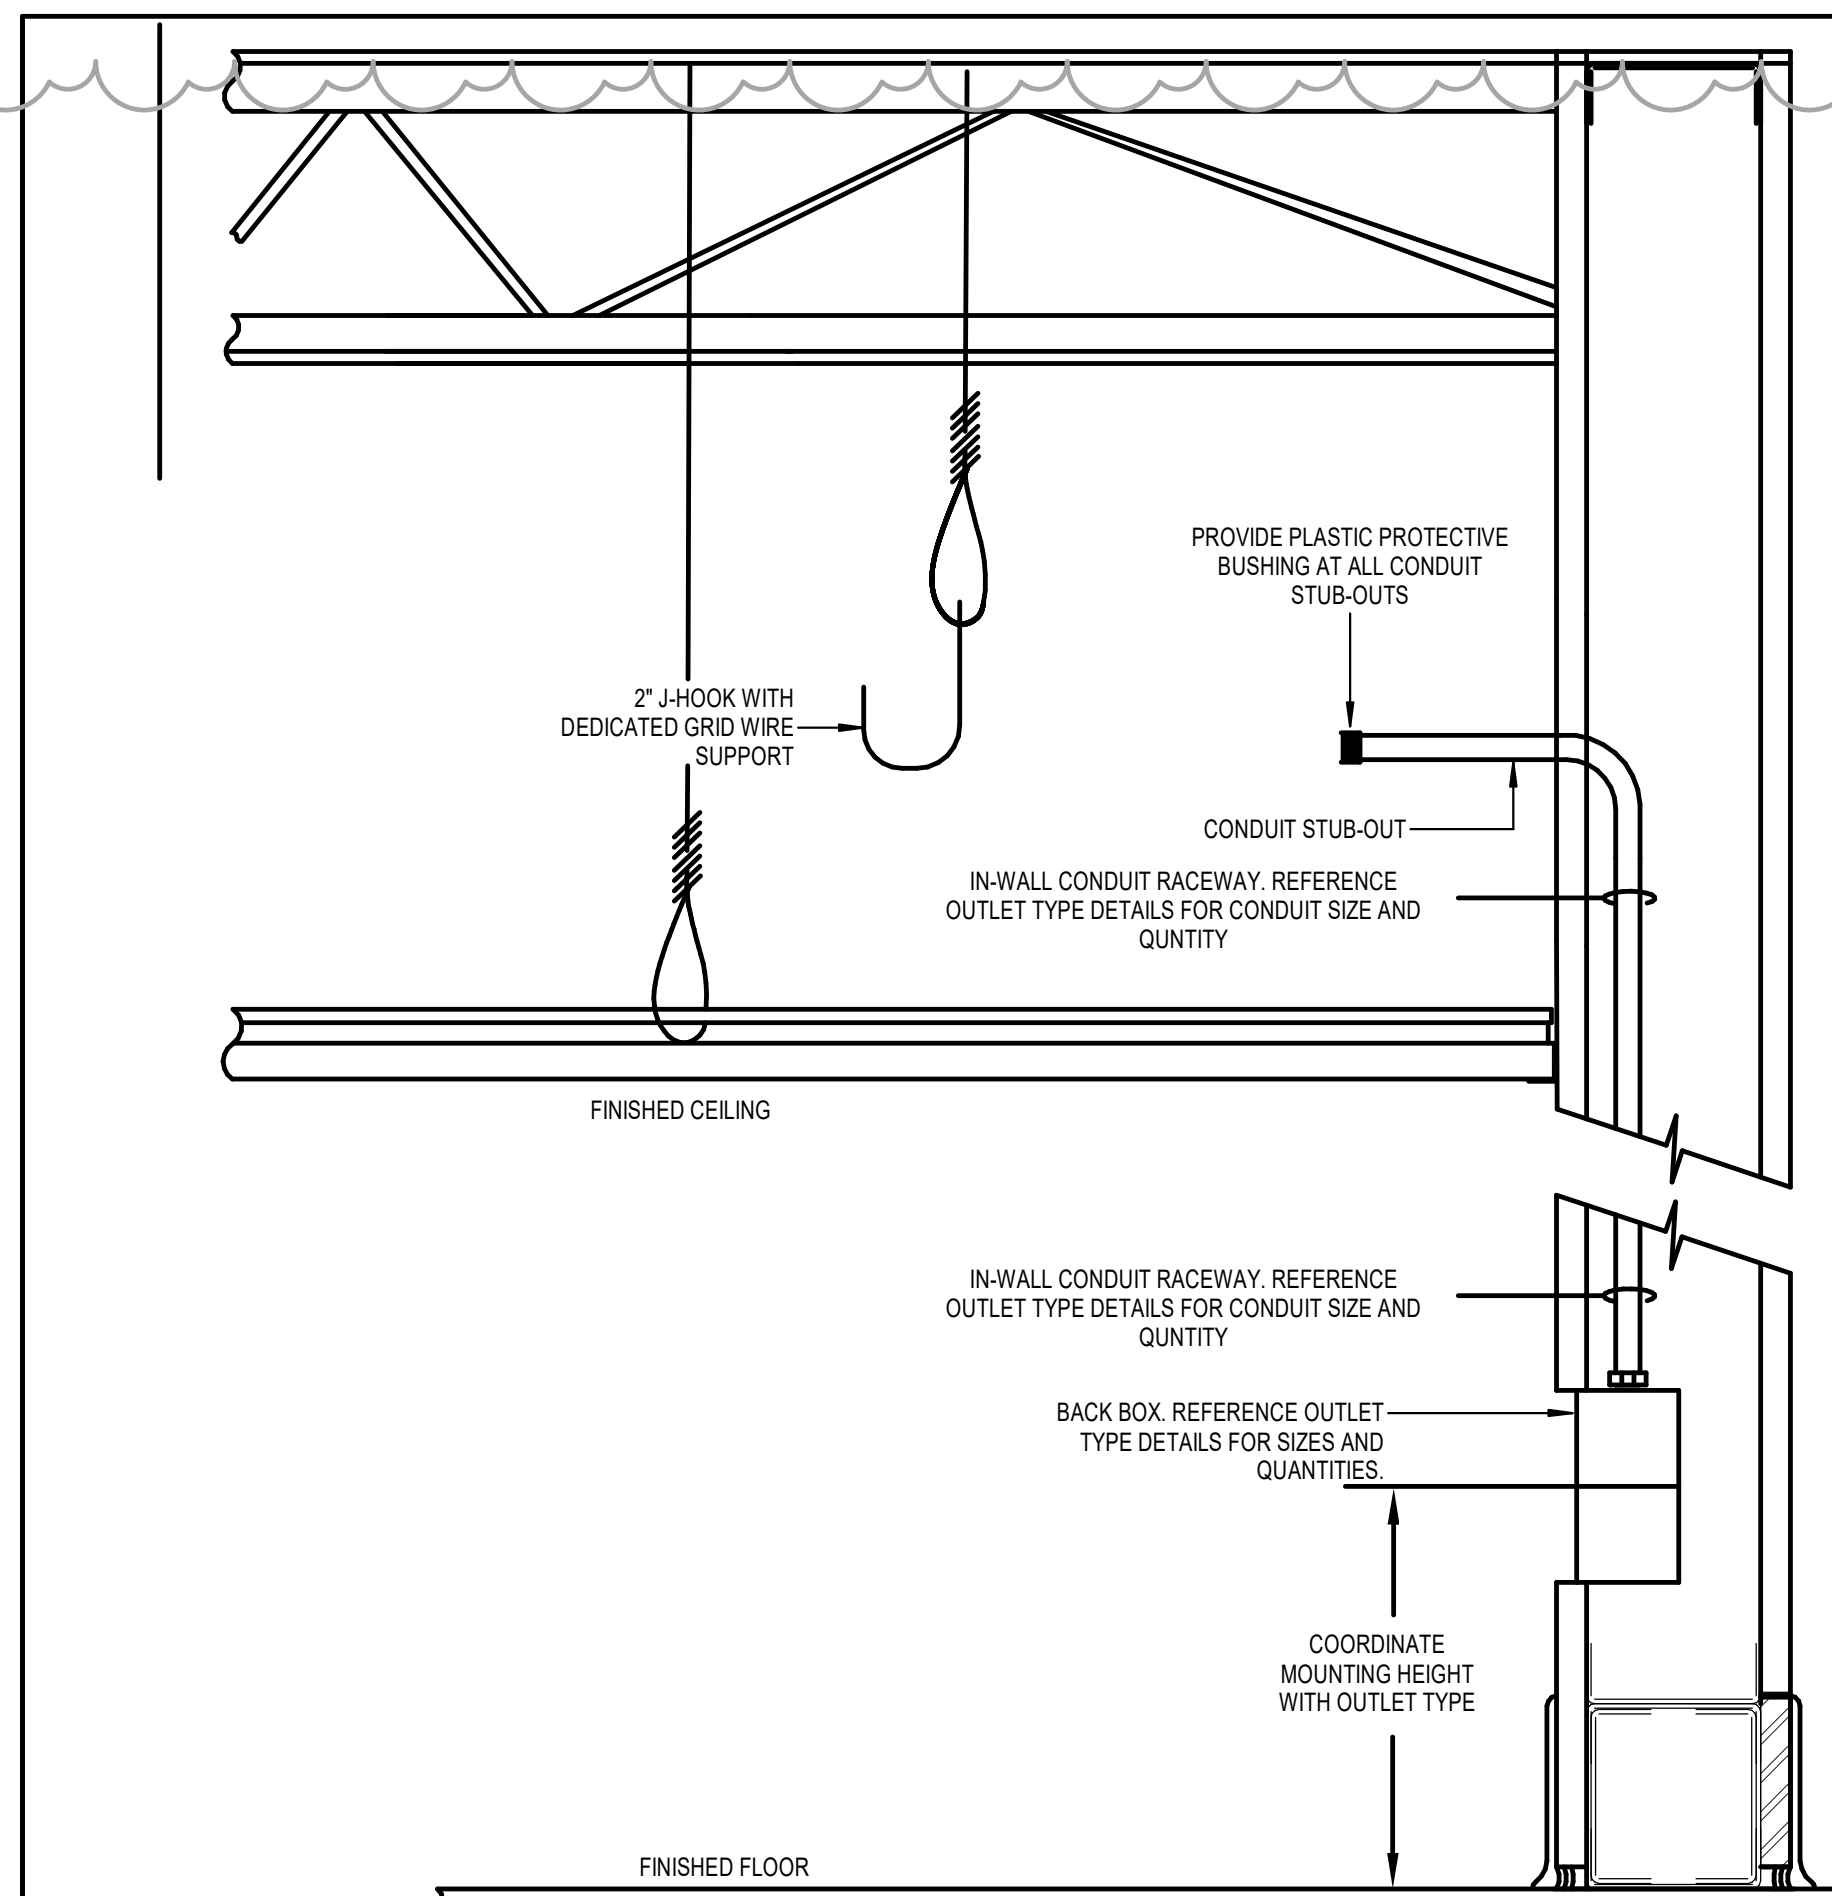


NOT TO SCALE

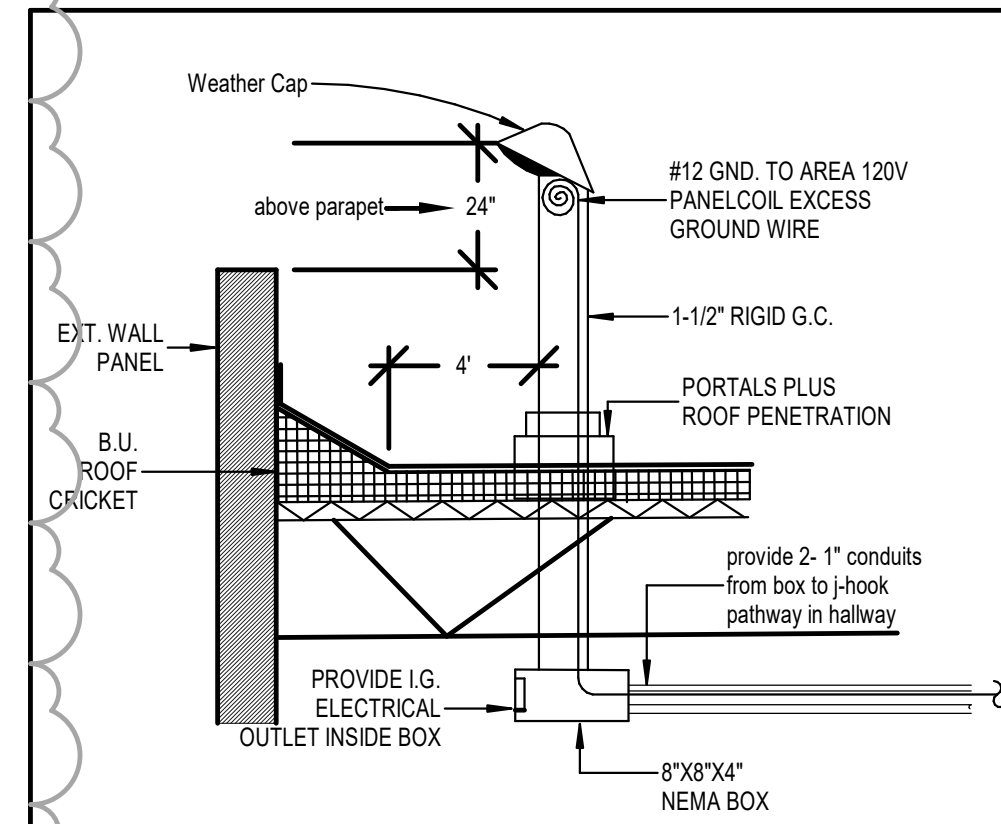


NOT TO SCALE

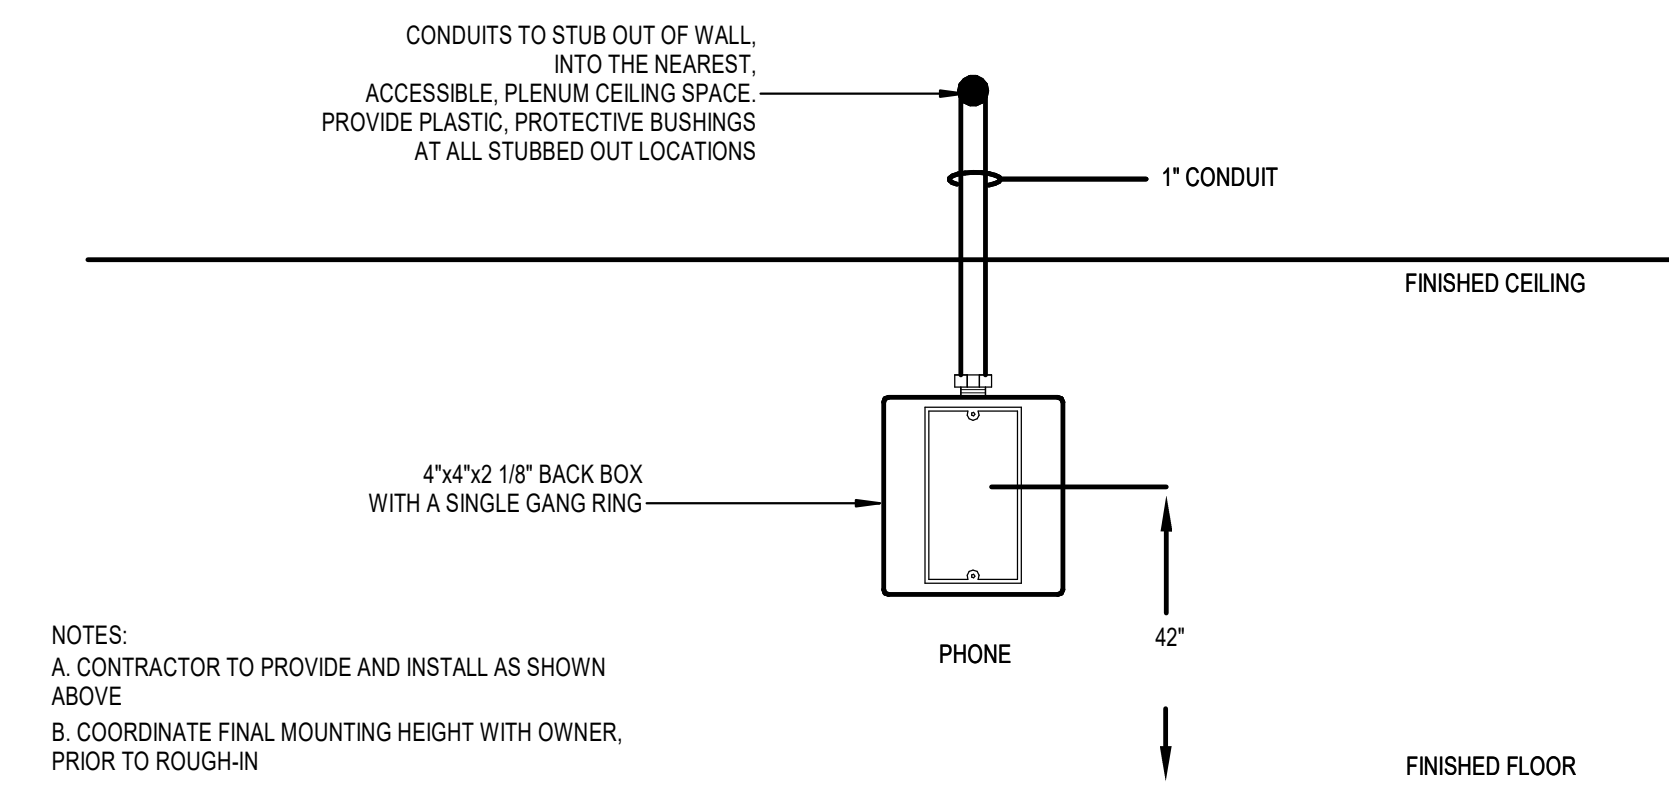


NOT TO SCALE

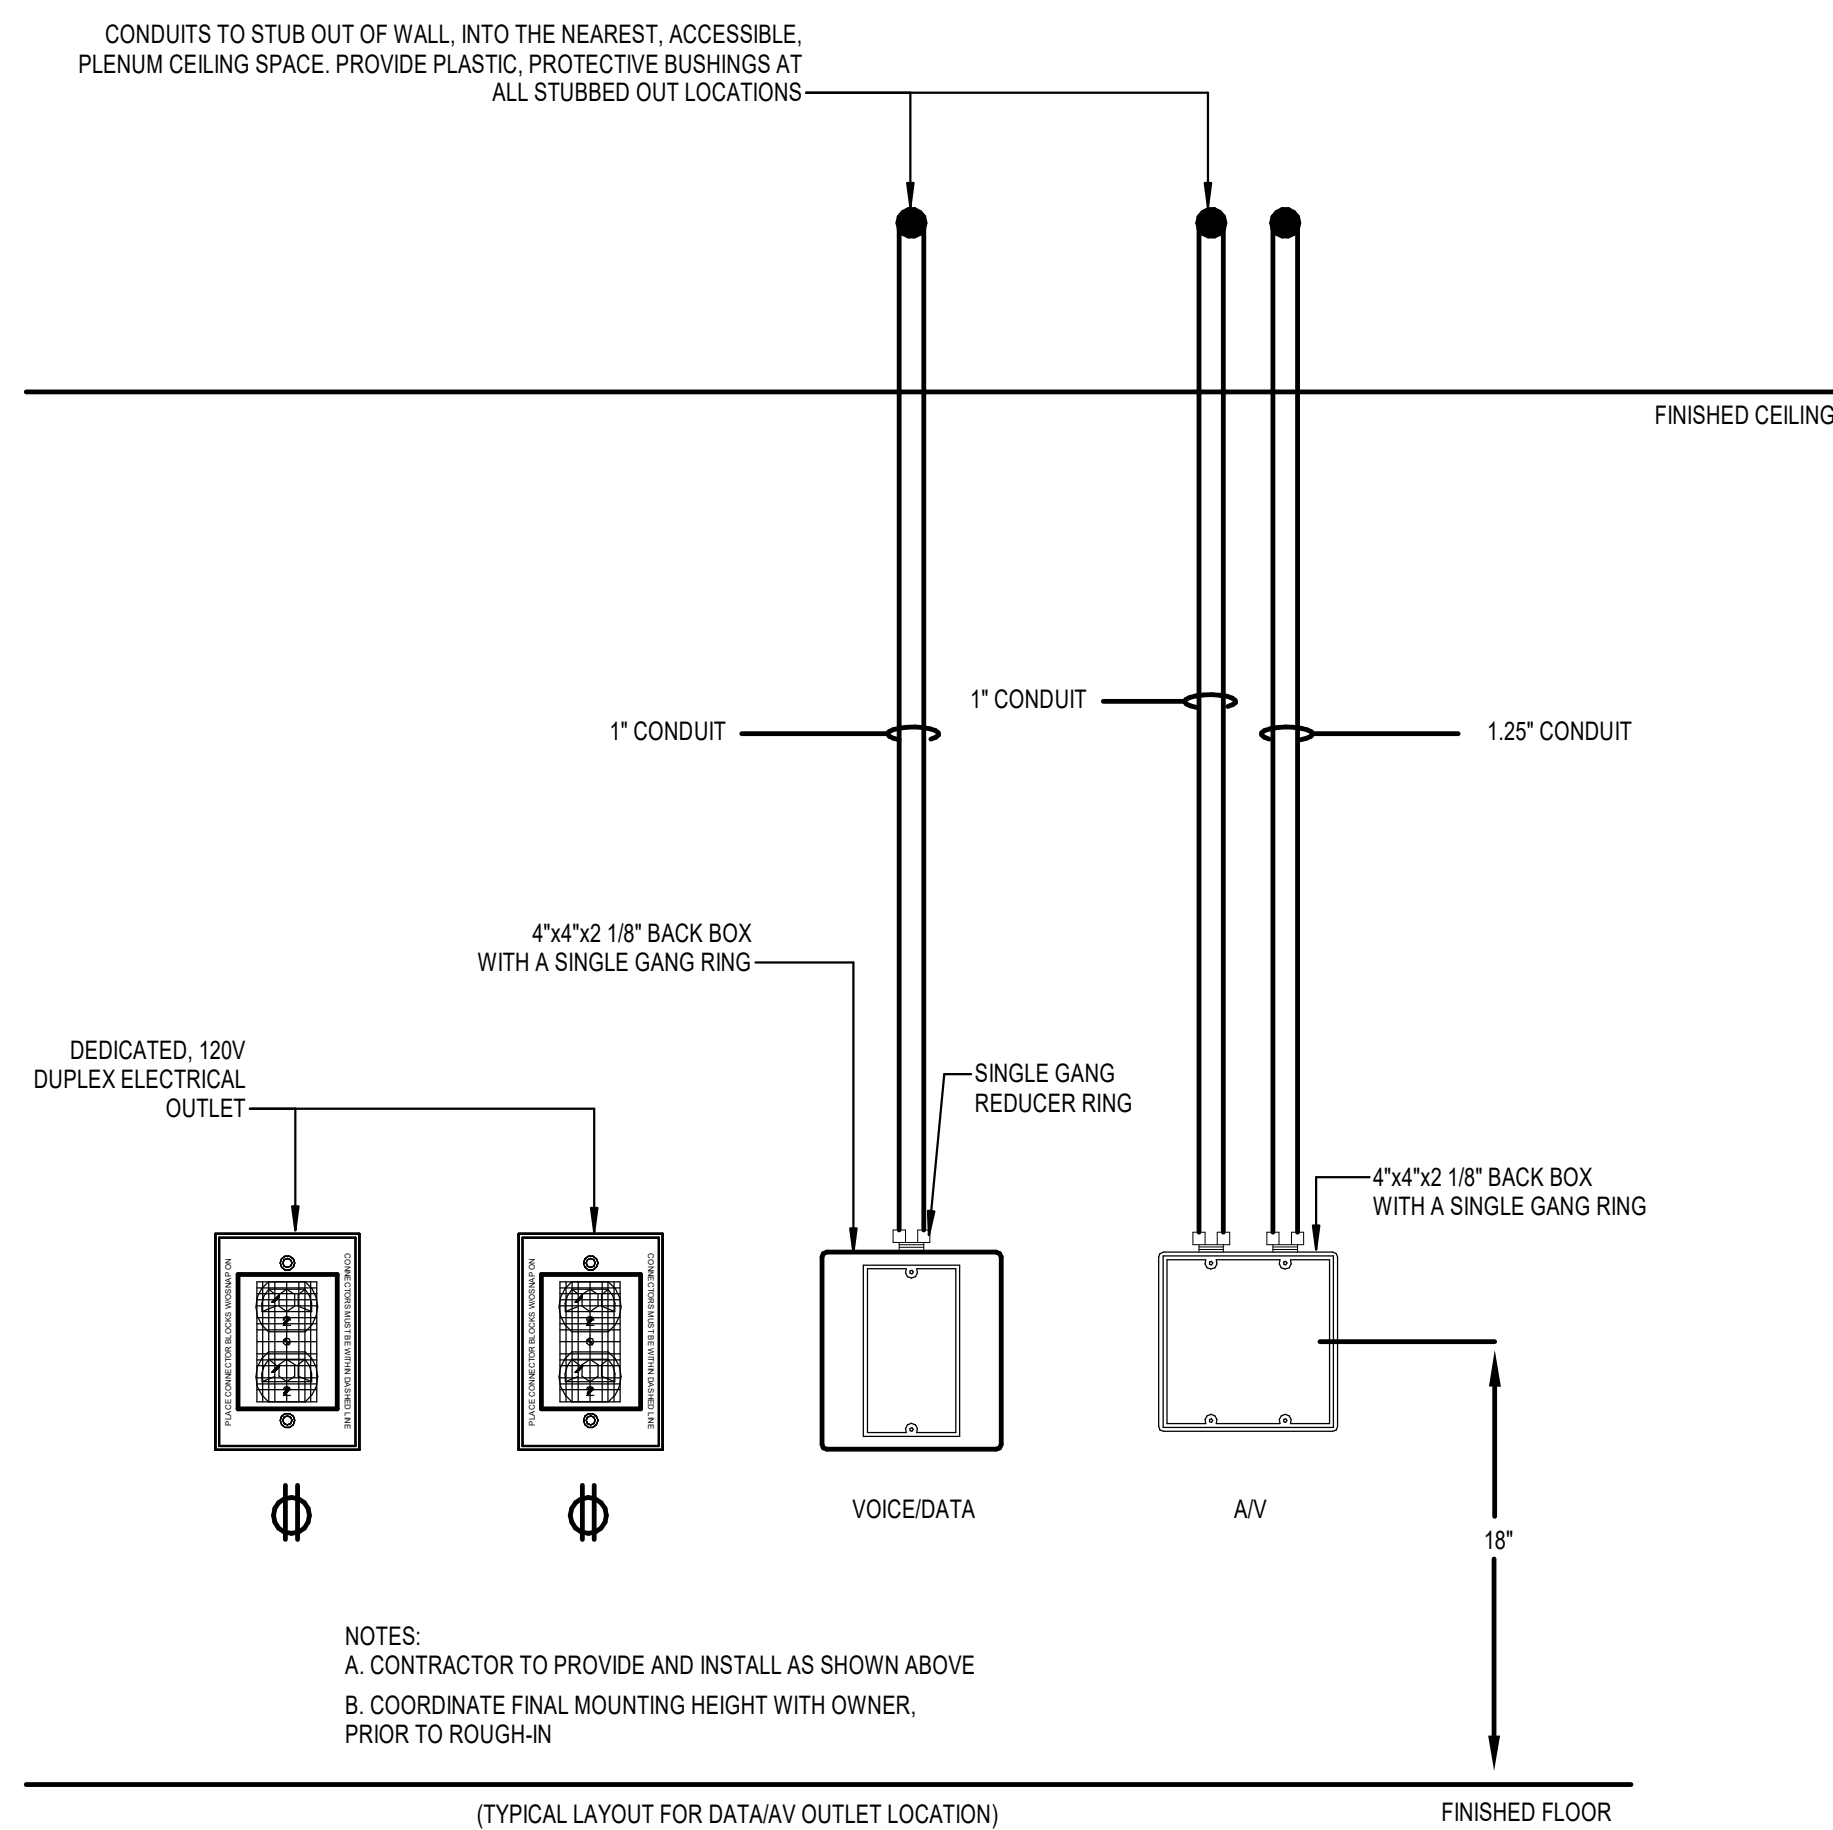


NOT TO SCALE

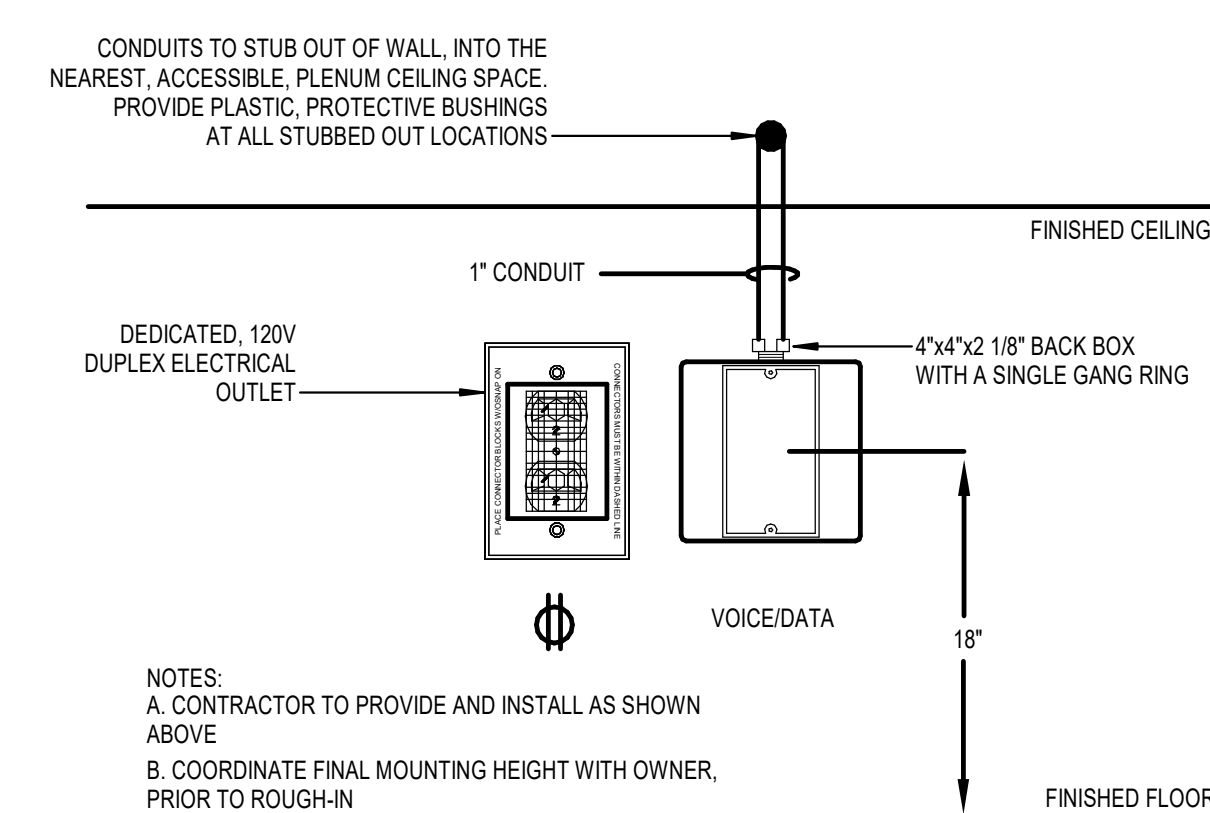


NOT TO SCALE

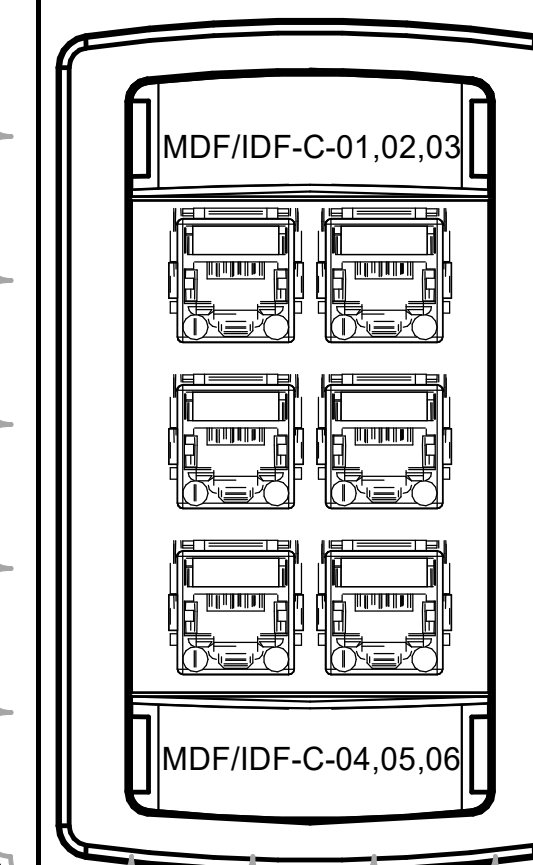


NOT TO SCALE

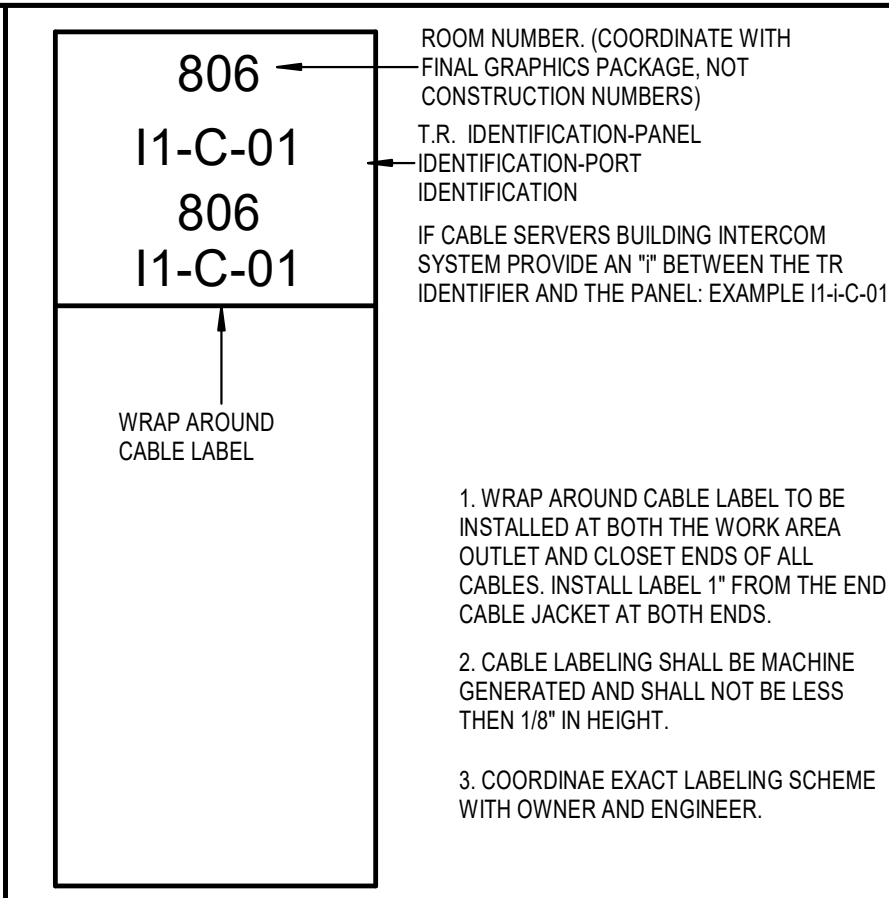


NOT TO SCALE

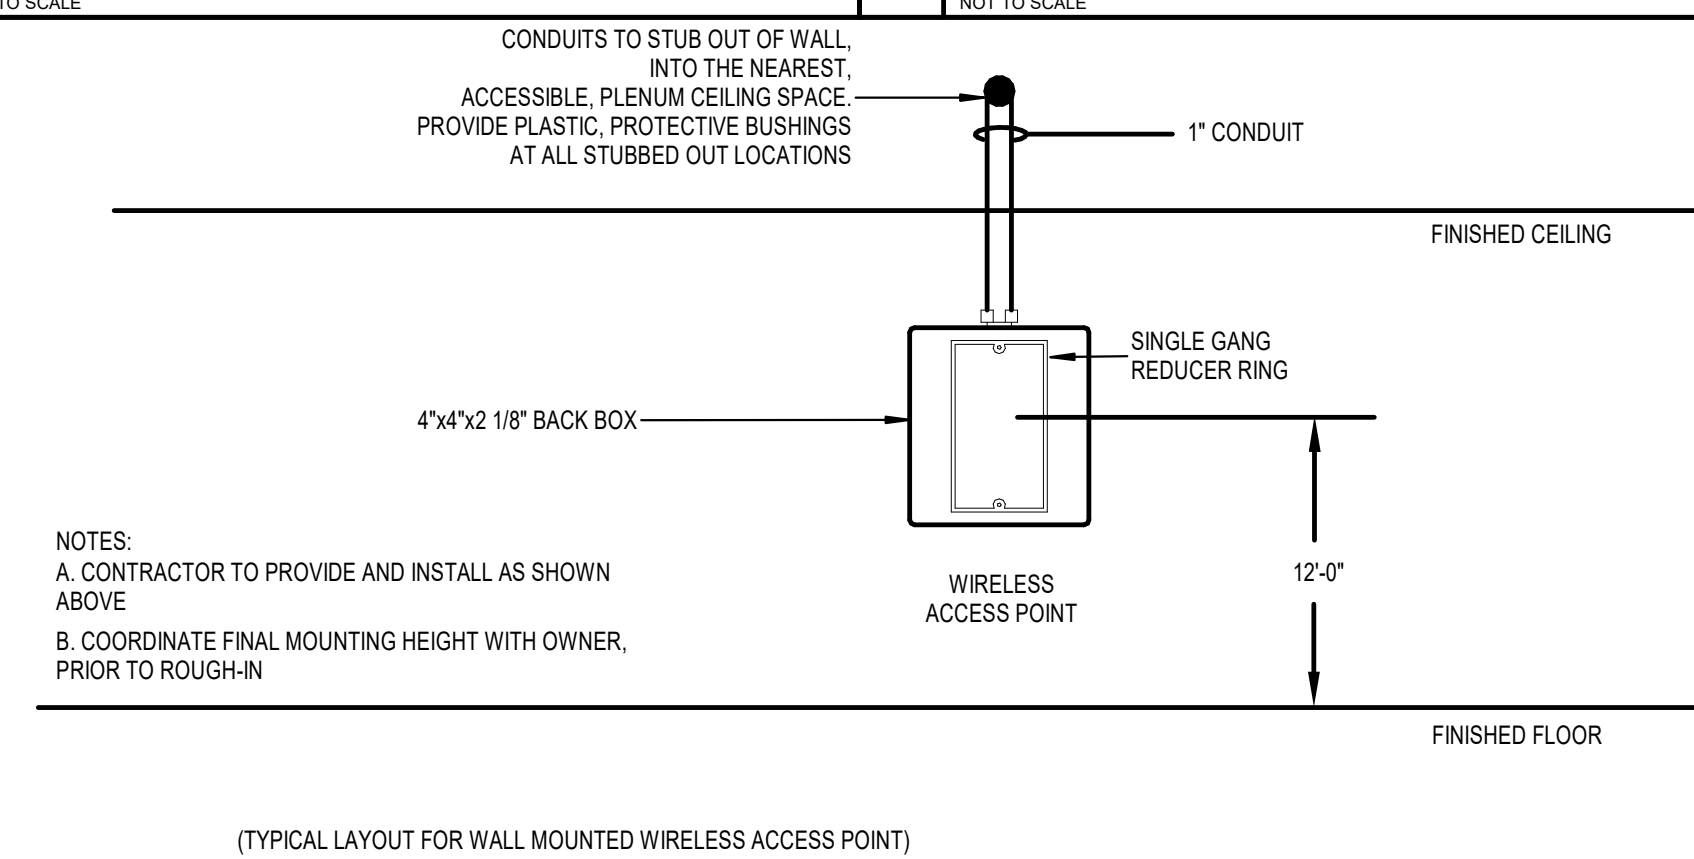


NOT TO SCALE

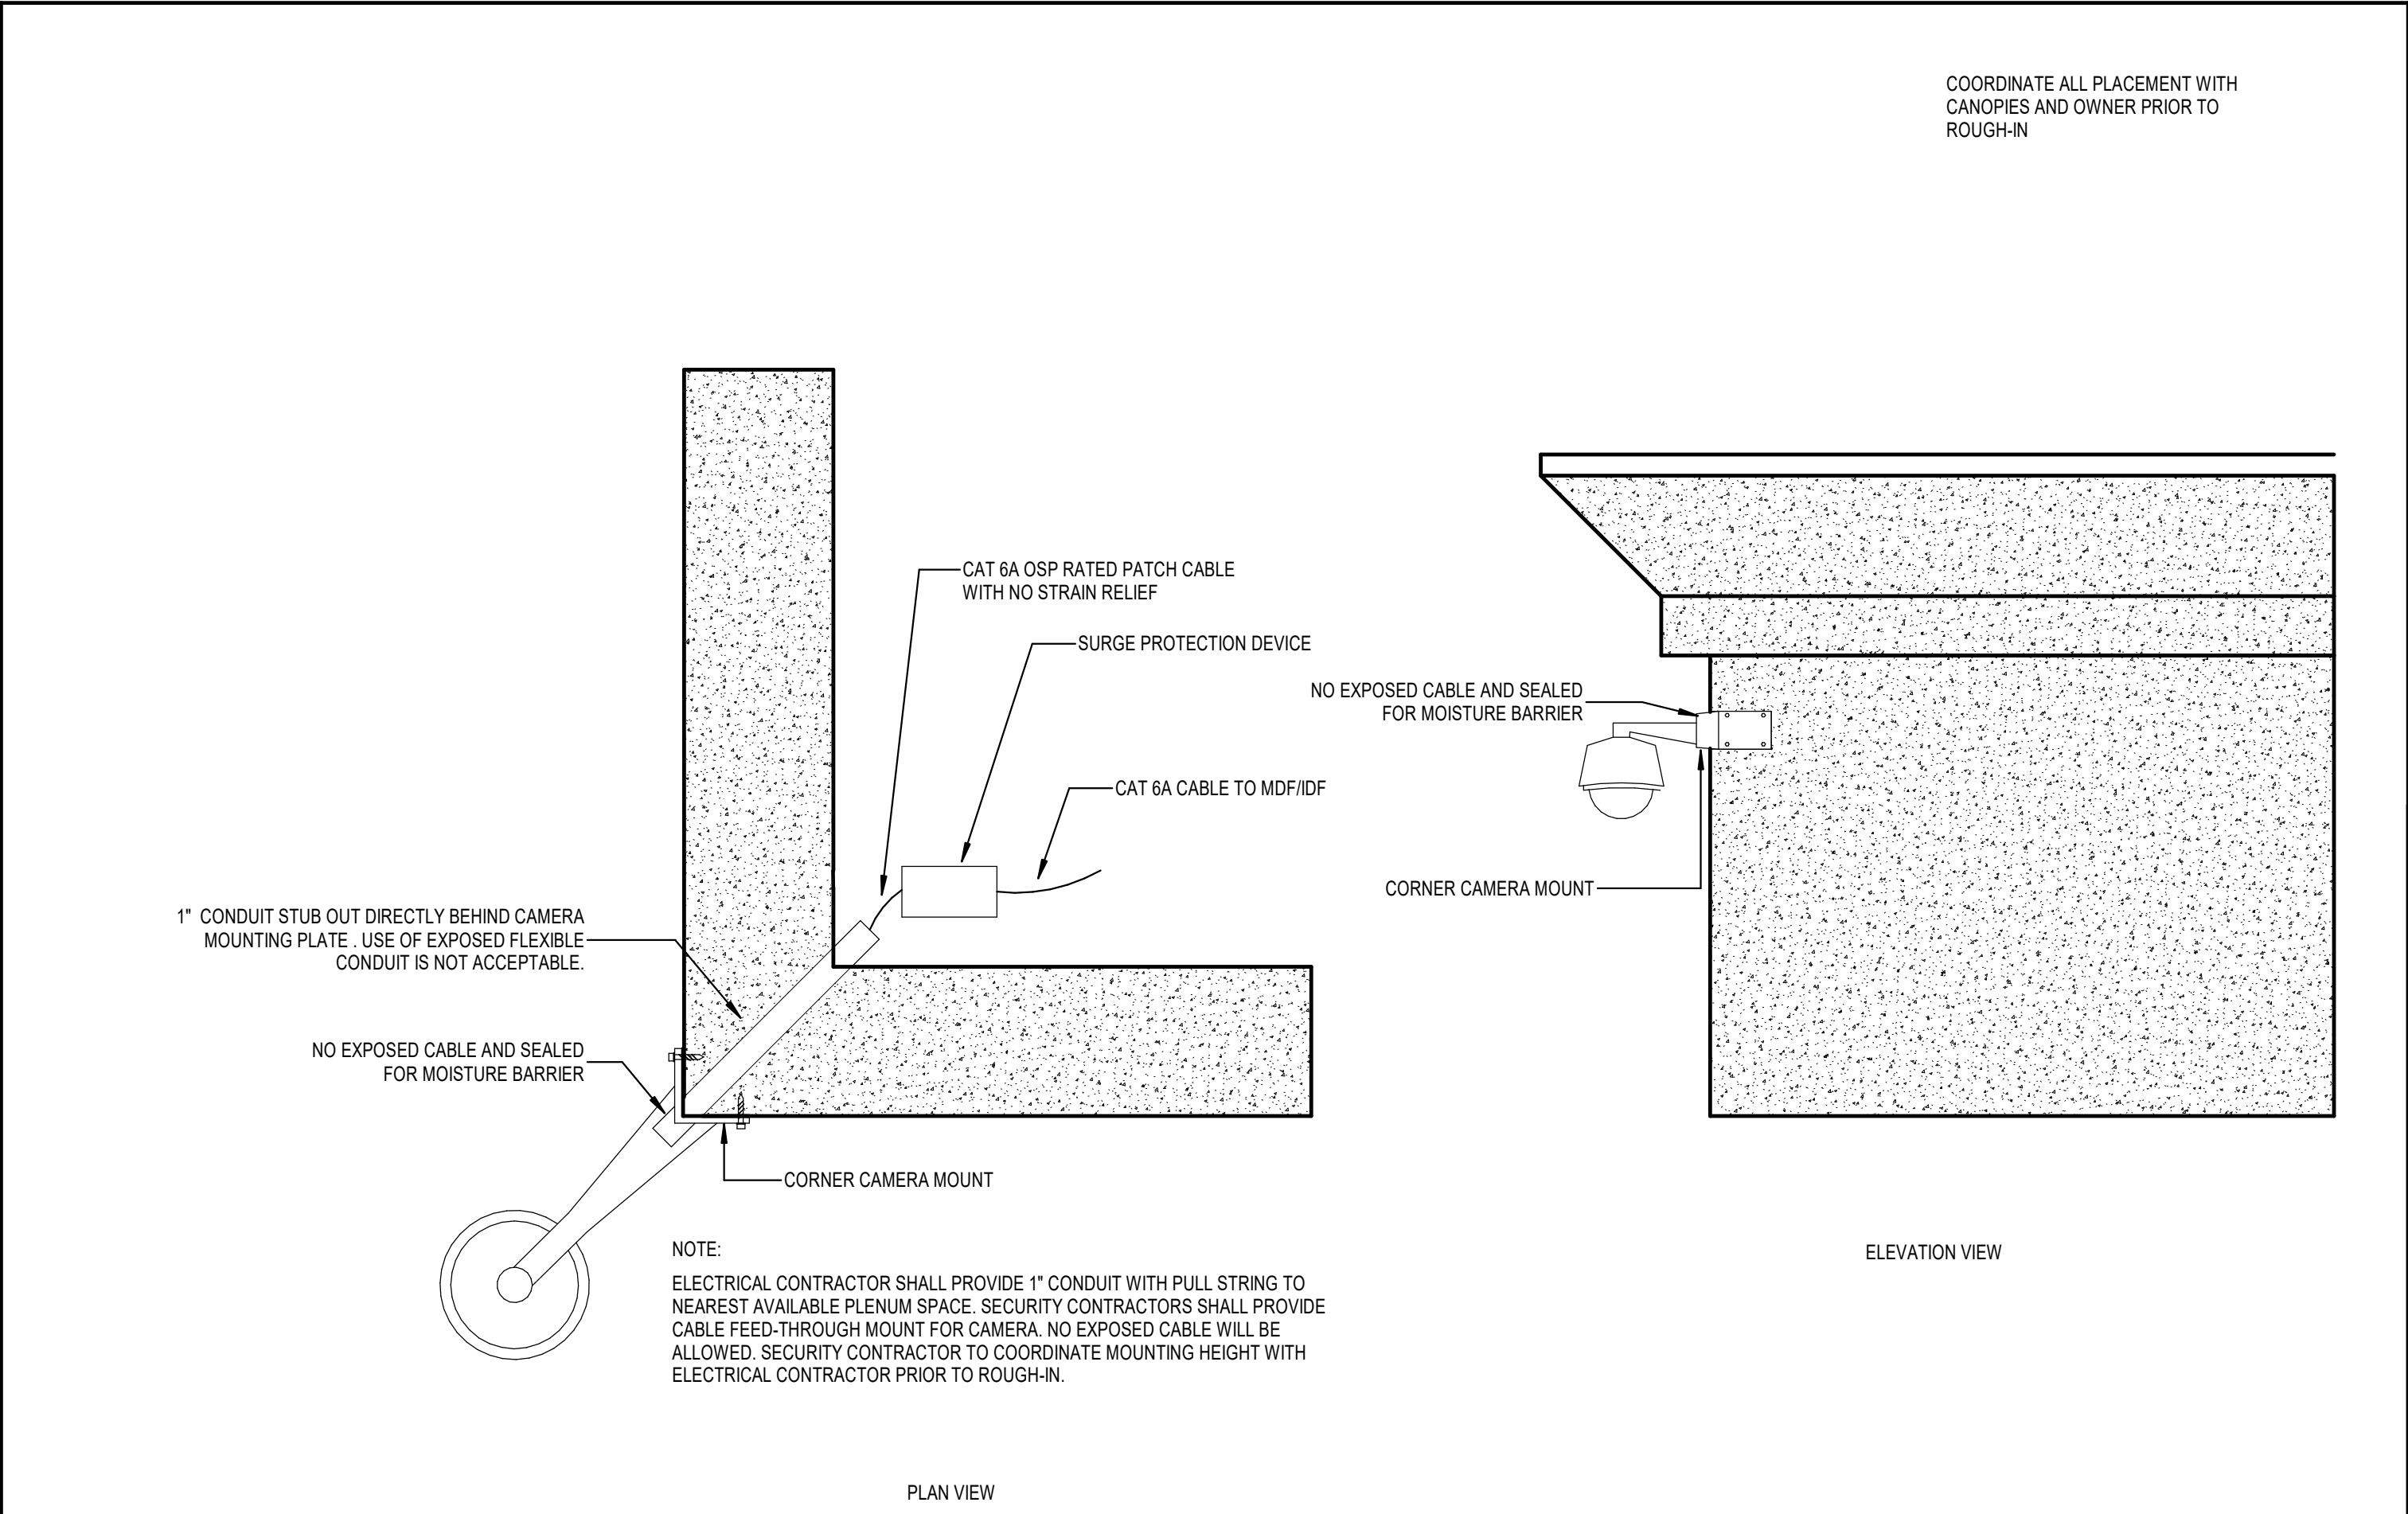


5 LVVSS-05 - CORNER MOUNTING DETAIL

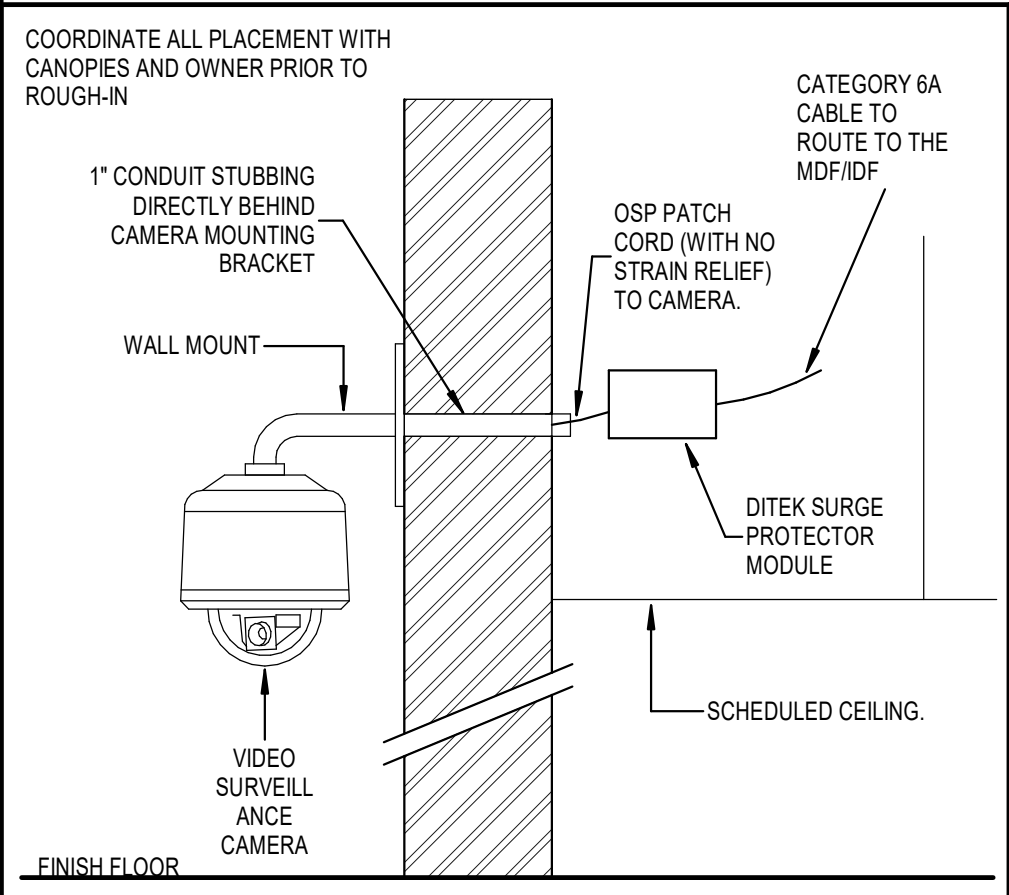

6 EXTERIOR WALL MOUNTED DOME CAMERA

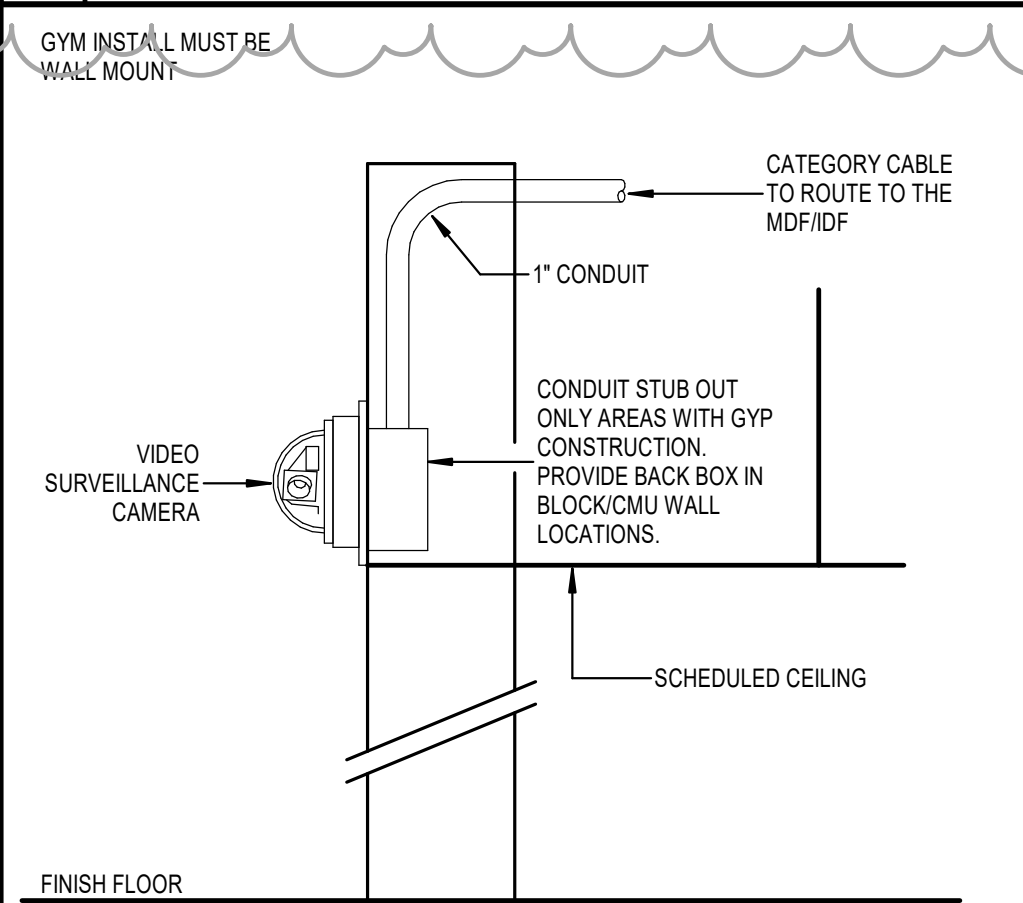

1 LVVSS-02 - INTERIOR WALL MOUNT CAMERA-VERTICAL

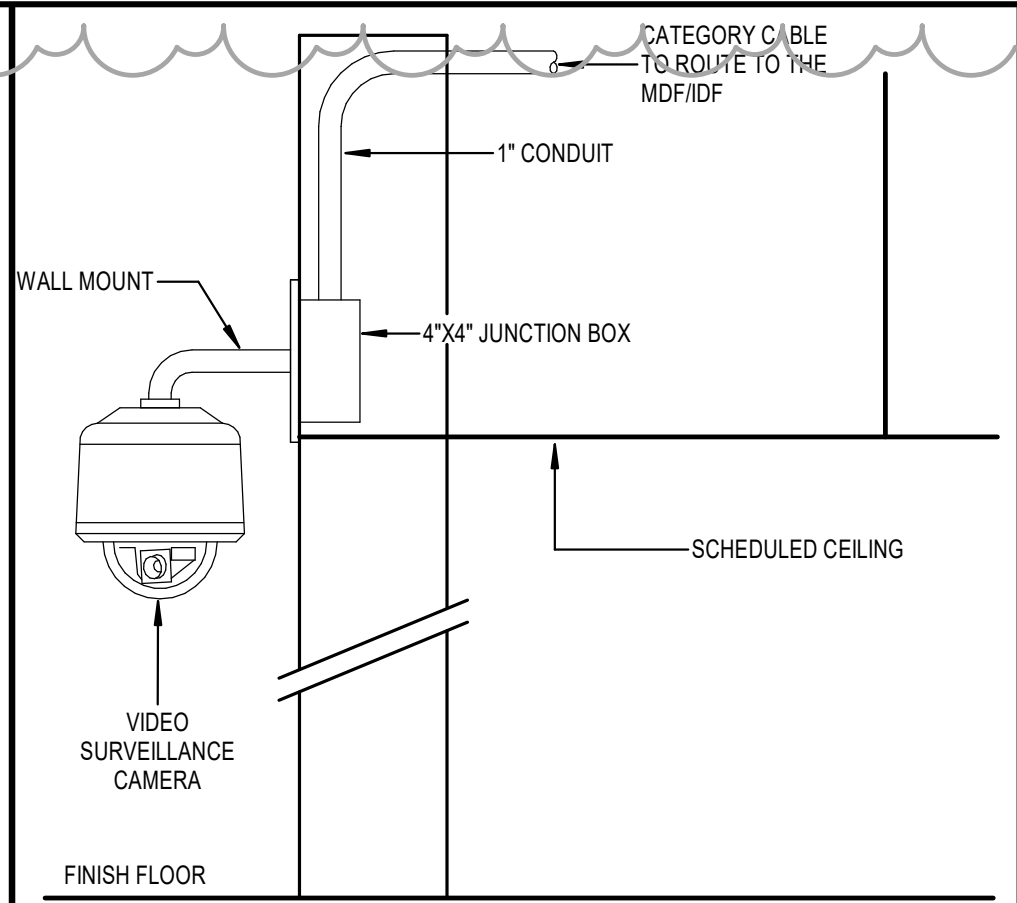

2 INTERIOR WALL MOUNTED DOME CAMERA

NO.	REVISION	DATE
1	Addendum 2	10.02.2024



**NEW CANEY I.S.D.**  
**NEW CANEY**  
**ELEMENTARY SCHOOL**  
19300 VIA CORSICA DRIVE  
NEW CANEY, TX 77337

COPYRIGHT © 2024  
BROWN REYNOLDS WATFORD ARCHITECTS, INC.  
DATE SEPTEMBER 9, 2024  
DRAWN BY DBR  
CHECKED BY DBR QC  
BRW PROJECT NUMBER 223117.00



**DBR**  
713.314.8888  
https://www.dbrinc.com  
TYPE: DBR Project # 220393.000  
BY: PARKWISLE/JLTN/AD




**Bicsi**  
Michael Quitt  
BICS ID # 187703  
EXPRESS ID # 187703  
9/21/2024




**BROWN REYNOLDS WATFORD**  
**ARCHITECTS**  
4501 MAGNOLIA COVE DRIVE  
SUITE 200  
HOUSTON, TEXAS 77045  
281.361.3800  
WWW.BRWARCH.COM

GENERAL DETAIL NOTES:


1. ALL EXTERIOR EGRESS DOORS PREPPED FOR FUTURE CARD READER WITH EPT INSTALLED.

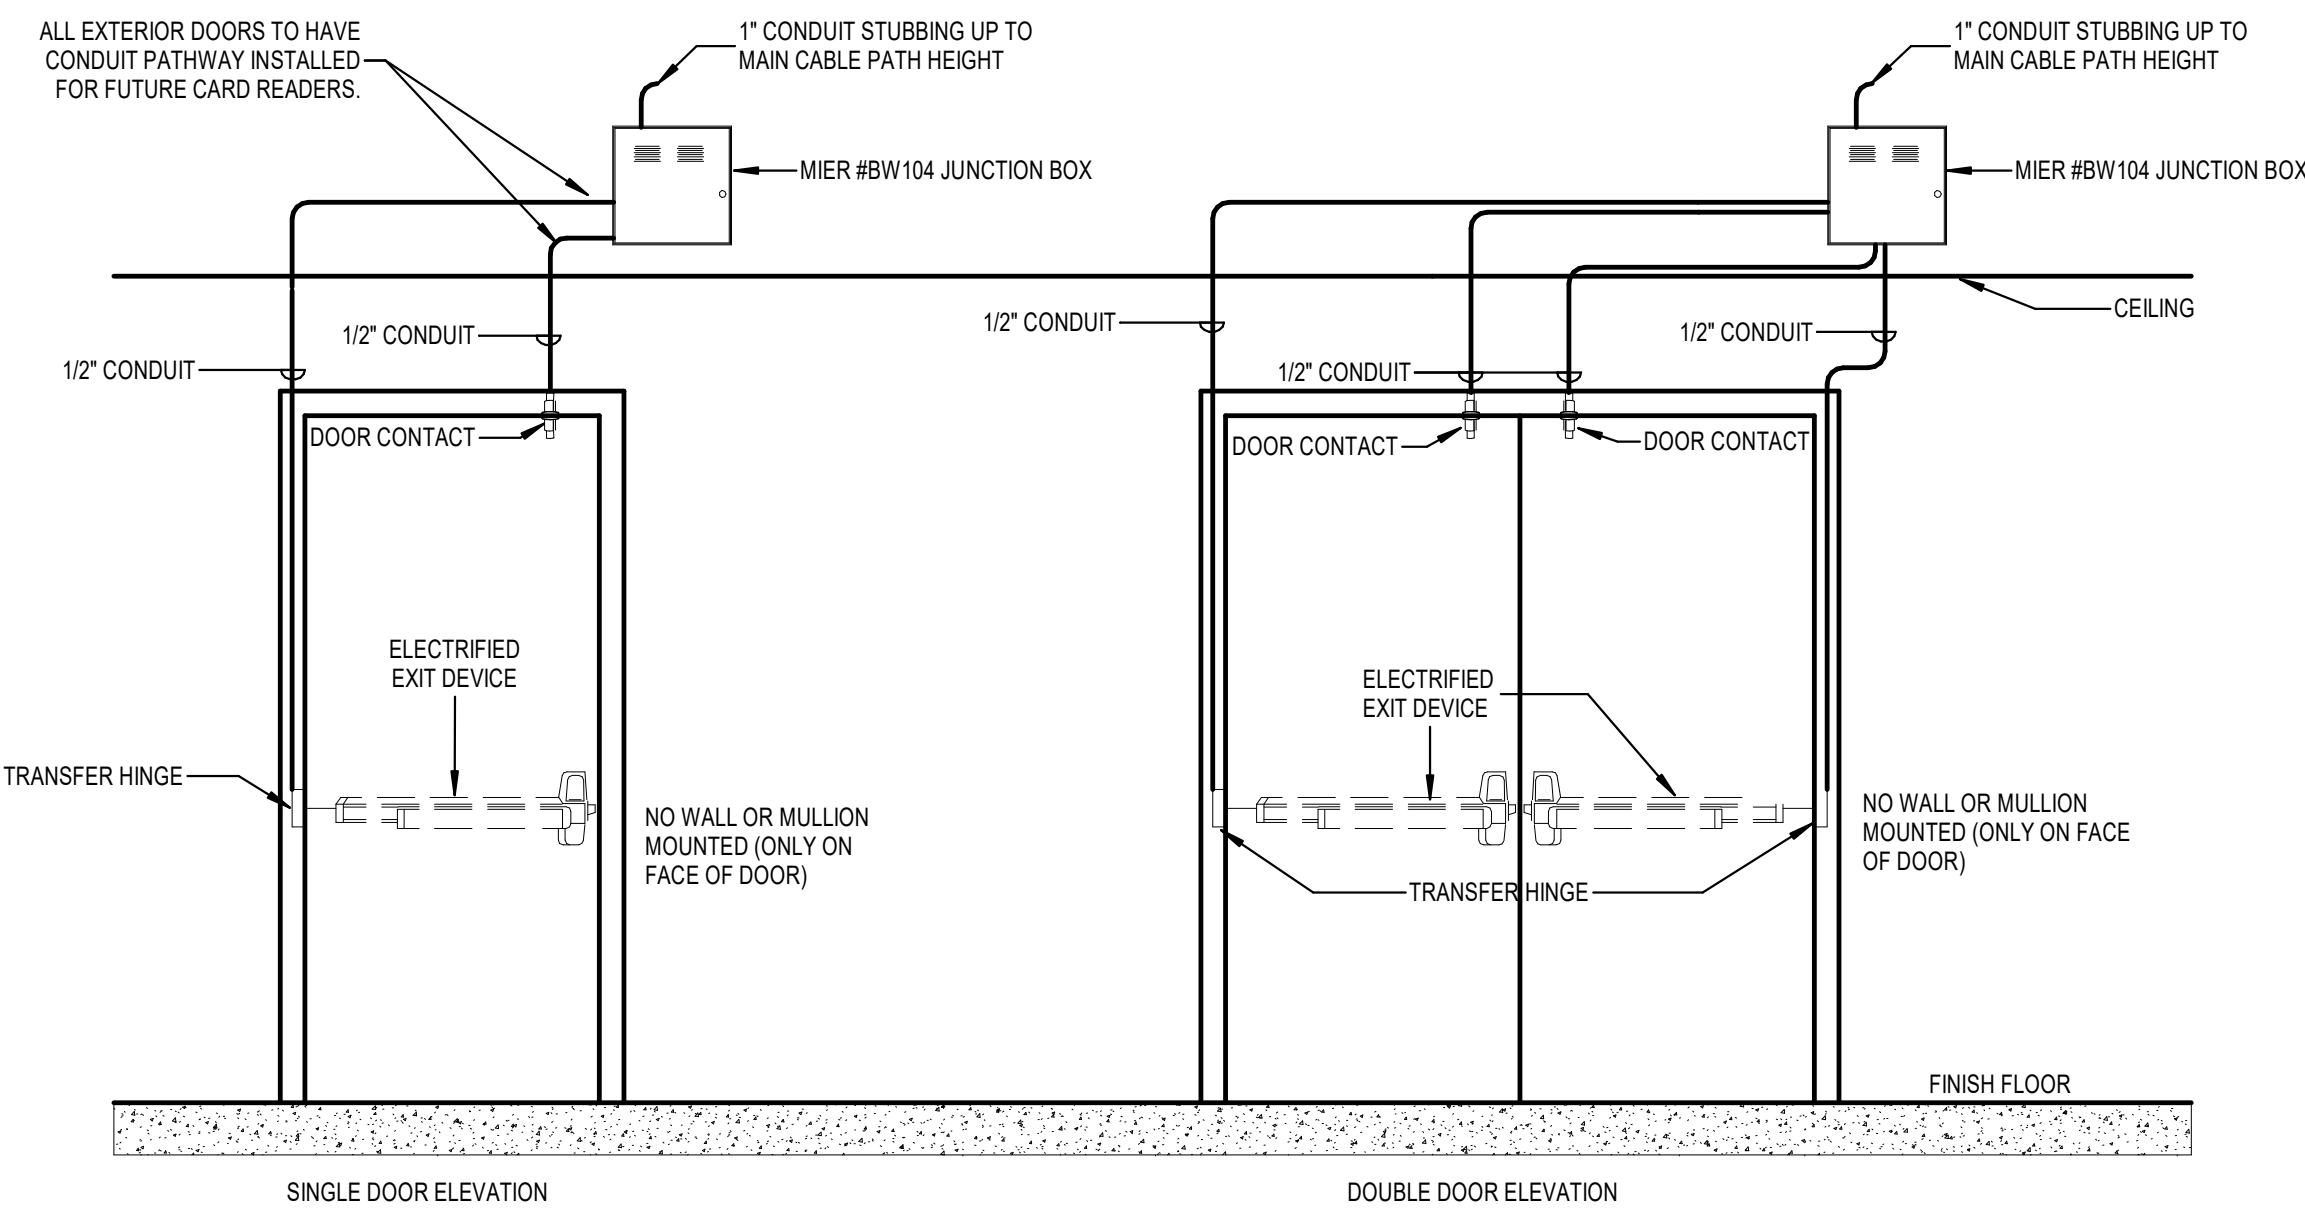


3 LVACS-03 - ACCESS CONTROL - EXIT DEVICE DOOR ELEVATION

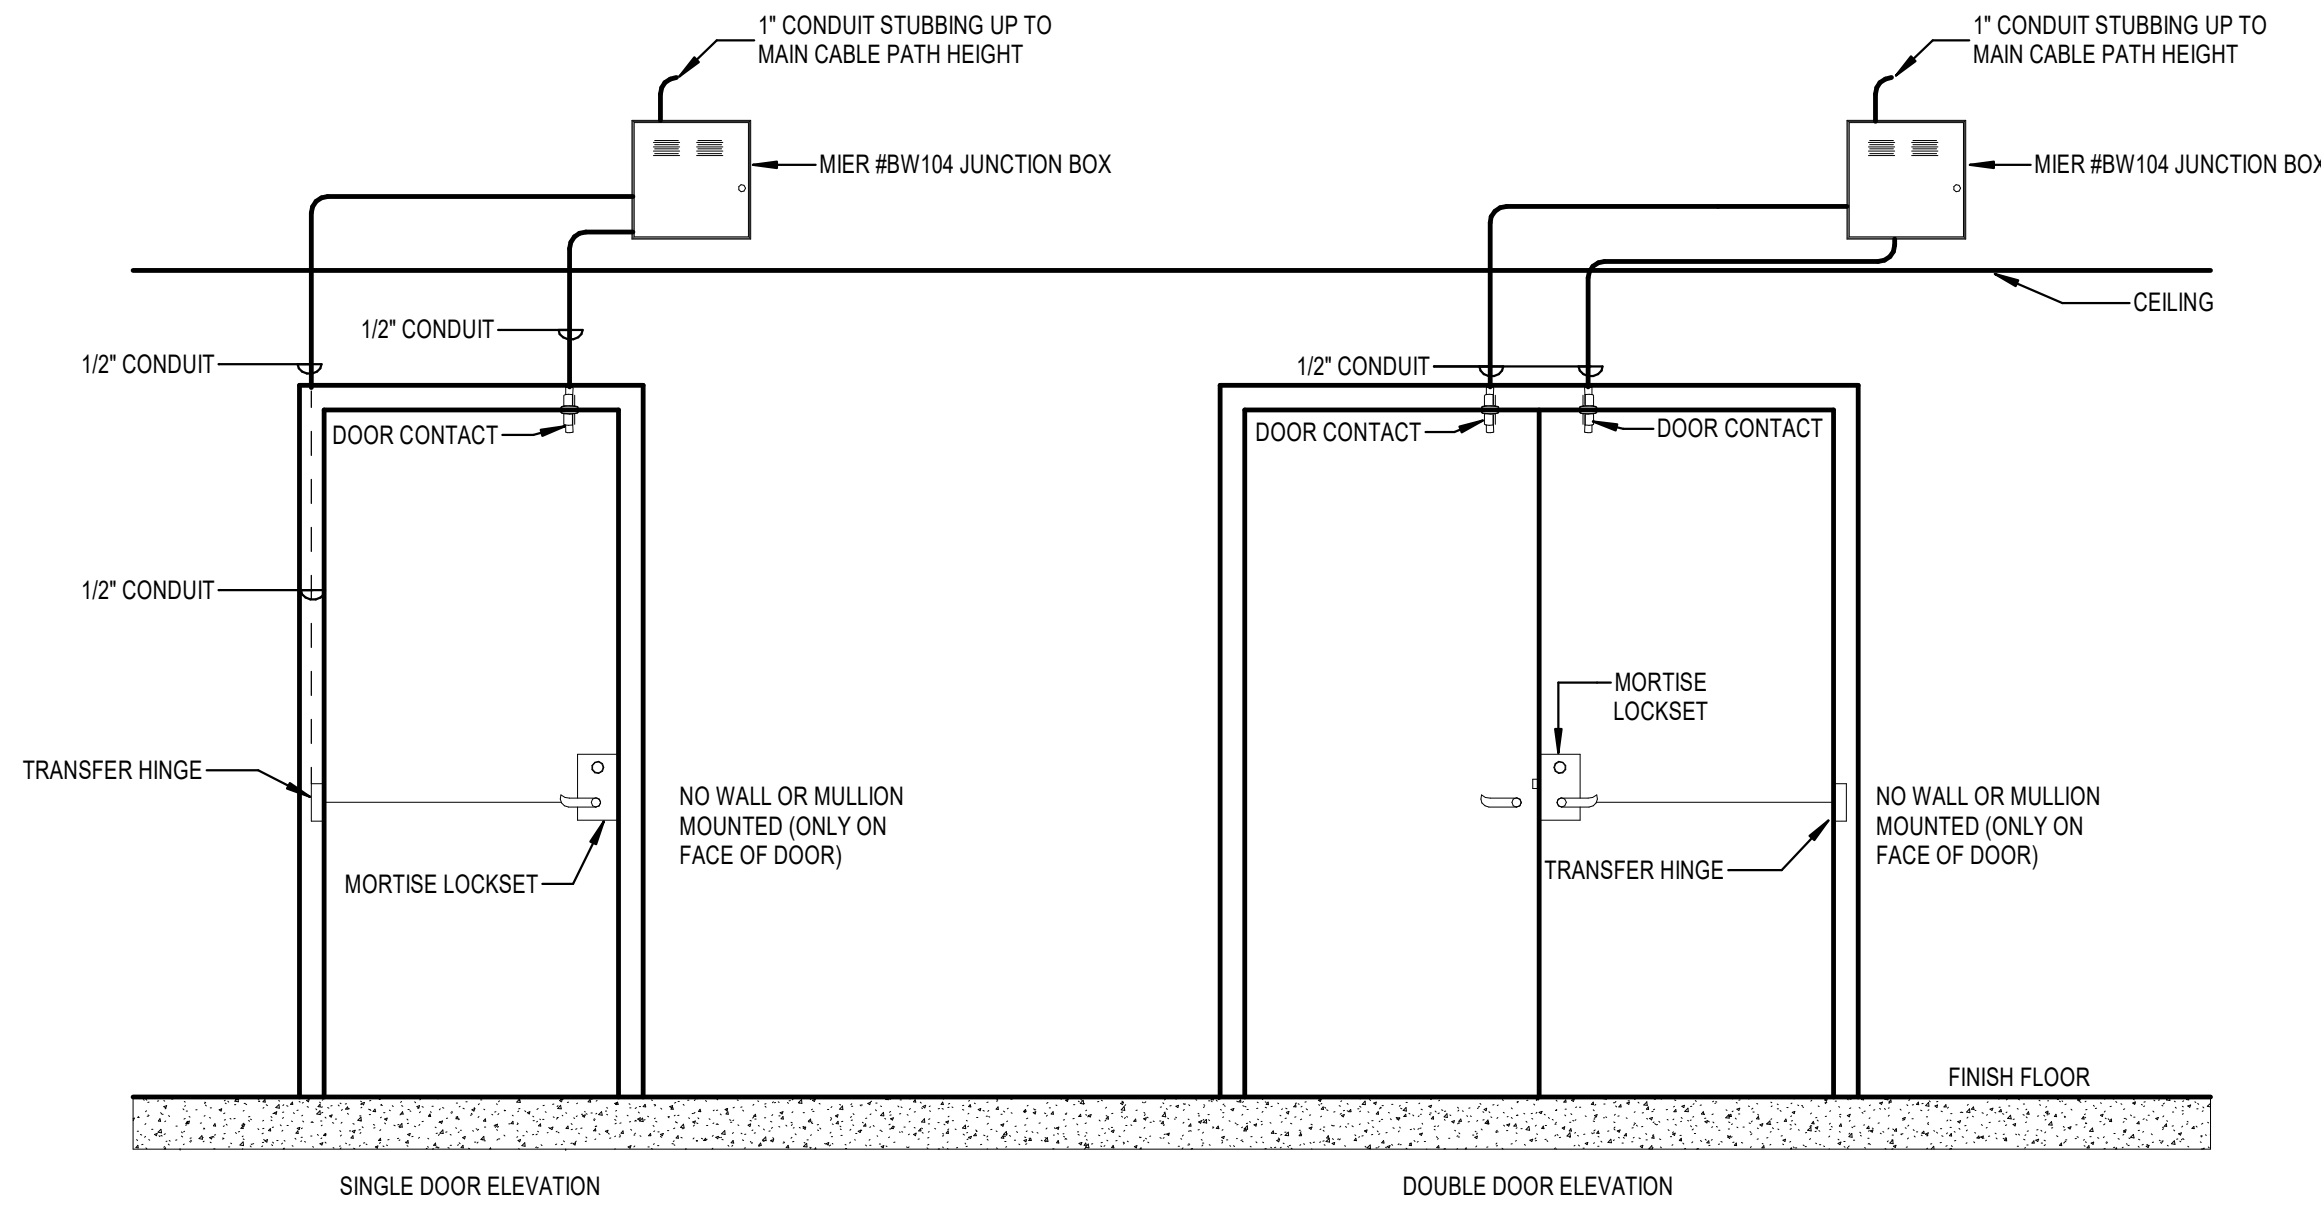

4 ACCESS CONTROL - MORTISE LOCK DOOR ELEVATION

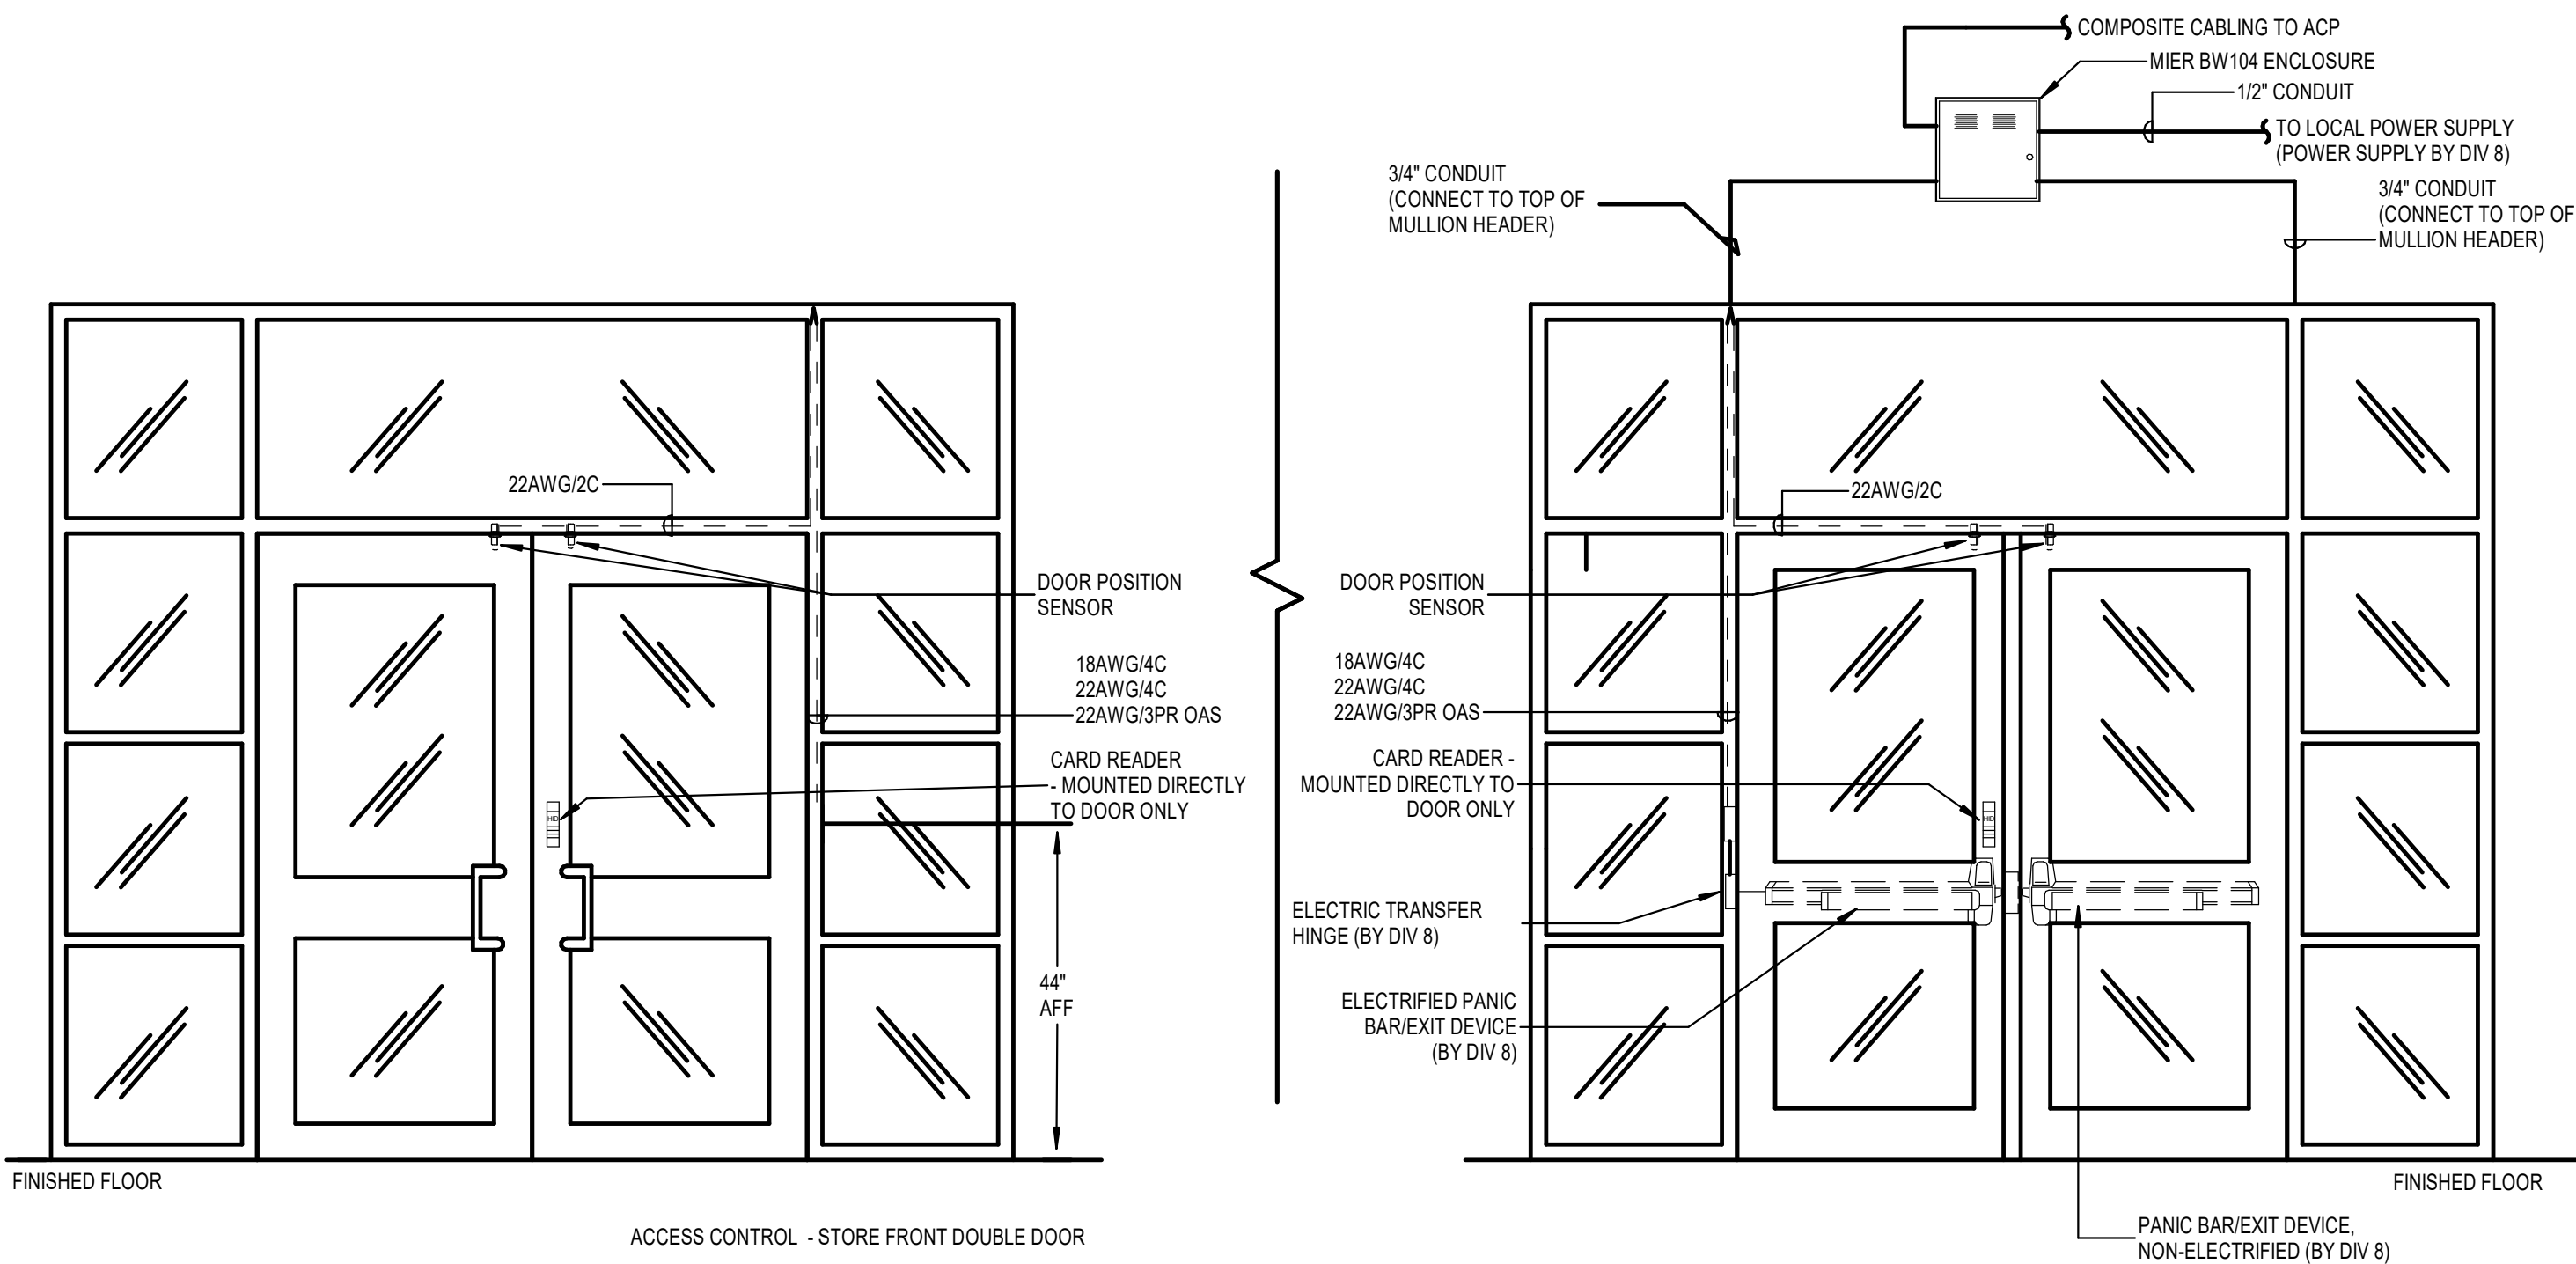

1 ACCESS CONTROL - STORE FRONT DOUBLE DOOR

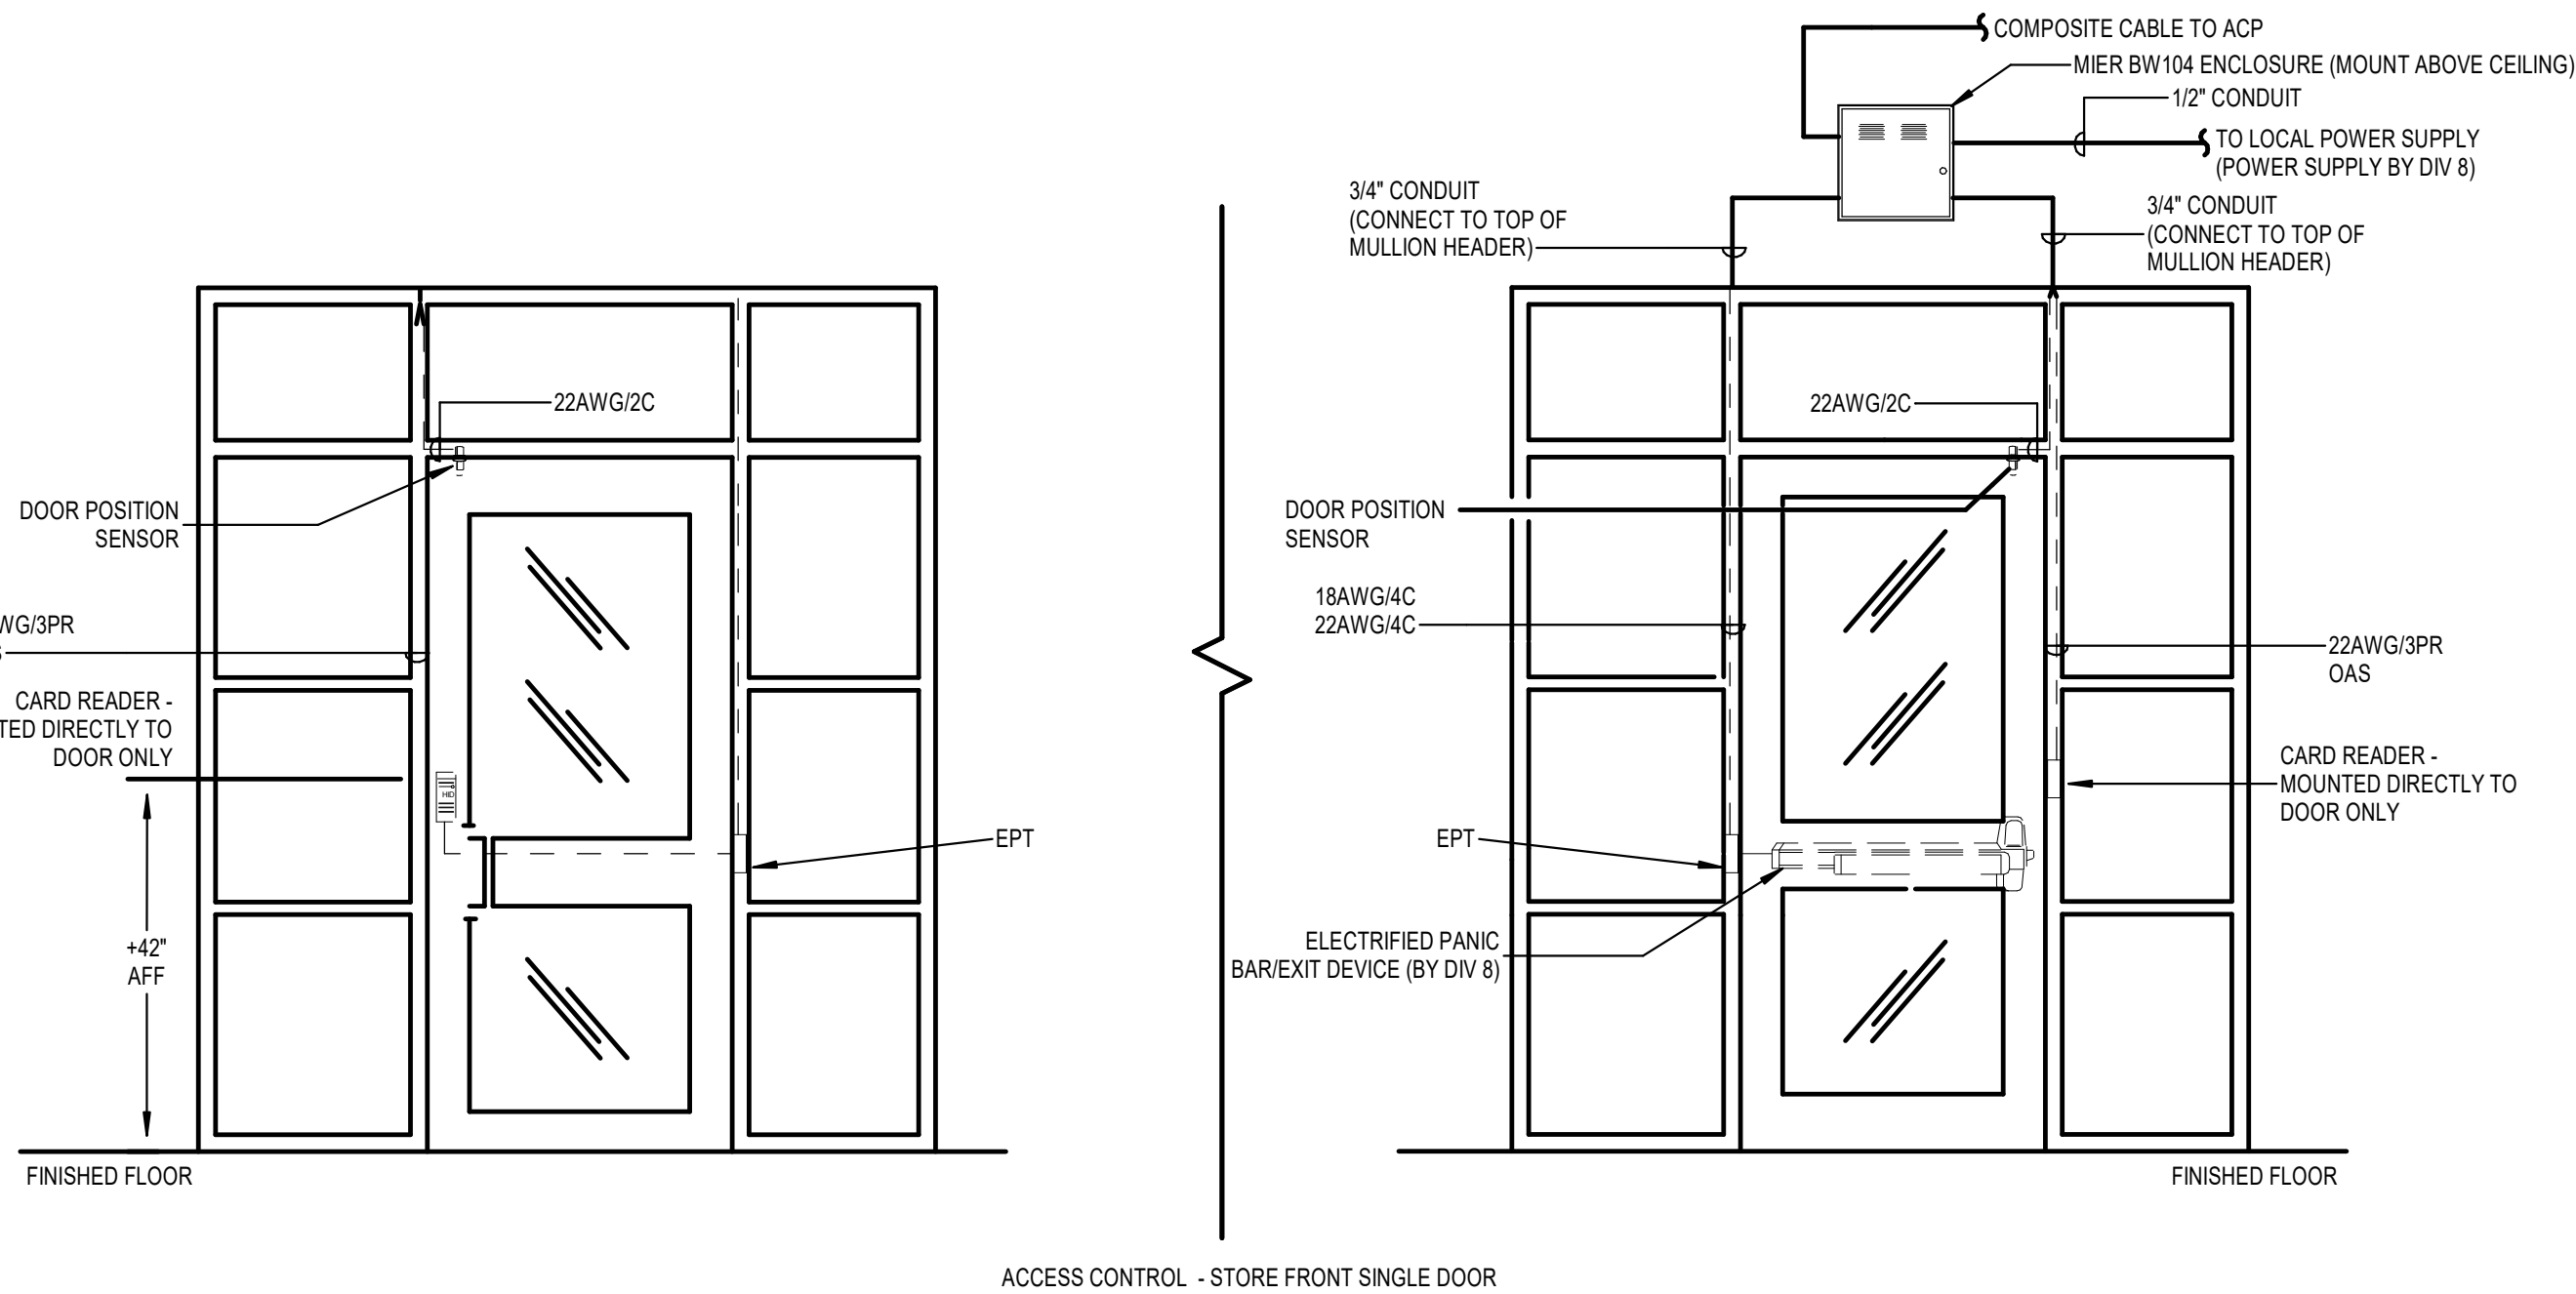

2 ACCESS CONTROL - STORE FRONT SINGLE DOOR